

## ADDENDUM NO. 1

**ISSUED**  
**October 16, 2018**

Fannin County Courthouse  
Phase II Interior & Exterior Restoration

Project No. #1737

**BY:** ARCHITEXAS  
1907 Marilla St.  
Second Floor  
Dallas, Texas 75201

214.748.4561

This Addendum forms a part of the Contract Documents and modifies the Construction Drawings and Project Manual dated January 23, 2018 as noted below.

**Bid Set Drawings**

AD1-01	A0.01	Replace A0.01 with attached.
AD1-02	L1.00	Replace L1.00 with attached.
AD1-03	L2.00	Replace L2.00 with attached.
AD1-04	L3.00	Replace L3.00 with attached.
AD1-05	C3.00	Replace C3.00 with attached.
AD1-06	C4.00	Replace C4.00 with attached.
AD1-07	C5.00	Replace C5.00 with attached.
AD1-08	C7.00	Replace C7.00 with attached.
AD1-09	A1.00	Replace A1.00 with attached.
AD1-10	A1.03	Replace A1.03 with attached.
AD1-11	A1.06	Replace A1.06 with attached.
AD1-12	A1.08	Replace A1.08 with attached.
AD1-13	A1.09	Replace A1.09 with attached.



10/16/18

AD1-14	A1.11	Replace A1.11 with attached.
AD1-15	A1.12	Replace A1.12 with attached.
AD1-16	A1.13	Replace A1.13 with attached.
AD1-17	A1.14	Replace A1.14 with attached.
AD1-18	A1.15	Replace A1.15 with attached.
AD1-19	A2.01	Replace A2.01 with attached.
AD1-20	A2.02	Replace A2.02 with attached.
AD1-21	A2.03	Replace A2.03 with attached.
AD1-22	A2.04	Replace A2.04 with attached.
AD1-23	A2.05	Replace A2.05 with attached.
AD1-24	A2.06	Replace A2.06 with attached.
AD1-25	A2.07	Replace A2.07 with attached.
AD1-26	A3.01	Replace A3.01 with attached.
AD1-27	A3.02	Replace A3.02 with attached.
AD1-28	A4.08	Replace A4.08 with attached.
AD1-29	A4.09	Replace A4.09 with attached.
AD1-30	A4.11	Replace A4.11 with attached.
AD1-31	A4.13	Replace A4.13 with attached.
AD1-32	A6.01	Replace A6.01 with attached.
AD1-33	A6.07	Replace A6.07 with attached.
AD1-34	A6.10	Replace A6.10 with attached.
AD1-35	A7.03	Replace A7.03 with attached.
AD1-36	A7.07	Replace A7.07 with attached.
AD1-37	A7.08	Replace A7.08 with attached.
AD1-38	A7.09	Replace A7.09 with attached.
AD1-39	SD2.01	Replace SD2.01 with attached.
AD1-40	SD2.02	Replace SD2.02 with attached.



AD1-41	S2.00	Replace S2.00 with attached.
AD1-42	S2.06	Replace S2.06 with attached.
AD1-43	S2.10	Replace S2.10 with attached.
AD1-44	S3.01	Replace S3.01 with attached.
AD1-45	S5.11	Replace S5.11 with attached.
AD1-46	M1.01	Replace M1.01 with attached.
AD1-47	M2.01	Replace M2.01 with attached.
AD1-48	M2.02	Replace M2.02 with attached.
AD1-49	M2.03	Replace M2.03 with attached.
AD1-50	M2.04	Replace M2.04 with attached.
AD1-51	M3.00	Replace M3.00 with attached.
AD1-52	M3.01	Replace M3.01 with attached.
AD1-53	M3.02	Insert M3.02 with attached.
AD1-54	M4.01	Replace M4.01 with attached.
AD1-55	M6.01	Replace M6.01 with attached.
AD1-56	P2.01	Replace P2.01 with attached.
AD1-57	P2.02	Replace P2.02 with attached.
AD1-58	P2.03	Replace P2.03 with attached.
AD1-59	P4.02	Replace P4.02 with attached.
AD1-60	P5.01	Replace P5.01 with attached.
AD1-61	E1.01	Replace E1.01 with attached.
AD1-62	E2.03	Replace E2.03 with attached.
AD1-63	E2.05	Replace E2.05 with attached.
AD1-64	E4.01	Replace E4.01 with attached.
AD1-65	E4.02	Replace E4.02 with attached.

**Project Manual**

AD1-66	00 0105	Replace Section 00 0105 Table of Contents page 3 with attached.
AD1-67	05 5000	Replace Section 05 5000 Metal Fabrications with attached.
AD1-68	07 3116	Replace Section 07 3116 Metal Shingles with attached.
AD1-69	07 5400	Replace Section 07 5400 Thermoplastic Membrane Roofing with attached.
AD1-70	07 7233	Insert Section 07 7233 Roof Hatches with attached.
AD1-71	08 5200	Replace Section 08 5200 Wood Windows with attached.
AD1-72	14 4200	Replace Section 14 4200 Wheel Chair Lifts with attached.
AD1-73	23 8126	Replace Section 23 8126 Split-System Air Conditioners with attached.
AD1-74	28 0800	Replace Section 28 0800 Security System Acceptance Testing with attached.
AD1-75	28 1300	Replace Section 28 1300 Access Control & Alarm Monitoring System with attached.
AD1-76	28 1600	Replace Section 28 1600 Intrusion Detection System with attached.
AD1-77	28 2300	Replace Section 28 2300 Video Surveillance System with attached.

**Bidder Questions**

AD1-78		<b>The attached Pre-Bid Conference sign-in sheet and bidder questions are hereby made part of the Contract &amp; bidding documents.</b>
AD1-79		<p>Question: What is the scope of A1- " During Construction:</p> <p>1. Perform additional paint discovery as directed by THC Representative.</p> <p>I am assuming the rest of this item 1.4 Art Conservator Responsibilities refers to the Vault door??</p> <p><b>Answer: Additional paint discovery may occur if uncovered. The Art Conservator would also supervise the restoration of the vault door.</b></p>
AD1-80		<p>Question: Will City of Bonham require an engineered stamp drawing for the clock tower? Spec Section 10 7429, 1.2C states to provide stamped drawing if required.</p> <p><b>Answer: Yes</b></p>

AD1-81

Question:

I was looking at this project on Dodge for DH Pace and there are not any plans posted – can you tell me if any doors or hardware are being replaced and if so how many total?

Answer:

Plans and specs can be obtained from Fannin CCH on the County's website and the State Electronic Business Daily or from Architexas at [rbresson@architexas.com](mailto:rbresson@architexas.com). All new doors and hardware.

AD1-82

Question:

We need a clarification for Spec 073116 Metal Shingles. Sub-section 2.3 ,A refers to shingle stamped to size and profile to match original shingles. We have not found the information for the original shingles in the documents. We also need to know if there is a different profile on the tower base and the dormers.

Answer:

Reference revised specification Section 073116 Metal Shingles and sheets A1.13, A7.09, and A7.10 for shingle types and locations.

AD1-83

Question:

Plan Sheet A6.01 calls out for Rooms 213 & 215 to have wood wainscot but the elevation on Plan Sheet A4.11 references Room 213 and Plan Sheet A4.12 references Room 215 does not show wood wainscot. Can we assume there is no wainscot in these rooms?

Answer:

No wainscot in Rooms 213 and 215. Reference revised A6.01.

AD1-84

Question:

What is the ul number that we are to use on the fireproofing and what is to be used you show Cafco is Cafco 300 ok

Answer:

Apply fireproofing as required to achieve noted rating. Material requirements are identified in the Project Manual.

AD1-85

Question:

What ul number and which product for Intumescent fireproofing is to be used

Answer:

Apply fireproofing as required to achieve noted rating. Material requirements are identified in the Project Manual.

AD1-86

Question:

Exact color/manufacture/style/pattern of the main roof custom metal stamped shingles

Answer:

Reference revised specification Section 073116 Metal Shingles.

- AD1-87
- Question:  
Profile Detail / Attachment / fastening detail for the Aluminum Cornice (Provided by others) Installed by roofing contractor
- Answer:**  
**Details provided on sheet A1.14. Shop drawings with proposed installation details to be reviewed by the architect and structural engineer.**
- AD1-88
- Question:  
Plans indicate NEW / EXISTING elevation lines on the elevation drawings, Will the downspouts be fully replaced?
- Answer:**  
**Yes**
- AD1-89
- Question:  
What type / gauge / materials will the inlaid gutters be fabricated with?
- Answer:**  
**Reference specification Section 076200 Sheet Metal Flashing and Trim.**
- AD1-90
- Question:  
What color / manufacture will the metal fascia, drip edge, exposed flashing's, transitions, crickets be?
- Answer:**  
**Fascia and Chimney Flashing – Colonial White**  
**Drip Edge, Crickets, Ridges, Valleys, Roof Flashings – Colonial Red**
- AD1-91
- Question:  
The tower will be provided and installed by a specialty contractor. Will there be ANY flashing's, or shingles installed by our scope as the possible roofing contractor?
- Answer:**  
**Roofer to include flashing and install between roof and tower base and roof and dormers**
- AD1-92
- Question:  
The specifications call for an 80 MIL TPO roof system with a 30 year NDL warranty. I do not see these roof areas called out on the plans, Where will this be installed? And if it will be used on this project, Would Mule-Hide a product made by Carlisle be allowed? It has the same specifications required since it is just a private label of Carlisle.
- Answer:**  
**Reference sheets A1.14 and 1.15. TPO to be installed at tower base. Mule-Hide may be submitted with a substitution form.**
- AD1-93
- Question:  
The project shows the decking and trusses to be removed and replaced with an all metal roof truss/deck system. Who will pick this up? (We will not bid installation of trusses, metal decking) And will only bid above deck substrates.

1. Will the metal decking have plywood installed over it?
2. Insulation? (R Value)? Thickness?
3. If above deck insulation is desired would a "Nail Base" (Factory manufactured POLY ISO laminated to 5/8" decking) be allowed?
4. Will wood blocking/sheathing be picked up by framing contractor?

**Answer:**

1. **Yes**
2. **Blown Insulation specified at attic with R-Value of 20**
3. **N/A**
4. **Coordinate with GC**

AD1-94

**Question:**

Will onsite dumpsters/roll offs be provided by GC?

**Answer:**

**Coordinate with GC**

AD1-95

**Question:**

Will all four sides of the building be scaffolded by others to the roof eave? beyond?

**Answer:**

**Coordinate with GC**

AD1-96

**Question:**

Do you have a product cut sheet for the stamped metal shingles?

**Answer:**

**Reference revised specification Section 073116 Metal Shingles**

AD1-97

**Question:**

Will the Aluminum cornice around the perimeter of the building also go up the rake/gable ends of the buildings and dormers?

**Answer:**

**Yes, at gable locations. Dormers will be pre-fabricated.**

AD1-98

**Question:**

I need to get the blind scope clarified. Note 10 in the general notes on the window schedule page A6.08 mentions blinds at typical windows. There are several windows that show to receive custom wood shutters, metal shutters and some are shown to have a laminated glass guard rail in front of the window. Other than the note 10 I can find no specific call out for blinds. Please clarify locations of blinds.

**Answer:**

**Typical window to receive wood blinds including windows with metal shutters and windows with laminated glass guardrails.**

- AD1-99
- Question:  
Is there a known process to remove black adhesive from existing stone exterior?
- Answer:**  
**Yes, reference Project Manual. Methodology is specified in Section 003144 Masonry Conservation Report and Section 040344 Masonry Cleaning**
- AD1-100
- Question:  
Does the \$14 million figure for project cost include abatement and Phase I?
- Answer:**  
**Yes**
- AD1-101
- Question:  
Section 013592 – Art Conservator, will this be the responsibility of the Owner?
- Answer:**  
**No**
- AD1-102
- Question:  
Section 014001 – Historic Preservation Qualification Statement Form, will this form be required to be submitted at bid time?
- Answer:**  
**No**
- AD1-103
- Question:  
Section 040342 – Masonry Restoration, could the costs for the quarry access be provided as an allowance established by the Owner?
- Answer:**  
**Reference County's response.**
- AD1-104
- Question:  
Section 073116 – Metal Shingles, the section states that the new metal shingles shall match the existing. Where can the existing shingles that are to be matched found?
- Answer:**  
**Reference revised specification Section 073116 Metal Shingles**
- AD1-105
- Question:  
Please extend deadline for asking questions. While we have tried to thoroughly review the documents and compile questions, it is inevitable that additional questions will come up as we continue to work through the scope.
- Answer:**  
**No**
- AD1-106
- Question:  
Metal roofing shingles – specifications say to custom stamp to match

original shingles. Please provide more information on the original shingle such as detailed photographs and dimensions. If the original shingle is not available, please select a similar shingle from a manufacturer's productline.

**Answer:**

**Reference revised specification Section 073116 Metal Shingles**

AD1-107

**Question:**

The specification calls for a 30 year warranty on the 80 mil TPO and the manufacturers typically only give 20 year warranties on that product. Please advise.

**Answer:**

**Reference revised specification Section 075400 Thermoplastic Membrane Roofing**

AD1-108

**Question:**

What is the thickness and fastening pattern for the plywooddeck?

**Answer:**

**Shown on General Notes on sheet S1.02.**

AD1-109

**Question:**

No specification for the metal gutter liner. Please provide material/gauge/etc.

**Answer:**

**Reference specification Section 076200.**

AD1-110

**Question:**

Restoration of existing vault door – can you provide any information you have on the existing vault door and/or detailedphotographs?

**Answer:**

**See attached photos. Door was purchased on E-Bay and is believed to be the original vault door to the building. It is currently being stored locally at a residence's barn and needs to be transported to a shop for restoration.**

AD1-111

**Question:**

Specification section 01-3592 Art Conservator, Item 1.4 Duties and Responsibilities calls for the conservator to perform additionalpaint discovery as directed. Can you please confirm what additional tests/analysis will be required?

**Answer:**

**Additional paint discovery may occur if uncovered. The Art Conservator would also supervise the restoration of the vault door.**

AD1-112

**Question:**

Detail 1 on sheet A6.01 details a pattern for sheet flooring (linoleum). The finish schedule on that same sheet lists flooring types for each room, but no room is indicated to have sheet flooring. Where does the sheet flooring occur?

- Answer:**  
**Reference revised sheet A6.01. This information is also called noted on sheets A1.06 and A1.08**
- AD1-113
- Question:**  
Specification section 07-1700 Bentonite Waterproofing calls to use Cetco material. Cetco makes several bentonite products. We assume the product for this project would be Voltex DS. Please confirm.
- Answer:**  
**We assumed Swelltite unless manufacturer recommends a different product for this application**
- AD1-114
- Question:**  
There are multiple details for the perimeter wall (included in alternate #1) that show different materials for the capstone. Please confirm that the capstone for the wall should be cast stone and the veneer stones should be limestone.
- Answer:**  
**Confirmed**
- AD1-115
- Question:**  
There are multiple details for the new chimneys that show different materials. Please confirm that new limestone should be used to build the new chimneys.
- Answer:**  
**The chimney cap is caststone. The rest of the chimney is limestone.**
- AD1-116
- Question:**  
In regards to the stone veneer repairs, in situations (particularly adjacent to windows) where large stones are present and only a portion of that stone's face is damaged, is it acceptable to do a partial veneer (in lieu of replacing the entire face of the stone, only replace the part that is damaged)? The cost savings would be very significant.
- Answer:**  
**A partial veneer may only be acceptable in certain areas. The sub-contractor is not to add any visible non-original vertical joints. They may add a joint where it will be concealed, such as behind a brick mould.**
- AD1-117
- Question:**  
Also in regards to the stone veneer repairs, what thickness will be required for the new stone replacement pieces?
- Answer:**  
**Size will vary depending on location and condition. Minimum 3".**
- AD1-118
- Question:**  
Please provide attachment details for stone veneer repairs and full depth stone replacement pieces.



- Answer:**  
**Details are not provided. Reference general notes on drawings and Project Manual for description of work.**
- AD1-119
- Question:  
Please provide the ASTM numbers and quantity for each type of stone testing required.
- Answer:**  
**Reference specification Section 040342 Masonry Restoration.**
- AD1-120
- Question:  
It was mentioned during the pre-bid meeting that we must keep the building in the dry at all times even when we remove the existing roof structure. This will be extremely difficult. Would it be acceptable to leave the building exposed for a short period of time if we remove and salvage any wood flooring/trim that is scheduled to remain and reinstall it once the building is dried in? The cost savings would be very significant
- Answer:**  
**No**
- AD1-121
- Question:  
Specification section 07-2126 Blown Insulation calls for insulation to be installed "between framing members in attic". Please confirm that the intention is to insulate the entire underside of the roof deck to an R value of 20.
- Answer:**  
**Design intent to be blown insulation above the Third Floor ceiling. Foam insulation at the underside of the roof deck would be considered if it does not impact the cost.**
- AD1-122
- Question:  
Sheet L1.00 – General Notes – Hardscape - #1 Type 1 calls for crushed limestone reused from existing stone panels removed in previous phase. Please confirm that this note no longer applies and the intention is to use new decomposed granite in all locations.
- Answer:**  
**Confirmed**
- AD1-123
- Question:  
Please clarify locations where fireproofing is required on structural steel and/or at walls.
- Answer:**  
**Locations noted to have a fire rated assembly: fire rated ceiling assemblies, shaft wall assemblies, balcony fire-rated plenum space**
- AD1-124
- Question:  
Please specify Break Room stairs – what type. Conflicting/unclear detail (A4.01, A4.07).

	<p><b>Answer:</b> <b>Reference sheet A7.03.</b></p>
AD1-125	<p>Question: We need details on Metal Shutters/Louvers (Type H &amp; G A1.08,A6.07) Mfg? Model?</p> <p><b>Answer:</b> <b>Type H &amp; G are custom metal shutters. The Louvers are pre-manufactured by the tower manufacturer.</b></p>
AD1-126	<p>Question: No intrusion called out in drawings. Is this correct? Specs call for Bosch E series – Please clarify and confirm.</p> <p><b>Answer:</b> <b>Provide add alternate pricing for comparable intrusion detection system.</b></p>
AD1-127	<p>Question: Controller at courtroom with existing system or new controller? S2 Software – existing or standalone?</p> <p><b>Answer:</b> <b>New controller. Stand alone.</b></p>
AD1-128	<p>Question: Video storage software called out supported by a Windows 2008 platform. Spec calls for S2NETVR 100. These are two different software programs. Pleaseclarify.</p> <p><b>Answer:</b> <b>S2NETVR 100</b></p>
AD1-129	<p>Question: Calling for network analytics in this spec. Usually in IT. Confirm scope for analytics.</p> <p><b>Answer:</b> <b>Requirement will be removed</b></p>
AD1-130	<p>Question: What kind of turnstile software and version?</p> <p><b>Answer:</b> <b>Requirement will be removed</b></p>
AD1-131	<p>Question: What type of TRS software and version?</p> <p><b>Answer:</b> <b>S2</b></p>

- AD1-132
- Question:  
VMS – fully scalable. Virtual server? S2 VR 100 Series/MS Windows 2008.  
Virtual for backup only? Redundant? There are 3 different storage solutions – please confirm which one?
- Answer:**  
**S2 VR 100 SERIES**
- AD1-133
- Question:  
Intercom access integration. More specific – what type of system is existing?
- Answer:**  
**Requirement will be removed**
- AD1-134
- Question:  
Active directory integrated with all systems or just for access control system?
- Answer:**  
**Only integrated with access control system**
- AD1-135
- Question:  
Access control software - servers confirm Cisco. Conflicting OS with MS Windows 2008?
- Answer:**  
**S2 CONTROL SOFTWARE**
- AD1-136
- Question:  
Controller calls for 16 readers for backup. Also calls for S2 which only has 14 readers.
- Answer:**  
**S2 SUPPORTS 32 CARD READERS**
- AD1-137
- Question:  
With S2 server - 99 fault guarantee not reasonable.
- Answer:**  
**Requirement will be removed**
- AD1-138
- Question:  
If Security/Technology/Data sub not authorized Bosch dealer – comparable mfg models acceptable?
- Answer:**  
**Comparable models will be accepted pending engineer review.**
- AD1-139
- Question:  
Can you provide a repair detail for repairs identified as “P”, “V”, “T”, “R”
- Answer:**

**Details are not provided. Reference general notes on drawings and Project Manual for description of work.**

AD1-140

Question:

Are we to bid repairs as shown on prints? Quantities of repairs seem small?

**Answer:**

**Yes**

AD1-141

Question:

What equipment is allowed inside building for installation of steel components?  
Floor Load ratings?

**Answer:**

**Submit the proposed lifts to be used at the existing building for review. Generally 60 psf max**

AD1-142

Question:

Majority of new structural steel will need to be dropped in through the roof via crane during structural steel erection leaving the interior open to the elements during this process. Is this responsibility of steel erector to keep dry?

**Answer:**

**Coordinate with GC**

AD1-143

Question:

A crane will have to be mobilized for the erection of this project. The crane will have to be positioned as close as possible to the building in various locations. Is this permissible?

**Answer:**

**Submit proposed crane for review.**

AD1-144

Question:

What, if any, fire protection measures will need to take place during the erection of steel for this project?

**Answer:**

**Coordinate with GC**

AD1-145

Question:

Will the concrete subcontractors cut openings for new imbeds? Will they be providing and installing embed plates as required?

**Answer:**

**This is a means and methods item.**

AD1-146

Question:

Can you provide "Quarry of stone" requirements and regulations?

**Answer:**

**Testing requirements of original and proposed limestone is specified in Section 040342 Masonry Restoration**

AD1-147

Question:

Outside & inside corner condition, do we replace entire corner piece of stone to eliminate joints at these locations, if only 1 side is marked for repair or replacement?

**Answer:**

**Yes, no added joints.**

AD1-148

Question:

Are the cleaning mock-ups acceptable finished results?

**Answer:**

**No, reference specification Section 040344 Masonry Cleaning**

AD1-149

Question:

(P) Patch repair

1. (P-2) indicates less than 15% deterioration. What average depth of repairs should be assumed for the P-2 repairs?
2. (P-3) indicates 15% to 50% deterioration., What average depth of repairs should be assumed for the P-3 repairs?

**Answer:**

1. **Depth varies, VIF**
2. **Depth varies, VIF**

AD1-150

Question:

R) Stone replacement

Notes say to provide new limestone from existing quarry to match original. Due to serious logistics issues to re-open a quarry and extract and cut the stone an alternative source for the stone would be beneficial to both bidders and the owner. Is an alternative source for limestone acceptable? If so, will the owner provide alternative sourcing, or are bidders required to source these materials?

**Answer:**

**No, there is no alternative**

AD1-151

Question:

(T) Tool repair

(T) Tool existing limestone surfaces to create surface finish that closely resembles existing adjacent stone surfaces.

1. Please clarify the expectation for this work.
2. We are assuming there will be no patching of these stone, is this correct?
3. We are assuming that these stone will have any loose areas chipped away and maybe some light sanding to enhance the appearance of the stone relative to the surrounding stone. Is this correct?
4. If the above is not the intention, please clarify.

**Answer:**

1. **Reference general notes on Exterior Elevations and Section 040342 Masonry Restoration**
2. **Yes**
3. **Yes**

AD1-152

**4. See above**

Question:

(V) Dutchman repair:

(V) Attach limestone veneer to match adjacent limestone surfaces. This is the most prominent call out on the exterior masonry, so understanding the requirements for these repairs is important. We realize there may not be a standard depth for the dutchman repairs, but we will have to base pricing on something approximating an average depth requirement.



1. Is there an average depth upon which pricing can be based? If not, what would be the thinnest depth dutchman repairs anticipated? What would be the thickest depth anticipated?
2. See question 2 above. Is an alternative source acceptable, and will owner provide alternative sourcing for acceptable limestone materials?

Answer:


1. **Minimum 3" to 12" +/- VIF**
2. **No**






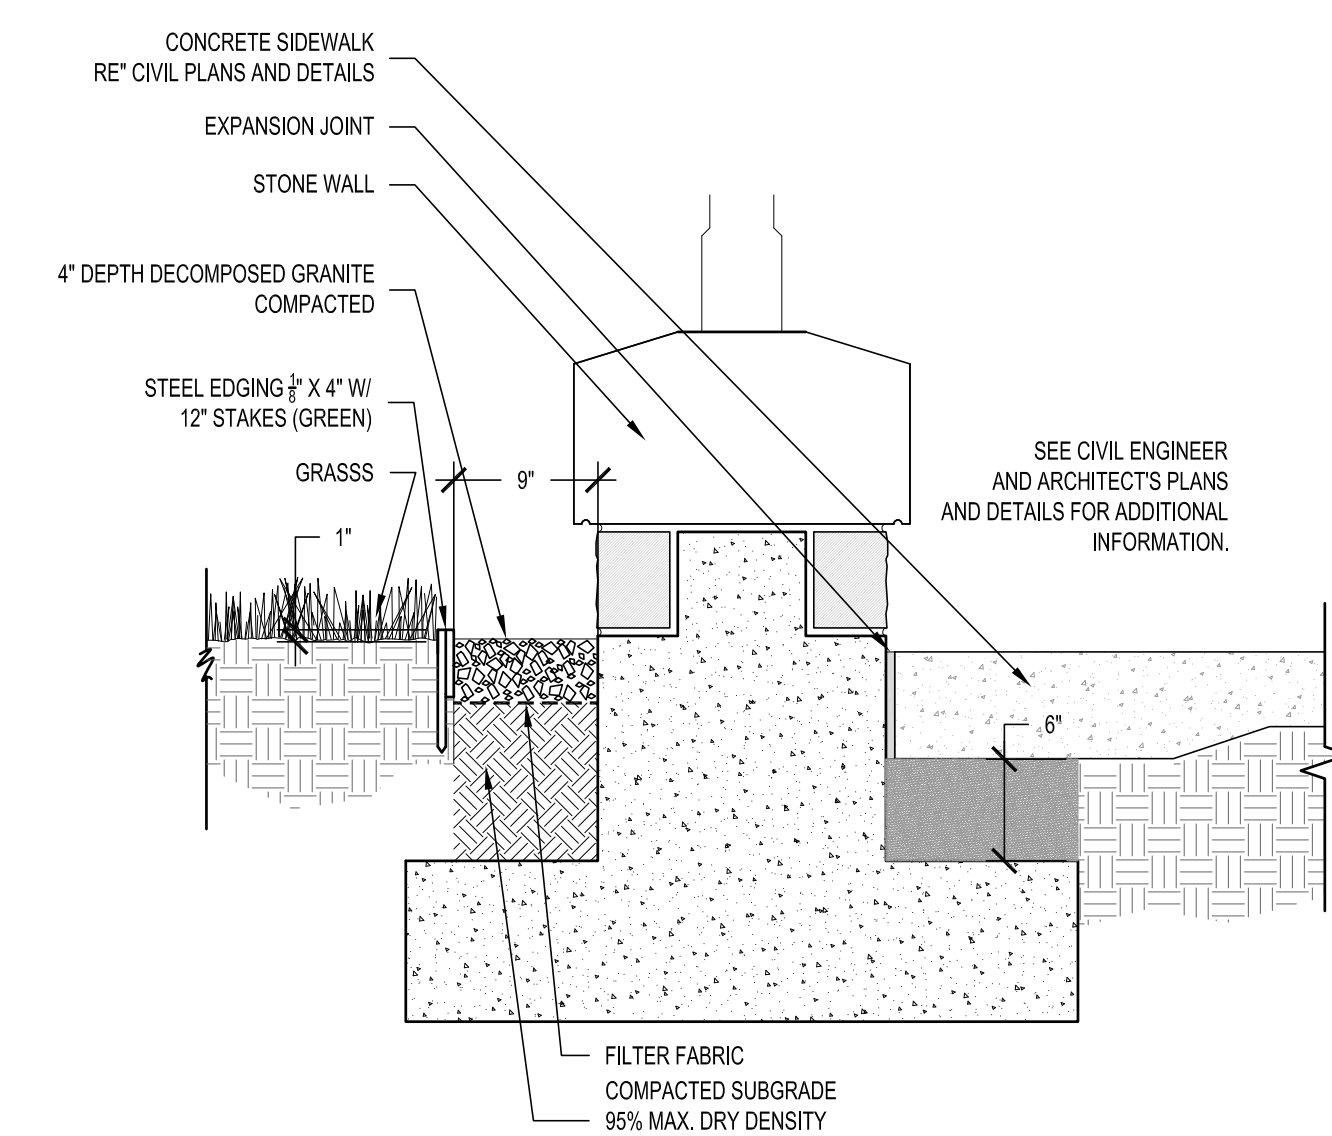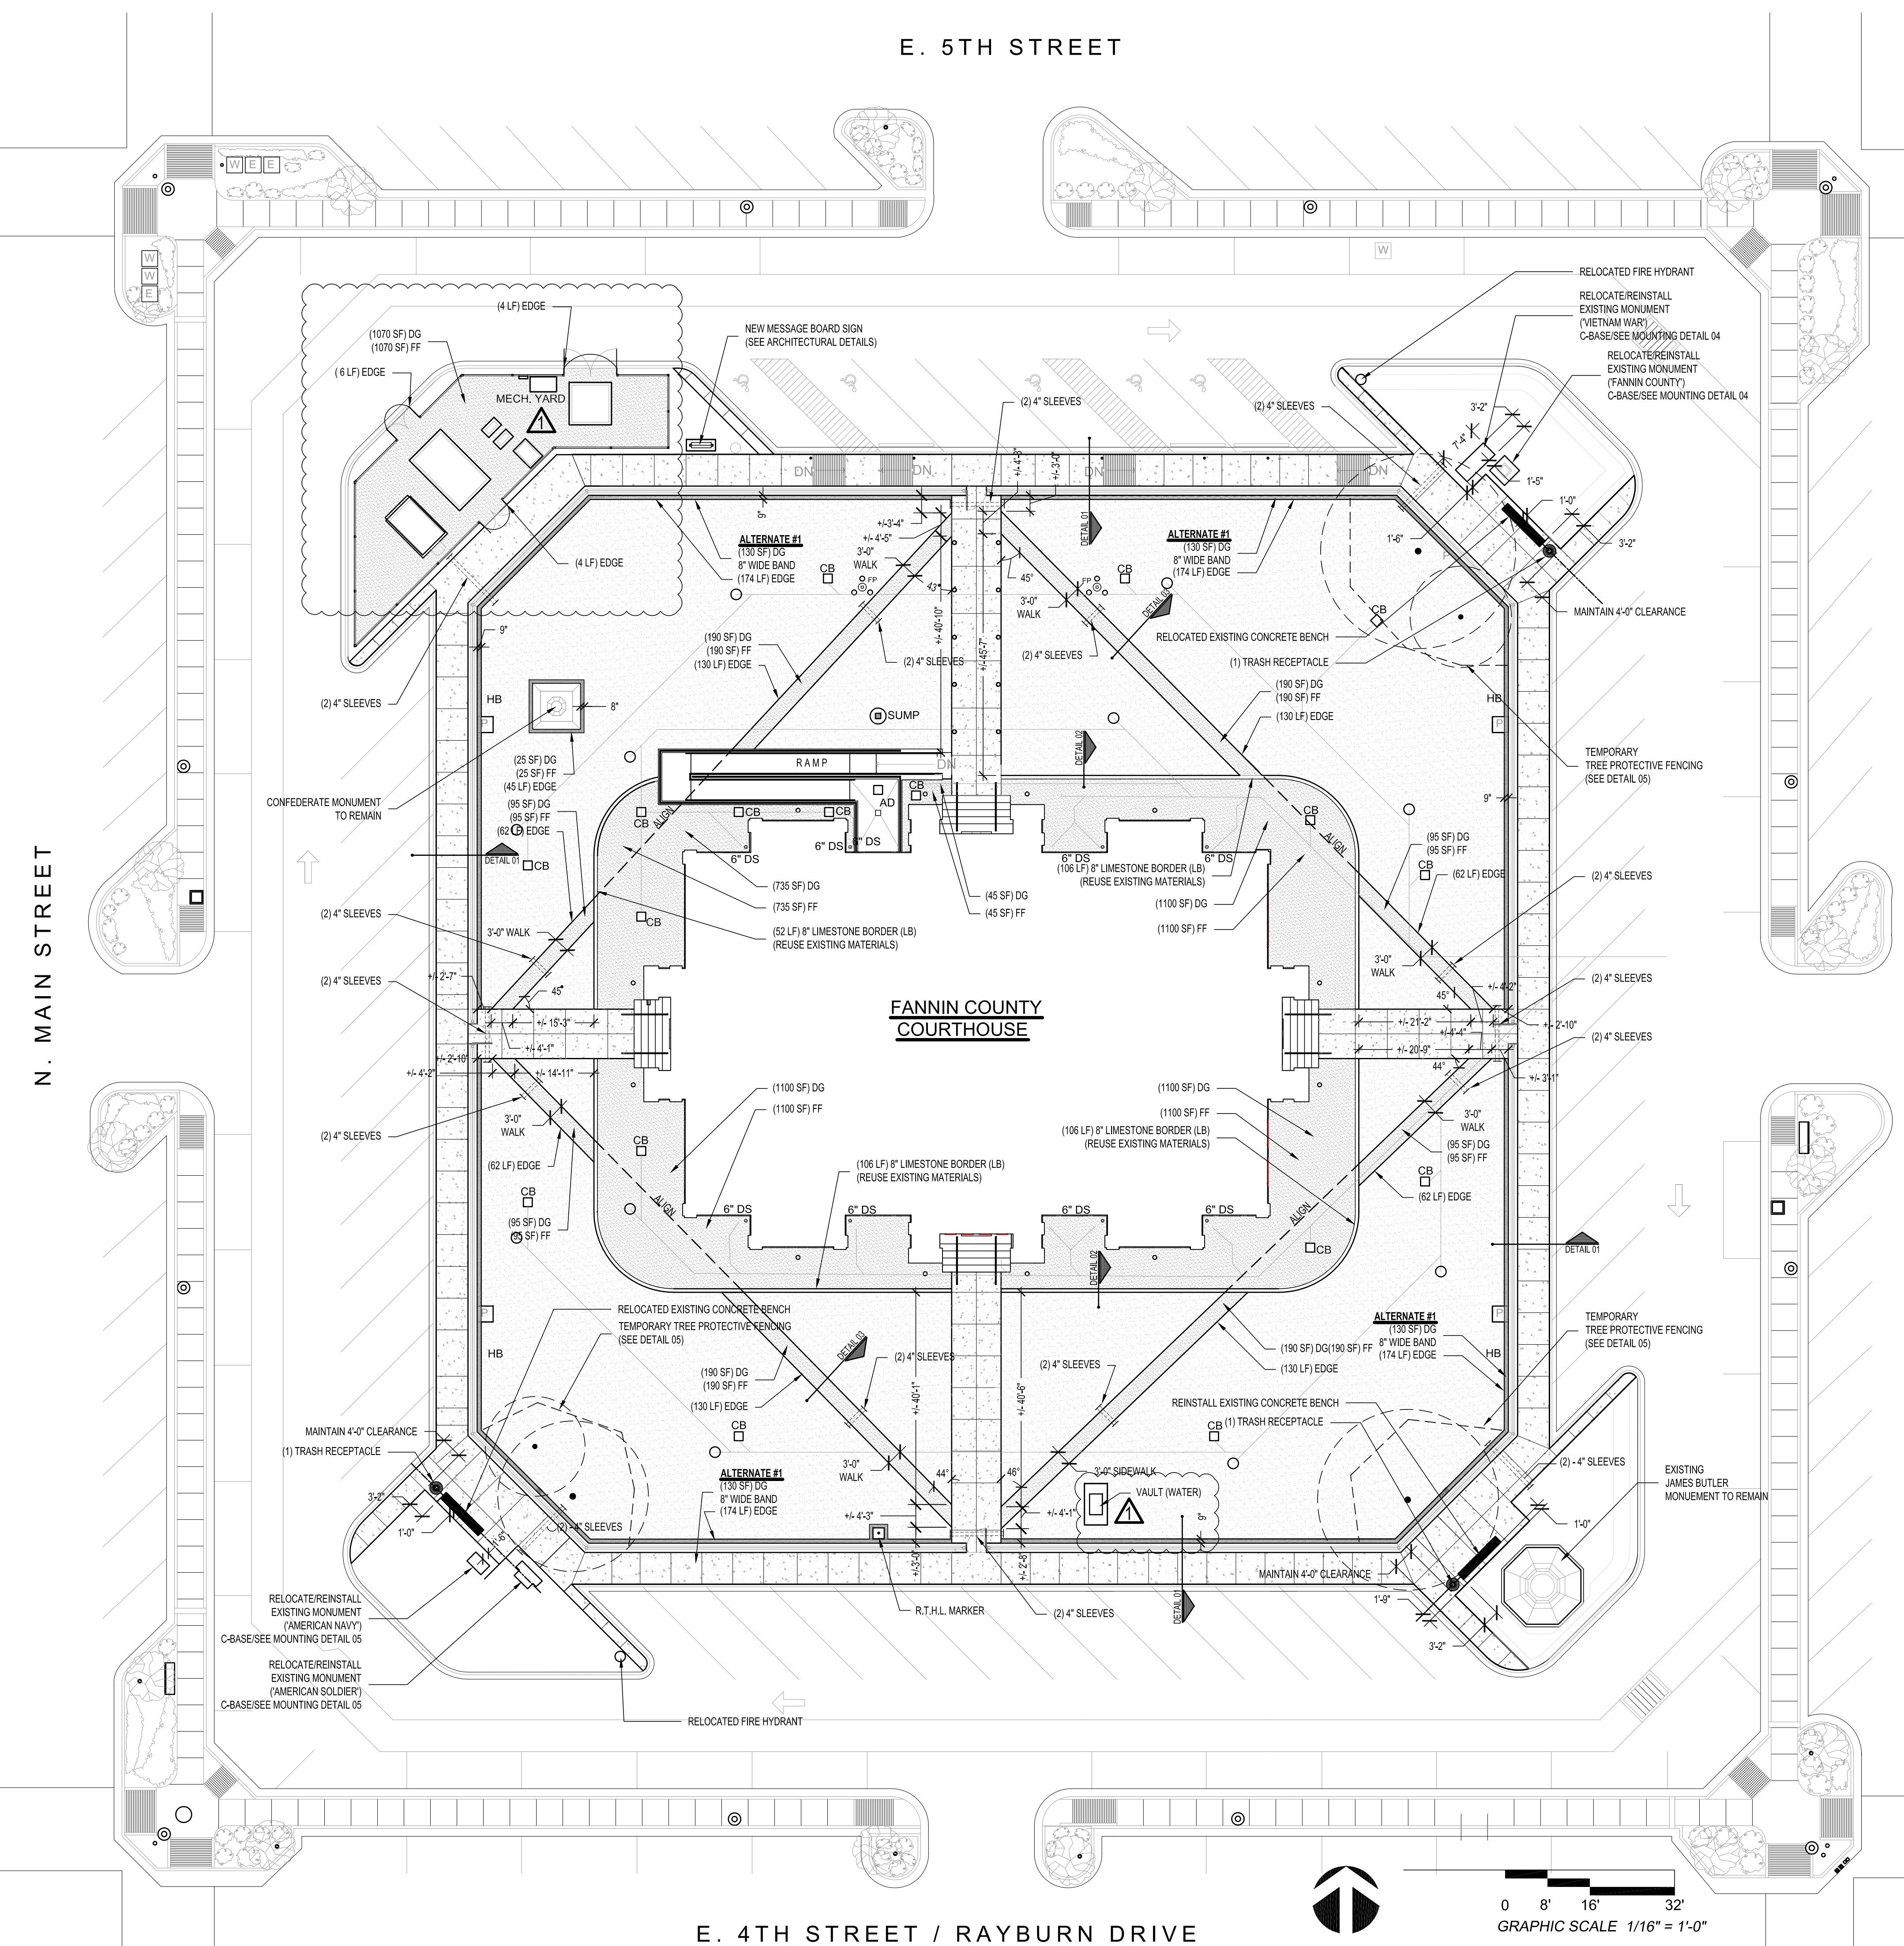


**ALTERNATE #1**  
**01 PERIMETER WALL BAND DETAIL (typ.)**  
SCALE: 1"=1'-0"

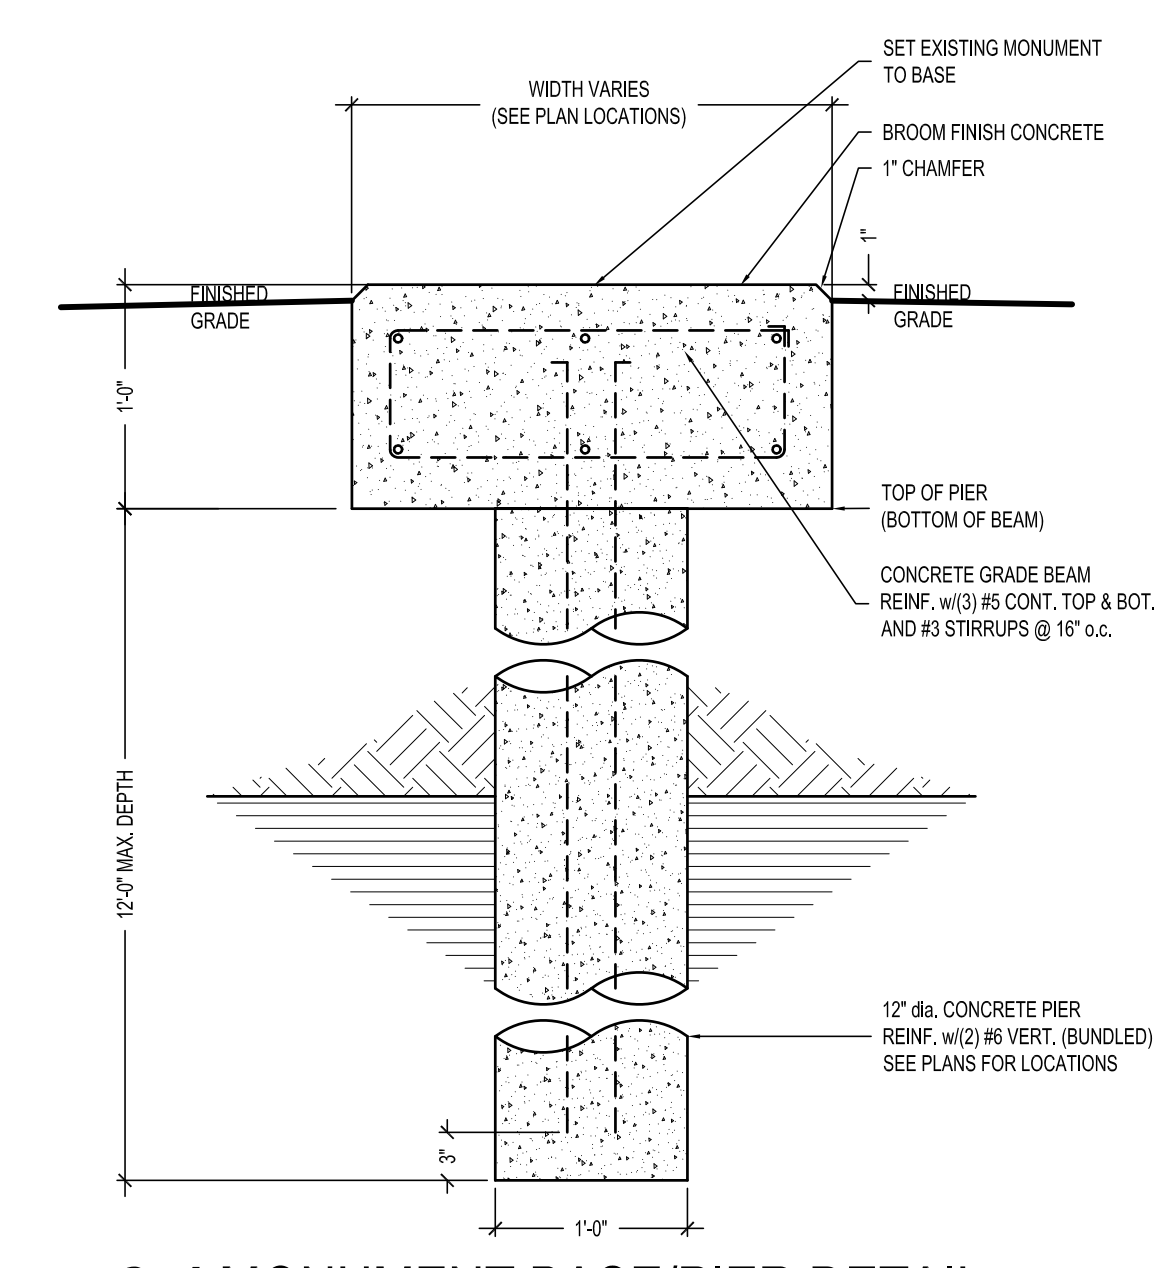


**04 MONUMENT BASE/PIER DETAIL**  
SCALE: 1"=1'-0"

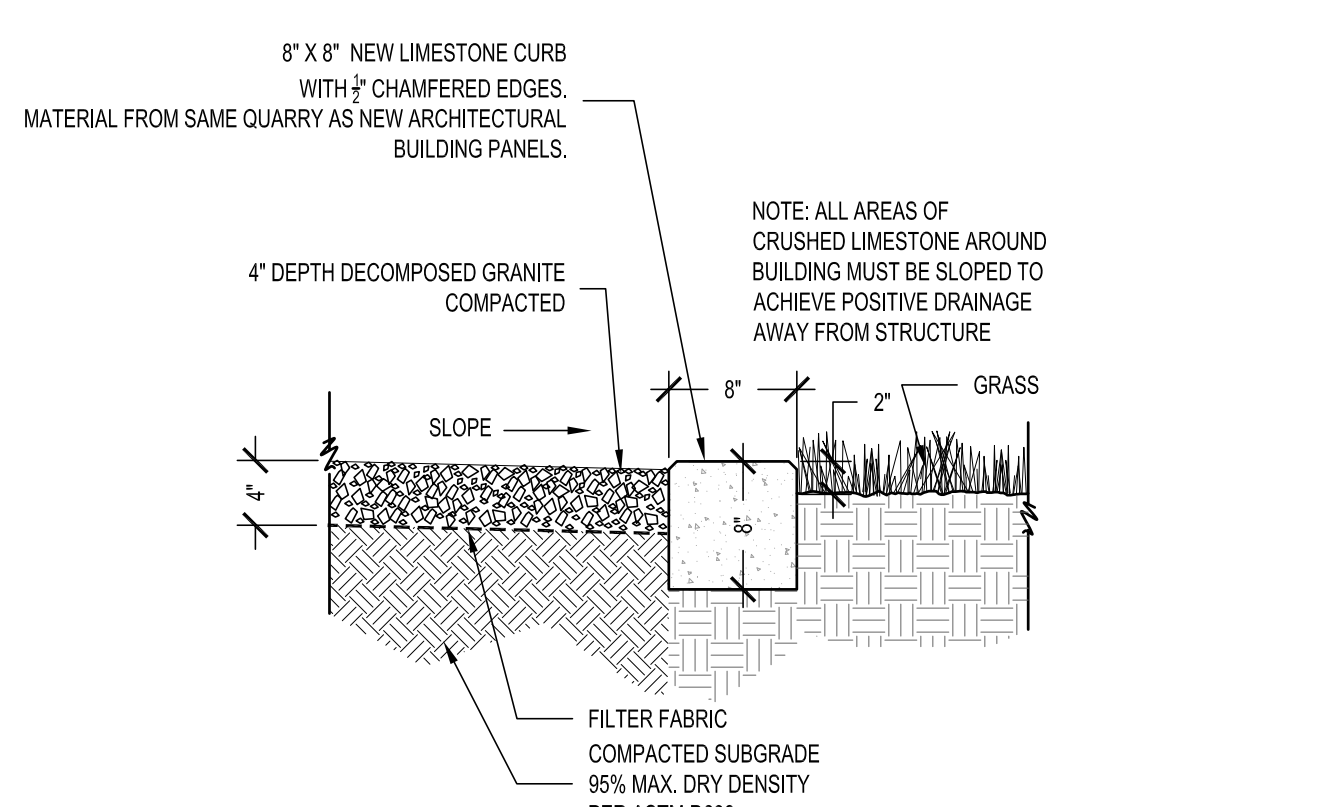

**02 LIMESTONE BASE & BORDER DETAIL (typ.)**  
SCALE: 1"=1'-0"

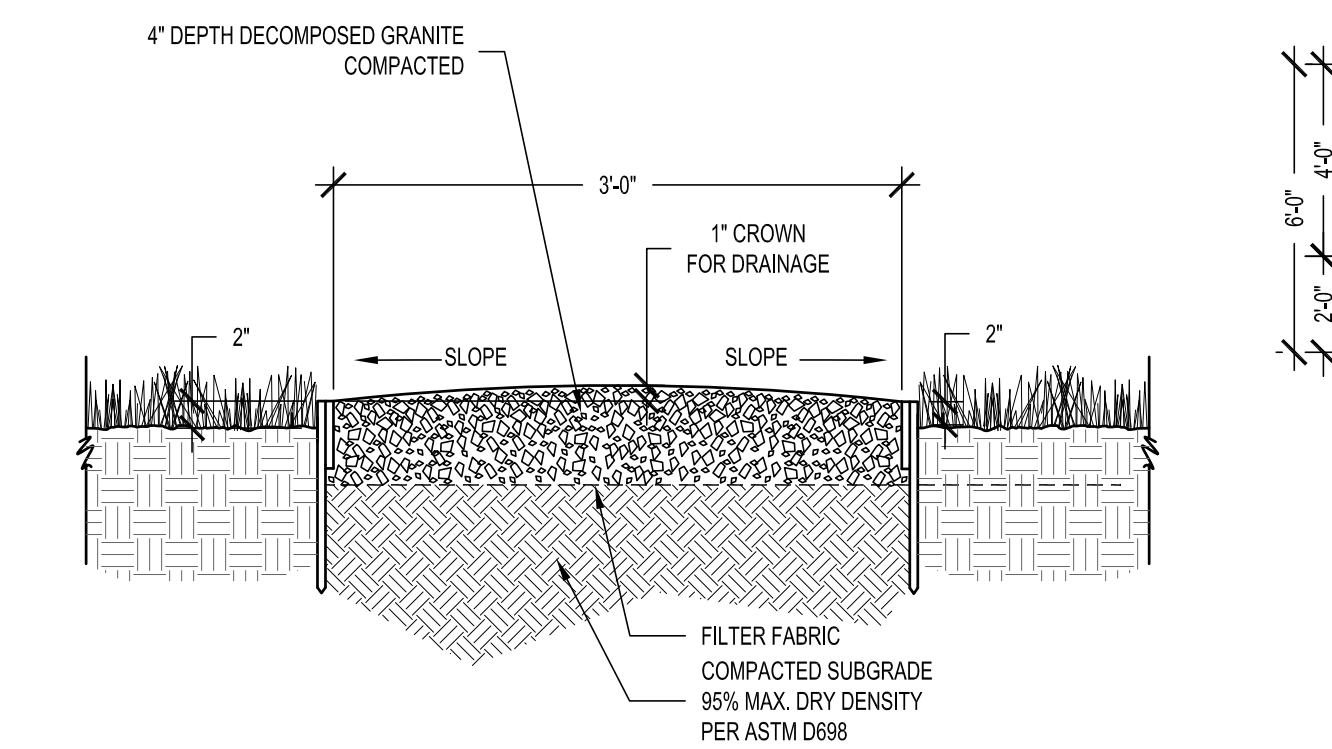

**03 CUSHED LIMESTONE WALK DETAIL (typ.)**  
SCALE: 1"=1'-0"

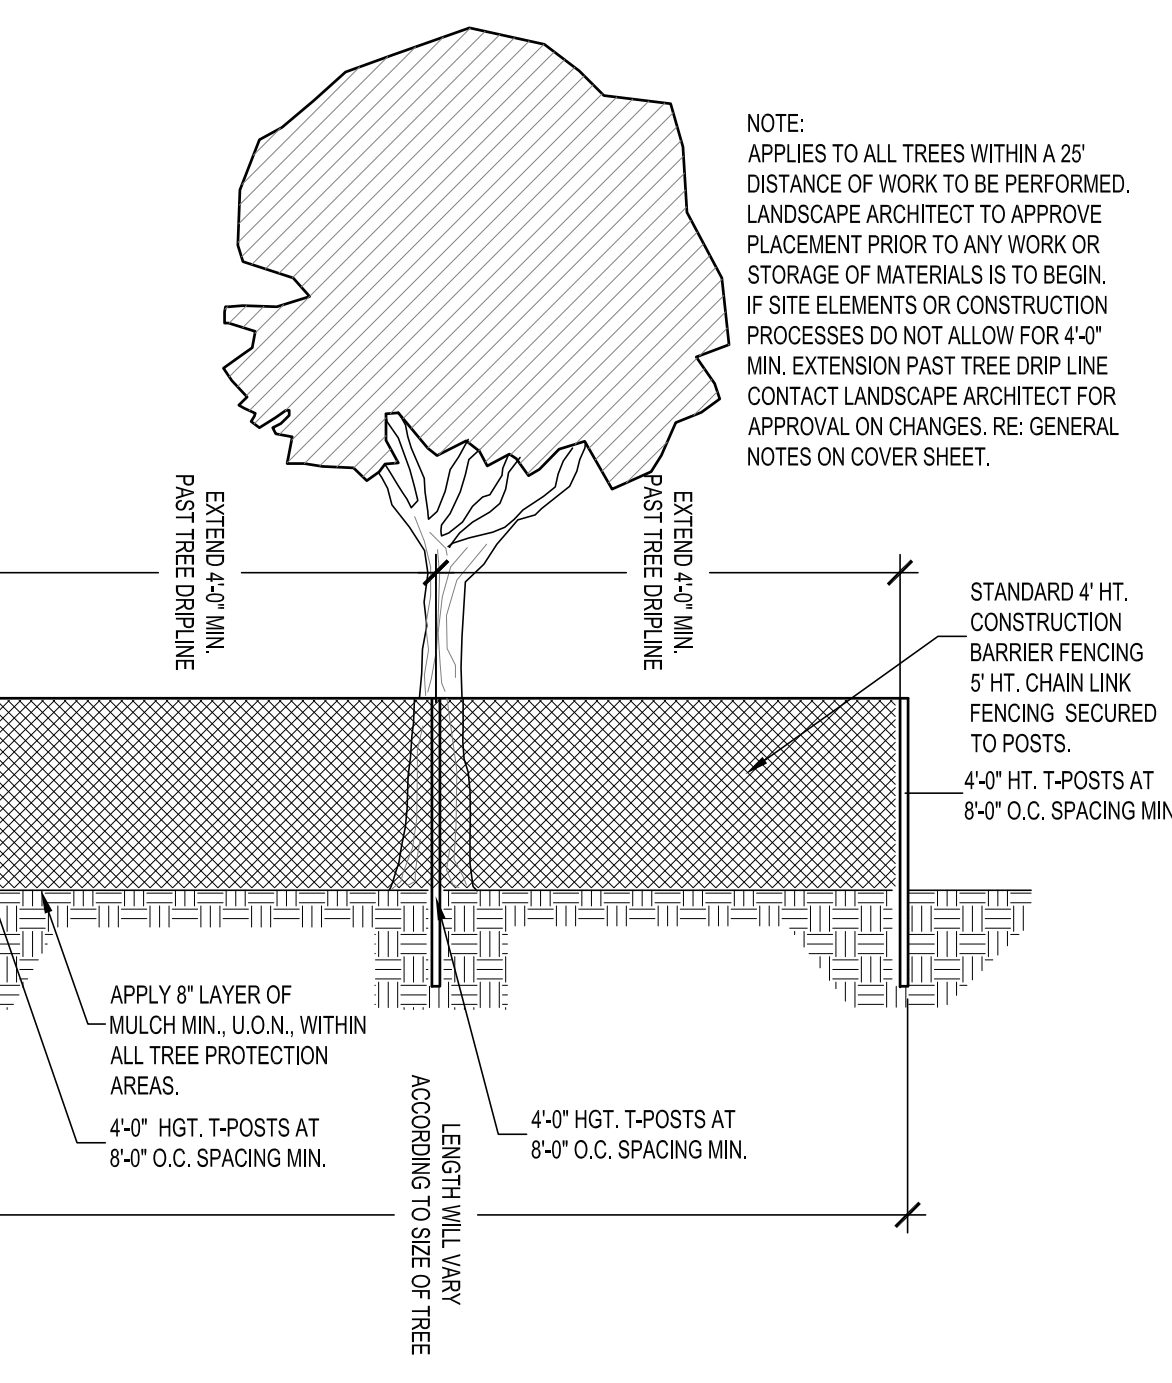

**05 TREE PROTECTION DETAIL**  
SCALE: 1/4" = 1'-0"

**MATERIALS LIST** June 2018

SYMBOL	QUANTITY	SCIENTIFIC NAME	COMMON NAME	NOTES
<b>SITE ELEMENTS (Existing)</b>				
	3	Existing Concrete Benches to be Re-Installed	(See Plan for locations)	
	1	Vietnam War Memorial Monument to be Relocated	(See Plan for location)	
	1	American Navy Monument to be Relocated	(See Plan for location)	
	1	American Soldier Monument to be Relocated	(See Plan for location)	
	1	Fannin County Monument to be Relocated	(See Plan for location)	
	1	New Message Board	(See Architectural Plans and Details)	
<b>SITE ELEMENTS (New)</b>				
	3	Trash Receptacles		Model: Victor Stanley SD-42, 36 Gal. w/Dome Top Color: Green (See Plan for locations) Includes Manufacturer's Hardware and Recommendations for Mounting to Concrete Slab
<b>SITE HARDSCAPE</b>				
	C-BASE	3	Concrete Base	Concrete Base 8" Reinforced Concrete Base Pad w/Pier (See Plan for locations) See Detail 04 this Sheet
	DG	2730 SF	Decomposed Granite	Decomposed Granite 4" Depth, Compact to 95% Density, Contractor to supply sample for approval by Landscape Architect.
	LB	370 LF	Limestone Border	Limestone Border New stone from same location as new architectural wall panels. Refer to Architectural Plans and Details.
	FF	5765 SF	Filter Fabric	Filter Fabric R040 Filter Fabric by Contractor Source Inc., Non-Woven Geotextile Fabric. Contact Phone: (713) 836-8999
	EDGE	1523 LF	Steel Edging	Steel Edging 2" x 4" Steel w/12" Stakes, Color: Green

**GENERAL NOTES**

- LAYOUT/SLEEVING NOTES**
1. All dimensions lines are perpendicular and are taken from the outside face of finished structure, edge of walk, etc., unless otherwise noted.
  2. All Sleeves to be installed for future utility access and distribution including Irrigation, Electrical, Etc. All locations on Plans are diagrammatic. Verify final sleeve locations with the Landscape Architect in the Field.
  3. All Sleeves on shown on Plan shall be comprised of a minimum of (2) 4" Schedule 40 PVC Pipes with no joinery unless there are spans greater than 8'-0" in length. All Slewing must be a minimum of 3" below the bottom surface of any concrete, stone or any structure to prevent upheaval or cracking and collapse of pipe.
  4. All Sleeve shall extend a minimum of 18" beyond the hardscape limits and should be clearly marked at each end in the field with a pipe or stake 12" above finished grade. Install (2) #3 Rebar on either side of sleeves below grade to locate sleeve ends in the future.
  5. See Architectural Plan Sheet A1.01 for additional information.

**TREE PROTECTION**


1. The Contractor must maintain the existing trees in their current condition. All measures possible must be taken to maintain the general health of the trees and minimize any negative impact to the trees. The General Contractor shall employ a certified arborist approved by the Owner to provide all tree canopy clearances for access and construction. Prior to any excavation the arborist shall provide in writing a written procedure for excavation in order to minimize the damage to existing tree roots. As excavation proceeds, the certified arborist will provide all required root pruning clearances necessary for forming the walls. The Contractor shall dig around roots carefully so as not to damage roots, allowing arborist to provide proper pruning. In no case will contractor rip, tear or pull out roots of surrounding trees. Contractor is to provide this flexibility within bid amount.

**DRAINAGE**

1. All new sod areas around building will need to be graded and sloped to achieve storm water runoff to new drainage catch basins. Refer to Civil Engineering Plans and Details.

**HARDSCAPE**

1. 8" x 8" Limestone Curb.

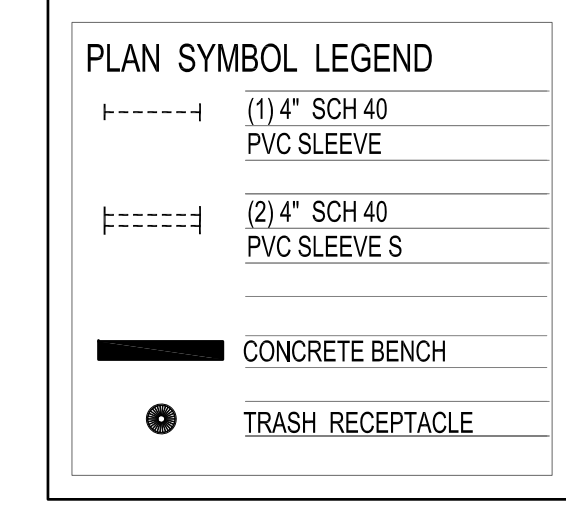


**FANNIN COUNTY COURTHOUSE**  
INTERIOR & EXTERIOR RESTORATION

101 E. Sam Rayburn Drive  
Bonham, Texas 75418

**COPYRIGHT**  
The Contractor shall verify and be responsible for all dimensions. DO NOT scale the drawing. Any errors or omissions shall be reported to Architexas without delay. The Copyrights to all designs and drawings are the property of Architexas. Reproduction or use for any purpose other than that authorized by Architexas is forbidden.

**REVISION HISTORY**  
1 Oct. 16, 2018 Addendum #1

ISSUED FOR CONSTRUCTION

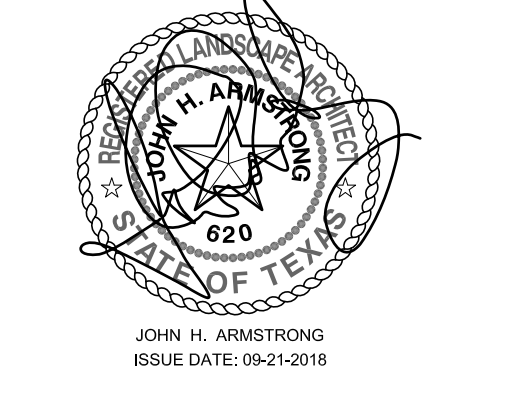



Architexas No. 1737 Date SEPT. 21, 2018

Sheet Name **Site Layout Plan and Hardscape Details**


Sheet Number

**L1.00**




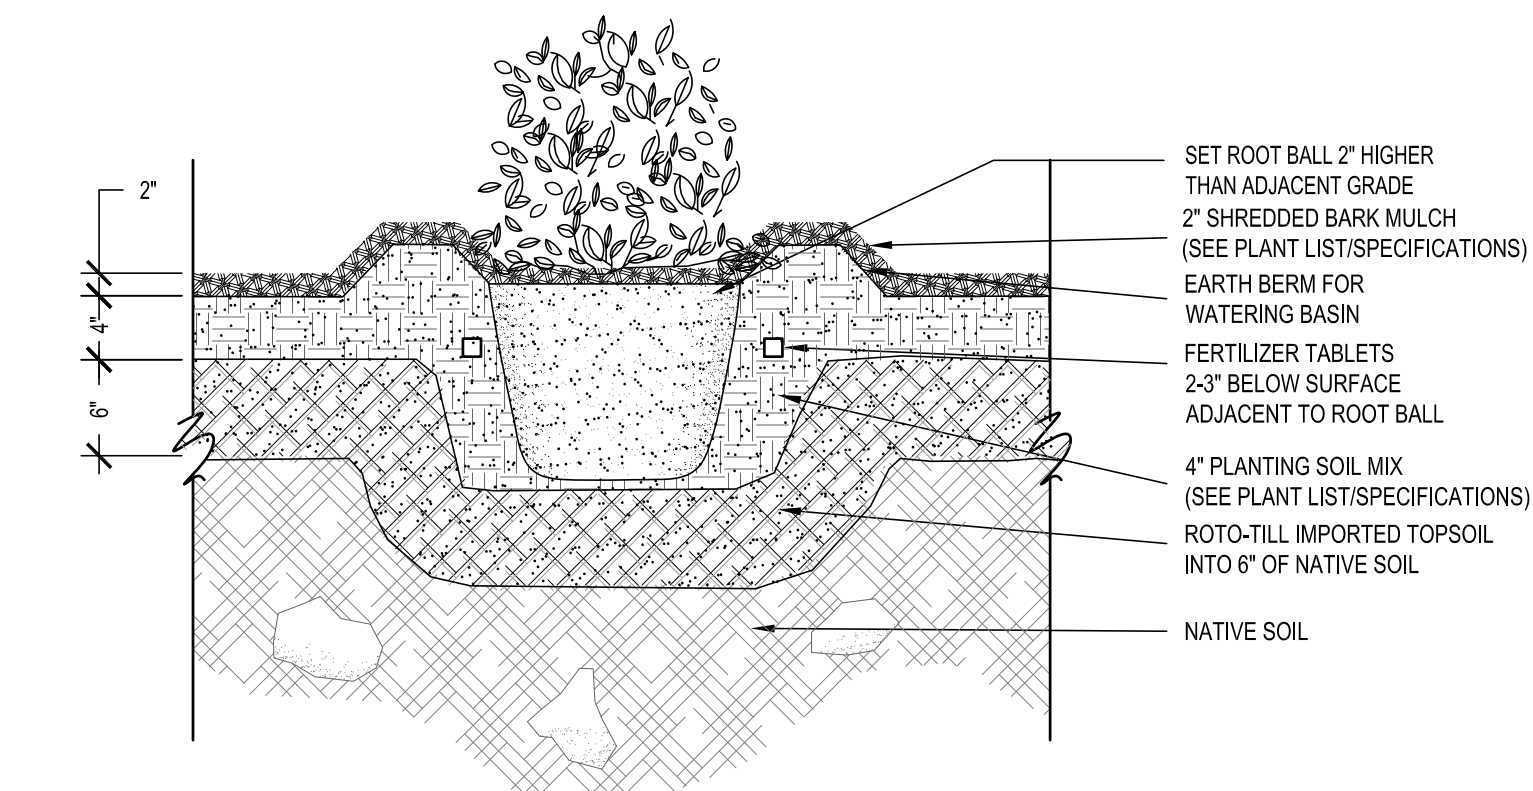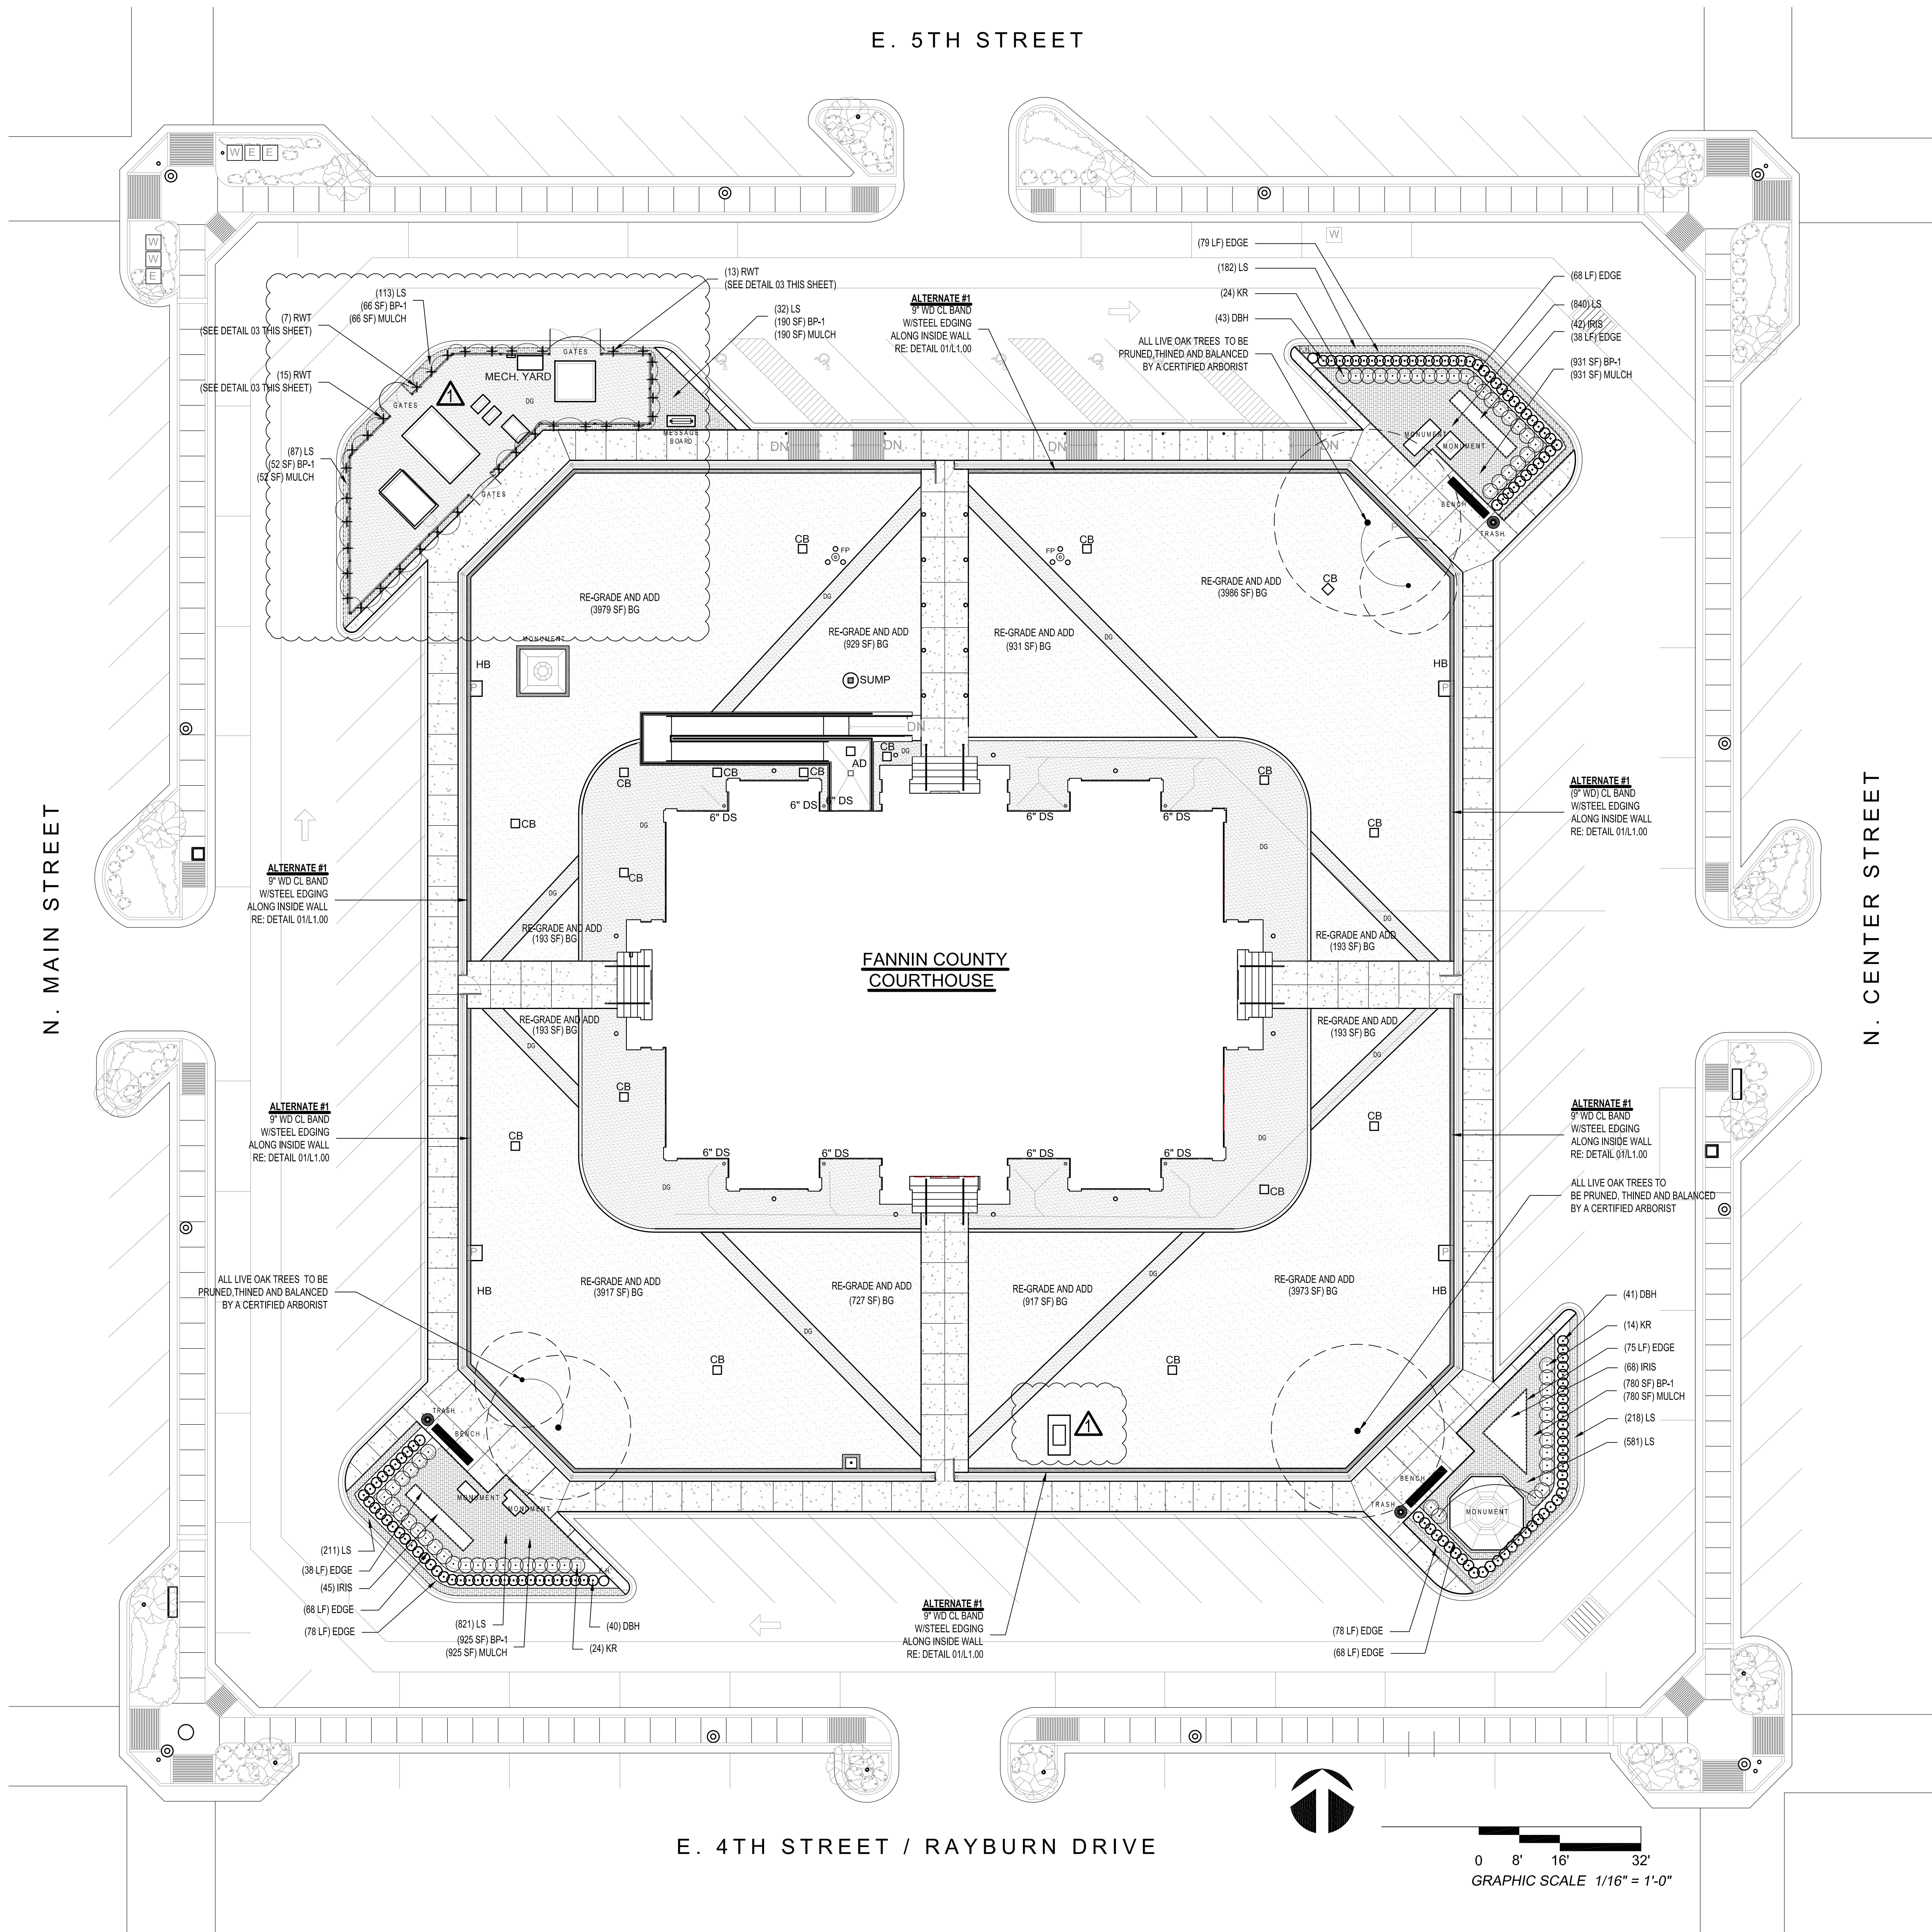

**01 SHRUB PLANTING DETAIL (typ.)**  
 SCALE: 1"=1'-0"

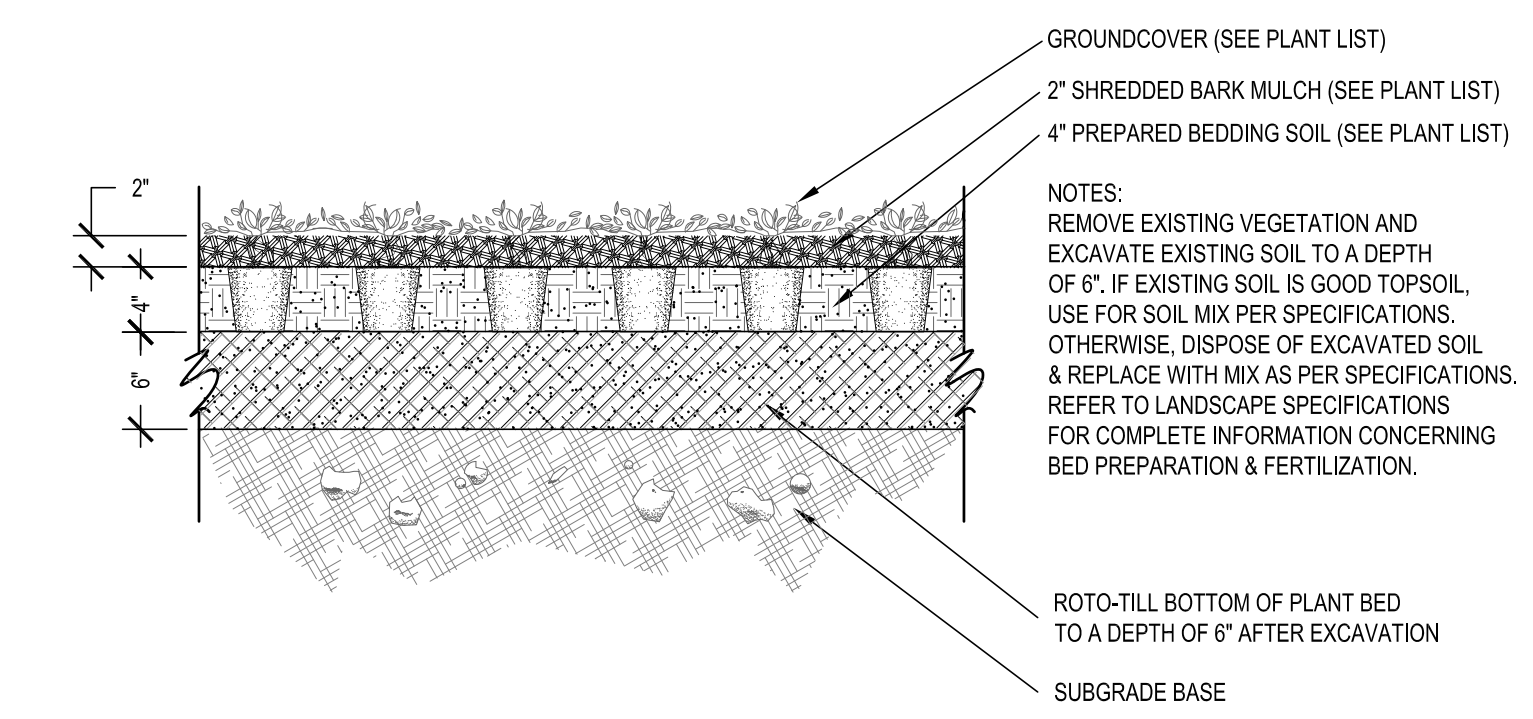

**02 GROUNDCOVER PLANTING DETAIL (typ.)**  
 SCALE: 1"=1'-0"

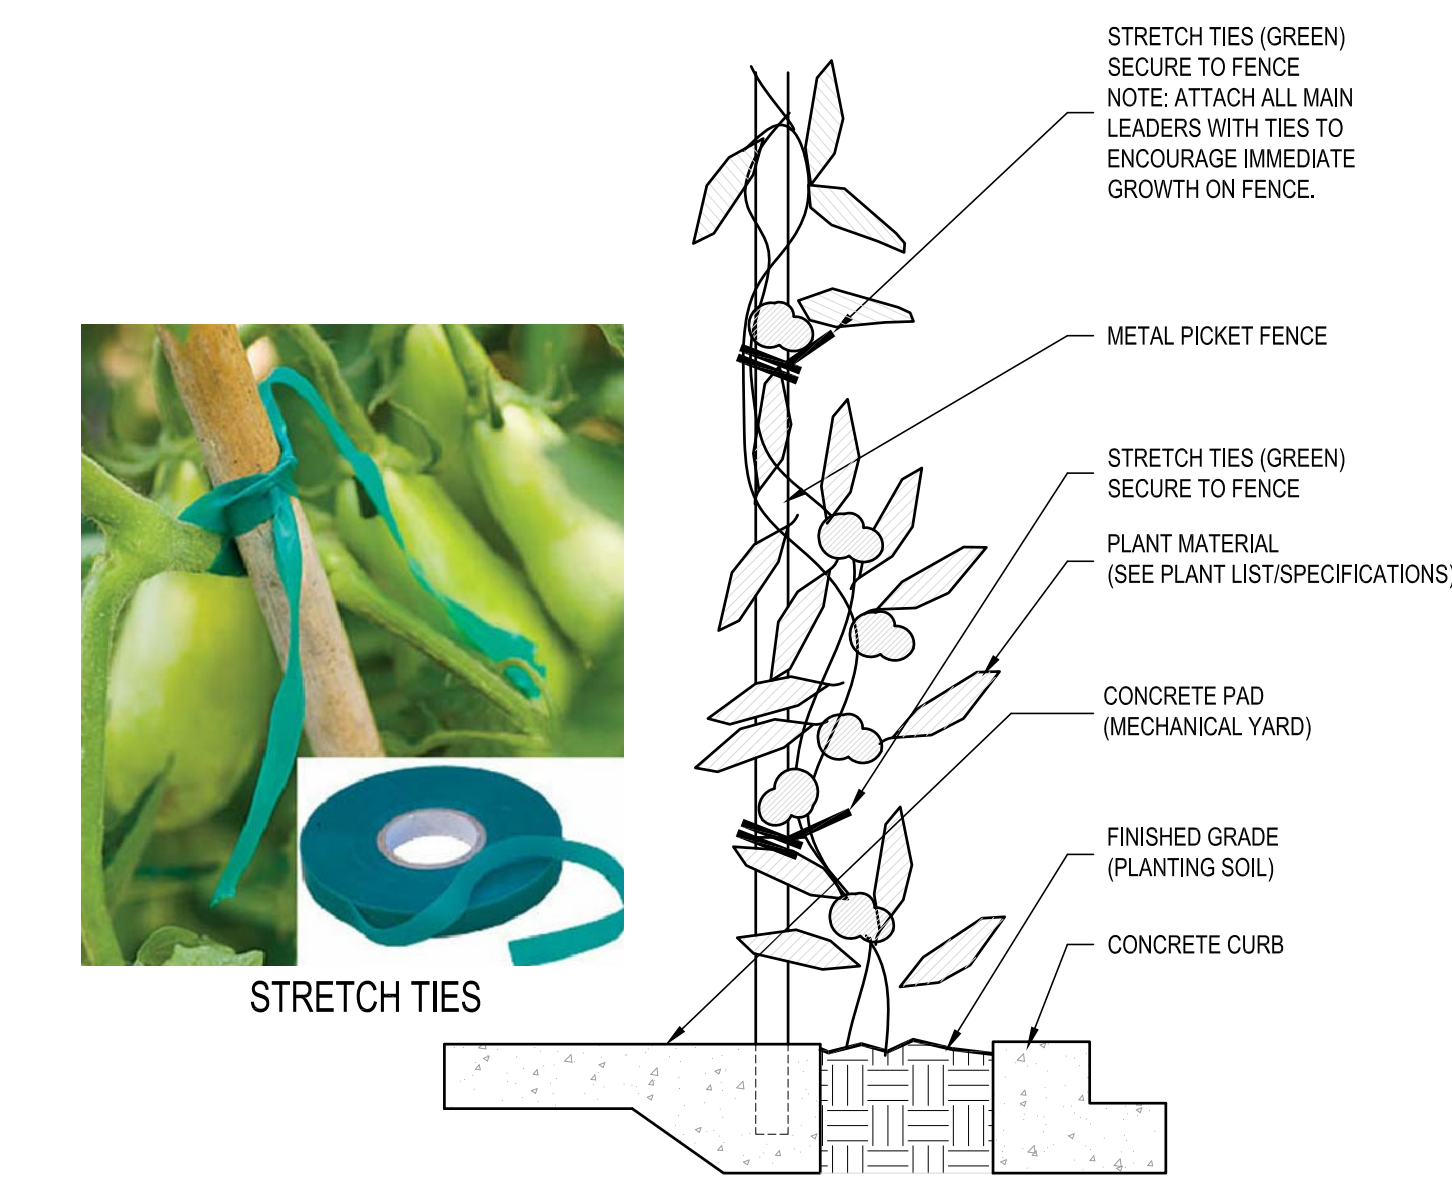

**03 ROSE WALL ATTACHMENT DETAIL (typ.)**  
 SCALE: 1"=1'-0"

PLANT LIST				August 2011
SYMBOL	QUANTITY	SCIENTIFIC NAME	COMMON NAME	NOTES
<b>SHRUBS / GROUNDCOVER / VINES / GRASS</b>				
DBH	124	Ilex cornuta 'Burfordii Nana'	Dwarf Burford Holly	5 Gal., Full, Bushy to Base
KR	62	Rosa 'Radcon'	'Knock Out Roses' (pink)	3 Gal., Full @ 24" O.C.
RWT	29	R. wichuriana thornless	Wichuriana Thornless Rose	2 Gallon Containers (Antique Rose Emporium) Ordered by mail mid Sept. to mid May, Call 1-800-441-0002 or 979-836-9051
IRIS	155	Iris spp.	Iris	1 Gal. @ 12" O.C., Mixed Colors (1.0 Multiplier)
LS	3374	Liriope spicata	Creeping Liriope	2-1/4" Pots @ 8" O.C. (2.25 Multiplier)
BG	20,111 SF	Cynodon dactylon	Bermuda Sod	Solid Sod
<b>MISCELLANEOUS MATERIALS</b>				
BP-1	60 SF	Vital Earth Bedding Soil	Bedding Soil Mix	2" Bedding Soil Mix around all existing trees Vital Earth Resources @ 1-800-245-7645
BP-2	2944 SF	Vital Earth Bedding Soil	Bedding Soil Mix	4" Bedding Soil Mix in all planting beds w/trees, shrubs, groundcover and vines. Vital Earth Resources @ 1-800-245-7645
MUL	2908 SF	Shredded Hardwood Mulch	Shredded Hardwood Mulch	1" in all Beds @ 2" around all trees. Vital Earth Resources @ 1-800-245-7645
EDGE	590 LF	Steel Edging	Steel Edging	1/2" x 4" Steel w/12" Stakes, Color: Green

**GENERAL PLANTING NOTES**

- Quantities noted in plant list represent landscape architect's estimate only. Contractor shall verify all quantities of plant material as well as miscellaneous items such as edging, bed preparations and mulch prior to bidding and provide revised quantities at time of bid.
- Contractor shall examine all areas and conditions under which work is to be performed. Notify landscape architect of any conditions detrimental to proper and timely completion of work.
- Upon completion of planting, contractor shall remove all wire, plastic and nylon rope from root balls and cut and remove burlap from top of root ball. Also, remove all tags and flags from all newly installed materials.
- Contractor shall guarantee all planting for one (1) year after final acceptance. Warranty replacements are to be made only once. Owner shall be responsible for proper maintenance of plants after final acceptance. Dead materials not in vigorous, thriving condition shall be replaced within 15 days of notification. Replace plants which have partially died, thereby damaging shape, size or symmetry. Plants shall be replaced with same kind and size as originally planted at no additional cost to owner. Contractor shall provide one (1) year guarantee on first replacement of plant only.
- All Bed Preparation shall be Vital Earth Bedding Soil Complete Mix. No substitutions. For Bed Preparation No. 1 add a 2" layer of Vital Earth Bedding Soil around all existing trees in new planting beds. For Bed Preparation No. 2 excavate as necessary to allow backfill of a 4" layer of Vital Earth Bedding Soil. Prior to backfill, fill sub grade to a 6" to 8" depth to break hardpan. Flood with water to insure good drainage. If good drainage does not exist, stop work and notify landscape architect. Finished bed shall be mounded in the center or high in the rear of bed to insure good drainage taking into account for settlement and displacement from shrubs. Till bedding soil into sub grade to create a fine, loose, friable soil suitable for planting. Do not damage roots of existing trees. Minimize preparation/filling under existing tree canopies.
- Handle all plant materials in accordance with best horticultural practices so that roots and root balls are adequately protected from mechanical injury, sun, drying winds, and any other detrimental effects. Plants shall not be bound with nylon rope or wire in a manner that would damage bark, break branches or destroy their natural shape.
- Provide a 2" layer of finely shredded hardwood mulch over all completed plantings and trees.
- All steel edging shall be 1/2" x 4", green in color with 12" stakes.
- Contractor shall add an approved fertilizer appropriate to new planting and lawn turf that is appropriate to season of year.
- All areas of landscape will be covered with an automatic sprinkler system.
- Contractor shall confirm operation and coverage of new irrigation system in all planting areas.
- Contractor shall remove all debris generated by work operations. Leave entire planting area in a raked condition free of debris, and all paved areas adjoining the planting areas in a broom clean condition ready for final acceptance.
- All Existing Site Landscaping (shrubs, ground cover, perennial color) will be removed and transported to their nearby City Parks under the direction of the City of Bonham Parks Department.
- All Crushed Limestone Material for landscape areas shown on this plan will come from material collected from the demolition work related to the Courthouse Building Restoration.




FANNIN COUNTY COURTHOUSE  
 INTERIOR & EXTERIOR RESTORATION

101 E. Sam Rayburn Drive  
 Bonham, Texas 75418

**COPYRIGHT**  
 The Contractor shall verify and be responsible for all dimensions. DO NOT scale the drawing. Any errors or omissions shall be reported to Architexas without delay. The Copyrights to all designs and drawings are the property of Architexas. Reproduction or use for any purpose other than that authorized by Architexas is forbidden.

**REVISION HISTORY**  
 1 Oct. 16, 2018 Addendum #1

ISSUED FOR CONSTRUCTION

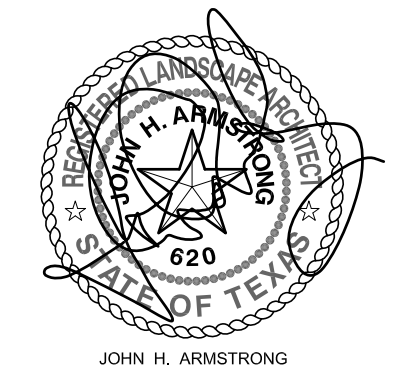

Architexas No. \_\_\_\_\_ Date \_\_\_\_\_  
 1737 SEPT. 21, 2018

Sheet Name  
**Site Planting Plan and Planting Details**


Sheet Number

**L2.00**





Landscape Architecture • Planning • Construction Management  
2011, Inc. 2012, 2013, 2014, 2015, 2016, 2017, 2018, 2019  
13447 0001 Rev  
13447 0001 Rev  
13447 0001 Rev

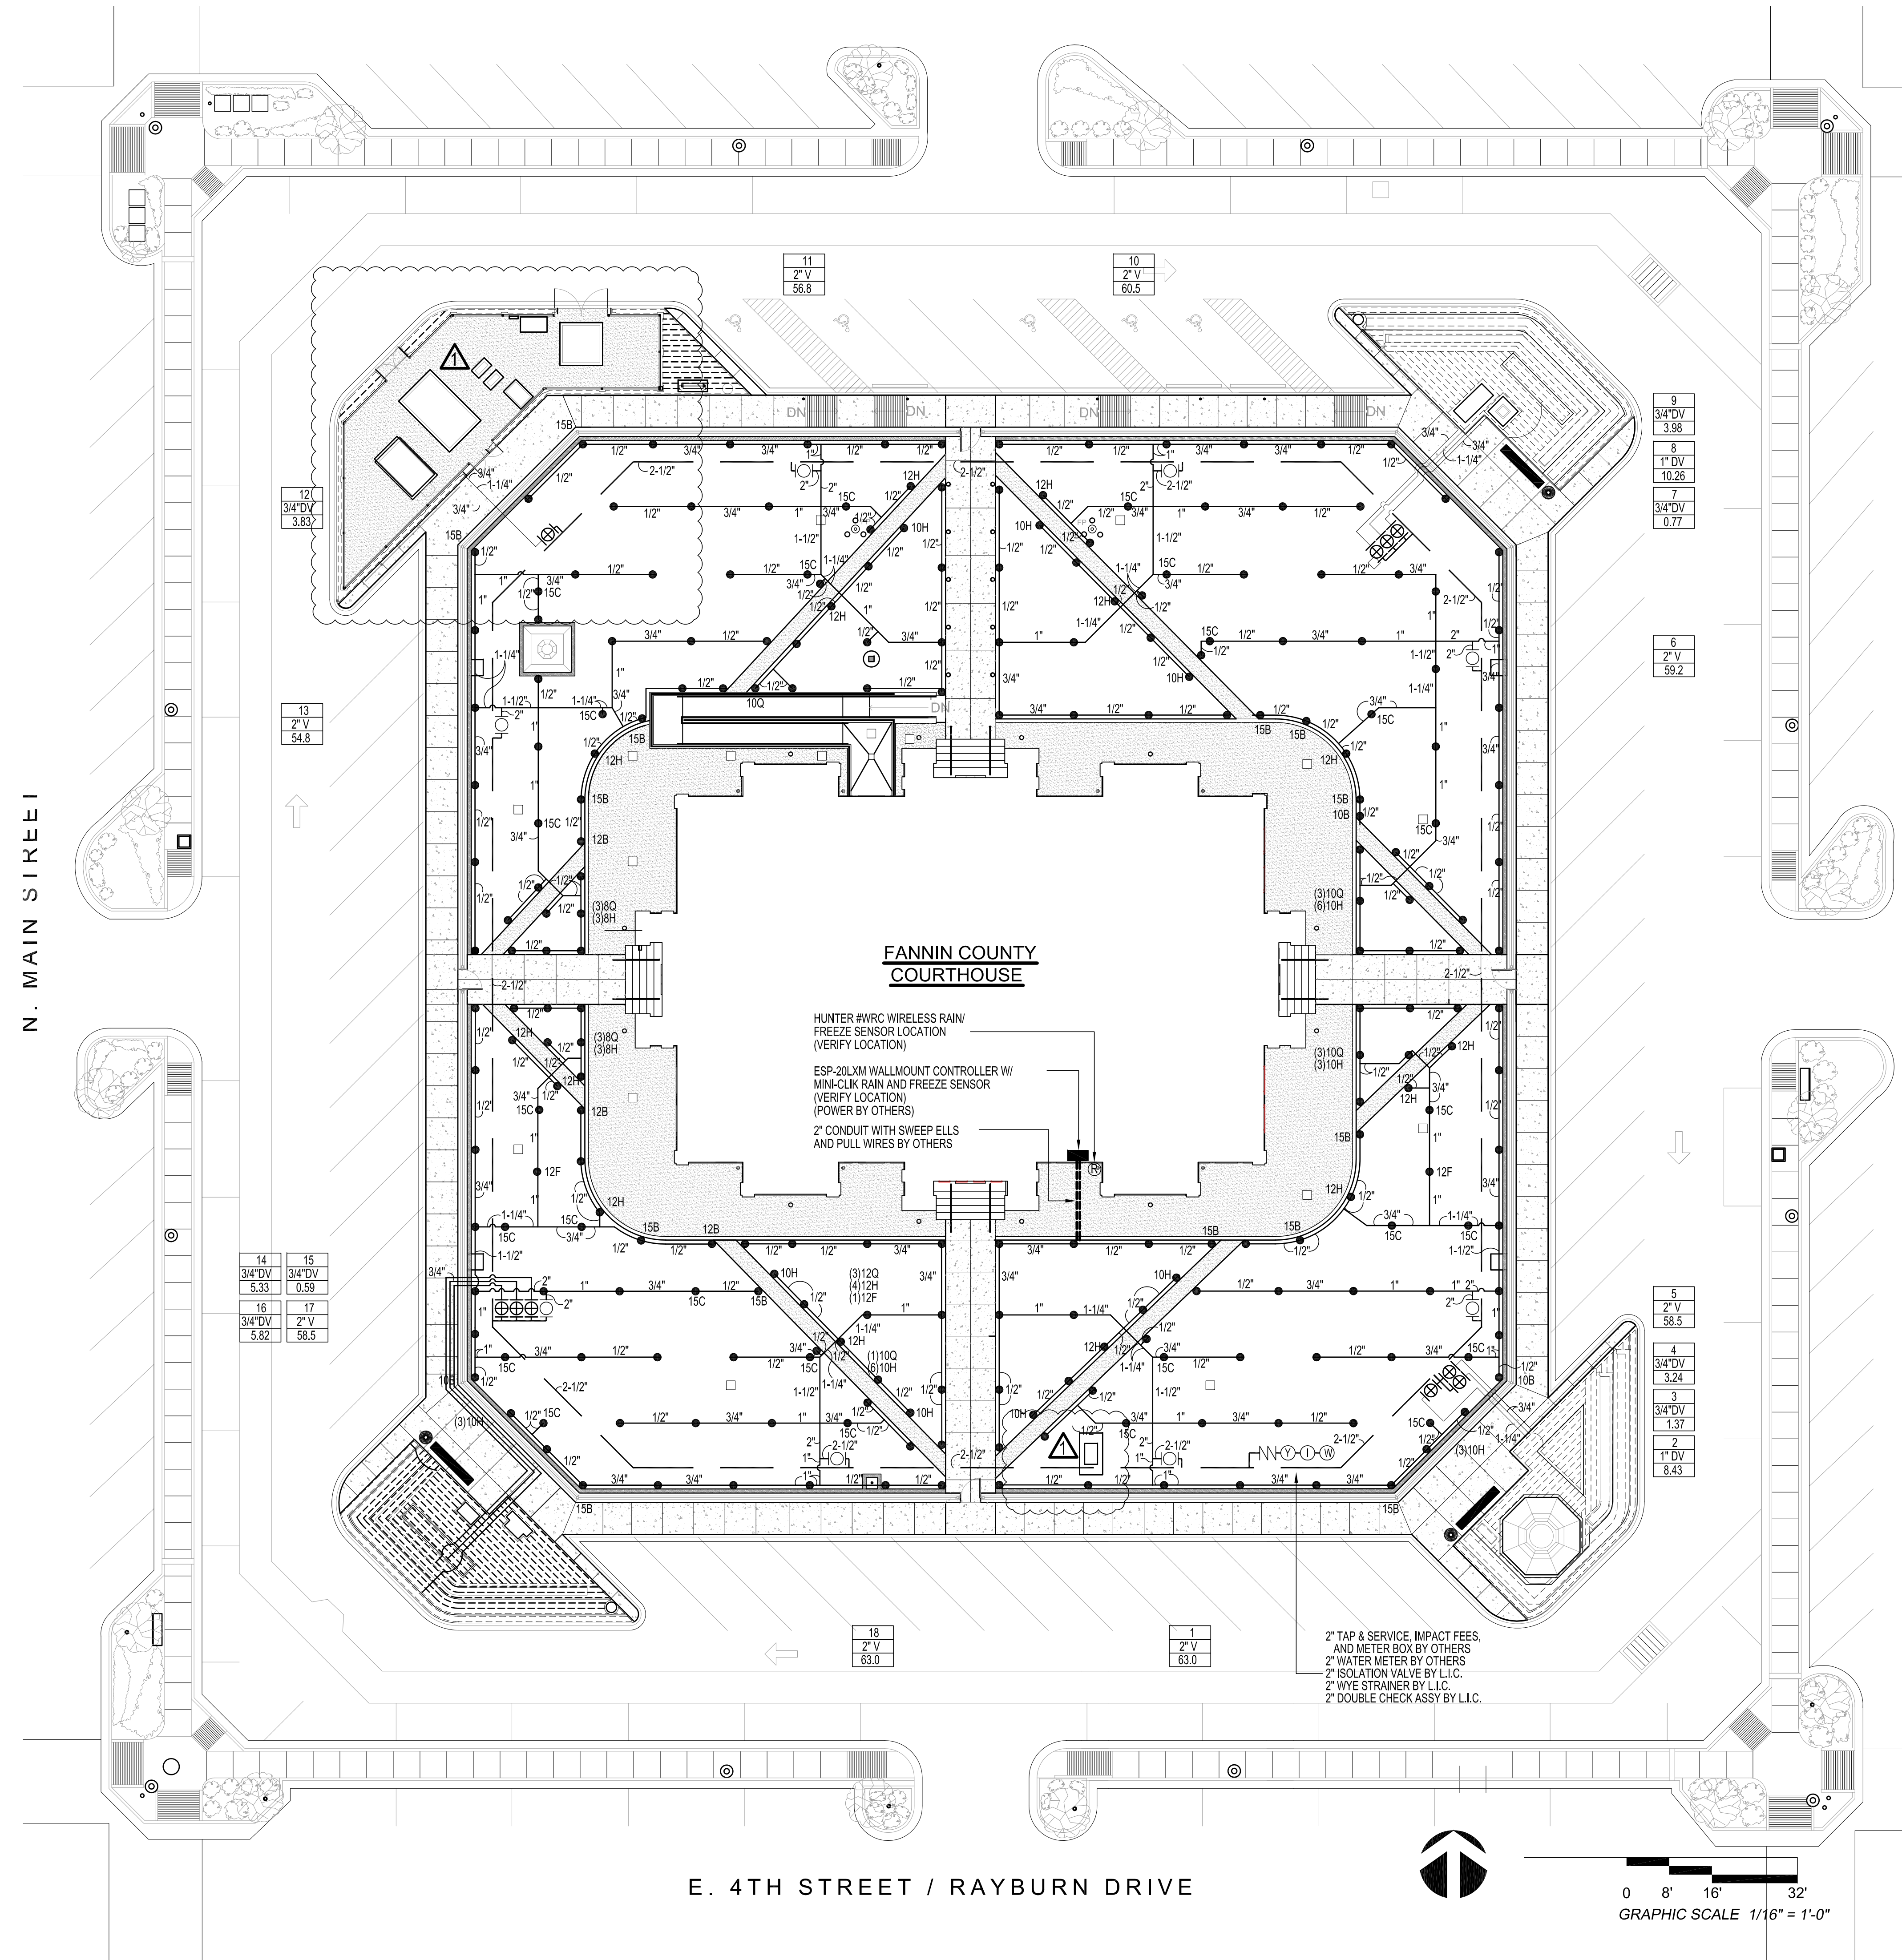

**IRRIGATION LEGEND:**

SYMBOL	DESCRIPTION	MANUFACTURER	MODEL NO.
●	LAWN SPRAY HEAD	RAINBIRD (30 PSI)	1804 WITH MPR PLASTIC NOZZLES UNLESS NOTED OTHERWISE
○	REMOTE CONTROL VALVE	RAINBIRD	PEB SERIES WITH PRS-D PRESSURE REGULATOR, REFER TO PLANS FOR SIZE
■	CONTROLLER	RAINBIRD	ESP-LXM SERIES W/ WIRELESS RAIN/FREEZE SENSOR
—	MAINLINE PIPING	REFER TO SPEC.	CLASS 200 PVC
—	LATERAL PIPING	REFER TO SPEC.	3/4" & LARGER - CLASS 200 PVC 1/2" - CLASS 315 PVC
⊕	REMOTE CONTROL DRIP VALVE	RAINBIRD	XCZ-PRF-BF SERIES, REFER TO PLAN FOR SIZE
⊞	PLANTING BED TECHLINE TUBING	RAINBIRD	XR-09-12 WITH COMPRESSION FITTINGS AND TDS-050 TUBING STAKES
⊙	WATER METER	REFER TO SPEC.	PER LOCAL BUILDING CODE
⊖	ISOLATION VALVE	NIBCO	#T-113 SERIES, REFER TO PLAN FOR SIZE
⊙	WYE STRAINER	FEBCO	#650 SERIES, REFER TO PLAN FOR SIZE
⊖	BACKFLOW PREVENTER	FEBCO	#850BV SERIES, REFER TO PLAN FOR SIZE
□	STATION NUMBER		VALVE SIZE GPM (APPROX.)

**FLOW CHART**

**SPRAY HEADS:**

NOZZLE	RADIUS	GPM
15F	15'	4.1
15E	15'	3.1
15C	15'	2.7
15H	15'	2.0
15B	15'	1.4
15Q	15'	1.0
12F	12'	2.9
12E	12'	2.2
12C	12'	1.9
12H	12'	1.4
12B	12'	1.0
12Q	12'	.7
10F	10'	1.7
10H	10'	.9
10B	10'	.6
10Q	10'	.4
8F	8'	1.7
8H	8'	.9
8B	8'	.6
8Q	8'	.4

**PIPE SIZE CHART**

FLOW/GPM:	PIPE SIZE:
0 - 4.0	1/2"
4.1 - 9.5	3/4"
9.6 - 14.5	1"
14.6 - 27.0	1-1/4"
27.1 - 35.0	1-1/2"
35.1 - 55.0	2"
55.1 - 70.0	2-1/2"

**RADIUS LEGEND:**

F = 360 °
E = 270 °
D = 240 °
C = 225 °
H = 180 °
B = 135 °
A = 120 °
Q = 90 °

**NOTE:**

1. THE IRRIGATION SUB-CONTRACTOR WILL REVIEW THE IRRIGATION HEAD LAYOUT OF THIS PLAN TO DETERMINE THE POSSIBILITY OF PLACING SPRINKLERS 20'-0" FROM FACE OF THE BUILDING AND STILL ACHIEVE COMPLETE COVERAGE. CONTRACTOR ALSO TO LOOK AT POSSIBILITY OF REDUCING TOTAL NUMBER OF HEADS AND DO THE SAME.




**FANNIN COUNTY COURTHOUSE**  
INTERIOR & EXTERIOR RESTORATION

101 E. Sam Rayburn Drive  
Bonham, Texas 75418

**COPYRIGHT**  
The Contractor shall verify and be responsible for all dimensions. DO NOT scale the drawing. Any errors or omissions shall be reported to Architexas without delay. The Copyrights to all designs and drawings are the property of Architexas. Reproduction or use for any purpose other than that authorized by Architexas is forbidden.

**REVISION HISTORY**  
1 Oct. 16, 2018 Addendum #1



ISSUED FOR CONSTRUCTION

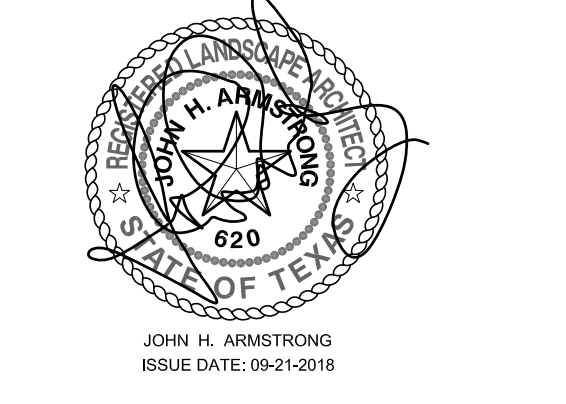

Architexas No. 1737 Date SEPT. 21, 2018  
Sheet Name **Site Irrigation Plan**

Sheet Number **L3.00**



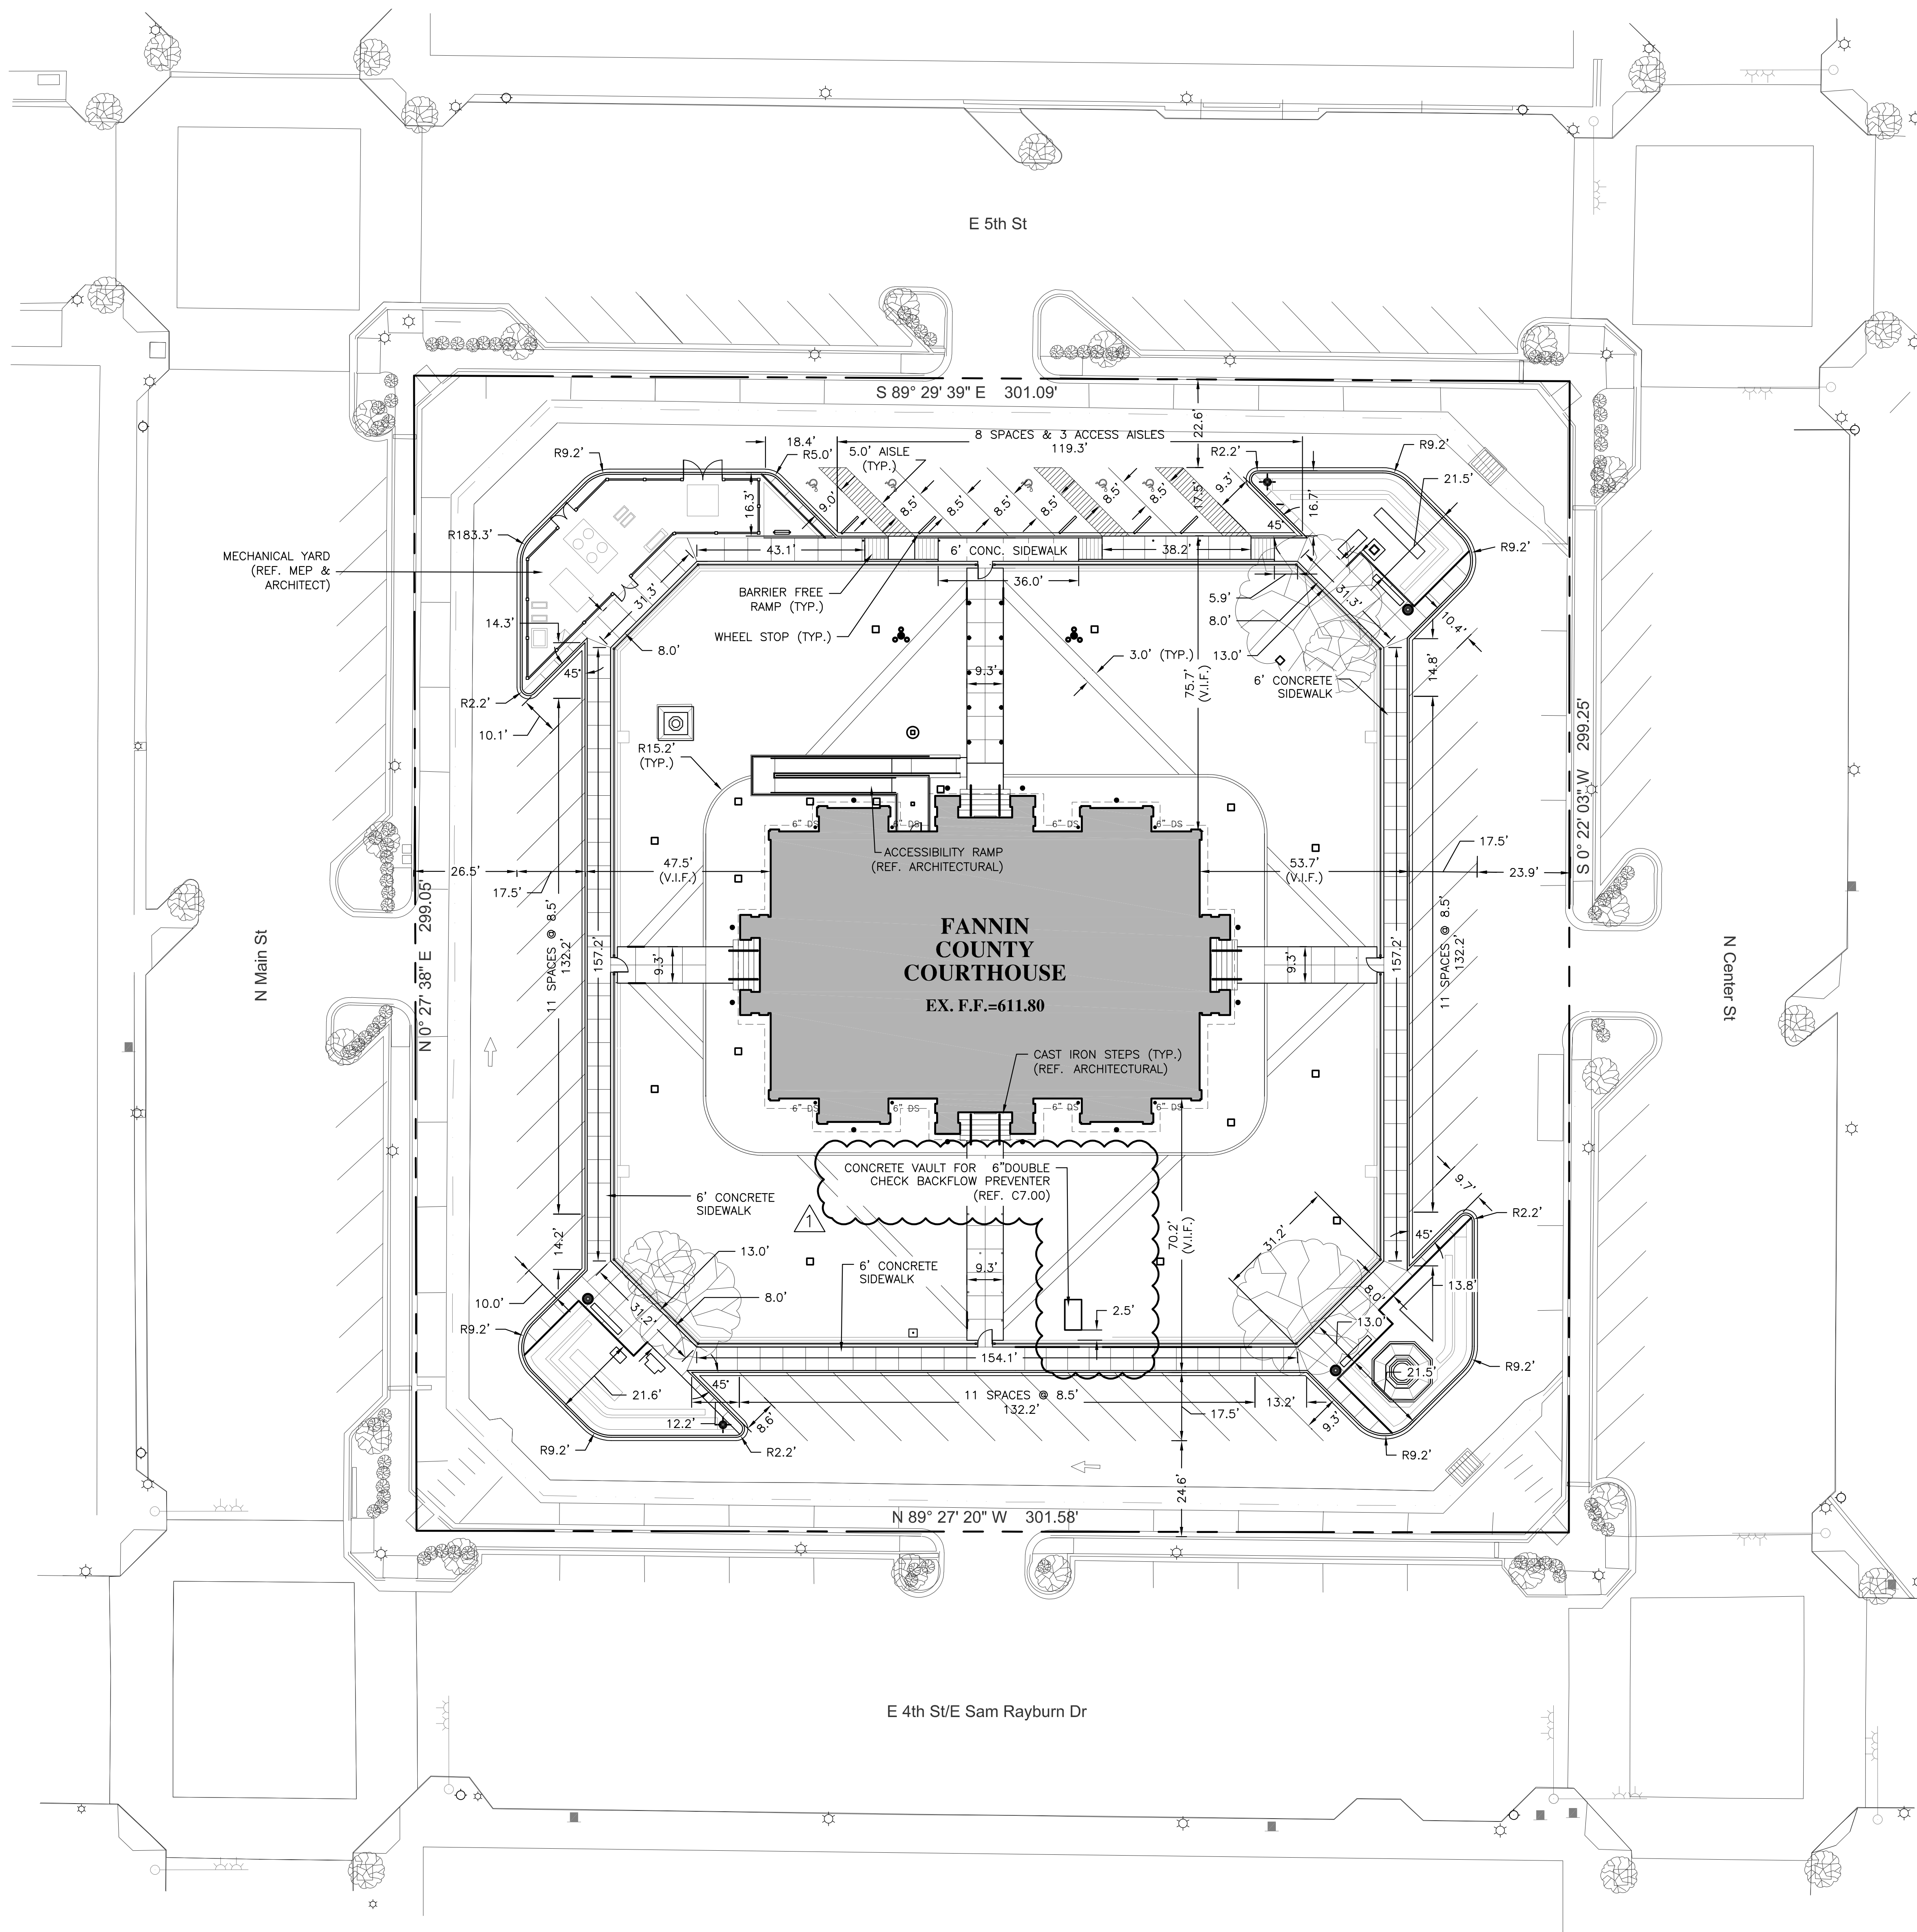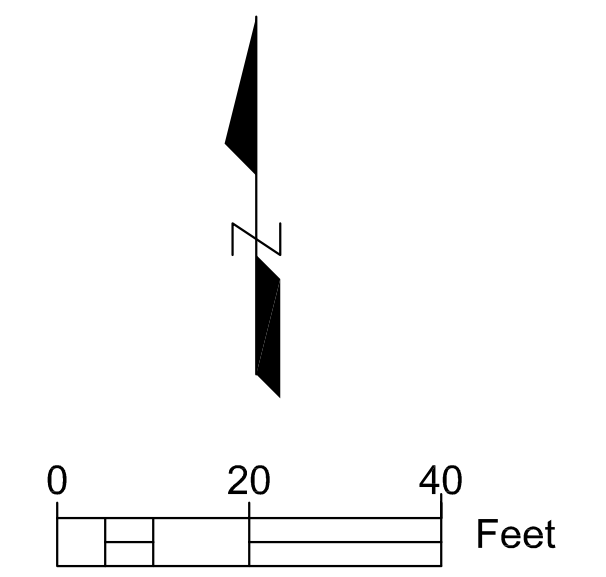

### Dimension Control Notes

1. PROPERTY LINE, PUBLIC RIGHT OF WAYS, EASEMENTS, EXISTING TOPOGRAPHIC SURVEY AND LOCATION OF PHYSICAL FEATURES WERE OBTAINED FROM A BOUNDARY/TOPOGRAPHIC SURVEY PERFORMED BY KSA ENGINEERS, INC. DATED APRIL 2007
2. ALL WORK, UNLESS NOTES, SHALL CONFORM TO THE CITY OF BONHAM STANDARD CONSTRUCTION SPECIFICATIONS.
3. THE HORIZONTAL AND VERTICAL LOCATION OF EXISTING SUBSURFACE UTILITIES HAVE BEEN DETERMINED FROM DATA RECORDED BY OTHERS. IT WILL BE THE RESPONSIBILITY OF THE CONTRACTOR TO PROTECT ALL EXISTING UTILITIES WITHIN THE AREA OF CONSTRUCTION. CONTRACTOR SHALL VERIFY SIZE AND LOCATION OF ALL UTILITIES PRIOR TO CONSTRUCTION.
4. ALL DIMENSIONS ARE FROM FACE OF CURB UNLESS OTHERWISE NOTED.
5. ALL DIMENSIONS ARE TO FACE OF BUILDING. REFER TO ARCHITECTURAL PLANS FOR BUILDING DIMENSIONS. VERIFY DIMENSIONS IN FIELD.
6. REFER TO ARCHITECTURAL PLANS FOR ALL RAMP AND STAIR DETAILS.
7. PROPERTY LINE NOT INCLUDED IN EXISTING SURVEY. THE PROPERTY LINE AS SHOWN WAS DRAWN IN BASED ON A PDF DOCUMENT CREATED & PROVIDED BY KSA ENGINEERING ON 23 OCT. 2017. THE BEARINGS & DISTANCES PROVIDED HAVE NOT BEEN VERIFIED. NO BENCH MARKS PROVIDED.



TEXAS HISTORICAL COMMISSION  
real places telling real stories



FANNIN COUNTY  
COURTHOUSE  
INTERIOR & EXTERIOR RESTORATION


101 E. Sam Rayburn Drive  
Bonham, Texas 75418

**COPYRIGHT**  
The Contractor shall verify and be responsible for all dimensions. DO NOT scale the drawing. Any errors or omissions shall be reported to Architexas without delay. The Copyrights to all designs and drawings are the property of Architexas. Reproduction or use for any purpose other than that authorized by Architexas is forbidden.

**REVISION HISTORY**

NO.	DESCRIPTION	DATE
ADDENDUM 1		October 16, 2018

ISSUED FOR CONSTRUCTION

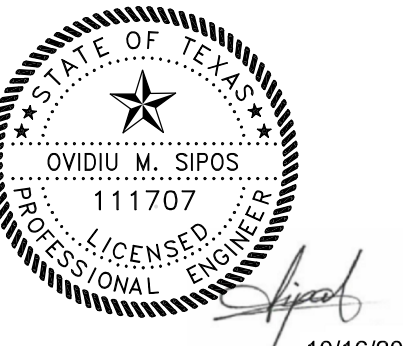

10/16/2018

**JQ ENGINEERING, LLP**  
200 S. GARY STREET  
P.O. BOX 1008  
DALLAS, TEXAS 75201  
TEL: 214.752.8008  
WWW.JQENGINEERING.COM  
TEXAS REGISTERED ENGINEER # 1234



Architexas No. 1737 Date September 21, 2018

Sheet Name DIMENSION CONTROL PLAN

Sheet Number

C3.00



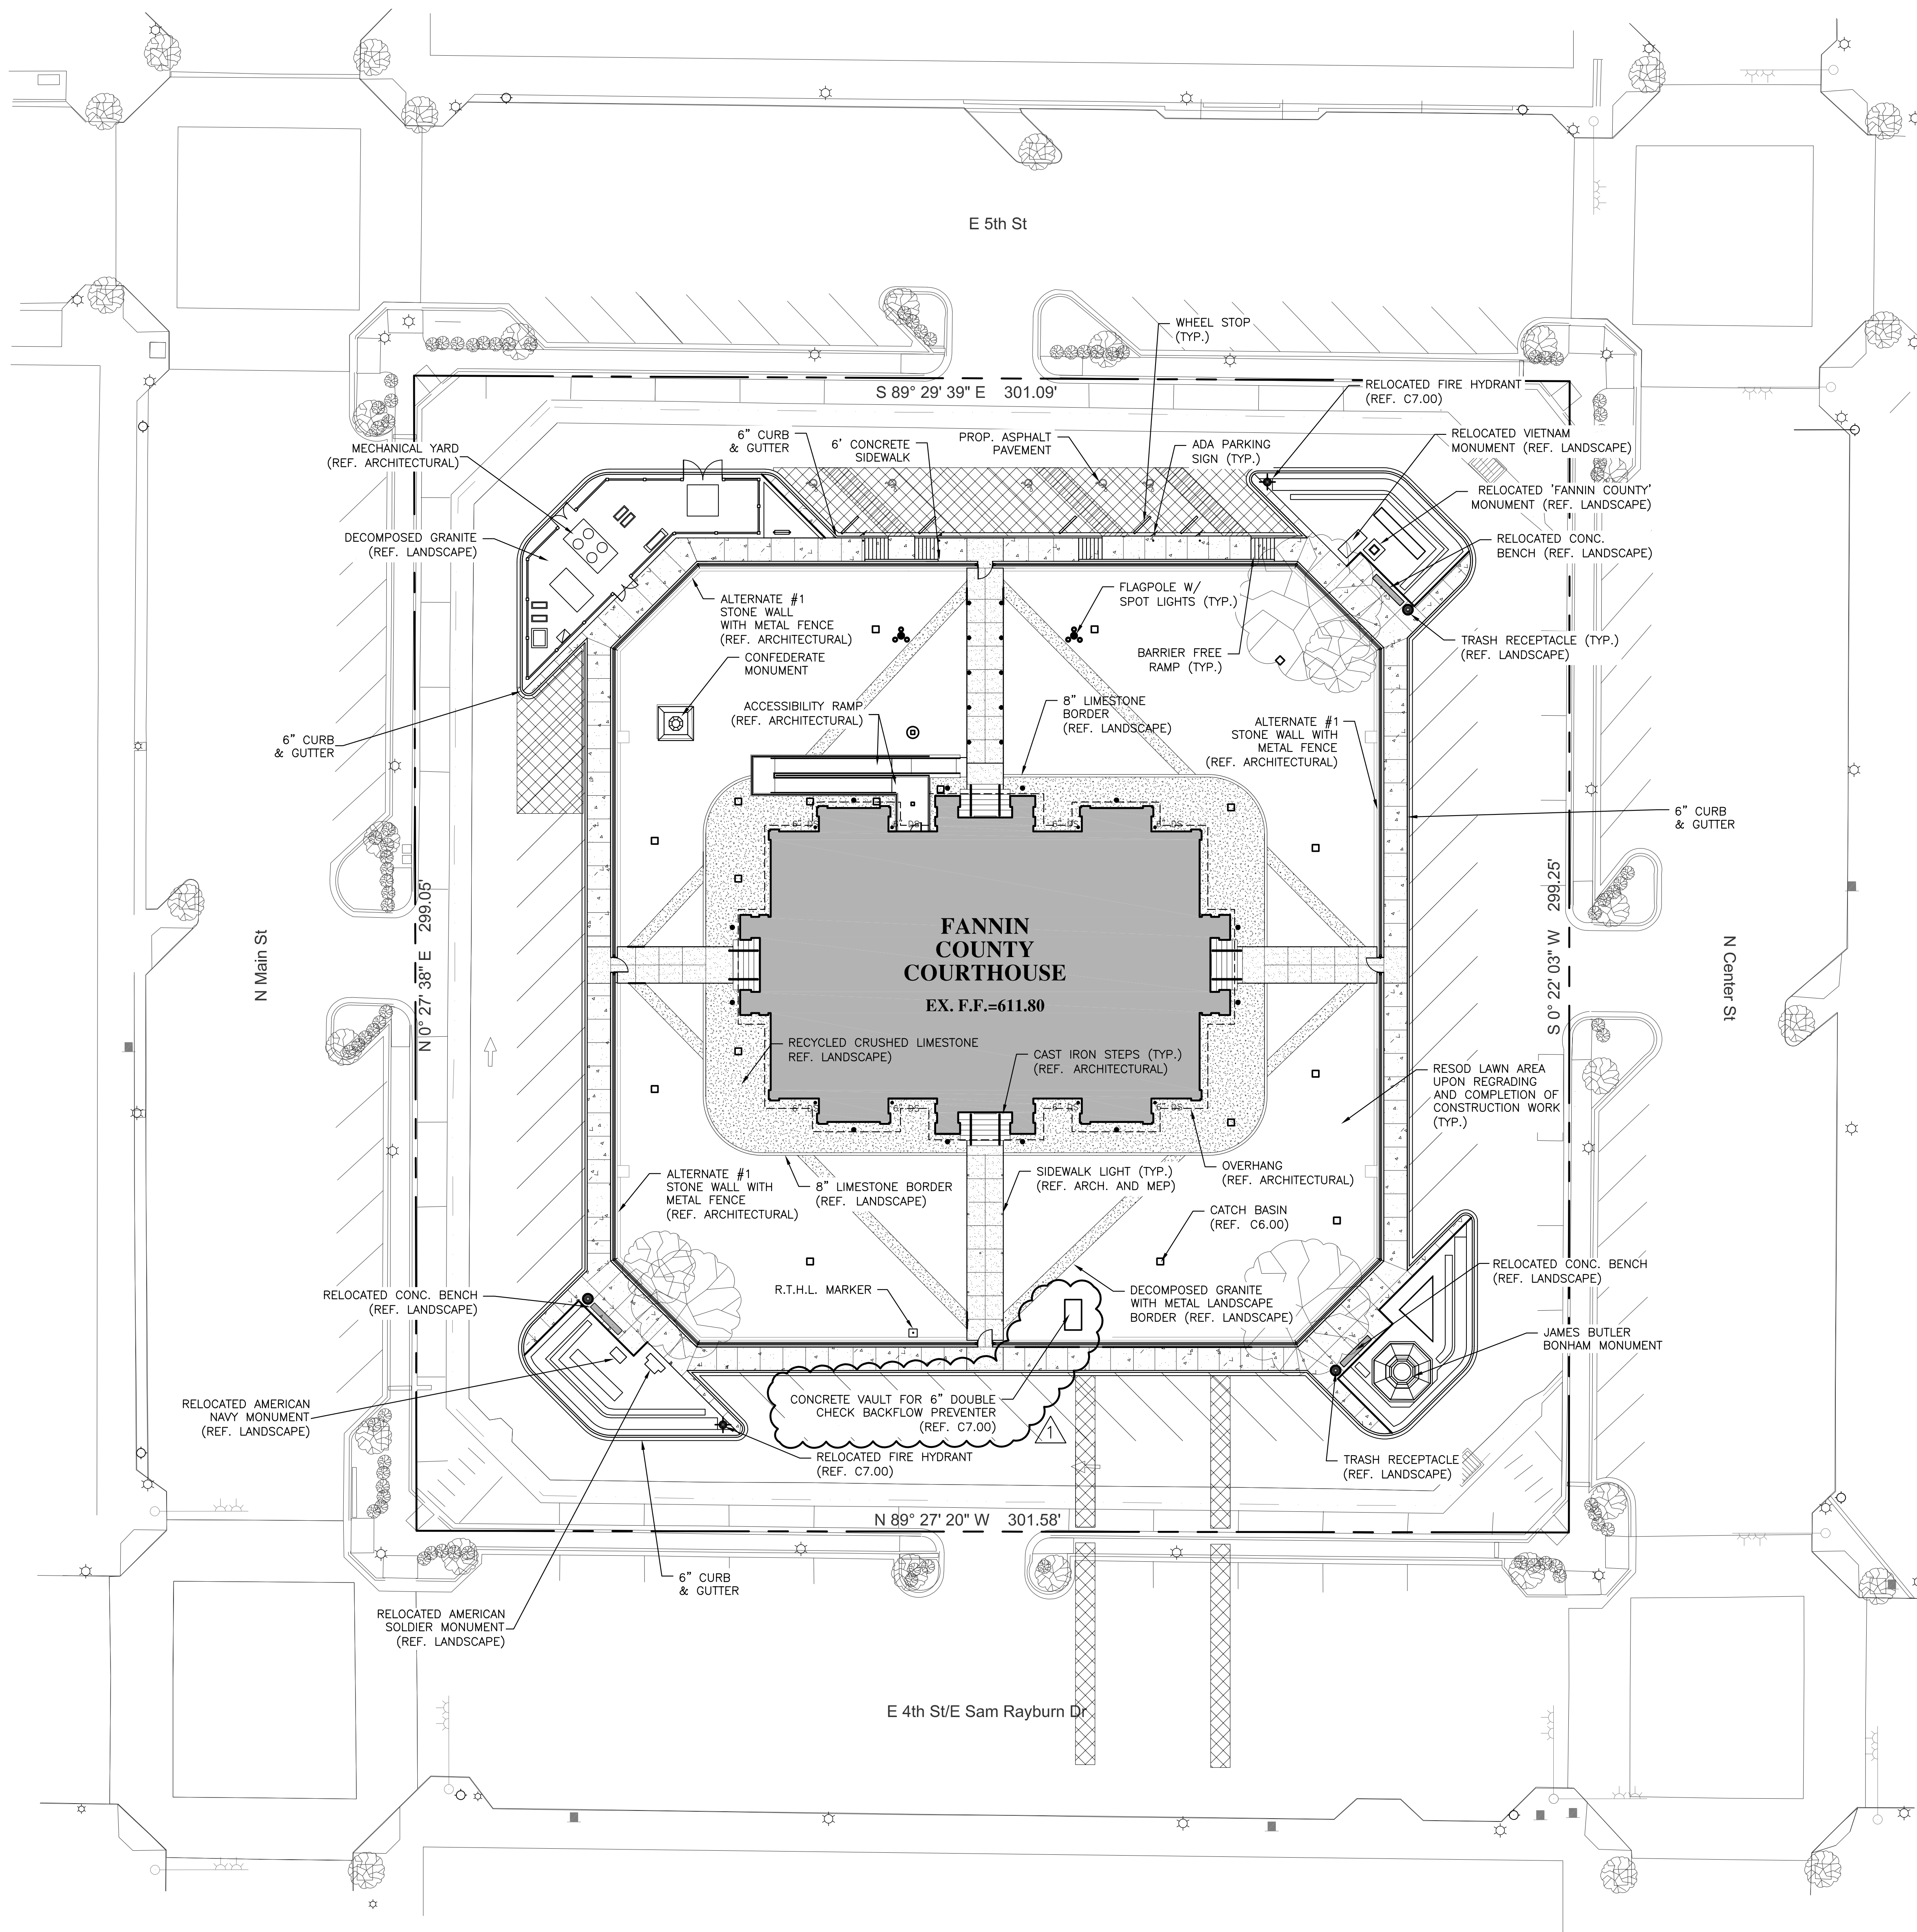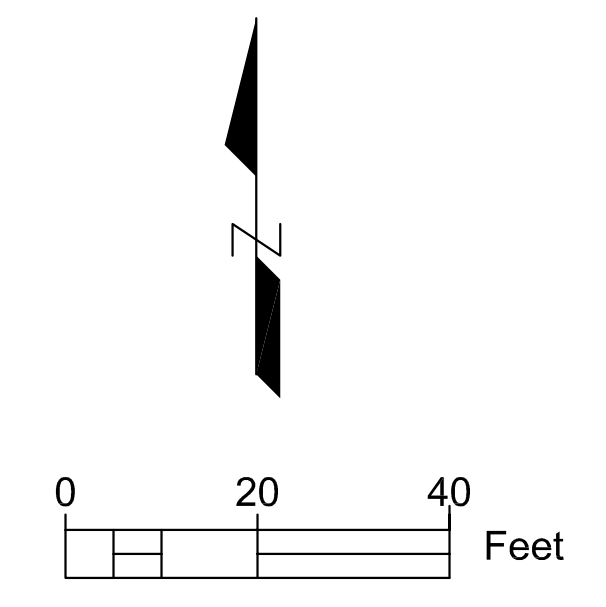

**Legend**

- PROPOSED COOL GRAY CONCRETE SIDEWALK
- PROPOSED WARM GRAY CONCRETE SIDEWALK
- PROPOSED ASPHALT PAVEMENT
- PROPOSED DECOMPOSED GRANITE (REF. LANDSCAPE)

**Paving Plan Notes**

1. PROPERTY LINE, PUBLIC RIGHT OF WAYS, EASEMENTS, EXISTING TOPOGRAPHIC SURVEY AND LOCATION OF PHYSICAL FEATURES WERE OBTAINED FROM A BOUNDARY/TOPOGRAPHIC SURVEY PERFORMED BY KSA ENGINEERS, INC. DATED APRIL 2007
2. ALL WORK, UNLESS NOTES, SHALL CONFORM TO THE CITY OF BONHAM STANDARD CONSTRUCTION SPECIFICATIONS.
3. THE HORIZONTAL AND VERTICAL LOCATION OF EXISTING SUBSURFACE UTILITIES HAVE BEEN DETERMINED FROM DATA RECORDED BY OTHERS. IT WILL BE THE RESPONSIBILITY OF THE CONTRACTOR TO PROTECT ALL EXISTING UTILITIES WITHIN THE AREA OF CONSTRUCTION. CONTRACTOR SHALL VERIFY SIZE AND LOCATION OF ALL UTILITIES PRIOR TO CONSTRUCTION.
4. REFER TO ARCHITECTURAL PLANS FOR ALL RAMP AND STAIR DETAILS.
5. REFER TO ARCHITECTURAL PLANS FOR CONCRETE COLORS & PATTERNS.



**TEXAS HISTORICAL COMMISSION**  
*real places telling real stories*



**FANNIN COUNTY COURTHOUSE**  
INTERIOR & EXTERIOR RESTORATION


101 E. Sam Rayburn Drive  
Bonham, Texas 75418

**COPYRIGHT**  
The Contractor shall verify and be responsible for all dimensions. DO NOT scale the drawing. Any errors or omissions shall be reported to Architexas without delay. The Copyrights to all designs and drawings are the property of Architexas. Reproduction or use for any purpose other than that authorized by Architexas is forbidden.

**REVISION HISTORY**

NO.	ADDENDUM 1	October 16, 2018
1		

ISSUED FOR CONSTRUCTION

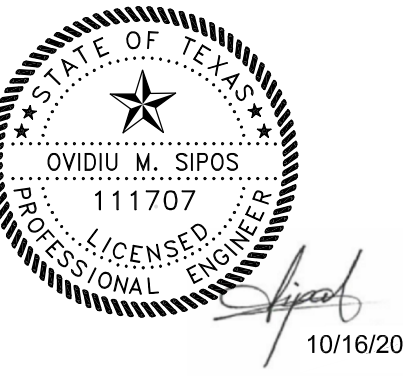


Architexas No. 1737 Date September 21, 2018

Sheet Name PAVING PLAN

Sheet Number

**C4.00**



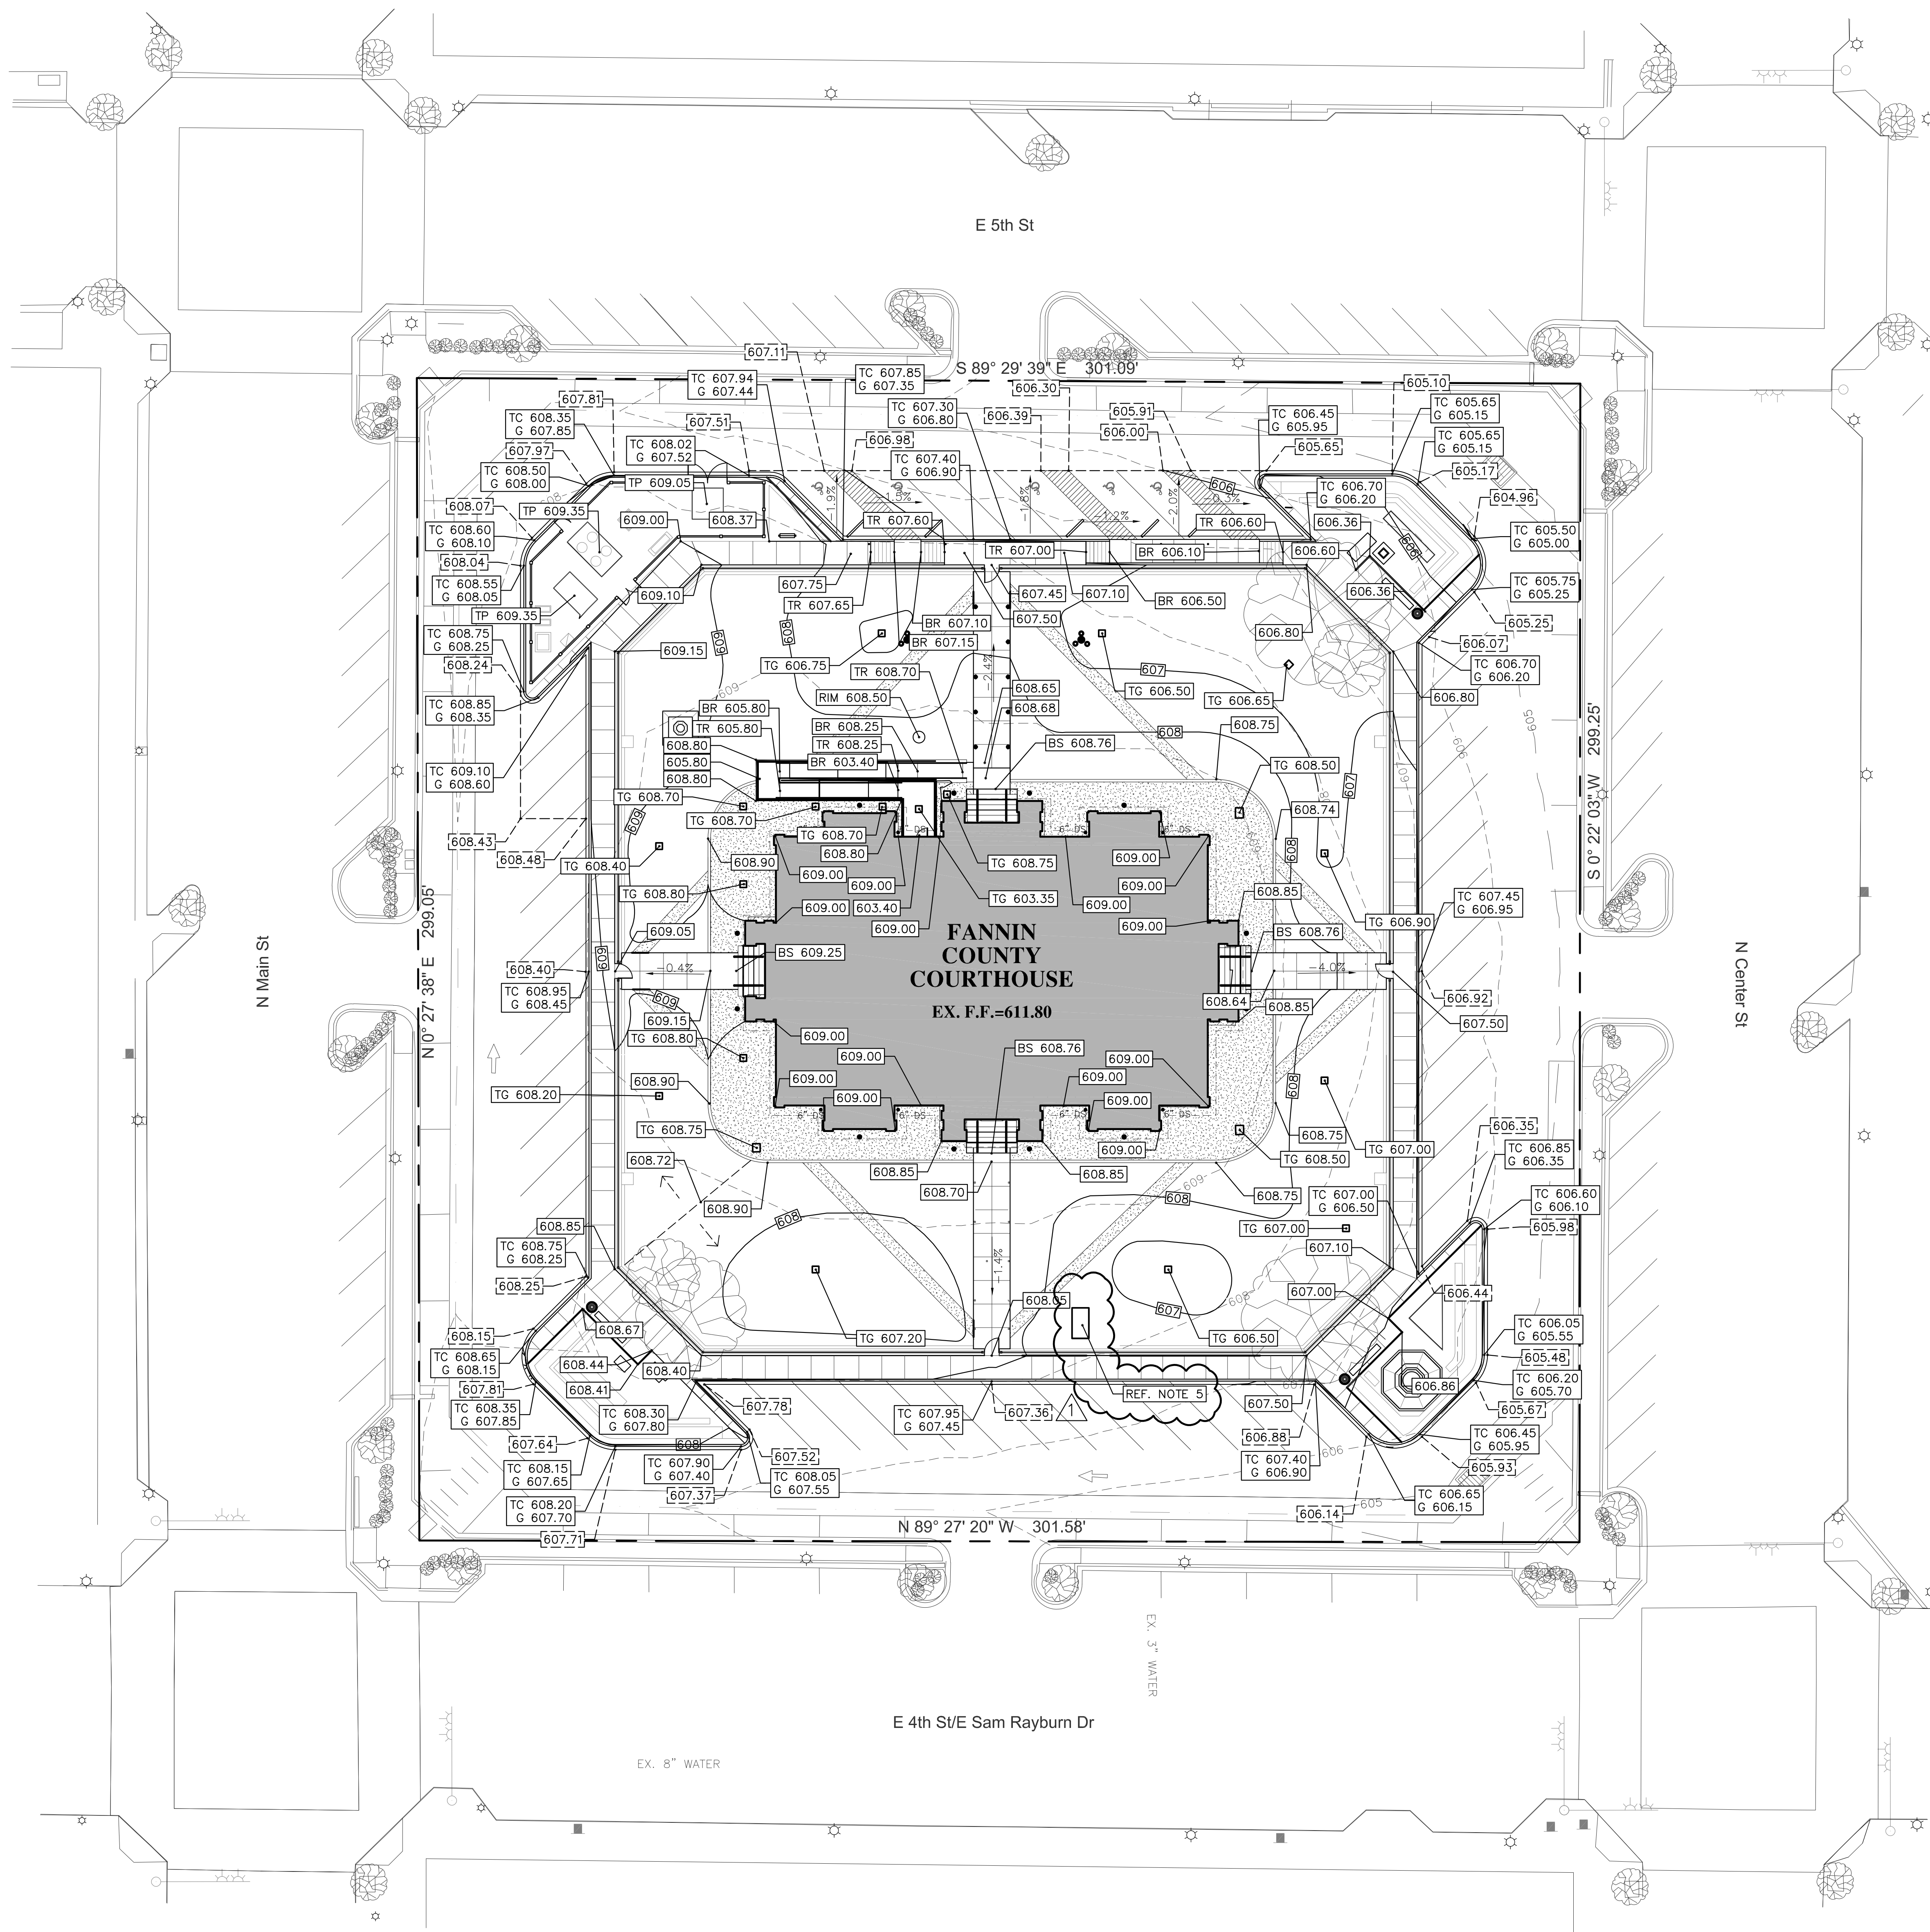

**Legend**

- PROPOSED SPOT
- MATCH EXISTING
- TC TOP OF CURB ELEVATION
- G GUTTER ELEVATION
- TS TOP OF STAIR
- BS BOTTOM OF STAIR
- TR TOP OF RAMP
- BR BOTTOM OF RAMP
- TG TOP OF GRATE
- RIM TOP OF RIM ELEVATION
- PROPOSED CONTOUR AND ELEVATION
- EXISTING CONTOUR AND ELEVATION

**Grading Plan Notes**

1. REFER TO GEOTECHNICAL REPORT FOR FILL COMPACTION AND MOISTURE CONTENT REQUIREMENTS.
2. IT WILL BE THE RESPONSIBILITY OF THE CONTRACTOR TO PROTECT ALL MANHOLES, CLEANOUTS, VALVE BOXES, FIRE HYDRANTS, ETC. WITHIN THE AREA OF CONSTRUCTION. THEY MUST BE ADJUSTED TO PROPER LINE AND GRADE BY THE CONTRACTOR PRIOR TO AND AFTER THE PLACING OF PAVING AND GRADING.
3. SIDEWALKS SHALL HAVE A SLOPE NO GREATER THAN 5% AND A CROSS SLOPE NOT GREATER THAN 2%, UNLESS OTHERWISE NOTED.
4. CONTRACTOR SHALL VERIFY AND RE-SHOOT ALL ELEVATIONS PRIOR TO CONSTRUCTION, ESPECIALLY IN AREAS WHERE EXISTING SITE FEATURES HAVE BEEN MOVED/REMOVED DURING PHASE 1 DEMOLITION.
5. CONTRACTOR SHALL INSTALL THE VAULT SUCH THAT THE TOP OF THE VAULT IS MIN. 4" ABOVE SURROUNDING GRADE.



TEXAS HISTORICAL COMMISSION  
real places telling real stories




FANNIN COUNTY  
COURTHOUSE  
INTERIOR & EXTERIOR RESTORATION

101 E. Sam Rayburn Drive  
Bonham, Texas 75418

**COPYRIGHT**  
The Contractor shall verify and be responsible for all dimensions. DO NOT scale the drawing. Any errors or omissions shall be reported to Architexas without delay. The Copyrights to all designs and drawings are the property of Architexas. Reproduction or use for any purpose other than that authorized by Architexas is forbidden.

**REVISION HISTORY**  
ADDENDUM 1 October 16, 2018

ISSUED FOR CONSTRUCTION

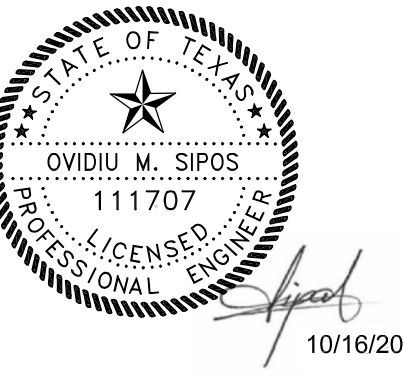


Architexas No. 1737 Date September 21, 2018

Sheet Name GRADING PLAN

Sheet Number

**JQ ENGINEERING, LLP**  
1000 GLASS STREET  
P.O. BOX 11000  
DALLAS, TEXAS 75207  
214.752.8008  
jqeng.com  
TEXAS REGISTERED ENGINEER # 11234



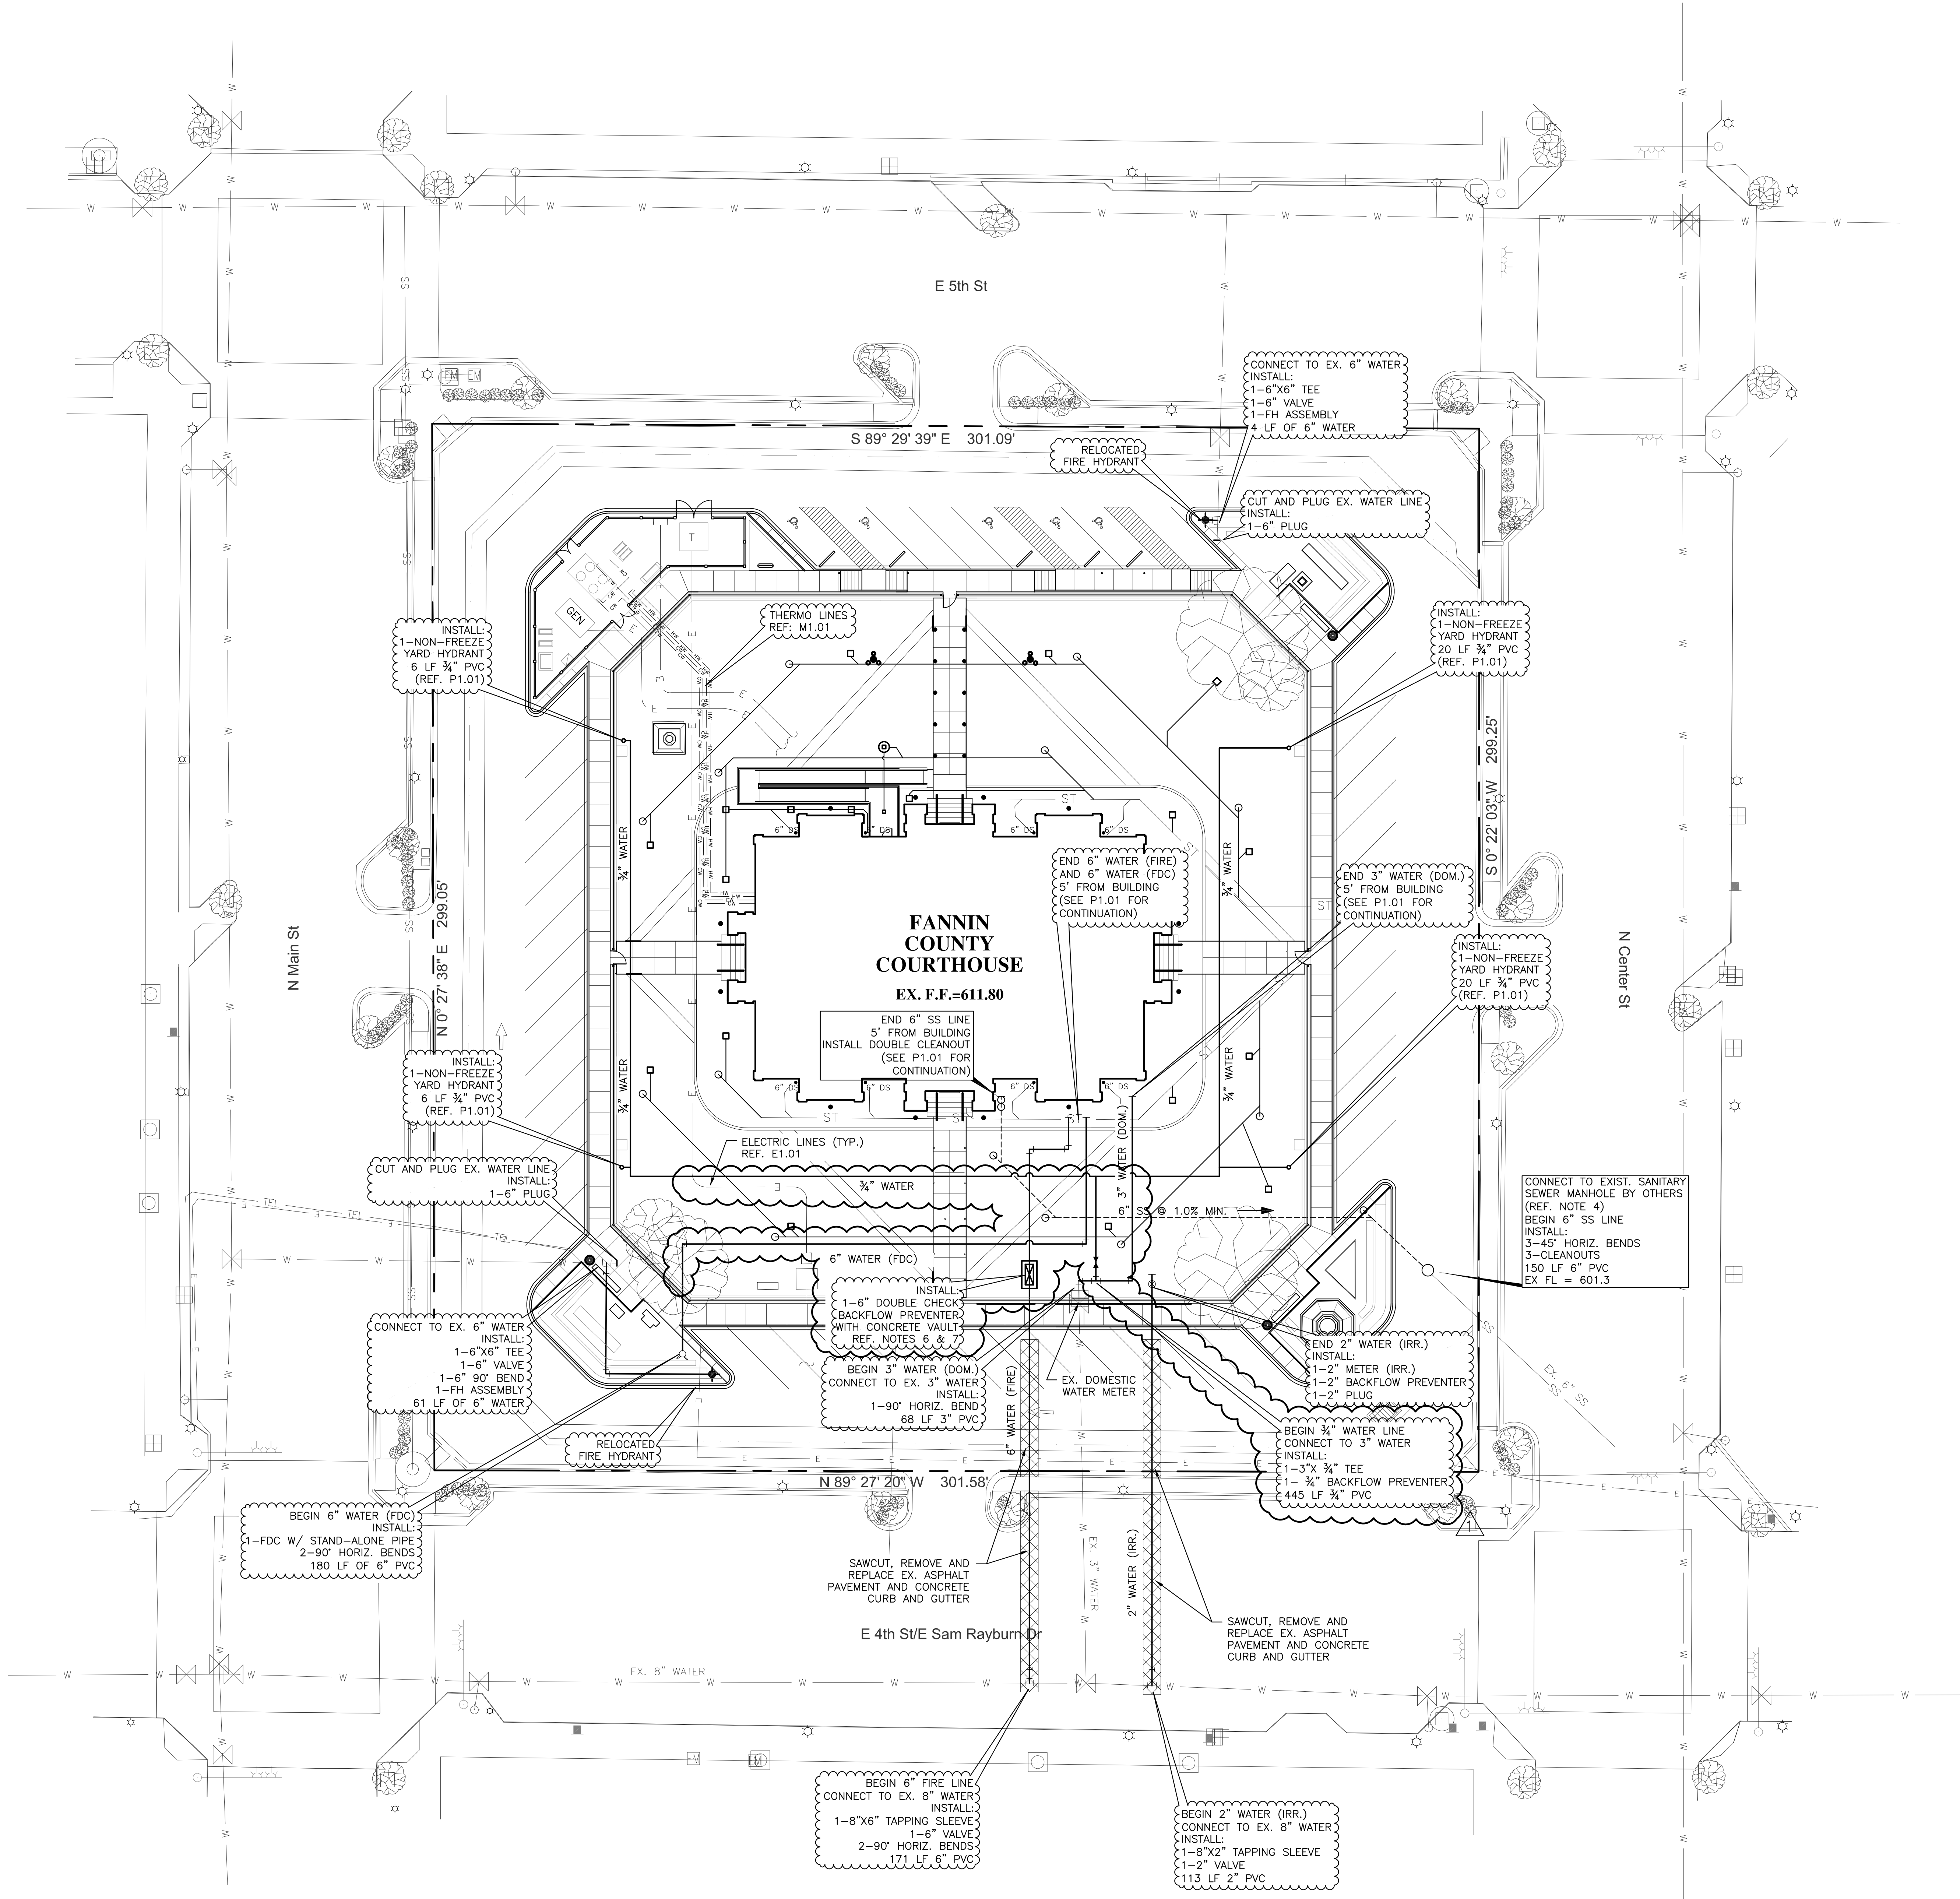

**Legend**

- SANITARY SEWER LINE
- SANITARY MANHOLE
- SANITARY CLEANOUT
- WATER LINE
- WATER VALVE
- FIRE HYDRANT
- E — ELECTRIC LINE (REF. E1.01)
- TEL — TELECOM LINE (REF. MEP)
- CH — CHILL WATER LINE (REF. M1.01)
- HW — HOT WATER LINE (REF. M1.01)

**Utility Plan Notes**

1. PROPERTY LINE, PUBLIC RIGHT OF WAYS, EASEMENTS, EXISTING TOPOGRAPHIC SURVEY AND LOCATION OF PHYSICAL FEATURES WERE OBTAINED FROM A BOUNDARY/TOPOGRAPHIC SURVEY PERFORMED BY KSA ENGINEERS, INC. DATED APRIL 2009
2. THE HORIZONTAL AND VERTICAL LOCATION OF EXISTING SUBSURFACE UTILITIES HAVE BEEN DETERMINED FROM DATA RECORDED BY OTHERS. IT WILL BE THE RESPONSIBILITY OF THE CONTRACTOR TO PROTECT ALL EXISTING UTILITIES WITHIN THE AREA OF CONSTRUCTION. CONTRACTOR SHALL VERIFY SIZE AND LOCATION OF ALL UTILITIES PRIOR TO CONSTRUCTION.
3. ALL WATER AND SANITARY SEWER PIPES MUST BE INSTALLED AND TESTED ACCORDING TO TEXAS COMMISSION ON ENVIRONMENTAL QUALITY (TCEQ).
4. CONTRACTOR SHALL VERIFY ALL EXISTING SANITARY SEWER FLOW LINES BEFORE BEGINNING CONSTRUCTION.
5. PROPOSED ELECTRIC, TELECOM, CHILL WATER, AND HOT WATER LINES SHOWN HEREON ARE FOR REFERENCE ONLY AND SHOULD BE CONSIDERED APPROXIMATE. REFER TO MEP DRAWINGS FOR EXACT LOCATIONS.
6. 6" DOUBLE CHECK BACKFLOW PREVENTER WITH CONCRETE VAULT TO BE PARK USA DOUBLE CHECK BACKFLOW PREVENTER ASSEMBLY (MODEL DDBP6) OR APPROVED EQUIVALENT.
7. CONTRACTOR SHALL INSTALL THE VAULT SUCH THAT THE TOP OF THE VAULT IS MIN. 4" ABOVE SURROUNDING GRADE. CONNECT SUMP TO NEAREST STORM DRAIN.




**FANNIN COUNTY COURTHOUSE INTERIOR & EXTERIOR RESTORATION**

101 E. Sam Rayburn Drive  
 Bonham, Texas 75418

**COPYRIGHT**  
 The Contractor shall verify and be responsible for all dimensions. DO NOT scale the drawing. Any errors or omissions shall be reported to Architexas without delay. The Copyrights to all designs and drawings are the property of Architexas. Reproduction or use for any purpose other than that authorized by Architexas is forbidden.

**REVISION HISTORY**  
 ADDENDUM 1 October 16, 2018

ISSUED FOR CONSTRUCTION

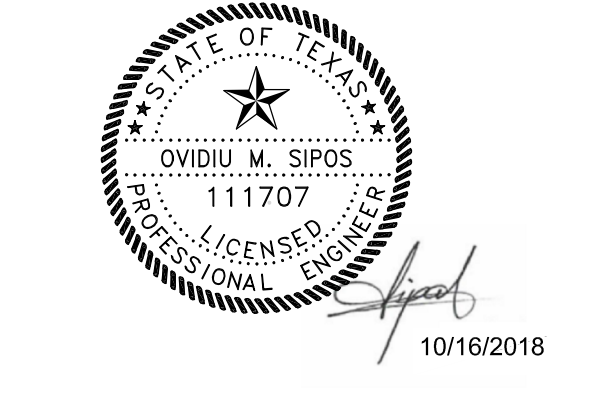

**JQ ENGINEERING, LLP**  
 200 GLASS STREET  
 DALLAS, TEXAS 75201  
 P: 214.752.8008  
 JQENG.COM  
 TEXAS REGISTERED ENGINEER PRWF-1224


Architexas No. 1737 Date September 21, 2018  
 Sheet Name UTILITY PLAN

Sheet Number



GENERAL NOTES

- GENERAL SITE WORK**
- ALL AREAS AND ITEMS INDICATING CONTRACT LIMITS AND LINES OF DEMARCATION ARE SHOWN FOR THE CONVENIENCE OF THE CONTRACTOR AND ARE NOT TO BE TAKEN LITERALLY. ACTUAL CONTRACT LIMITS ARE TO BE DETERMINED PRIOR TO CONSTRUCTION BY FIELD VERIFICATION.
  - EXISTING CONSTRUCTION SHOWN TO REMAIN SHALL NOT BE DAMAGED DURING THE DEMOLITION PROCESS. PROVIDE ALL NECESSARY TEMPORARY PROTECTION.
  - EXISTING UTILITY SERVICES ARE TO REMAIN, BE PROTECTED, AND / OR TO BE OPERATIONAL DURING DEMOLITION AND CONSTRUCTION. REFERENCE RELEVANT MECHANICAL, PLUMBING, AND ELECTRICAL DRAWINGS. CONTRACTOR TO BE RESPONSIBLE FOR PROTECTION OF AND RESTORATION OF SERVICES, AS WELL AS PROVISION OF TEMPORARY UTILITY SERVICES.
  - NOTIFY CITY OF BONHAM WHEN IT IS NECESSARY TO AFFECT UTILITIES BEFORE PROCEEDING WITH THE WORK. ALL EXISTING UTILITIES MUST BE CHECKED BY THE CONTRACTOR PRIOR TO THE COMMENCEMENT OF DEMOLITION WORK. ANY DAMAGES RESULTING FROM LACK OF COMPLIANCE WITH THE PROVISION SHOULD BE CORRECTED BY THE CONTRACTOR AT HIS OR HER OWN EXPENSE.
  - REFERENCE CIVIL AND MEP DRAWINGS FOR SCOPE OF UTILITY WORK.
  - CONTRACTOR TO TAKE SPOT ELEVATIONS AT BUILDING CORNERS AND ENTRIES ONCE SIDEWALKS SURROUNDING BUILDING ARE REMOVED. SITE GRADING TO BE DETERMINED AFTER RECEIVING SPOT ELEVATIONS, REFERENCE CIVIL.
  - SITE SURVEY WITH UTILITY INFORMATION TO BE PROVIDED BY OWNER.
  - LIGHTNING PROTECTION SYSTEM TO BE INSTALLED, COORDINATE GROUNDING ROD LOCATIONS WITH ARCHITECT PRIOR TO INSTALLATION.
- FOUNDATION WATERPROOFING SYSTEM**
- REFERENCE 1/A1.04 FOR ROUTING OF FOUNDATION DRAIN.
  - NOTIFY ARCHITECT IF DAMAGED AREAS OF FOUNDATION WALL ARE DISCOVERED PRIOR TO APPLICATION OF WATERPROOFING SYSTEM.
  - CONTRACTOR TO COORDINATE HELICAL PILE INSTALLATION AT ENTRIES AWAY FROM FOUNDATION DRAIN SYSTEM.
- MONUMENTS & MARKERS**
- PROVIDE TEMPORARY PROTECTION FOR EXISTING MONUMENTS AND RITHL MARKERS DURING CONSTRUCTION ACTIVITIES ON SITE.
  - WHERE NOTED, REMOVE AND SALVAGE EXISTING SITE MARKERS AND FURNISHINGS FOR REINSTALLATION.
- TREES & LANDSCAPING**
- EXISTING TREES ARE TO REMAIN UNLESS NOTED OTHERWISE ON ARCHITECTURAL DRAWINGS.
  - PRESERVE AND PROTECT EXISTING TREES ON SITE DURING CONSTRUCTION. PROVIDE TREE PROTECTION FENCING UNDER DRIP LINE OF TREE.
  - ADJUST LAYOUT TEMPORARILY AS NECESSARY TO ALLOW FOR CONSTRUCTION IN IMMEDIATE VICINITY OF TREES.
  - EXISTING LANDSCAPE AFFECTED BY CONSTRUCTION ACTIVITIES IS TO BE REPLACED. (REF. LANDSCAPE)
- LIGHTING**
- REFERENCE ARCHITECTURAL, MEP AND LANDSCAPE DRAWINGS FOR SCOPE OF WORK ASSOCIATED WITH EXTERIOR BUILDING AND SITE LIGHTING.
- PARKING LOT**
- PROVIDE HANDICAP SIGNAGE AT HANDICAP PARKING. (REF. CIVIL)
  - RESTRIPE PARKING TO ACCOMMODATE 60' PARKING AND ONE WAY DRIVE.  
 MAINTAIN 12 FT. MIN. CLEAR WIDTH AT AISLES. (REF. CIVIL)

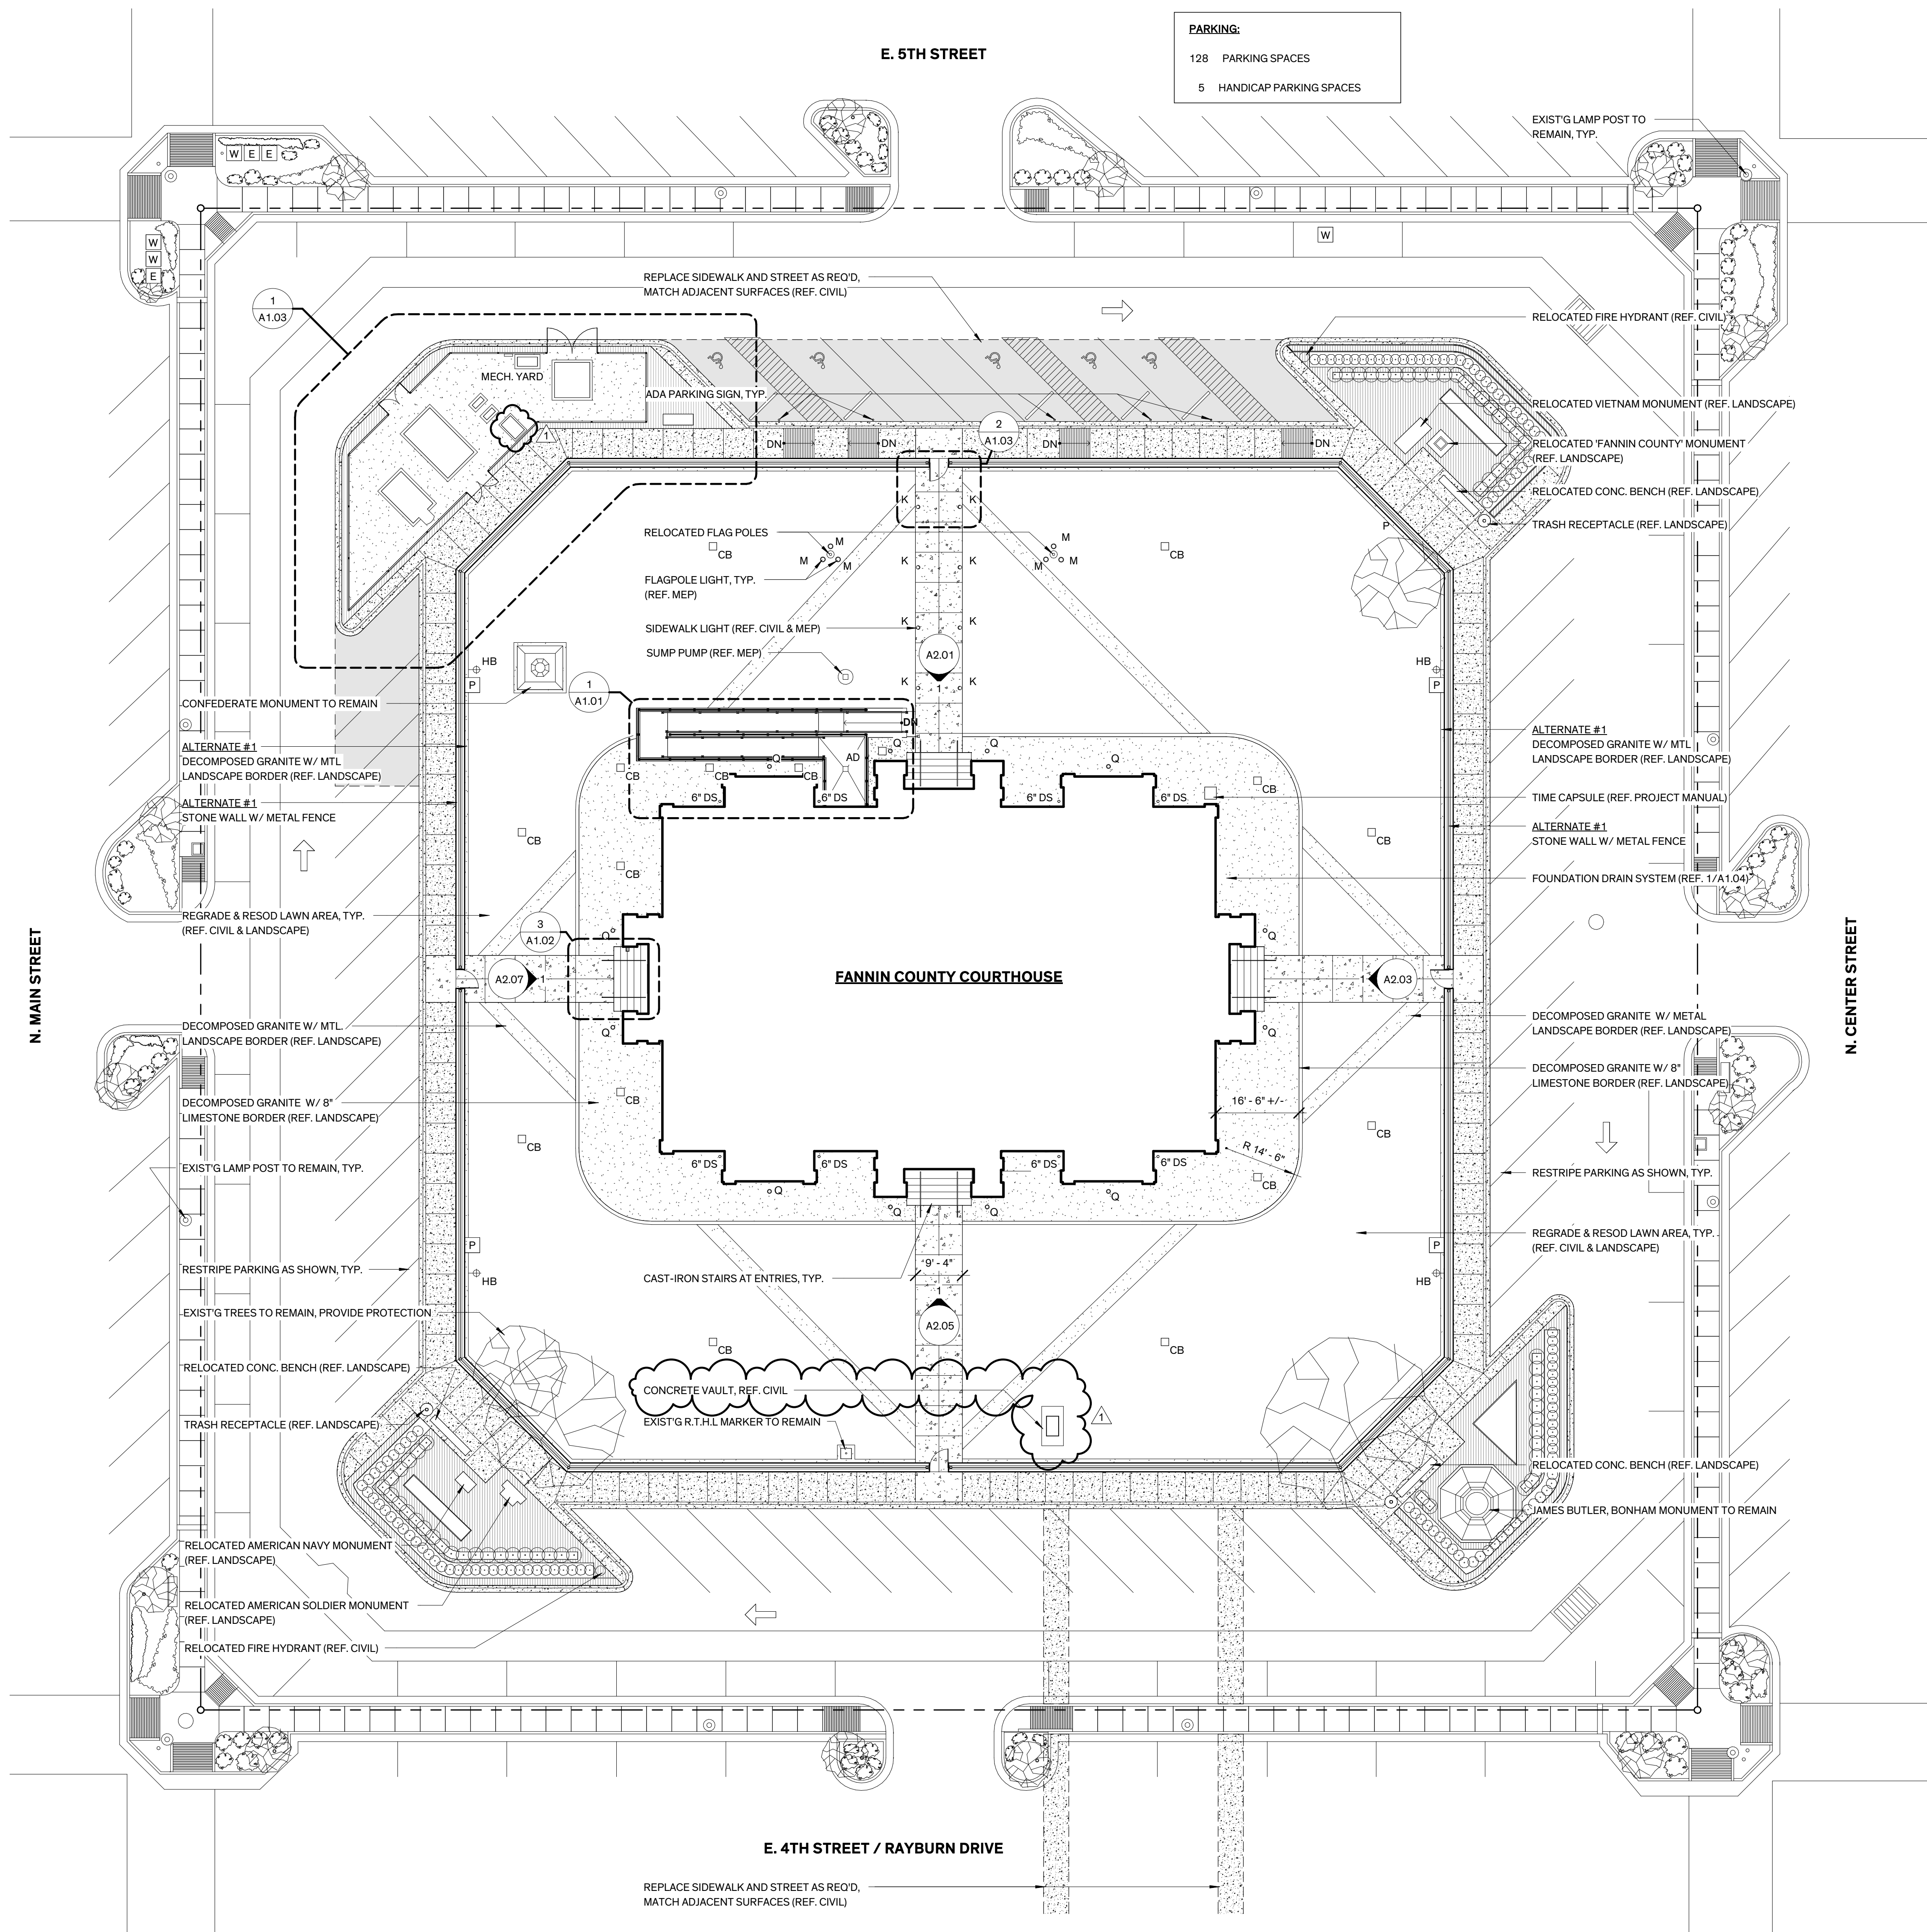

**PARKING:**  
 128 PARKING SPACES  
 5 HANDICAP PARKING SPACES

Site Plan  
 1/16" = 1'-0"




FANNIN COUNTY COURTHOUSE  
 INTERIOR & EXTERIOR RESTORATION

101 E. Sam Rayburn Drive  
 Bonham, Texas 75418

**COPYRIGHT**  
 The Contractor shall verify and be responsible for all dimensions. DO NOT scale the drawing. Any errors or omissions shall be reported to Architexas without delay. The Copyrights to all designs and drawings are the property of Architexas. Reproduction or use for any purpose other than that authorized by Architexas is forbidden.

**REVISION HISTORY**  
 1 Oct. 16, 2018 Addendum #1

ISSUED FOR CONSTRUCTION

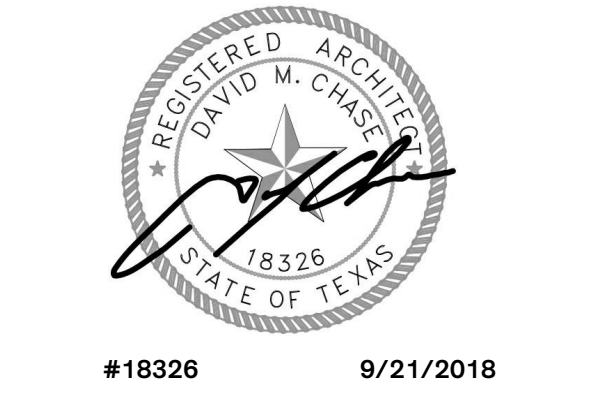


Architexas No. 1737 Date SEPT. 21, 2018

Sheet Name SITE PLAN


Sheet Number AI.00

SITE PLAN LEGEND


	ASPHALT PAVING (REF. CIVIL)
	CONCRETE PAVING W/ CONTEMPORARY FINISH
	CONCRETE PAVING W/ HISTORIC FINISH
	DECOMPOSED GRANITE (REF. LANDSCAPE)
	PLANTINGS (REF. LANDSCAPE)
	OUTDOOR POWER RECEPTACLE (REF. MEP/ CIVIL/ LANDSCAPE)
	CATCH BASIN, TYP. OF 16 (REF. CIVIL)
	PROPERTY LINE
	HOSE BIB (REF. MEP/ CIVIL/ LANDSCAPE)

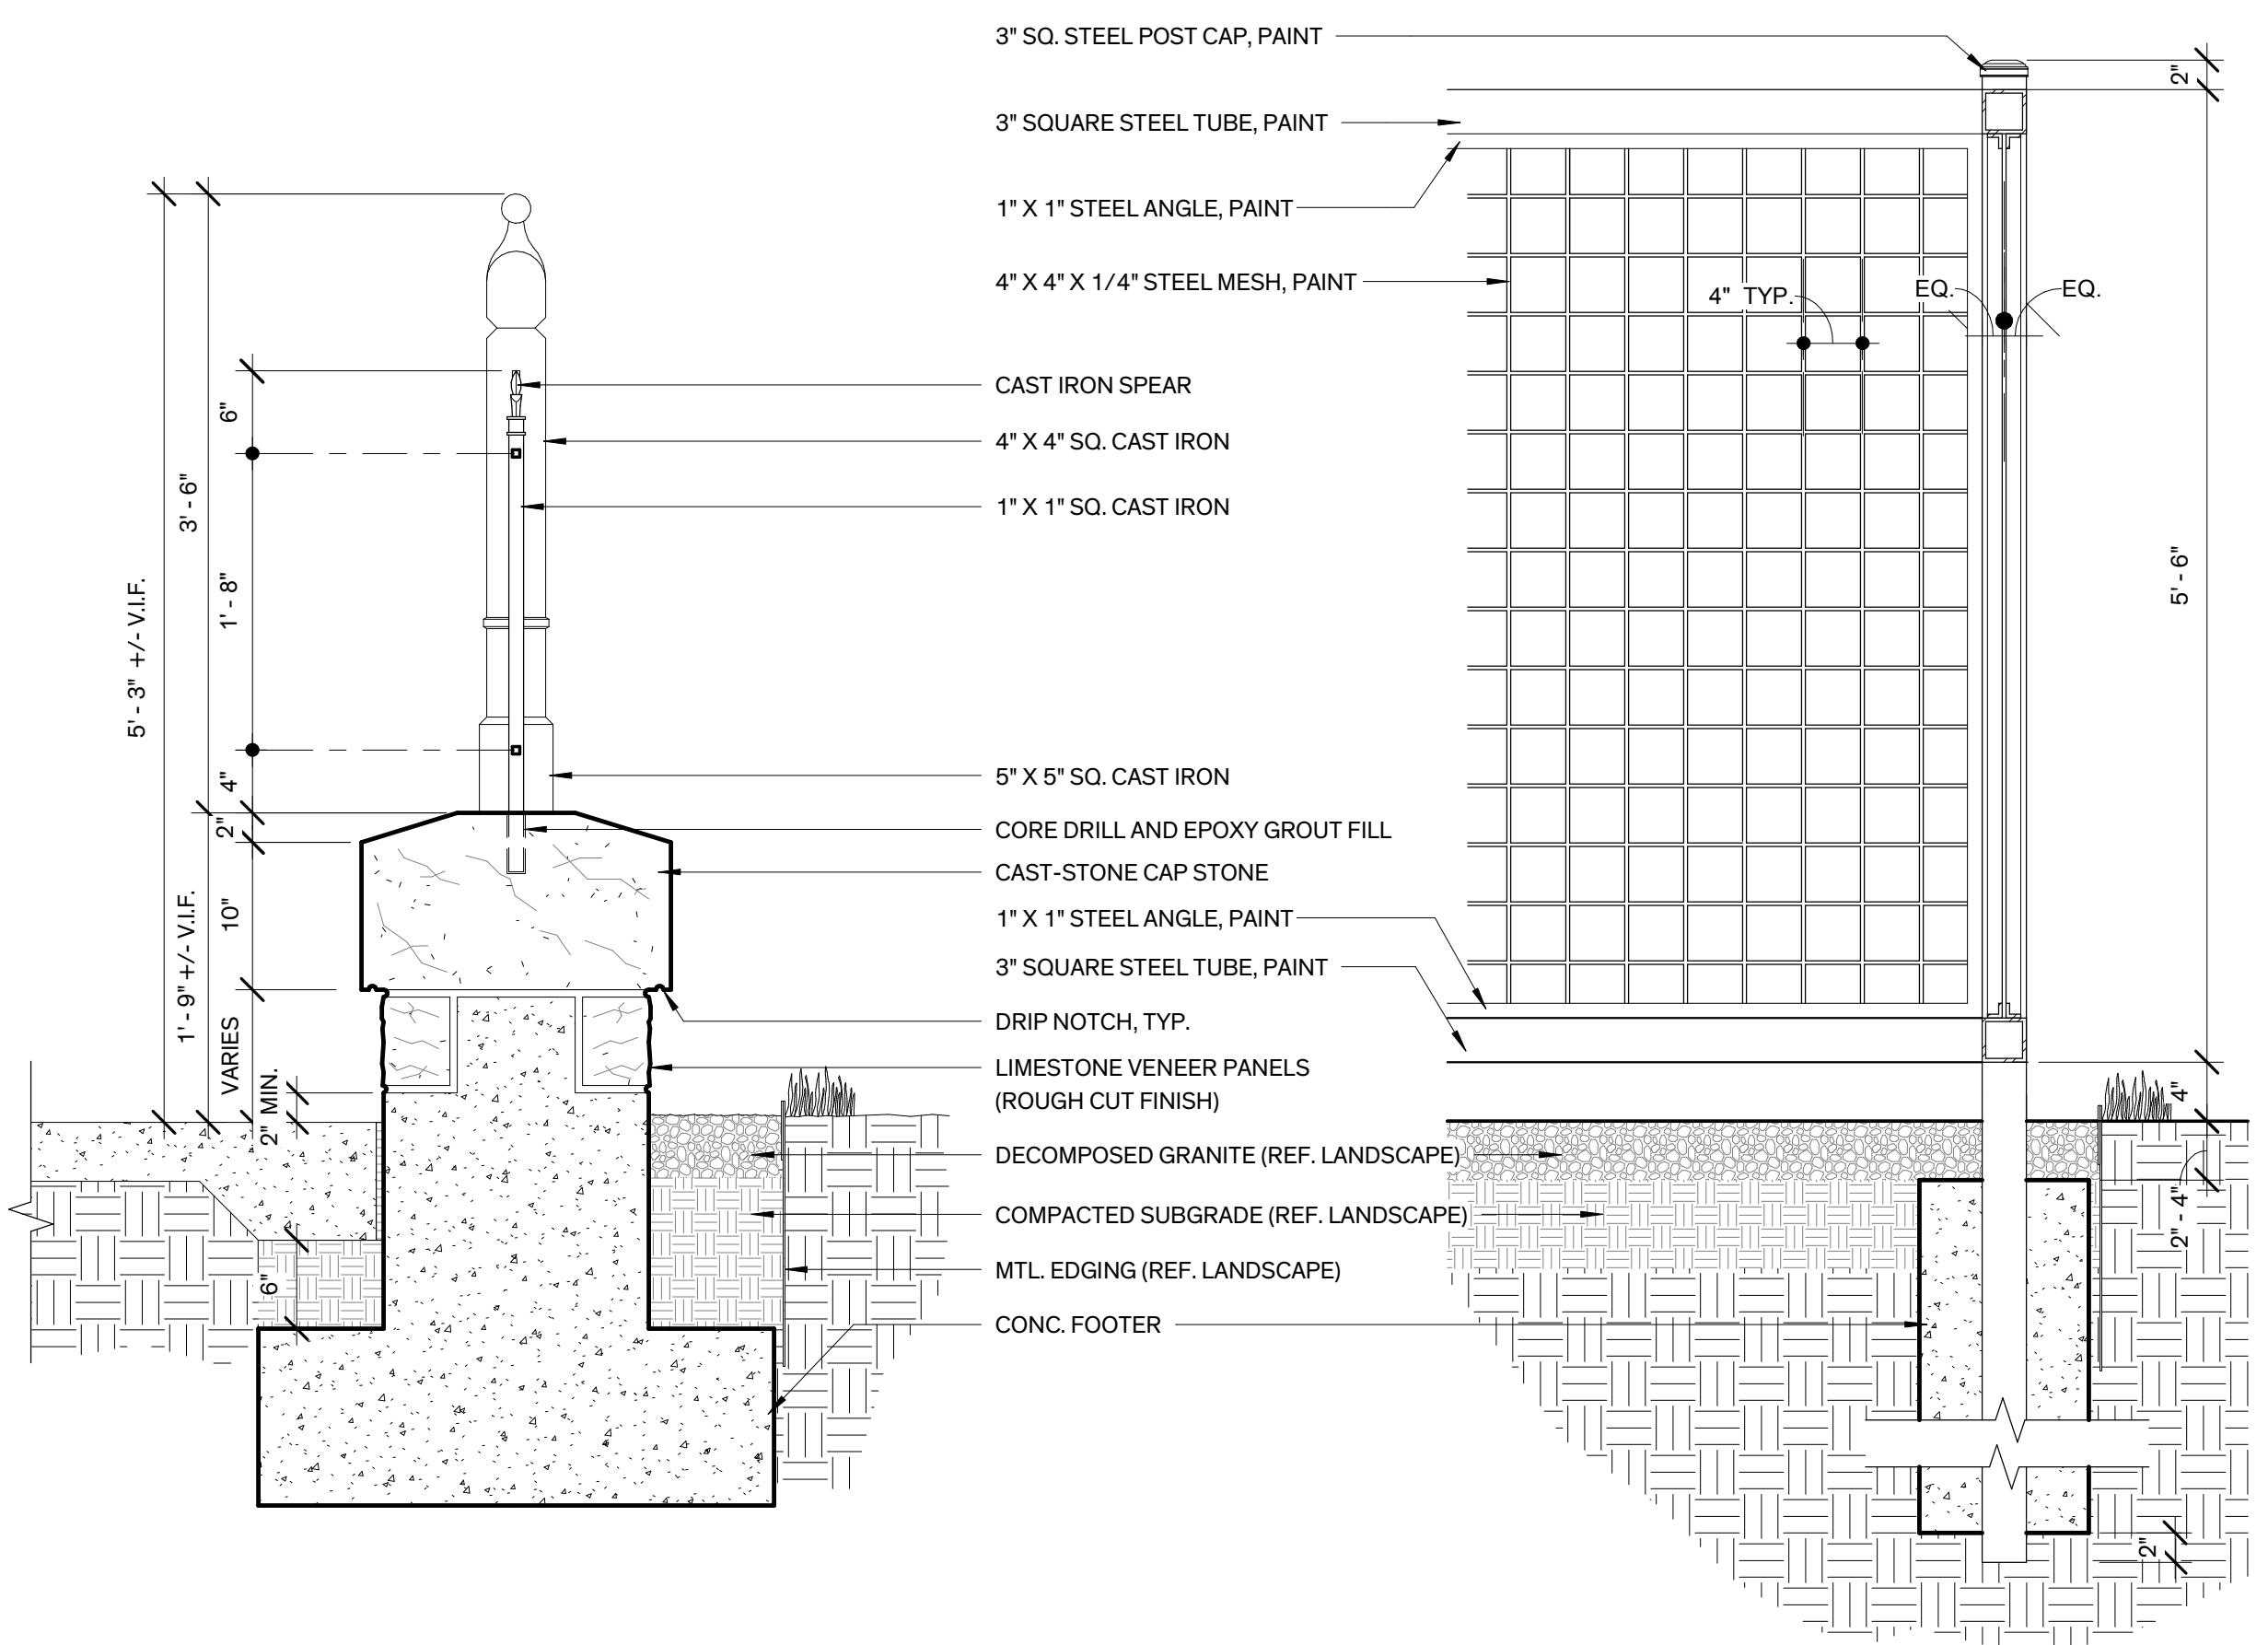


**8 Alternate #1 Stone Wall Detail**  
 1" = 1'-0"

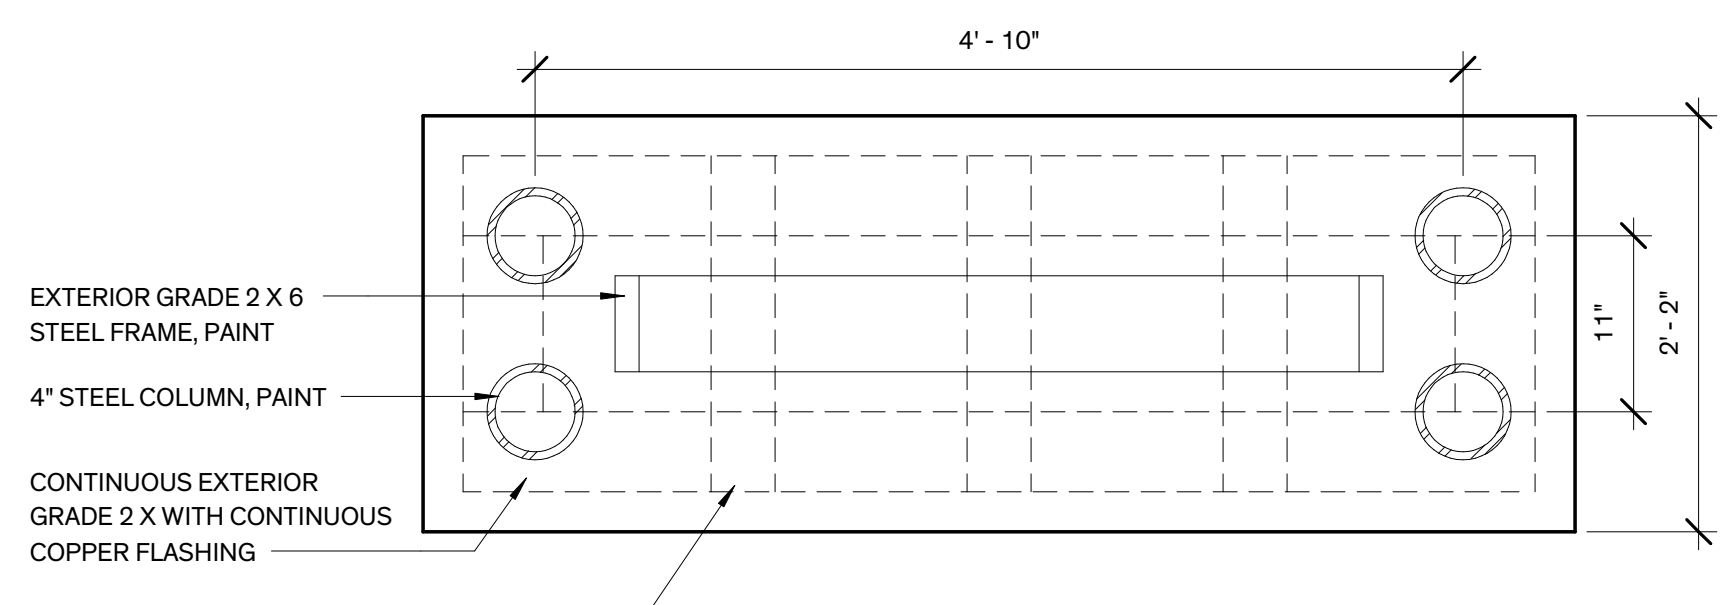

**6 Public Message Board Plan View**  
 1" = 1'-0"

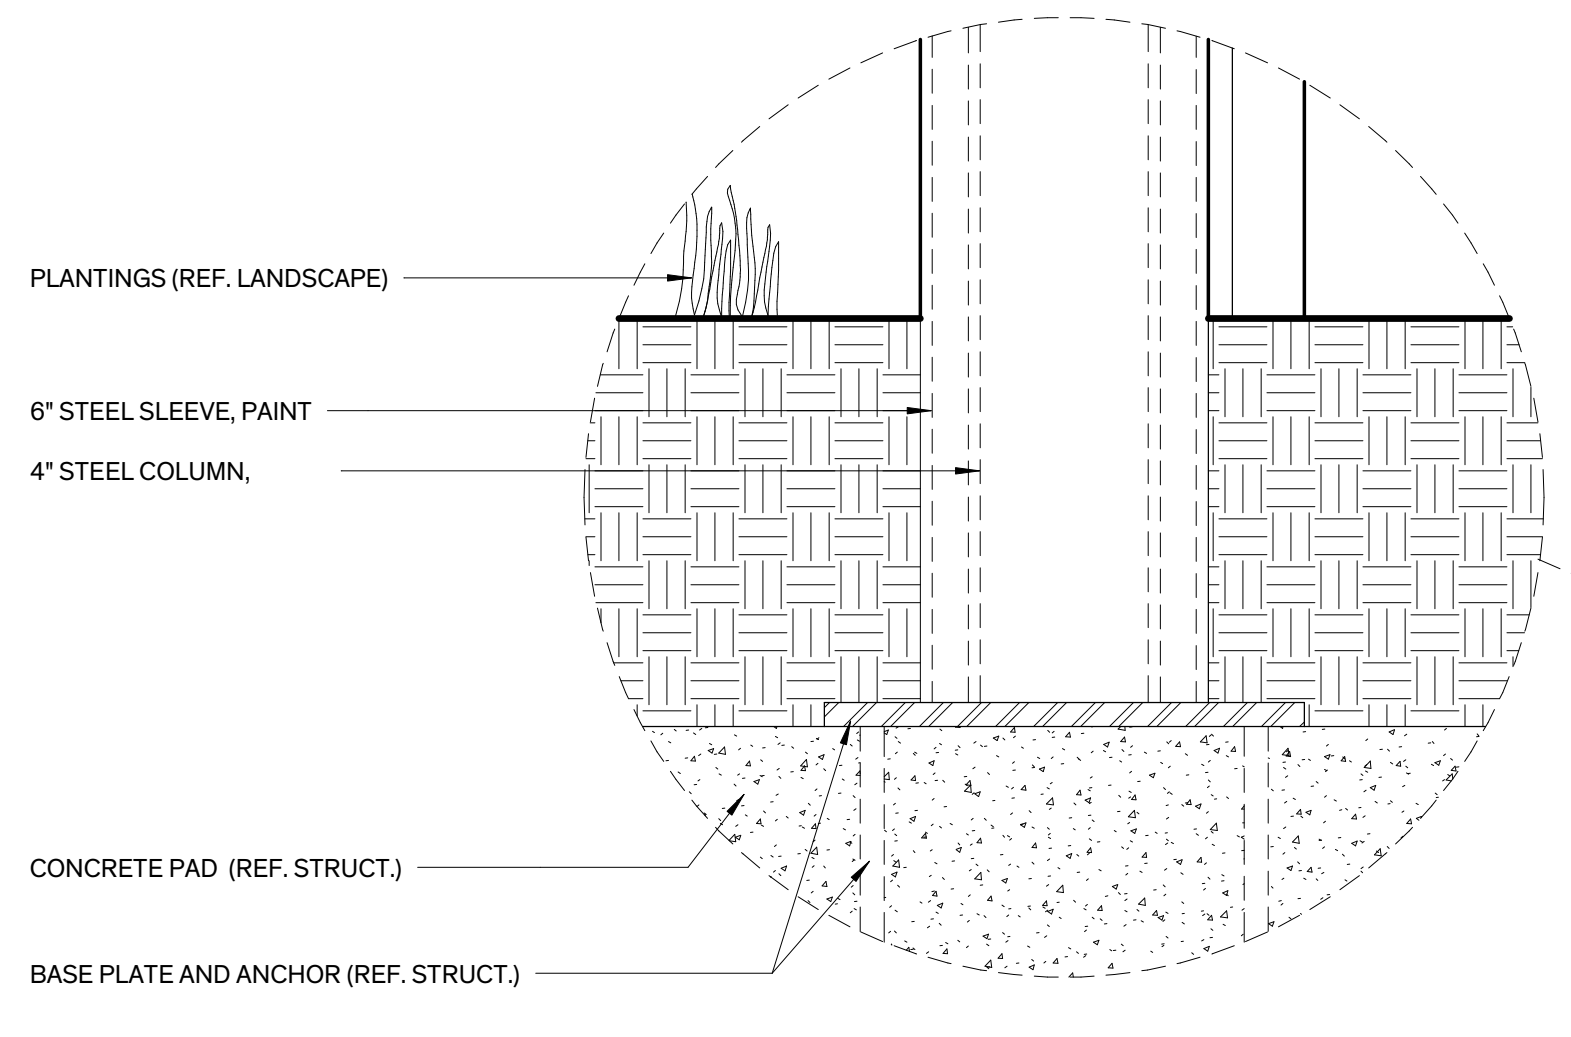


**7 Mechanical Yard Fence Detail**  
 1" = 1'-0"

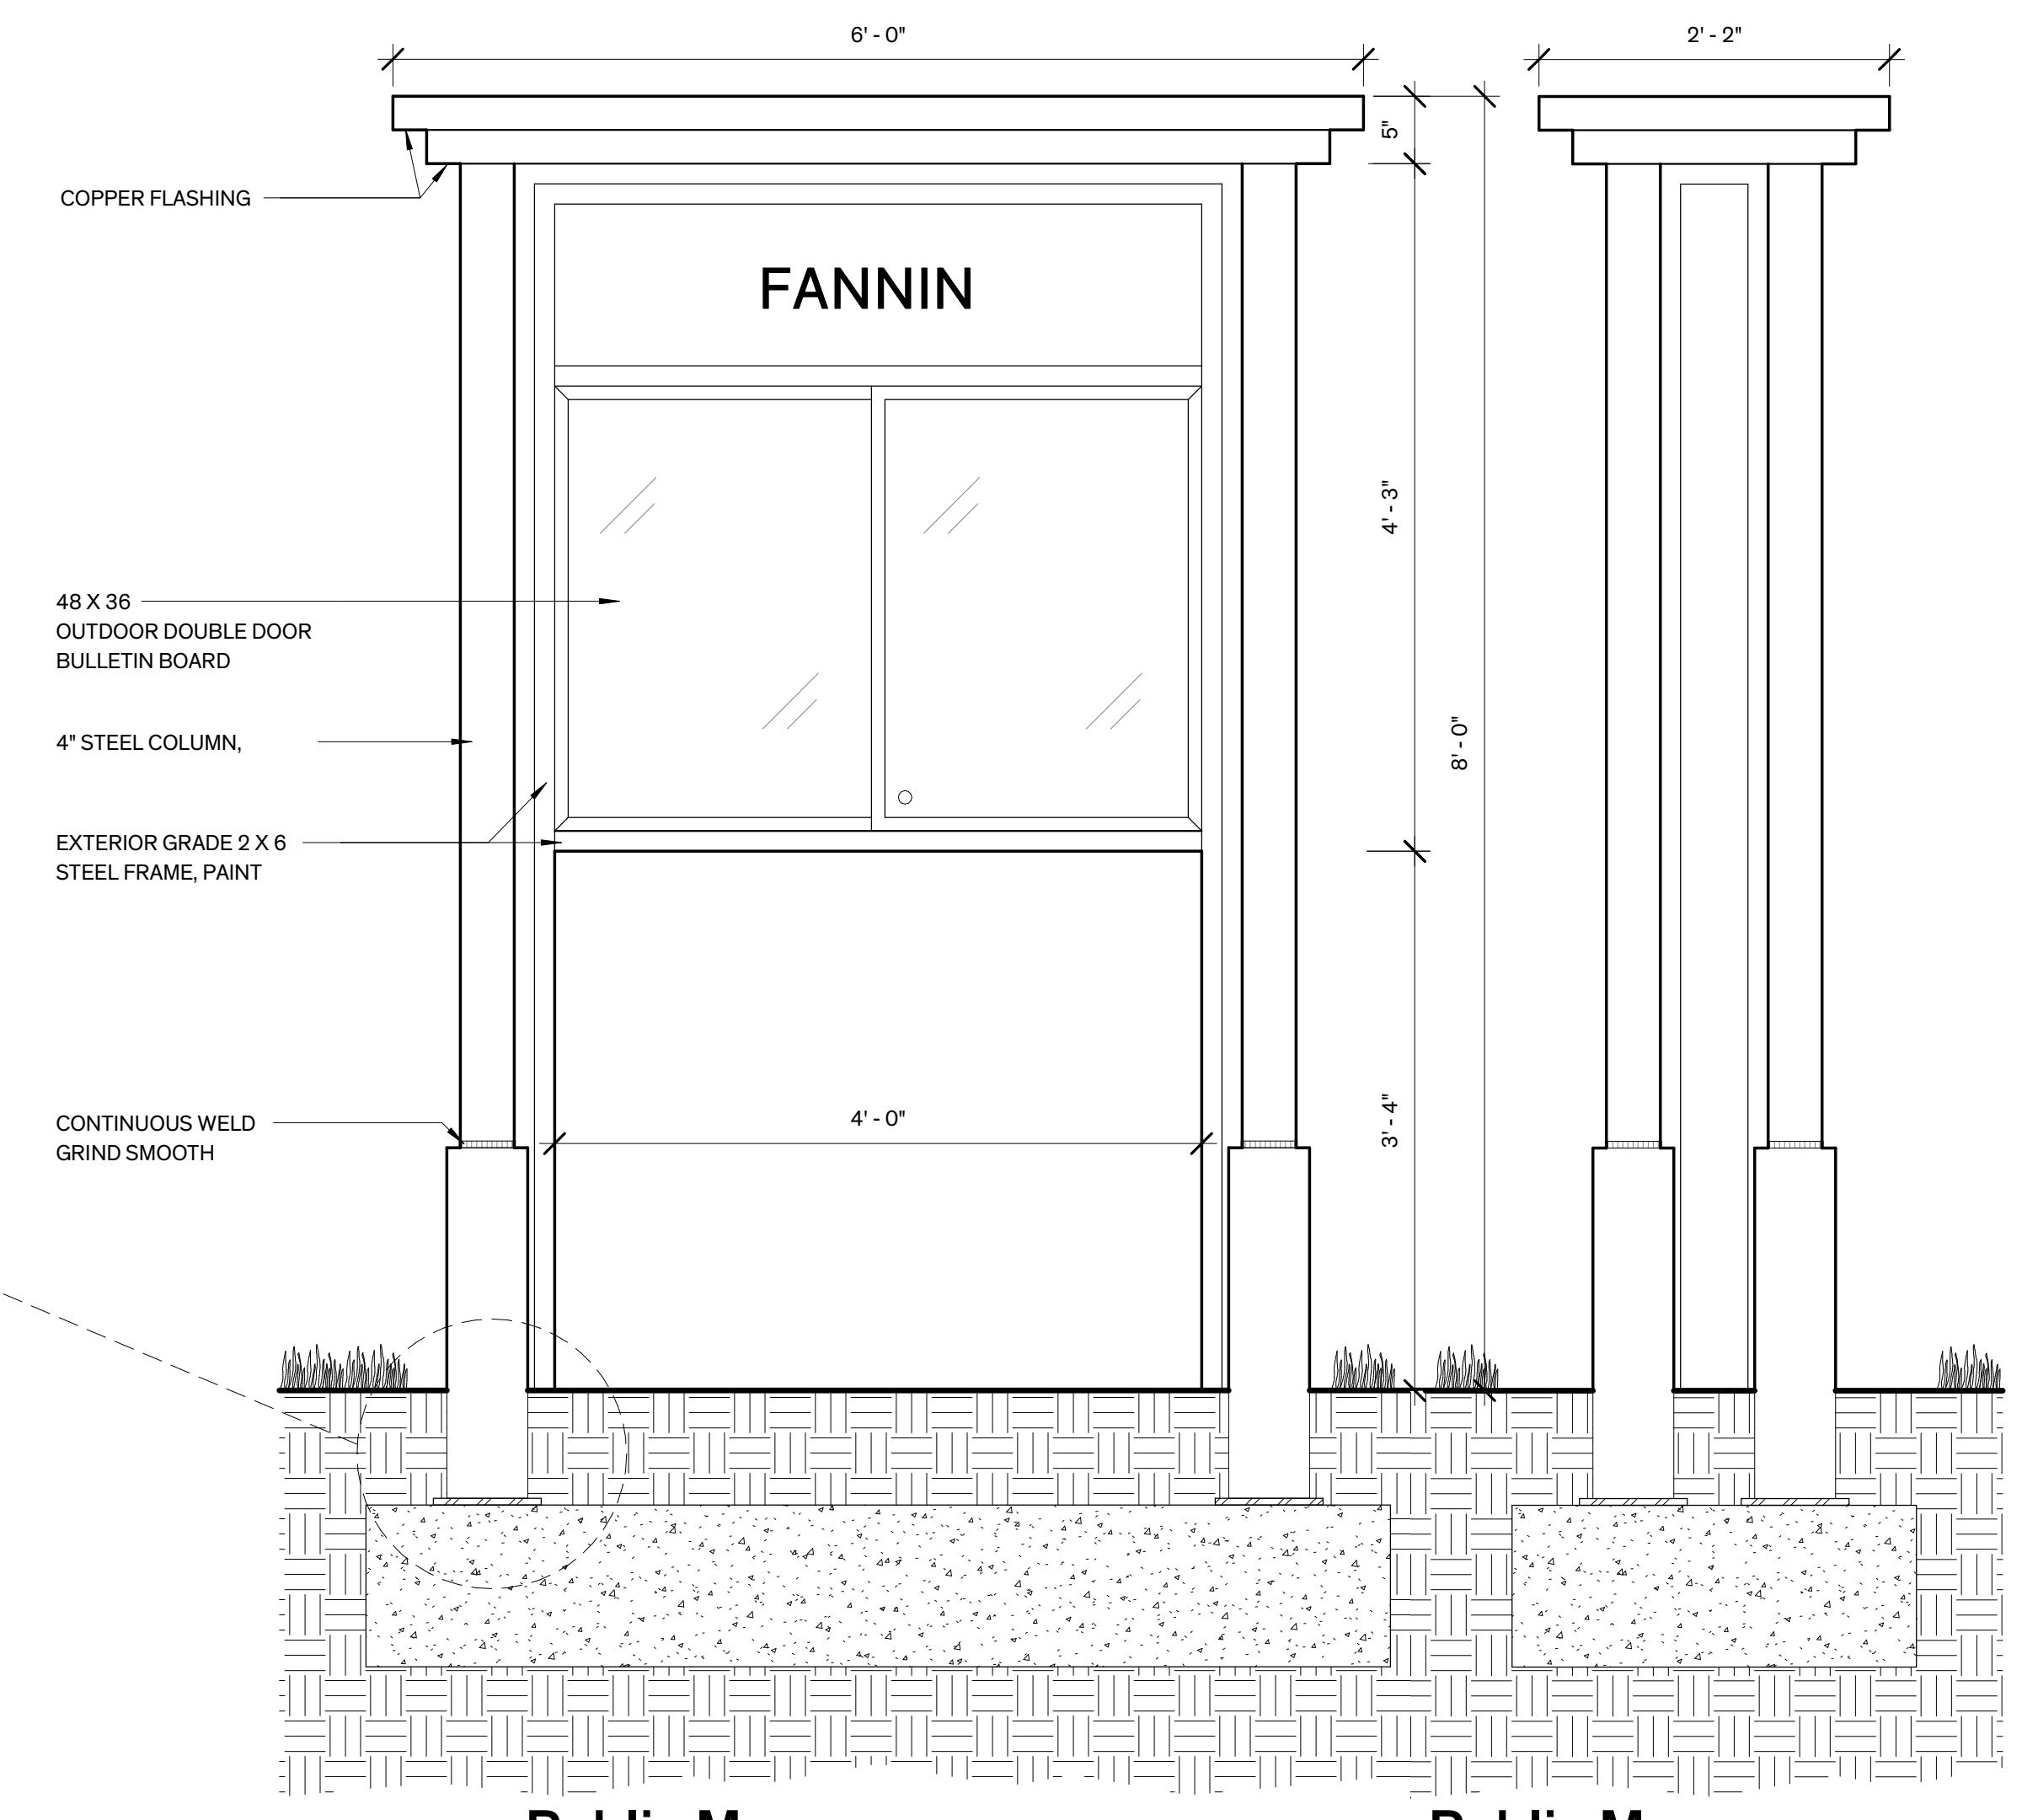


**5 Public Message Board Front Elevation**  
 1" = 1'-0"


**4 Public Message Board Side Elevation**  
 1" = 1'-0"

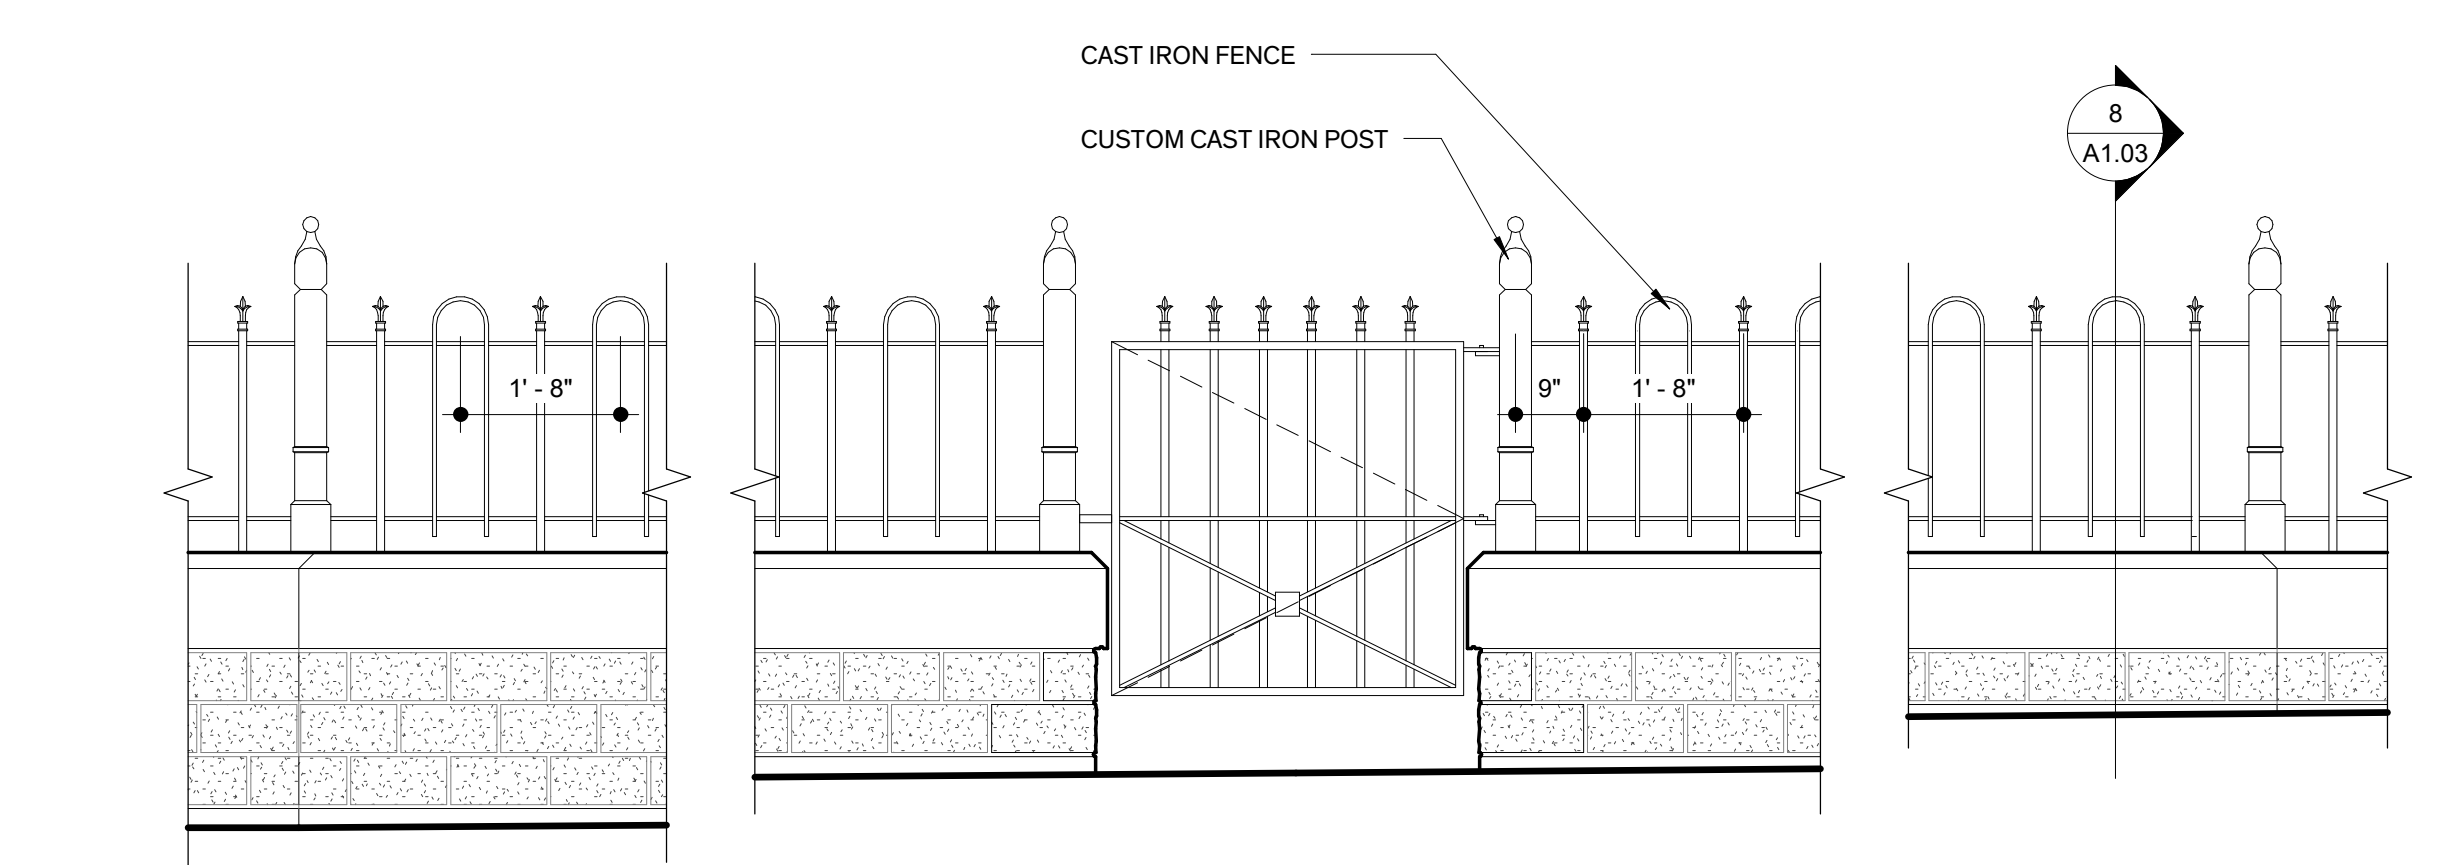

**3 Alternate #1 Stone Wall Elevation**  
 1/2" = 1'-0"

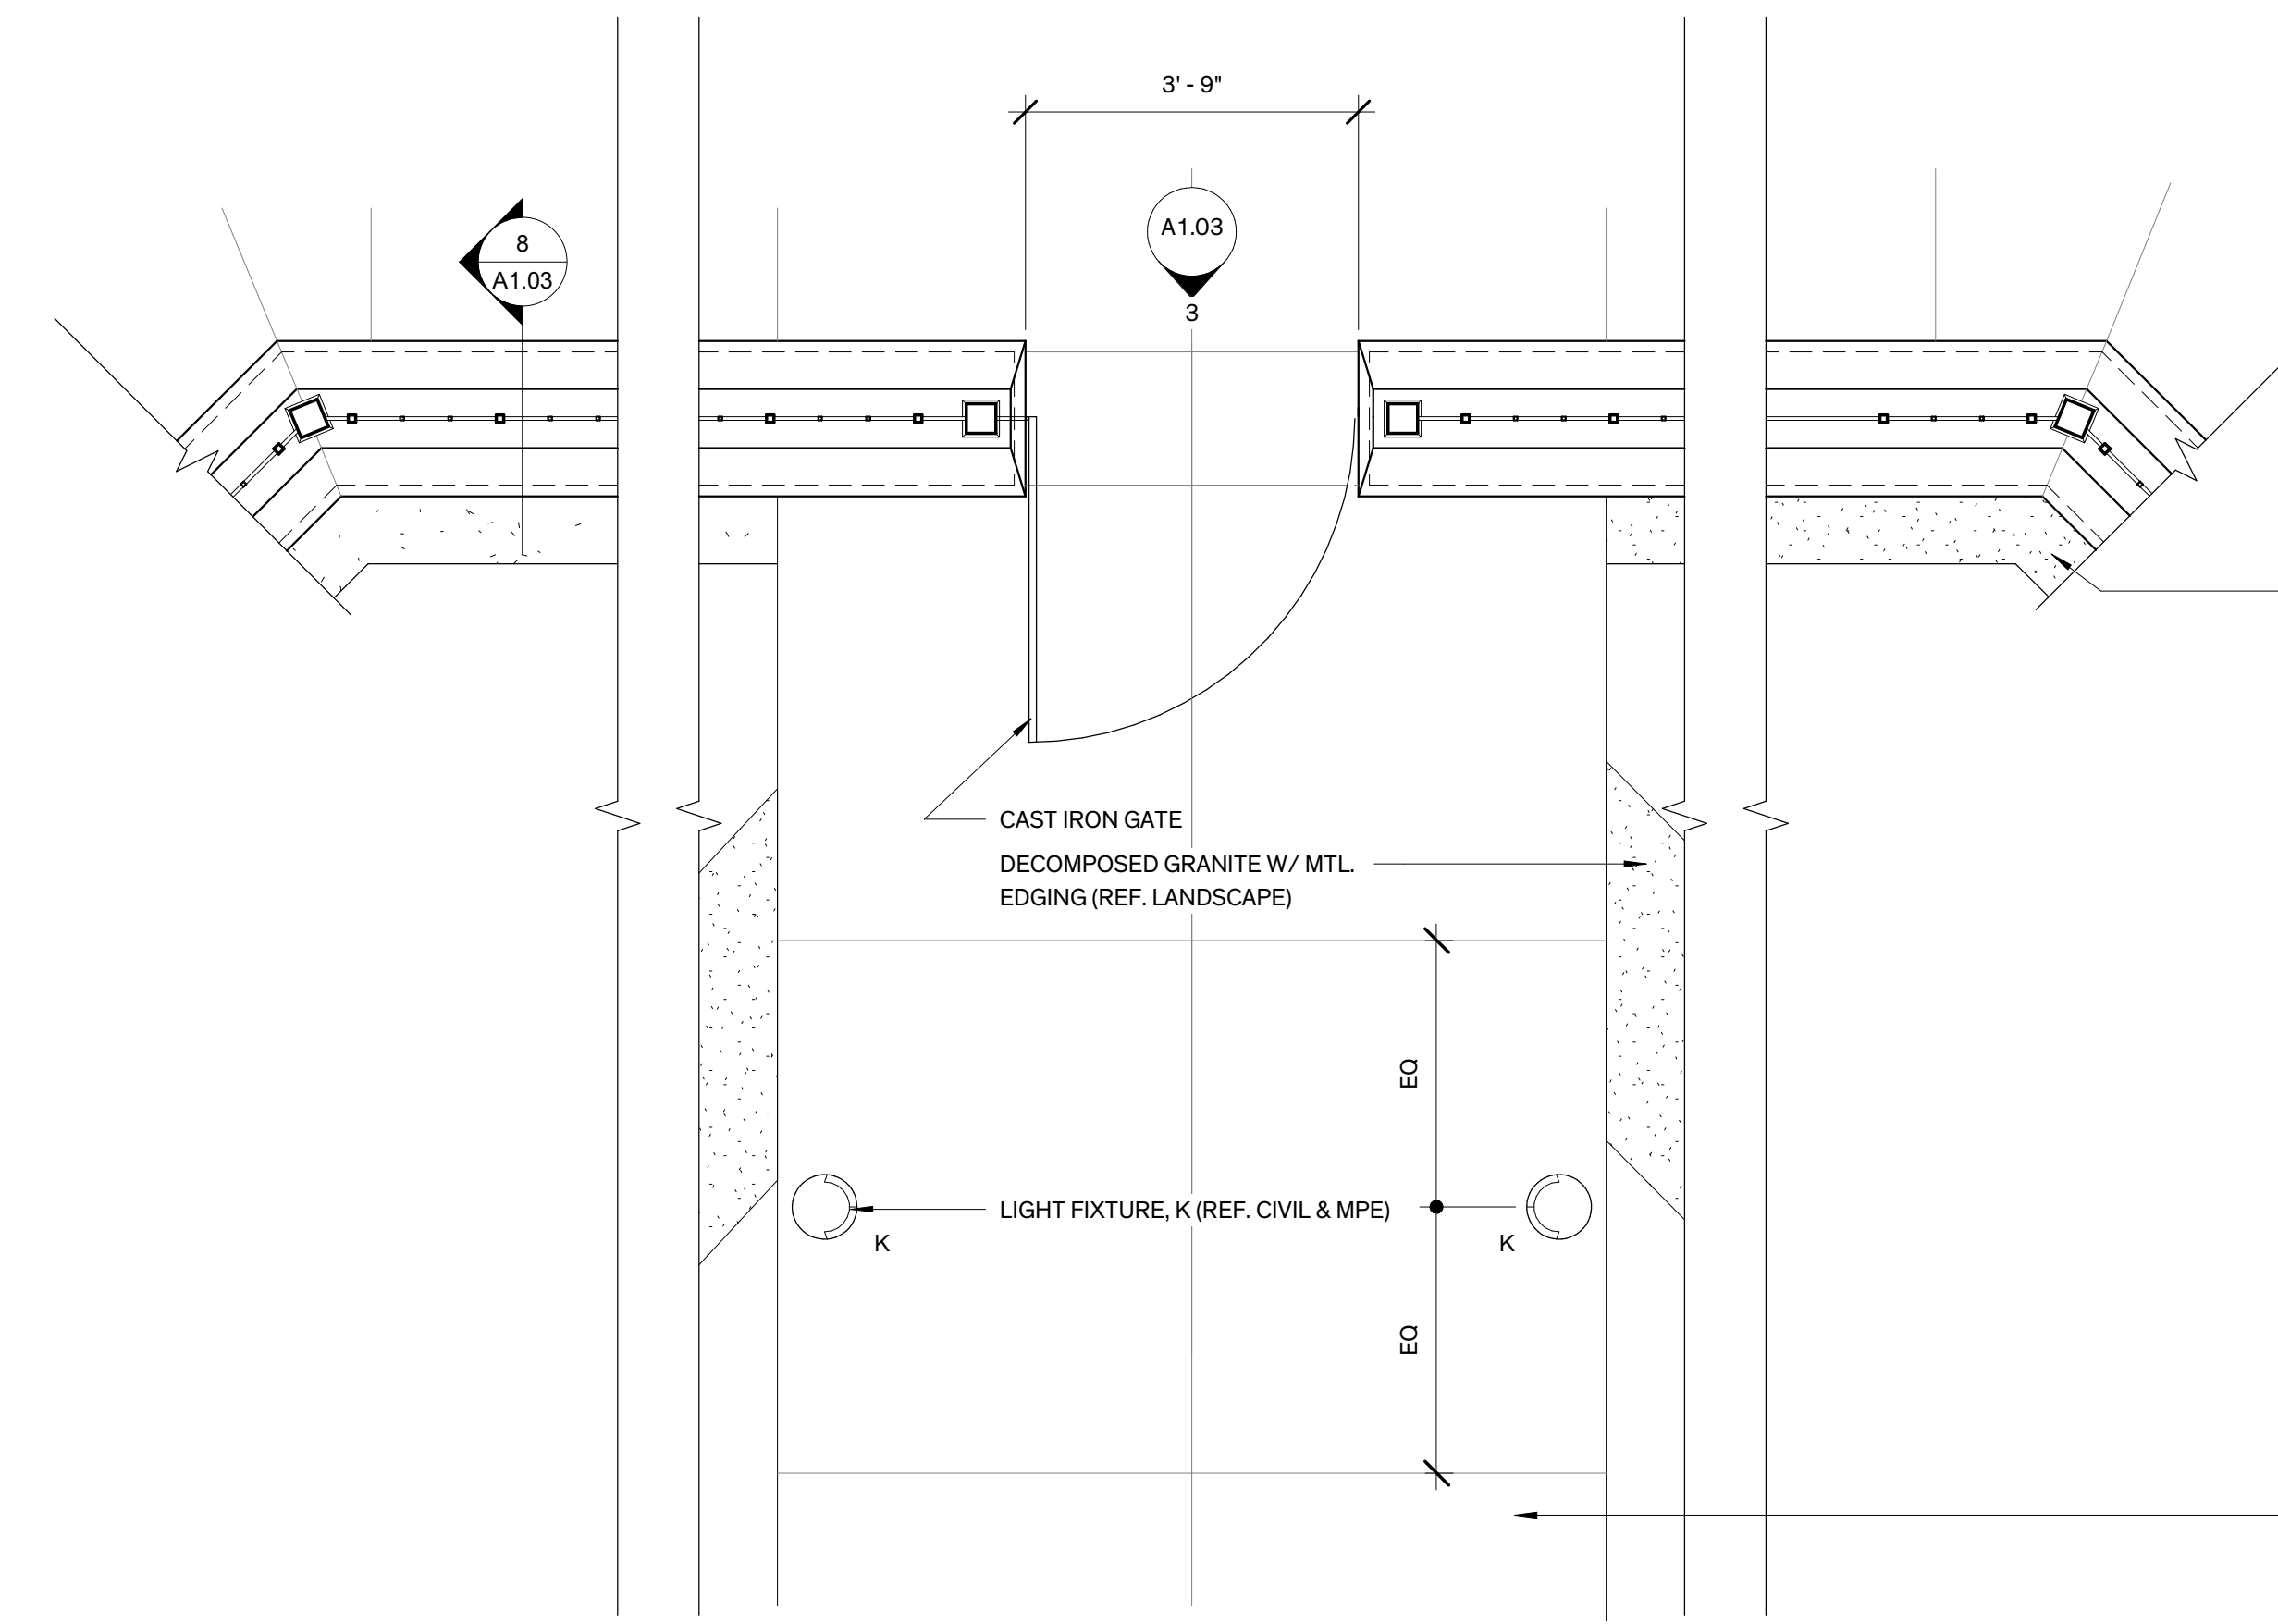

**2 Alternate #1 Stone Wall Plan**  
 1/2" = 1'-0"

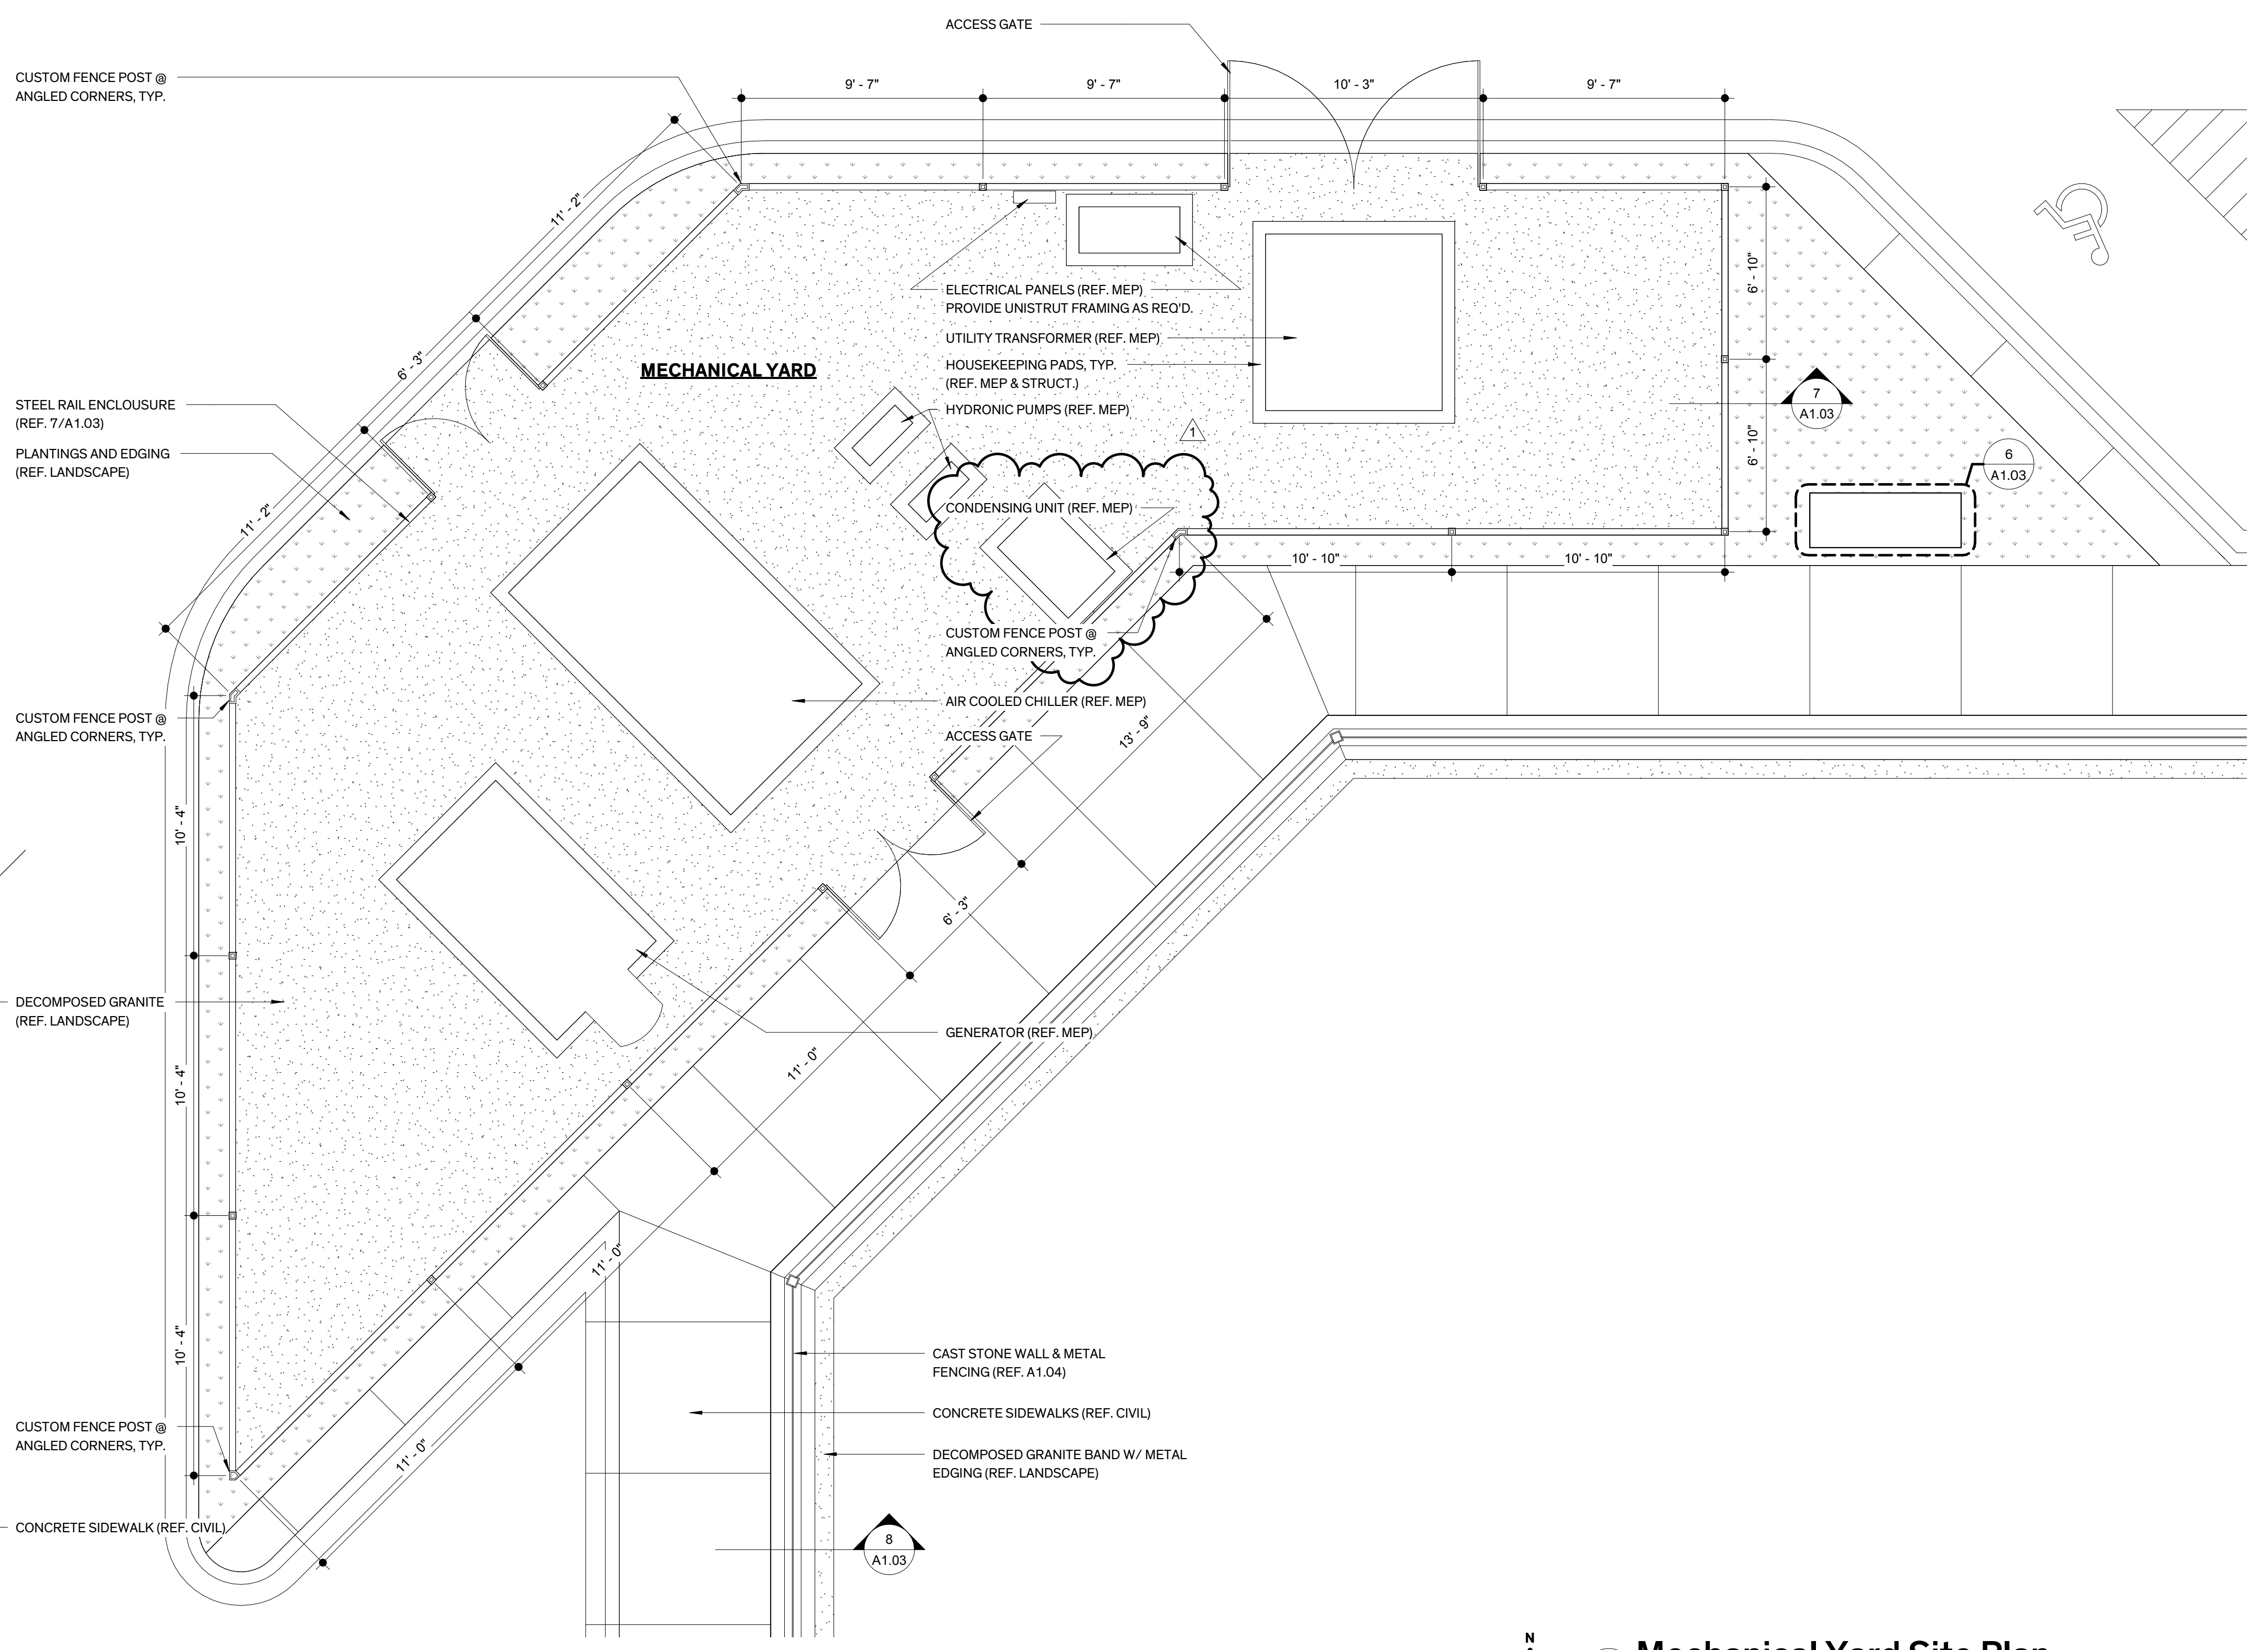

**1 Mechanical Yard Site Plan**  
 1/4" = 1'-0"



FANNIN COUNTY  
 COURTHOUSE  
 INTERIOR & EXTERIOR RESTORATION

101 E. Sam Rayburn Drive  
 Bonham, Texas 75418

**COPYRIGHT**  
 The Contractor shall verify and be responsible for all dimensions. DO NOT scale the drawing. Any errors or omissions shall be reported to Architexas without delay. The Copyrights to all designs and drawings are the property of Architexas. Reproduction or use for any purpose other than that authorized by Architexas is forbidden.

**REVISION HISTORY**  
 1 Oct. 16, 2018 Addendum #1

ISSUED FOR CONSTRUCTION



#18326 9/21/2018

Architexas No. 1737 Date SEPT. 21, 2018


Sheet Name SITE DETAILS

Sheet Number



**GENERAL NOTES**

- GENERAL**
- FINISH EXPOSED SURFACES UNLESS NOTED OTHERWISE. THE CONTRACTOR SHALL ASSUME FULL RESPONSIBILITY FOR THE COORDINATION OF THE COMPLETE FINISH-OUT OF THE PROJECT. ANY SURFACES WHICH DO NOT HAVE A SPECIFIC FINISH NOTED, NOR ARE NOTED TO REMAIN UNFINISHED SHALL BE BROUGHT TO THE ATTENTION OF THE ARCHITECT AND FINISHED PER THE ARCHITECT'S INSTRUCTION.
  - CONTRACTOR TO FIELD VERIFY EXISTING WALL THICKNESS.
  - FINISH FLOOR ELEVATIONS:
    - EXISTING ELEVATIONS AND CEILING HEIGHTS ARE APPROXIMATE AND ARE TO BE VERIFIED IN THE FIELD BY THE CONTRACTOR.
    - FINAL ELEVATIONS AND CEILING HEIGHTS WILL BE DETERMINED ONCE FINISH FLOOR LEVELS ARE ESTABLISHED IN CORRIDORS.
  - DIMENSIONING AT WALLS SHOWN IS FINISHED FACE OF WALL TO FINISHED FACE OF WALL UNLESS NOTED OTHERWISE.
  - THE EXISTING METAL CEILING PAINT IS KNOWN TO CONTAIN LEAD. WASTE GENERATED BY COATING REMOVAL PROCESS SHALL BE CLASSIFIED AS HAZARDOUS MATERIAL AND SHALL BE REMOVED IN ACCORDANCE WITH EPA AND OSHA GUIDELINES.
  - REFERENCE FINISH SCHEDULE ON SHEET A6.01 FOR ROOM FINISH AND PAINT COLOR SELECTIONS.
  - REFERENCE DOOR AND WINDOW SCHEDULES ON SHEETS A6.04 THRU A6.10 FOR SCOPE OF WORK ASSOCIATED WITH DOORS AND WINDOWS.
- CONDUIT AT MASONRY WALLS**
- SURFACE MOUNT CONDUIT AND J-BOXES PARALLEL TO FLOOR AND WALLS. PROVIDE TIGHT 90 DEGREE BENDS AT CORNERS AND GANG TIGHT AND PARALLEL TO OTHER PIPING AND CONDUIT WHERE POSSIBLE.
  - EXPOSED CONDUIT, PIPING, WIRING, ASSOCIATED FASTENERS, ETC. ARE TO BE PRIMED AND PAINTED.
  - ALLOW FOR (3) PAINT COLORS ON MEP COMPONENTS. MECHANICAL COMPONENTS WILL BE ON COLOR, ELECTRICAL COMPONENTS WILL BE A SECOND COLOR, AND PLUMBING COMPONENTS WILL BE A THIRD COLOR.
- CONDUIT AT PLASTER WALLS**
- CONCEAL CONDUIT BEHIND FINISH FACE OF PLASTER. ROUT PLASTER AND UNDERLYING MASONRY TO ACCEPT CONDUIT AND TO ALLOW FOR A FULL APPLICATION OF LATH AND PLASTER. PLASTER IS TO MATCH EXISTING ADJACENT SURFACES.
  - ELECTRICAL BOXES AND ASSOCIATED ELEMENTS MUST BE RECESSED INTO WALLS SO THAT COVER PLATES AND DEVICES ARE FLUSH WITH THE FINISH SURFACE OF THE WALL.
  - PREPARE AND FINISH PLASTER WALLS AS REQUIRED TO MATCH ORIGINAL PLASTER FINISH.

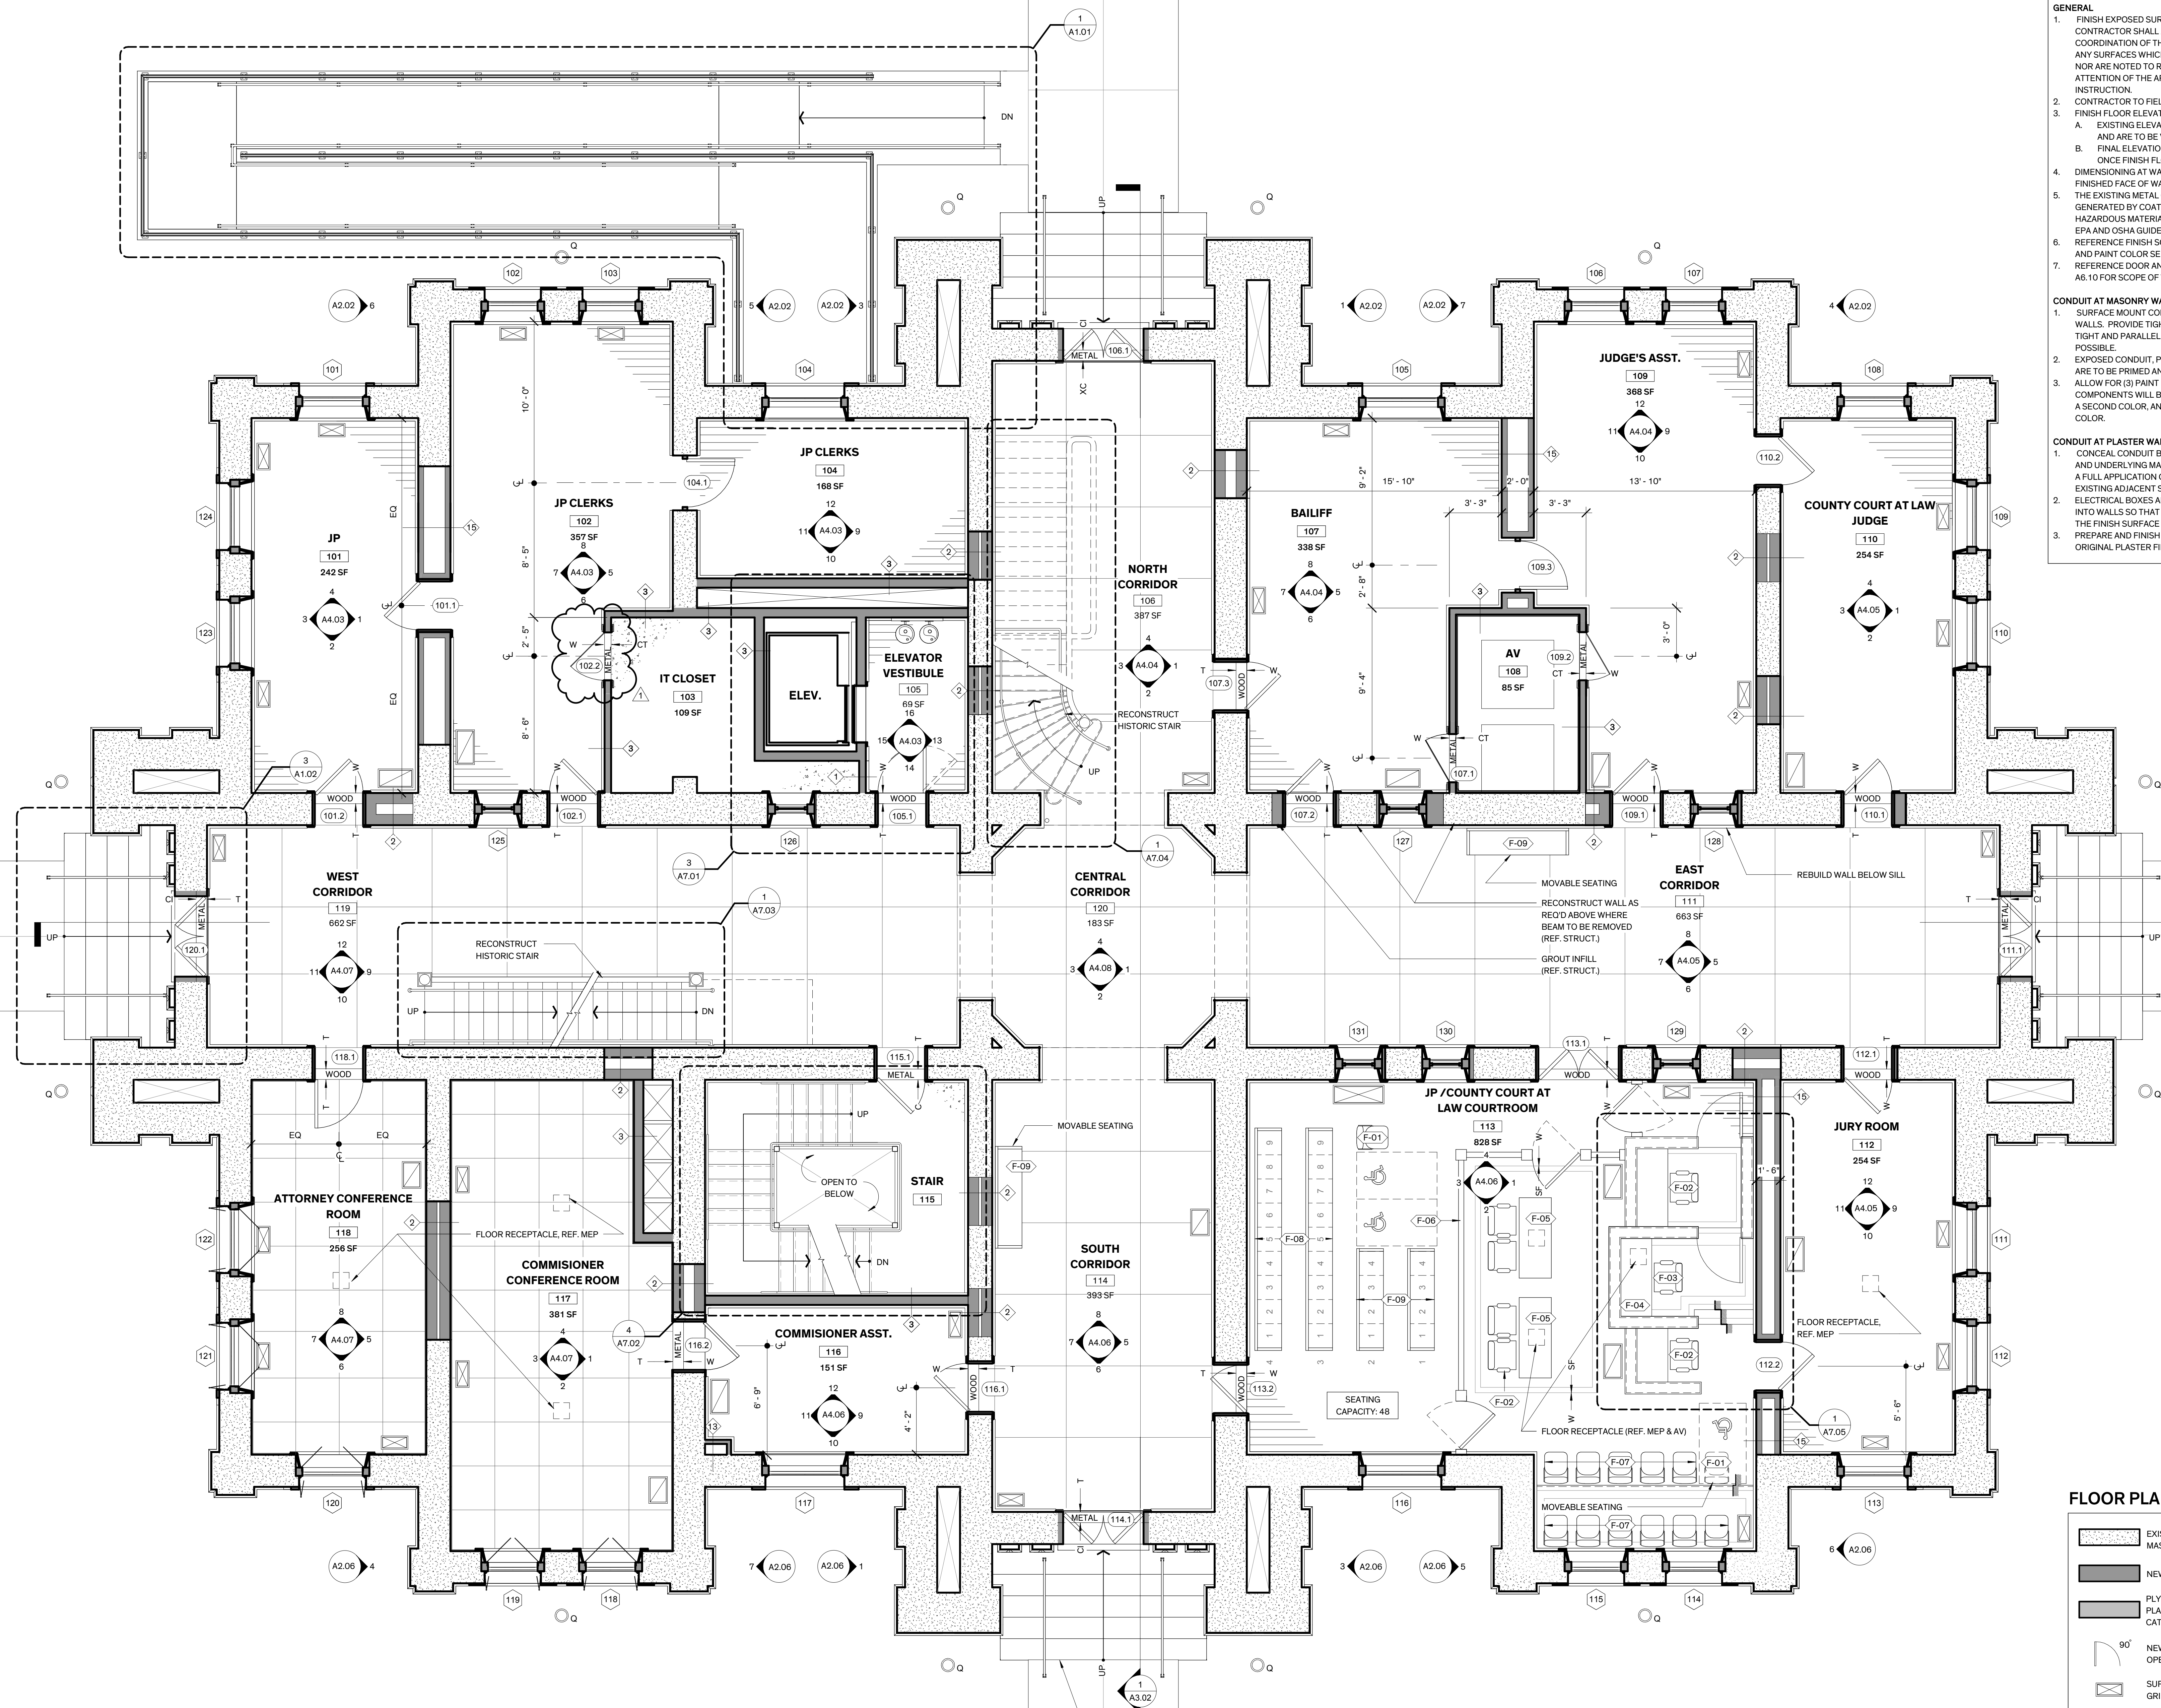

**1 Ground Level Floor Plan**  
 1/4" = 1'-0"

**FLOOR PLAN LEGEND**

	EXISTING MASONRY WALL		CONC. CAP/ CONC. FINISH FLOOR
	NEW WALL		BUILT-UP STONE MASONRY WALL
	PLYWOOD PLATFORMS/ CATWALKS		FURNITURE TAG (REF. FURNISHING SCHEDULE)
	NEW DOOR OPENING		HISTORIC DOOR OPENING
	SUPPLY AIR GRILLE, REF. MEP		RETURN AIR GRILLE, REF. MEP
	EXISTING CONCRETE FLOOR		TILE FLOOR
	CONCRETE FLOOR		CAST IRON
	WOOD FLOOR		CONCRETE TOPPING
	CUSTOM SHEET FLOORING		

TEXAS HISTORICAL COMMISSION  
*real places telling real stories*



FANNIN COUNTY COURTHOUSE  
 INTERIOR & EXTERIOR RESTORATION

101 E. Sam Rayburn Drive  
 Bonham, Texas 75418

**COPYRIGHT**  
 The Contractor shall verify and be responsible for all dimensions. DO NOT scale the drawing. Any errors or omissions shall be reported to Architexas without delay. The Copyrights to all designs and drawings are the property of Architexas. Reproduction or use for any purpose other than that authorized by Architexas is forbidden.

**REVISION HISTORY**  
 1 Oct. 16, 2018 Addendum #1

ISSUED FOR CONSTRUCTION



#18326 9/21/2018

Architexas No. 1737 Date SEPT. 21, 2018


Sheet Name GROUND LEVEL FLOOR PLAN

Sheet Number AI.06



**GENERAL NOTES**

- GENERAL**
- FINISH EXPOSED SURFACES UNLESS NOTED OTHERWISE. THE CONTRACTOR SHALL ASSUME FULL RESPONSIBILITY FOR THE COORDINATION OF THE COMPLETE FINISH-OUT OF THE PROJECT. ANY SURFACES WHICH DO NOT HAVE A SPECIFIC FINISH NOTED, NOR ARE NOTED TO REMAIN UNFINISHED SHALL BE BROUGHT TO THE ATTENTION OF THE ARCHITECT AND FINISHED PER THE ARCHITECT'S INSTRUCTION.
  - CONTRACTOR TO FIELD VERIFY EXISTING WALL THICKNESS.
  - FINISH FLOOR ELEVATIONS:
    - EXISTING ELEVATIONS AND CEILING HEIGHTS ARE APPROXIMATE AND ARE TO BE VERIFIED IN THE FIELD BY THE CONTRACTOR.
    - FINAL ELEVATIONS AND CEILING HEIGHTS WILL BE DETERMINED ONCE FINISH FLOOR LEVELS ARE ESTABLISHED IN CORRIDORS.
  - DIMENSIONING AT WALLS SHOWN IS FINISHED FACE OF WALL TO FINISHED FACE OF WALL UNLESS NOTED OTHERWISE.
  - THE EXISTING METAL CEILING PAINT IS KNOWN TO CONTAIN LEAD. WASTE GENERATED BY COATING REMOVAL PROCESS SHALL BE CLASSIFIED AS HAZARDOUS MATERIAL AND SHALL BE REMOVED IN ACCORDANCE WITH EPA AND OSHA GUIDELINES.
  - REFERENCE FINISH SCHEDULE ON SHEET A6.01 FOR ROOM FINISH AND PAINT COLOR SELECTIONS.
  - REFERENCE DOOR AND WINDOW SCHEDULES ON SHEETS A6.04 THRU A6.10 FOR SCOPE OF WORK ASSOCIATED WITH DOORS AND WINDOWS.
- CONDUIT AT MASONRY WALLS**
- SURFACE MOUNT CONDUIT AND J-BOXES PARALLEL TO FLOOR AND WALLS. PROVIDE TIGHT 90 DEGREE BENDS AT CORNERS AND GANG TIGHT AND PARALLEL TO OTHER PIPING AND CONDUIT WHERE POSSIBLE.
  - EXPOSED CONDUIT, PIPING, WIRING, ASSOCIATED FASTENERS, ETC. ARE TO BE PRIMED AND PAINTED.
  - ALLOW FOR (3) PAINT COLORS ON MEP COMPONENTS. MECHANICAL COMPONENTS WILL BE ON COLOR, ELECTRICAL COMPONENTS WILL BE A SECOND COLOR, AND PLUMBING COMPONENTS WILL BE A THIRD COLOR.
- CONDUIT AT PLASTER WALLS**
- CONCEAL CONDUIT BEHIND FINISH FACE OF PLASTER. ROUT PLASTER AND UNDERLYING MASONRY TO ACCEPT CONDUIT AND TO ALLOW FOR A FULL APPLICATION OF LATH AND PLASTER. PLASTER IS TO MATCH EXISTING ADJACENT SURFACES.
  - ELECTRICAL BOXES AND ASSOCIATED ELEMENTS MUST BE RECESSED INTO WALLS SO THAT COVER PLATES AND DEVICES ARE FLUSH WITH THE FINISH SURFACE OF THE WALL.
  - PREPARE AND FINISH PLASTER WALLS AS REQUIRED TO MATCH ORIGINAL PLASTER FINISH.

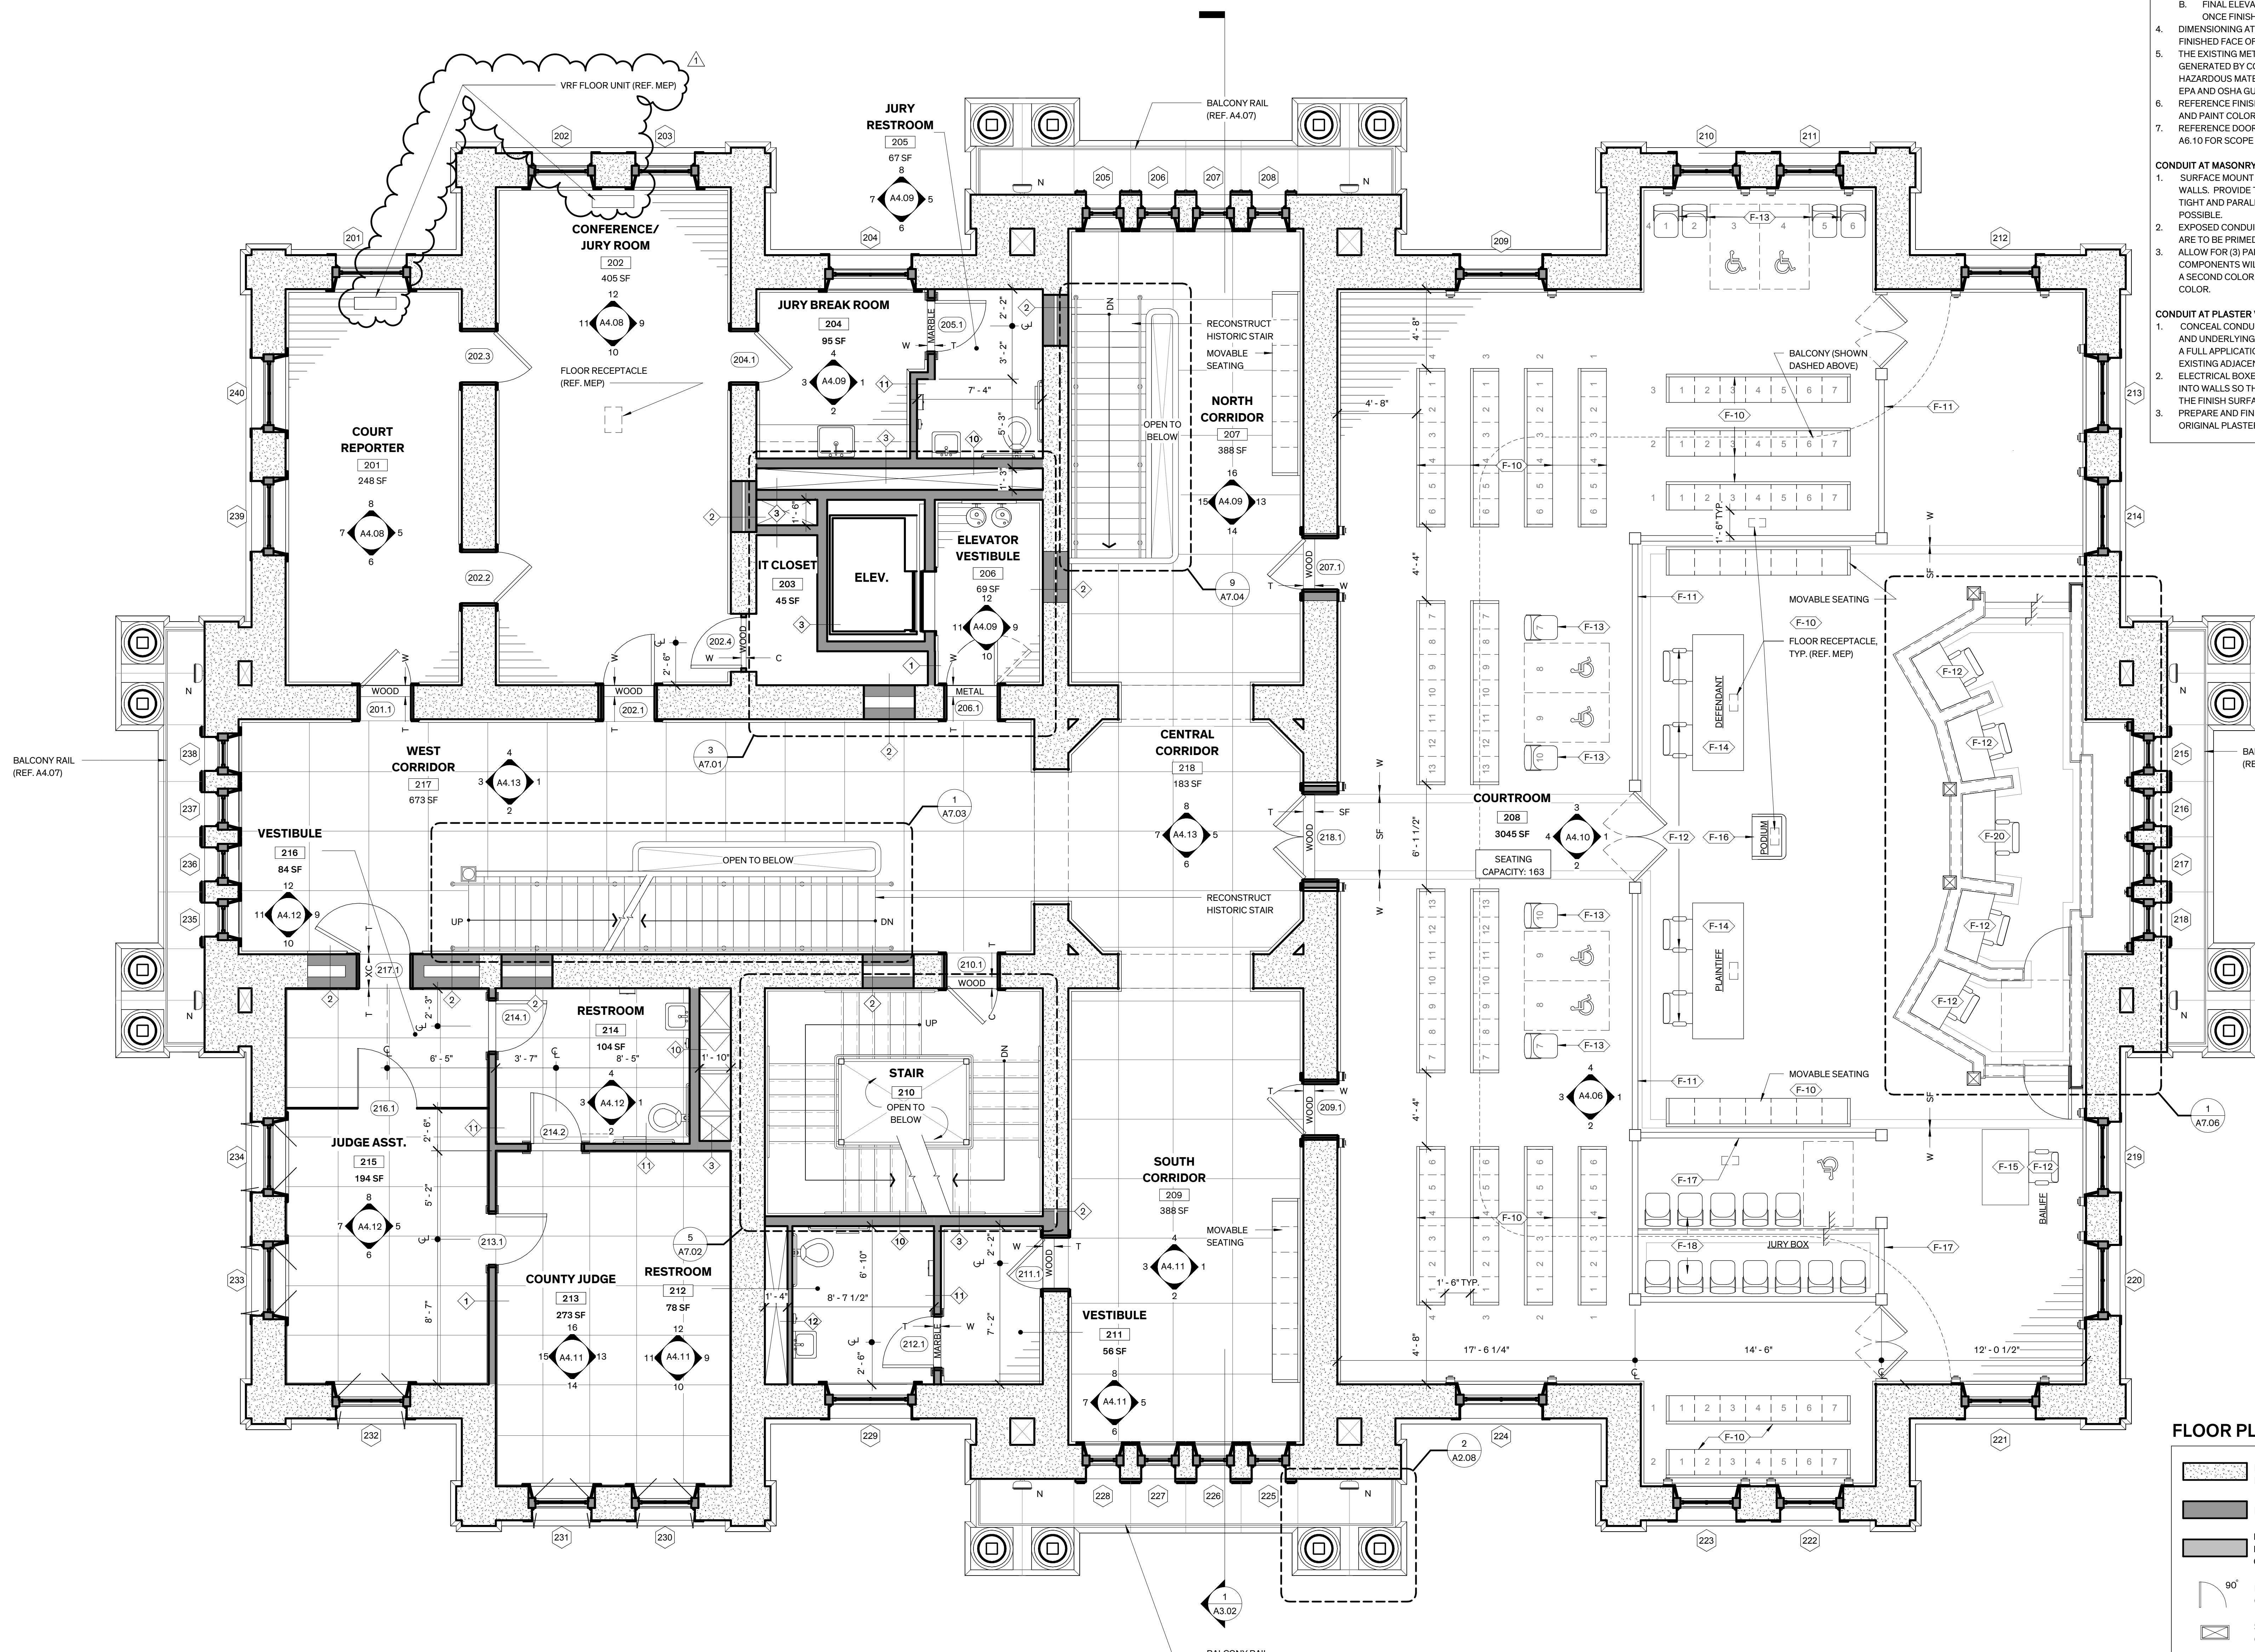

**1 Second Level Floor Plan**  
 1/4" = 1'-0"

**FLOOR PLAN LEGEND**

	EXISTING MASONRY WALL		CONC. CAP/ CONC. FINISH FLOOR
	NEW WALL		BUILT-UP STONE MASONRY WALL
	PLYWOOD PLATFORMS/ CATWALKS		FURNITURE TAG (REF. FURNISHING SCHEDULE)
	90° NEW DOOR OPENING		45° HISTORIC DOOR OPENING
	SUPPLY AIR GRILLE, REF. MEP		RETURN AIR GRILLE, REF. MEP
	XC EXISTING CONCRETE FLOOR		T TILE FLOOR
	C CONCRETE FLOOR		CI CAST IRON
	W WOOD FLOOR		CT CONCRETE TOPPING
	SF CUSTOM SHEET FLOORING		

TEXAS HISTORICAL COMMISSION  
*real places telling real stories*




FANNIN COUNTY  
 COURTHOUSE  
 INTERIOR & EXTERIOR RESTORATION

101 E. Sam Rayburn Drive  
 Bonham, Texas 75418

**COPYRIGHT**  
 The Contractor shall verify and be responsible for all dimensions. DO NOT scale the drawing. Any errors or omissions shall be reported to Architexas without delay. The Copyrights to all designs and drawings are the property of Architexas. Reproduction or use for any purpose other than that authorized by Architexas is forbidden.

**REVISION HISTORY**  
 1 Oct. 16, 2018 Addendum #1

ISSUED FOR CONSTRUCTION

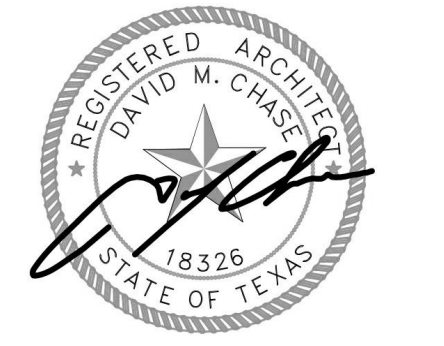

#18326 9/21/2018

Architexas No. 1737 Date SEPT. 21, 2018


Sheet Name SECOND LEVEL FLOOR PLAN

Sheet Number A1.08



**GENERAL NOTES**

- GENERAL**
- FINISH EXPOSED SURFACES UNLESS NOTED OTHERWISE. THE CONTRACTOR SHALL ASSUME FULL RESPONSIBILITY FOR THE COORDINATION OF THE COMPLETE FINISH-OUT OF THE PROJECT. ANY SURFACES WHICH DO NOT HAVE A SPECIFIC FINISH NOTED, NOR ARE NOTED TO REMAIN UNFINISHED SHALL BE BROUGHT TO THE ATTENTION OF THE ARCHITECT AND FINISHED PER THE ARCHITECT'S INSTRUCTION.
  - CONTRACTOR TO FIELD VERIFY EXISTING WALL THICKNESS.
  - FINISH FLOOR ELEVATIONS:
    - EXISTING ELEVATIONS AND CEILING HEIGHTS ARE APPROXIMATE AND ARE TO BE VERIFIED IN THE FIELD BY THE CONTRACTOR.
    - FINAL ELEVATIONS AND CEILING HEIGHTS WILL BE DETERMINED ONCE FINISH FLOOR LEVELS ARE ESTABLISHED IN CORRIDORS.
  - DIMENSIONING AT WALLS SHOWN IS FINISHED FACE OF WALL TO FINISHED FACE OF WALL UNLESS NOTED OTHERWISE.
  - THE EXISTING METAL CEILING PAINT IS KNOWN TO CONTAIN LEAD. WASTE GENERATED BY COATING REMOVAL PROCESS SHALL BE CLASSIFIED AS HAZARDOUS MATERIAL AND SHALL BE REMOVED IN ACCORDANCE WITH EPA AND OSHA GUIDELINES.
  - REFERENCE FINISH SCHEDULE ON SHEET A6.01 FOR ROOM FINISH AND PAINT COLOR SELECTIONS.
  - REFERENCE DOOR AND WINDOW SCHEDULES ON SHEETS A6.04 THRU A6.10 FOR SCOPE OF WORK ASSOCIATED WITH DOORS AND WINDOWS.
- CONDUIT AT MASONRY WALLS**
- SURFACE MOUNT CONDUIT AND J-BOXES PARALLEL TO FLOOR AND WALLS. PROVIDE TIGHT 90 DEGREE BENDS AT CORNERS AND GANG TIGHT AND PARALLEL TO OTHER PIPING AND CONDUIT WHERE POSSIBLE.
  - EXPOSED CONDUIT, PIPING, WIRING, ASSOCIATED FASTENERS, ETC. ARE TO BE PRIMED AND PAINTED.
  - ALLOW FOR (3) PAINT COLORS ON MEP COMPONENTS. MECHANICAL COMPONENTS WILL BE ON COLOR, ELECTRICAL COMPONENTS WILL BE A SECOND COLOR, AND PLUMBING COMPONENTS WILL BE A THIRD COLOR.
- CONDUIT AT PLASTER WALLS**
- CONCEAL CONDUIT BEHIND FINISH FACE OF PLASTER. ROUT PLASTER AND UNDERLYING MASONRY TO ACCEPT CONDUIT AND TO ALLOW FOR A FULL APPLICATION OF LATH AND PLASTER. PLASTER IS TO MATCH EXISTING ADJACENT SURFACES.
  - ELECTRICAL BOXES AND ASSOCIATED ELEMENTS MUST BE RECESSED INTO WALLS SO THAT COVER PLATES AND DEVICES ARE FLUSH WITH THE FINISH SURFACE OF THE WALL.
  - PREPARE AND FINISH PLASTER WALLS AS REQUIRED TO MATCH ORIGINAL PLASTER FINISH.

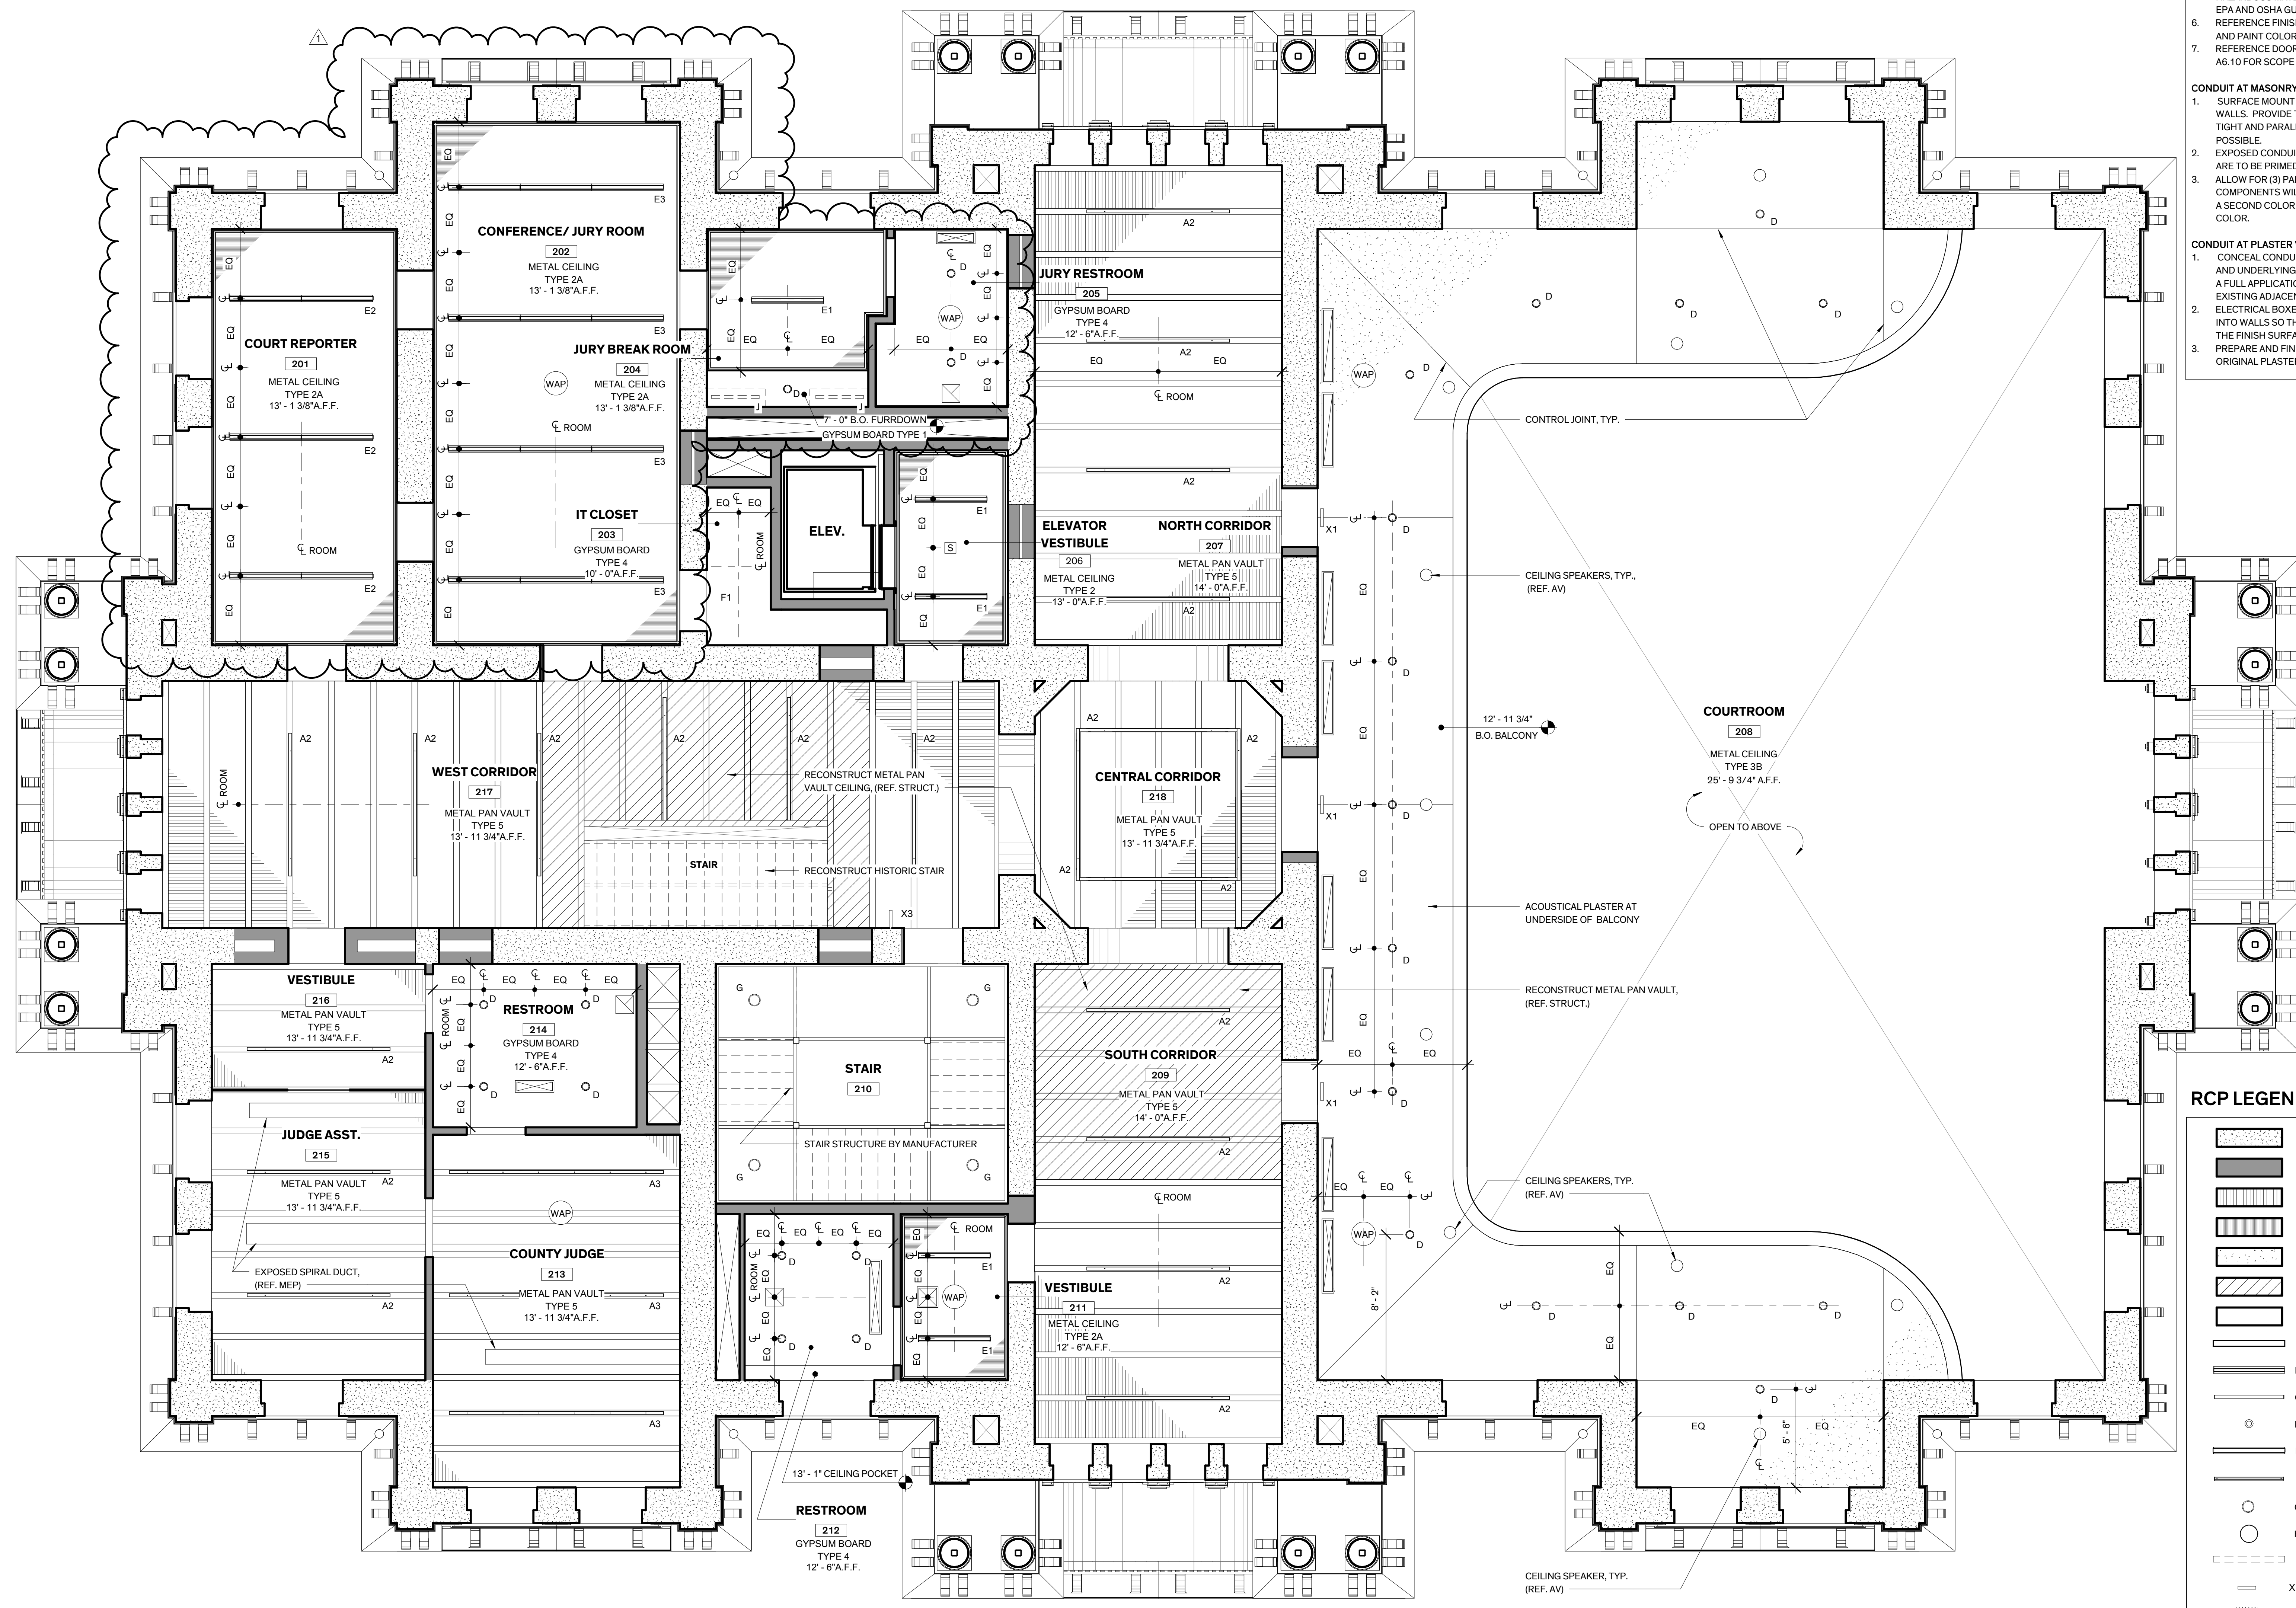

**RCP LEGEND**

- EXISTING MASONRY WALL
- NEW WALL
- EXISTING METAL PAN VAULT
- METAL CEILING
- ACOUSTICAL PLASTER CEILING
- RECONSTRUCTED FLOOR SYSTEM, REF. STRUCT.
- GYPSUM BOARD CEILING
- A INDIRECT / DIRECT LINEAR PENDANT FIXTURE
- B RECESSED LINEAR FIXTURE
- C SURFACE MOUNT LINEAR FIXTURE
- D RECESSED DOWNLIGHT FIXTURE
- E LINEAR PENDANT FIXTURE
- F SURFACE MOUNT STRIPLIGHT
- G SURFACE MOUNT FIXTURE
- H PENDANT FIXTURE
- J UNDERMOUNT CABINET FIXTURE
- X1 CEILING MOUNT EXIT LIGHT
- X2 WALL MOUNT EXIT LIGHT
- X3 SIDE MOUNT EXIT LIGHT
- SMOKE DETECTOR, REF. TECH
- WIRELESS ACCESS POINT, REF. TECH
- EXHAUST AIR GRILLE, REF. MEP
- RETURN AIR GRILLE, REF. MEP
- SUPPLY AIR GRILLE, REF. MEP

1 **Second Level RCP**  
 1/4" = 1'-0"




**FANNIN COUNTY COURTHOUSE**  
 INTERIOR & EXTERIOR RESTORATION

101 E. Sam Rayburn Drive  
 Bonham, Texas 75418

**COPYRIGHT**  
 The Contractor shall verify and be responsible for all dimensions. DO NOT scale the drawing. Any errors or omissions shall be reported to Architexas without delay. The Copyrights to all designs and drawings are the property of Architexas. Reproduction or use for any purpose other than that authorized by Architexas is forbidden.

**REVISION HISTORY**  
 1 Oct. 16, 2018 Addendum #1

ISSUED FOR CONSTRUCTION

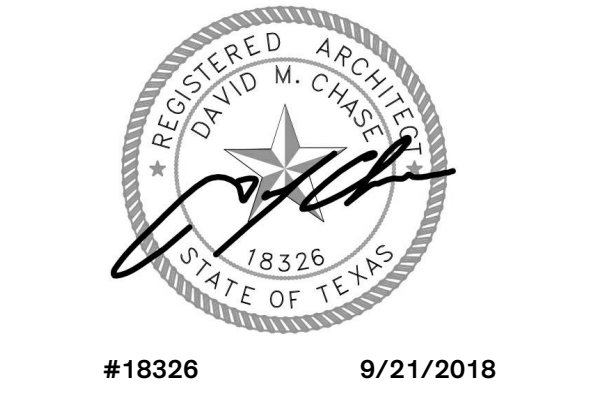


Architexas No. 1737 Date SEPT. 21, 2018


Sheet Name SECOND LEVEL RCP

Sheet Number



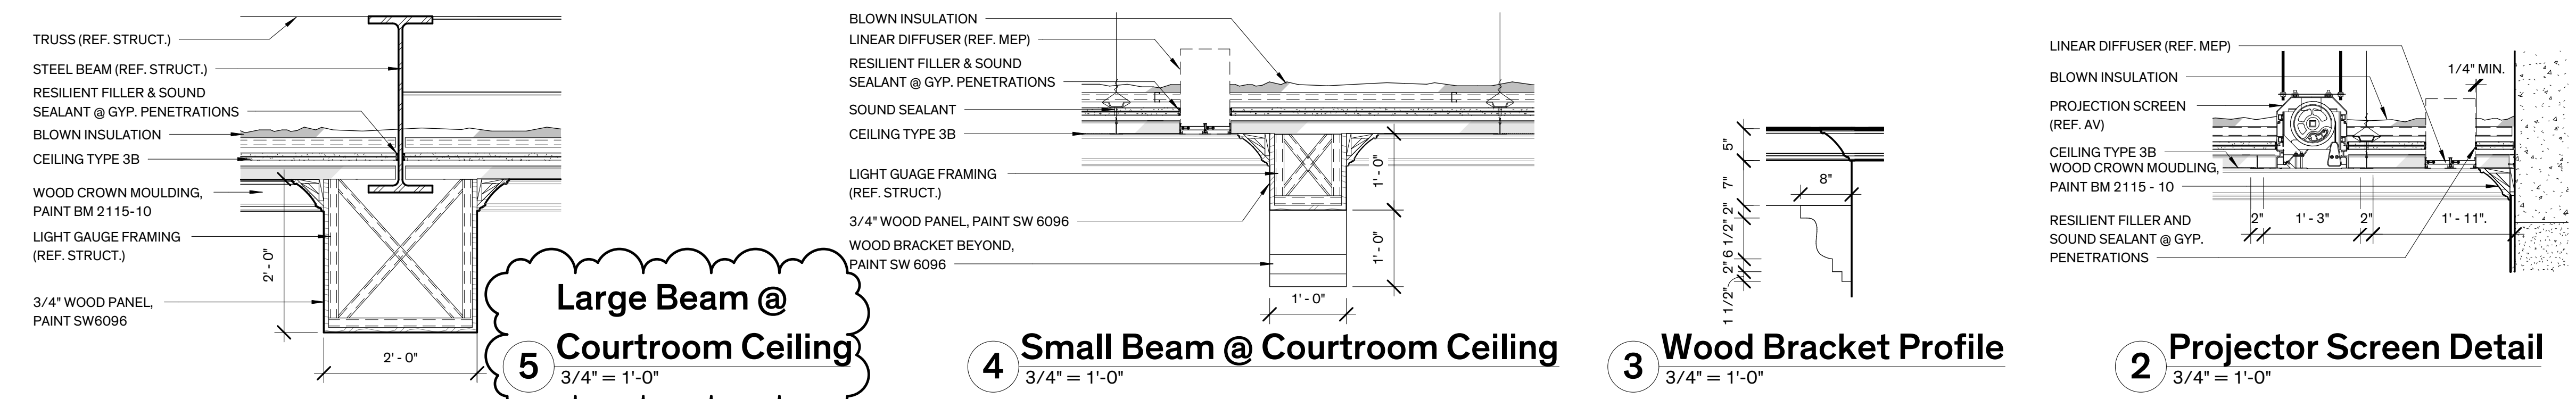


- ### GENERAL NOTES
- GENERAL**
- FINISH EXPOSED SURFACES UNLESS NOTED OTHERWISE. THE CONTRACTOR SHALL ASSUME FULL RESPONSIBILITY FOR THE COORDINATION OF THE COMPLETE FINISH-OUT OF THE PROJECT. ANY SURFACES WHICH DO NOT HAVE A SPECIFIC FINISH NOTED, NOR ARE NOTED TO REMAIN UNFINISHED SHALL BE BROUGHT TO THE ATTENTION OF THE ARCHITECT AND FINISHED PER THE ARCHITECT'S INSTRUCTION.
  - CONTRACTOR TO FIELD VERIFY EXISTING WALL THICKNESS.
  - FINISH FLOOR ELEVATIONS:
    - EXISTING ELEVATIONS AND CEILING HEIGHTS ARE APPROXIMATE AND ARE TO BE VERIFIED IN THE FIELD BY THE CONTRACTOR.
    - FINAL ELEVATIONS AND CEILING HEIGHTS WILL BE DETERMINED ONCE FINISH FLOOR LEVELS ARE ESTABLISHED IN CORRIDORS.
  - DIMENSIONING AT WALLS SHOWN IS FINISHED FACE OF WALL TO FINISHED FACE OF WALL UNLESS NOTED OTHERWISE.
  - THE EXISTING METAL CEILING PAINT IS KNOWN TO CONTAIN LEAD. WASTE GENERATED BY COATING REMOVAL PROCESS SHALL BE CLASSIFIED AS HAZARDOUS MATERIAL AND SHALL BE REMOVED IN ACCORDANCE WITH EPA AND OSHA GUIDELINES.
  - REFERENCE FINISH SCHEDULE ON SHEET A6.01 FOR ROOM FINISH AND PAINT COLOR SELECTIONS.
  - REFERENCE DOOR AND WINDOW SCHEDULES ON SHEETS A6.04 THRU A6.10 FOR SCOPE OF WORK ASSOCIATED WITH DOORS AND WINDOWS.
- CONDUIT AT MASONRY WALLS**
- SURFACE MOUNT CONDUIT AND J-BOXES PARALLEL TO FLOOR AND WALLS. PROVIDE TIGHT 90 DEGREE BENDS AT CORNERS AND GANG TIGHT AND PARALLEL TO OTHER PIPING AND CONDUIT WHERE POSSIBLE.
  - EXPOSED CONDUIT, PIPING, WIRING, ASSOCIATED FASTENERS, ETC. ARE TO BE PRIMED AND PAINTED.
  - ALLOW FOR (3) PAINT COLORS ON MEP COMPONENTS. MECHANICAL COMPONENTS WILL BE ON COLOR, ELECTRICAL COMPONENTS WILL BE A SECOND COLOR, AND PLUMBING COMPONENTS WILL BE A THIRD COLOR.
- CONDUIT AT PLASTER WALLS**
- CONCEAL CONDUIT BEHIND FINISH FACE OF PLASTER. ROUT PLASTER AND UNDERLYING MASONRY TO ACCEPT CONDUIT AND TO ALLOW FOR A FULL APPLICATION OF LATH AND PLASTER. PLASTER IS TO MATCH EXISTING ADJACENT SURFACES.
  - ELECTRICAL BOXES AND ASSOCIATED ELEMENTS MUST BE RECESSED INTO WALLS SO THAT COVER PLATES AND DEVICES ARE FLUSH WITH THE FINISH SURFACE OF THE WALL.
  - PREPARE AND FINISH PLASTER WALLS AS REQUIRED TO MATCH ORIGINAL PLASTER FINISH.

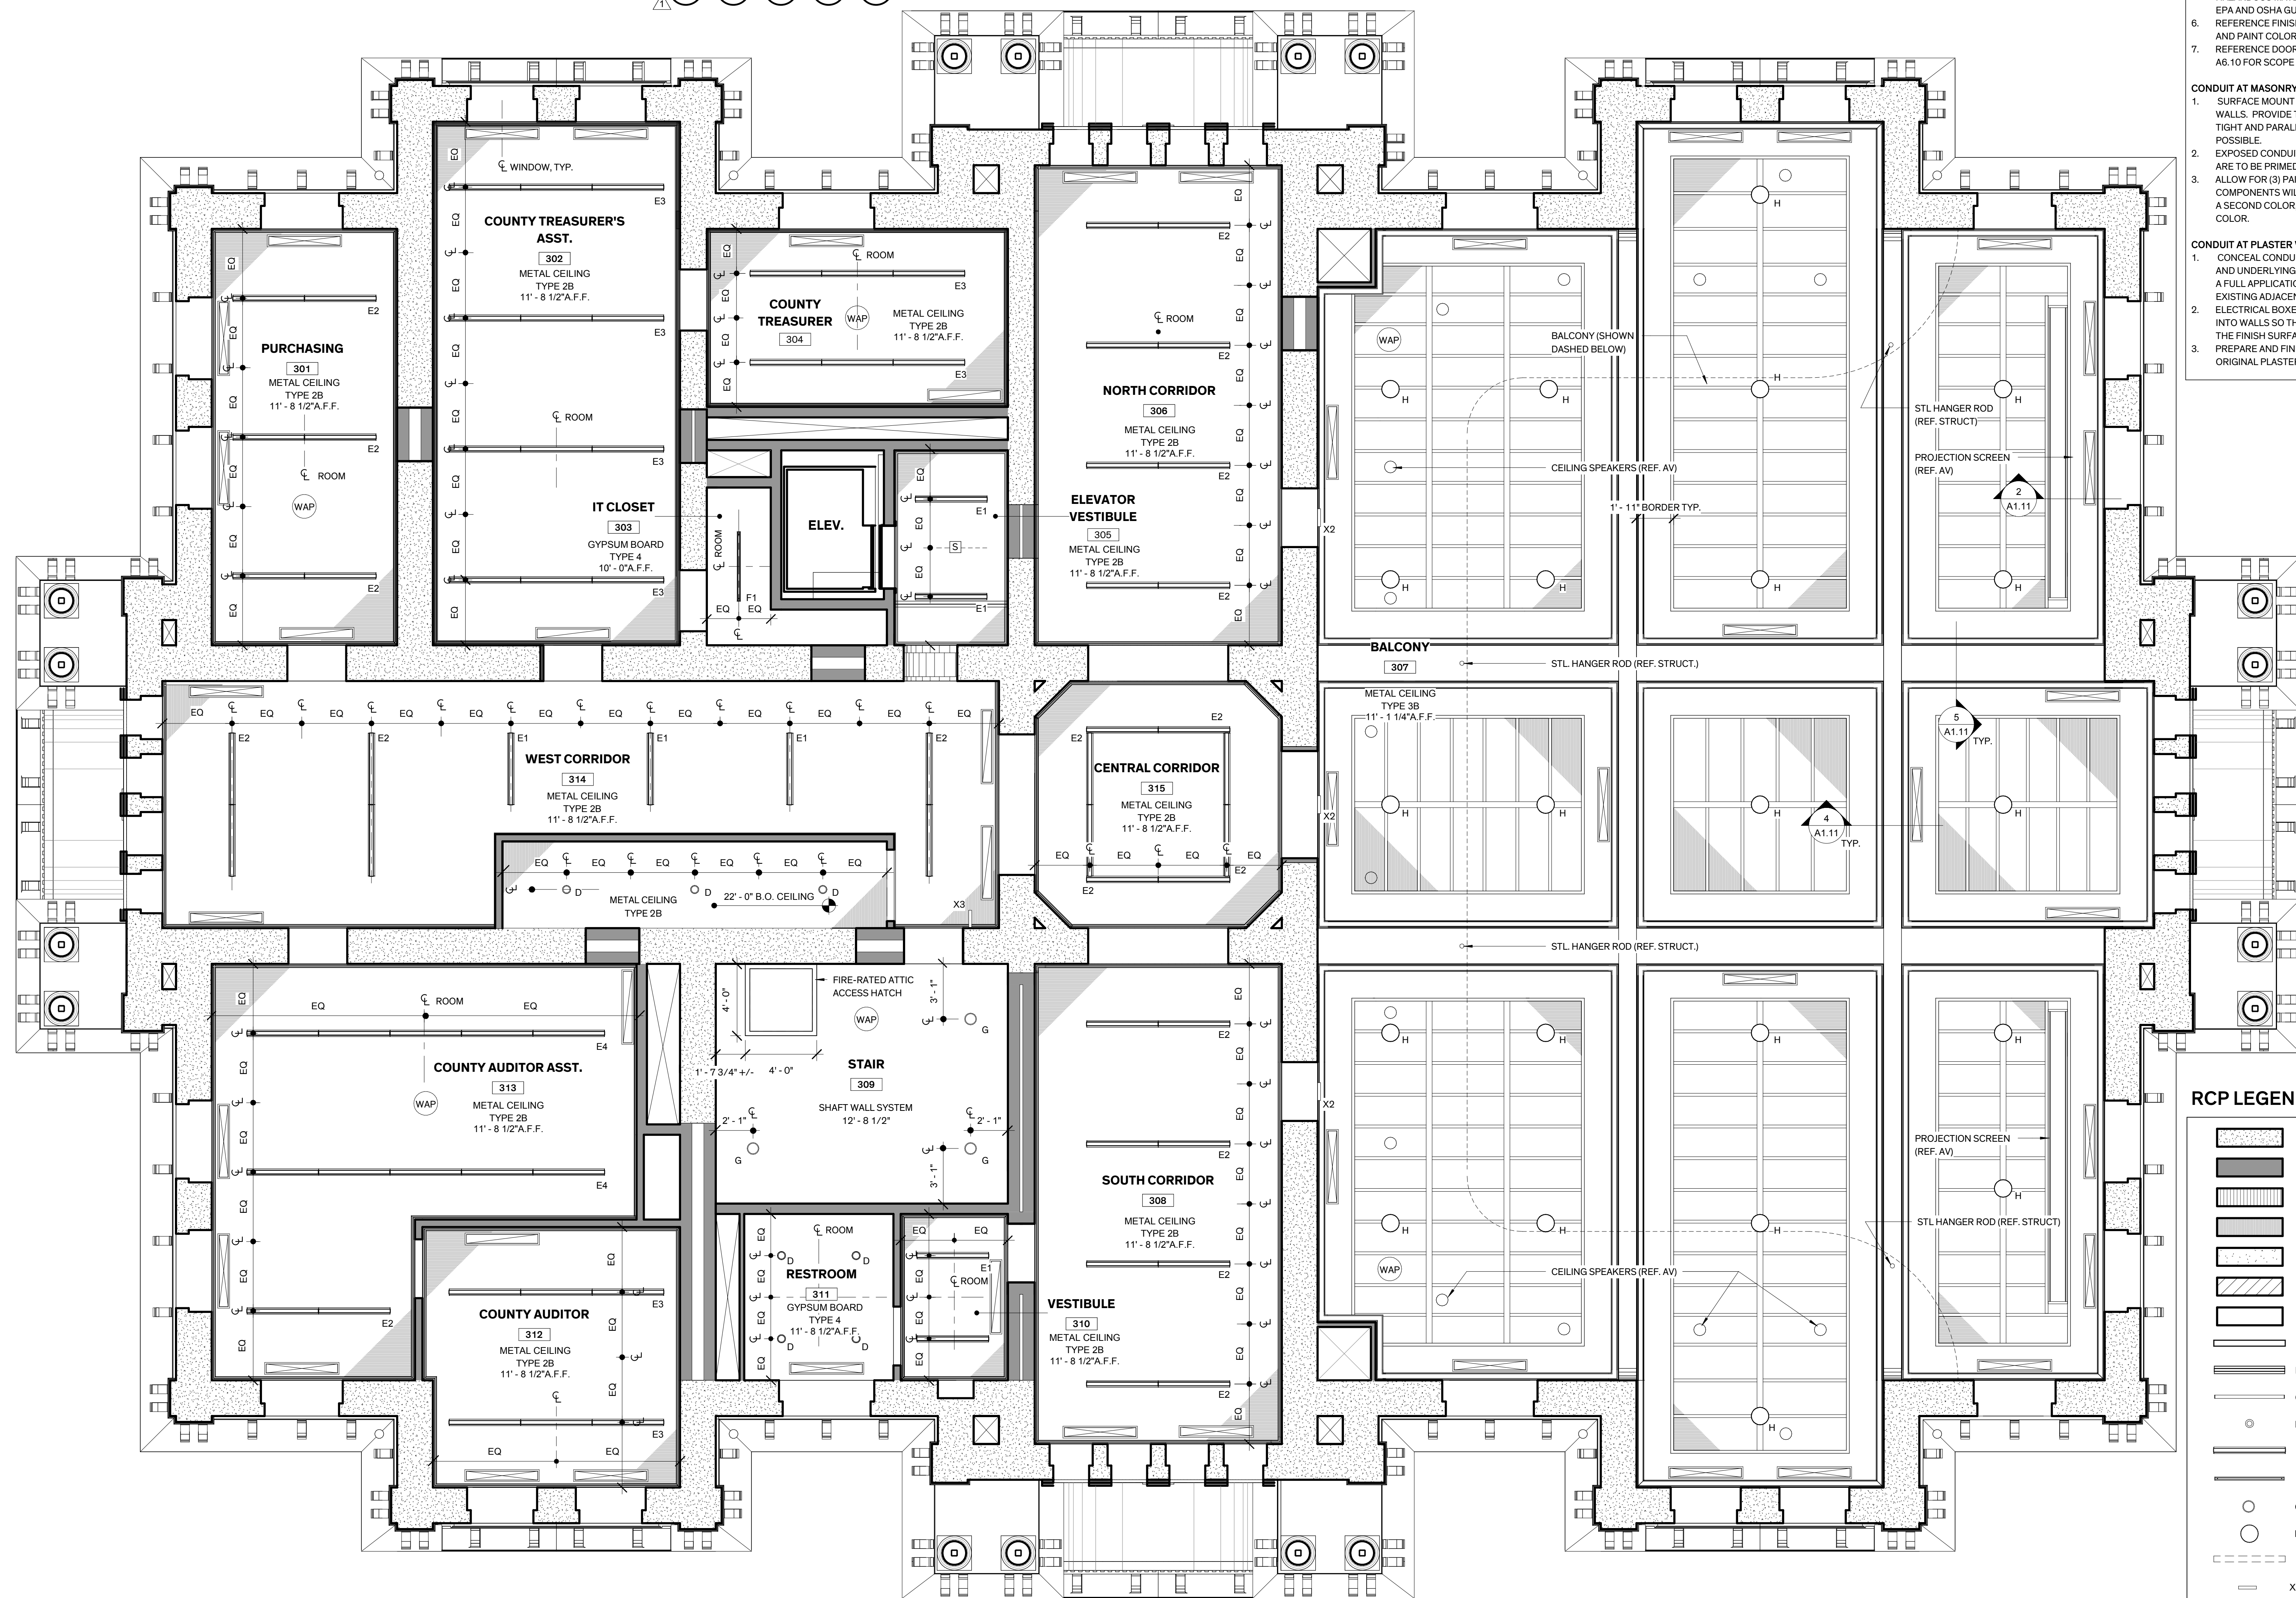

### RCP LEGEND

	EXISTING MASONRY WALL
	NEW WALL
	EXISTING METAL PAN VAULT
	METAL CEILING
	ACOUSTICAL PLASTER CEILING
	RECONSTRUCTED FLOOR SYSTEM, REF. STRUCT.
	GYPSUM BOARD CEILING
	A INDIRECT / DIRECT LINEAR PENDANT FIXTURE
	B RECESSED LINEAR FIXTURE
	C SURFACE MOUNT LINEAR FIXTURE
	D RECESSED DOWNLIGHT FIXTURE
	E LINEAR PENDANT FIXTURE
	F SURFACE MOUNT STRIPLIGHT
	G SURFACE MOUNT FIXTURE
	H PENDANT FIXTURE
	J UNDERMOUNT CABINET FIXTURE
	X1 CEILING MOUNT EXIT LIGHT
	X2 WALL MOUNT EXIT LIGHT
	X3 SIDE MOUNT EXIT LIGHT
	S SMOKE DETECTOR, REF. TECH
	WAP WIRELESS ACCESS POINT, REF. TECH
	EXHAUST AIR GRILLE, REF. MEP
	RETURN AIR GRILLE, REF. MEP
	SUPPLY AIR GRILLE, REF. MEP

**1 Third Level RCP**  
 1/4" = 1'-0"

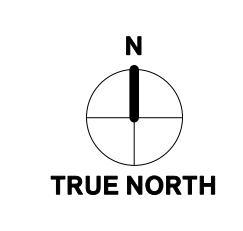

TEXAS HISTORICAL COMMISSION  
*real places telling real stories*



FANNIN COUNTY  
 COURTHOUSE  
 INTERIOR & EXTERIOR RESTORATION

101 E. Sam Rayburn Drive  
 Bonham, Texas 75418

**COPYRIGHT**  
 The Contractor shall verify and be responsible for all dimensions. DO NOT scale the drawing. Any errors or omissions shall be reported to Architexas without delay. The Copyrights to all designs and drawings are the property of Architexas. Reproduction or use for any purpose other than that authorized by Architexas is forbidden.

**REVISION HISTORY**  
 1 Oct. 16, 2018 Addendum #1

ISSUED FOR CONSTRUCTION



#18326 9/21/2018


Architexas No. 1737 Date SEPT. 21, 2018

Sheet Name THIRD LEVEL RCP


Sheet Number **AI.II**

**GENERAL NOTES**

- GENERAL**
1. REFERENCE MEP DRAWINGS FOR EQUIPMENT SIZES, WEIGHTS AND APPROXIMATE LOCATIONS.
  2. ARRANGE AIR HANDLER AND CONNECTING DUCTWORK TO PROVIDE MAXIMUM ACCESS FOR MAINTENANCE AND SERVICE PERSONNEL.
  3. CONTRACTOR TO PROPERLY COORDINATE MECHANICAL EQUIPMENT LOCATIONS AND MINIMUM SPACE REQUIREMENTS FOR SERVICING EQUIPMENT WITH LIGHT GAUGE METAL TRUSS SUPPLIER AND CATWALK LAYOUT. NOTIFY ARCHITECT OF ANY CONFLICTS PRIOR TO INSTALLATION.

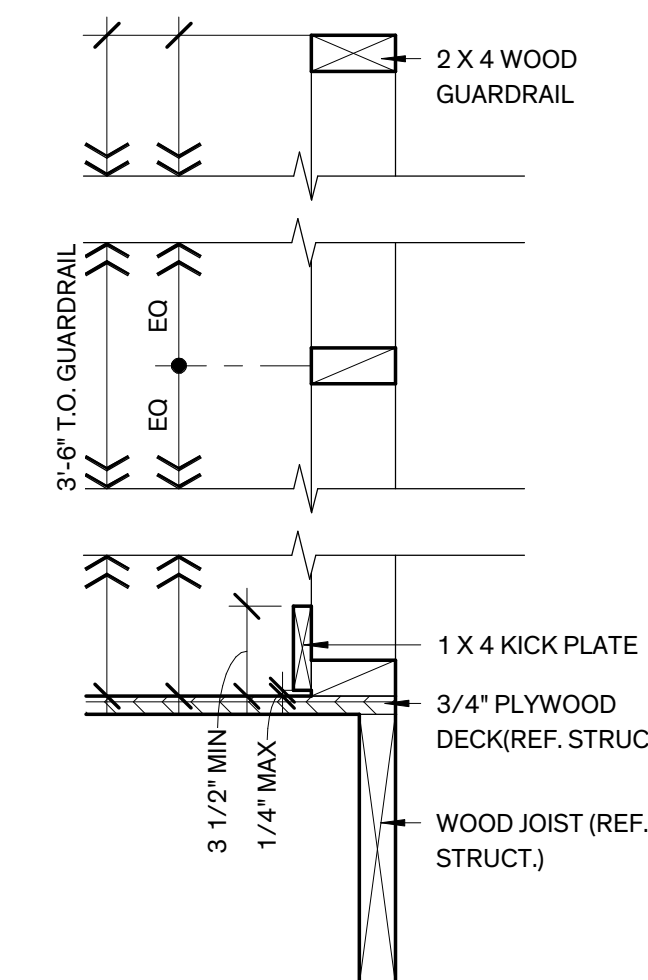

**2 Detail @ Catwalk Railing**  
 1 1/2" = 1'-0"

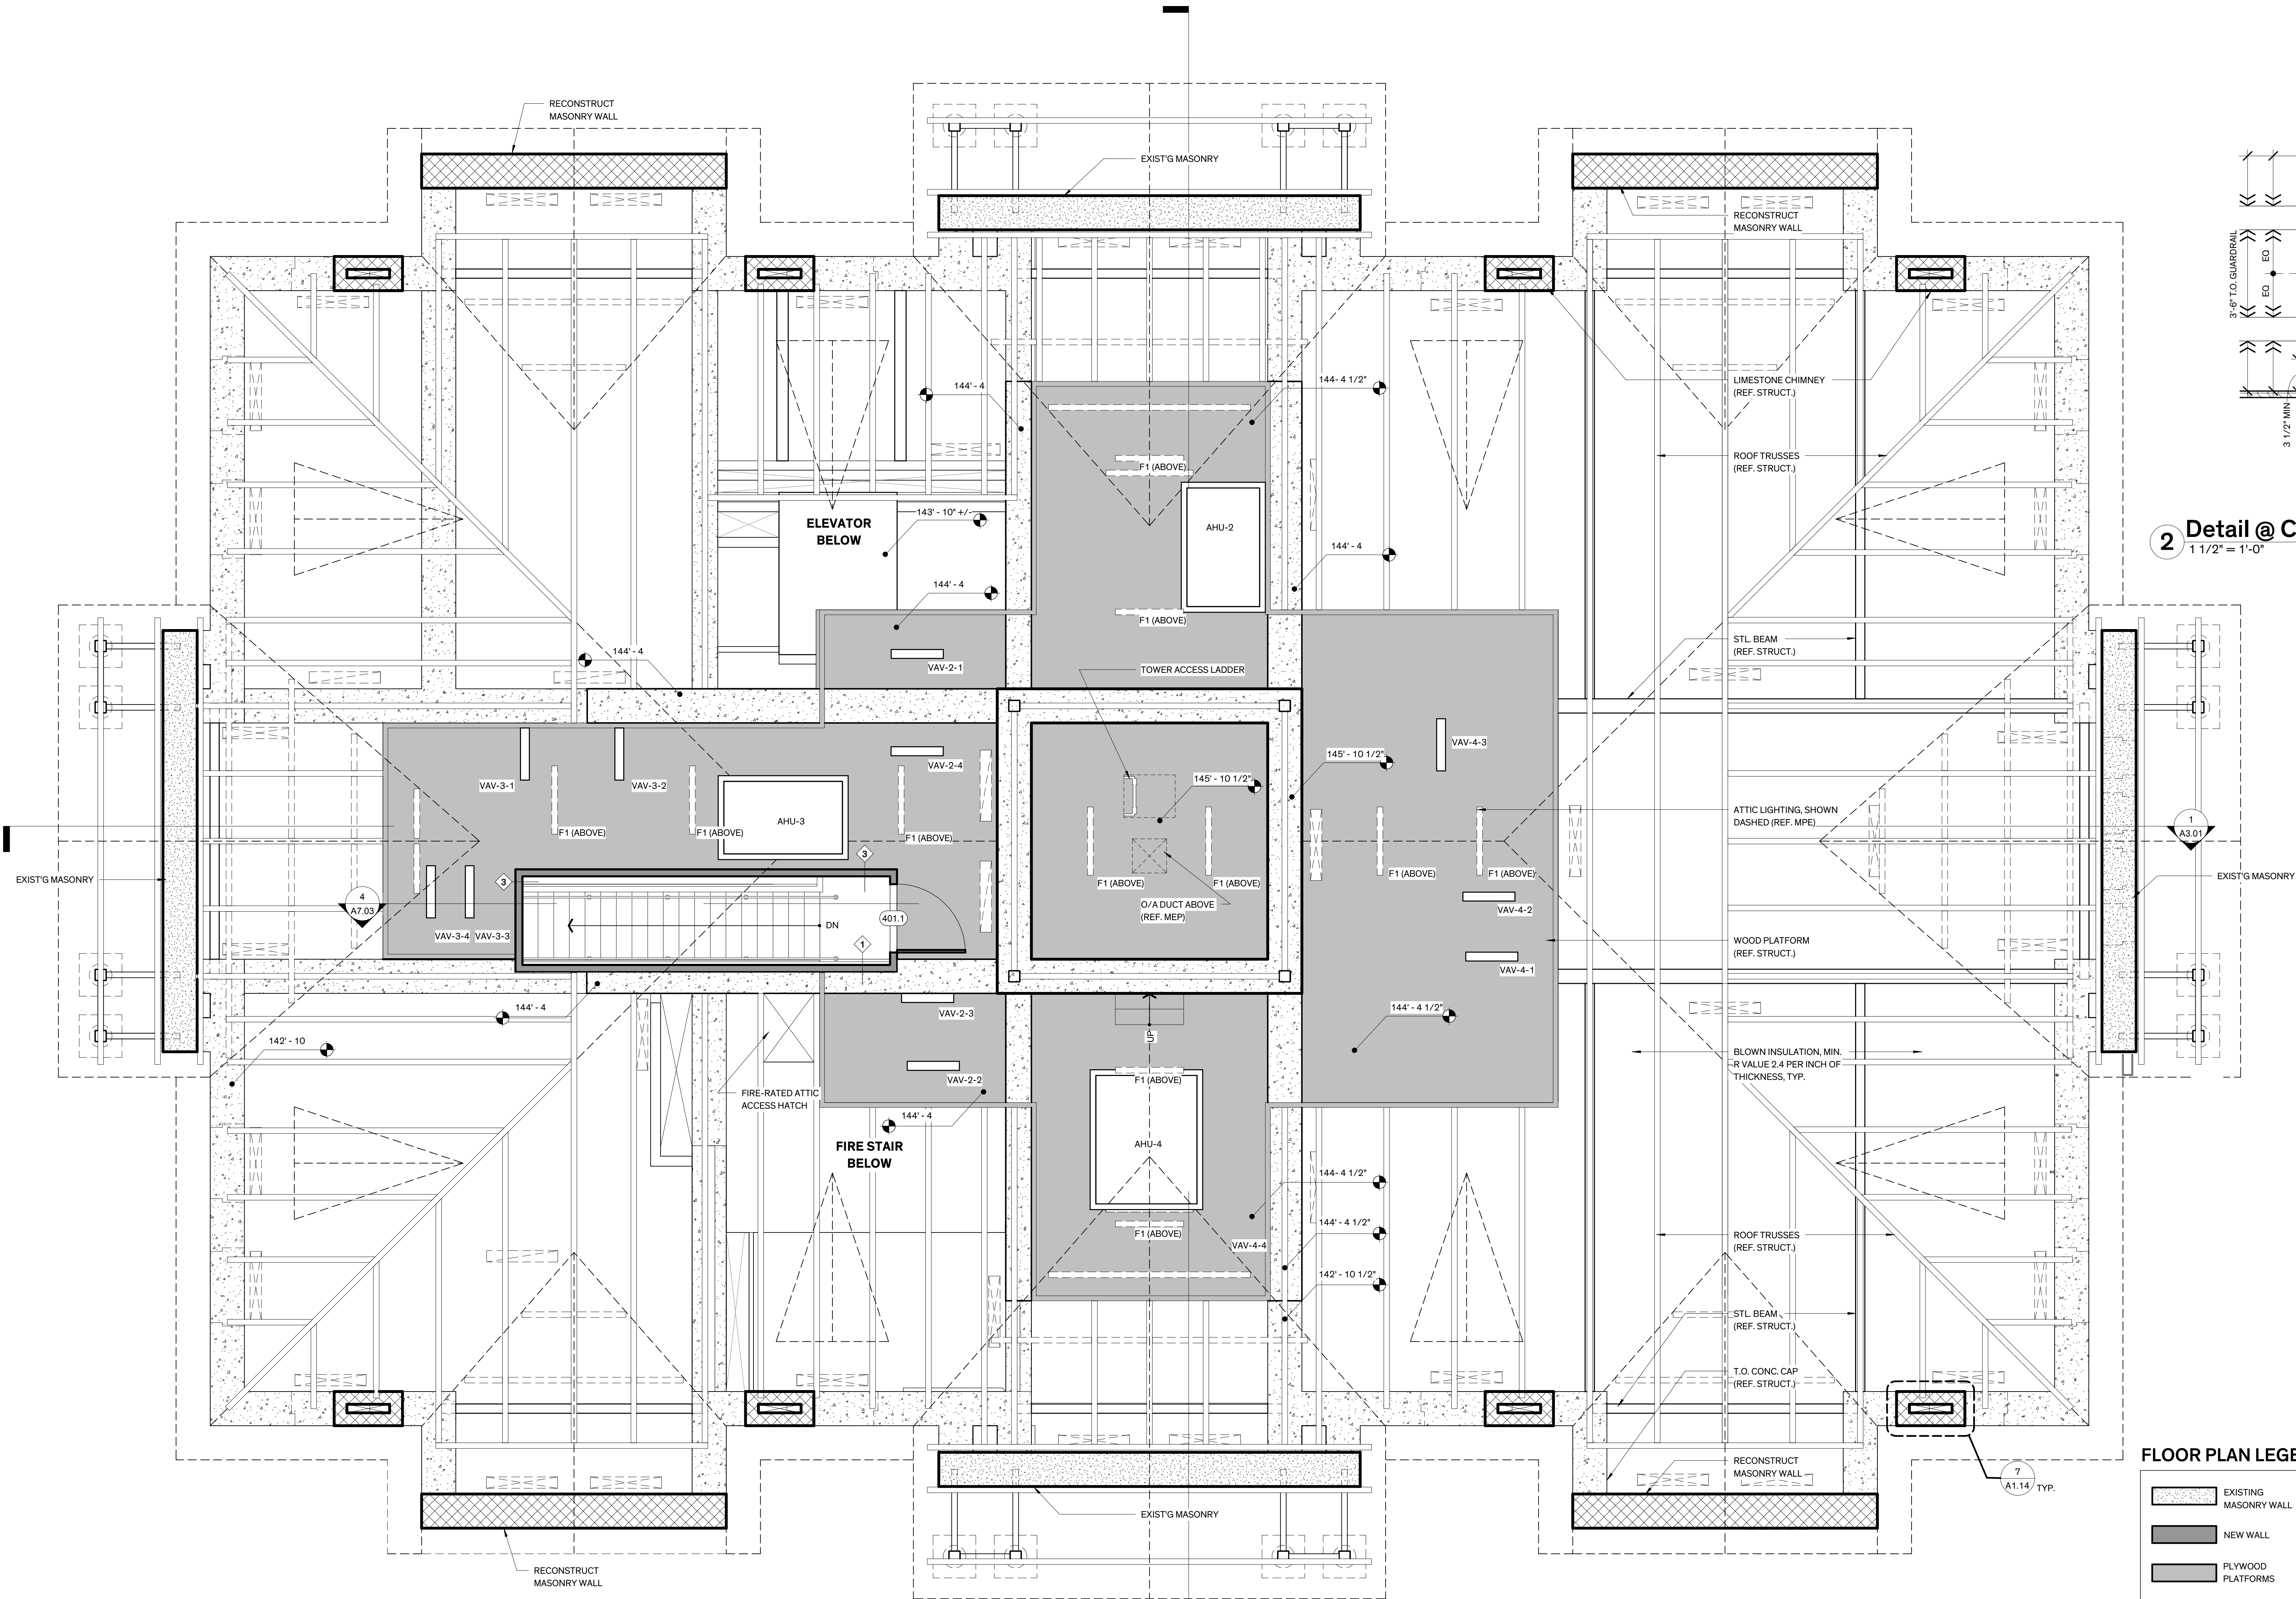

**1 Attic Level Plan**  
 1/4" = 1'-0"

**FLOOR PLAN LEGEND**


	EXISTING MASONRY WALL		CONC. CAP
	NEW WALL		BUILT-UP STONE MASONRY WALL
	PLYWOOD PLATFORMS		45° HISTORIC DOOR OPENING
	90° NEW DOOR OPENING		RETURN AIR GRILLE, REF. MEP
	SUPPLY AIR GRILLE, REF. MEP		TILE FLOOR
	XC EXISTING CONCRETE FLOOR		CI CAST IRON
	C CONCRETE FLOOR		CT CONCRETE TOPPING
	W WOOD FLOOR		SF CUSTOM SHEET FLOORING



**FANNIN COUNTY COURTHOUSE**  
 INTERIOR & EXTERIOR RESTORATION  
 101 E. Sam Rayburn Drive  
 Bonham, Texas 75418

**COPYRIGHT**  
 The Contractor shall verify and be responsible for all dimensions. DO NOT scale the drawing. Any errors or omissions shall be reported to Architexas without delay. The Copyrights to all designs and drawings are the property of Architexas. Reproduction or use for any purpose other than that authorized by Architexas is forbidden.

**REVISION HISTORY**  
 1 Oct. 16, 2018 Addendum #1

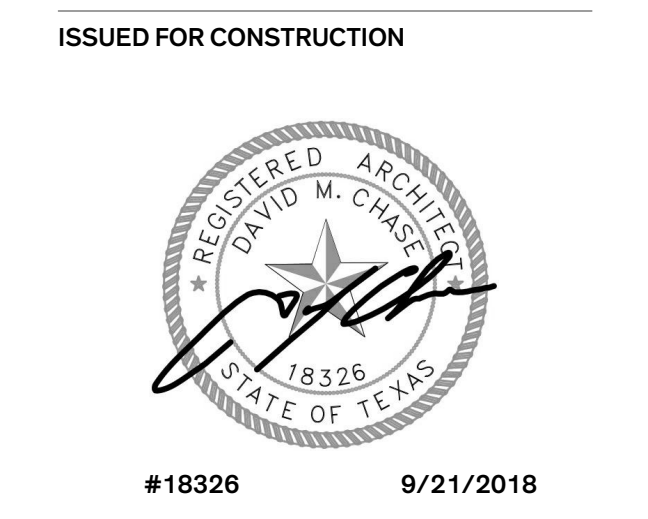

Architexas No. 1737 Date SEPT. 21, 2018

Sheet Name **ATTIC LEVEL PLAN**

Sheet Number






**GENERAL NOTES**

- GENERAL**
1. REFERENCE 'PROJECT MANUAL' FOR EXTENT OF ROOFING AND FLASHING SCOPE OF WORK.
  2. PROTECT EXISTING MATERIALS DURING CONSTRUCTION THAT ARE SCHEDULED TO REMAIN DURING DEMOLITION PROCESS. DAMAGE TO EXISTING FINISH SURFACES BY THE CONTRACTOR SHALL BE CORRECTED IN KIND AT NO ADDITIONAL COST TO THE OWNER.
  3. REMOVE DEBRIS FROM DEMOLITION AT THE END OF EACH WORK DAY AND MAINTAIN BUILDING IN A SAFE MANNER CLEAR OF DEMOLITION AND CONSTRUCTION DEBRIS AND EQUIPMENT.
  4. PROVIDE TEMPORARY PROTECTION AS REQUIRED DURING DEMOLITION AND CONSTRUCTION OF ROOF TO PROTECT INTERIOR FROM WATER / MOISTURE INTRUSION.
  5. REMOVE EXISTING FASTENERS, BOLTS, CLAMPS, STRAPS, ETC. ON THE EXTERIOR OF THE BUILDING THAT ARE ATTACHED OR EMBEDDED IN EXISTING MATERIALS AND ARE NOT BEING USED TO FASTEN ELEMENTS TO REMAIN.
- MECHANICAL, ELECTRICAL, AND PLUMBING**
1. REMOVE EXISTING ELECTRICAL CONDUIT, OUTLETS, SWITCHES, SLEEVES, PIPING STRAPS, ANCHORS, NAILS, BOLTS, SCREWS, ETC. WHICH ARE ATTACHED TO THE BUILDING EXTERIOR, WHETHER OR NOT THEY ARE INDICATED ON THE DRAWINGS.
  2. REMOVE MEP SYSTEMS AS NOTED ON THE MEP DRAWINGS.
  3. INSTALL WORK IN LOCATIONS SHOWN ON THE DRAWINGS, UNLESS PREVENTED BY PROJECT CONDITIONS. REARRANGEMENT MUST BE APPROVED BY ARCHITECT / ENGINEER PRIOR TO INSTALLATION.

**ROOF AREA**

TOWER ROOF	510 SF +/-
LOWER ROOF	12425 SF +/-
TOTAL	12935 SF +/-

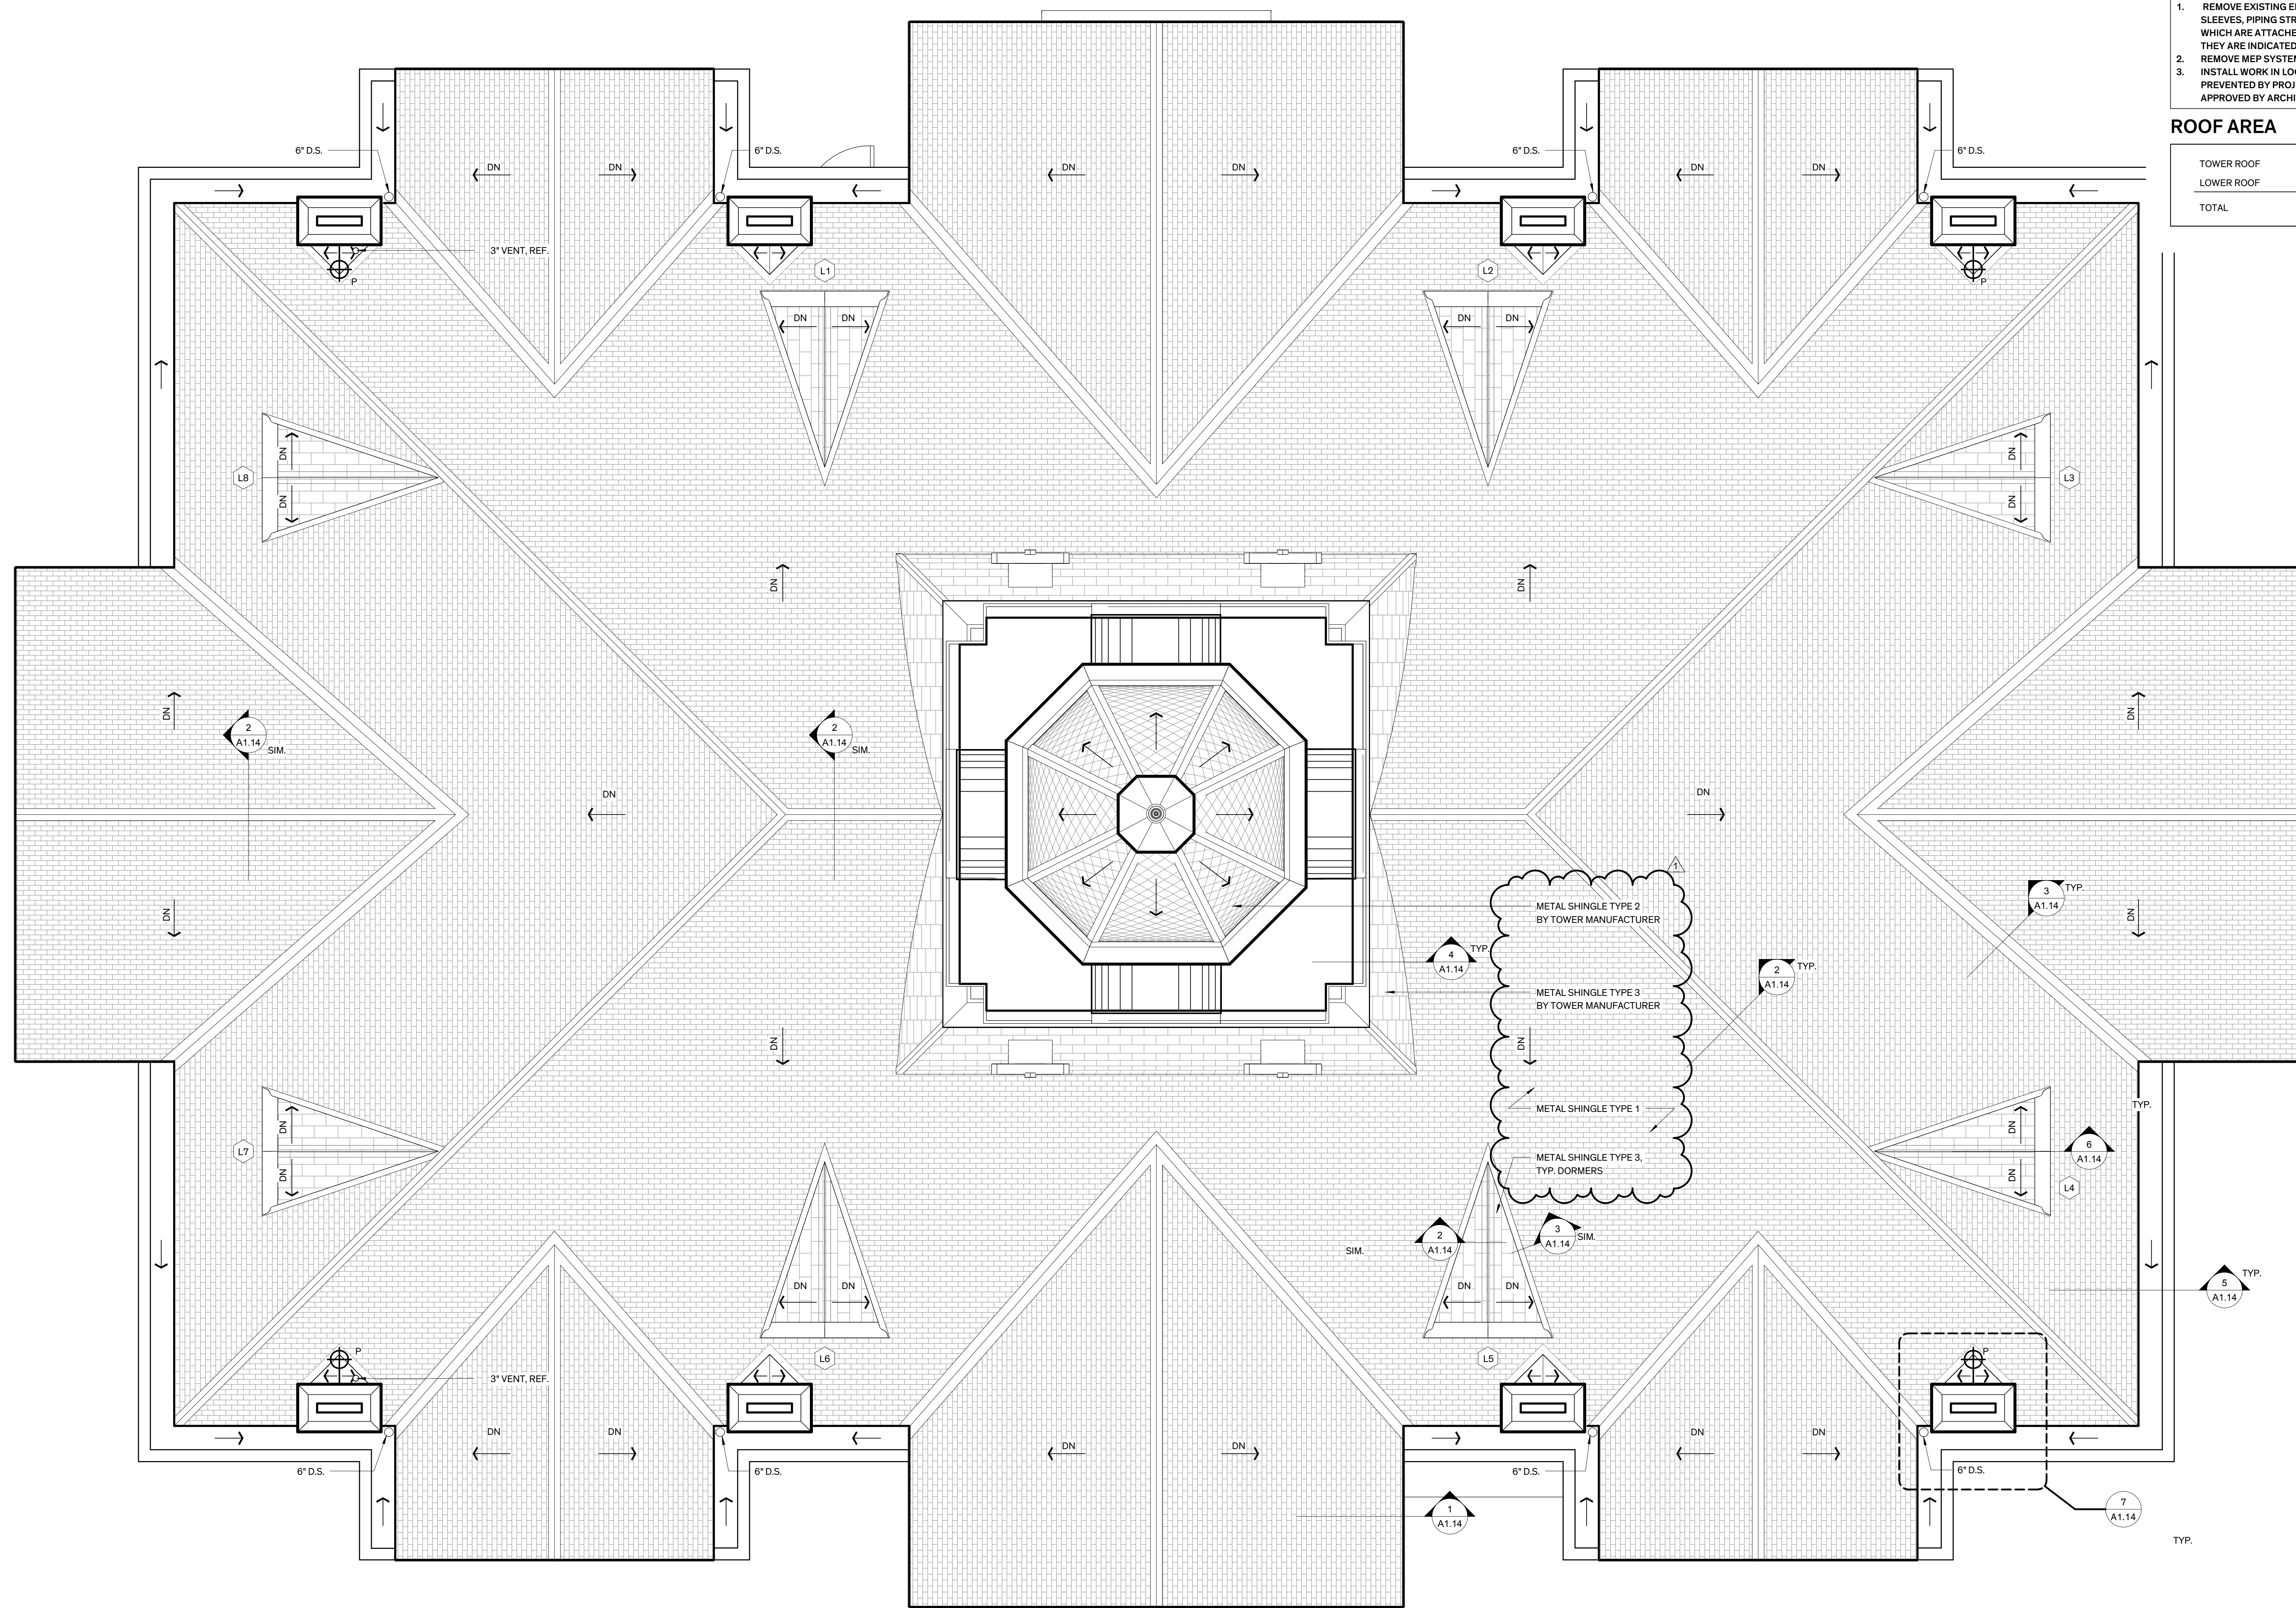

**FANNIN COUNTY COURTHOUSE**  
INTERIOR & EXTERIOR RESTORATION

101 E. Sam Rayburn Drive  
Bonham, Texas 75418

**COPYRIGHT**  
The Contractor shall verify and be responsible for all dimensions. DO NOT scale the drawing. Any errors or omissions shall be reported to Architexas without delay. The Copyrights to all designs and drawings are the property of Architexas. Reproduction or use for any purpose other than that authorized by Architexas is forbidden.

**REVISION HISTORY**  
1 Oct. 16, 2018 Addendum #1

ISSUED FOR CONSTRUCTION




#18326 9/21/2018

Architexas No. 1737 Date SEPT. 21, 2018


Sheet Name ROOF PLAN

Sheet Number


**1 Roof Plan**  
1/4" = 1'-0"  
TRUE NORTH

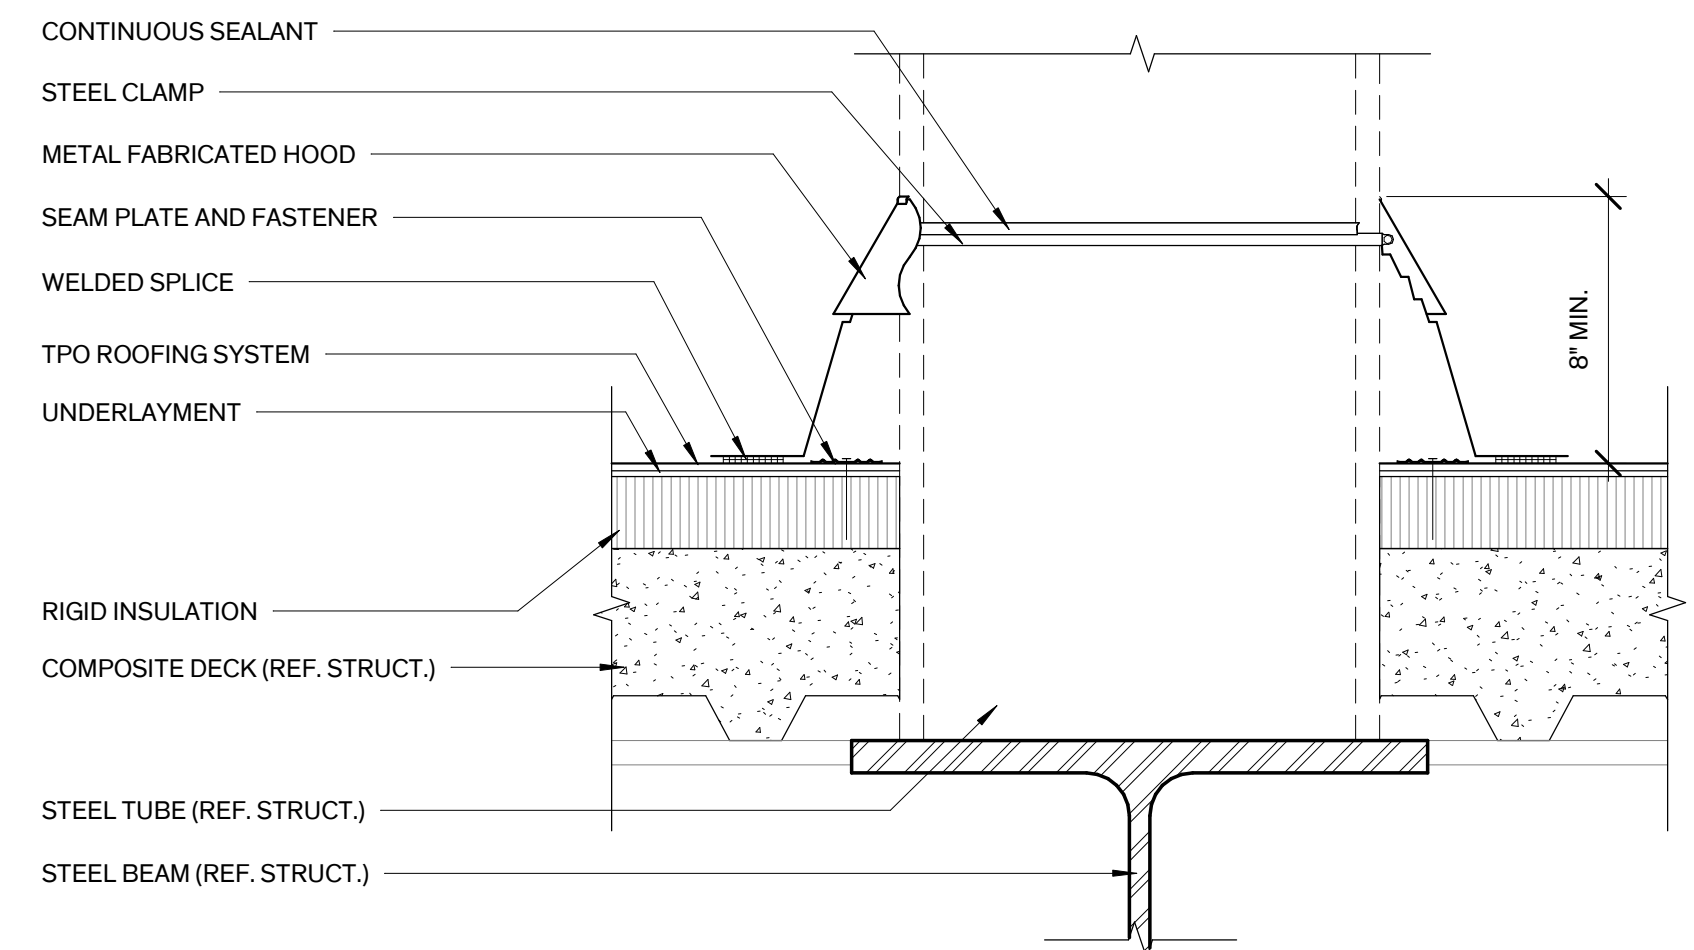


**12 Column Flashing Detail**  
 3\"/>

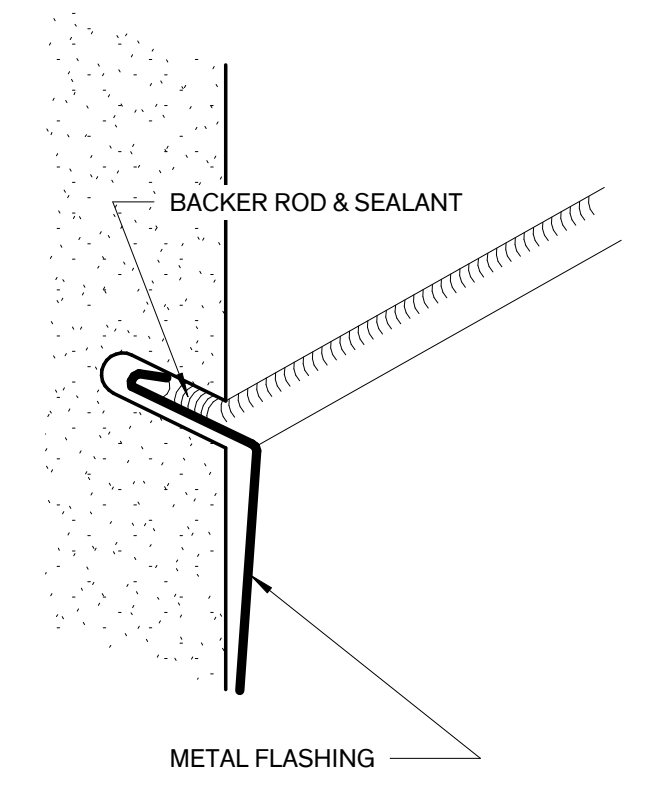


**11 Saw-Cut Reglet Detail**  
 3\"/>

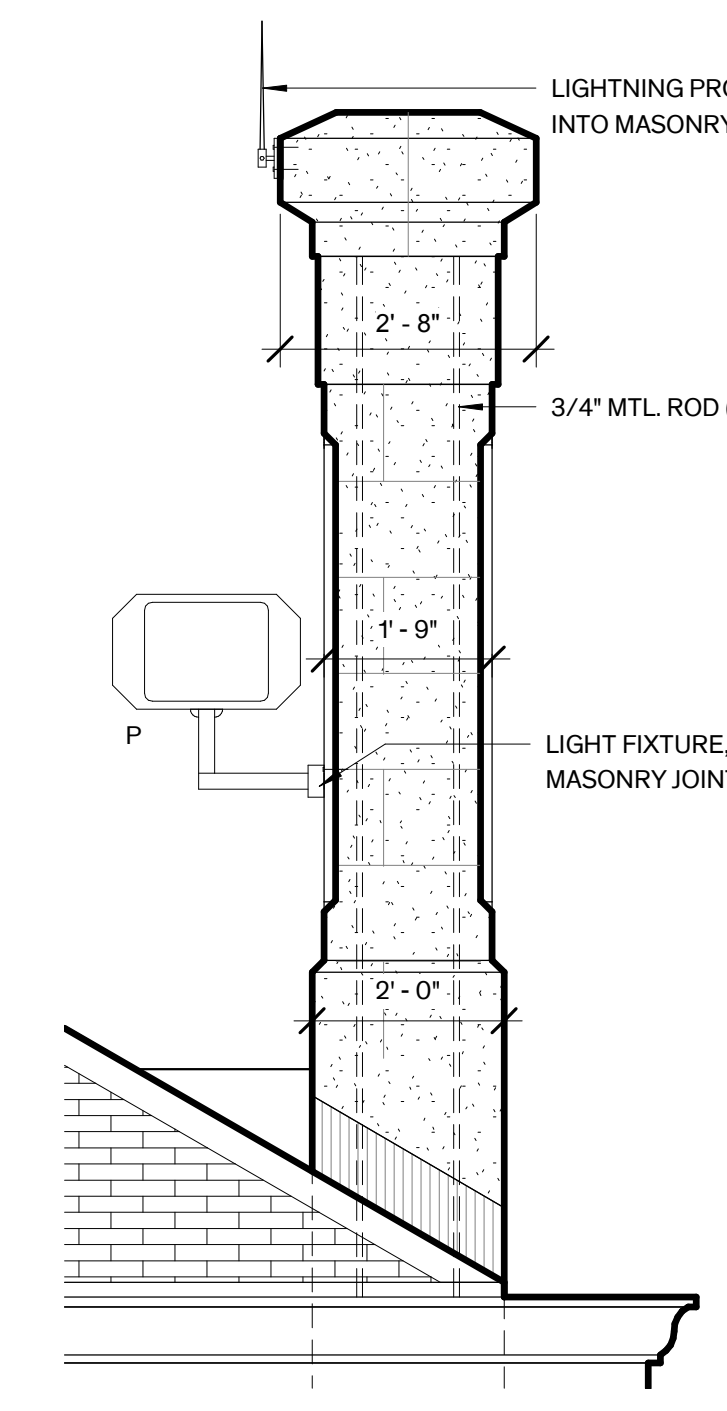


**10 Typical Chimney Side Elevation**  
 1/2\"/>

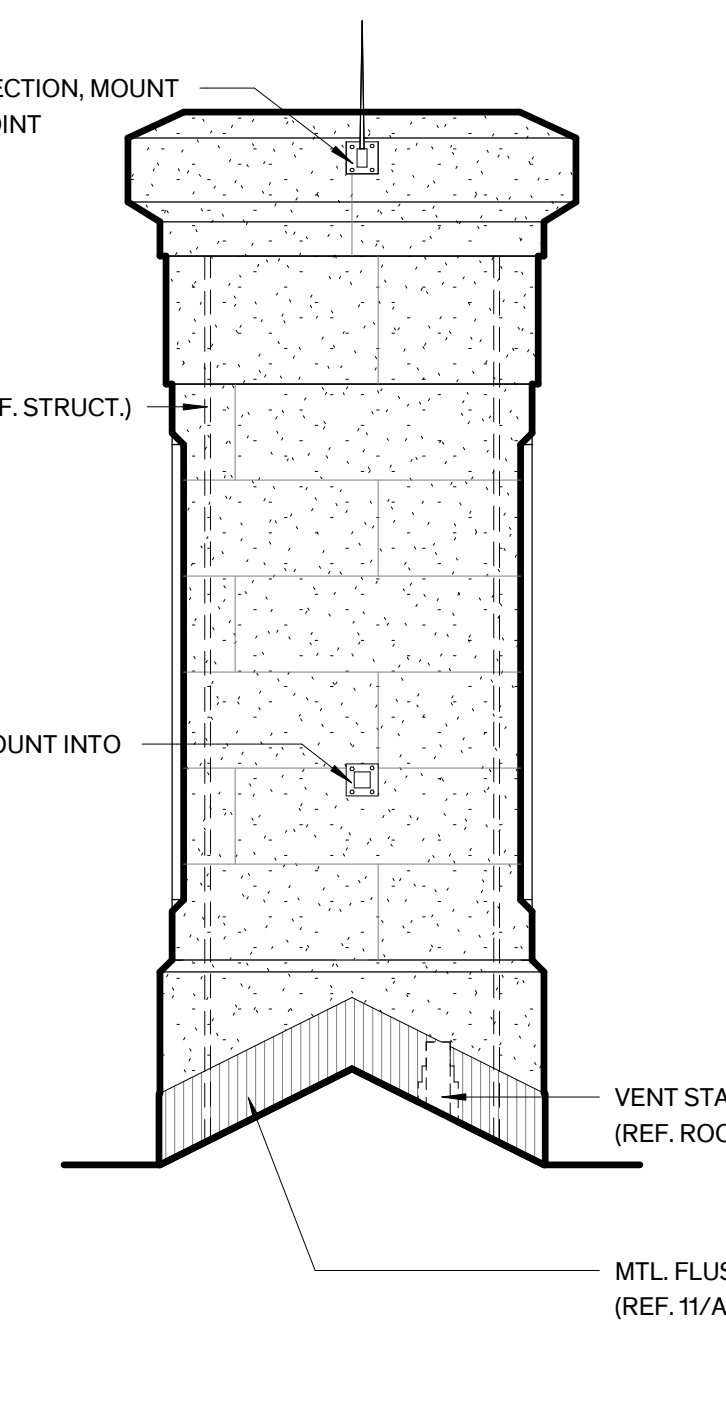

**9 Typical Chimney Back Elevation**  
 1/2\"/>

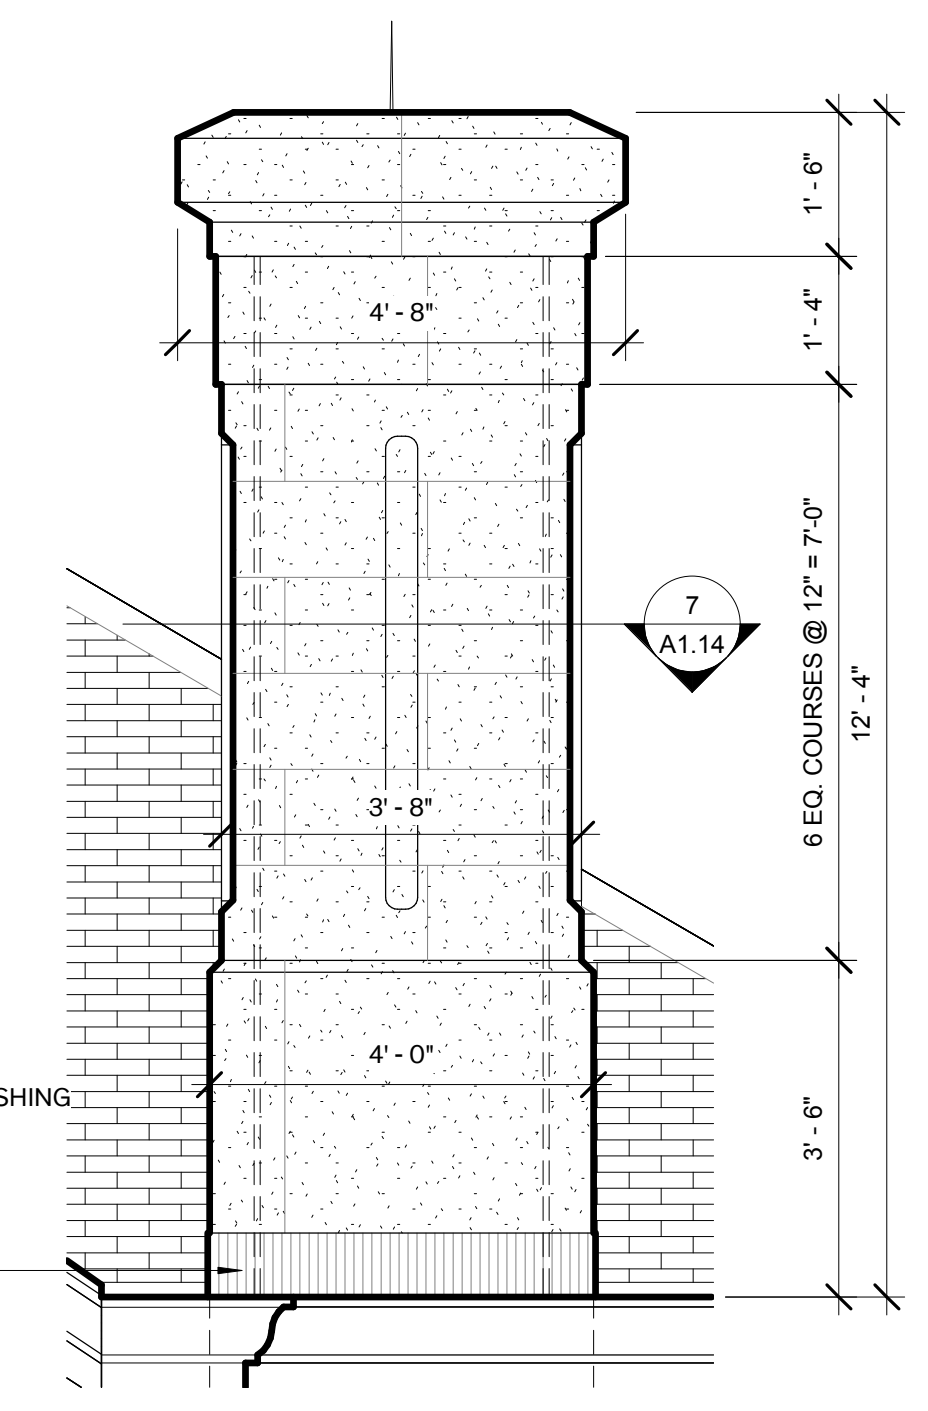


**8 Typical Chimney Front Elevation**  
 1/2\"/>

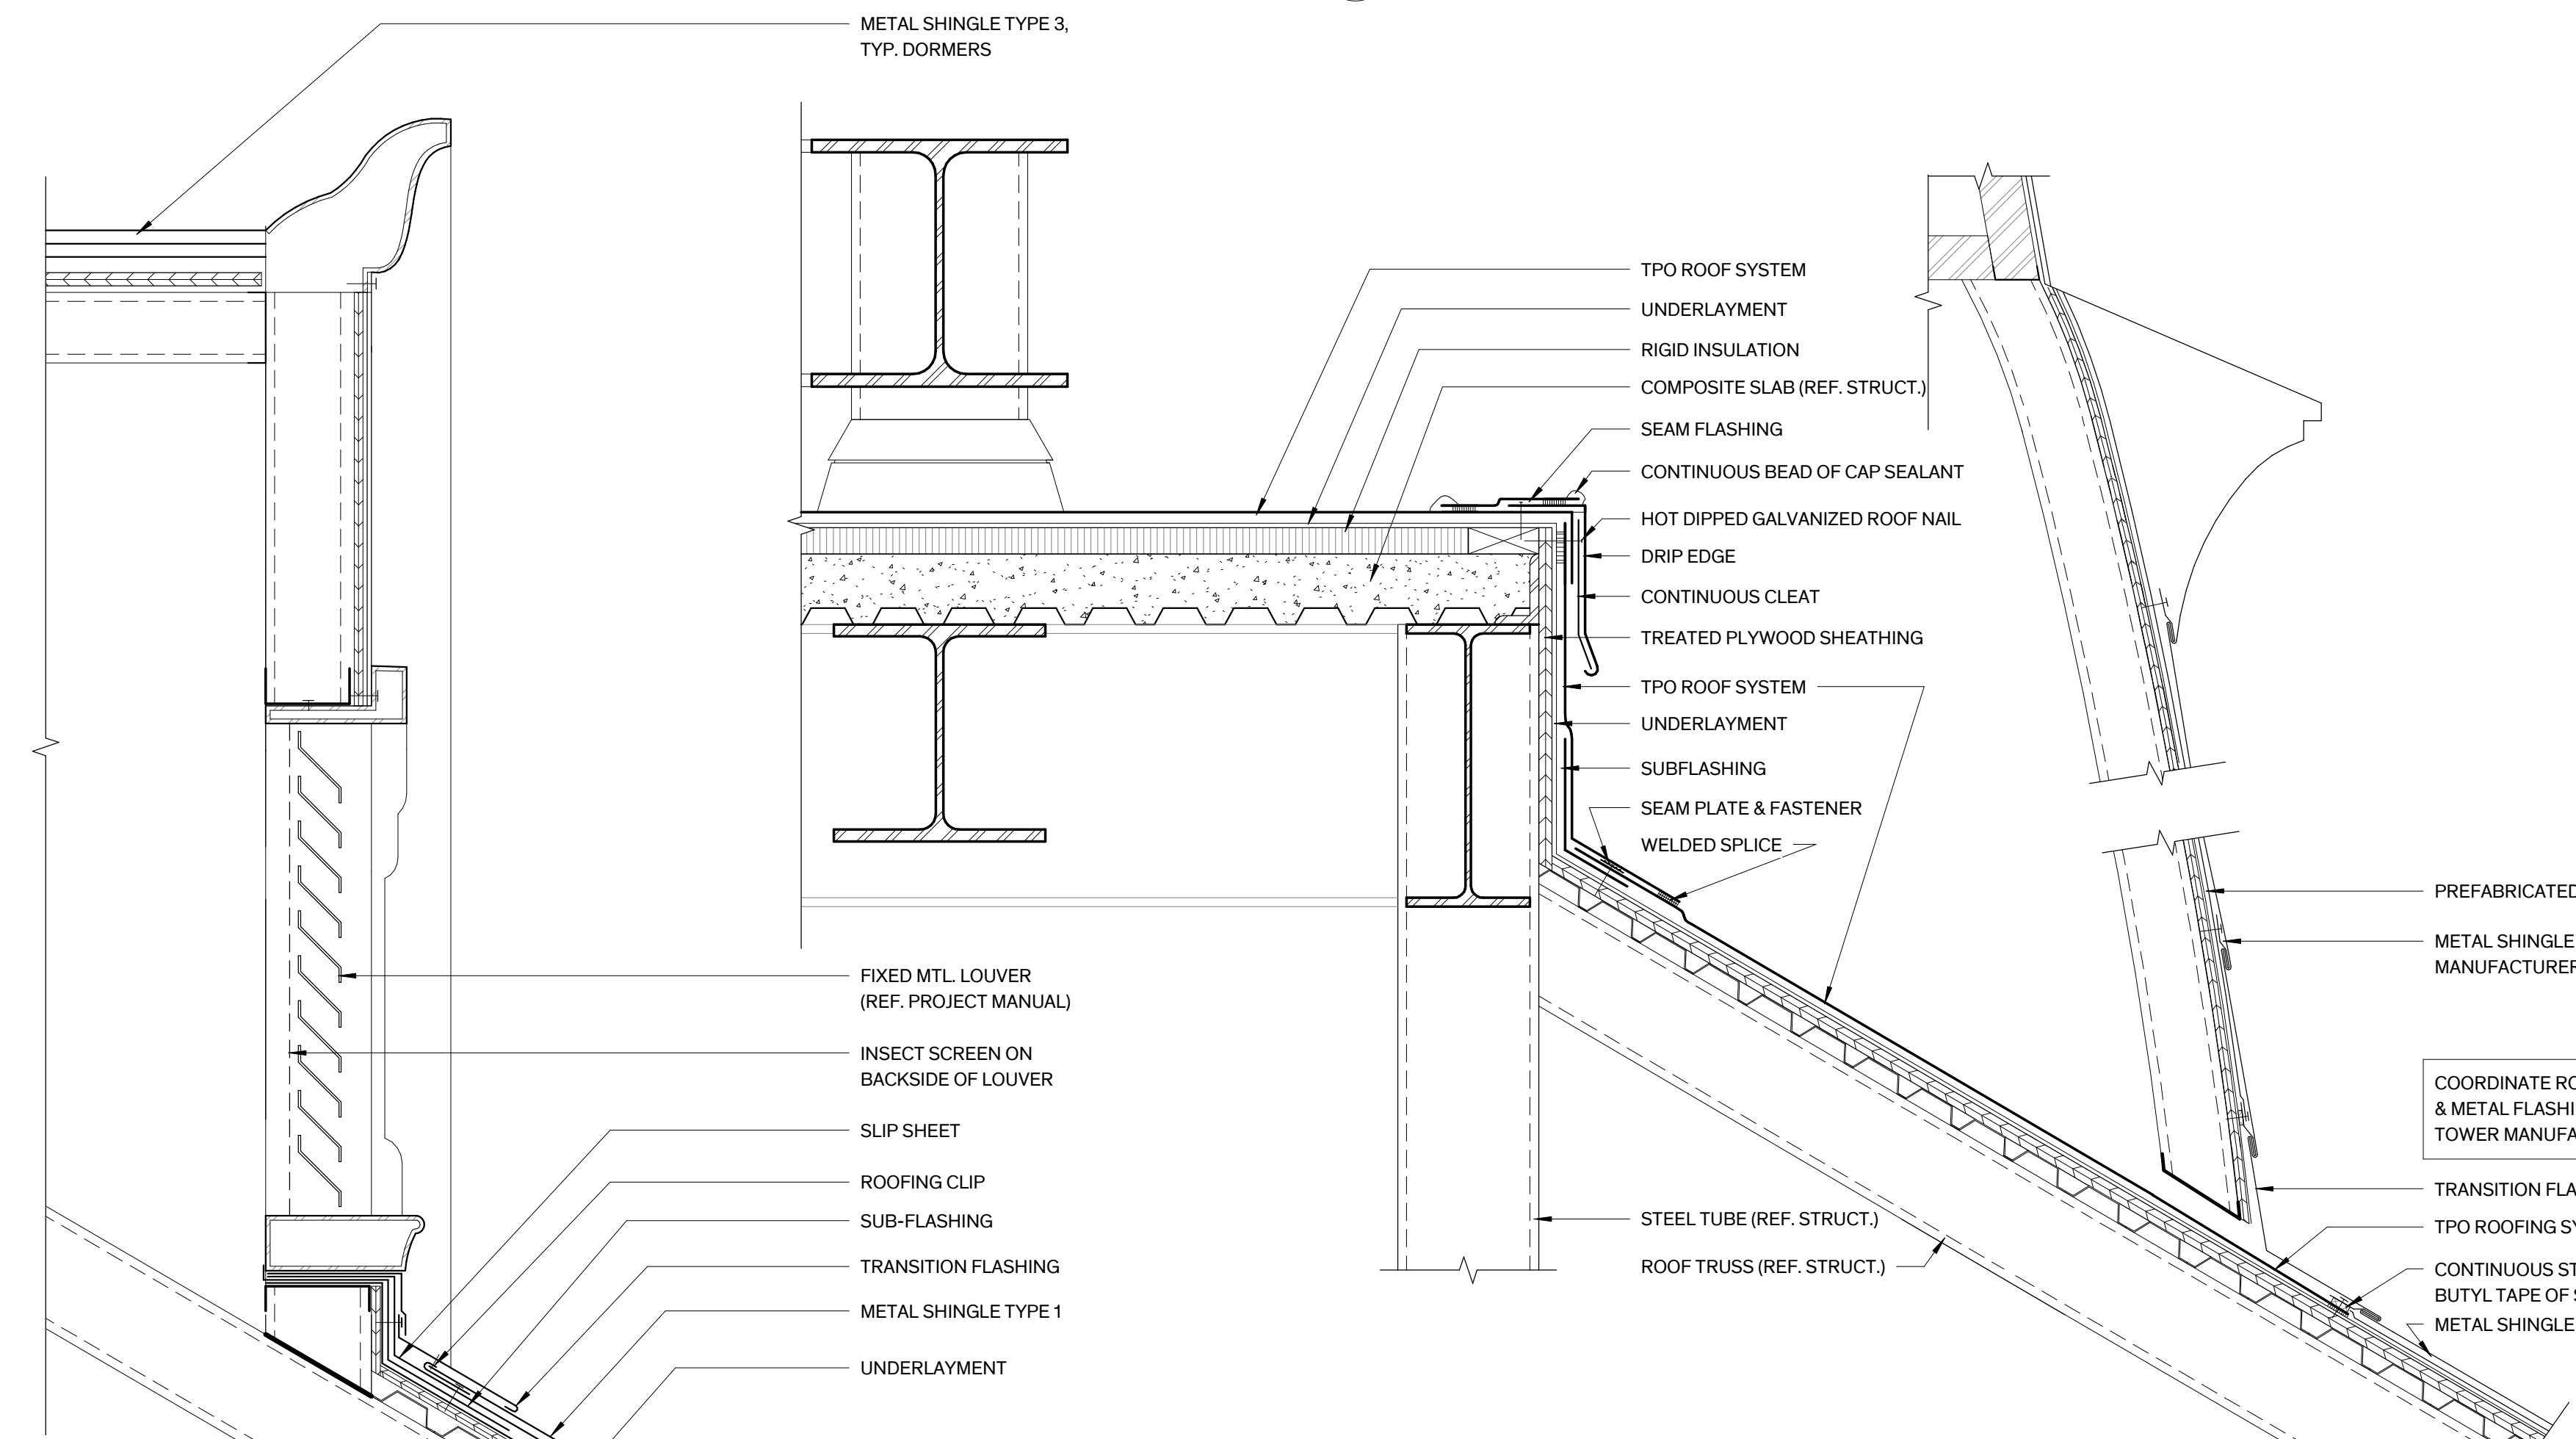


**4 Tower Base Detail**  
 1 1/2\"/>

**6 Dormer Detail**  
 1 1/2\"/>

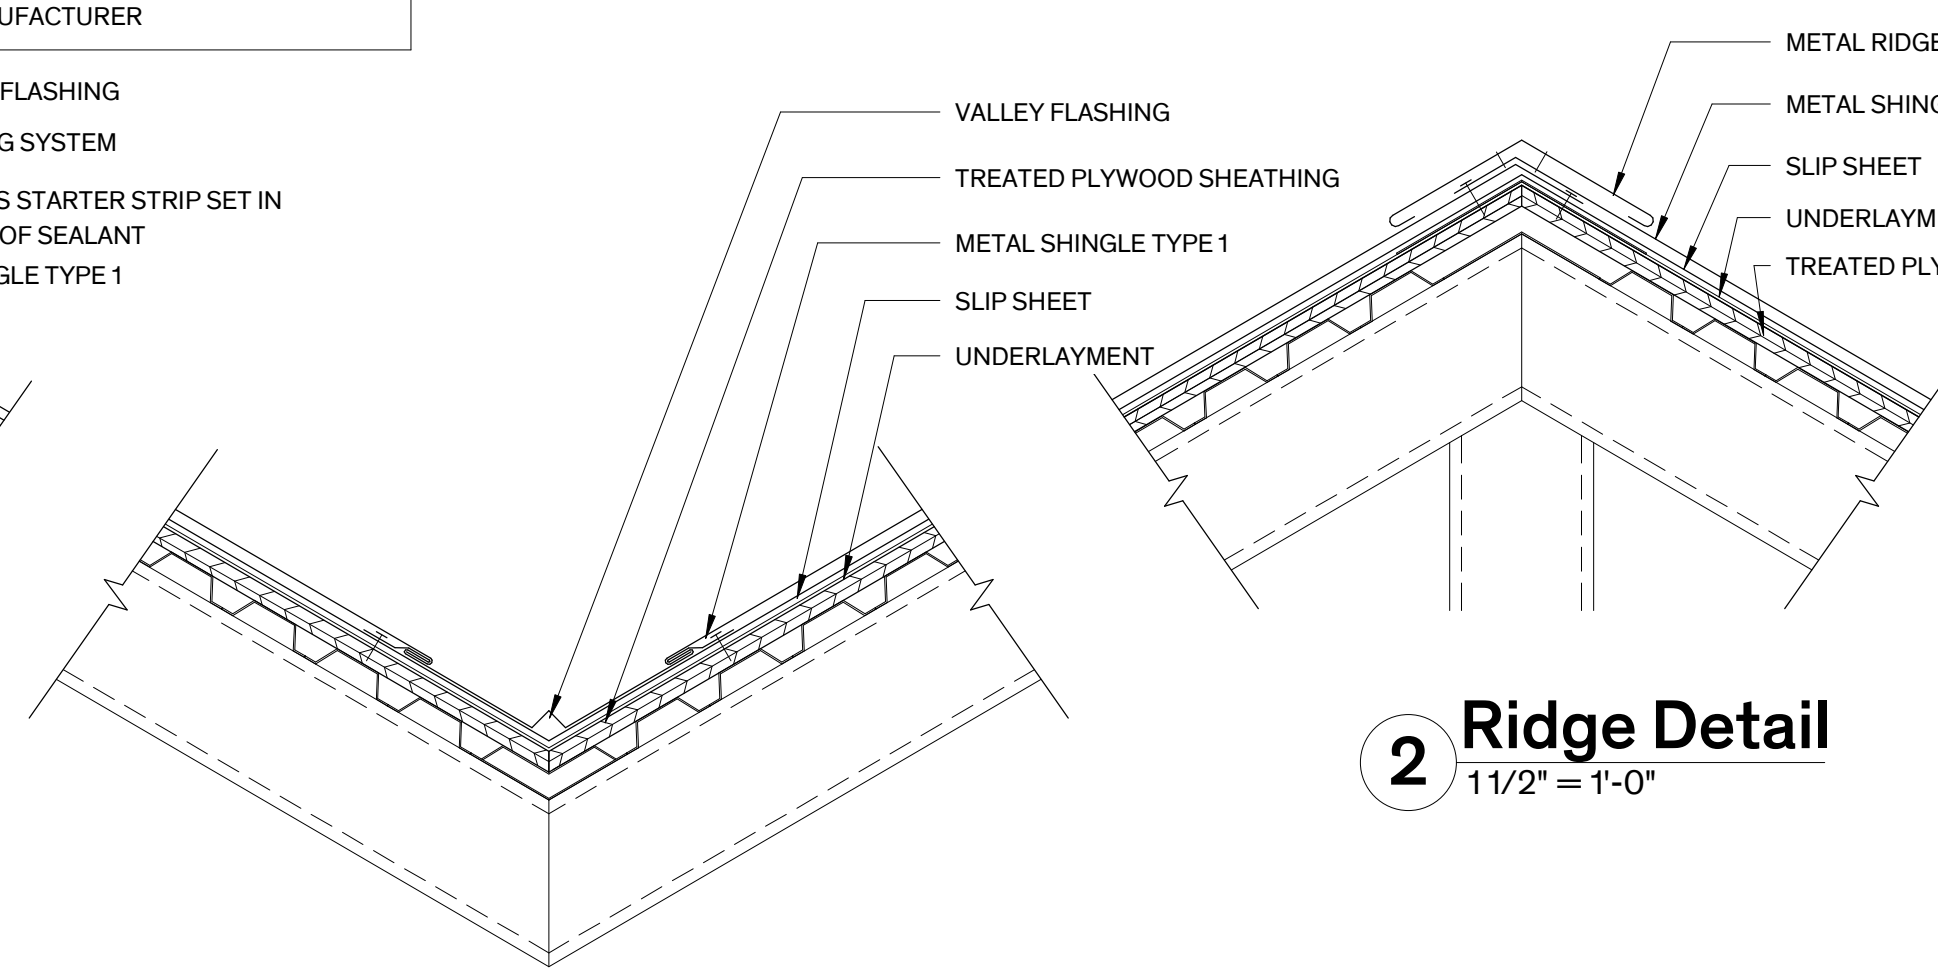


**3 Valley Detail**  
 1 1/2\"/>

**2 Ridge Detail**  
 1 1/2\"/>

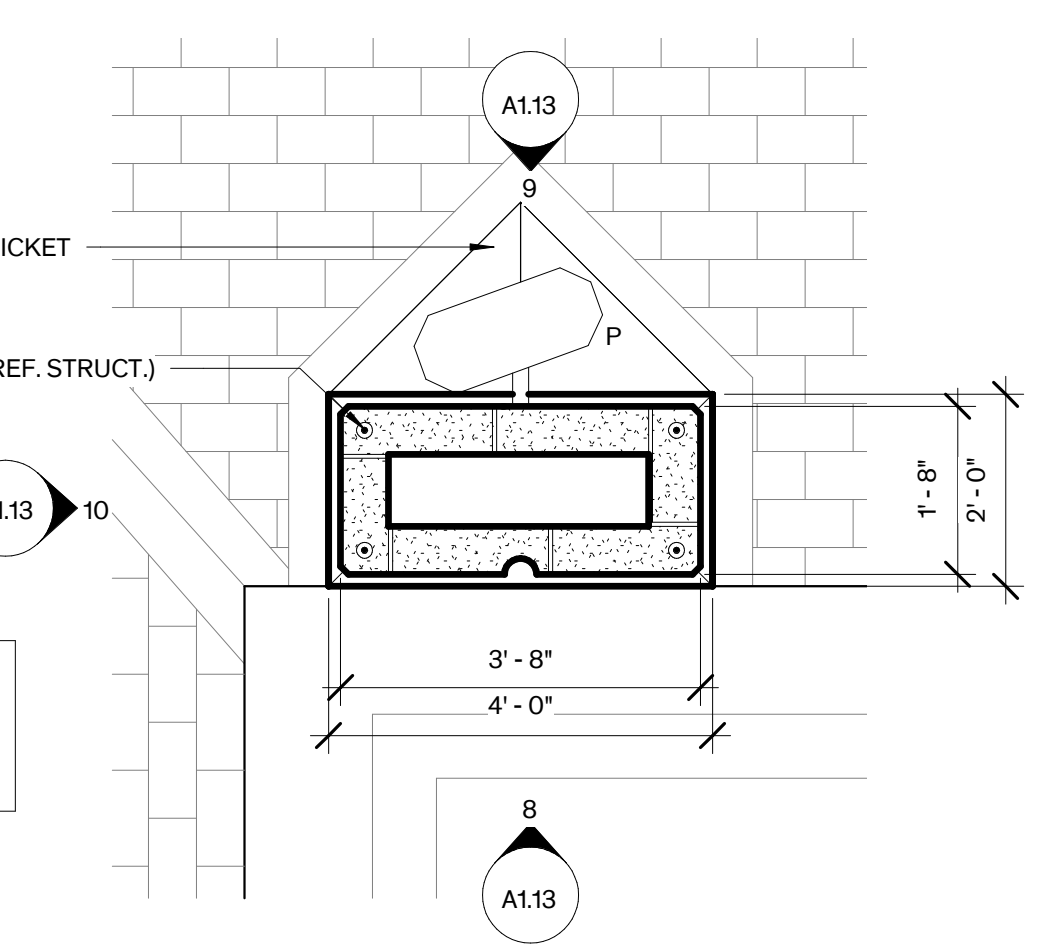


**7 Typical Chimney Plan**  
 1/2\"/>

NOTE:  
 REF. STRUCTURAL FOR  
 REINFORCEMENT  
 REQUIREMENTS

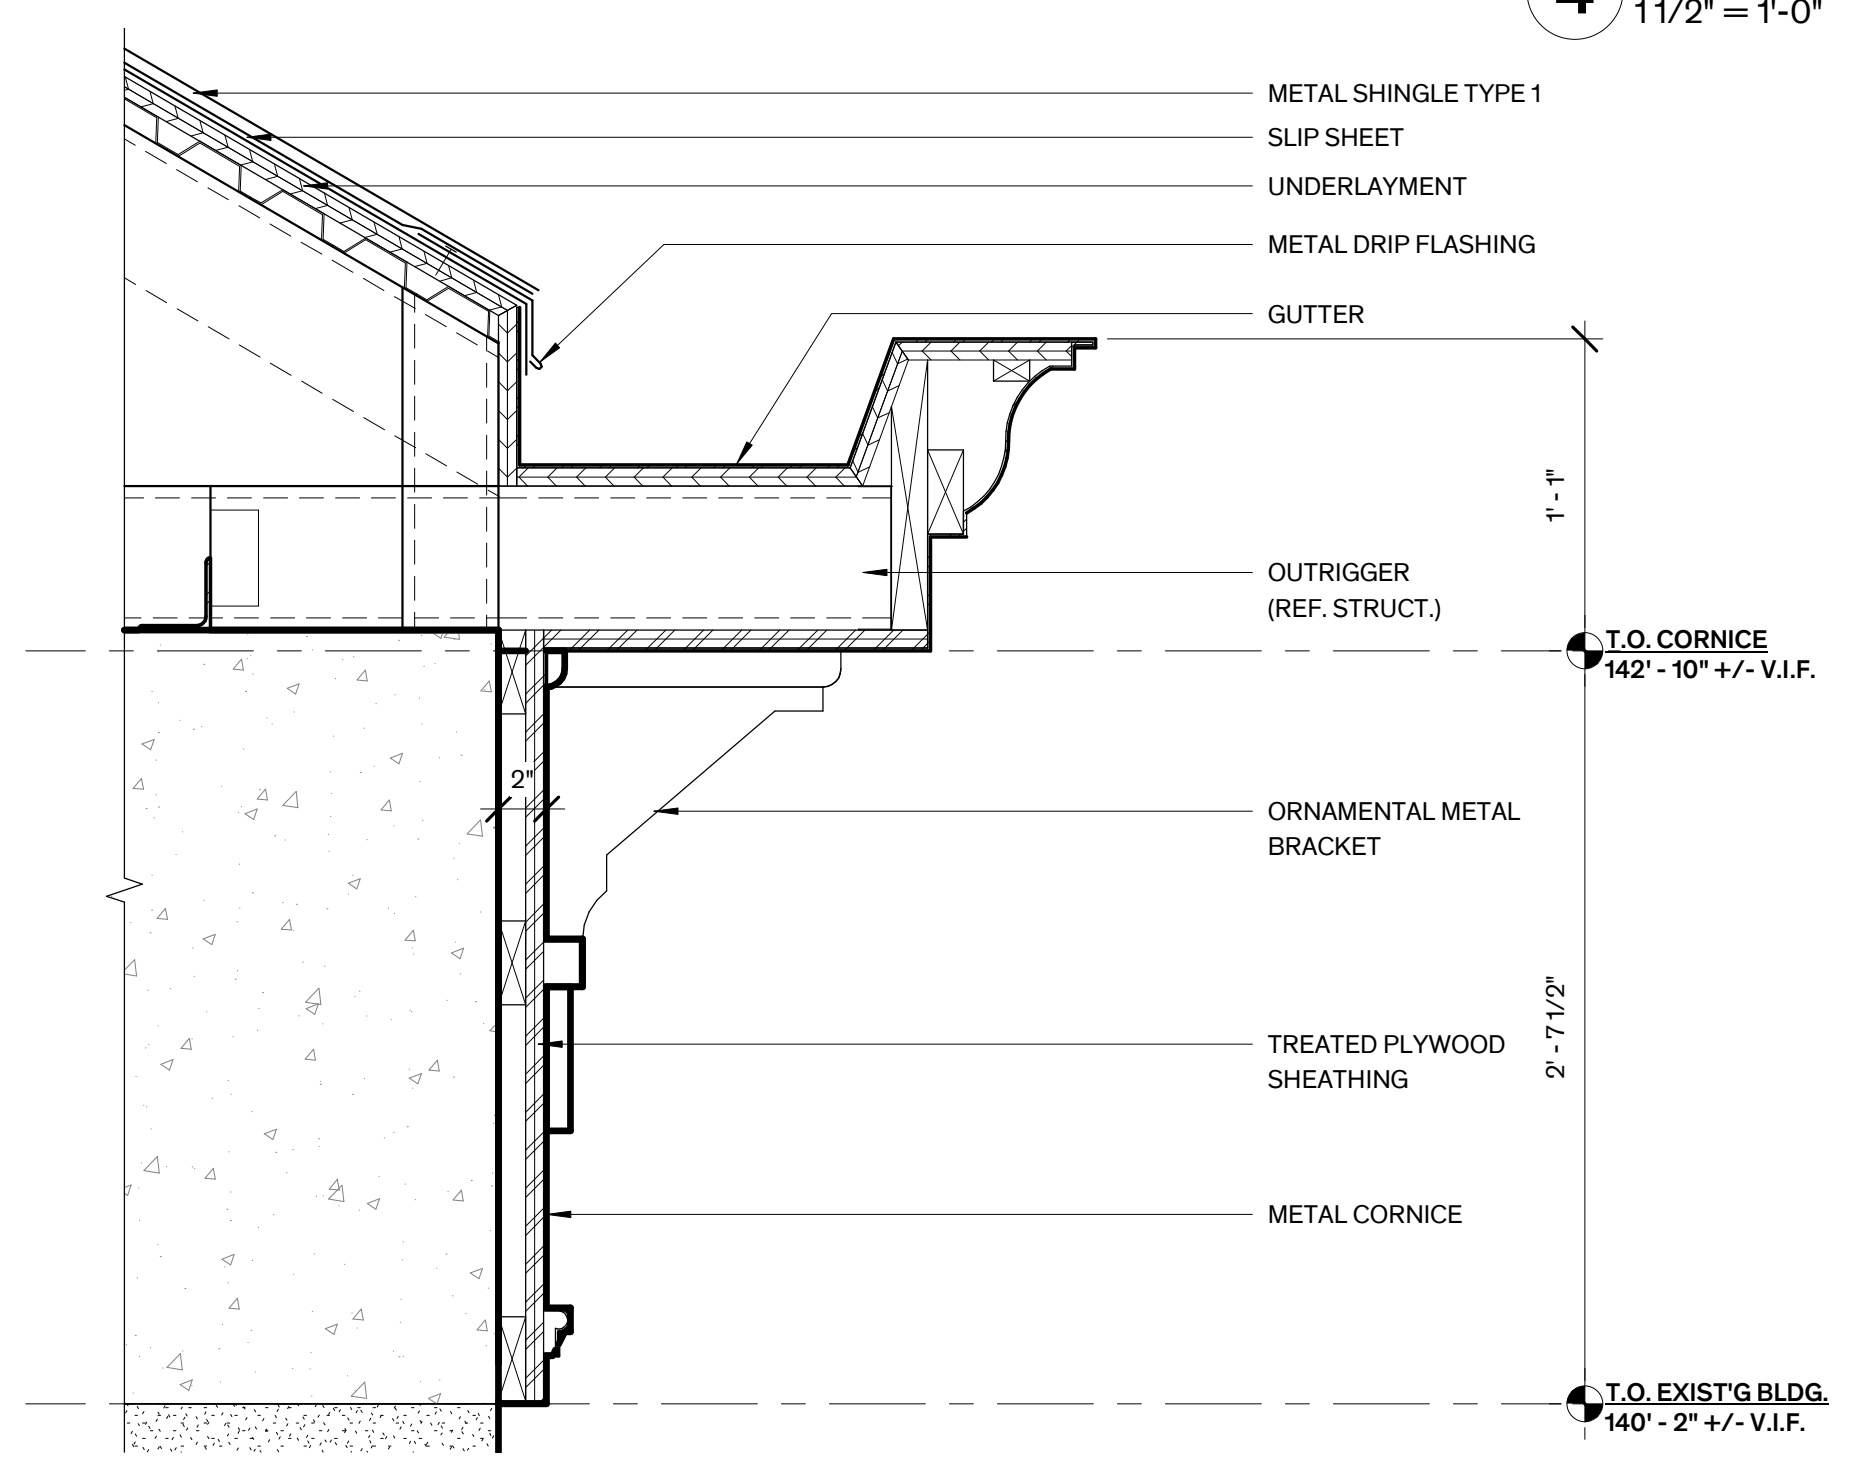

**5 Cornice Gutter Detail**  
 1 1/2\"/>

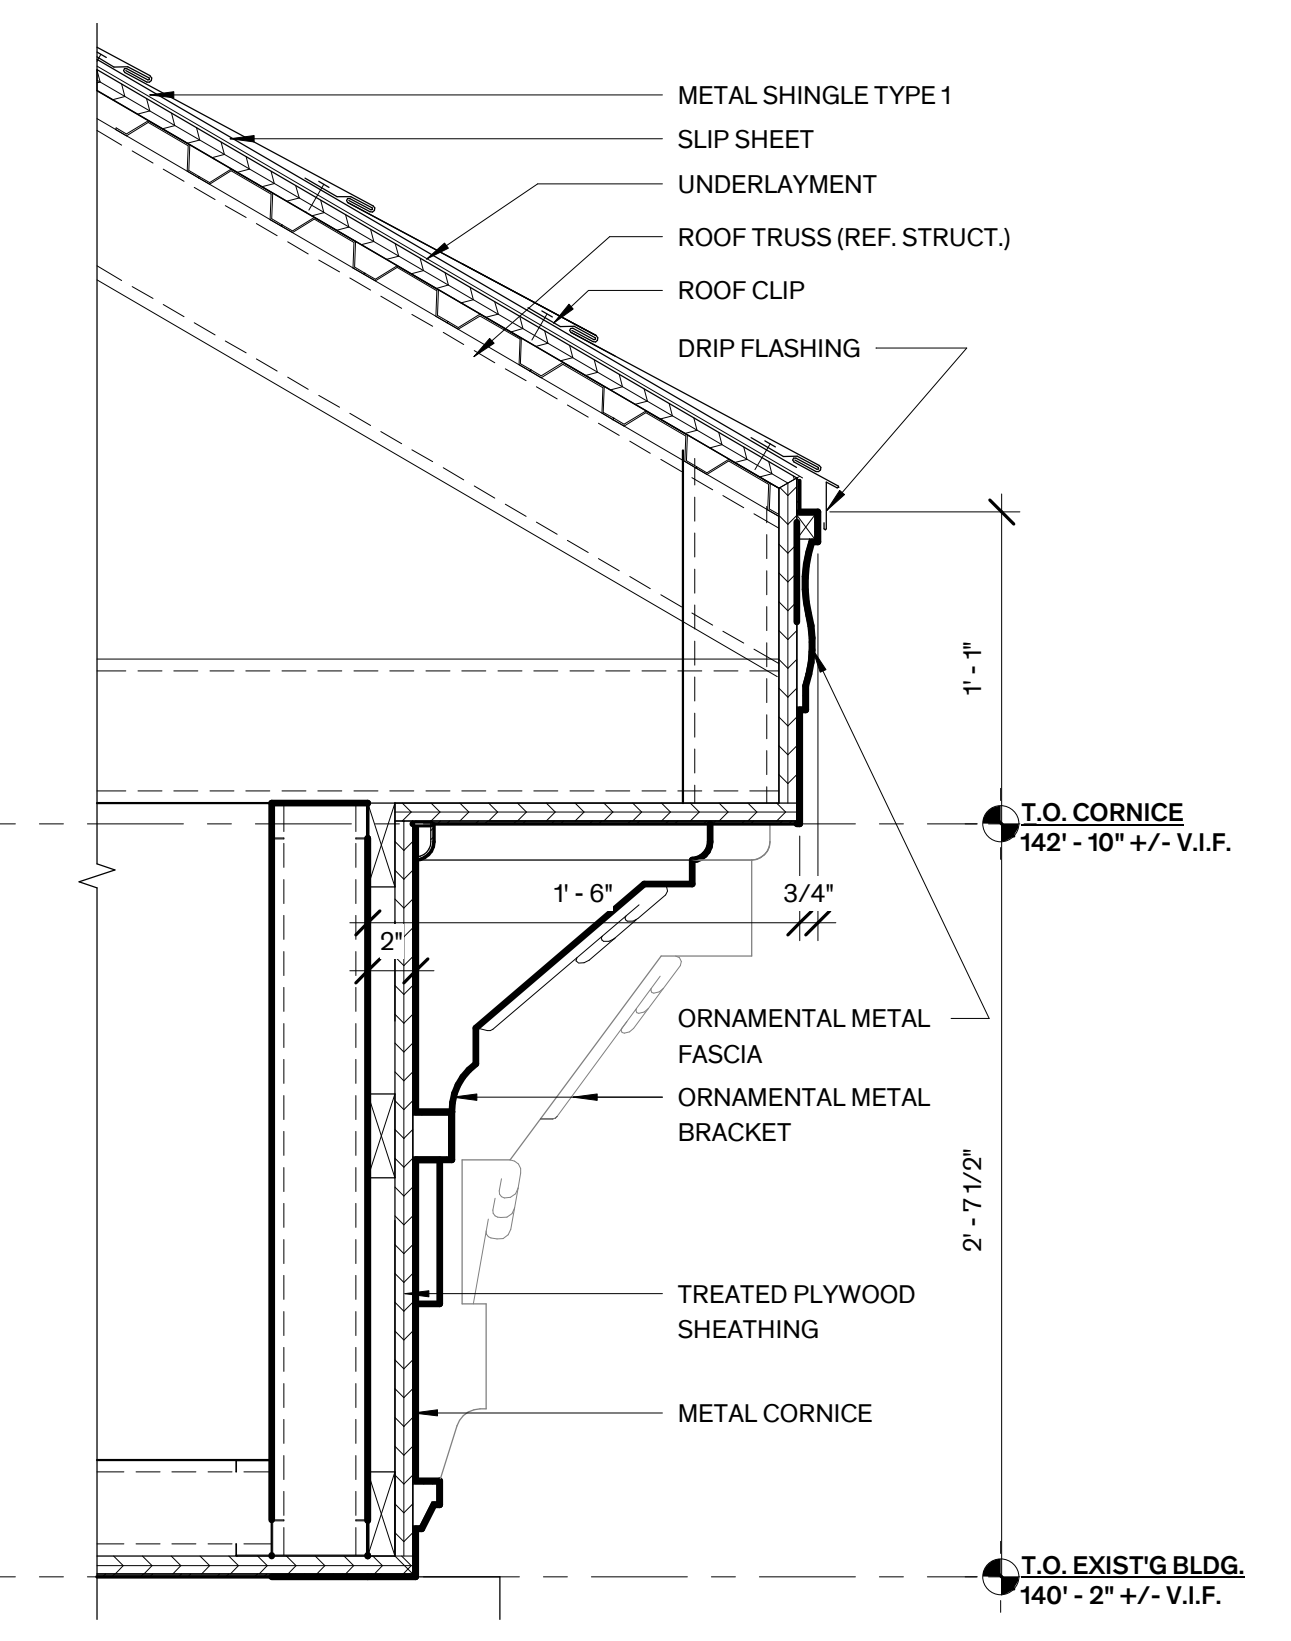

**1 Cornice Detail**  
 1 1/2\"/>



FANNIN COUNTY  
 COURTHOUSE  
 INTERIOR & EXTERIOR RESTORATION  
 101 E. Sam Rayburn Drive  
 Bonham, Texas 75418

COPYRIGHT  
 The Contractor shall verify and be responsible for all dimensions. DO NOT scale the drawing. Any errors or omissions shall be reported to Architexas without delay. The Copyrights to all designs and drawings are the property of Architexas. Reproduction or use for any purpose other than that authorized by Architexas is forbidden.

REVISION HISTORY  
 1 Oct. 16, 2018 Addendum #1

ISSUED FOR CONSTRUCTION




#18326 9/21/2018

Architexas No. 1737 Date SEPT. 21, 2018


Sheet Name ROOF DETAILS

Sheet Number A1.14




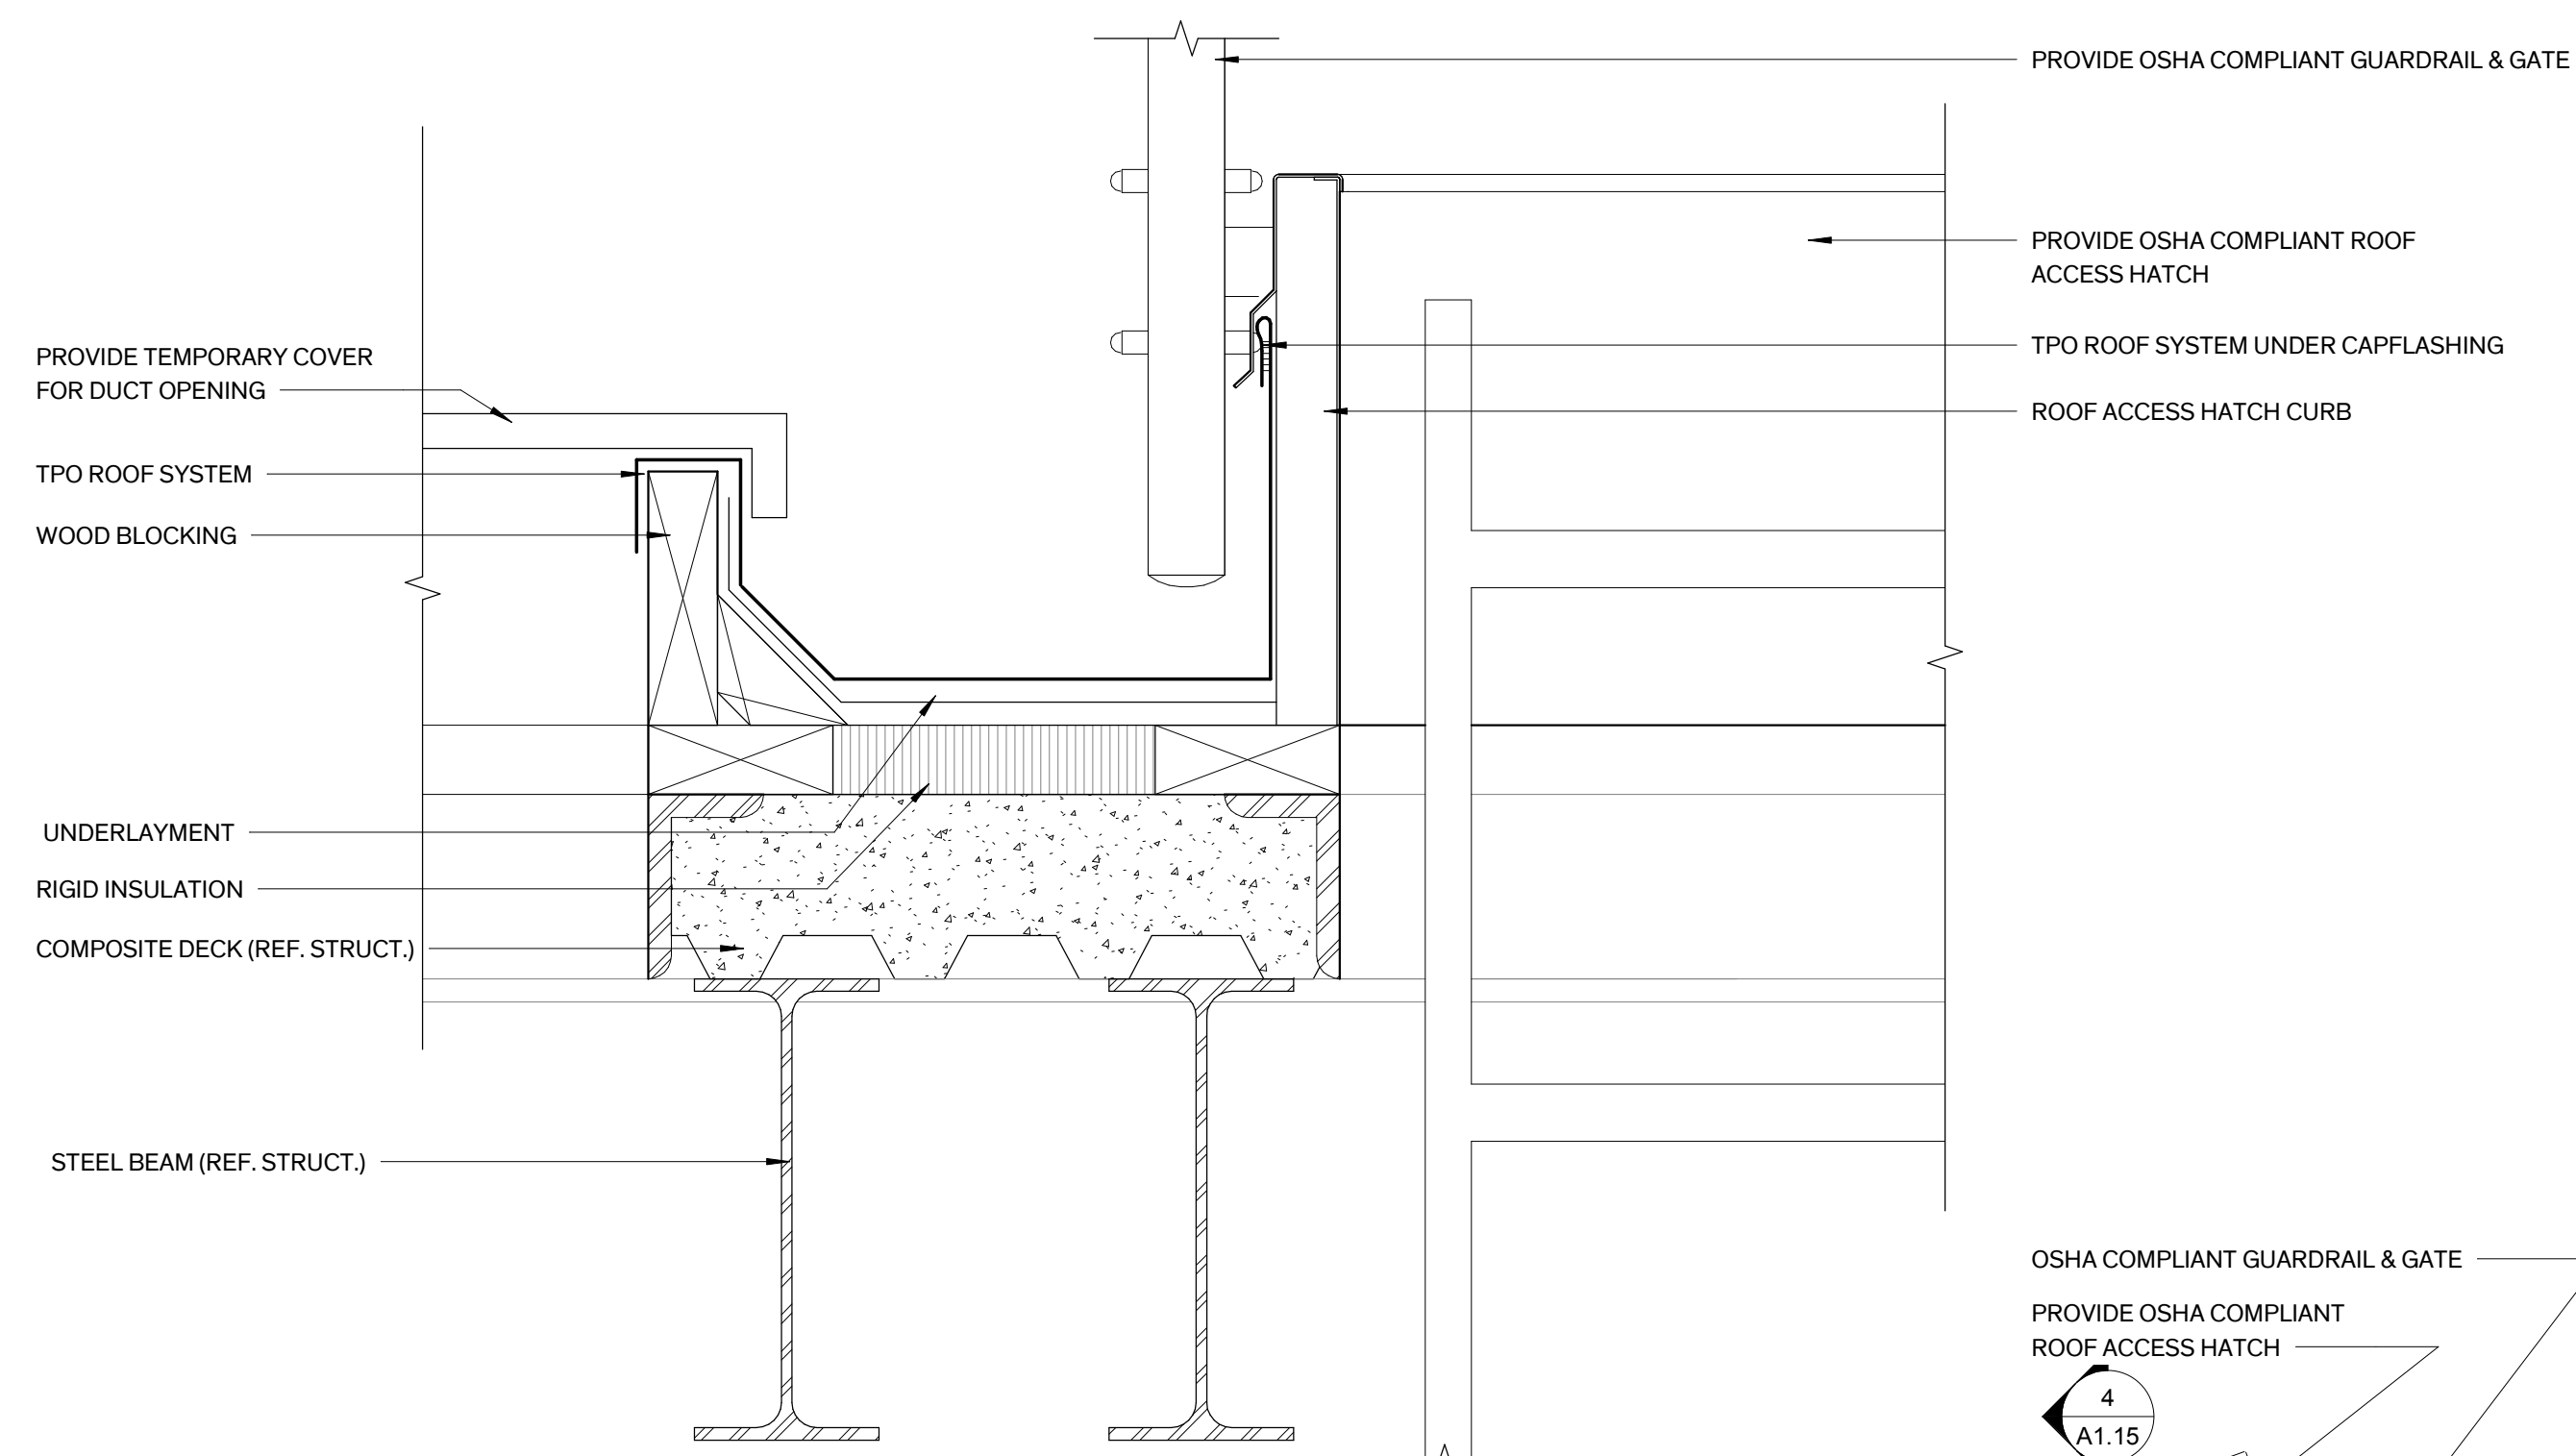

**4 Curb Details @ Access Hatch & Duct Opening**  
3" = 1'-0"

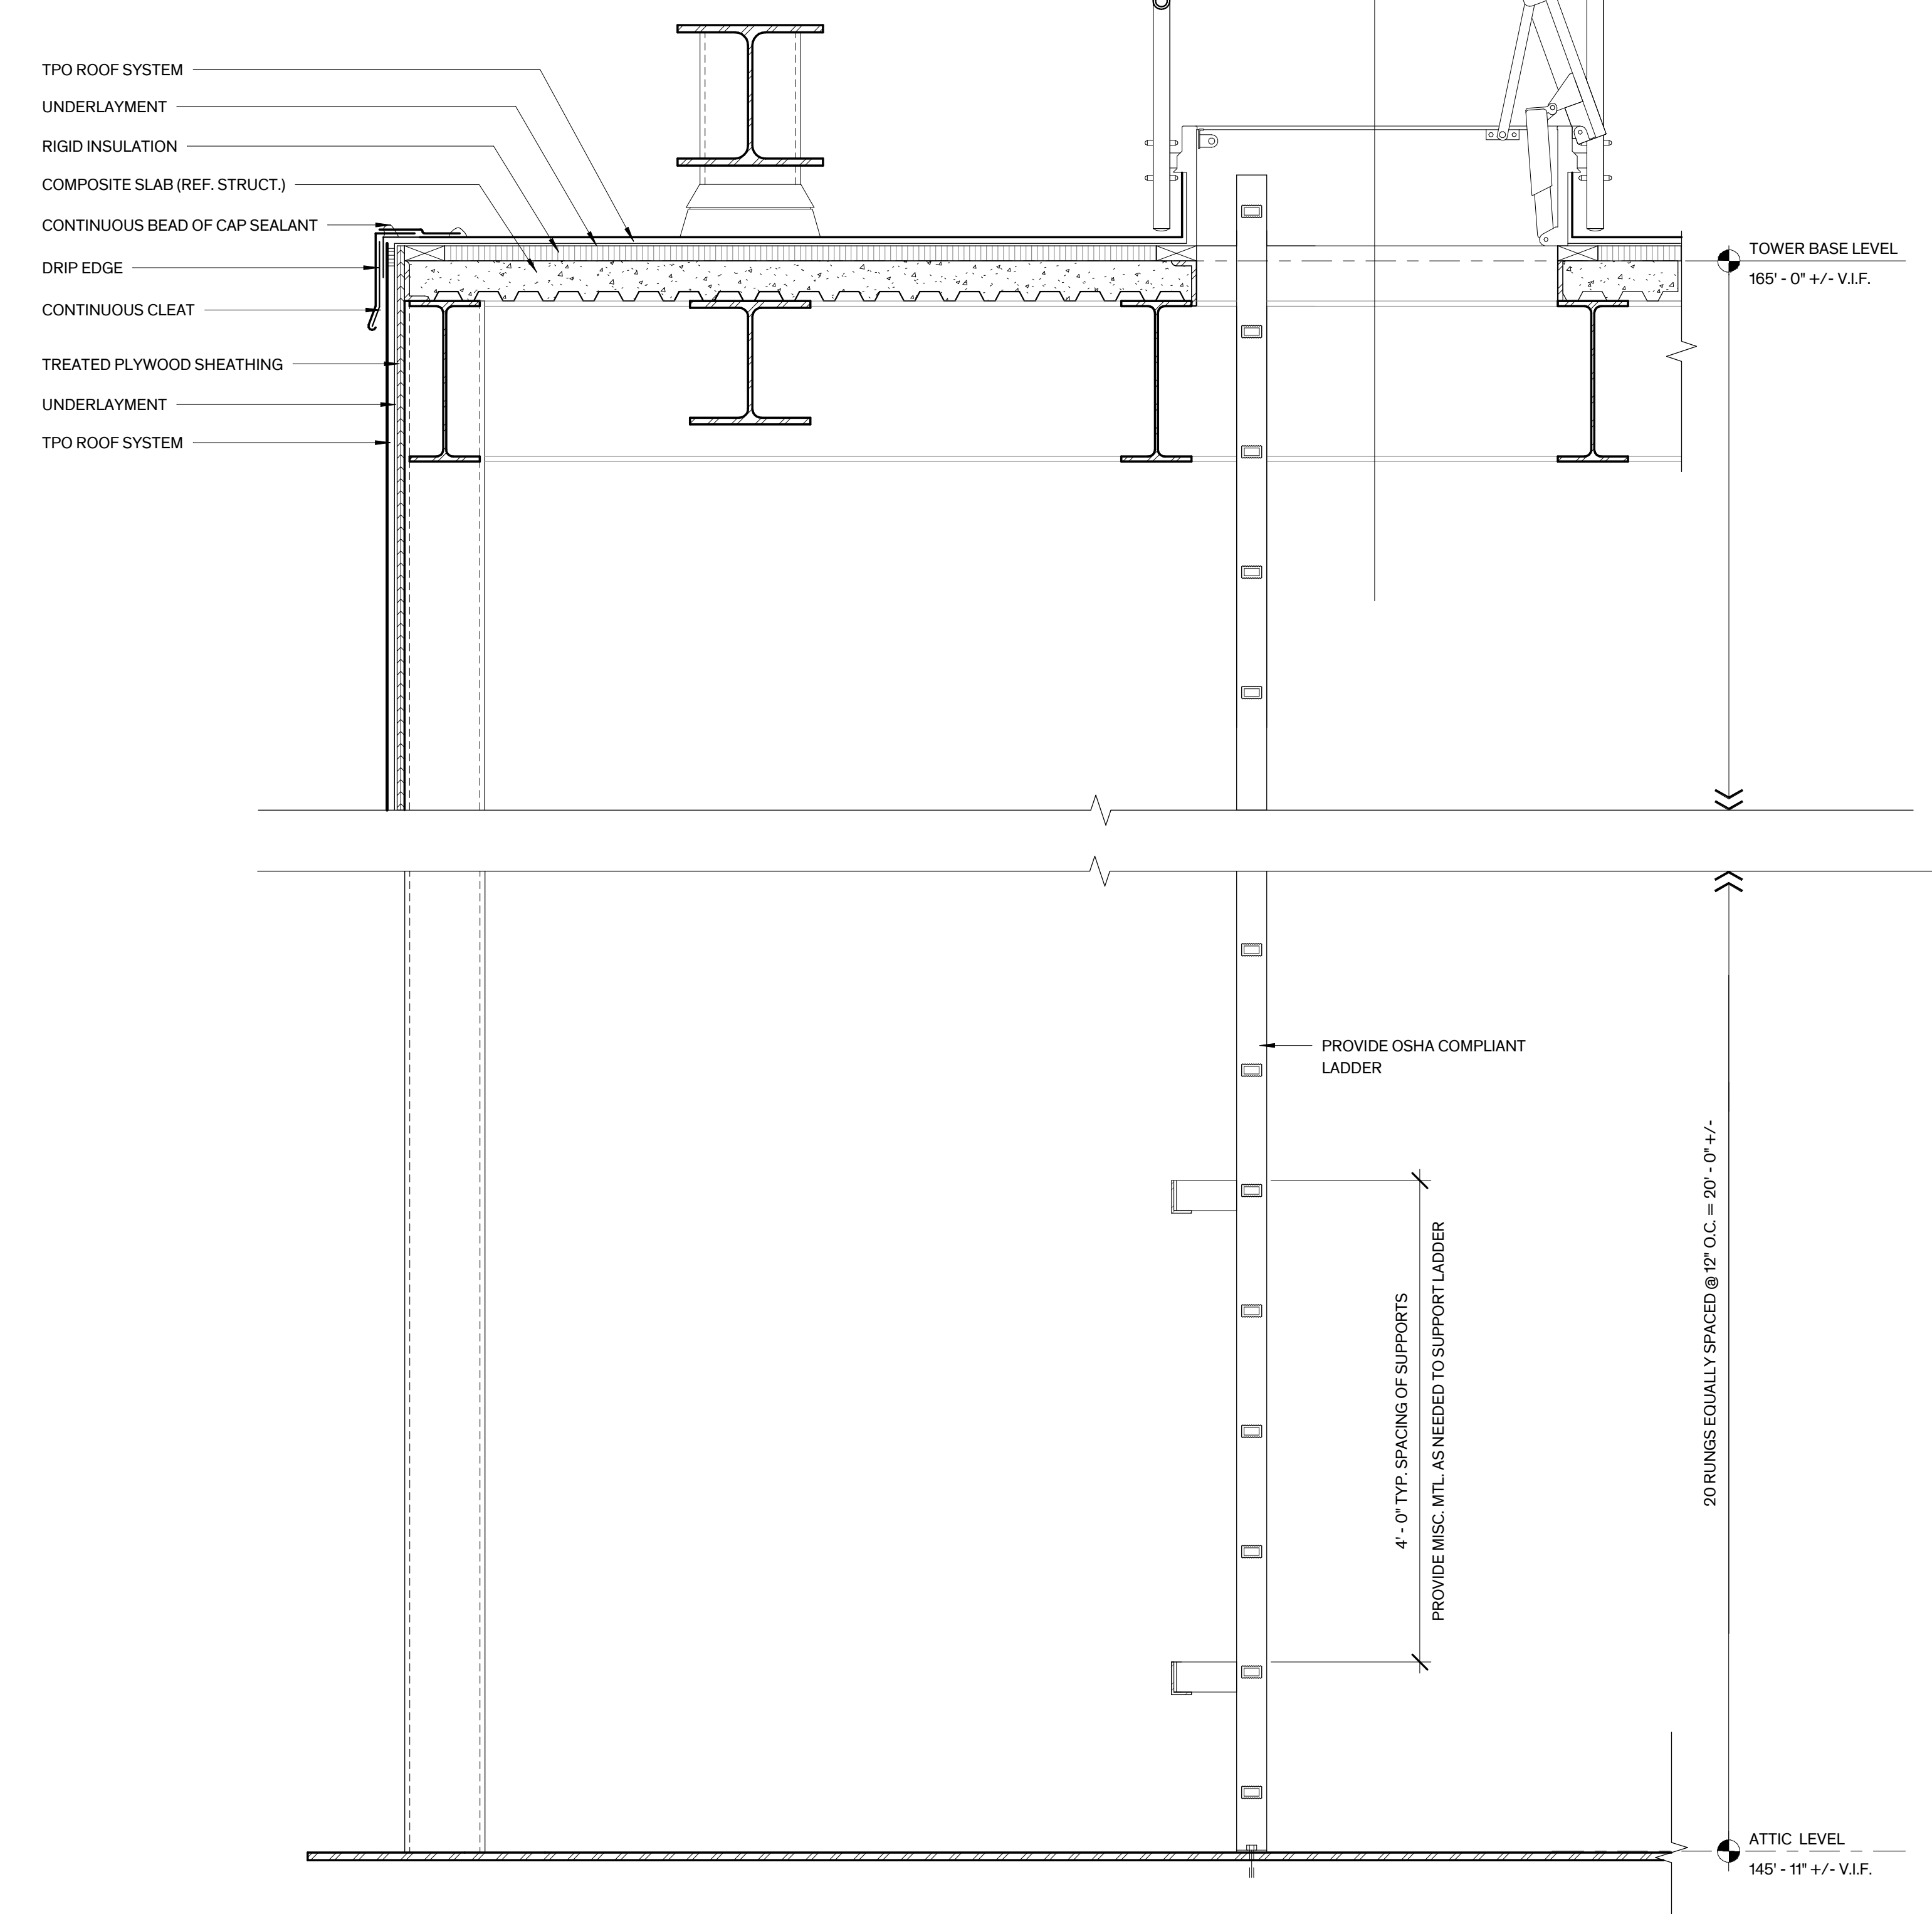


**2 Ladder Section**  
1" = 1'-0"

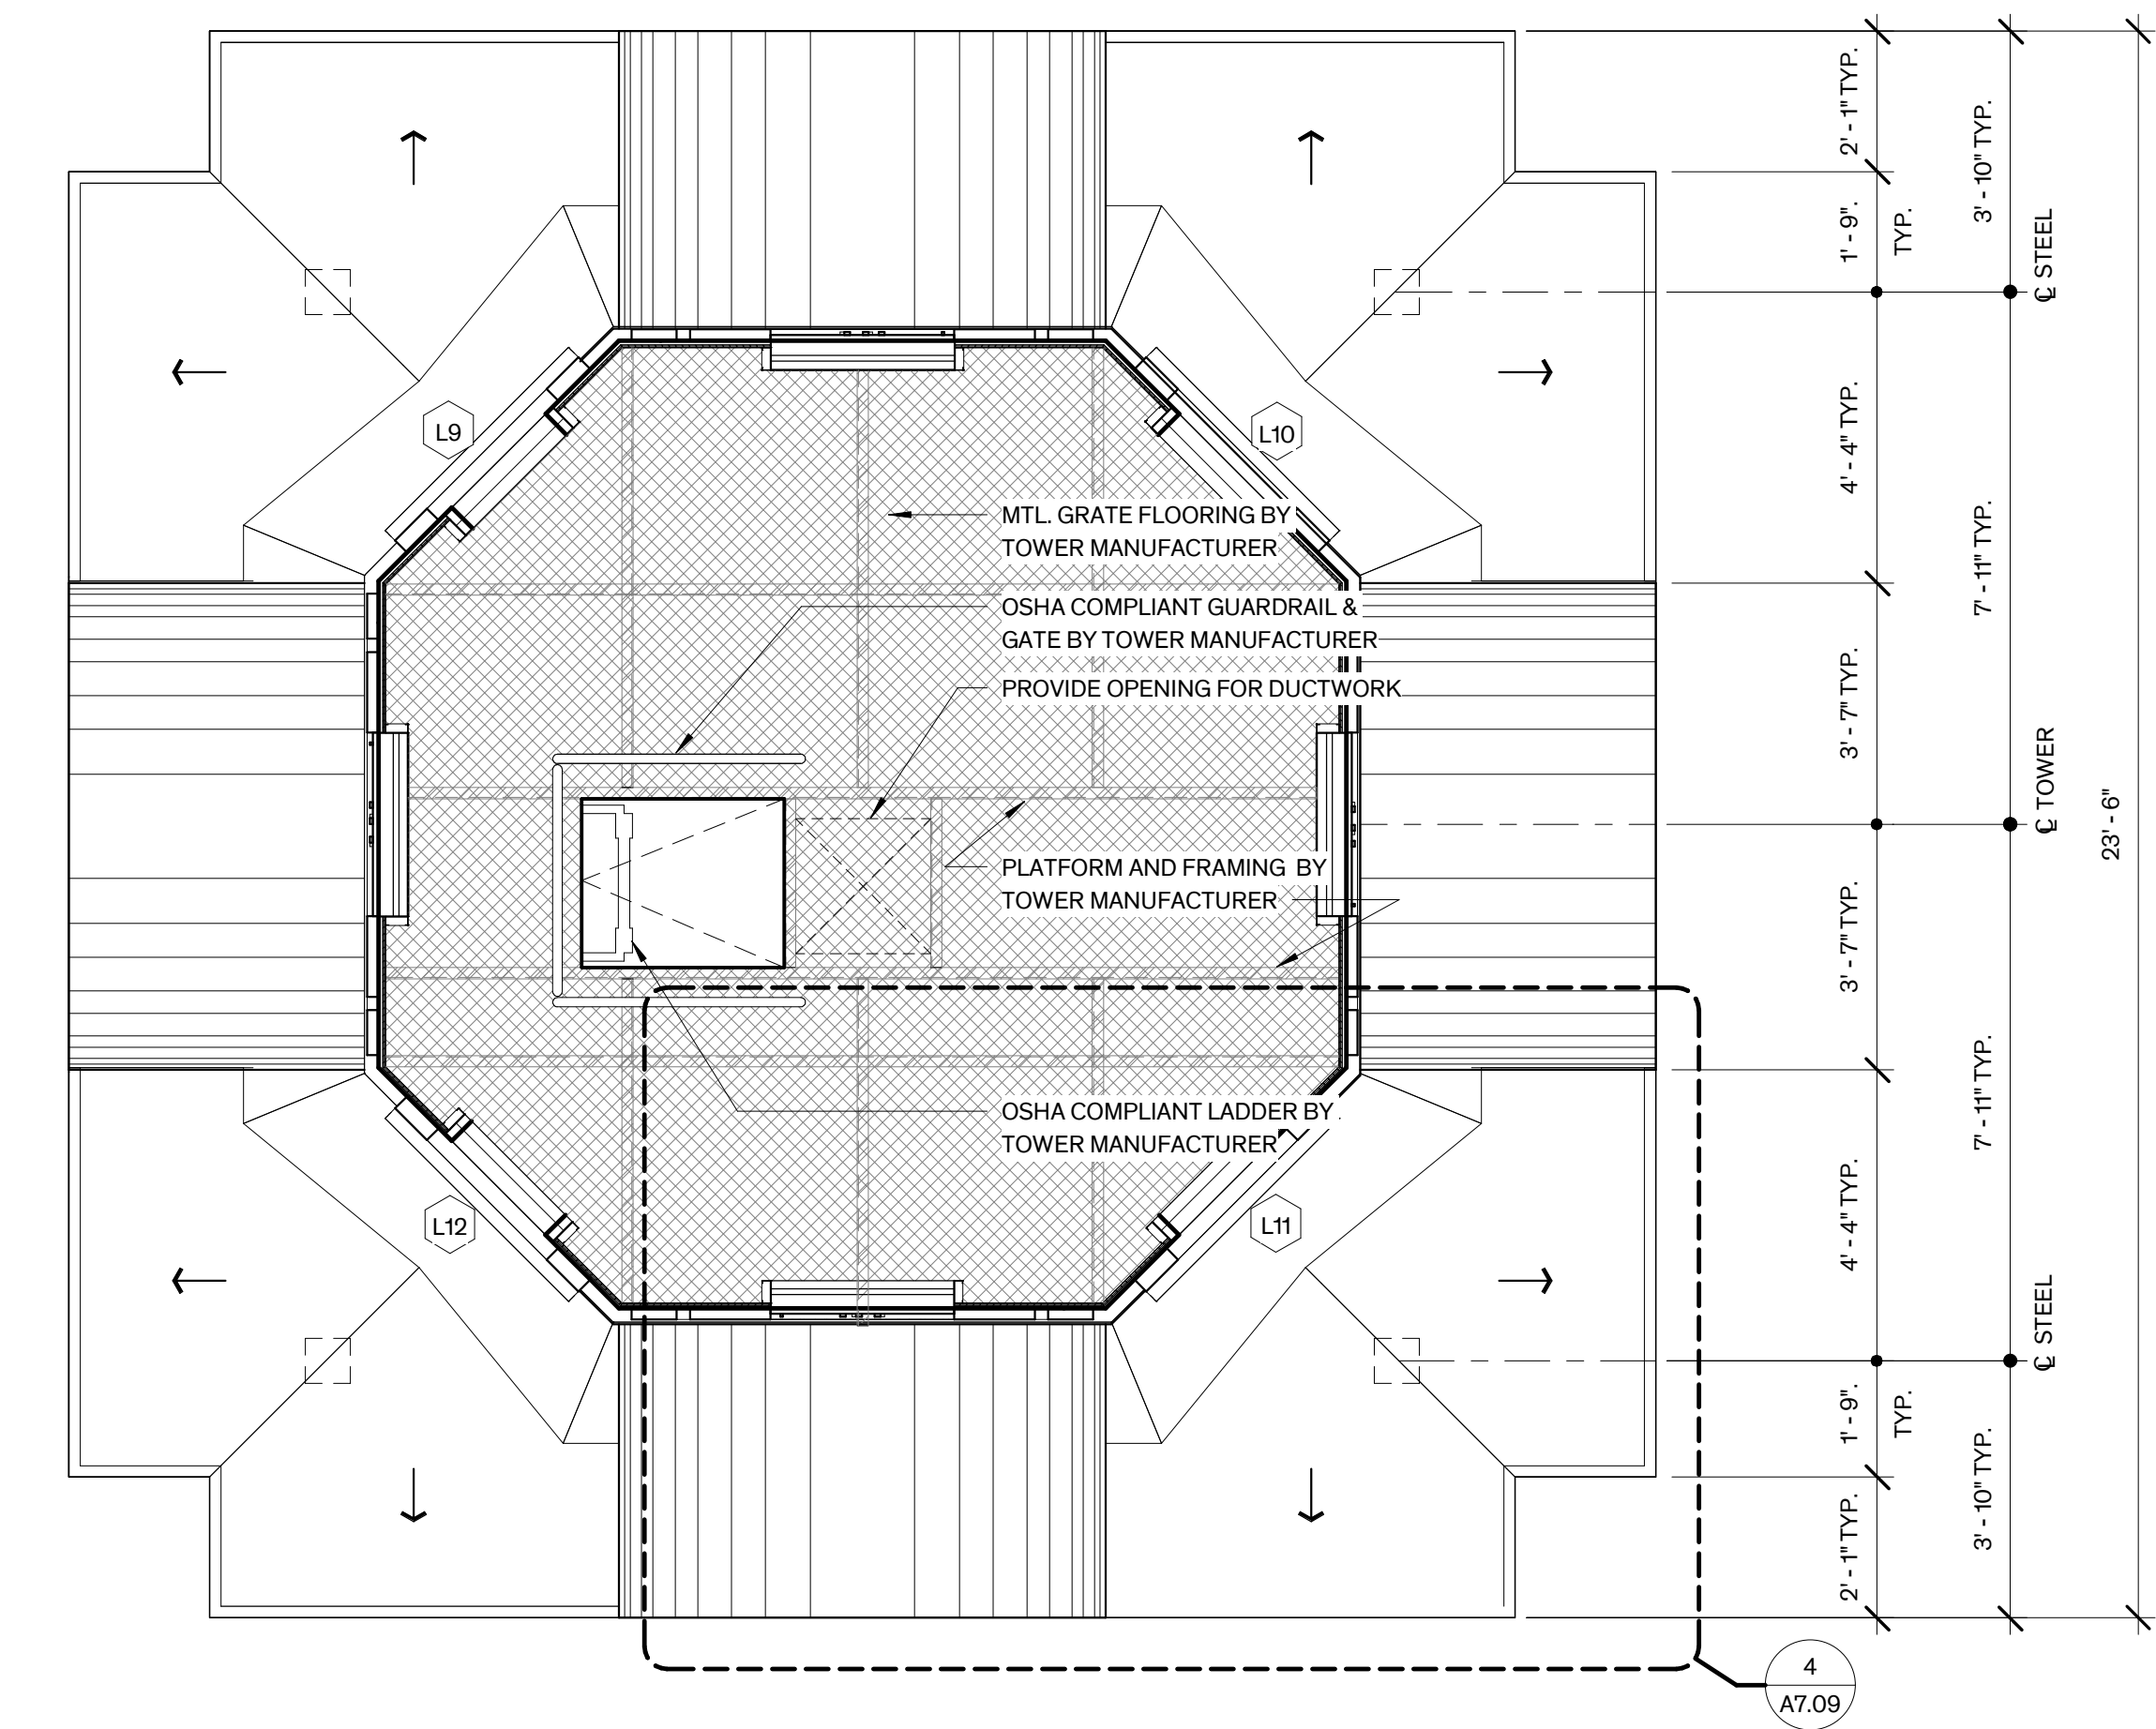

**3 Tower Clock Level Plan**  
3/8" = 1'-0"

NOTE:  
TOWER DRAWINGS ILLUSTRATE DESIGN INTENT FOR PRICING PURPOSES ONLY. DETAILS ARE TO BE COORDINATED WITH PREFABRICATED TOWER MANUFACTURER.

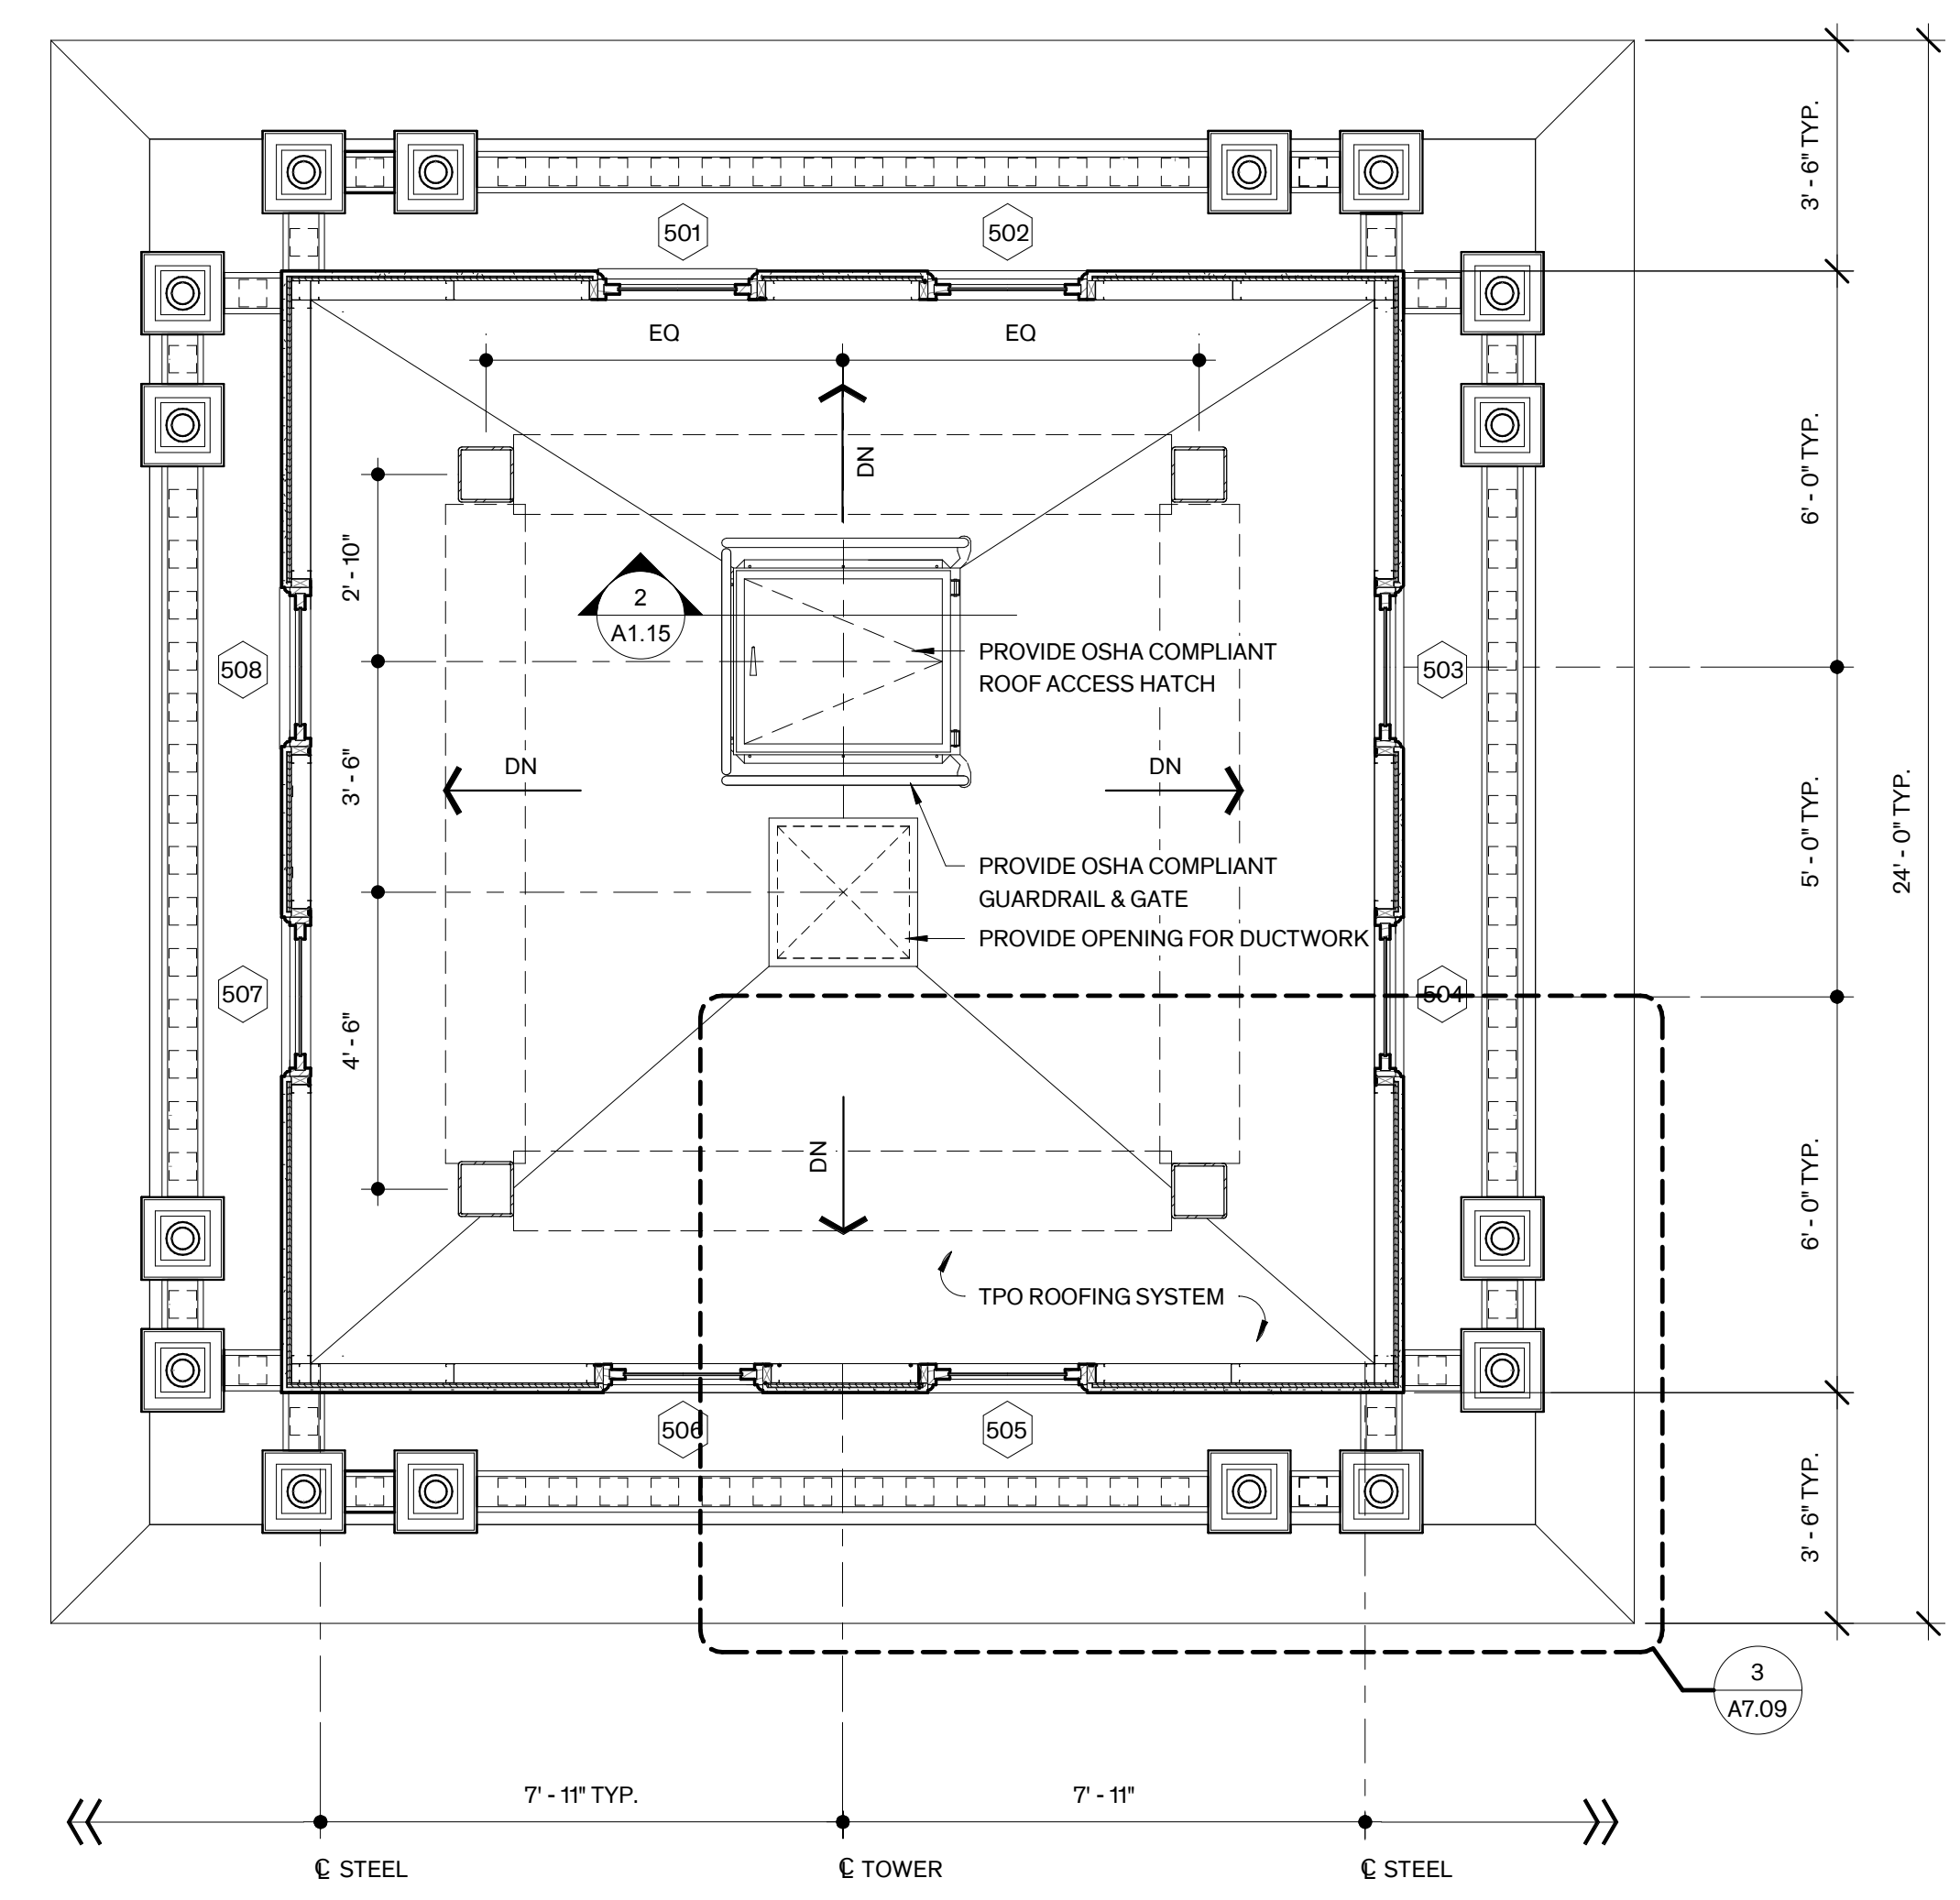

**1 Tower Base Level Plan**  
3/8" = 1'-0"



**FANNIN COUNTY COURTHOUSE**  
INTERIOR & EXTERIOR RESTORATION  
101 E. Sam Rayburn Drive  
Bonham, Texas 75418

**COPYRIGHT**  
The Contractor shall verify and be responsible for all dimensions. DO NOT scale the drawing. Any errors or omissions shall be reported to Architexas without delay. The Copyrights to all designs and drawings are the property of Architexas. Reproduction or use for any purpose other than that authorized by Architexas is forbidden.


**REVISION HISTORY**  
1 Oct. 16, 2018 Addendum #1

ISSUED FOR CONSTRUCTION



Architexas No. 1737 Date SEPT. 21, 2018

Sheet Name **TOWER LEVEL FLOOR PLANS & LADDER DETAILS**

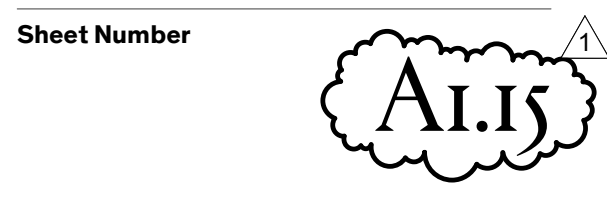



GENERAL NOTES

- GENERAL:**
- PROTECT EXISTING MATERIALS DURING CONSTRUCTION THAT ARE SCHEDULED TO REMAIN. DAMAGE TO EXISTING FINISH SURFACES BY THE CONTRACTOR SHALL BE CORRECTED IN KIND AT NO ADDITIONAL COST TO THE OWNER.
  - PROVIDE TEMPORARY WEATHERTIGHT CLOSURES FOR EXTERIOR OPENINGS TO PROVIDE ACCEPTABLE INTERIOR WORKING CONDITIONS AND PREVENT ENTRY OF UNAUTHORIZED PERSONS.
  - REMOVE NON-ORIGINAL MASONRY AT ORIGINAL WINDOW OPENINGS.
  - FINISH FLOOR ELEVATIONS:
    - EXIST'G ELEVATIONS & CEILING HEIGHTS ARE APPROXIMATE & ARE TO BE VERIFIED IN THE FIELD BY CONTRACTOR.
    - FINAL ELEVATIONS & CEILING HEIGHTS WILL BE DETERMINED ONCE NEW FINISH FLOOR LEVELS ARE ESTABLISHED IN CORRIDORS.

- MASONRY CLEANING**
- CLEAN EXISTING LIMESTONE SURFACES WITH APPROVED PROCEDURES NOTED IN PROJECT MANUAL AND REPORT FROM WJE.
  - PROVIDE MOCKUP TO DETERMINE APPROPRIATE METHOD WITH GENTLEST MEANS POSSIBLE.
  - SANDBLASTING AND THE USE OF NON-PROPRIETARY ACIDS IS PROHIBITED.
  - FOLLOW MANUFACTURER'S INSTRUCTIONS AND PROCEDURES ESTABLISHED DURING PREPARATION OF MOCKUP.
  - DO NOT DAMAGE EXISTING SURFACES. LEAVE SURFACES UNIFORM IN APPEARANCE PRIOR TO PATCH APPLICATION.
  - THE EXISTING PAINT LAYERS UNDERNEATH THE MASTIC ON THE EXTERIOR MASONRY IS KNOWN TO CONTAIN LEAD. WASTE GENERATED BY COATING REMOVAL PROCESS SHALL BE CLASSIFIED AS HAZARDOUS MATERIAL AND SHALL BE REMOVED IN ACCORDANCE WITH EPA & OSHA GUIDELINES.

- REMOVAL OF FASTENERS**
- REMOVE EXISTING FASTENERS, BOLTS, CLAMPS, STRAPS, ETC. ON THE EXTERIOR OF THE BUILDING THAT ARE ATTACHED OR EMBEDDED IN EXISTING MATERIALS AND ARE NOT BEING USED TO FASTEN ELEMENTS TO REMAIN.
  - REMOVE EXISTING ANCHORS, FASTENERS AND THE WIRE USING CORE DRILL.
  - WIDTH AND DEPTH OF CORE DRILLED HOLES TO BE DETERMINED BY MASONRY REPAIR MANUFACTURER.
  - PROVIDE MOCKUP OF EACH TYPE OF ANCHOR REMOVAL TO DETERMINE APPROPRIATE METHOD.
  - TREAT EXPOSED FERROUS METAL WITHIN REPAIR AREA WITH COATING BY MASONRY REPAIR MANUFACTURER.

- RESTORATION MORTAR**
- CONTRACTOR IS RESPONSIBLE FOR CONDUCTING PETROGRAPHIC TESTING ON ORIGINAL MORTAR.
  - PROVIDE MOCKUP OF MORTAR THAT CLOSELY MATCHES CONSISTENCY, COLOR, STRENGTH AND PROFILE OF ORIGINAL MORTAR.
  - ASSUME 100% REPOINTING OF EXTERIOR MASONRY JOINTS.

- MASONRY RESTORATION**
- REMOVE LOOSE AND DELAMINATED MATERIAL FROM STONE SURFACES.
  - REMOVE EXISTING LIMESTONE FOR TESTING OF COMPRESSIVE STRENGTH, ABSORPTION, AND INITIAL RATE OF ABSORPTION.
  - REUSE ORIGINAL LIMESTONE WHERE POSSIBLE. WHERE SALVAGED LIMESTONE IS OF INSUFFICIENT QUANTITY, PROVIDE NEW LIMESTONE FROM ORIGINAL QUARRY TO MATCH ORIGINAL. TEST QUARRY STONE TO DETERMINE IF IT IS A SUITABLE MATCH TO EXISTING LIMESTONE PRIOR TO INSTALLATION.
  - DAMAGED AND / OR MISSING LIMESTONE IS TO BE PATCHED, TOOLED, AND / OR REPLACED WITH MATERIAL THAT CLOSELY MATCHES ORIGINAL PROFILE, COLOR, AND COMPOSITION.

- DOORS AND WINDOWS**
- REFERENCE DOOR & WINDOW SCHEDULES FOR SCOPE OF WORK ASSOCIATED WITH EXTERIOR FACING DOORS AND WINDOWS.

MASONRY RESTORATION LEGEND

**NEW / REPLACEMENT LIMESTONE**

**NEW / REPLACEMENT CAST STONE**

**PATCH REPAIR:**

REMOVE DETERIORATED STONE UNTIL SOUND MATERIAL IS REACHED AND TOOL SURFACES TO FORM MECHANICAL BOND WITH CEMENTITIOUS PATCHING MATERIAL. PATCHING MATERIAL SHALL BE CUSTOM COLOR - MATCH ADJACENT STONE.

- INDICATES AREAS WHERE ANCHORS WERE LOCATED
- INDICATES LESS THAN 15% DETERIORATION
- INDICATES 15% TO 50% DETERIORATION

**STONE REPLACEMENT:**

REPLACE DAMAGED OR MISSING LIMESTONE WITH LIMESTONE MATERIAL THAT MATCHES ADJACENT STONE SURFACES.

**CRACK REPAIR:**


INDICATES EXIST'G CRACK TO RECEIVE EPOXY

**TOOL REPAIR:**

TOOL EXISTING LIMESTONE SURFACES TO CREATE SURFACE FINISH THAT CLOSELY RESEMBLES EXISTING ADJACENT STONE SURFACES

**DUTCHMAN REPAIR:**

- RESURFACE DETERIORATED STONE WITH NEW STONE TO MATCH ORIGINAL.
- REMOVE DETERIORATED STONE TO POINT AT WHICH SOUND STONE IS REACHED. REMOVAL TO INCLUDE FULL OUTER SURFACE EXTENDING FROM MORTAR JOINT TO MORTAR JOINT. DEPTH VARIES, VERIFY CONDITIONS IN THE FIELD. ASSUME 3 INCH MINIMUM DEPTH AT SMOOTH SURFACES AND UP TO 12 INCHES +/- AT SPLIT-FACED SURFACES.
- DRILL HOLES FOR DOWELS AT INTERFACE OF NEW AND EXISTING STONE.
- ANCHOR NEW STONE TO EXISTING WITH ANCHORS SET IN EPOXY.
- FINISH NEW STONE FLUSH WITH ADJACENT STONE. MAINTAIN ORIGINAL MORTAR JOINT LOCATIONS. PARTIAL VENEERS WILL ONLY BE CONSIDERED AT CONCEALED LOCATIONS.

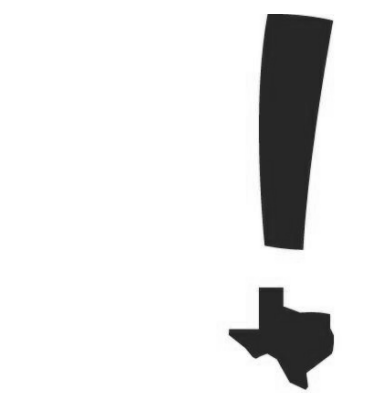

TEXAS HISTORICAL COMMISSION  
real places telling real stories



FANNIN COUNTY  
COURTHOUSE  
INTERIOR & EXTERIOR RESTORATION

101 E. Sam Rayburn Drive  
Bonham, Texas 75418

**COPYRIGHT**  
The Contractor shall verify and be responsible for all dimensions. DO NOT scale the drawing. Any errors or omissions shall be reported to Architexas without delay. The Copyrights to all designs and drawings are the property of Architexas. Reproduction or use for any purpose other than that authorized by Architexas is forbidden.

**REVISION HISTORY**  
1 Oct. 16, 2018 Addendum #1

ISSUED FOR CONSTRUCTION




#18326 9/21/2018

Architexas No. 1737 Date SEPT. 21, 2018

Sheet Name NORTH ELEVATION

Sheet Number

A2.01

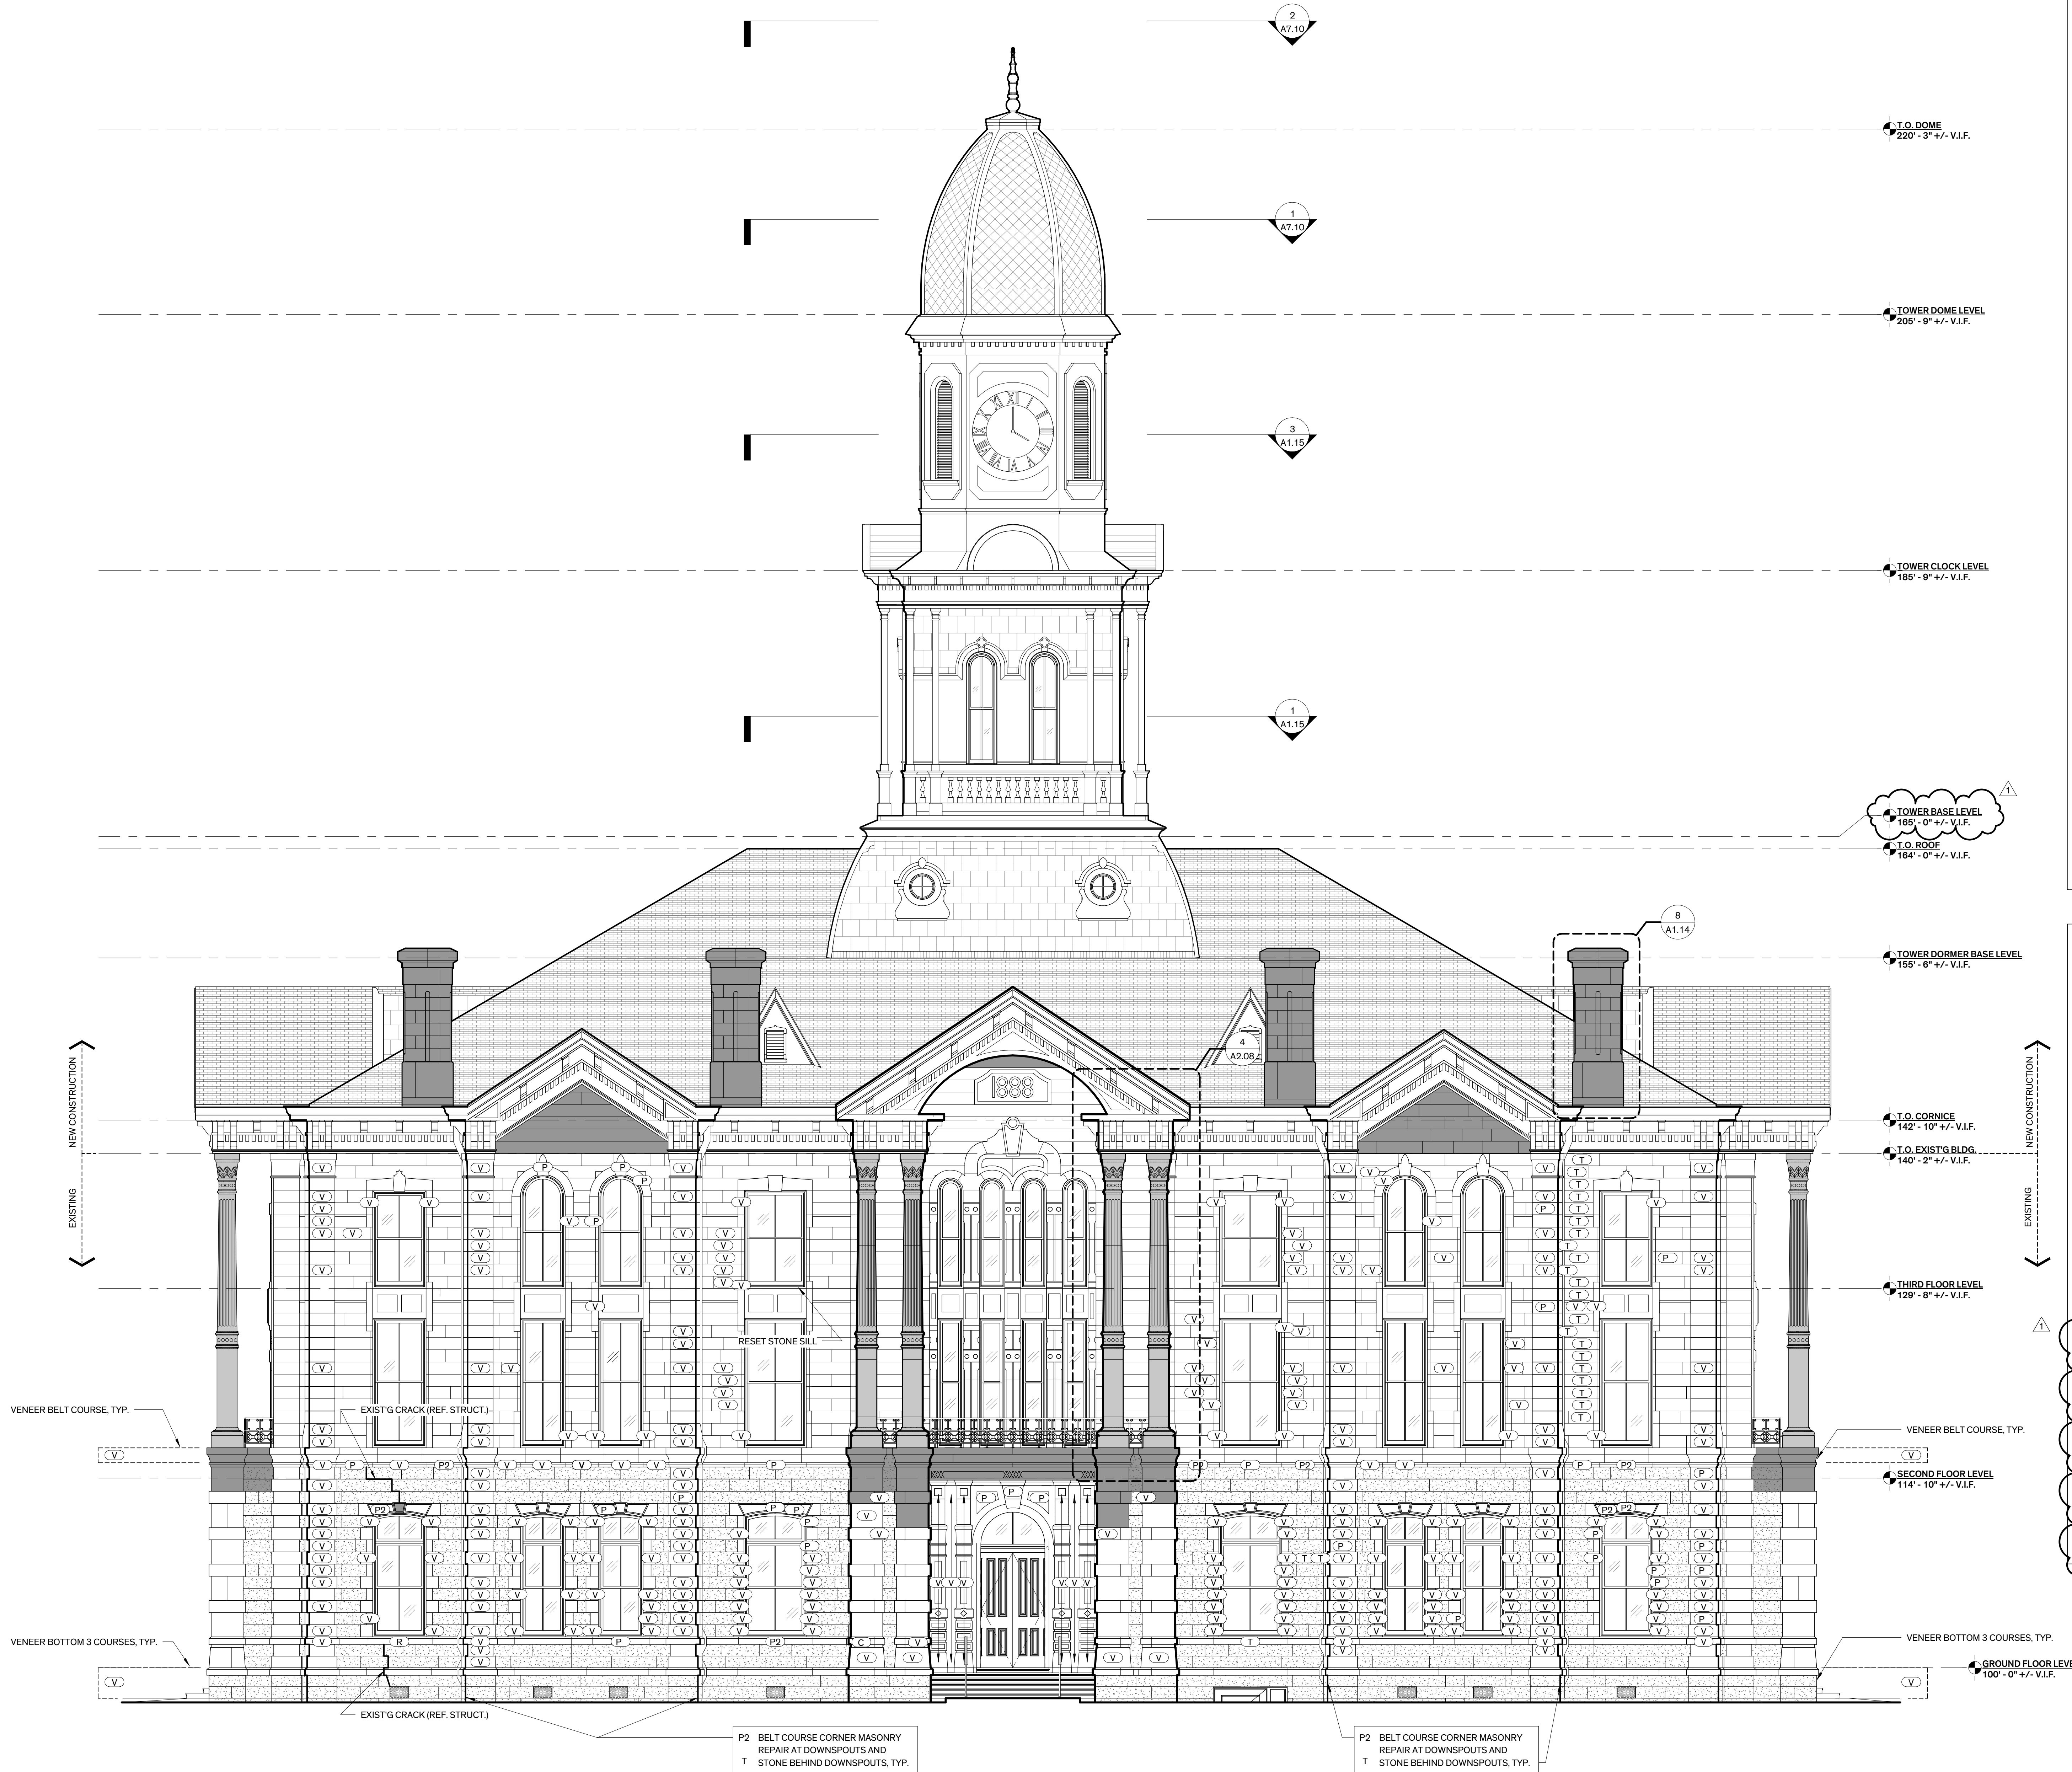

1 North Elevation  
3/16" = 1'-0"

LEGEND

- HONED, SMOOTH LIMESTONE
- ROCK FACE LIMESTONE

## GENERAL NOTES

- GENERAL:**
- PROTECT EXISTING MATERIALS DURING CONSTRUCTION THAT ARE SCHEDULED TO REMAIN. DAMAGE TO EXISTING FINISH SURFACES BY THE CONTRACTOR SHALL BE CORRECTED IN KIND AT NO ADDITIONAL COST TO THE OWNER.
  - PROVIDE TEMPORARY WEATHERTIGHT CLOSURES FOR EXTERIOR OPENINGS TO PROVIDE ACCEPTABLE INTERIOR WORKING CONDITIONS AND PREVENT ENTRY OF UNAUTHORIZED PERSONS.
  - REMOVE NON-ORIGINAL MASONRY AT ORIGINAL WINDOW OPENINGS.
  - FINISH FLOOR ELEVATIONS:
    - EXIST'G ELEVATIONS & CEILING HEIGHTS ARE APPROXIMATE & ARE TO BE VERIFIED IN THE FIELD BY CONTRACTOR.
    - FINAL ELEVATIONS & CEILING HEIGHTS WILL BE DETERMINED ONCE NEW FINISH FLOOR LEVELS ARE ESTABLISHED IN CORRIDORS.

- MASONRY CLEANING**
- CLEAN EXISTING LIMESTONE SURFACES WITH APPROVED PROCEDURES NOTED IN PROJECT MANUAL AND REPORT FROM WJE.
  - PROVIDE MOCKUP TO DETERMINE APPROPRIATE METHOD WITH GENTLEST MEANS POSSIBLE.
  - SANDBLASTING AND THE USE OF NON-PROPRIETARY ACIDS IS PROHIBITED.
  - FOLLOW MANUFACTURER'S INSTRUCTIONS AND PROCEDURES ESTABLISHED DURING PREPARATION OF MOCKUP.
  - DO NOT DAMAGE EXISTING SURFACES. LEAVE SURFACES UNIFORM IN APPEARANCE PRIOR TO PATCH APPLICATION.
  - THE EXISTING PAINT LAYERS UNDERNEATH THE MASTIC ON THE EXTERIOR MASONRY IS KNOWN TO CONTAIN LEAD. WASTE GENERATED BY COATING REMOVAL PROCESS SHALL BE CLASSIFIED AS HAZARDOUS MATERIAL AND SHALL BE REMOVED IN ACCORDANCE WITH EPA & OSHA GUIDELINES.

- REMOVAL OF FASTENERS**
- REMOVE EXISTING FASTENERS, BOLTS, CLAMPS, STRAPS, ETC. ON THE EXTERIOR OF THE BUILDING THAT ARE ATTACHED OR EMBEDDED IN EXISTING MATERIALS AND ARE NOT BEING USED TO FASTEN ELEMENTS TO REMAIN.
  - REMOVE EXISTING ANCHORS, FASTENERS AND THE WIRE USING CORE DRILL.
  - WIDTH AND DEPTH OF CORE DRILLED HOLES TO BE DETERMINED BY MASONRY REPAIR MANUFACTURER.
  - PROVIDE MOCKUP OF EACH TYPE OF ANCHOR REMOVAL TO DETERMINE APPROPRIATE METHOD.
  - TREAT EXPOSED FERROUS METAL WITHIN REPAIR AREA WITH COATING BY MASONRY REPAIR MANUFACTURER.

- RESTORATION MORTAR**
- CONTRACTOR IS RESPONSIBLE FOR CONDUCTING PETROGRAPHIC TESTING ON ORIGINAL MORTAR.
  - PROVIDE MOCKUP OF MORTAR THAT CLOSELY MATCHES CONSISTENCY, COLOR, STRENGTH AND PROFILE OF ORIGINAL MORTAR.
  - ASSUME 100% REPOINTING OF EXTERIOR MASONRY JOINTS.

- MASONRY RESTORATION**
- REMOVE LOOSE AND DELAMINATED MATERIAL FROM STONE SURFACES.
  - REMOVE EXISTING LIMESTONE FOR TESTING OF COMPRESSIVE STRENGTH, ABSORPTION AND INITIAL RATE OF ABSORPTION.
  - REUSE ORIGINAL LIMESTONE WHERE POSSIBLE. WHERE SALVAGED LIMESTONE IS OF INSUFFICIENT QUANTITY, PROVIDE NEW LIMESTONE FROM ORIGINAL QUARRY TO MATCH ORIGINAL. TEST QUARRY STONE TO DETERMINE IF IT IS A SUITABLE MATCH TO EXISTING LIMESTONE PRIOR TO INSTALLATION.
  - DAMAGED AND / OR MISSING LIMESTONE IS TO BE PATCHED, TOOLED, AND / OR REPLACED WITH MATERIAL THAT CLOSELY MATCHES ORIGINAL PROFILE, COLOR, AND COMPOSITION.

- DOORS AND WINDOWS**
- REFERENCE DOOR & WINDOW SCHEDULES FOR SCOPE OF WORK ASSOCIATED WITH EXTERIOR FACING DOORS AND WINDOWS.

## MASONRY RESTORATION LEGEND

**NEW / REPLACEMENT LIMESTONE**

**NEW / REPLACEMENT CAST STONE**

**PATCH REPAIR:**

REMOVE DETERIORATED STONE UNTIL SOUND MATERIAL IS REACHED AND TOOL SURFACES TO FORM MECHANICAL BOND WITH CEMENTITIOUS PATCHING MATERIAL. PATCHING MATERIAL SHALL BE CUSTOM COLOR - MATCH ADJACENT STONE.

- 1 - INDICATES AREAS WHERE ANCHORS WERE LOCATED
- 2 - INDICATES LESS THAN 15% DETERIORATION
- 3 - INDICATES 15% TO 50% DETERIORATION

**STONE REPLACEMENT:**

REPLACE DAMAGED OR MISSING LIMESTONE WITH LIMESTONE MATERIAL THAT MATCHES ADJACENT STONE SURFACES.

**CRACK REPAIR:**



INDICATES EXIST'G CRACK TO RECEIVE EPOXY

**TOOL REPAIR:**

TOOL EXISTING LIMESTONE SURFACES TO CREATE SURFACE FINISH THAT CLOSELY RESEMBLES EXISTING ADJACENT STONE SURFACES

**DUTCHMAN REPAIR:**

REF. SHEET A2.01

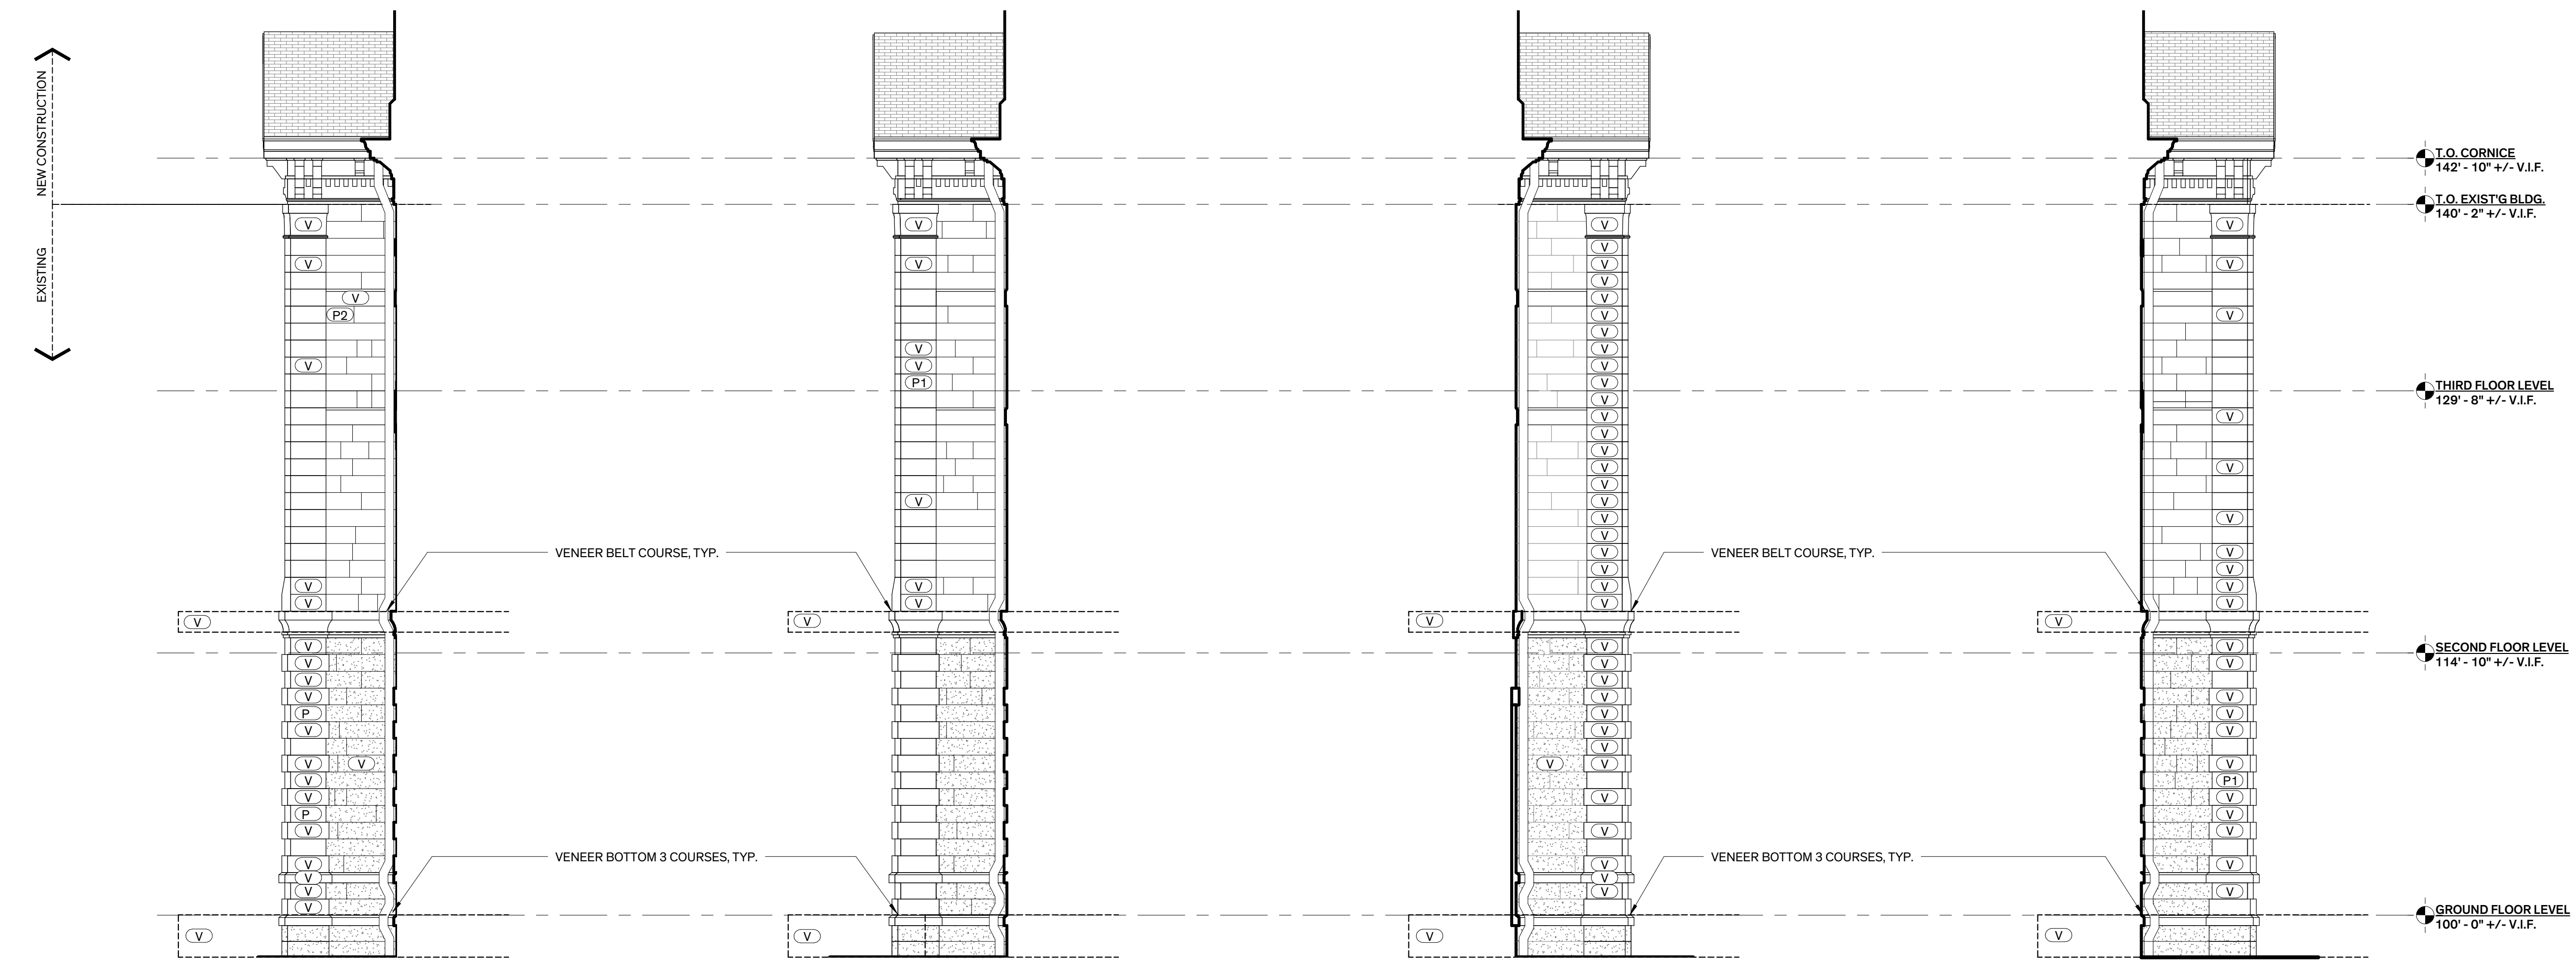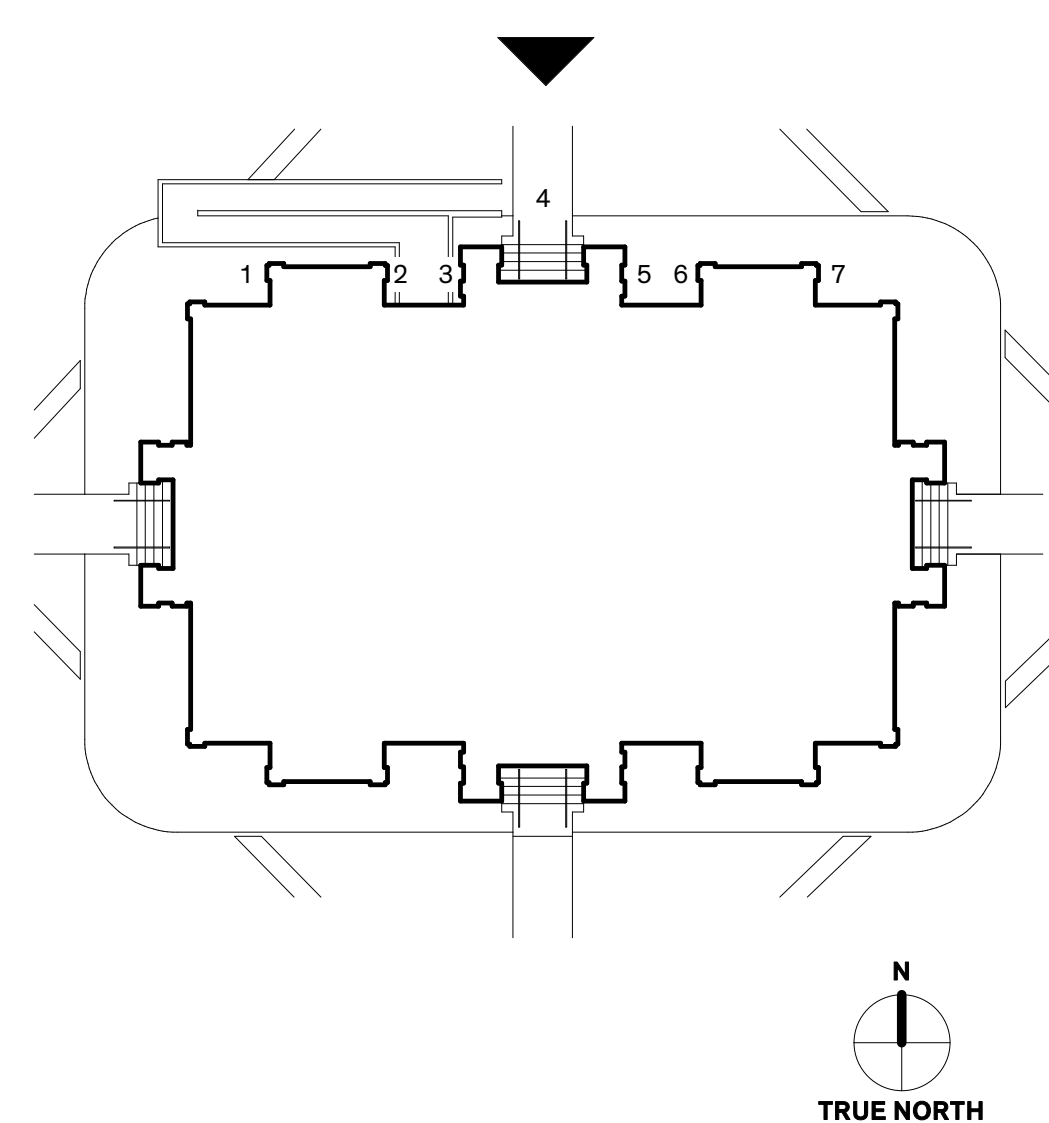


**View # 1**  
**7 @ North Elevation**  
 3/16" = 1'-0"

**View #2**  
**6 @ North Elevation**  
 3/16" = 1'-0"

**View #6**  
**5 @ North Elevation**  
 3/16" = 1'-0"

**View #7**  
**4 @ North Elevation**  
 3/16" = 1'-0"

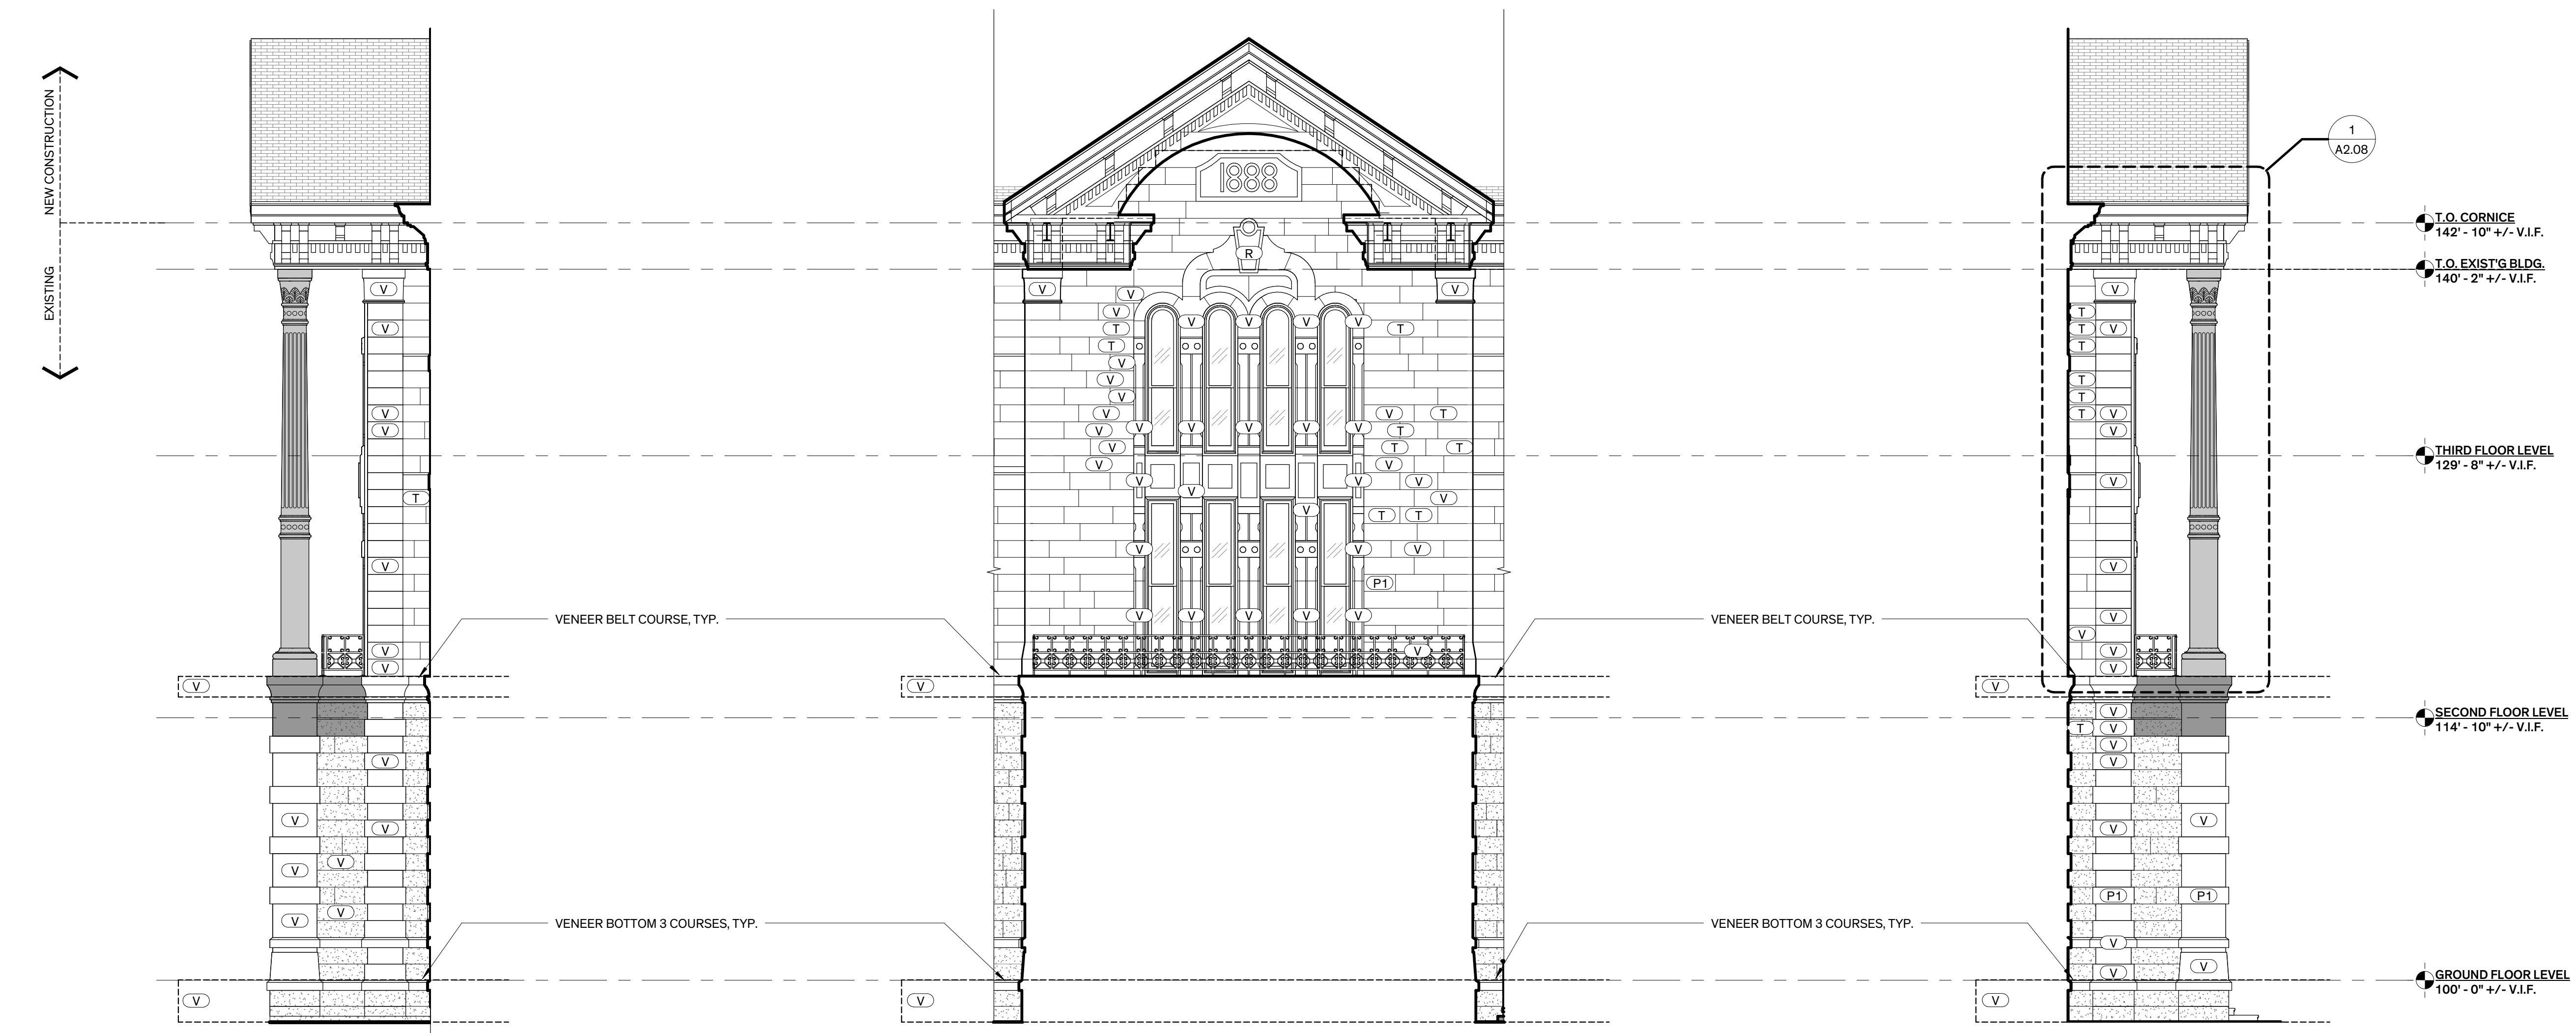

**View #3**  
**3 @ North Elevation**  
 3/16" = 1'-0"

**View #4**  
**2 @ North Elevation**  
 3/16" = 1'-0"

**View #5**  
**1 @ North Elevation**  
 3/16" = 1'-0"

**LEGEND**

HONED, SMOOTH LIMESTONE

ROCK FACE LIMESTONE



## FANNIN COUNTY COURTHOUSE INTERIOR & EXTERIOR RESTORATION

101 E. Sam Rayburn Drive  
 Bonham, Texas 75418

**COPYRIGHT**  
 The Contractor shall verify and be responsible for all dimensions. DO NOT scale the drawing. Any errors or omissions shall be reported to Architexas without delay. The Copyrights to all designs and drawings are the property of Architexas. Reproduction or use for any purpose other than that authorized by Architexas is forbidden.

**REVISION HISTORY**

1	Oct. 16, 2018	Addendum #1
---	---------------	-------------

ISSUED FOR CONSTRUCTION




Architexas No. 1737 Date SEPT. 21, 2018

Sheet Name PARTIAL NORTH ELEVATIONS

Sheet Number



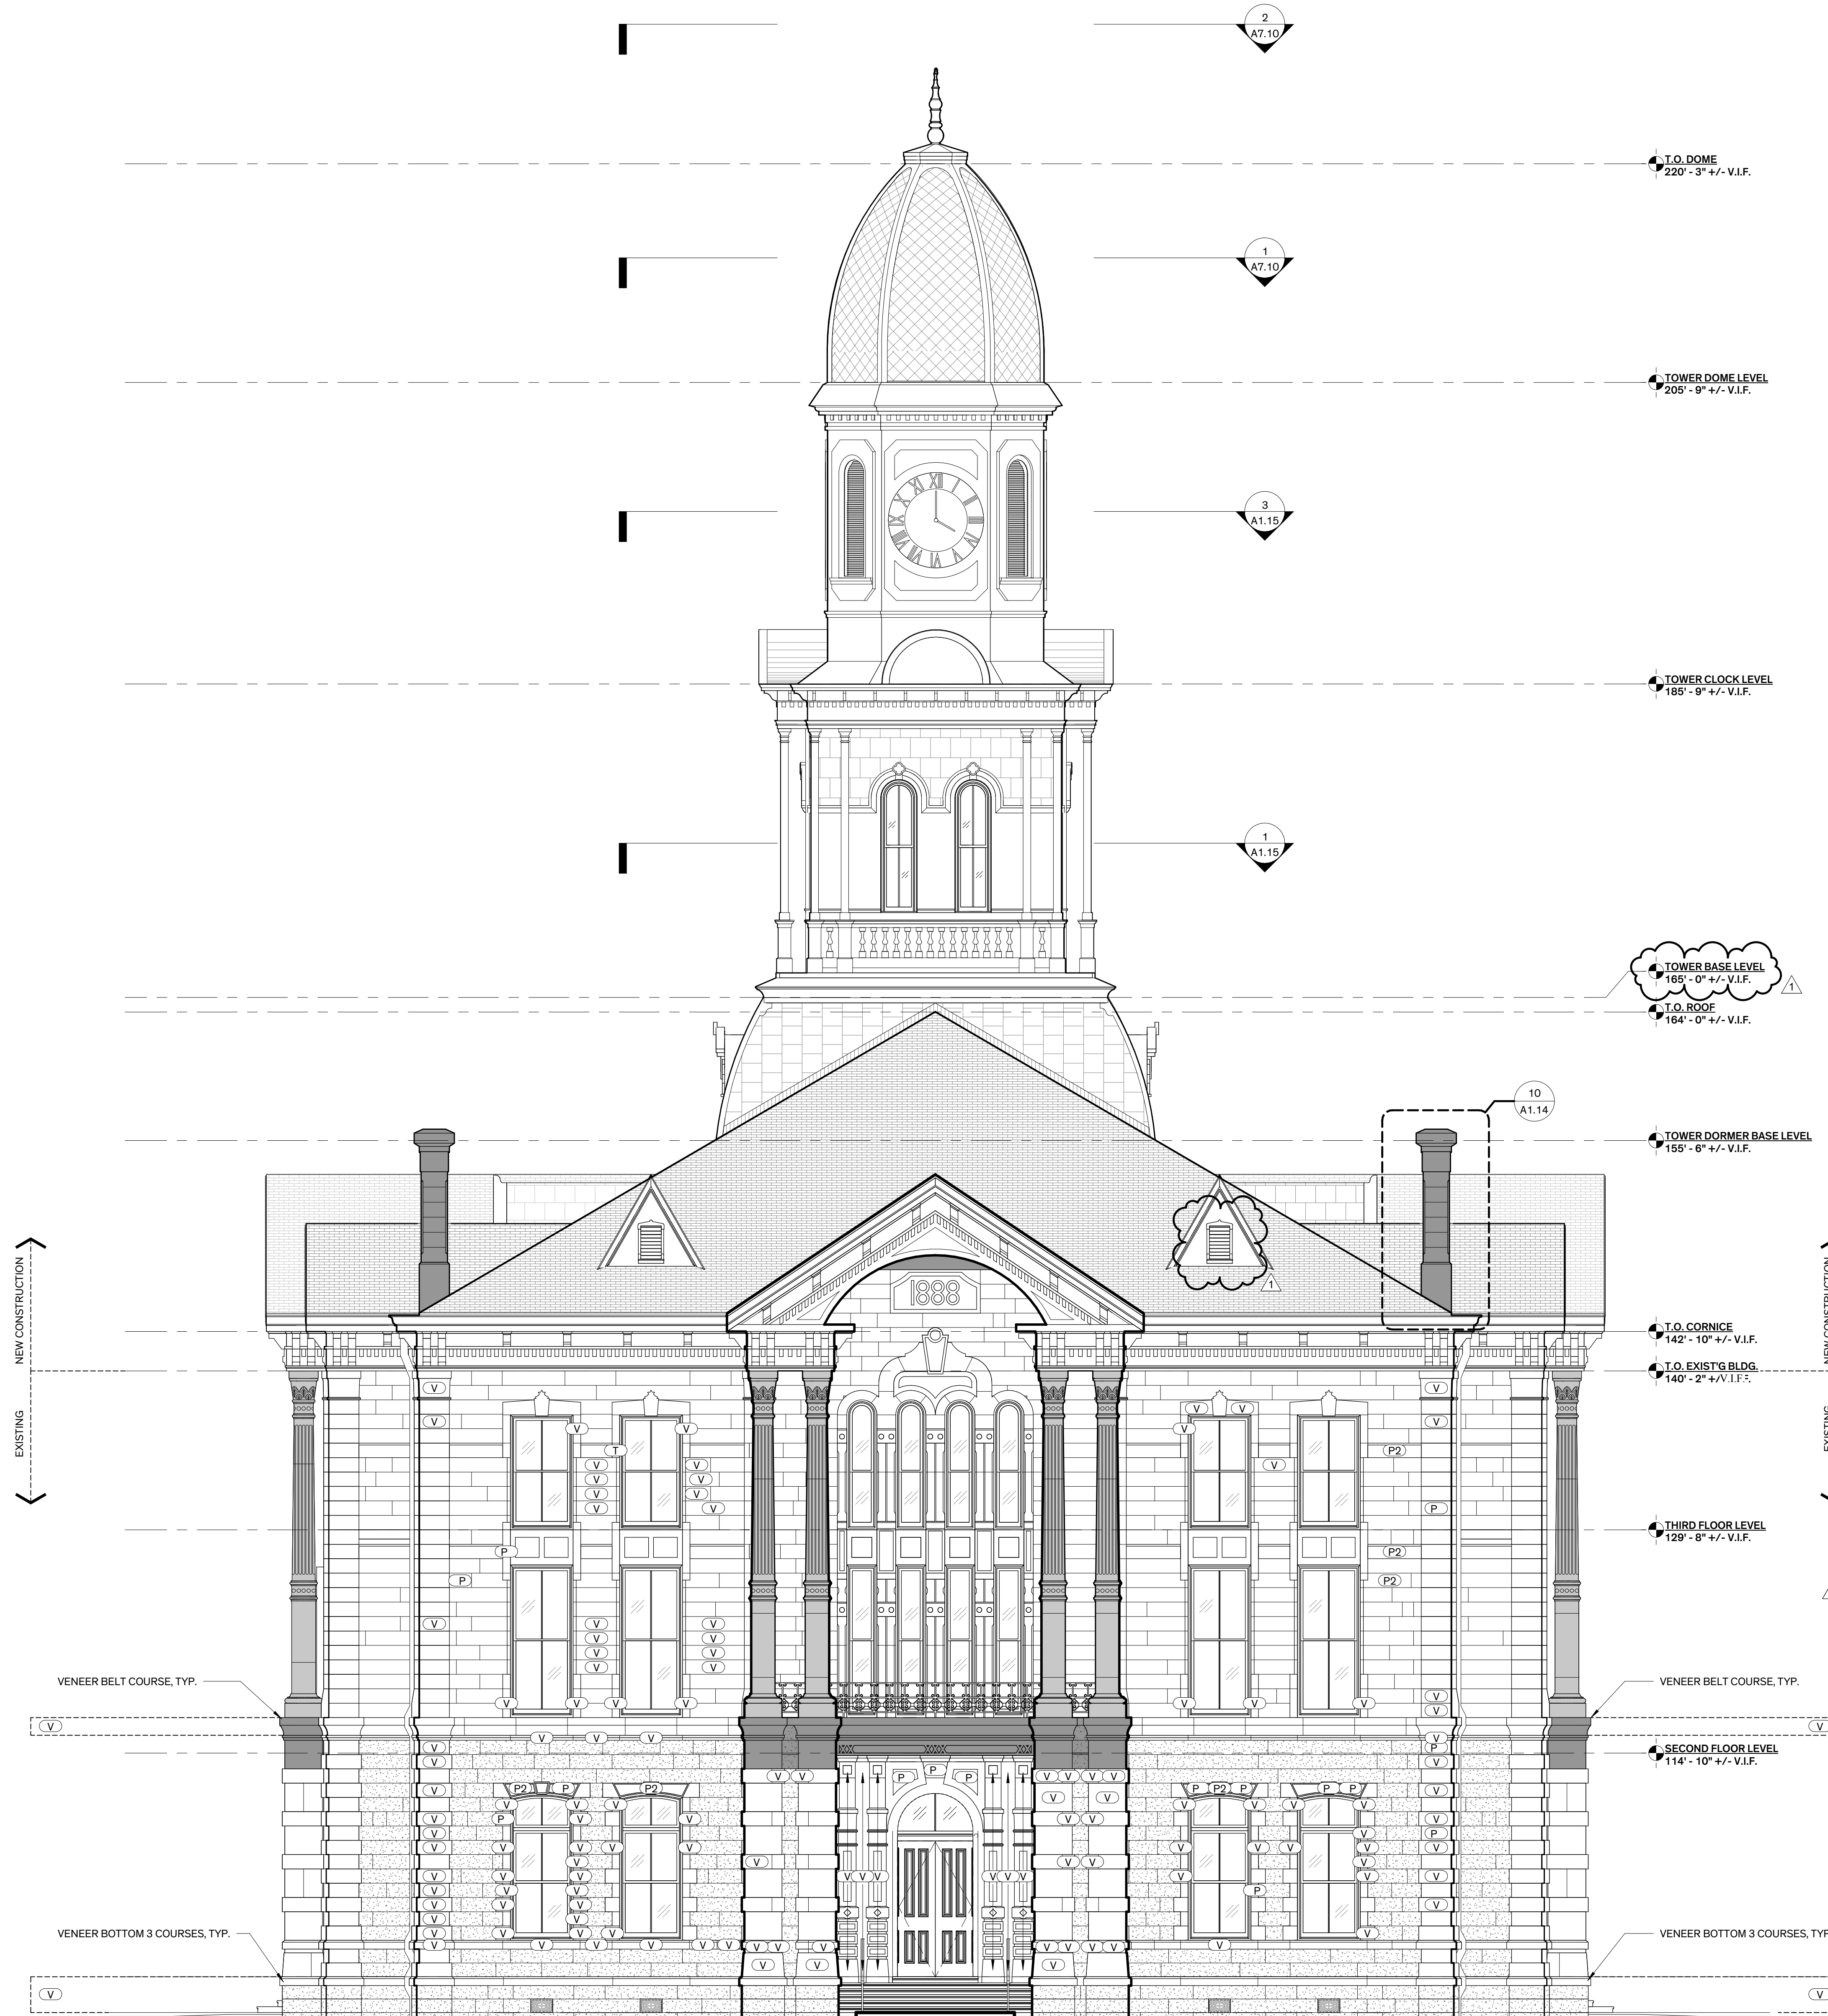

1 East Elevation  
3/16" = 1'-0"

GENERAL NOTES

- GENERAL:**
- PROTECT EXISTING MATERIALS DURING CONSTRUCTION THAT ARE SCHEDULED TO REMAIN. DAMAGE TO EXISTING FINISH SURFACES BY THE CONTRACTOR SHALL BE CORRECTED IN KIND AT NO ADDITIONAL COST TO THE OWNER.
  - PROVIDE TEMPORARY WEATHERTIGHT CLOSURES FOR EXTERIOR OPENINGS TO PROVIDE ACCEPTABLE INTERIOR WORKING CONDITIONS AND PREVENT ENTRY OF UNAUTHORIZED PERSONS.
  - REMOVE NON-ORIGINAL MASONRY AT ORIGINAL WINDOW OPENINGS.
  - FINISH FLOOR ELEVATIONS:
    - EXIST'G ELEVATIONS & CEILING HEIGHTS ARE APPROXIMATE & ARE TO BE VERIFIED IN THE FIELD BY CONTRACTOR.
    - FINAL ELEVATIONS & CEILING HEIGHTS WILL BE DETERMINED ONCE NEW FINISH FLOOR LEVELS ARE ESTABLISHED IN CORRIDORS.

- MASONRY CLEANING**
- CLEAN EXISTING LIMESTONE SURFACES WITH APPROVED PROCEDURES NOTED IN PROJECT MANUAL AND REPORT FROM WJE.
  - PROVIDE MOCKUP TO DETERMINE APPROPRIATE METHOD WITH GENTLEST MEANS POSSIBLE.
  - SANDBLASTING AND THE USE OF NON-PROPRIETARY ACIDS IS PROHIBITED.
  - FOLLOW MANUFACTURER'S INSTRUCTIONS AND PROCEDURES ESTABLISHED DURING PREPARATION OF MOCKUP.
  - DO NOT DAMAGE EXISTING SURFACES. LEAVE SURFACES UNIFORM IN APPEARANCE PRIOR TO PATCH APPLICATION.
  - THE EXISTING PAINT LAYERS UNDERNEATH THE MASTIC ON THE EXTERIOR MASONRY IS KNOWN TO CONTAIN LEAD. WASTE GENERATED BY COATING REMOVAL PROCESS SHALL BE CLASSIFIED AS HAZARDOUS MATERIAL AND SHALL BE REMOVED IN ACCORDANCE WITH EPA & OSHA GUIDELINES.

- REMOVAL OF FASTENERS**
- REMOVE EXISTING FASTENERS, BOLTS, CLAMPS, STRAPS, ETC. ON THE EXTERIOR OF THE BUILDING THAT ARE ATTACHED OR EMBEDDED IN EXISTING MATERIALS AND ARE NOT BEING USED TO FASTEN ELEMENTS TO REMAIN.
  - REMOVE EXISTING ANCHORS, FASTENERS AND THE WIRE USING CORE DRILL.
  - WIDTH AND DEPTH OF CORE DRILLED HOLES TO BE DETERMINED BY MASONRY REPAIR MANUFACTURER.
  - PROVIDE MOCKUP OF EACH TYPE OF ANCHOR REMOVAL TO DETERMINE APPROPRIATE METHOD.
  - TREAT EXPOSED FERROUS METAL WITHIN REPAIR AREA WITH COATING BY MASONRY REPAIR MANUFACTURER.

- RESTORATION MORTAR**
- CONTRACTOR IS RESPONSIBLE FOR CONDUCTING PETROGRAPHIC TESTING ON ORIGINAL MORTAR.
  - PROVIDE MOCKUP OF MORTAR THAT CLOSELY MATCHES CONSISTENCY, COLOR, STRENGTH AND PROFILE OF ORIGINAL MORTAR.
  - ASSUME 100% REPOINTING OF EXTERIOR MASONRY JOINTS.

- MASONRY RESTORATION**
- REMOVE LOOSE AND DELAMINATED MATERIAL FROM STONE SURFACES.
  - REMOVE EXISTING LIMESTONE FOR TESTING OF COMPRESSIVE STRENGTH, ABSORPTION, AND INITIAL RATE OF ABSORPTION.
  - REUSE ORIGINAL LIMESTONE WHERE POSSIBLE. WHERE SALVAGED LIMESTONE IS OF INSUFFICIENT QUANTITY, PROVIDE NEW LIMESTONE FROM ORIGINAL QUARRY TO MATCH ORIGINAL. TEST QUARRY STONE TO DETERMINE IF IT IS A SUITABLE MATCH TO EXISTING LIMESTONE PRIOR TO INSTALLATION.
  - DAMAGED AND / OR MISSING LIMESTONE IS TO BE PATCHED, TOOLED, AND / OR REPLACED WITH MATERIAL THAT CLOSELY MATCHES ORIGINAL PROFILE, COLOR, AND COMPOSITION.

- DOORS AND WINDOWS**
- REFERENCE DOOR & WINDOW SCHEDULES FOR SCOPE OF WORK ASSOCIATED WITH EXTERIOR FACING DOORS AND WINDOWS.

MASONRY RESTORATION LEGEND

**NEW / REPLACEMENT LIMESTONE**

**NEW / REPLACEMENT CAST STONE**

**PATCH REPAIR:**

REMOVE DETERIORATED STONE UNTIL SOUND MATERIAL IS REACHED AND TOOL SURFACES TO FORM MECHANICAL BOND WITH CEMENTITIOUS PATCHING MATERIAL. PATCHING MATERIAL SHALL BE CUSTOM COLOR - MATCH ADJACENT STONE.

- INDICATES AREAS WHERE ANCHORS WERE LOCATED
- INDICATES LESS THAN 15% DETERIORATION
- INDICATES 15% TO 50% DETERIORATION

**STONE REPLACEMENT:**

REPLACE DAMAGED OR MISSING LIMESTONE WITH LIMESTONE MATERIAL THAT MATCHES ADJACENT STONE SURFACES.

**CRACK REPAIR:**

INDICATES EXIST'G CRACK TO RECEIVE EPOXY

**TOOL REPAIR:**

TOOL EXISTING LIMESTONE SURFACES TO CREATE SURFACE FINISH THAT CLOSELY RESEMBLES EXISTING ADJACENT STONE SURFACES

**DITCHMAN REPAIR:**

- RESURFACE DETERIORATED STONE WITH NEW STONE TO MATCH ORIGINAL.
- REMOVE DETERIORATED STONE TO POINT AT WHICH SOUND STONE IS REACHED. REMOVAL TO INCLUDE FULL OUTER SURFACE EXTENDING FROM MORTAR JOINT TO MORTAR JOINT. DEPTH VARIES, VERIFY CONDITIONS IN THE FIELD. ASSUME 3 INCH MINIMUM DEPTH AT SMOOTH SURFACES AND UP TO 12 INCHES +/- AT SPLIT-FACED SURFACES.
- DRILL HOLES FOR DOWELS AT INTERFACE OF NEW AND EXISTING STONE.
- ANCHOR NEW STONE TO EXISTING WITH ANCHORS SET IN EPOXY.
- FINISH NEW STONE FLUSH WITH ADJACENT STONE.
- MAINTAIN ORIGINAL MORTAR JOINT LOCATIONS. PARTIAL VENEERS WILL ONLY BE CONSIDERED AT CONCEALED LOCATIONS.

LEGEND

HONED, SMOOTH LIMESTONE

ROCK FACE LIMESTONE



FANNIN COUNTY  
COURTHOUSE  
INTERIOR & EXTERIOR RESTORATION

101 E. Sam Rayburn Drive  
Bonham, Texas 75418

**COPYRIGHT**  
The Contractor shall verify and be responsible for all dimensions. DO NOT scale the drawing. Any errors or omissions shall be reported to Architexas without delay. The Copyrights to all designs and drawings are the property of Architexas. Reproduction or use for any purpose other than that authorized by Architexas is forbidden.

**REVISION HISTORY**  
1 Oct. 16, 2018 Addendum #1

ISSUED FOR CONSTRUCTION



#18326 9/21/2018

Architexas No. 1737 Date SEPT. 21, 2018

Sheet Name EAST ELEVATION

Sheet Number A2.03

## GENERAL NOTES

- GENERAL**
- PROTECT EXISTING MATERIALS DURING CONSTRUCTION THAT ARE SCHEDULED TO REMAIN. DAMAGE TO EXISTING FINISH SURFACES BY THE CONTRACTOR SHALL BE CORRECTED IN KIND AT NO ADDITIONAL COST TO THE OWNER.
  - PROVIDE TEMPORARY WEATHERTIGHT CLOSURES FOR EXTERIOR OPENINGS TO PROVIDE ACCEPTABLE INTERIOR WORKING CONDITIONS AND PREVENT ENTRY OF UNAUTHORIZED PERSONS.
  - REMOVE NON-ORIGINAL MASONRY AT ORIGINAL WINDOW OPENINGS.
  - FINISH FLOOR ELEVATIONS:
    - EXIST'G ELEVATIONS & CEILING HEIGHTS ARE APPROXIMATE & ARE TO BE VERIFIED IN THE FIELD BY CONTRACTOR.
    - FINAL ELEVATIONS & CEILING HEIGHTS WILL BE DETERMINED ONCE NEW FINISH FLOOR LEVELS ARE ESTABLISHED IN CORRIDORS.

- MASONRY CLEANING**
- CLEAN EXISTING LIMESTONE SURFACES WITH APPROVED PROCEDURES NOTED IN PROJECT MANUAL AND REPORT FROM WJE.
  - PROVIDE MOCKUP TO DETERMINE APPROPRIATE METHOD WITH GENTLEST MEANS POSSIBLE.
  - SANDBLASTING AND THE USE OF NON-PROPRIETARY ACIDS IS PROHIBITED.
  - FOLLOW MANUFACTURER'S INSTRUCTIONS AND PROCEDURES ESTABLISHED DURING PREPARATION OF MOCKUP.
  - DO NOT DAMAGE EXISTING SURFACES. LEAVE SURFACES UNIFORM IN APPEARANCE PRIOR TO PATCH APPLICATION.
  - THE EXISTING PAINT LAYERS UNDERNEATH THE MASTIC ON THE EXTERIOR MASONRY IS KNOWN TO CONTAIN LEAD. WASTE GENERATED BY COATING REMOVAL PROCESS SHALL BE CLASSIFIED AS HAZARDOUS MATERIAL AND SHALL BE REMOVED IN ACCORDANCE WITH EPA & OSHA GUIDELINES.

- REMOVAL OF FASTENERS**
- REMOVE EXISTING FASTENERS, BOLTS, CLAMPS, STRAPS, ETC. ON THE EXTERIOR OF THE BUILDING THAT ARE ATTACHED OR EMBEDDED IN EXISTING MATERIALS AND ARE NOT BEING USED TO FASTEN ELEMENTS TO REMAIN.
  - REMOVE EXISTING ANCHORS, FASTENERS AND TIE WIRE USING CORE DRILL.
  - WIDTH AND DEPTH OF CORE DRILLED HOLES TO BE DETERMINED BY MASONRY REPAIR MANUFACTURER.
  - PROVIDE MOCKUP OF EACH TYPE OF ANCHOR REMOVAL TO DETERMINE APPROPRIATE METHOD.
  - TREAT EXPOSED FERROUS METAL WITHIN REPAIR AREA WITH COATING BY MASONRY REPAIR MANUFACTURER.



- RESTORATION MORTAR**
- CONTRACTOR IS RESPONSIBLE FOR CONDUCTING PETROGRAPHIC TESTING ON ORIGINAL MORTAR.
  - PROVIDE MOCKUP OF MORTAR THAT CLOSELY MATCHES CONSISTENCY, COLOR, STRENGTH AND PROFILE OF ORIGINAL MORTAR.
  - ASSUME 100% REPOINTING OF EXTERIOR MASONRY JOINTS.

- MASONRY RESTORATION**
- REMOVE LOOSE AND DELAMINATED MATERIAL FROM STONE SURFACES.
  - REMOVE EXISTING LIMESTONE FOR TESTING OF COMPRESSIVE STRENGTH, ABSORPTION, AND INITIAL RATE OF ABSORPTION.
  - REUSE ORIGINAL LIMESTONE WHERE POSSIBLE. WHERE SALVAGED LIMESTONE IS OF INSUFFICIENT QUANTITY, PROVIDE NEW LIMESTONE FROM ORIGINAL QUARRY TO MATCH ORIGINAL. TEST QUARRY STONE TO DETERMINE IF IT IS A SUITABLE MATCH TO EXISTING LIMESTONE PRIOR TO INSTALLATION.
  - DAMAGED AND / OR MISSING LIMESTONE IS TO BE PATCHED, TOOLED, AND / OR REPLACED WITH MATERIAL THAT CLOSELY MATCHES ORIGINAL PROFILE, COLOR, AND COMPOSITION.

- DOORS AND WINDOWS**
- REFERENCE DOOR & WINDOW SCHEDULES FOR SCOPE OF WORK ASSOCIATED WITH EXTERIOR FACING DOORS AND WINDOWS.

## MASONRY RESTORATION LEGEND


	NEW / REPLACEMENT LIMESTONE
	NEW / REPLACEMENT CAST STONE
	<b>PATCH REPAIR:</b>
	REMOVE DETERIORATED STONE UNTIL SOUND MATERIAL IS REACHED AND TOOL SURFACES TO FORM MECHANICAL BOND WITH CEMENTITIOUS PATCHING MATERIAL. PATCHING MATERIAL SHALL BE CUSTOM COLOR - MATCH ADJACENT STONE.
	1 - INDICATES AREAS WHERE ANCHORS WERE LOCATED
	2 - INDICATES LESS THAN 15% DETERIORATION
	3 - INDICATES 15% TO 50% DETERIORATION
	<b>STONE REPLACEMENT:</b>
	REPLACE DAMAGED OR MISSING LIMESTONE WITH LIMESTONE MATERIAL THAT MATCHES ADJACENT STONE SURFACES.
	<b>CRACK REPAIR:</b>
	INDICATES EXIST'G CRACK TO RECEIVE EPOXY
	<b>TOOL REPAIR:</b>
	TOOL EXISTING LIMESTONE SURFACES TO CREATE SURFACE FINISH THAT CLOSELY RESEMBLES EXISTING ADJACENT STONE SURFACES
	<b>DITCHMAN REPAIR:</b>
	REF. SHEET A2.01

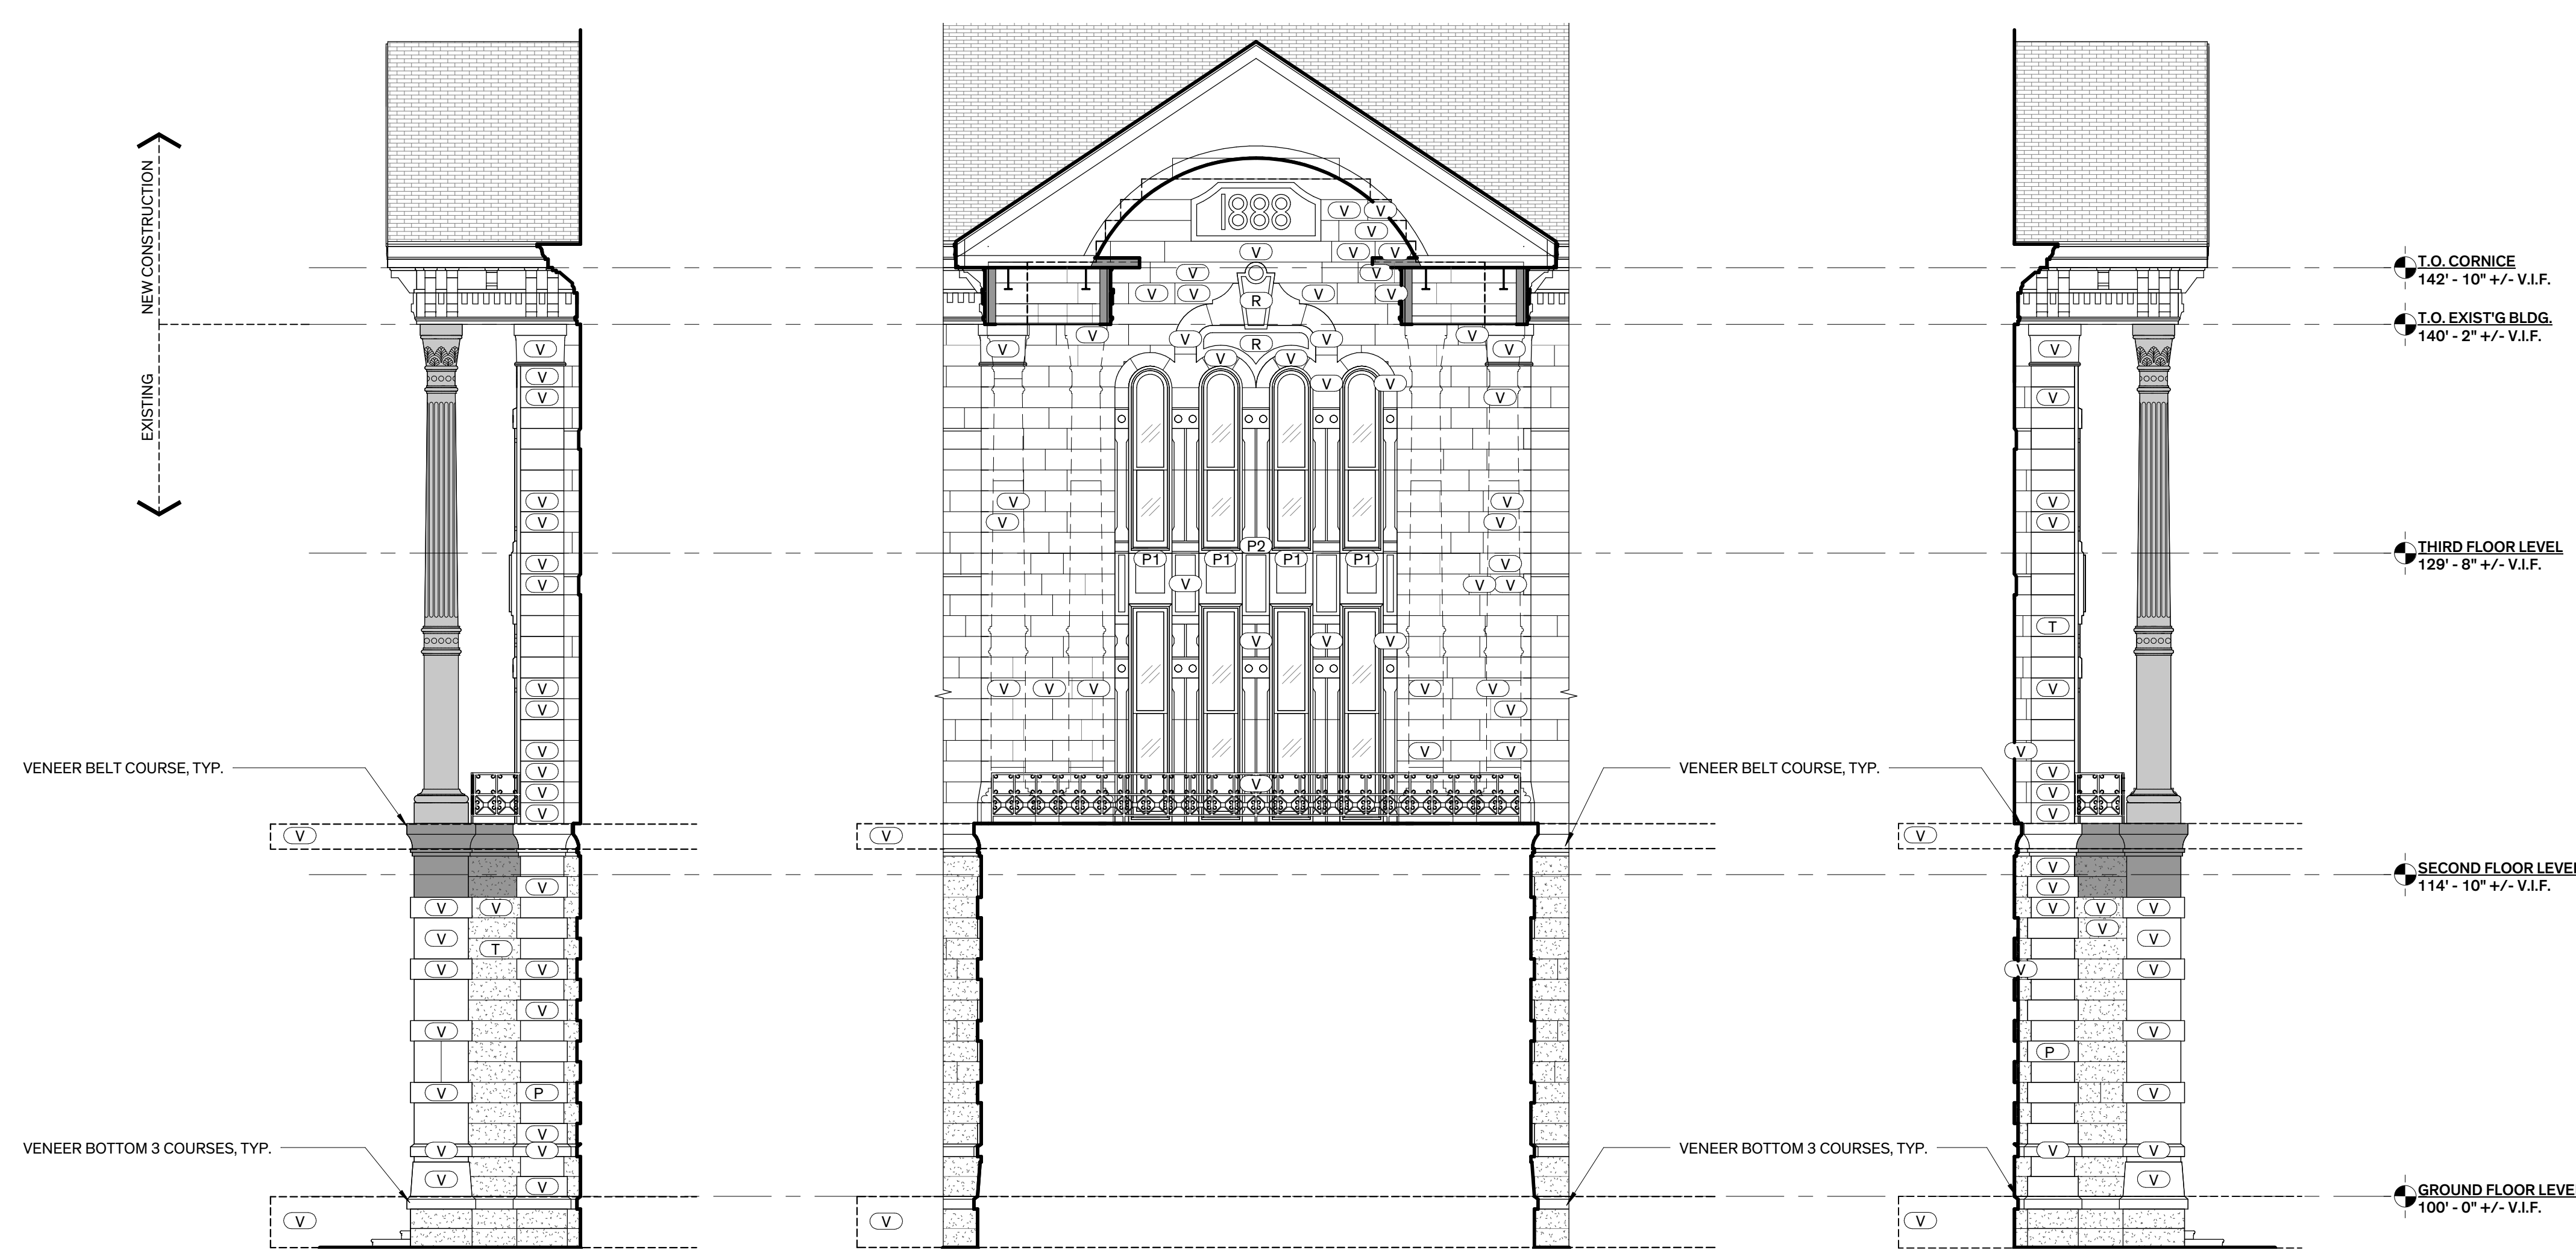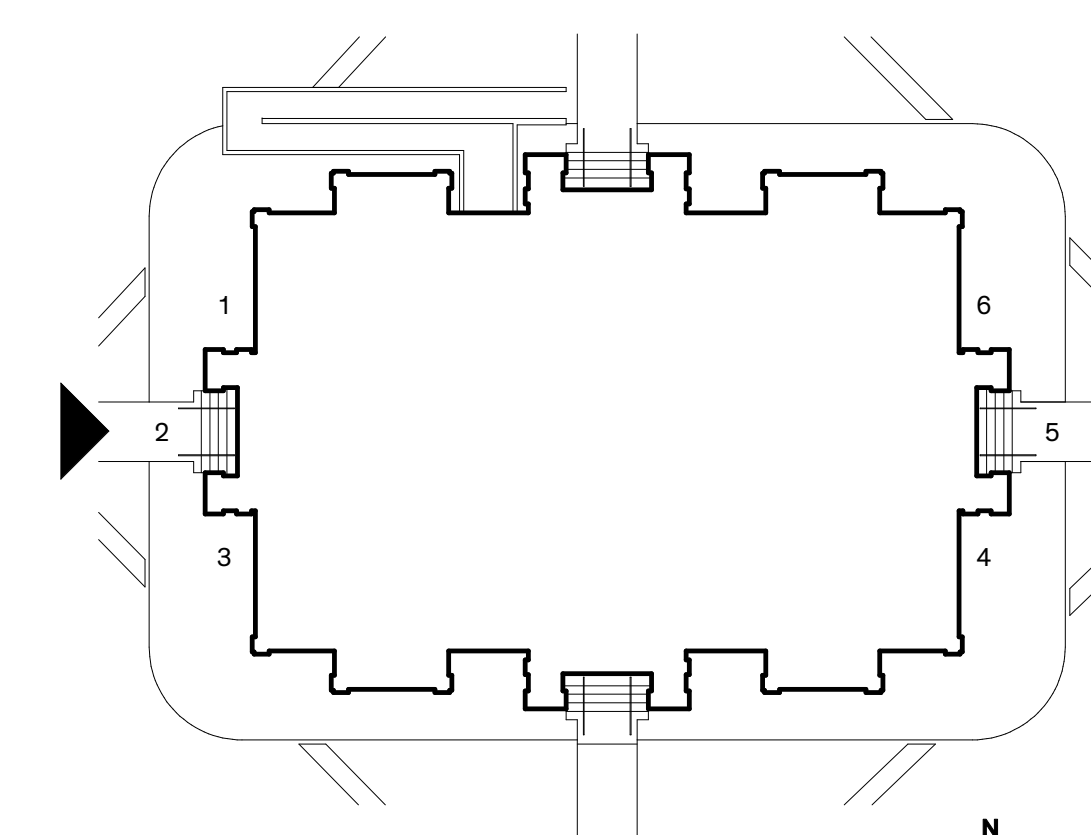

**View #3**  
**6 @ West Elevation**  
 3/16" = 1'-0"

**View #2**  
**5 @ West Elevation**  
 3/16" = 1'-0"

**View #1**  
**4 @ West Elevation**  
 3/16" = 1'-0"

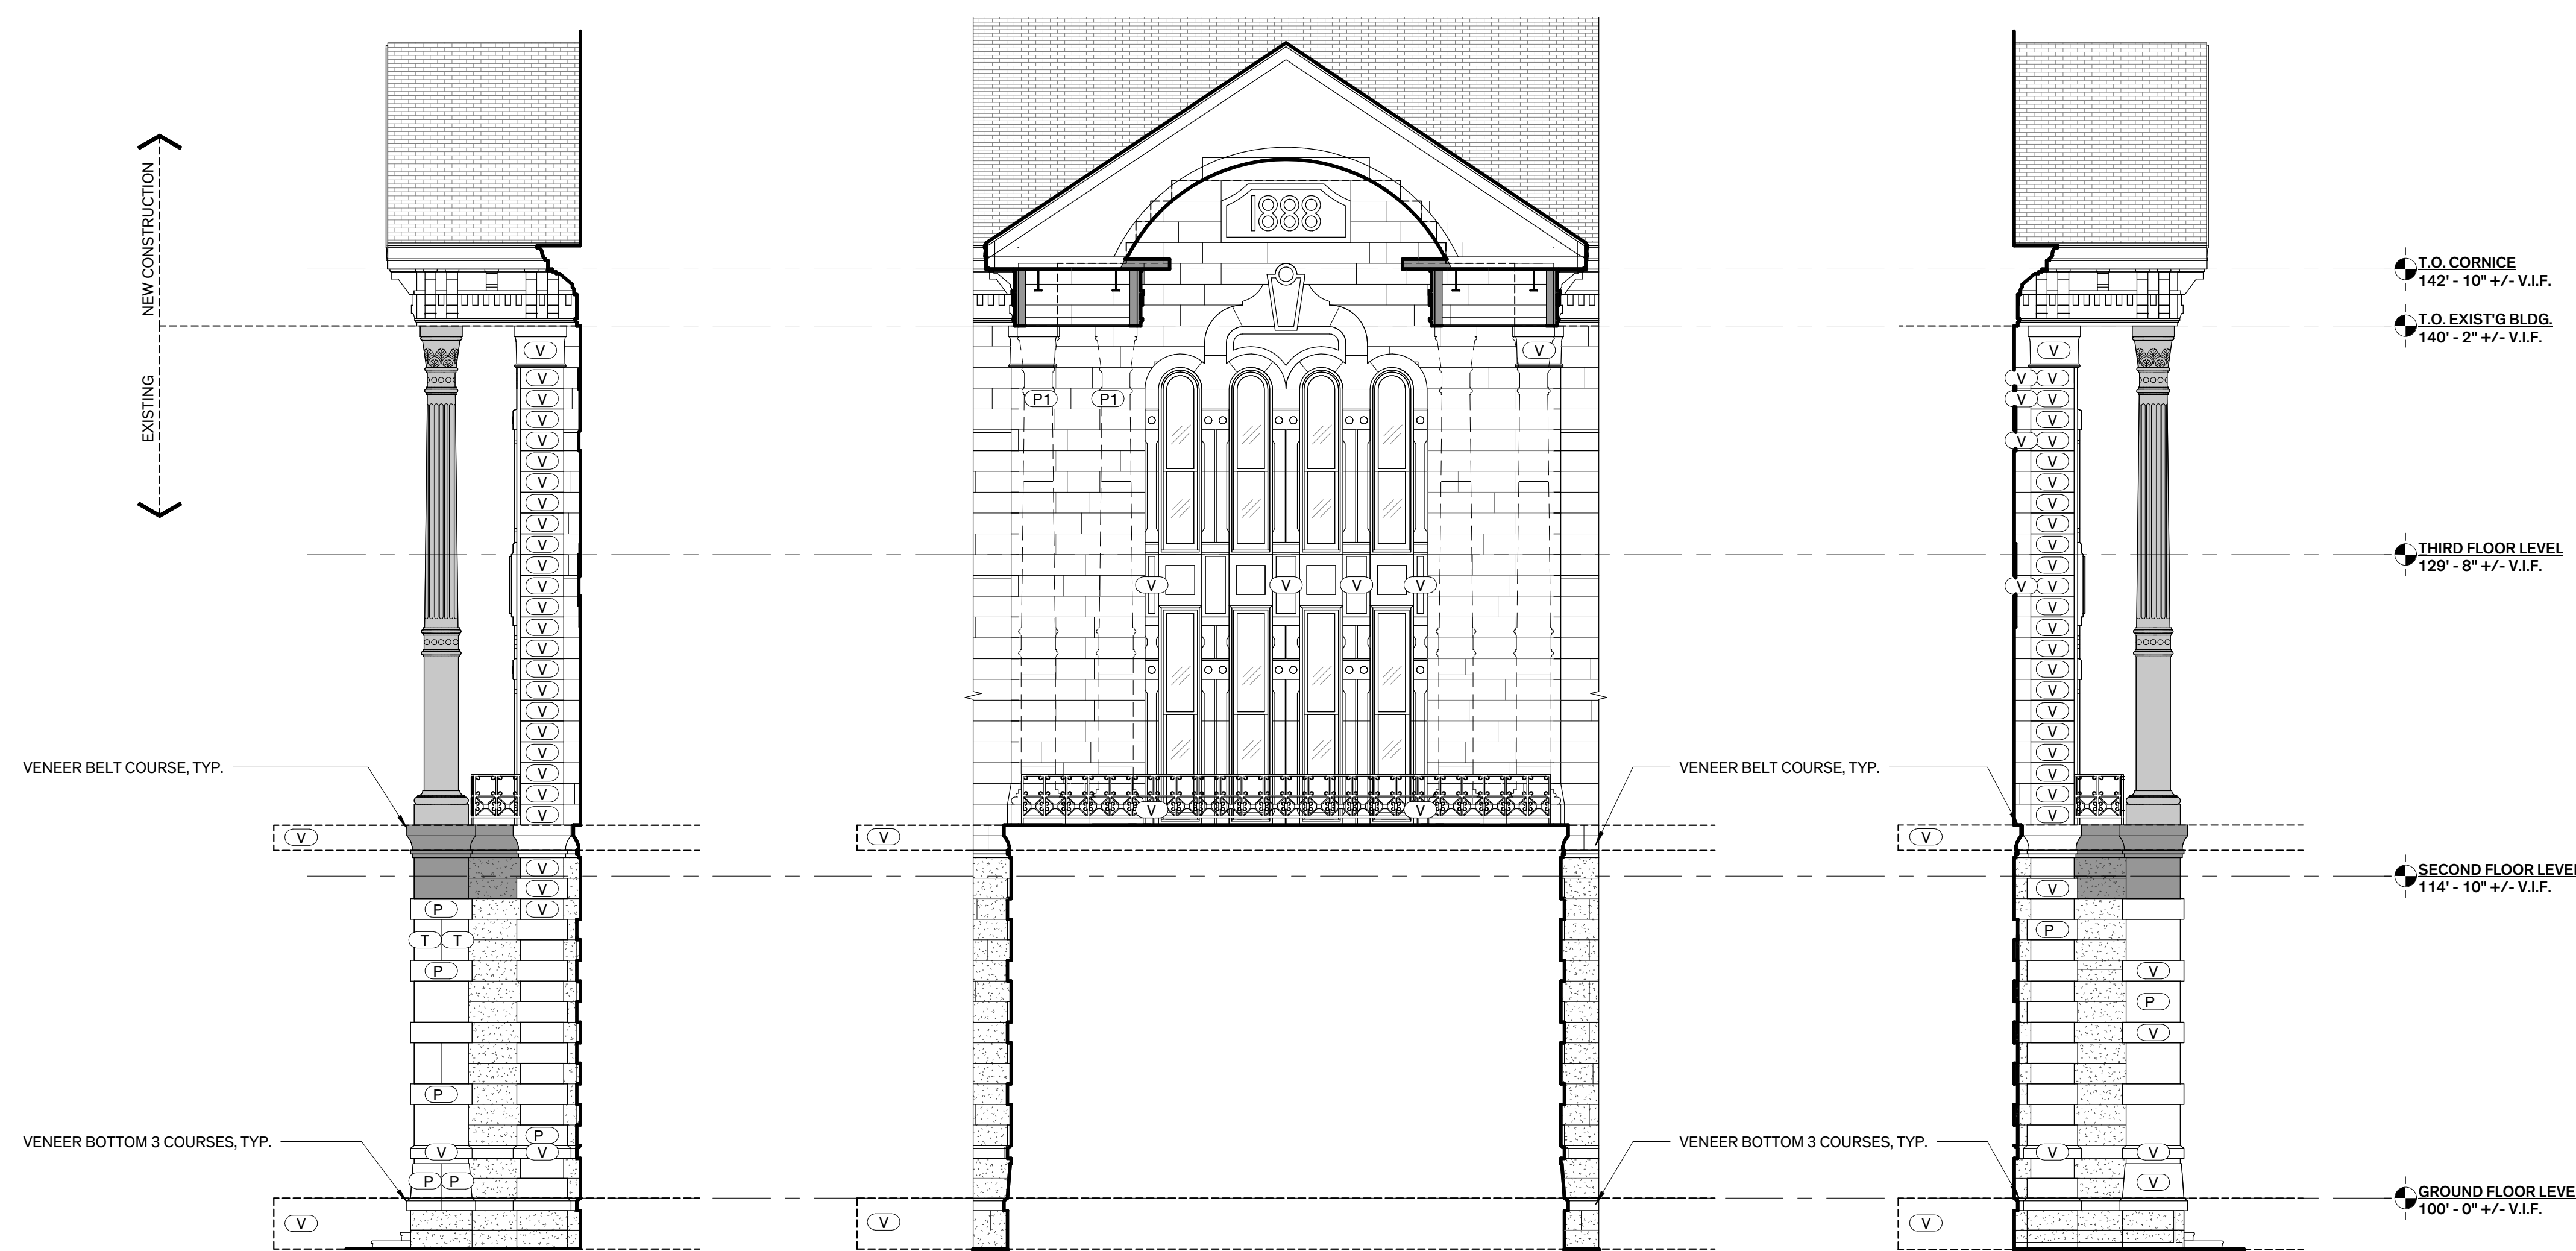

**View #6**  
**3 @ East Elevation**  
 3/16" = 1'-0"

**View #5**  
**2 @ East Elevation**  
 3/16" = 1'-0"

**View #4**  
**1 @ East Elevation**  
 3/16" = 1'-0"

## LEGEND

	HONED, SMOOTH LIMESTONE
	ROCK FACE LIMESTONE

TEXAS HISTORICAL COMMISSION  
*real places telling real stories*




FANNIN COUNTY  
 COURTHOUSE  
 INTERIOR & EXTERIOR RESTORATION

101 E. Sam Rayburn Drive  
 Bonham, Texas 75418

**COPYRIGHT**  
 The Contractor shall verify and be responsible for all dimensions. DO NOT scale the drawing. Any errors or omissions shall be reported to Architexas without delay. The Copyrights to all designs and drawings are the property of Architexas. Reproduction or use for any purpose other than that authorized by Architexas is forbidden.

**REVISION HISTORY**  
 1 Oct. 16, 2018 Addendum #1

ISSUED FOR CONSTRUCTION

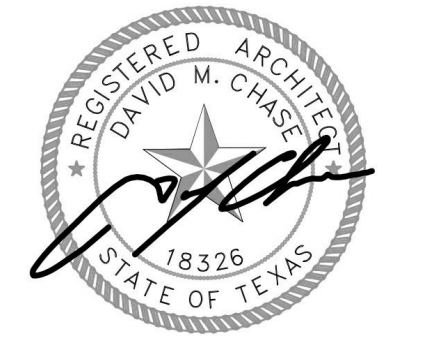

Architexas No. 1737 Date SEPT. 21, 2018

Sheet Name PARTIAL EAST & WEST ELEVATIONS

Sheet Number



## GENERAL NOTES

- GENERAL**
- PROTECT EXISTING MATERIALS DURING CONSTRUCTION THAT ARE SCHEDULED TO REMAIN. DAMAGE TO EXISTING FINISH SURFACES BY THE CONTRACTOR SHALL BE CORRECTED IN KIND AT NO ADDITIONAL COST TO THE OWNER.
  - PROVIDE TEMPORARY WEATHERTIGHT CLOSURES FOR EXTERIOR OPENINGS TO PROVIDE ACCEPTABLE INTERIOR WORKING CONDITIONS AND PREVENT ENTRY OF UNAUTHORIZED PERSONS.
  - REMOVE NON-ORIGINAL MASONRY AT ORIGINAL WINDOW OPENINGS.
  - FINISH FLOOR ELEVATIONS:
    - EXIST'G ELEVATIONS & CEILING HEIGHTS ARE APPROXIMATE & ARE TO BE VERIFIED IN THE FIELD BY CONTRACTOR.
    - FINAL ELEVATIONS & CEILING HEIGHTS WILL BE DETERMINED ONCE NEW FINISH FLOOR LEVELS ARE ESTABLISHED IN CORRIDORS.

- MASONRY CLEANING**
- CLEAN EXISTING LIMESTONE SURFACES WITH APPROVED PROCEDURES NOTED IN PROJECT MANUAL AND REPORT FROM WJE.
  - PROVIDE MOCKUP TO DETERMINE APPROPRIATE METHOD WITH GENTLEST MEANS POSSIBLE.
  - SANDBLASTING AND THE USE OF NON-PROPRIETARY ACIDS IS PROHIBITED.
  - FOLLOW MANUFACTURER'S INSTRUCTIONS AND PROCEDURES ESTABLISHED DURING PREPARATION OF MOCKUP.
  - DO NOT DAMAGE EXISTING SURFACES. LEAVE SURFACES UNIFORM IN APPEARANCE PRIOR TO PATCH APPLICATION.
  - THE EXISTING PAINT LAYERS UNDERNEATH THE MASTIC ON THE EXTERIOR MASONRY IS KNOWN TO CONTAIN LEAD. WASTE GENERATED BY COATING REMOVAL PROCESS SHALL BE CLASSIFIED AS HAZARDOUS MATERIAL AND SHALL BE REMOVED IN ACCORDANCE WITH EPA & OSHA GUIDELINES.

- REMOVAL OF FASTENERS**
- REMOVE EXISTING FASTENERS, BOLTS, CLAMPS, STRAPS, ETC. ON THE EXTERIOR OF THE BUILDING THAT ARE ATTACHED OR EMBEDDED IN EXISTING MATERIALS AND ARE NOT BEING USED TO FASTEN ELEMENTS TO REMAIN.
  - REMOVE EXISTING ANCHORS, FASTENERS AND THE WIRE USING CORE DRILL.
  - WIDTH AND DEPTH OF CORE DRILLED HOLES TO BE DETERMINED BY MASONRY REPAIR MANUFACTURER.
  - PROVIDE MOCKUP OF EACH TYPE OF ANCHOR REMOVAL TO DETERMINE APPROPRIATE METHOD.
  - TREAT EXPOSED FERROUS METAL WITHIN REPAIR AREA WITH COATING BY MASONRY REPAIR MANUFACTURER.

- RESTORATION MORTAR**
- CONTRACTOR IS RESPONSIBLE FOR CONDUCTING PETROGRAPHIC TESTING ON ORIGINAL MORTAR.
  - PROVIDE MOCKUP OF MORTAR THAT CLOSELY MATCHES CONSISTENCY, COLOR, STRENGTH AND PROFILE OF ORIGINAL MORTAR.
  - ASSUME 100% REPOINTING OF EXTERIOR MASONRY JOINTS.

- MASONRY RESTORATION**
- REMOVE LOOSE AND DELAMINATED MATERIAL FROM STONE SURFACES.
  - REMOVE EXISTING LIMESTONE FOR TESTING OF COMPRESSIVE STRENGTH, ABSORPTION AND INITIAL RATE OF ABSORPTION.
  - REUSE ORIGINAL LIMESTONE WHERE POSSIBLE. WHERE SALVAGED LIMESTONE IS OF INSUFFICIENT QUANTITY, PROVIDE NEW LIMESTONE FROM ORIGINAL QUARRY TO MATCH ORIGINAL. TEST QUARRY STONE TO DETERMINE IF IT IS A SUITABLE MATCH TO EXISTING LIMESTONE PRIOR TO INSTALLATION.
  - DAMAGED AND / OR MISSING LIMESTONE IS TO BE PATCHED, TOOLED, AND / OR REPLACED WITH MATERIAL THAT CLOSELY MATCHES ORIGINAL PROFILE, COLOR, AND COMPOSITION.

- DOORS AND WINDOWS**
- REFERENCE DOOR & WINDOW SCHEDULES FOR SCOPE OF WORK ASSOCIATED WITH EXTERIOR FACING DOORS AND WINDOWS.

## MASONRY RESTORATION LEGEND

**NEW / REPLACEMENT LIMESTONE**

**NEW / REPLACEMENT CAST STONE**

**PATCH REPAIR:**

REMOVE DETERIORATED STONE UNTIL SOUND MATERIAL IS REACHED AND TOOL SURFACES TO FORM MECHANICAL BOND WITH CEMENTITIOUS PATCHING MATERIAL. PATCHING MATERIAL SHALL BE CUSTOM COLOR - MATCH ADJACENT STONE.

- 1 - INDICATES AREAS WHERE ANCHORS WERE LOCATED
- 2 - INDICATES LESS THAN 15% DETERIORATION
- 3 - INDICATES 15% TO 50% DETERIORATION

**STONE REPLACEMENT:**

REPLACE DAMAGED OR MISSING LIMESTONE WITH LIMESTONE MATERIAL THAT MATCHES ADJACENT STONE SURFACES.

**CRACK REPAIR:**

INDICATES EXIST'G CRACK TO RECEIVE EPOXY

**TOOL REPAIR:**

TOOL EXISTING LIMESTONE SURFACES TO CREATE SURFACE FINISH THAT CLOSELY RESEMBLES EXISTING ADJACENT STONE SURFACES

**DUTCHMAN REPAIR:**

- RESURFACE DETERIORATED STONE WITH NEW STONE TO MATCH ORIGINAL.
- REMOVE DETERIORATED STONE TO POINT AT WHICH SOUND STONE IS REACHED. REMOVAL TO INCLUDE FULL OUTER SURFACE EXTENDING FROM MORTAR JOINT TO MORTAR JOINT. DEPTH VARIES, VERIFY CONDITIONS IN THE FIELD. ASSUME 3 INCH MINIMUM DEPTH AT SMOOTH SURFACES AND UP TO 12 INCHES +/- AT SPLIT-FACED SURFACES.
- DRILL HOLES FOR DOWELS AT INTERFACE OF NEW AND EXISTING STONE.
- ANCHOR NEW STONE TO EXISTING WITH ANCHORS SET IN EPOXY.
- FINISH NEW STONE FLUSH WITH ADJACENT STONE. MAINTAIN ORIGINAL MORTAR JOINT LOCATIONS. PARTIAL VENEERS WILL ONLY BE CONSIDERED AT CONCEALED LOCATIONS.



## FANNIN COUNTY COURTHOUSE INTERIOR & EXTERIOR RESTORATION

101 E. Sam Rayburn Drive  
 Bonham, Texas 75418

**COPYRIGHT**  
 The Contractor shall verify and be responsible for all dimensions. DO NOT scale the drawing. Any errors or omissions shall be reported to Architexas without delay. The Copyrights to all designs and drawings are the property of Architexas. Reproduction or use for any purpose other than that authorized by Architexas is forbidden.

**REVISION HISTORY**  
 1 Oct. 16, 2018 Addendum #1


ISSUED FOR CONSTRUCTION



Architexas No. 1737 Date SEPT. 21, 2018

Sheet Name SOUTH ELEVATION

Sheet Number A2.05

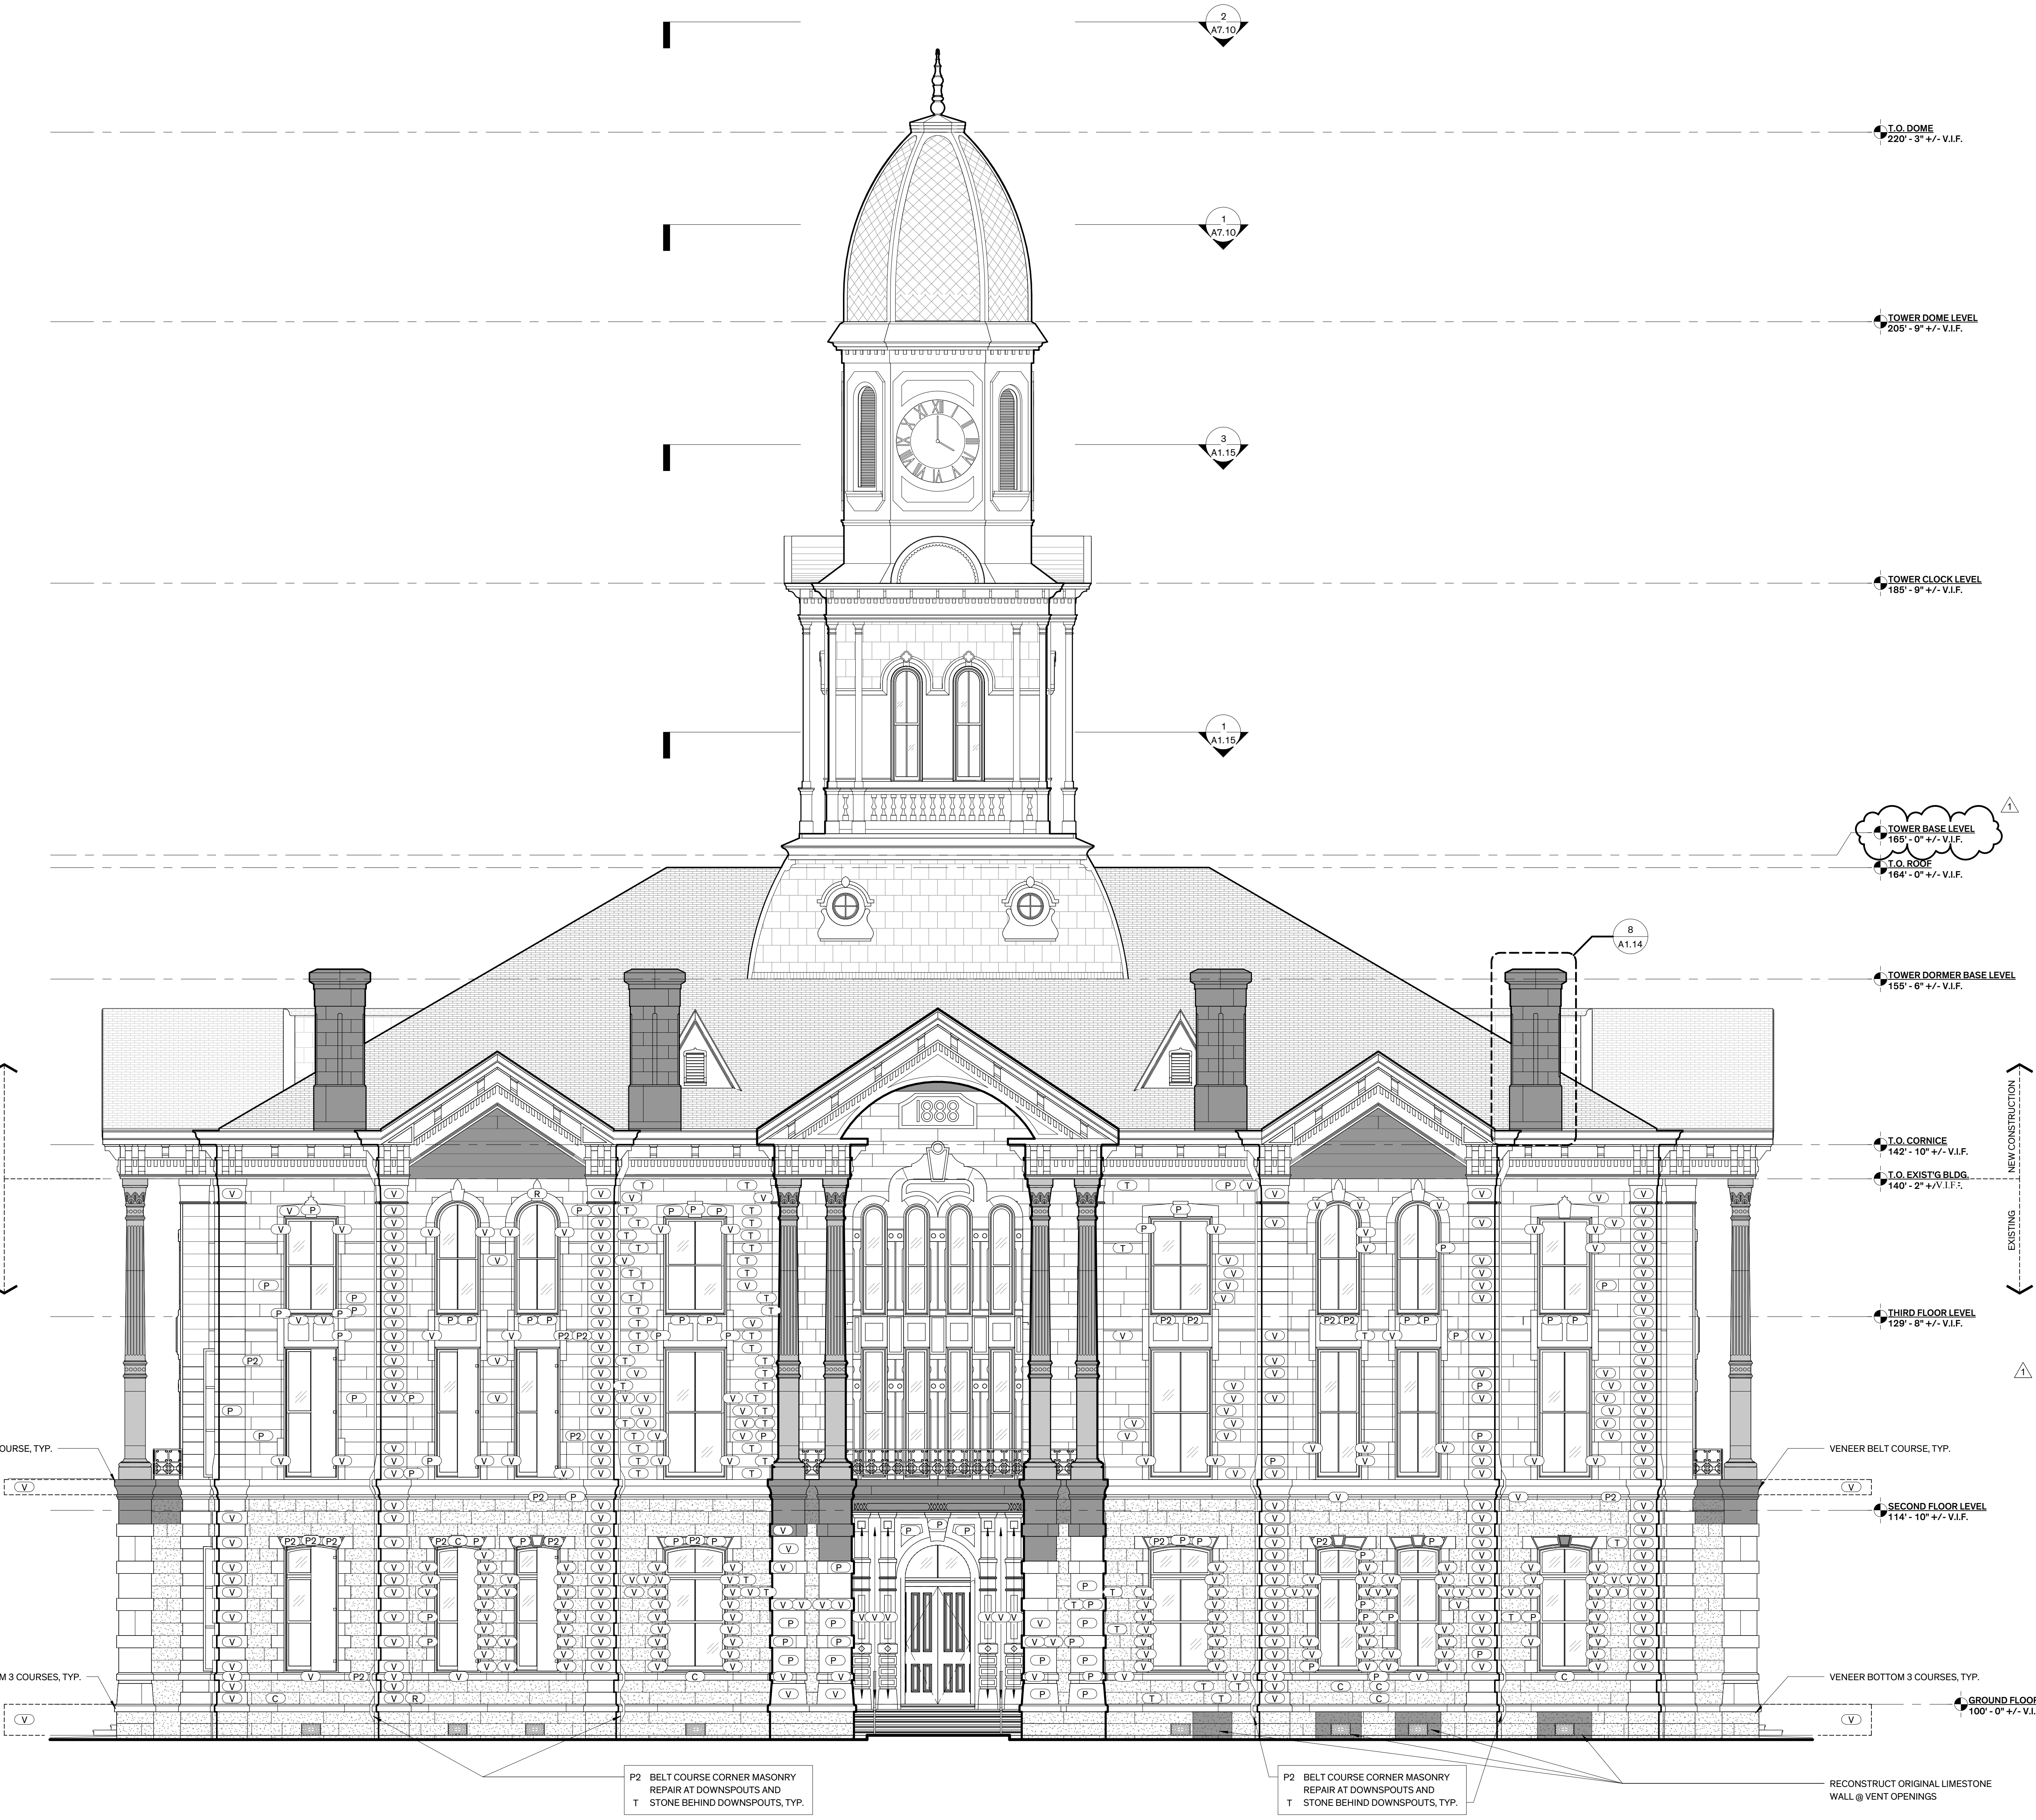

1 South Elevation  
 3/16" = 1'-0"

## LEGEND

**HONED, SMOOTH LIMESTONE**

**ROCK FACE LIMESTONE**

**GENERAL NOTES**

- GENERAL**
- PROTECT EXISTING MATERIALS DURING CONSTRUCTION THAT ARE SCHEDULED TO REMAIN. DAMAGE TO EXISTING FINISH SURFACES BY THE CONTRACTOR SHALL BE CORRECTED IN KIND AT NO ADDITIONAL COST TO THE OWNER.
  - PROVIDE TEMPORARY WEATHERTIGHT CLOSURES FOR EXTERIOR OPENINGS TO PROVIDE ACCEPTABLE INTERIOR WORKING CONDITIONS AND PREVENT ENTRY OF UNAUTHORIZED PERSONS.
  - REMOVE NON-ORIGINAL MASONRY AT ORIGINAL WINDOW OPENINGS.
  - FINISH FLOOR ELEVATIONS:
    - EXIST'G ELEVATIONS & CEILING HEIGHTS ARE APPROXIMATE & ARE TO BE VERIFIED IN THE FIELD BY CONTRACTOR.
    - FINAL ELEVATIONS & CEILING HEIGHTS WILL BE DETERMINED ONCE NEW FINISH FLOOR LEVELS ARE ESTABLISHED IN CORRIDORS.

- MASONRY CLEANING**
- CLEAN EXISTING LIMESTONE SURFACES WITH APPROVED PROCEDURES NOTED IN PROJECT MANUAL AND REPORT FROM WJE.
  - PROVIDE MOCKUP TO DETERMINE APPROPRIATE METHOD WITH GENTLEST MEANS POSSIBLE.
  - SANDBLASTING AND THE USE OF NON-PROPRIETARY ACIDS IS PROHIBITED.
  - FOLLOW MANUFACTURER'S INSTRUCTIONS AND PROCEDURES ESTABLISHED DURING PREPARATION OF MOCKUP.
  - DO NOT DAMAGE EXISTING SURFACES. LEAVE SURFACES UNIFORM IN APPEARANCE PRIOR TO PATCH APPLICATION.
  - THE EXISTING PAINT LAYERS UNDERNEATH THE MASTIC ON THE EXTERIOR MASONRY IS KNOWN TO CONTAIN LEAD. WASTE GENERATED BY COATING REMOVAL PROCESS SHALL BE CLASSIFIED AS HAZARDOUS MATERIAL AND SHALL BE REMOVED IN ACCORDANCE WITH EPA & OSHA GUIDELINES.

- REMOVAL OF FASTENERS**
- REMOVE EXISTING FASTENERS, BOLTS, CLAMPS, STRAPS, ETC. ON THE EXTERIOR OF THE BUILDING THAT ARE ATTACHED OR EMBEDDED IN EXISTING MATERIALS AND ARE NOT BEING USED TO FASTEN ELEMENTS TO REMAIN.
  - REMOVE EXISTING ANCHORS, FASTENERS AND THE WIRE USING CORE DRILL.
  - WIDTH AND DEPTH OF CORE DRILLED HOLES TO BE DETERMINED BY MASONRY REPAIR MANUFACTURER.
  - PROVIDE MOCKUP OF EACH TYPE OF ANCHOR REMOVAL TO DETERMINE APPROPRIATE METHOD.
  - TREAT EXPOSED FERROUS METAL WITHIN REPAIR AREA WITH COATING BY MASONRY REPAIR MANUFACTURER.

- RESTORATION MORTAR**
- CONTRACTOR IS RESPONSIBLE FOR CONDUCTING PETROGRAPHIC TESTING ON ORIGINAL MORTAR.
  - PROVIDE MOCKUP OF MORTAR THAT CLOSELY MATCHES CONSISTENCY, COLOR, STRENGTH AND PROFILE OF ORIGINAL MORTAR.
  - ASSUME 100% REPOINTING OF EXTERIOR MASONRY JOINTS.

- MASONRY RESTORATION**
- REMOVE LOOSE AND DELAMINATED MATERIAL FROM STONE SURFACES.
  - REMOVE EXISTING LIMESTONE FOR TESTING OF COMPRESSIVE STRENGTH, ABSORPTION, AND INITIAL RATE OF ABSORPTION.
  - REUSE ORIGINAL LIMESTONE WHERE POSSIBLE. WHERE SALVAGED LIMESTONE IS OF INSUFFICIENT QUANTITY, PROVIDE NEW LIMESTONE FROM ORIGINAL QUARRY TO MATCH ORIGINAL. TEST QUARRY STONE TO DETERMINE IF IT IS A SUITABLE MATCH TO EXISTING LIMESTONE PRIOR TO INSTALLATION.
  - DAMAGED AND / OR MISSING LIMESTONE IS TO BE PATCHED, TOOLED, AND / OR REPLACED WITH MATERIAL THAT CLOSELY MATCHES ORIGINAL PROFILE, COLOR, AND COMPOSITION.

- DOORS AND WINDOWS**
- REFERENCE DOOR & WINDOW SCHEDULES FOR SCOPE OF WORK ASSOCIATED WITH EXTERIOR FACING DOORS AND WINDOWS.

**MASONRY RESTORATION LEGEND**

NEW / REPLACEMENT LIMESTONE

NEW / REPLACEMENT CAST STONE



(P) PATCH REPAIR:  
 REMOVE DETERIORATED STONE UNTIL SOUND MATERIAL IS REACHED AND TOOL SURFACES TO FORM MECHANICAL BOND WITH CEMENTITIOUS PATCHING MATERIAL. PATCHING MATERIAL SHALL BE CUSTOM COLOR - MATCH ADJACENT STONE.  
 1 - INDICATES AREAS WHERE ANCHORS WERE LOCATED  
 2 - INDICATES LESS THAN 15% DETERIORATION  
 3 - INDICATES 15% TO 50% DETERIORATION

(R) STONE REPLACEMENT:  
 REPLACE DAMAGED OR MISSING LIMESTONE WITH LIMESTONE MATERIAL THAT MATCHES ADJACENT STONE SURFACES.

(C) CRACK REPAIR:  
 INDICATES EXIST'G CRACK TO RECEIVE EPOXY

(T) TOOL REPAIR:  
 TOOL EXISTING LIMESTONE SURFACES TO CREATE SURFACE FINISH THAT CLOSELY RESEMBLES EXISTING ADJACENT STONE SURFACES



(D) DUTCHMAN REPAIR:  
 REF. SHEET A2.01

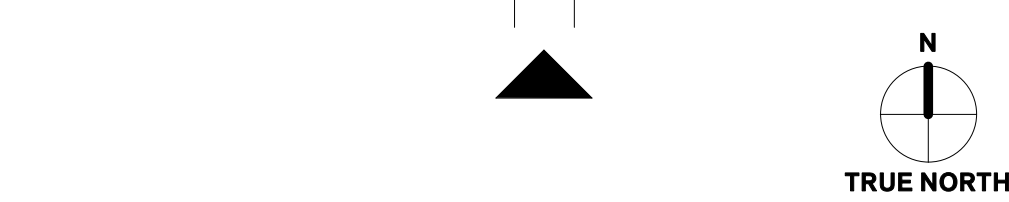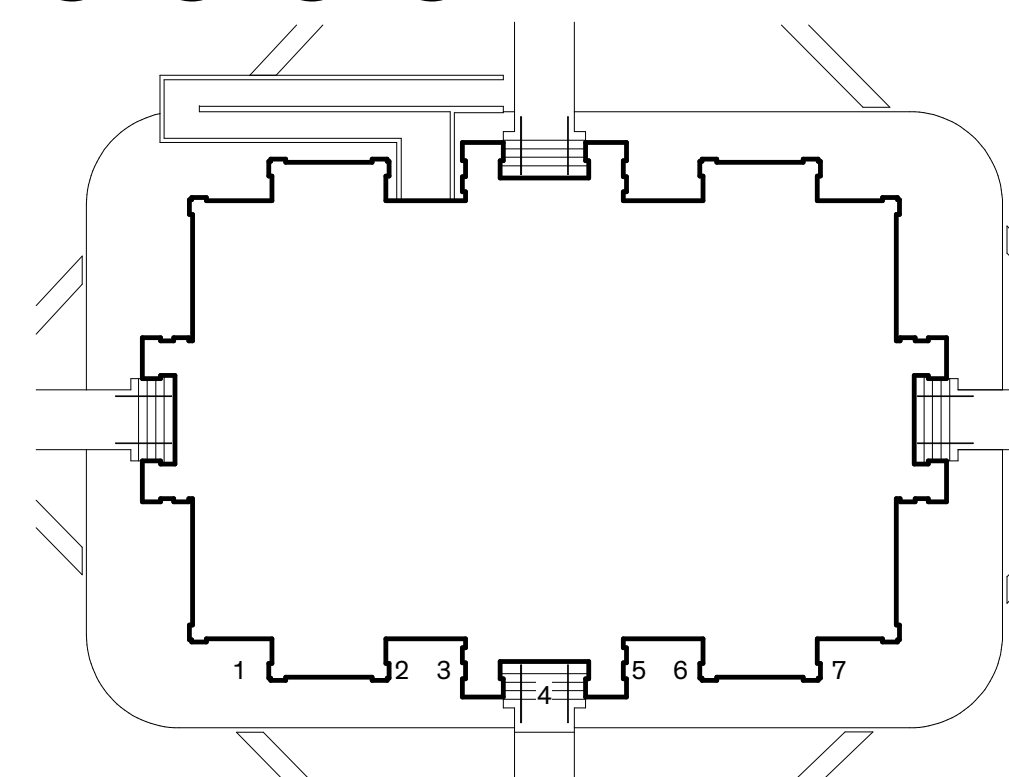

**LEGEND**

HONED, SMOOTH LIMESTONE

ROCK FACE LIMESTONE

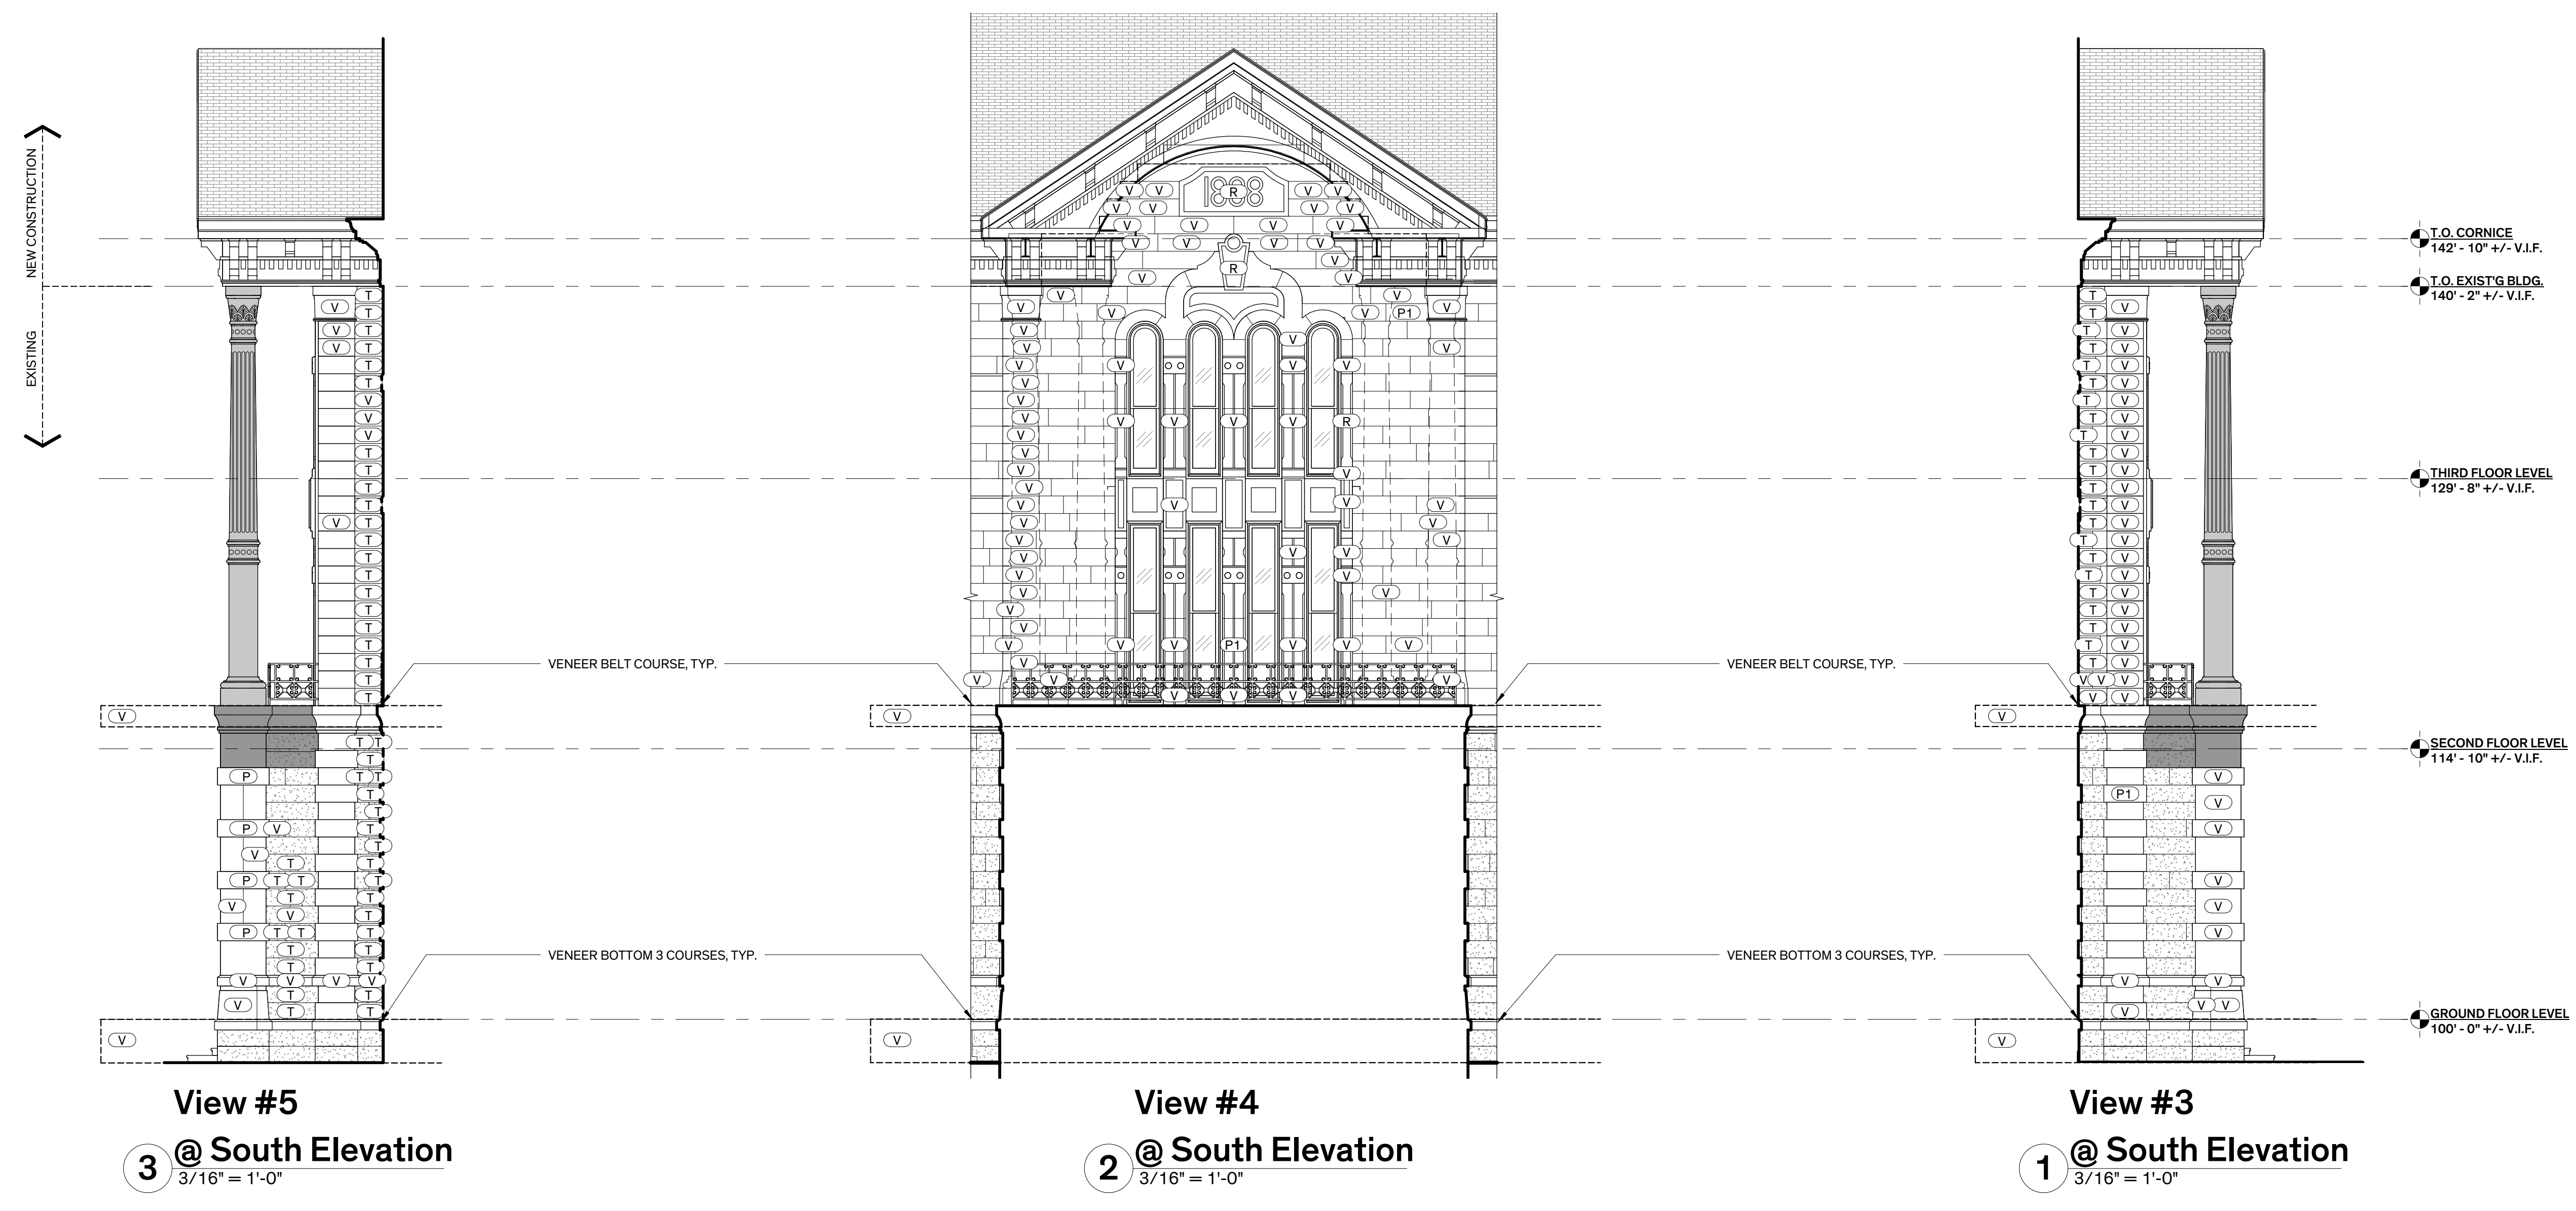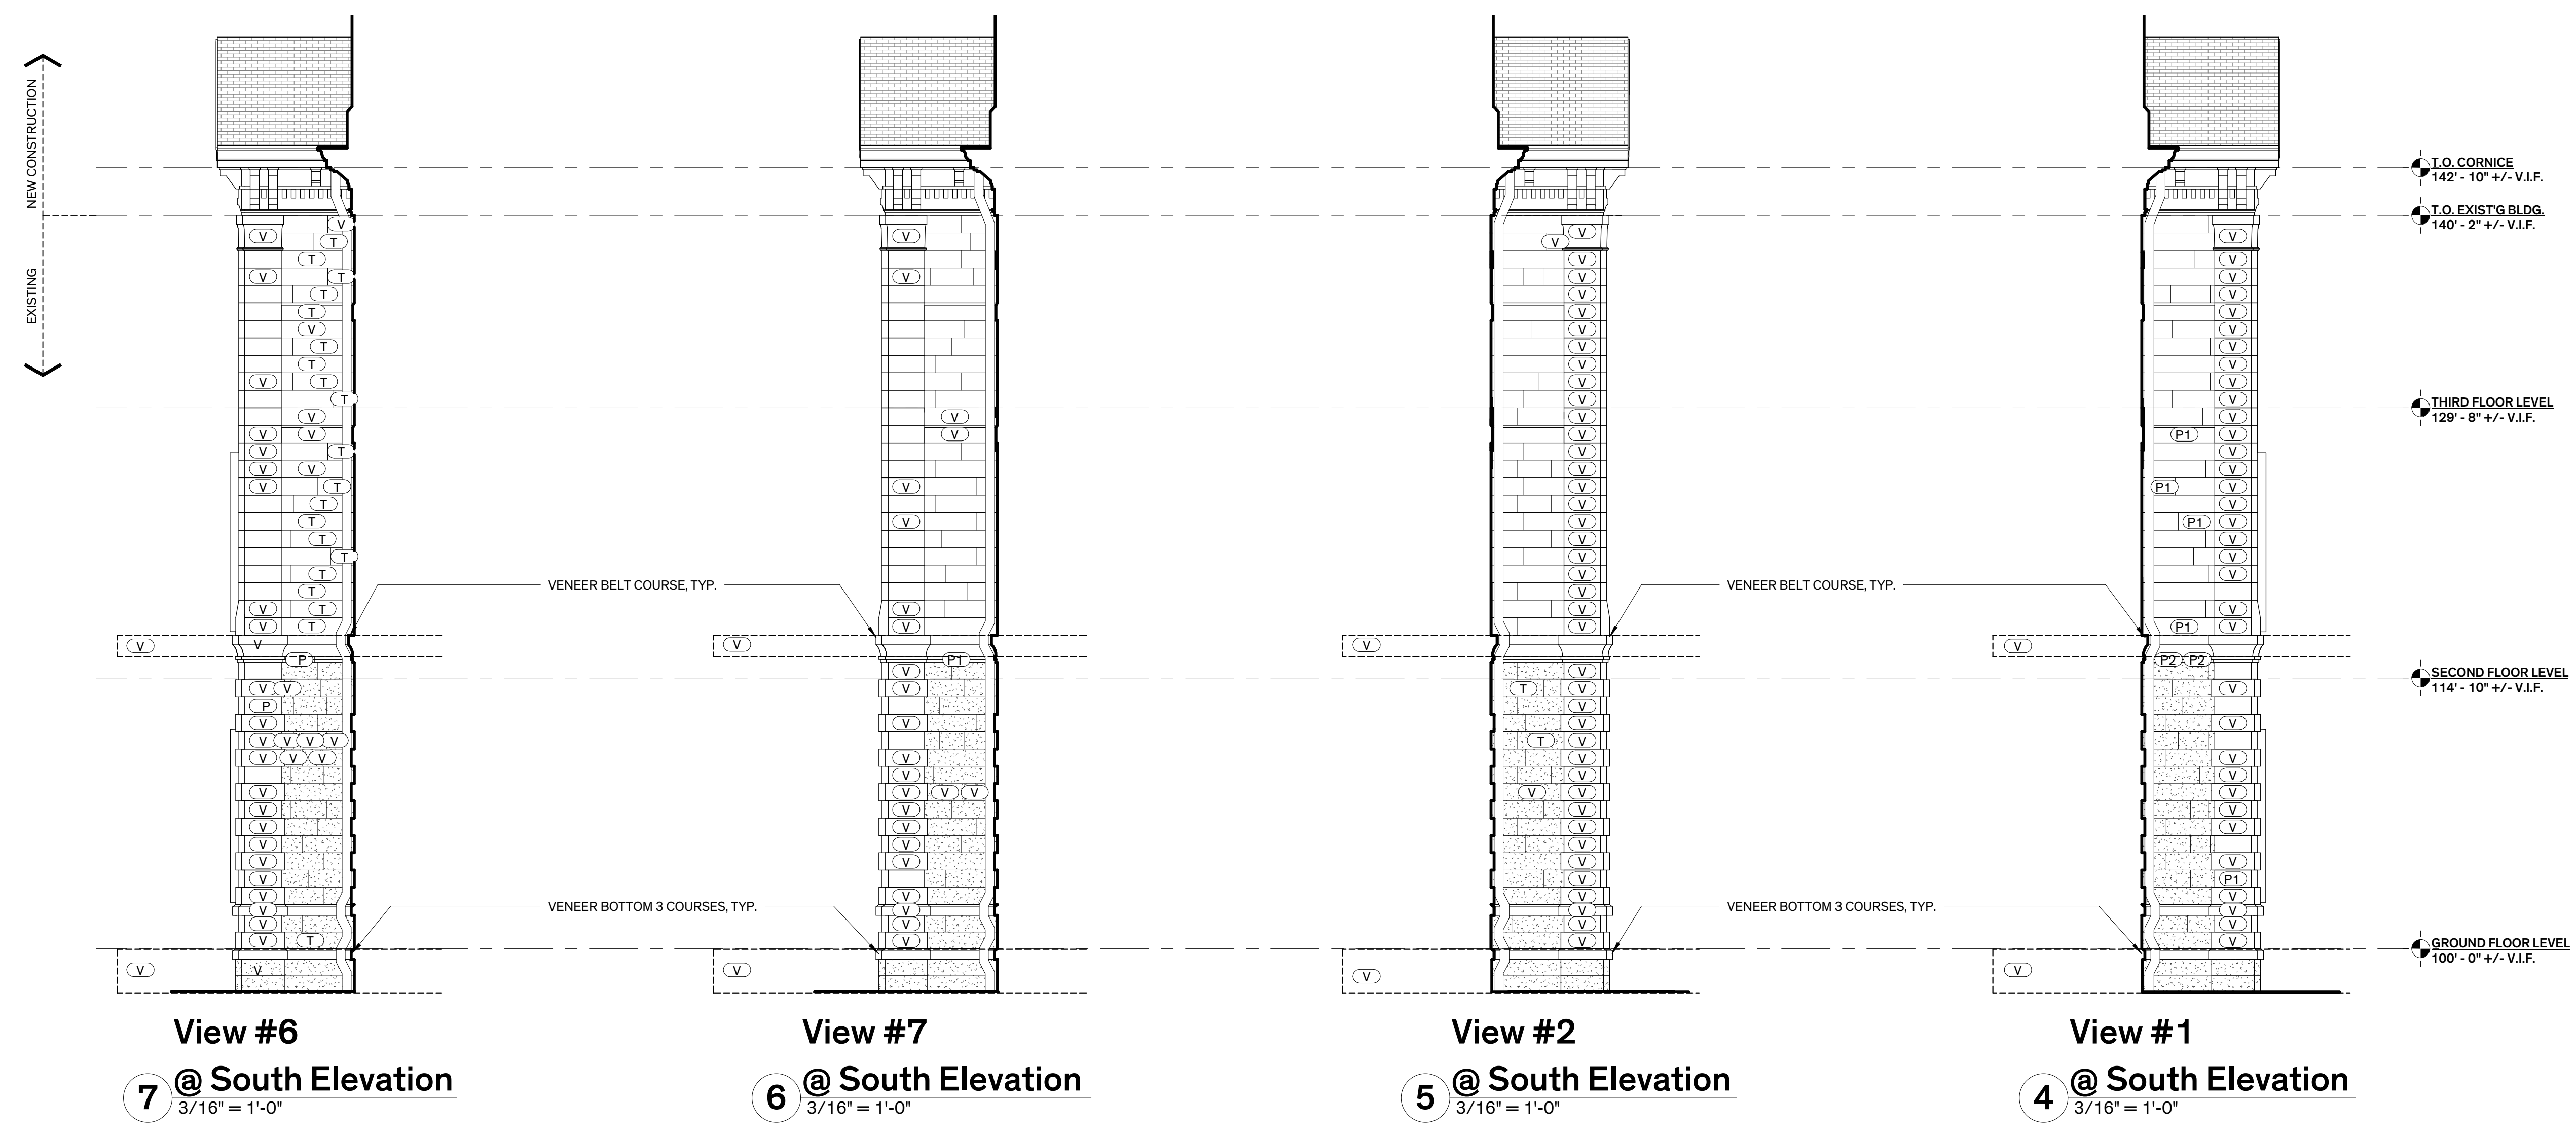

**FANNIN COUNTY COURTHOUSE**  
 INTERIOR & EXTERIOR RESTORATION

101 E. Sam Rayburn Drive  
 Bonham, Texas 75418

**COPYRIGHT**  
 The Contractor shall verify and be responsible for all dimensions. DO NOT scale the drawing. Any errors or omissions shall be reported to Architexas without delay. The Copyrights to all designs and drawings are the property of Architexas. Reproduction or use for any purpose other than that authorized by Architexas is forbidden.

**REVISION HISTORY**  
 1 Oct. 16, 2018 Addendum #1

ISSUED FOR CONSTRUCTION




Architexas No. 1737 Date SEPT. 21, 2018

Sheet Name PARTIAL SOUTH ELEVATIONS

Sheet Number A2.06



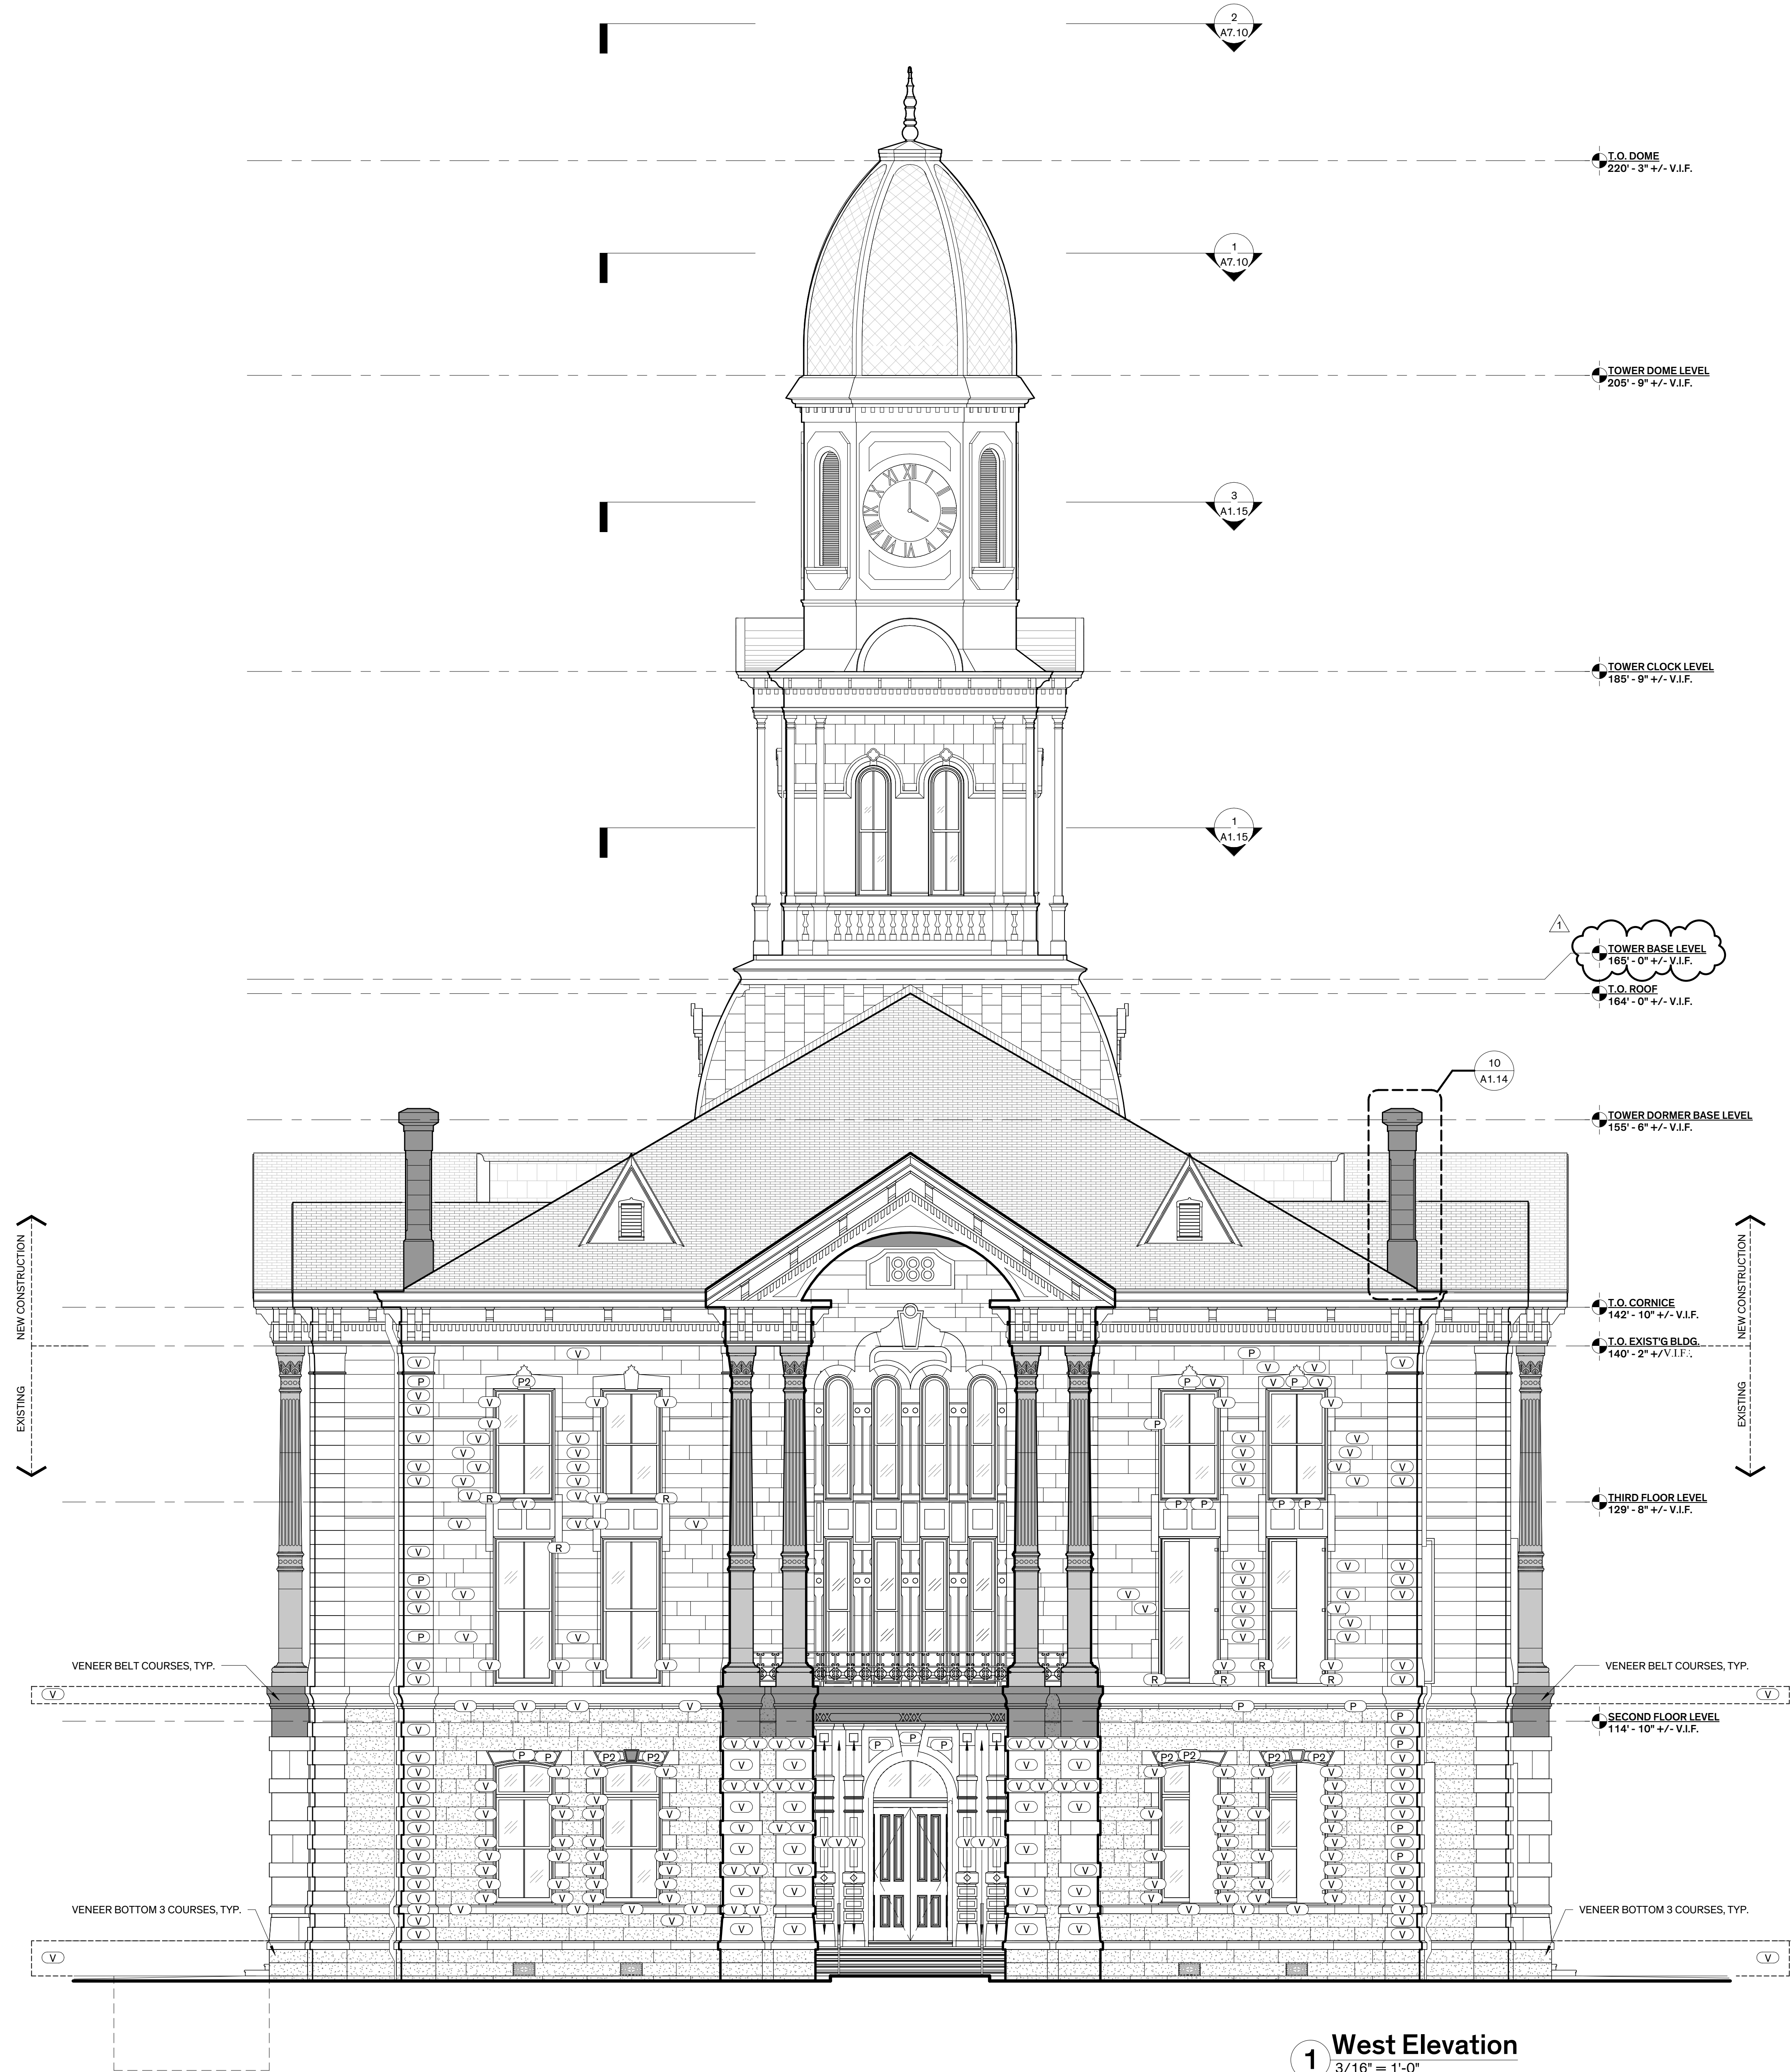

1 West Elevation  
3/16" = 1'-0"

GENERAL NOTES

- GENERAL:**
- PROTECT EXISTING MATERIALS DURING CONSTRUCTION THAT ARE SCHEDULED TO REMAIN. DAMAGE TO EXISTING FINISH SURFACES BY THE CONTRACTOR SHALL BE CORRECTED IN KIND AT NO ADDITIONAL COST TO THE OWNER.
  - PROVIDE TEMPORARY WEATHERTIGHT CLOSURES FOR EXTERIOR OPENINGS TO PROVIDE ACCEPTABLE INTERIOR WORKING CONDITIONS AND PREVENT ENTRY OF UNAUTHORIZED PERSONS. REMOVE NON-ORIGINAL MASONRY AT ORIGINAL WINDOW OPENINGS.
  - FINISH FLOOR ELEVATIONS:
    - EXIST'G ELEVATIONS & CEILING HEIGHTS ARE APPROXIMATE & ARE TO BE VERIFIED IN THE FIELD BY CONTRACTOR.
    - FINAL ELEVATIONS & CEILING HEIGHTS WILL BE DETERMINED ONCE NEW FINISH FLOOR LEVELS ARE ESTABLISHED IN CORRIDORS.

MASONRY CLEANING

- CLEAN EXISTING LIMESTONE SURFACES WITH APPROVED PROCEDURES NOTED IN PROJECT MANUAL AND REPORT FROM WJE.
- PROVIDE MOCKUP TO DETERMINE APPROPRIATE METHOD WITH GENTLEST MEANS POSSIBLE.
- SANDBLASTING AND THE USE OF NON-PROPRIETARY ACIDS IS PROHIBITED.
- FOLLOW MANUFACTURER'S INSTRUCTIONS AND PROCEDURES ESTABLISHED DURING PREPARATION OF MOCKUP.
- DO NOT DAMAGE EXISTING SURFACES. LEAVE SURFACES UNIFORM IN APPEARANCE PRIOR TO PATCH APPLICATION.
- THE EXISTING PAINT LAYERS UNDERNEATH THE MASTIC ON THE EXTERIOR MASONRY IS KNOWN TO CONTAIN LEAD. WASTE GENERATED BY COATING REMOVAL PROCESS SHALL BE CLASSIFIED AS HAZARDOUS MATERIAL AND SHALL BE REMOVED IN ACCORDANCE WITH EPA & OSHA GUIDELINES.

REMOVAL OF FASTENERS

- REMOVE EXISTING FASTENERS, BOLTS, CLAMPS, STRAPS, ETC. ON THE EXTERIOR OF THE BUILDING THAT ARE ATTACHED OR EMBEDDED IN EXISTING MATERIALS AND ARE NOT BEING USED TO FASTEN ELEMENTS TO REMAIN.
- REMOVE EXISTING ANCHORS, FASTENERS AND THE WIRE USING CORE DRILL.
- WIDTH AND DEPTH OF CORE DRILLED HOLES TO BE DETERMINED BY MASONRY REPAIR MANUFACTURER.
- PROVIDE MOCKUP OF EACH TYPE OF ANCHOR REMOVAL TO DETERMINE APPROPRIATE METHOD.
- TREAT EXPOSED FERROUS METAL WITHIN REPAIR AREA WITH COATING BY MASONRY REPAIR MANUFACTURER.

RESTORATION MORTAR

- CONTRACTOR IS RESPONSIBLE FOR CONDUCTING PETROGRAPHIC TESTING ON ORIGINAL MORTAR.
- PROVIDE MOCKUP OF MORTAR THAT CLOSELY MATCHES CONSISTENCY, COLOR, STRENGTH AND PROFILE OF ORIGINAL MORTAR.
- ASSUME 100% REPOINTING OF EXTERIOR MASONRY JOINTS.

MASONRY RESTORATION

- REMOVE LOOSE AND DELAMINATED MATERIAL FROM STONE SURFACES.
- REMOVE EXISTING LIMESTONE FOR TESTING OF COMPRESSIVE STRENGTH, ABSORPTION, AND INITIAL RATE OF ABSORPTION.
- REUSE ORIGINAL LIMESTONE WHERE POSSIBLE. WHERE SALVAGED LIMESTONE IS OF INSUFFICIENT QUANTITY, PROVIDE NEW LIMESTONE FROM ORIGINAL QUARRY TO MATCH ORIGINAL. TEST QUARRY STONE TO DETERMINE IF IT IS A SUITABLE MATCH TO EXISTING LIMESTONE PRIOR TO INSTALLATION.
- DAMAGED AND / OR MISSING LIMESTONE IS TO BE PATCHED, TOOLED, AND / OR REPLACED WITH MATERIAL THAT CLOSELY MATCHES ORIGINAL PROFILE, COLOR, AND COMPOSITION.

DOORS AND WINDOWS

- REFERENCE DOOR & WINDOW SCHEDULES FOR SCOPE OF WORK ASSOCIATED WITH EXTERIOR FACING DOORS AND WINDOWS.

MASONRY RESTORATION LEGEND

**NEW / REPLACEMENT LIMESTONE**

**NEW / REPLACEMENT CAST STONE**

**PATCH REPAIR:**

REMOVE DETERIORATED STONE UNTIL SOUND MATERIAL IS REACHED AND TOOL SURFACES TO FORM MECHANICAL BOND WITH CEMENTITIOUS PATCHING MATERIAL. PATCHING MATERIAL SHALL BE CUSTOM COLOR - MATCH ADJACENT STONE.

- INDICATES AREAS WHERE ANCHORS WERE LOCATED
- INDICATES LESS THAN 15% DETERIORATION
- INDICATES 15% TO 50% DETERIORATION

**STONE REPLACEMENT:**

REPLACE DAMAGED OR MISSING LIMESTONE WITH LIMESTONE MATERIAL THAT MATCHES ADJACENT STONE SURFACES.

**CRACK REPAIR:**

INDICATES EXIST'G CRACK TO RECEIVE EPOXY

**TOOL REPAIR:**

TOOL EXISTING LIMESTONE SURFACES TO CREATE SURFACE FINISH THAT CLOSELY RESEMBLES EXISTING ADJACENT STONE SURFACES

**DUTCHMAN REPAIR:**

- RESURFACE DETERIORATED STONE WITH NEW STONE TO MATCH ORIGINAL.
- REMOVE DETERIORATED STONE TO POINT AT WHICH SOUND STONE IS REACHED. REMOVAL TO INCLUDE FULL OUTER SURFACE EXTENDING FROM MORTAR JOINT TO MORTAR JOINT. DEPTH VARIES. VERIFY CONDITIONS IN THE FIELD. ASSUME 3 INCH MINIMUM DEPTH AT SMOOTH SURFACES AND UP TO 12 INCHES +/- AT SPLIT-FACED SURFACES.
- DRILL HOLES FOR DOWELS AT INTERFACE OF NEW AND EXISTING STONE.
- ANCHOR NEW STONE TO EXISTING WITH ANCHORS SET IN EPOXY.
- FINISH NEW STONE FLUSH WITH ADJACENT STONE.
- MAINTAIN ORIGINAL MORTAR JOINT LOCATIONS. PARTIAL VENEERS WILL ONLY BE CONSIDERED AT CONCEALED LOCATIONS.



TEXAS HISTORICAL COMMISSION  
real places telling real stories



FANNIN COUNTY  
COURTHOUSE  
INTERIOR & EXTERIOR RESTORATION

101 E. Sam Rayburn Drive  
Bonham, Texas 75418

**COPYRIGHT**  
The Contractor shall verify and be responsible for all dimensions. DO NOT scale the drawing. Any errors or omissions shall be reported to Architexas without delay. The Copyrights to all designs and drawings are the property of Architexas. Reproduction or use for any purpose other than that authorized by Architexas is forbidden.

**REVISION HISTORY**  
1 Oct. 16, 2018 Addendum #1

ISSUED FOR CONSTRUCTION



#18326 9/21/2018

Architexas No. 1737 Date SEPT. 21, 2018


Sheet Name WEST ELEVATION

Sheet Number

LEGEND

**HONED, SMOOTH LIMESTONE**

**ROCK FACE LIMESTONE**

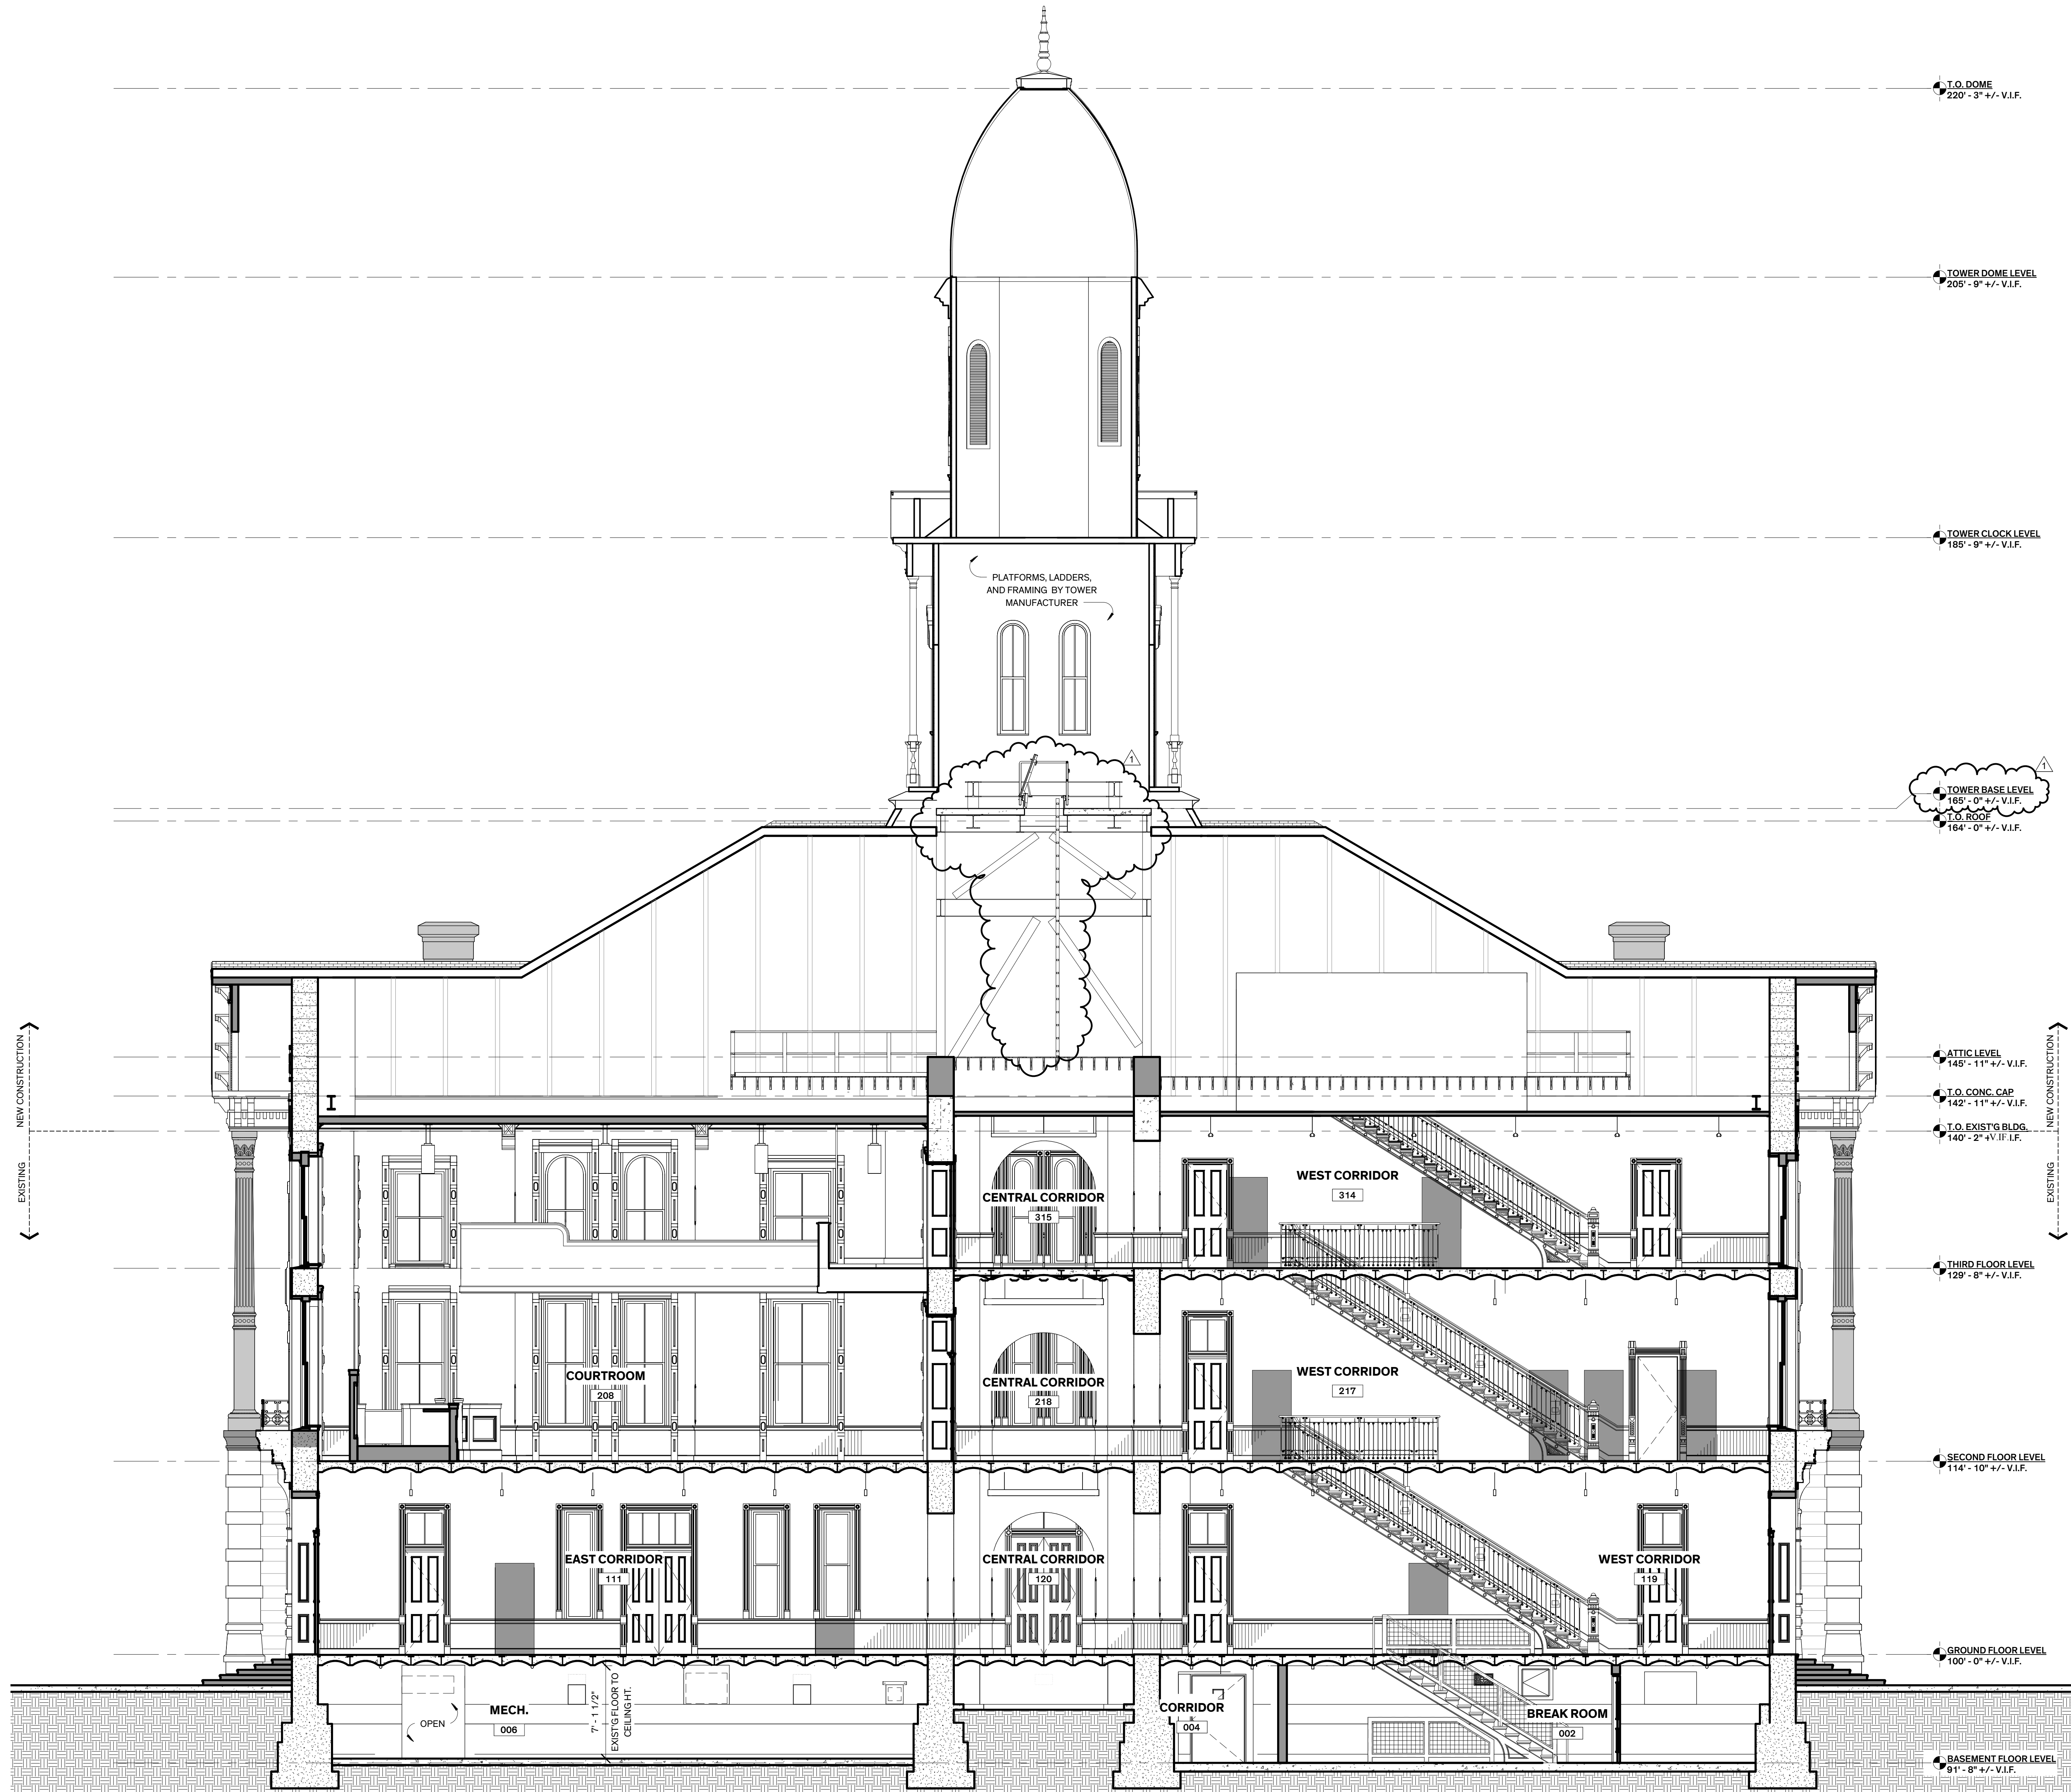

**FANNIN COUNTY COURTHOUSE**  
 INTERIOR & EXTERIOR RESTORATION

101 E. Sam Rayburn Drive  
 Bonham, Texas 75418

**COPYRIGHT**  
 The Contractor shall verify and be responsible for all dimensions. DO NOT scale the drawing. Any errors or omissions shall be reported to Architexas without delay. The Copyrights to all designs and drawings are the property of Architexas. Reproduction or use for any purpose other than that authorized by Architexas is forbidden.

**REVISION HISTORY**

1	Oct. 16, 2018	Addendum #1
---	---------------	-------------

ISSUED FOR CONSTRUCTION



#18326 9/21/2018


Architexas No. 1737 Date SEPT. 21, 2018

Sheet Name BUILDING SECTION

Sheet Number

**1 Building Section A**  
 3/16" = 1'-0"



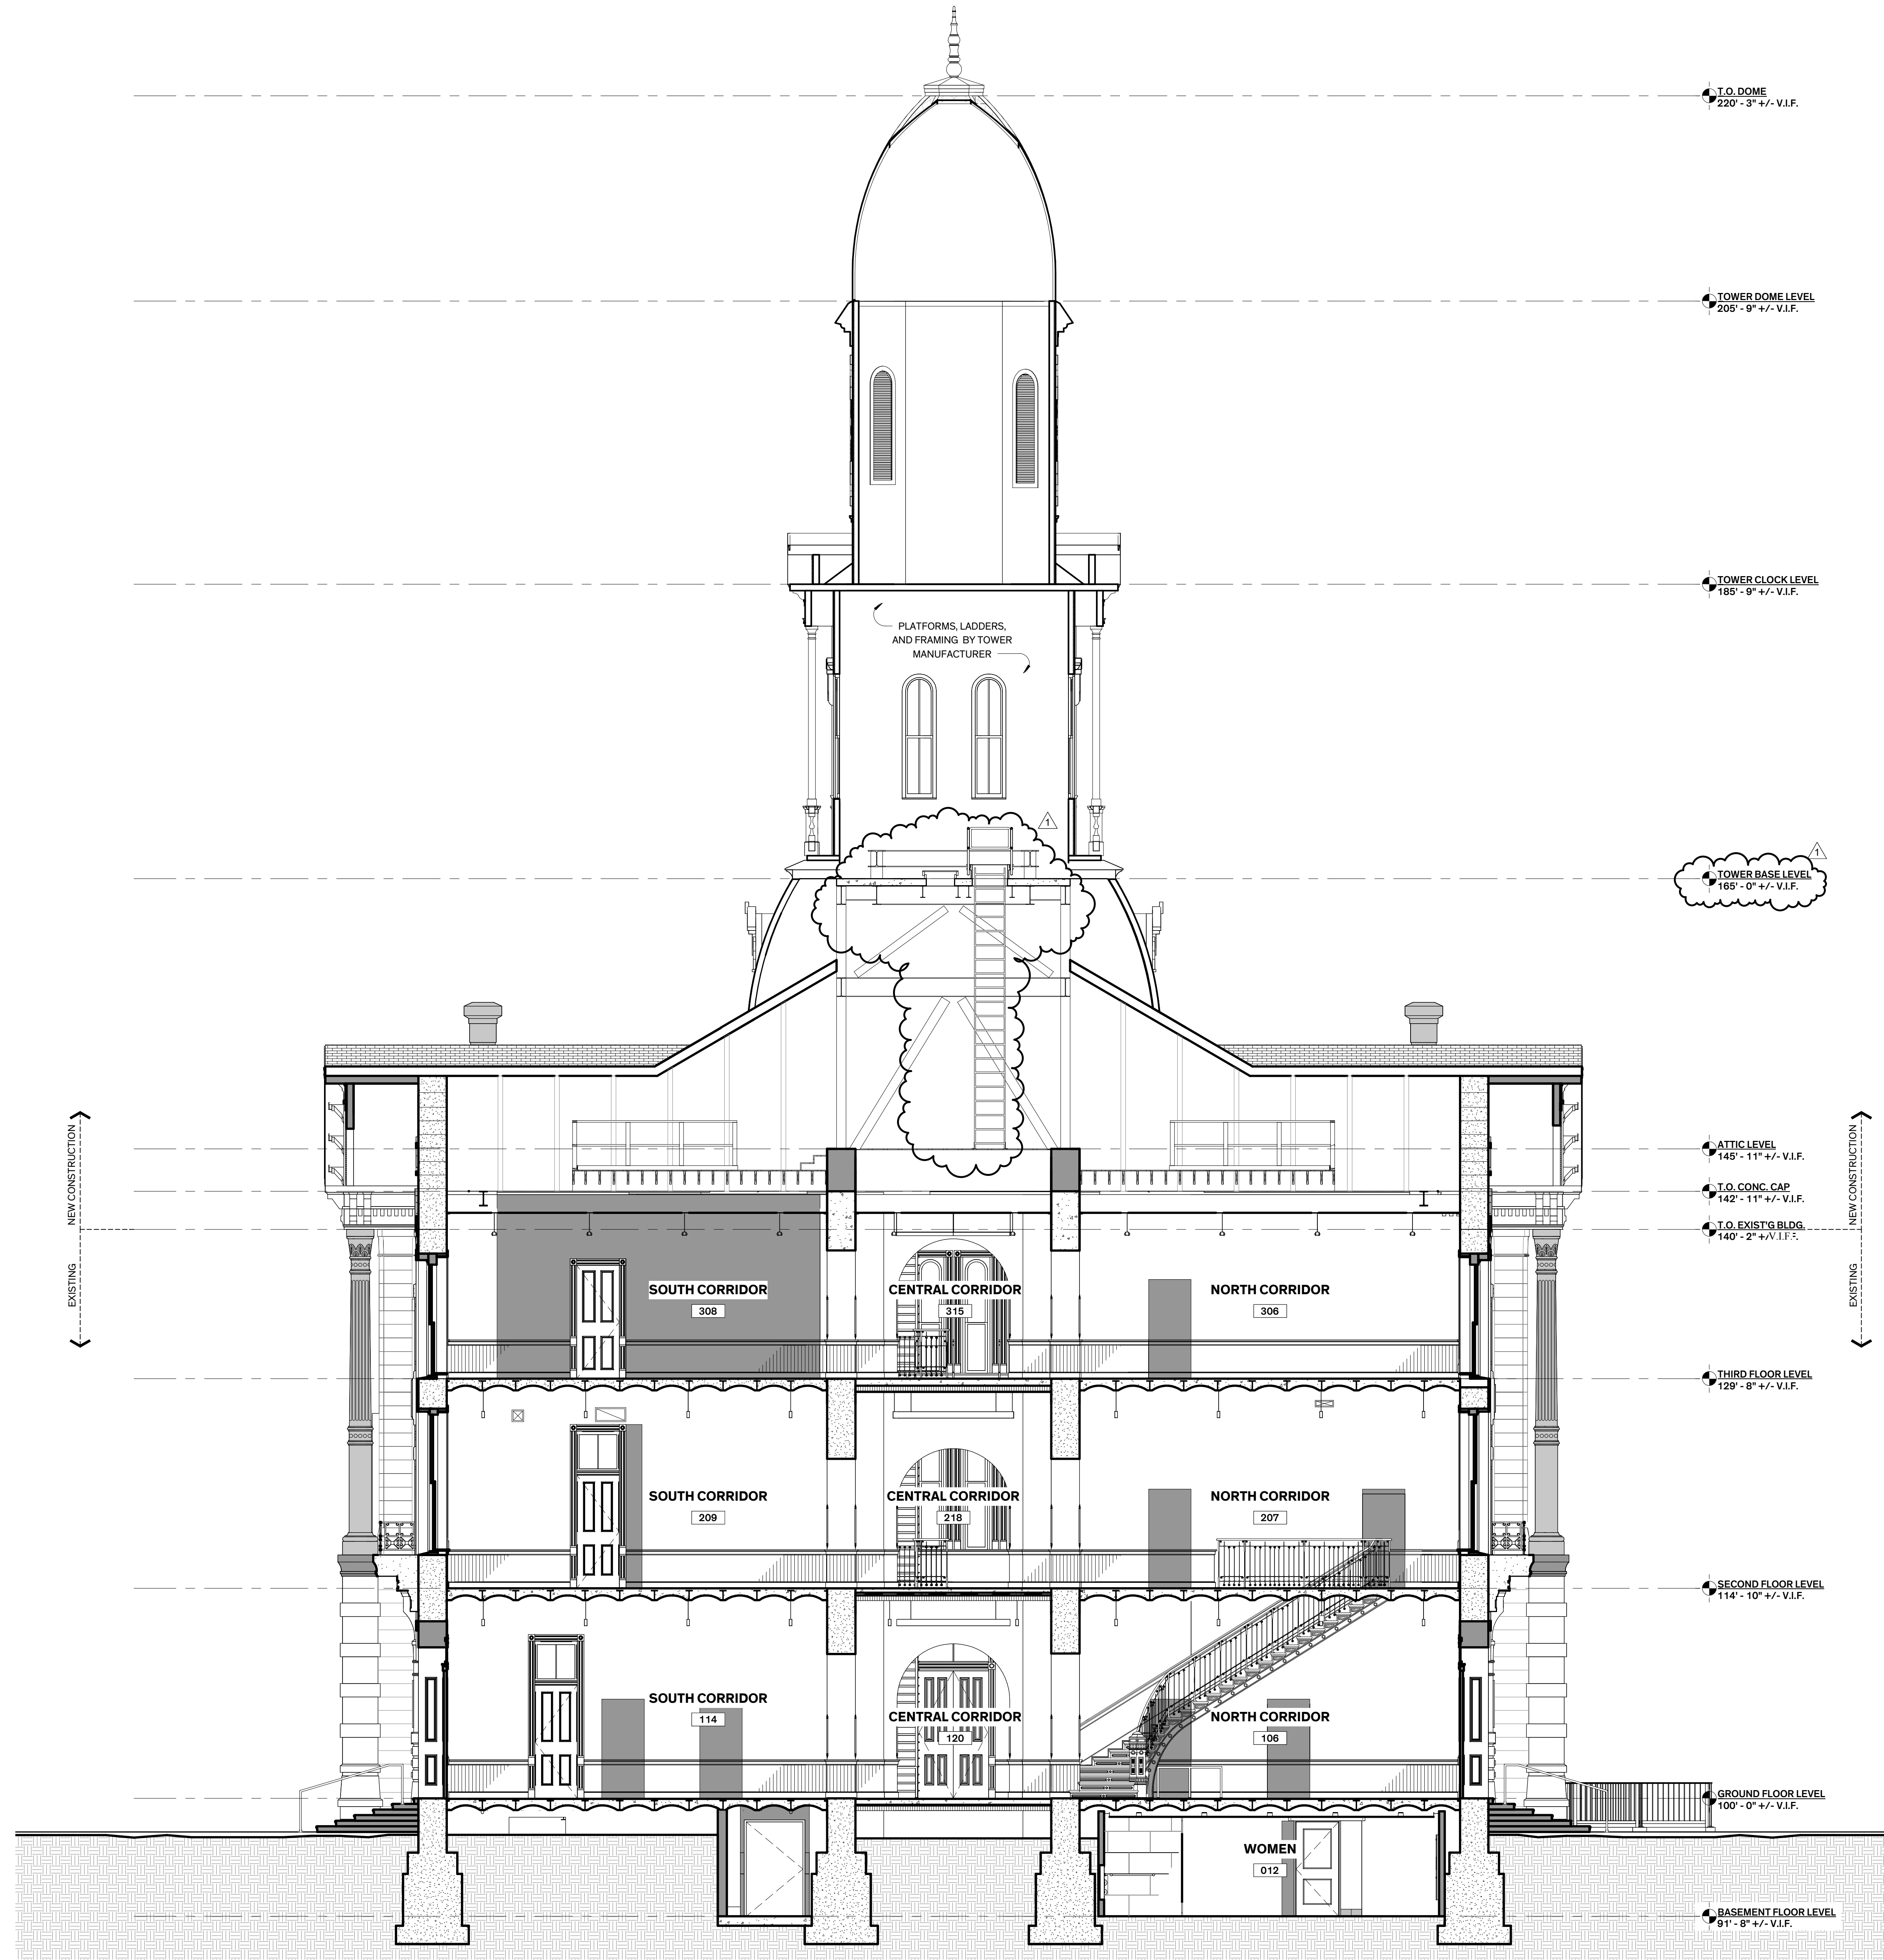

1 Building Section B  
 3/16" = 1'-0"



TEXAS HISTORICAL COMMISSION  
*real places telling real stories*



FANNIN COUNTY  
 COURTHOUSE  
 INTERIOR & EXTERIOR RESTORATION

101 E. Sam Rayburn Drive  
 Bonham, Texas 75418

**COPYRIGHT**  
 The Contractor shall verify and be responsible for all dimensions. DO NOT scale the drawing. Any errors or omissions shall be reported to Architexas without delay. The Copyrights to all designs and drawings are the property of Architexas. Reproduction or use for any purpose other than that authorized by Architexas is forbidden.

**REVISION HISTORY**  
 1 Oct. 16, 2018 Addendum #1

ISSUED FOR CONSTRUCTION




#18326 9/21/2018


Architexas No. 1737 Date SEPT. 21, 2018

Sheet Name BUILDING SECTION


Sheet Number A3.02

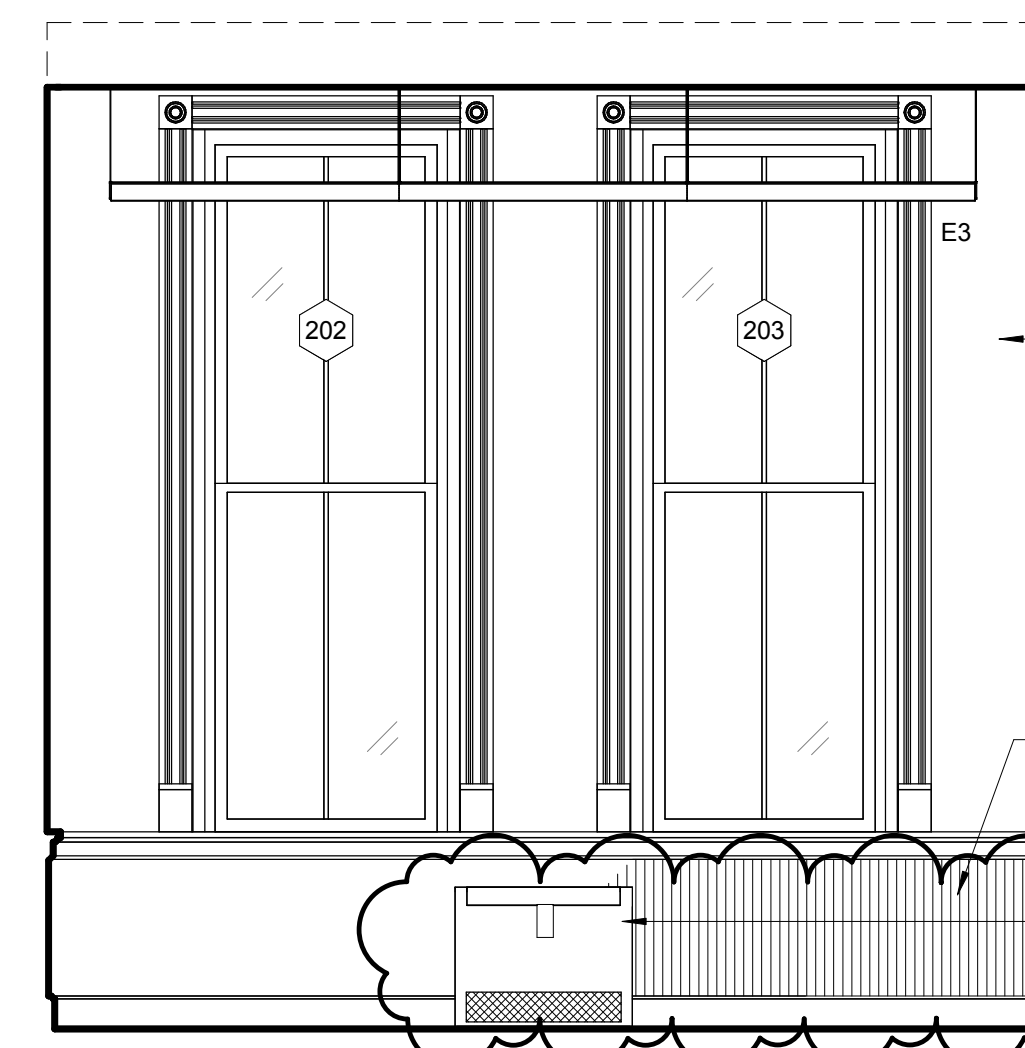


12 202 Conf. / Jury Rm. - North  
 3/8" = 1'-0"

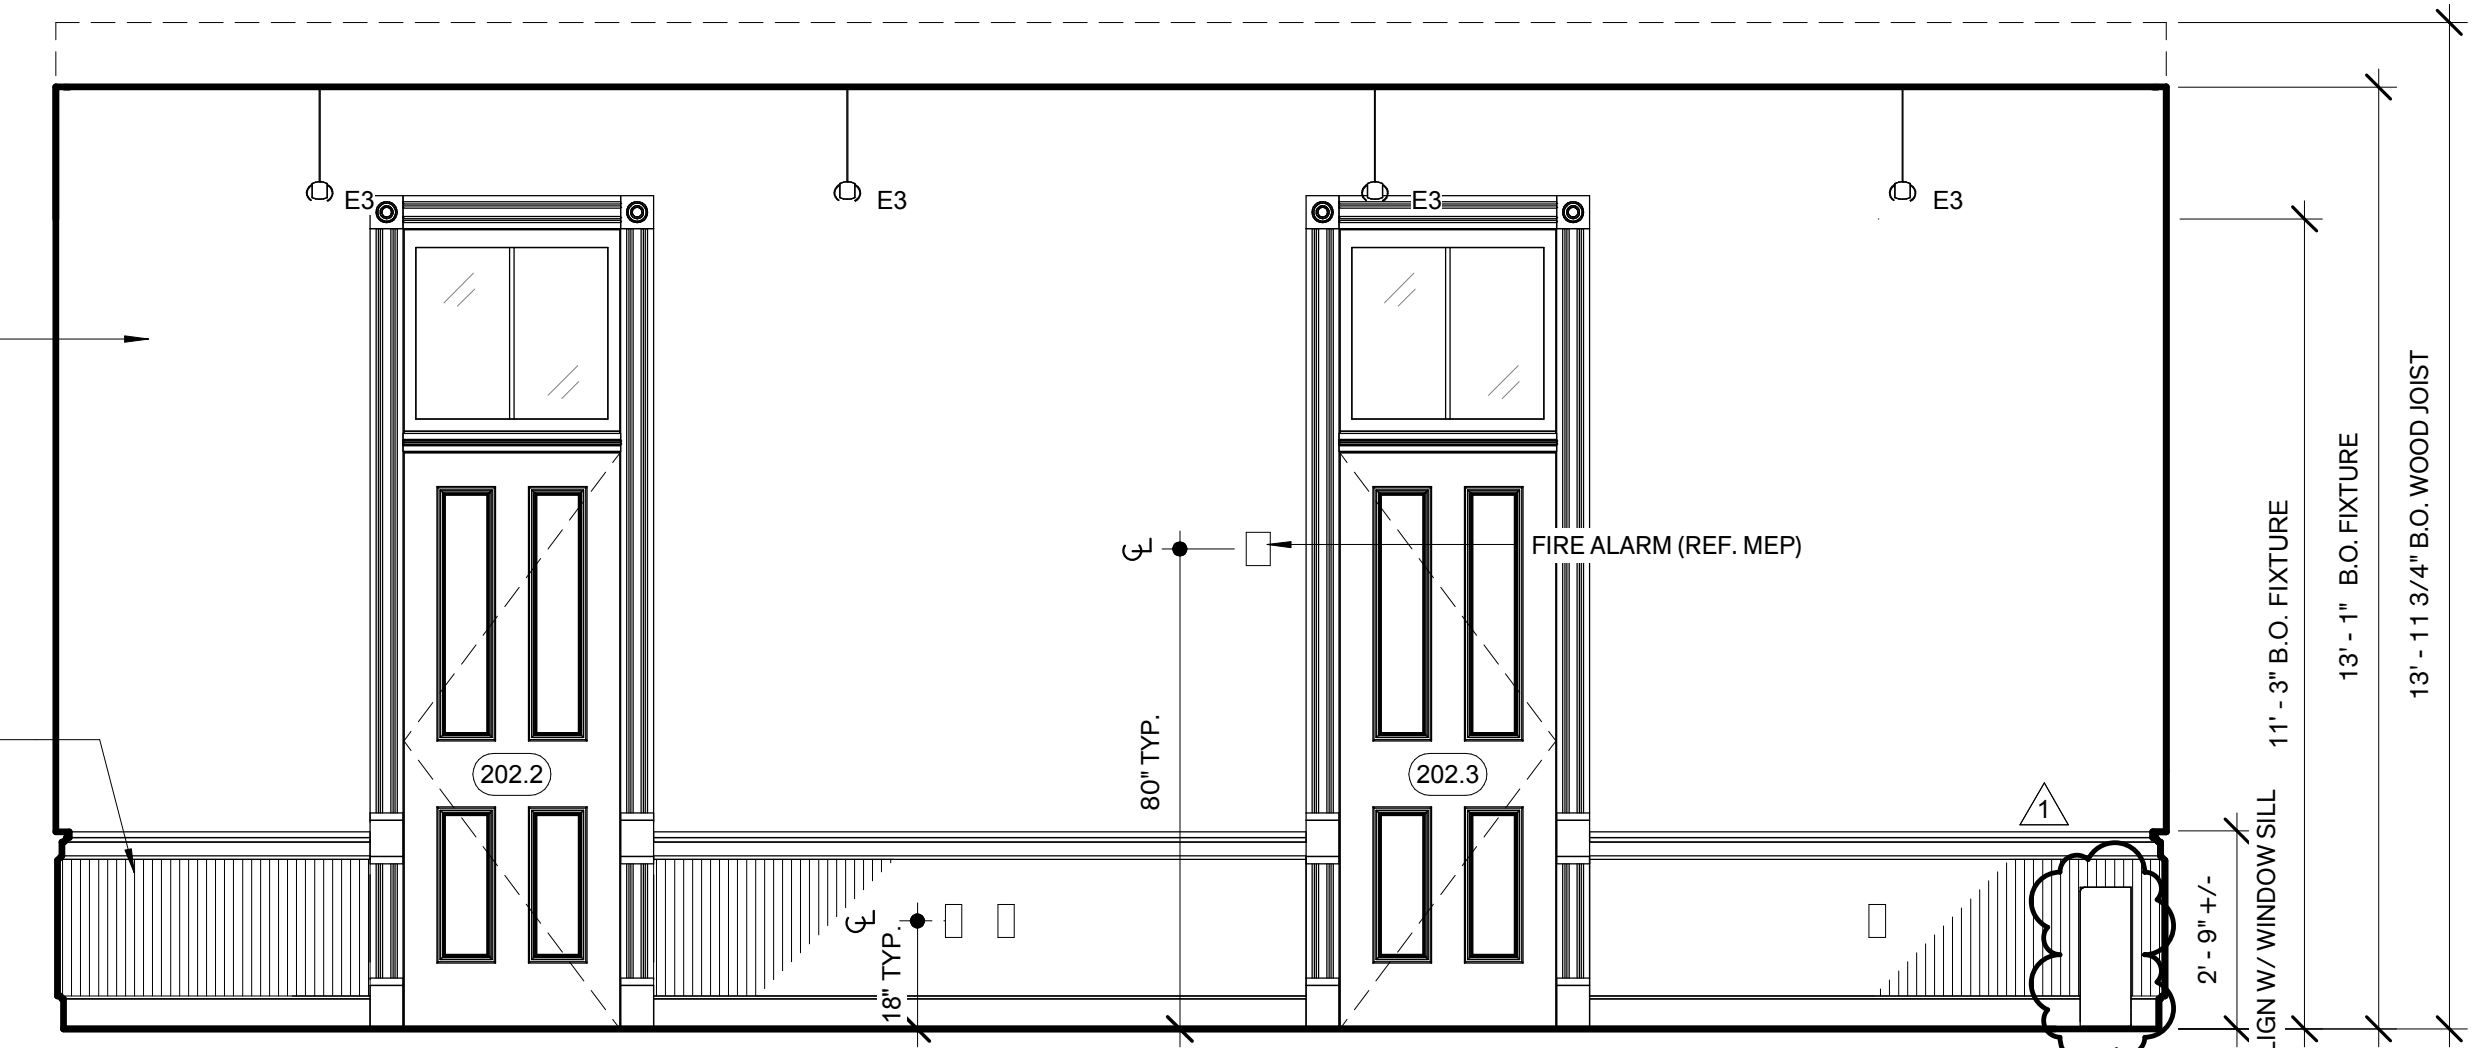


11 202 Conf. / Jury Rm. - West  
 3/8" = 1'-0"

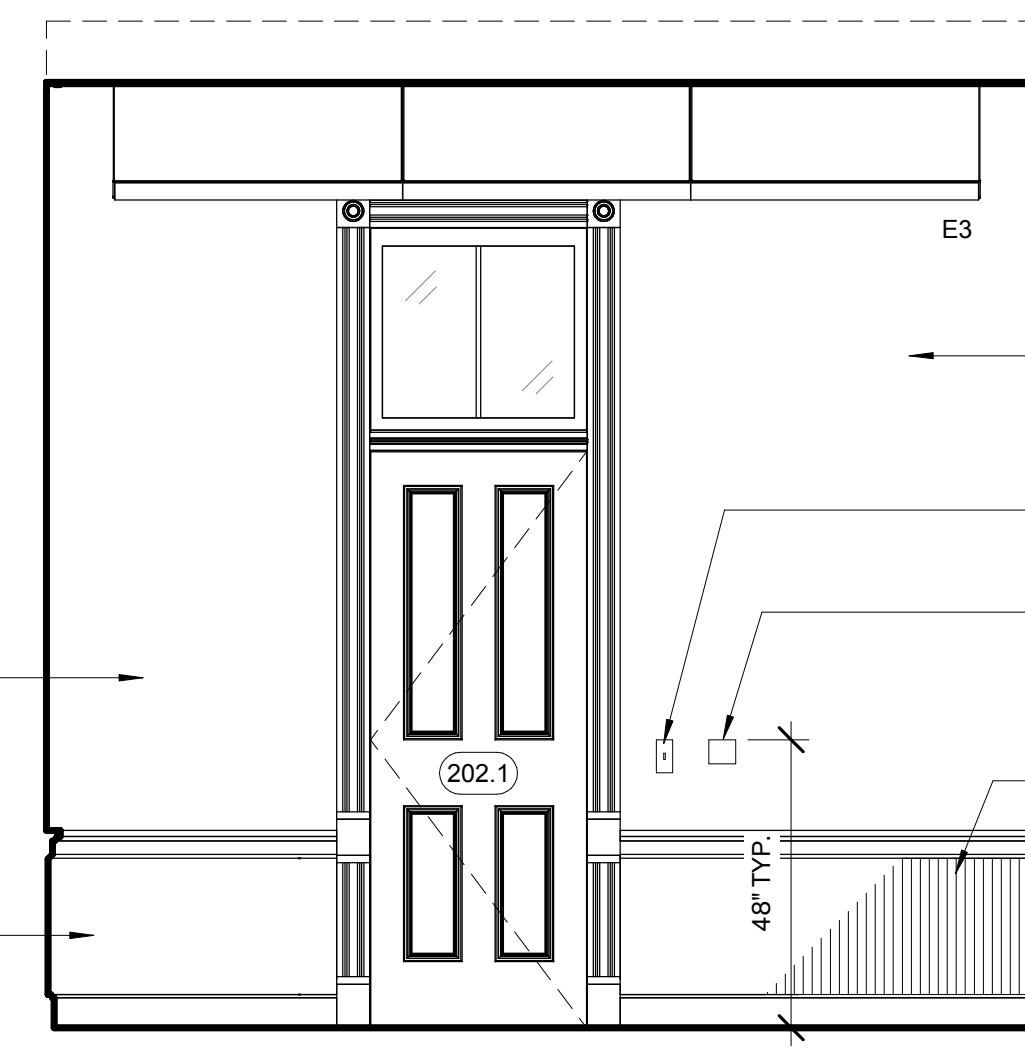


10 202 Conf. / Jury Rm. - South  
 3/8" = 1'-0"

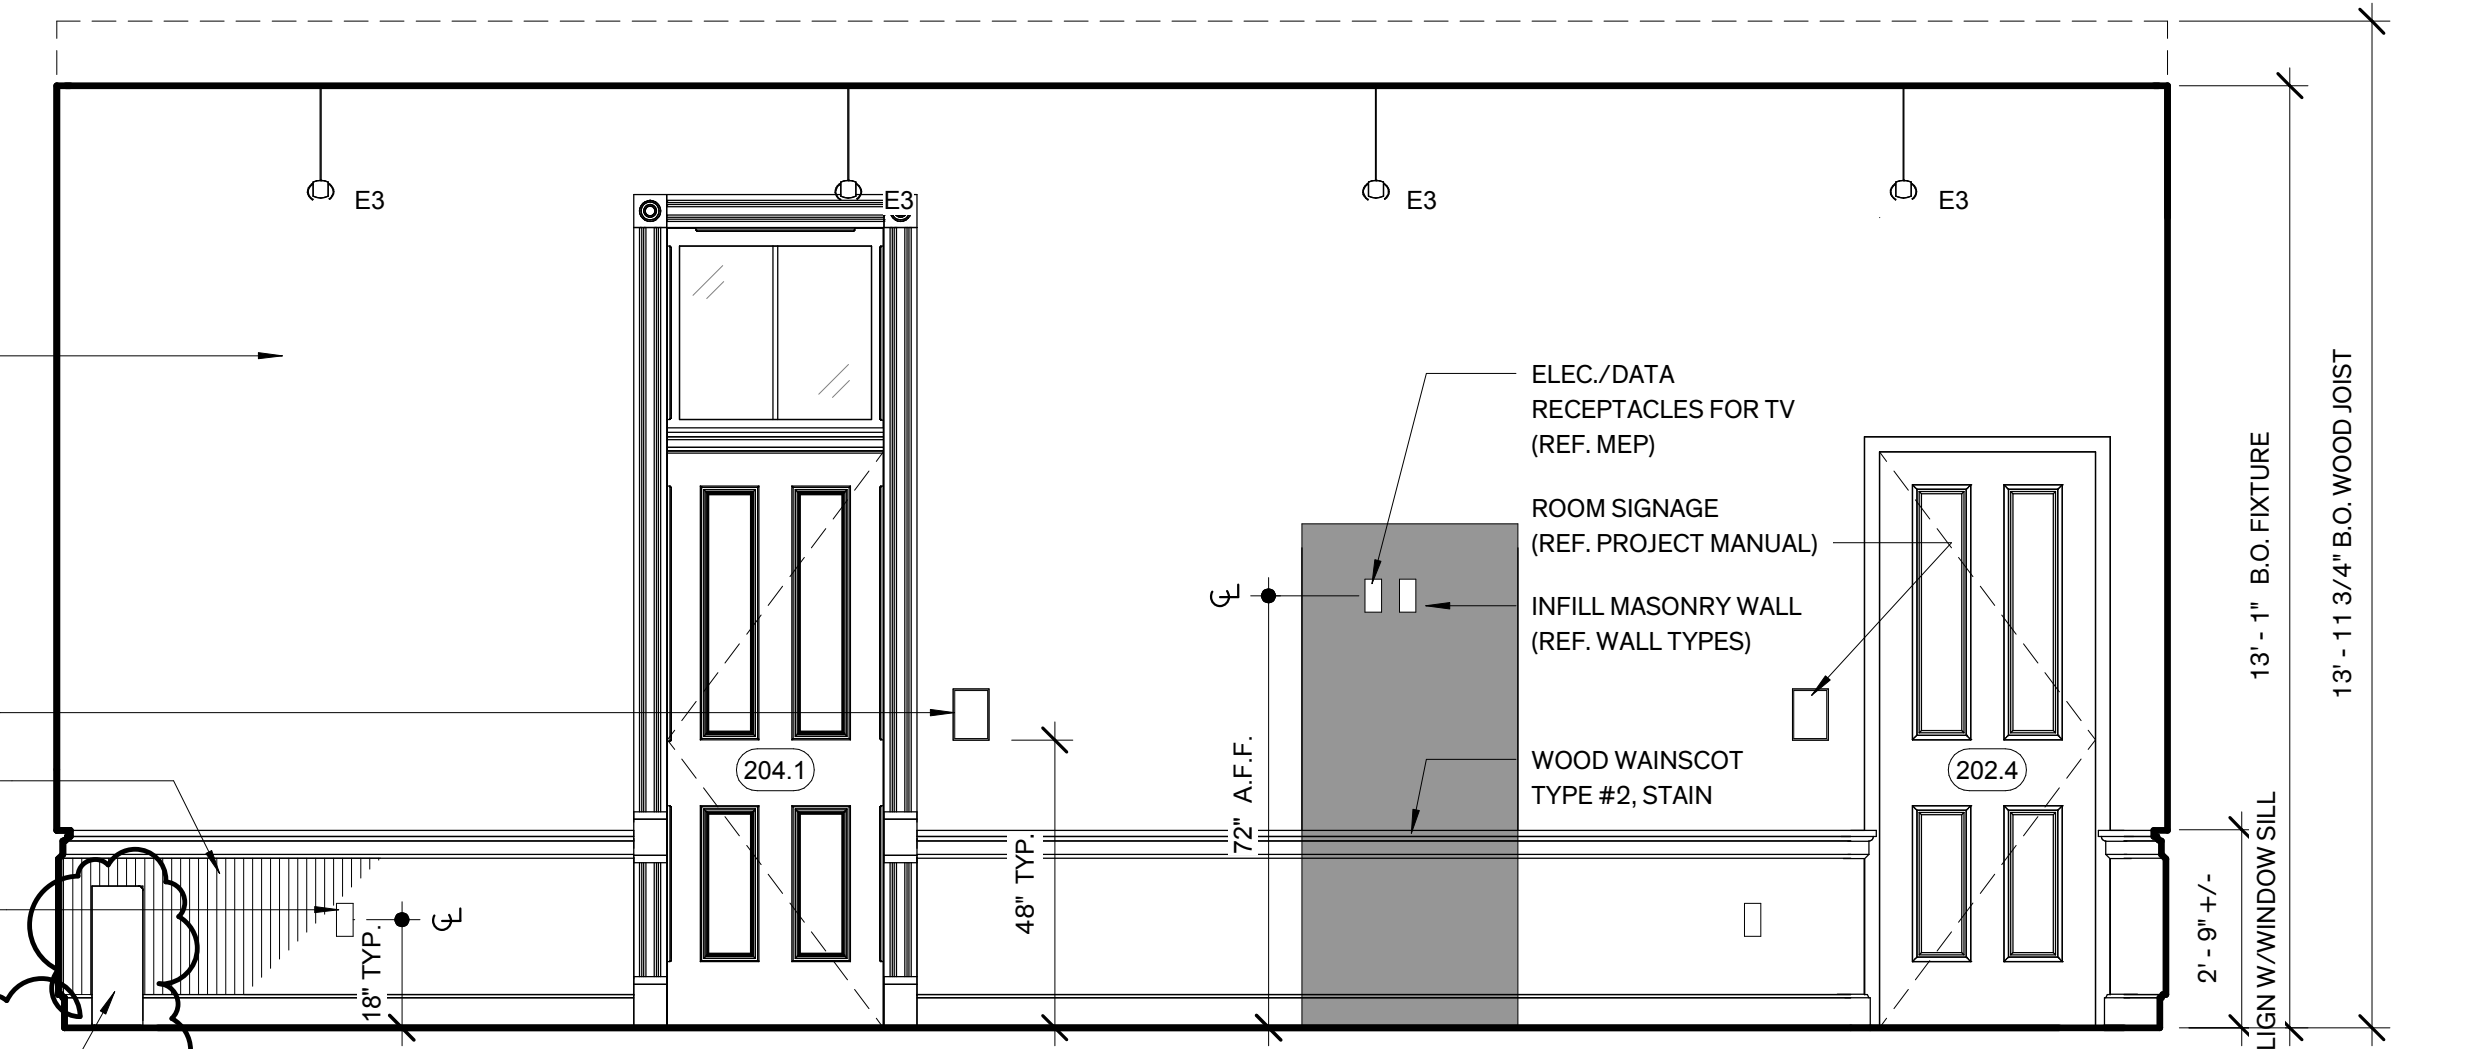


9 202 Conf. / Jury Rm. - East  
 3/8" = 1'-0"

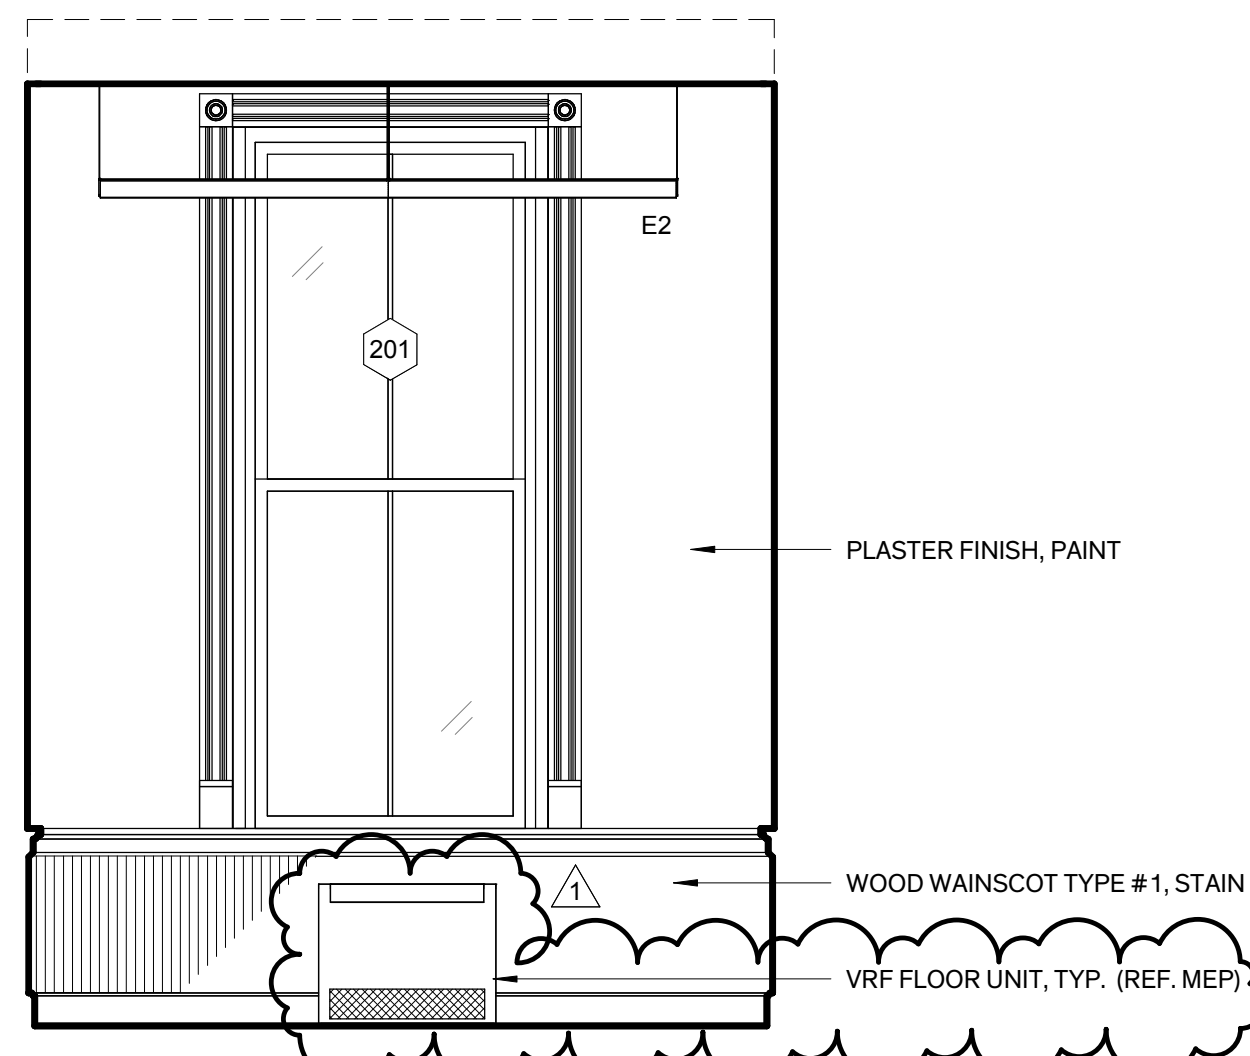


8 201 Court Reporter - North  
 3/8" = 1'-0"

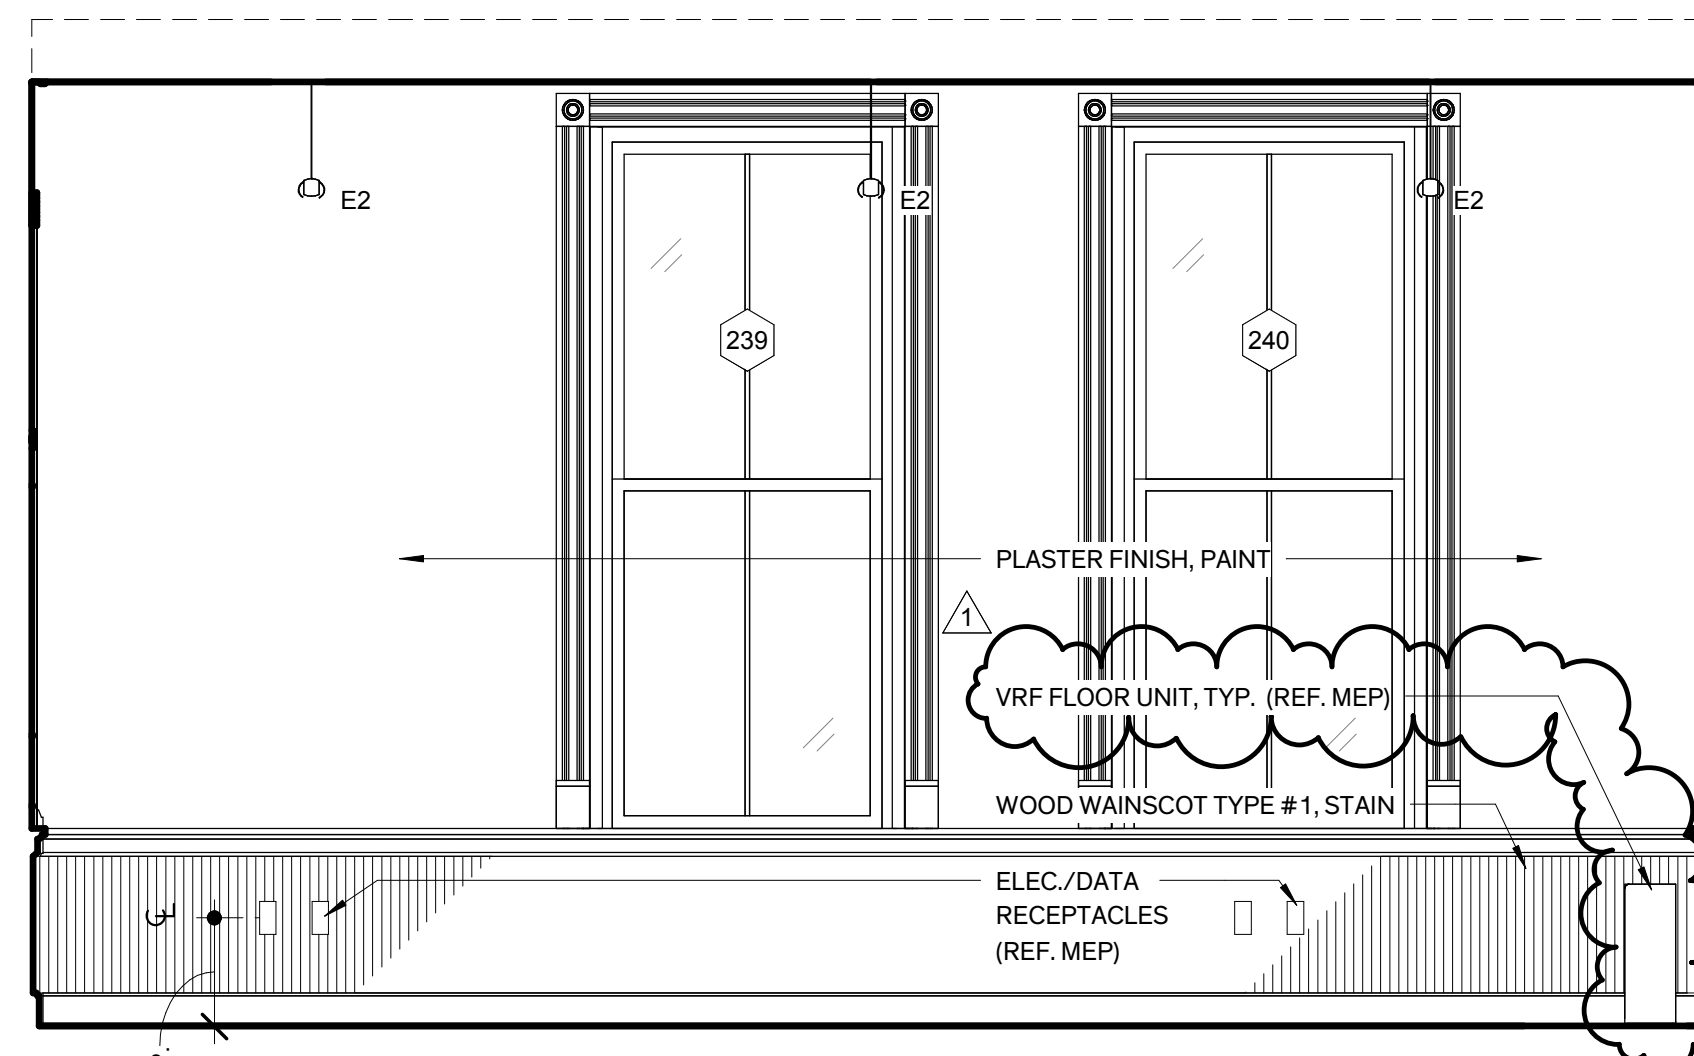


7 201 Court Reporter - West  
 3/8" = 1'-0"

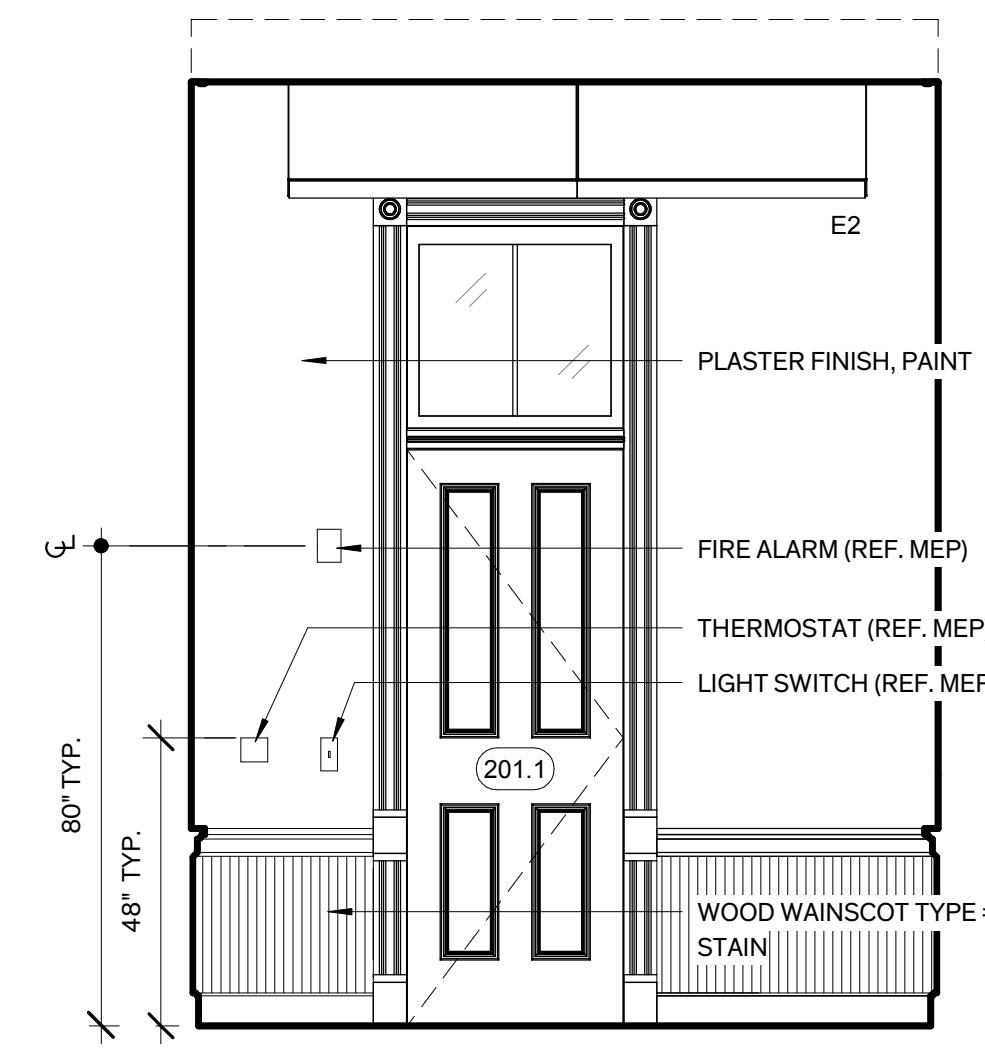


6 201 Court Reporter - South  
 3/8" = 1'-0"

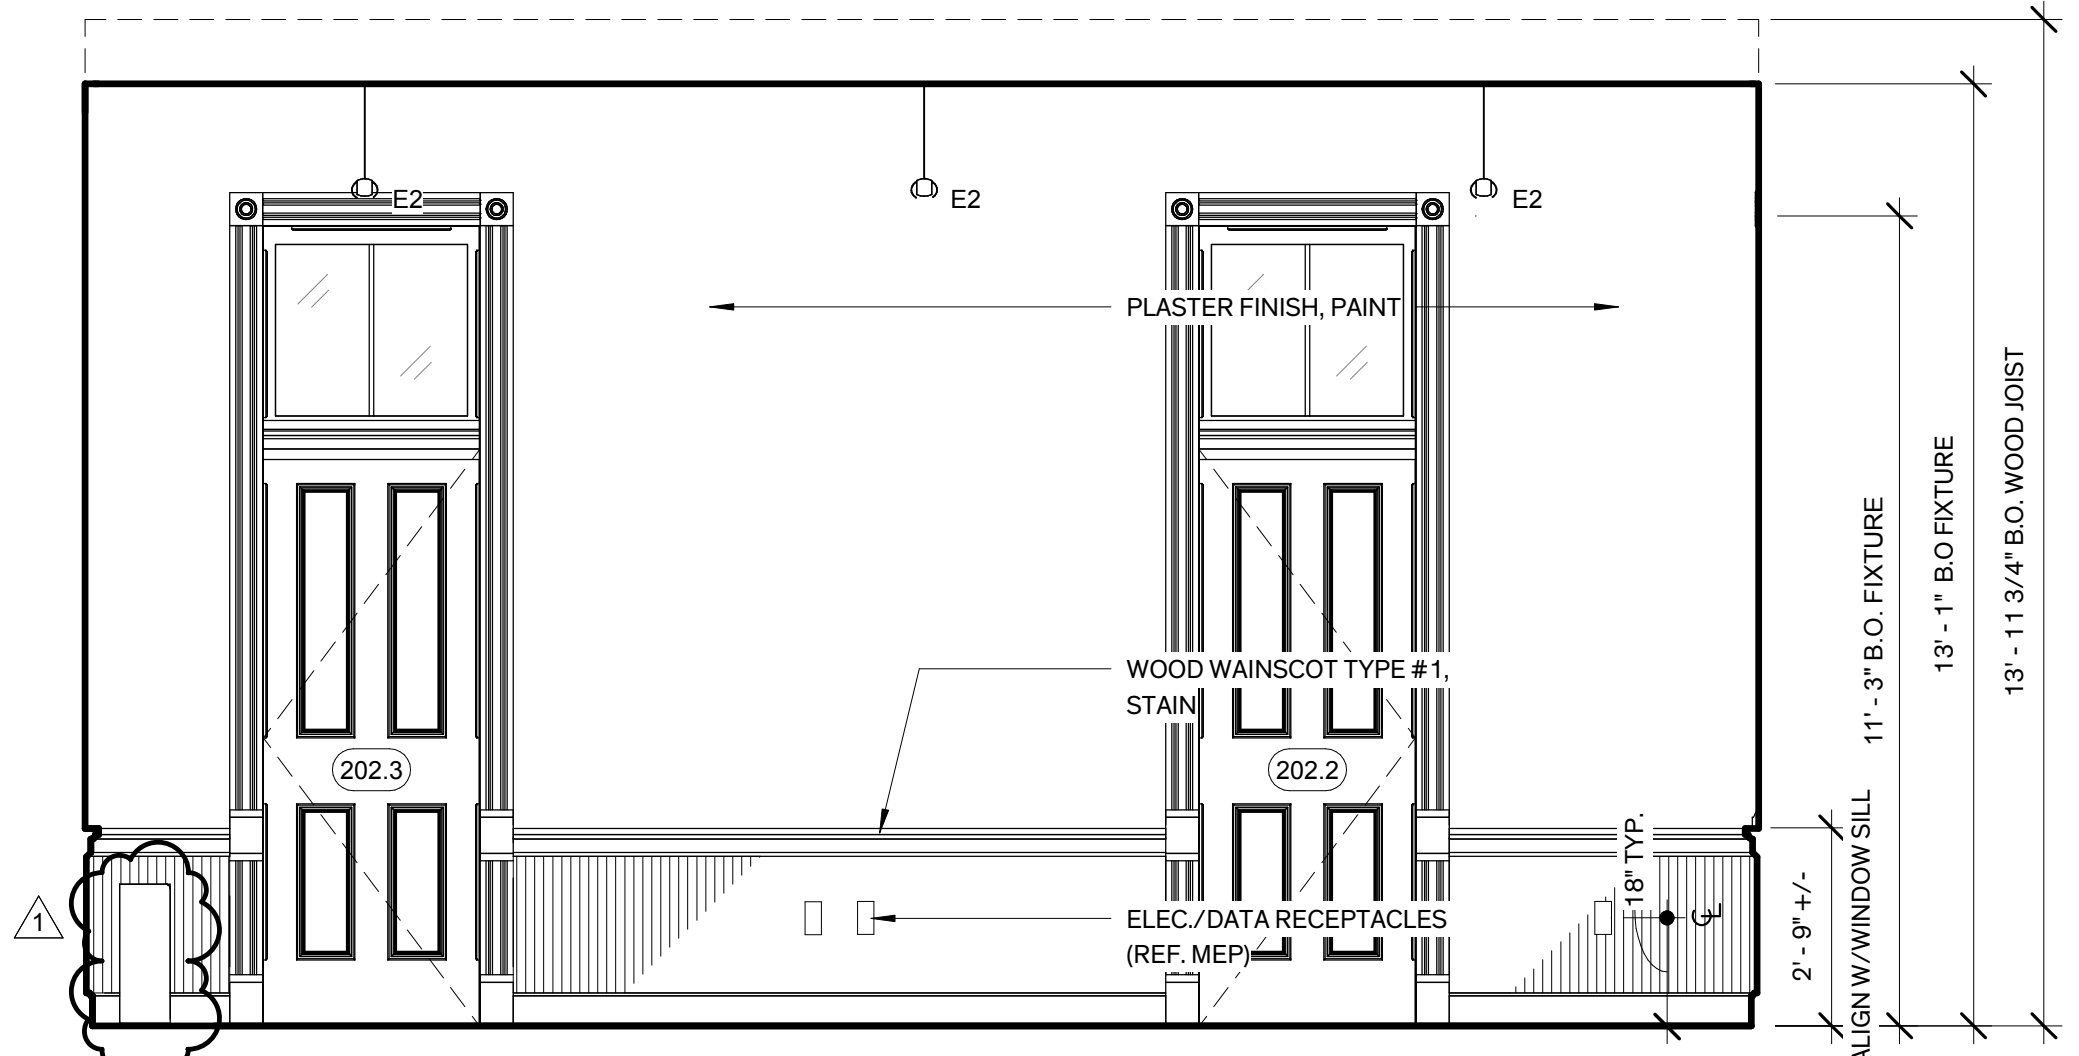


5 201 Court Reporter - East  
 3/8" = 1'-0"

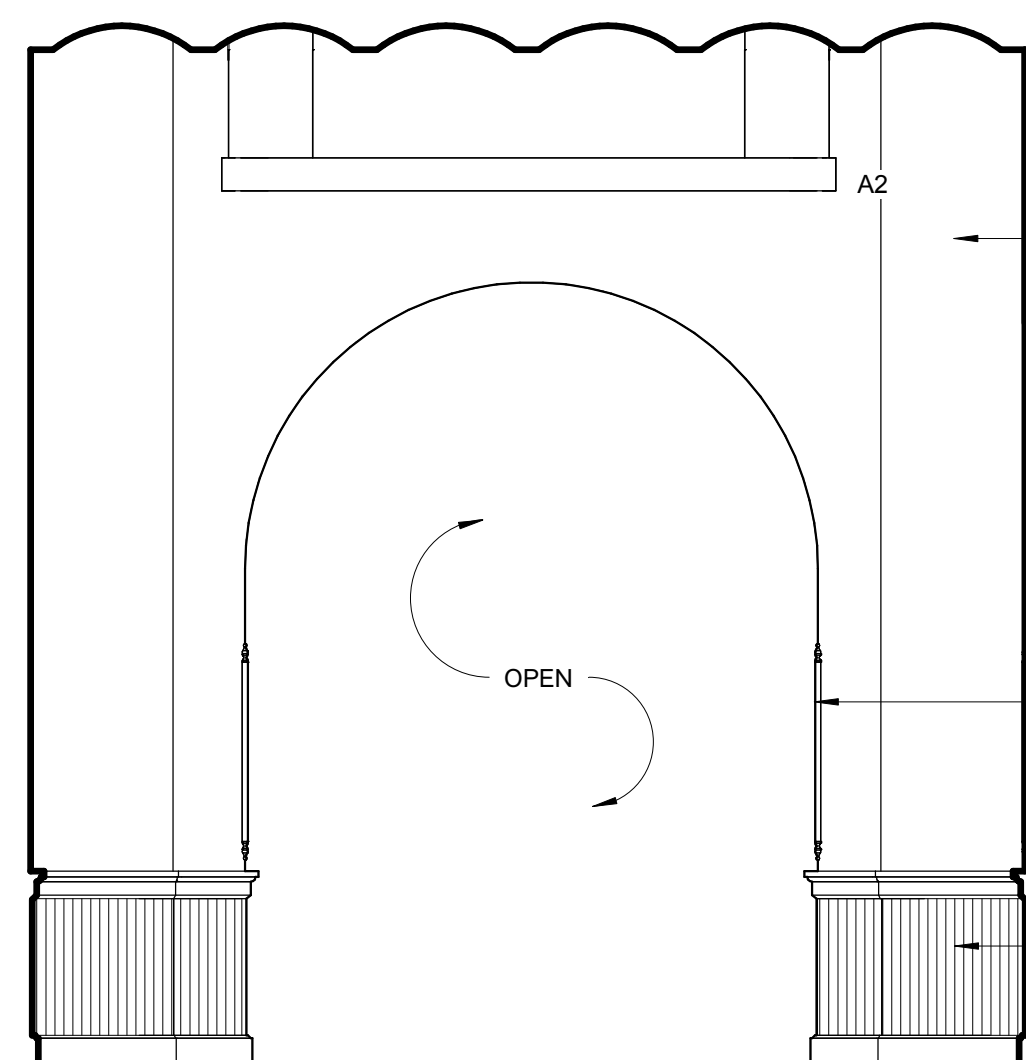


4 120 Central Corridor - North  
 3/8" = 1'-0"

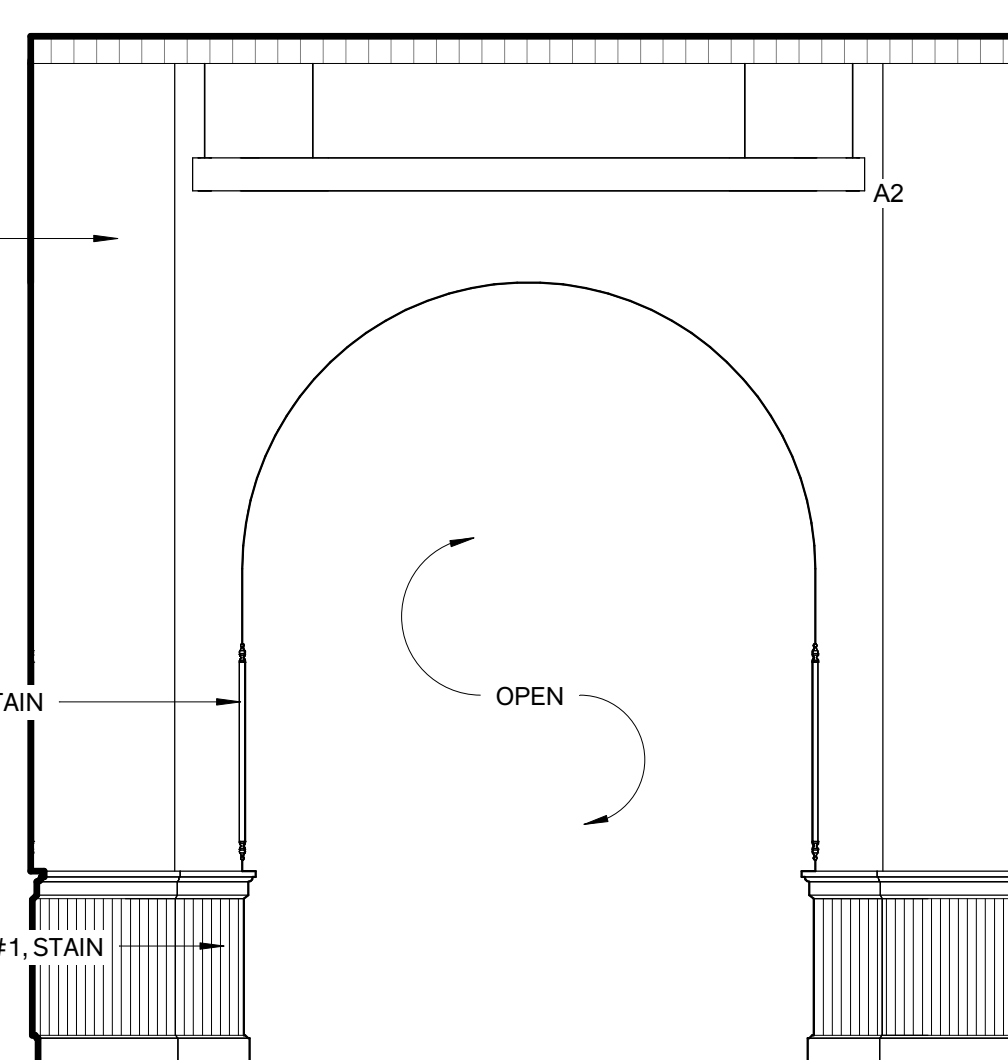

3 120 Central Corridor - West  
 3/8" = 1'-0"

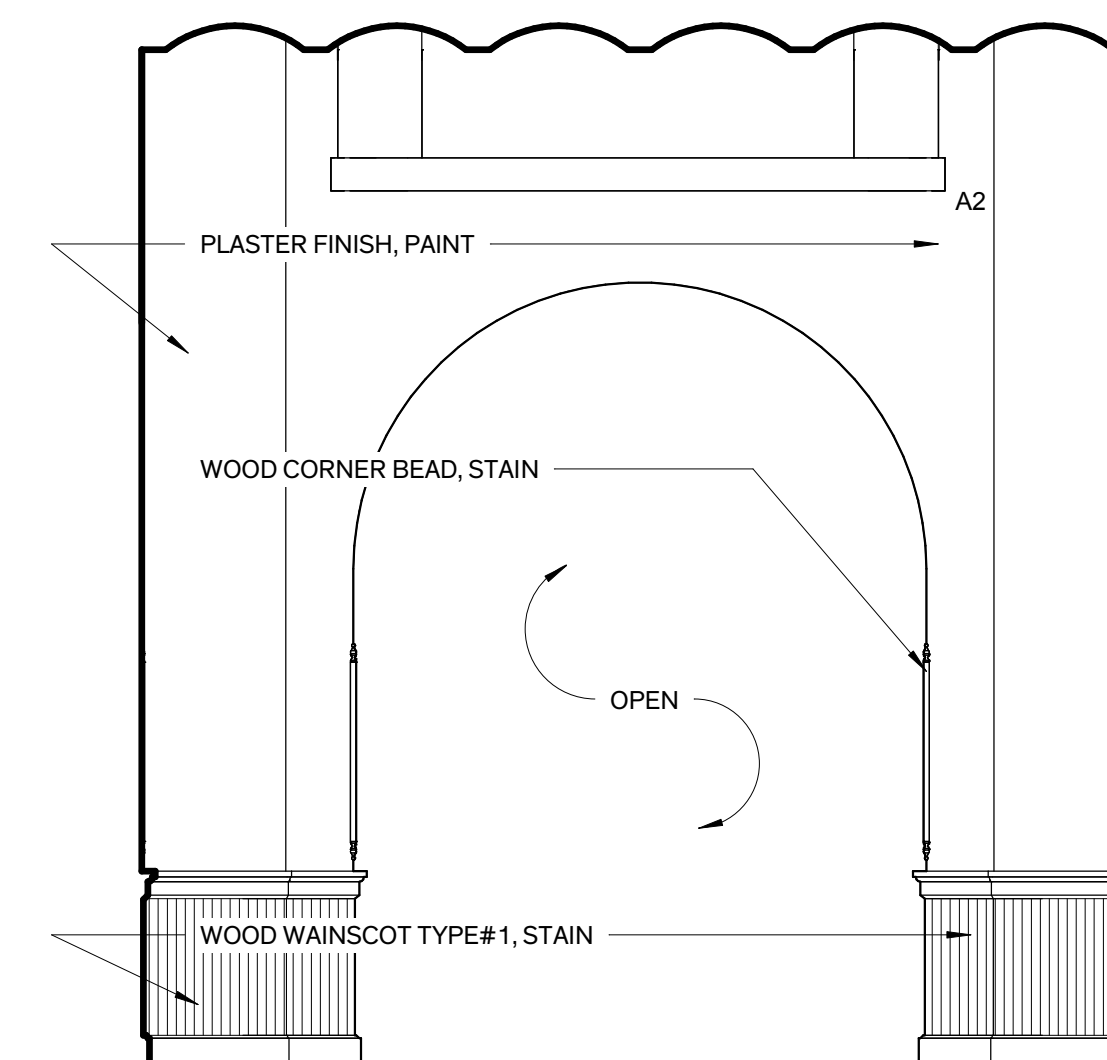

2 120 Central Corridor - South  
 3/8" = 1'-0"

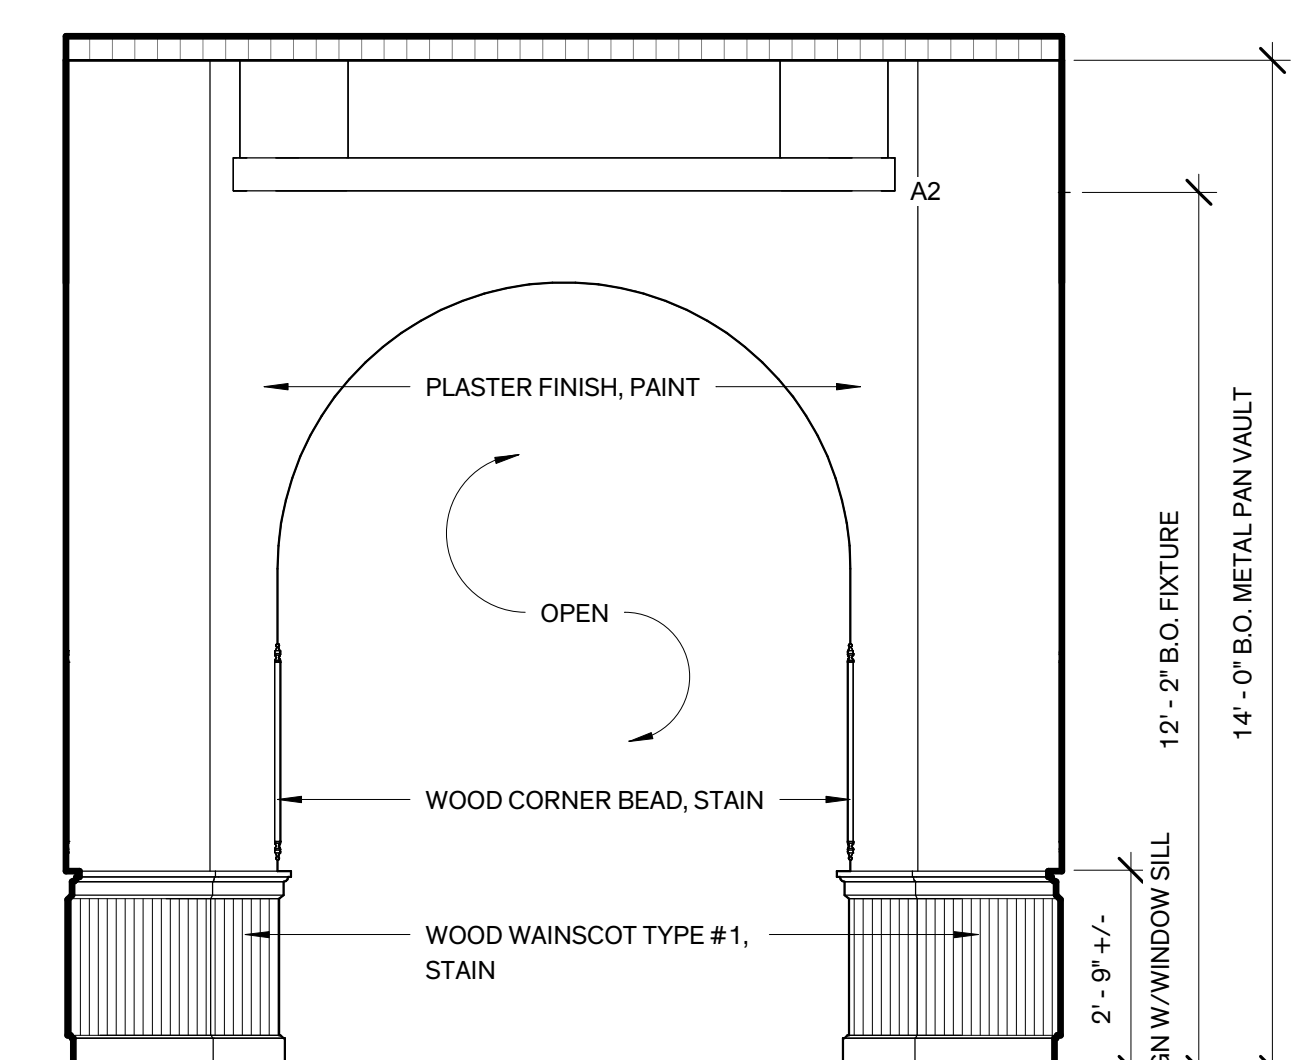

1 120 Central Corridor - East  
 3/8" = 1'-0"



TEXAS HISTORICAL COMMISSION  
 real places telling real stories



FANNIN COUNTY  
 COURTHOUSE  
 INTERIOR & EXTERIOR RESTORATION

101 E. Sam Rayburn Drive  
 Bonham, Texas 75418

**COPYRIGHT**  
 The Contractor shall verify and be responsible for all dimensions. DO NOT scale the drawing. Any errors or omissions shall be reported to Architexas without delay. The Copyrights to all designs and drawings are the property of Architexas. Reproduction or use for any purpose other than that authorized by Architexas is forbidden.

**REVISION HISTORY**  
 1 Oct. 16, 2018 Addendum #1


ISSUED FOR CONSTRUCTION




#18326 9/21/2018

Architexas No. 1737 Date SEPT. 21, 2018


Sheet Name  
 INTERIOR ELEVATIONS -  
 GROUND LEVEL AND SECOND  
 LEVEL  
 Sheet Number

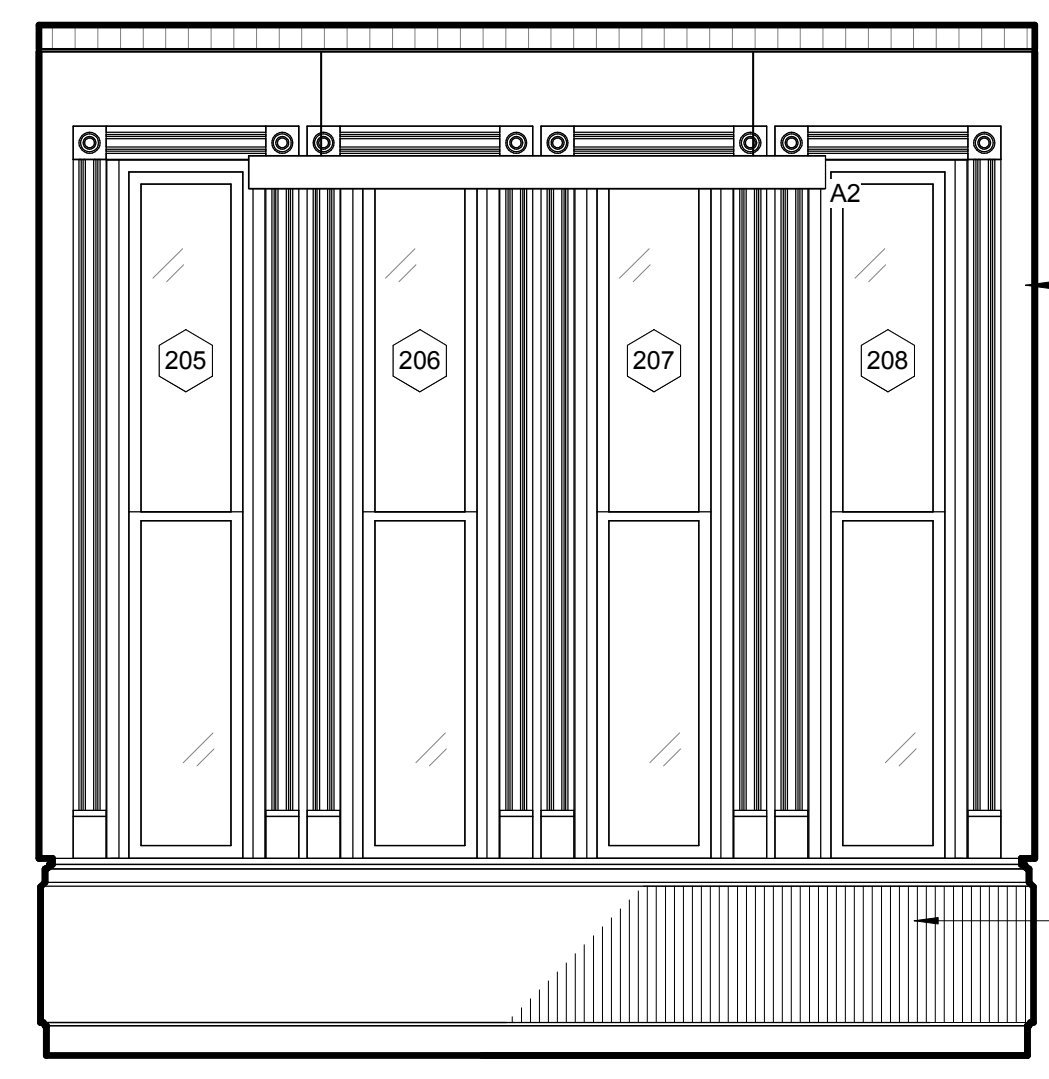


16 207 North Corridor - North  
 3/8" = 1'-0"

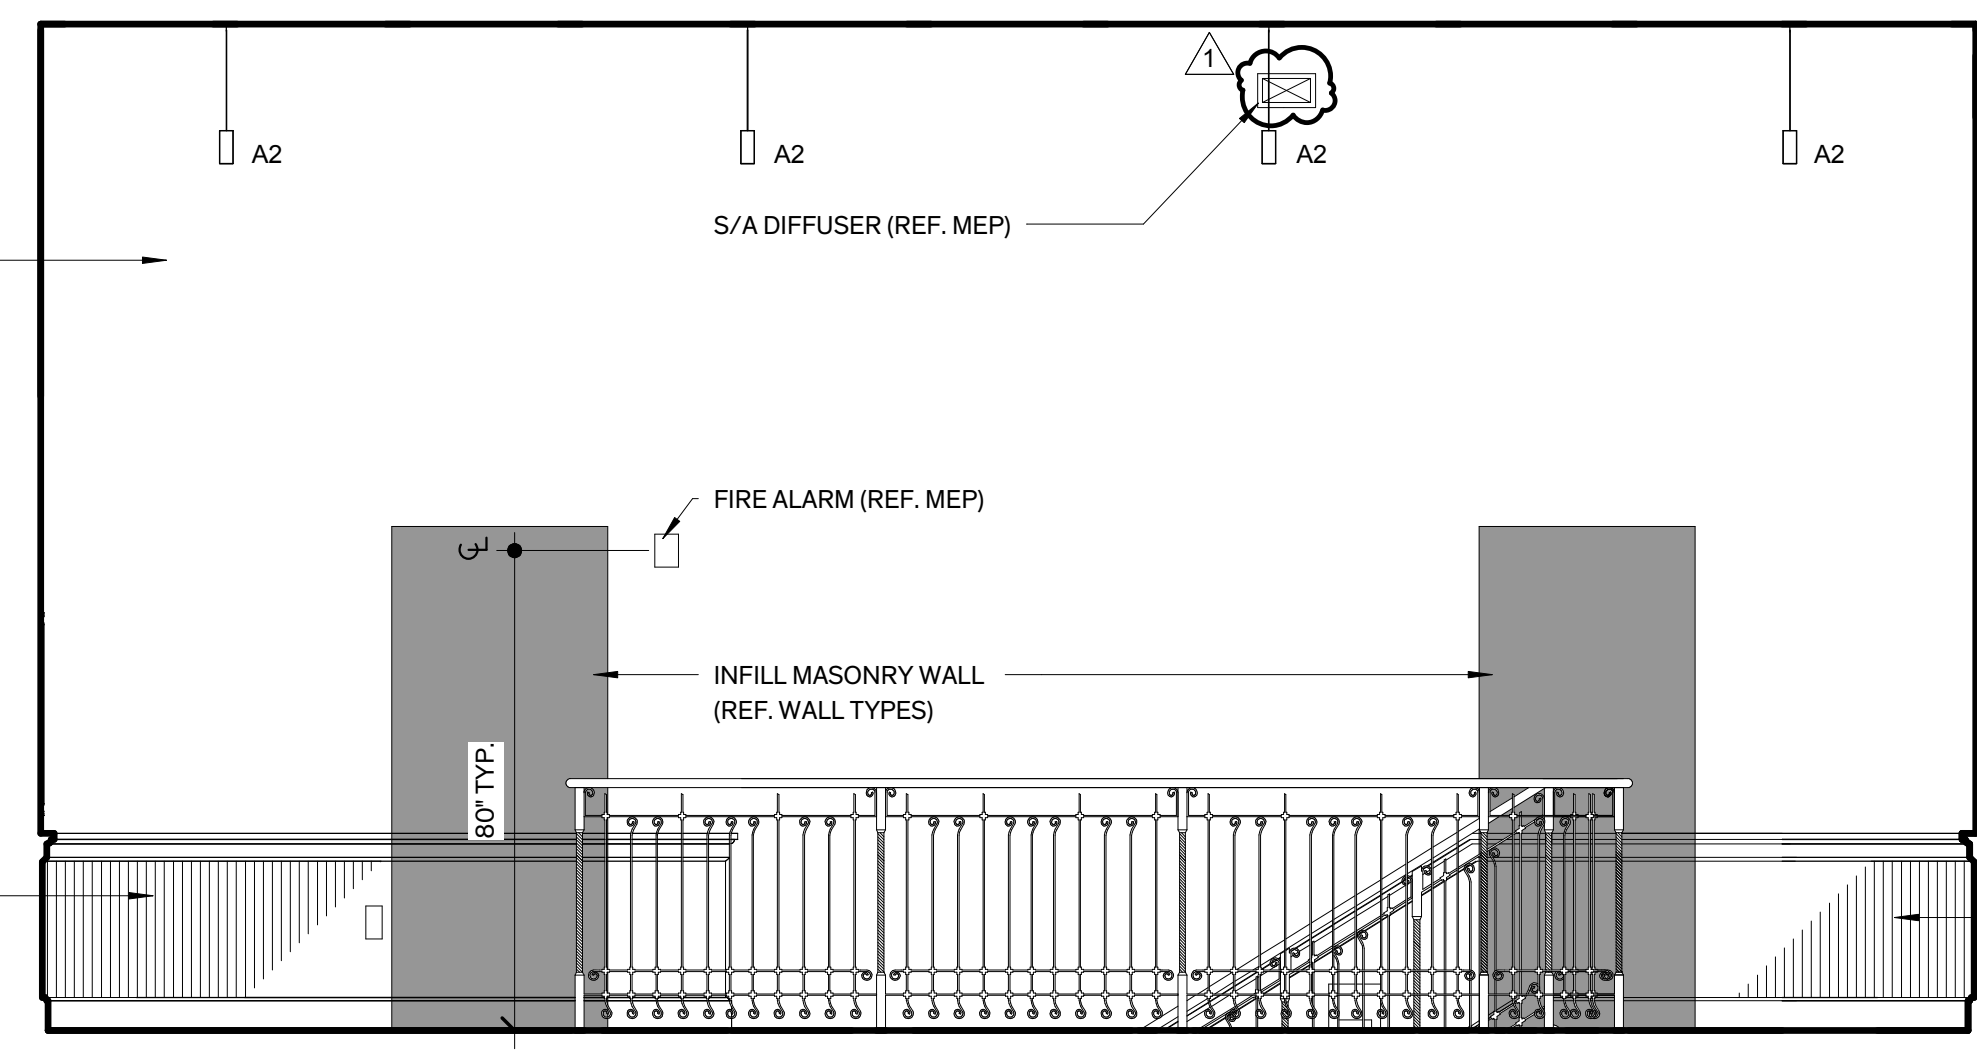


15 207 North Corridor - West  
 3/8" = 1'-0"

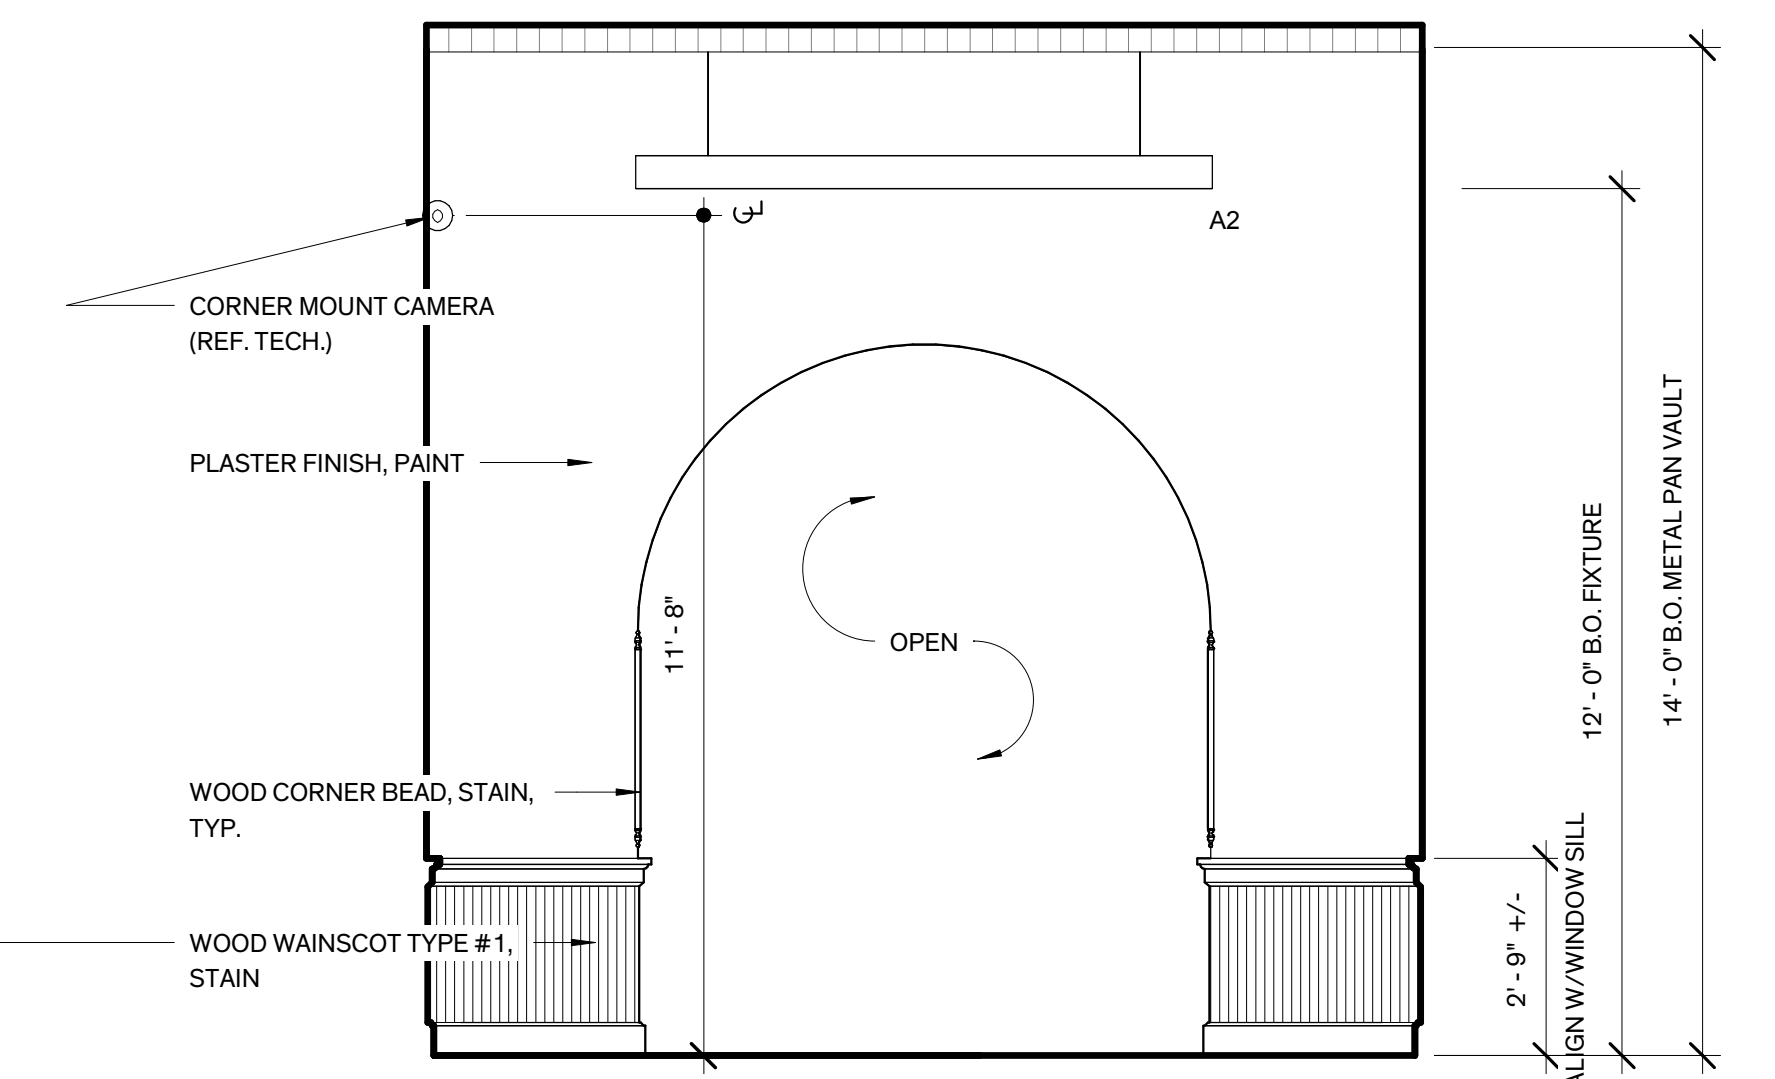


14 207 North Corridor - South  
 3/8" = 1'-0"

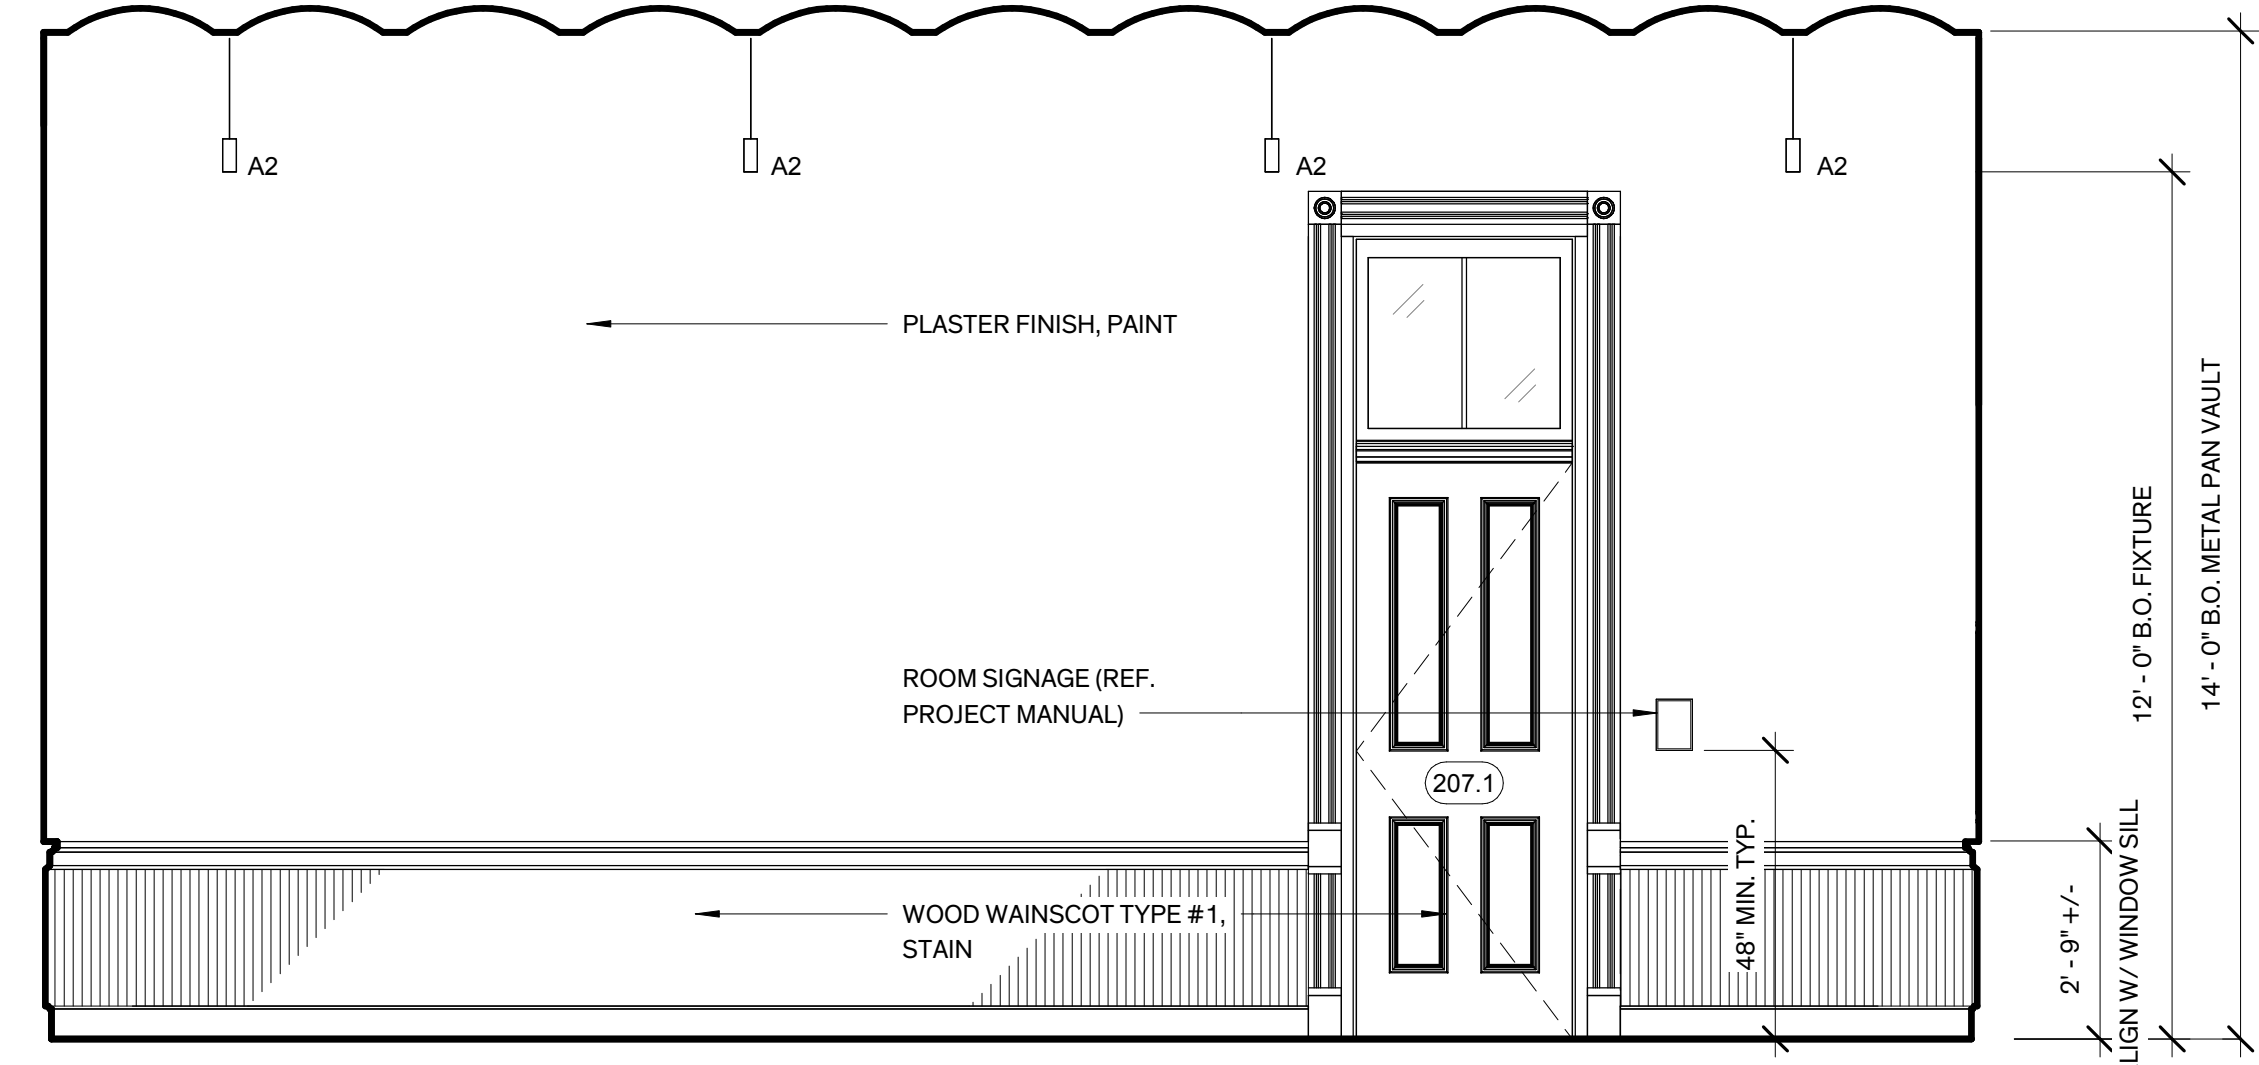


13 207 North Corridor - East  
 3/8" = 1'-0"

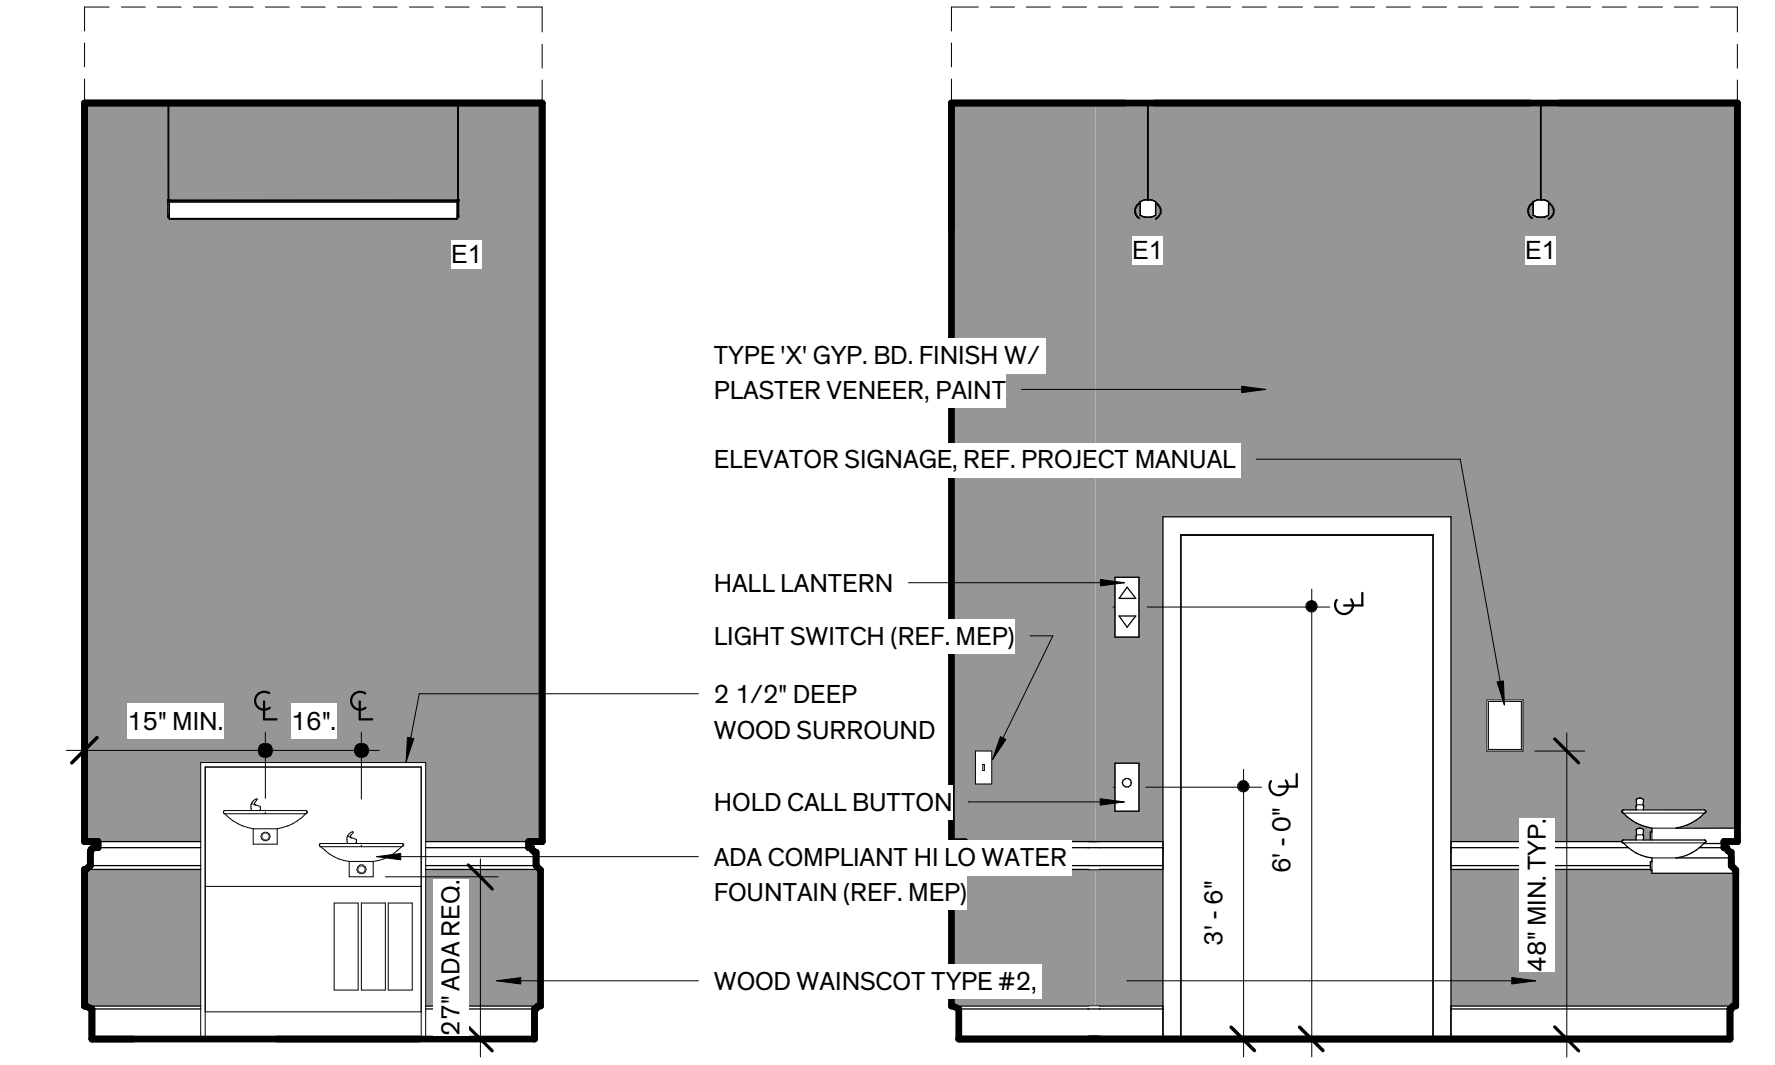


12 206 Elev. Vestibule - North  
 3/8" = 1'-0"

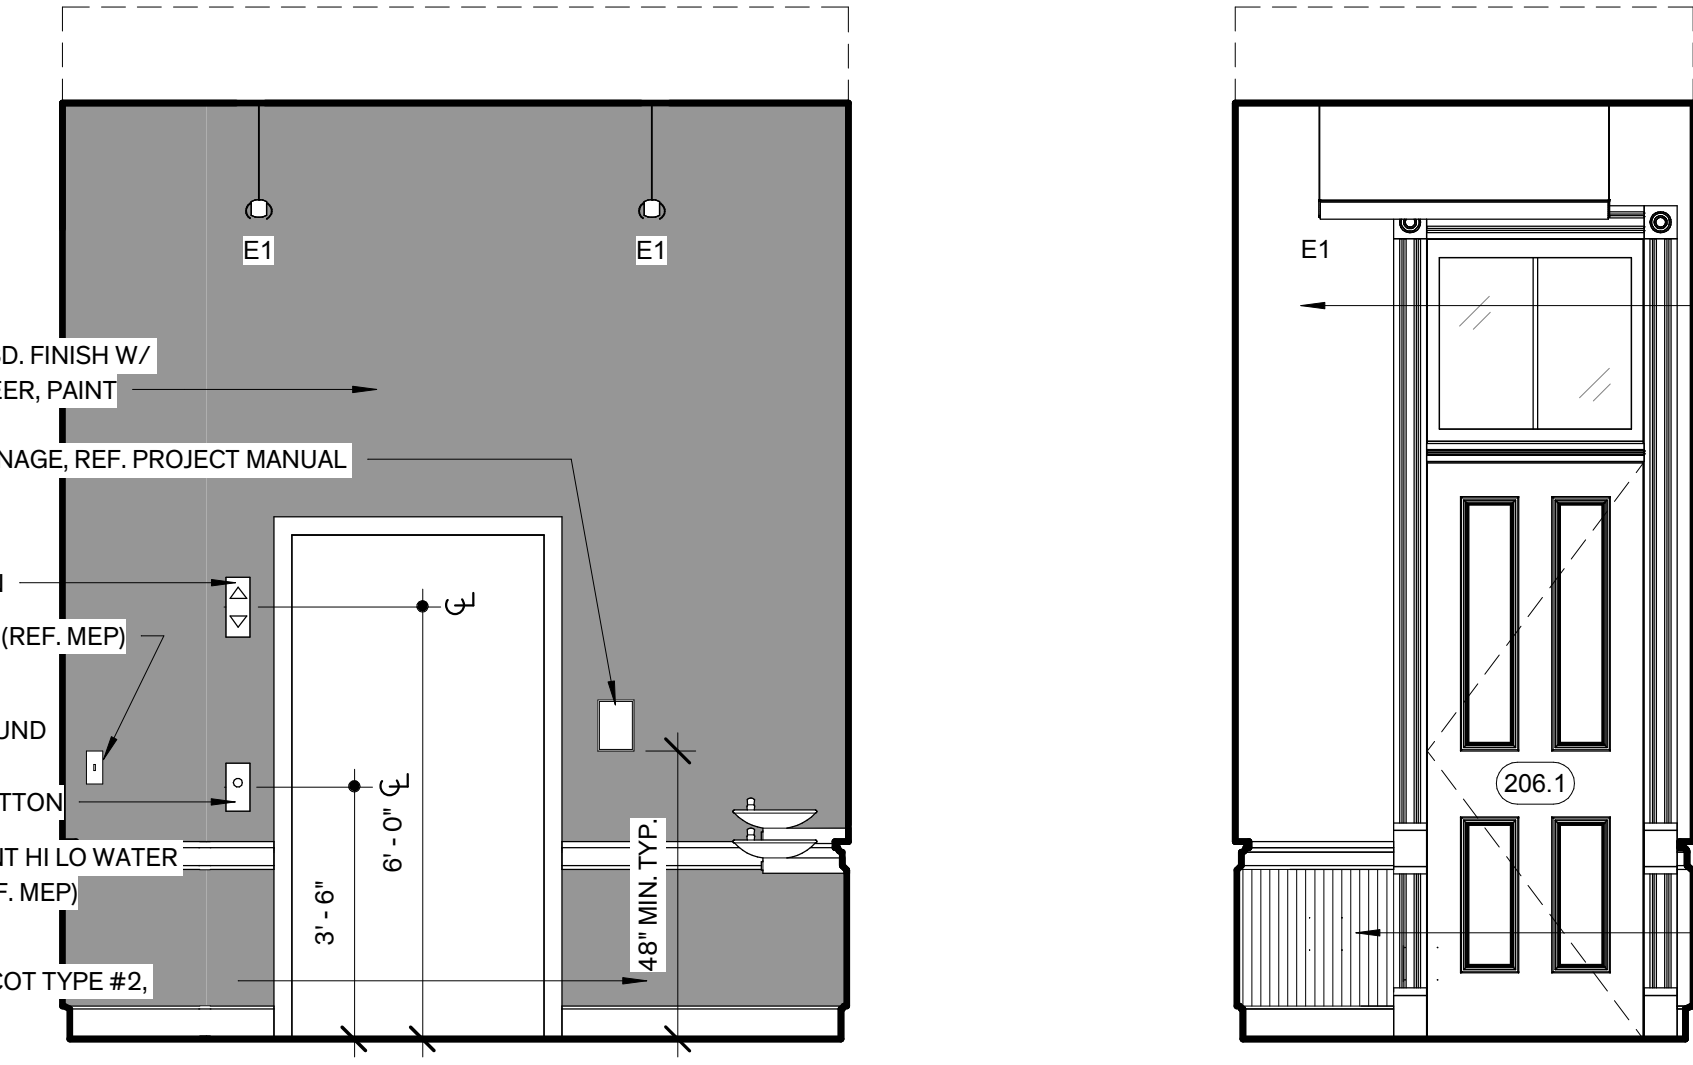


11 206 Elev. Vestibule - West  
 3/8" = 1'-0"

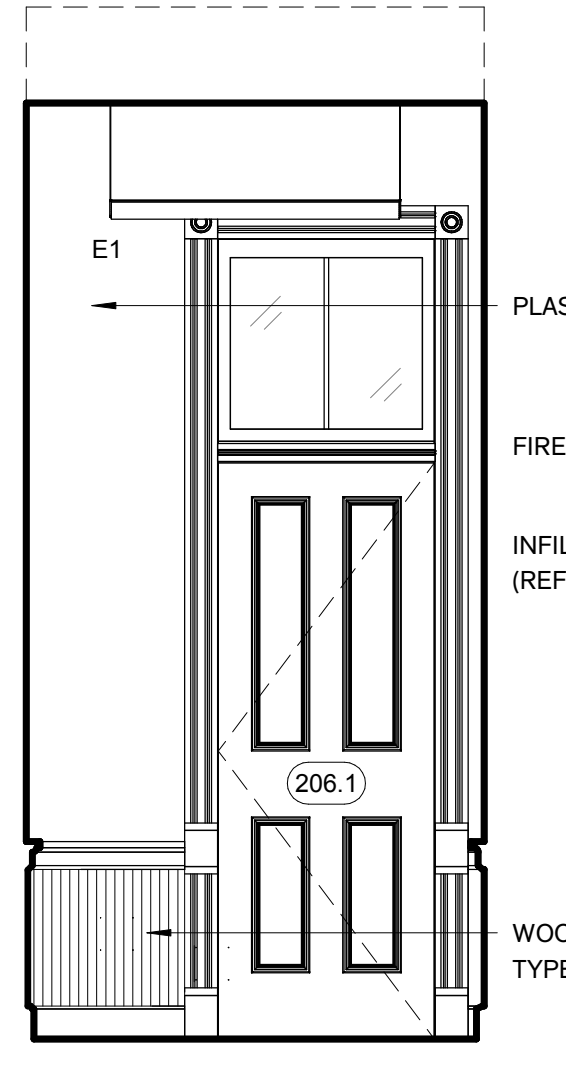


10 206 Elev. Vestibule - South  
 3/8" = 1'-0"

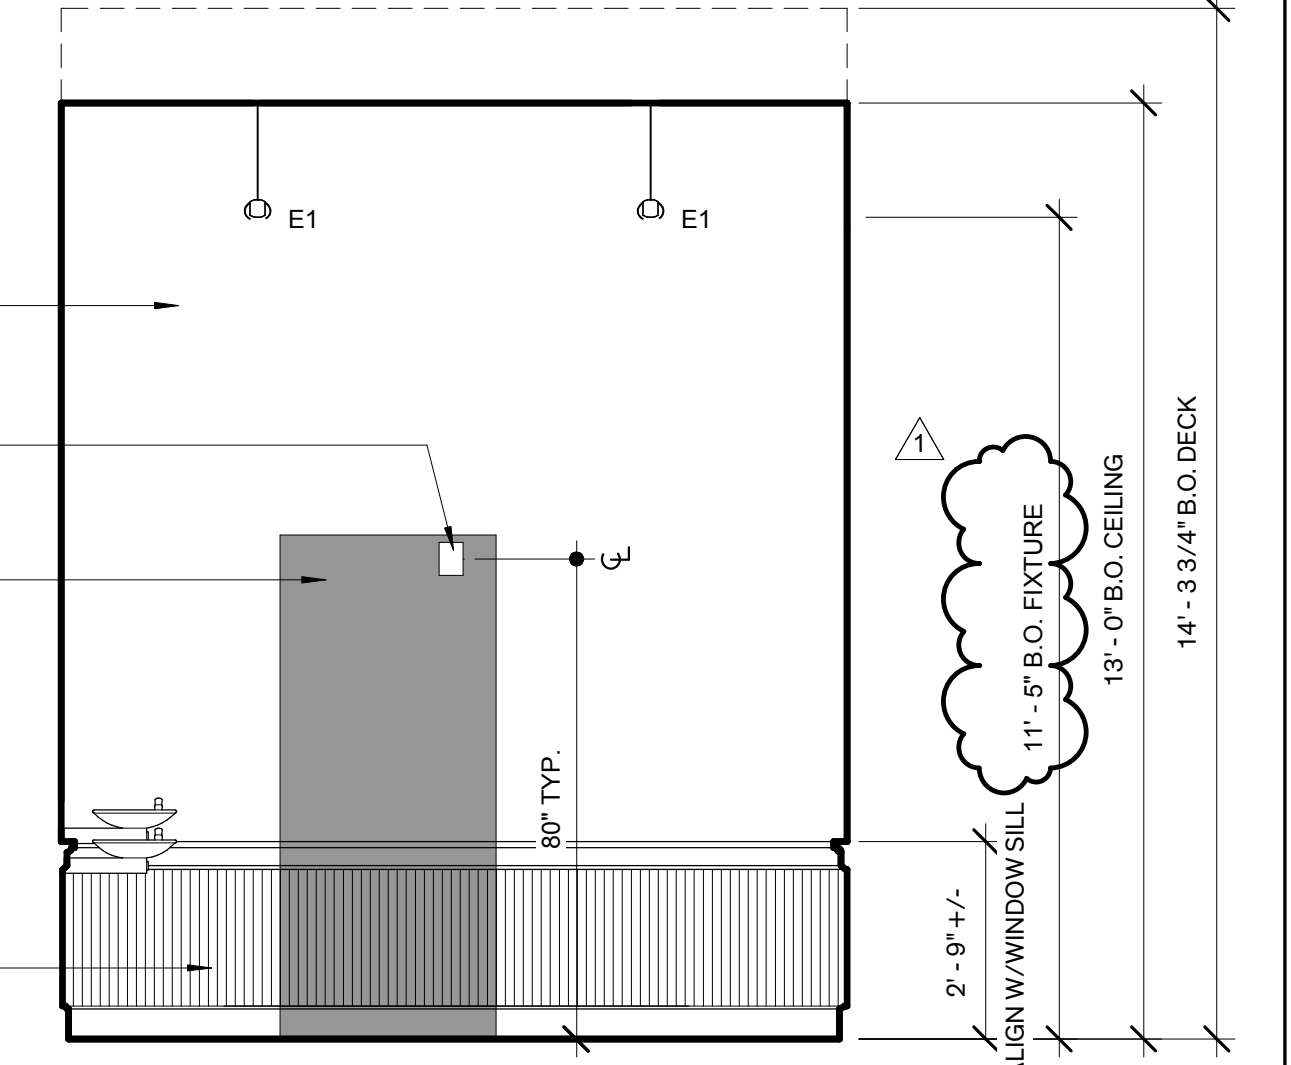


9 206 Elev. Vestibule - East  
 3/8" = 1'-0"

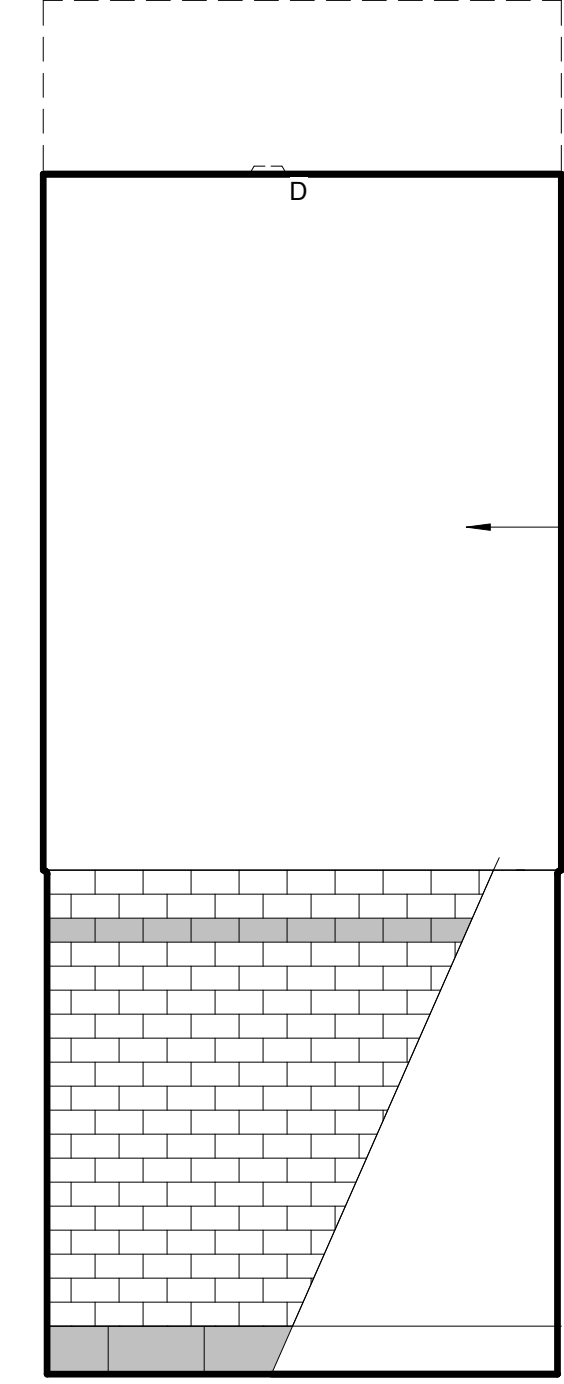


8 205 Jury Restroom - North  
 1/2" = 1'-0"

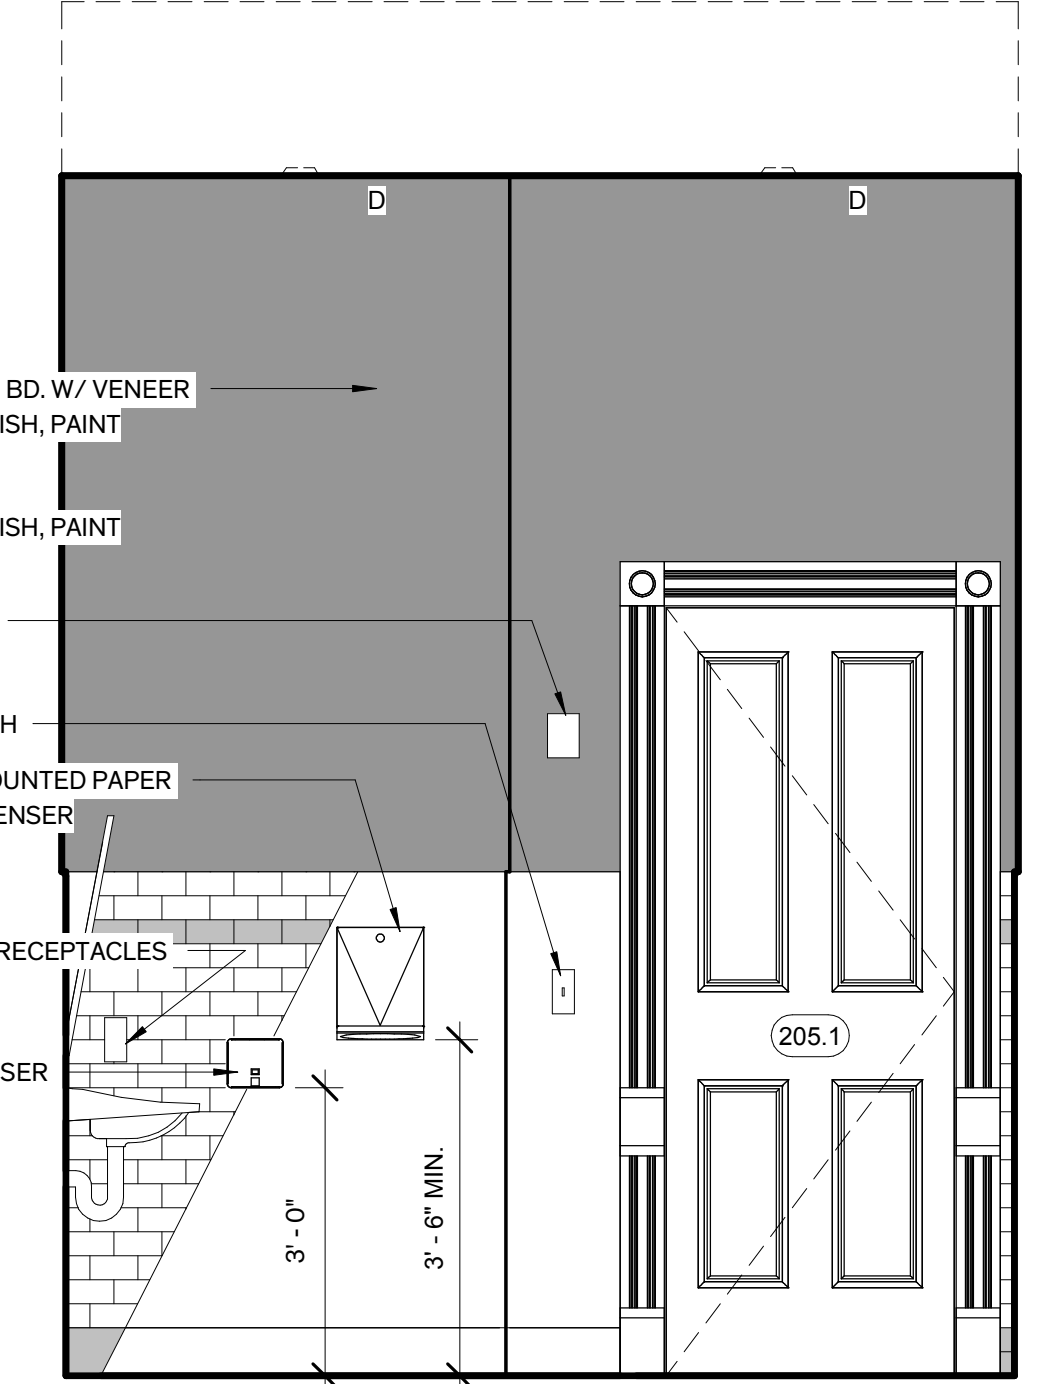


7 205 Jury Restroom - West  
 1/2" = 1'-0"

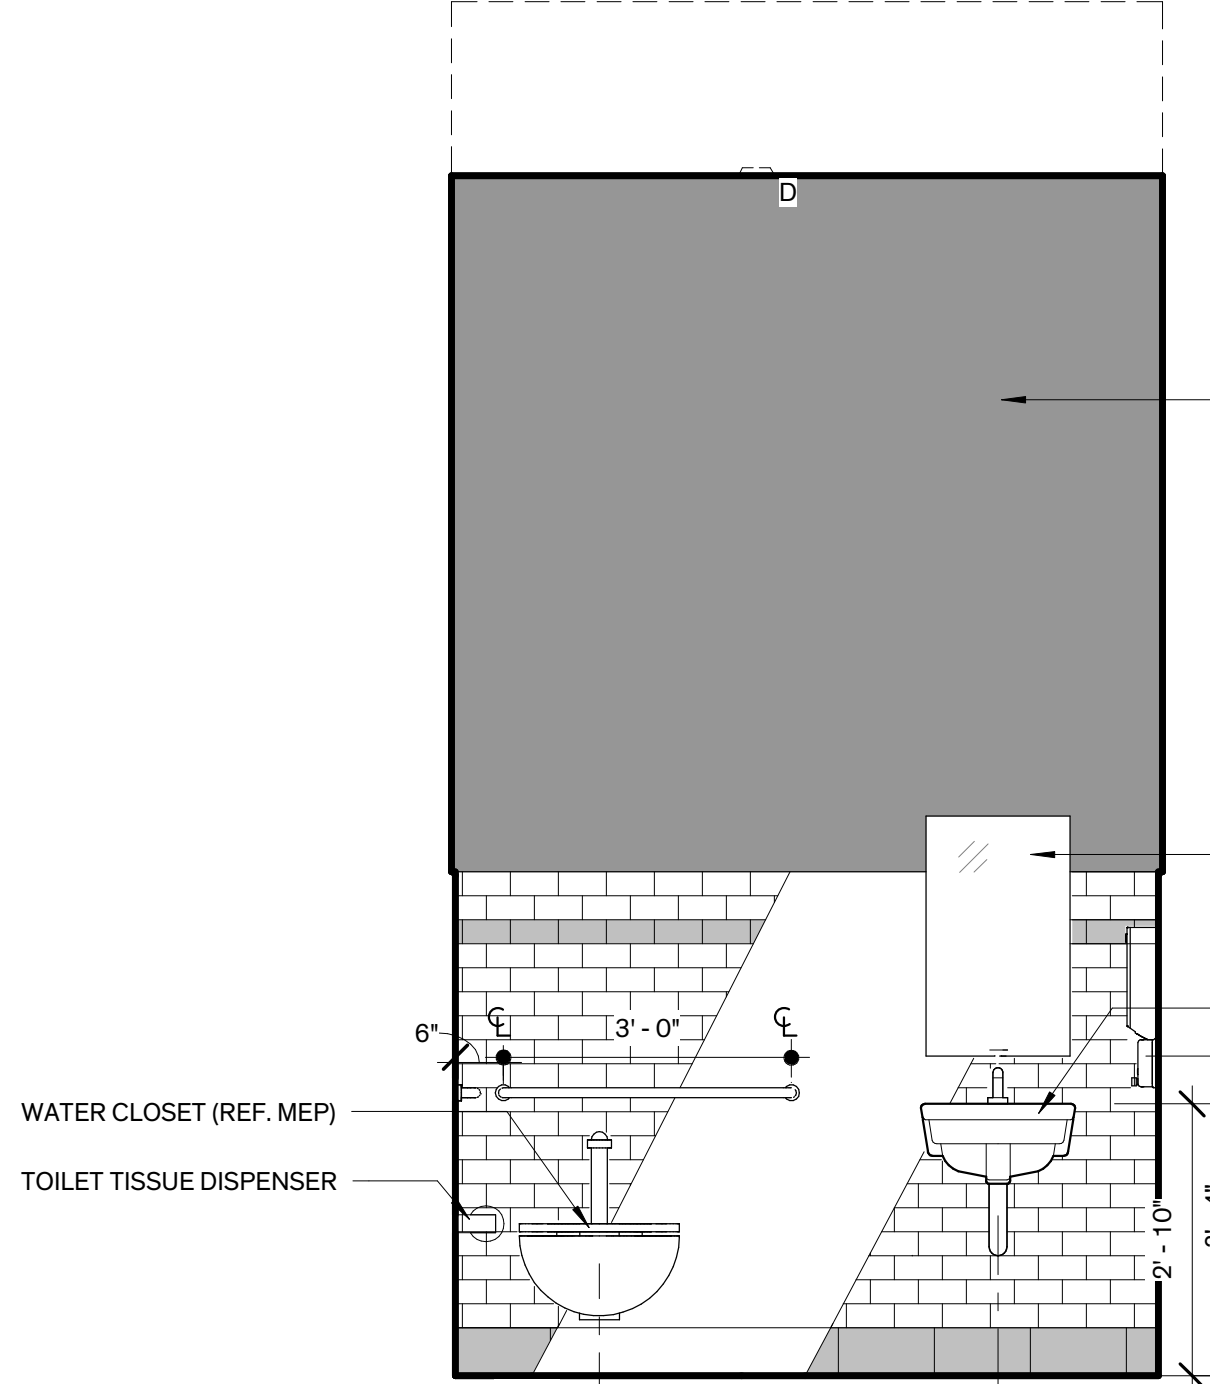


6 205 Jury Restroom - South  
 1/2" = 1'-0"

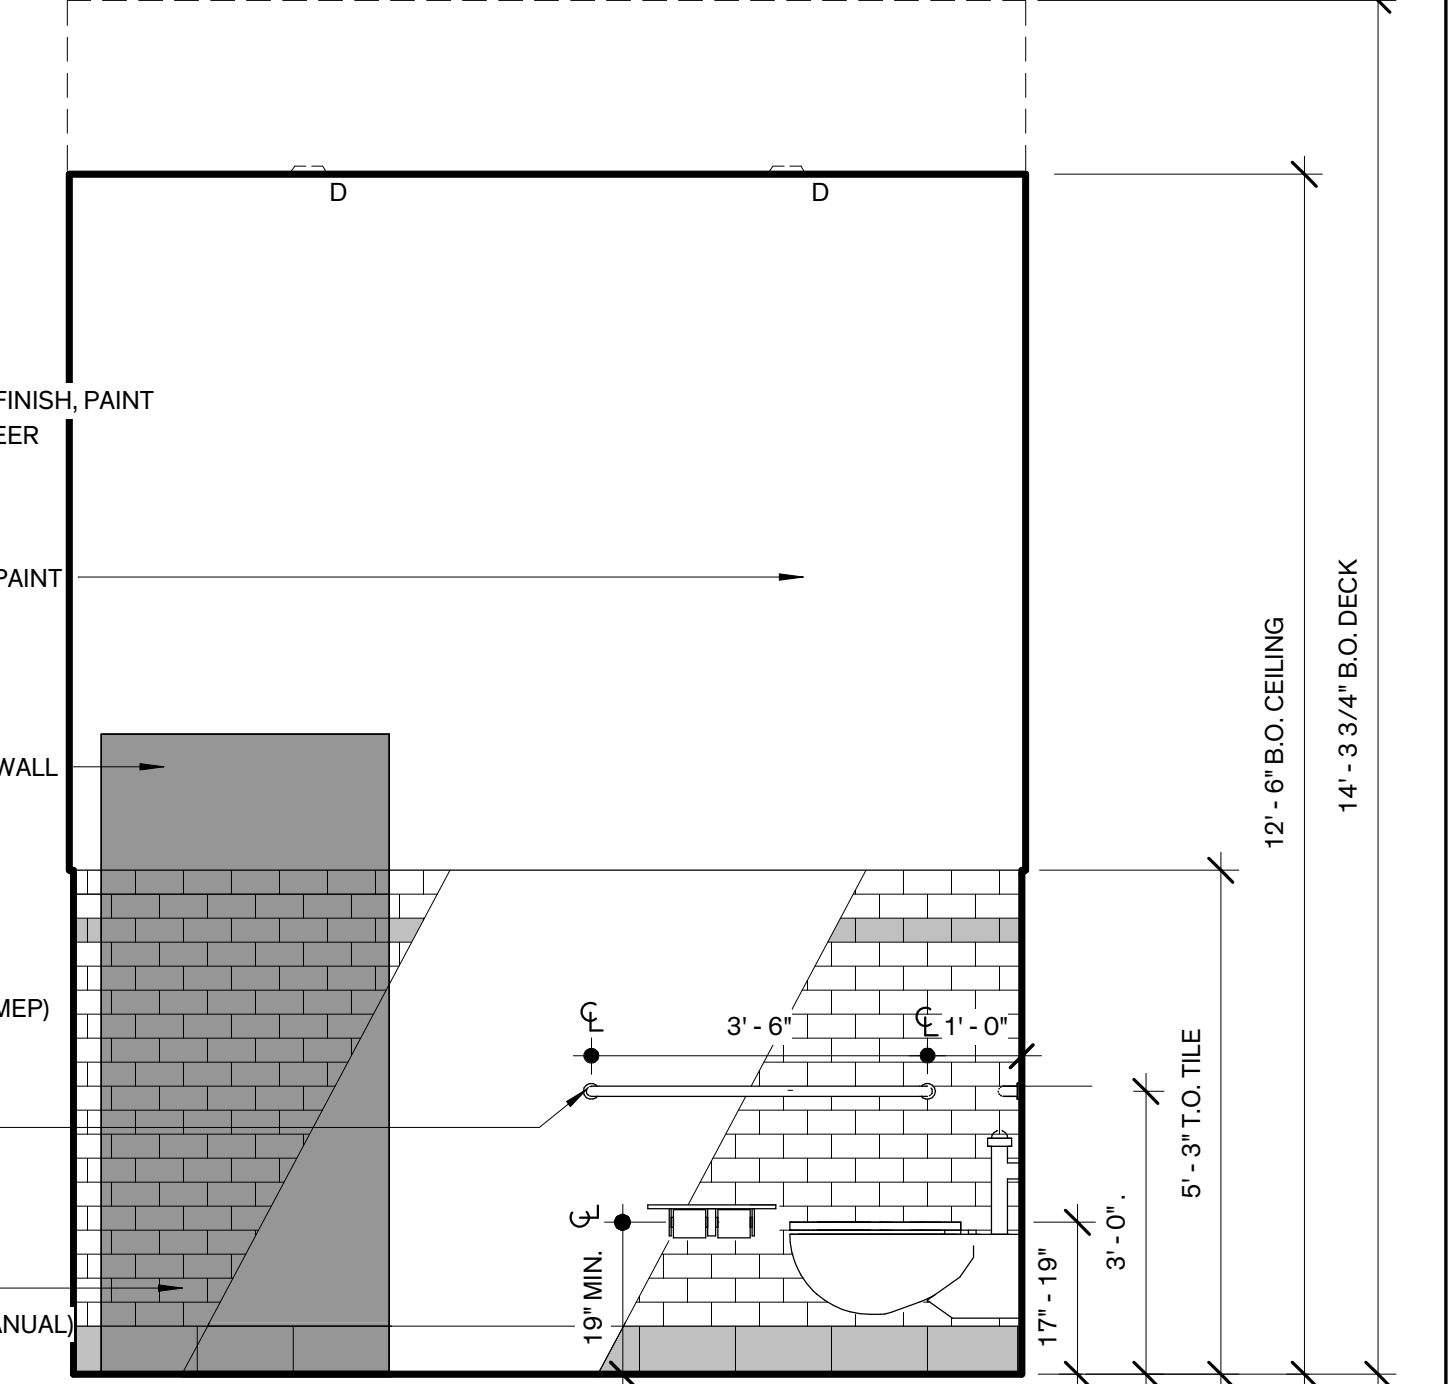


5 205 Jury Restroom - East  
 1/2" = 1'-0"

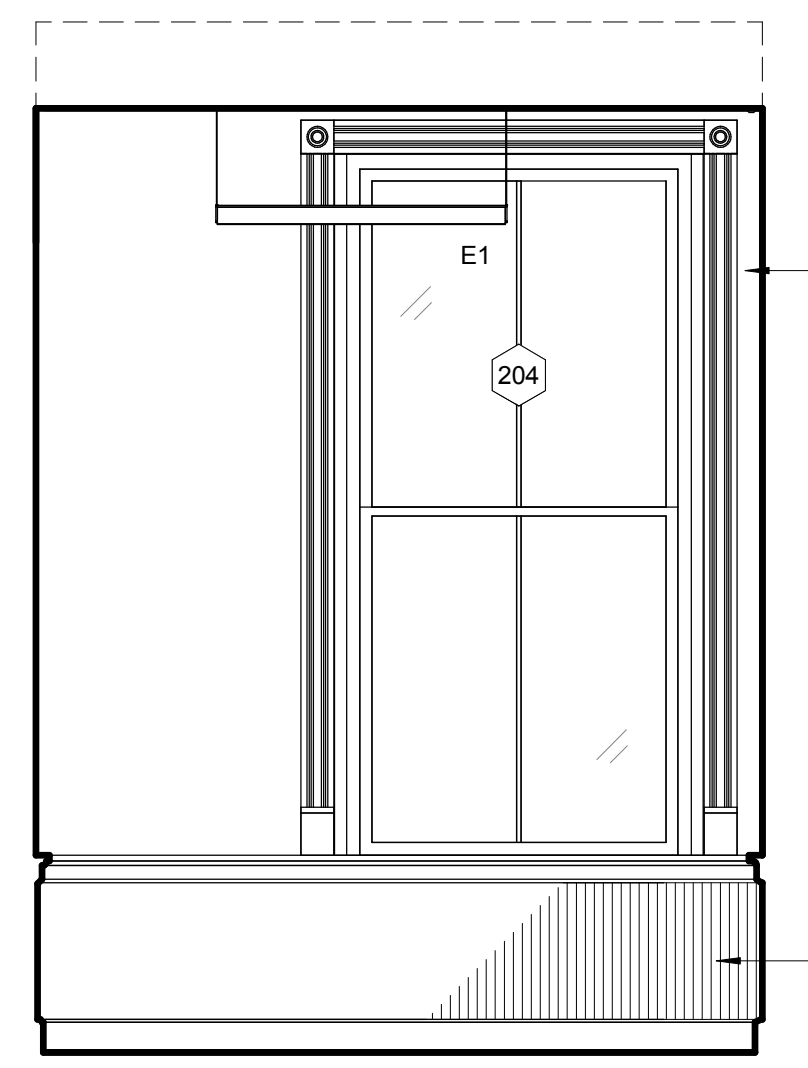


4 204 Jury Kitchen - North  
 3/8" = 1'-0"

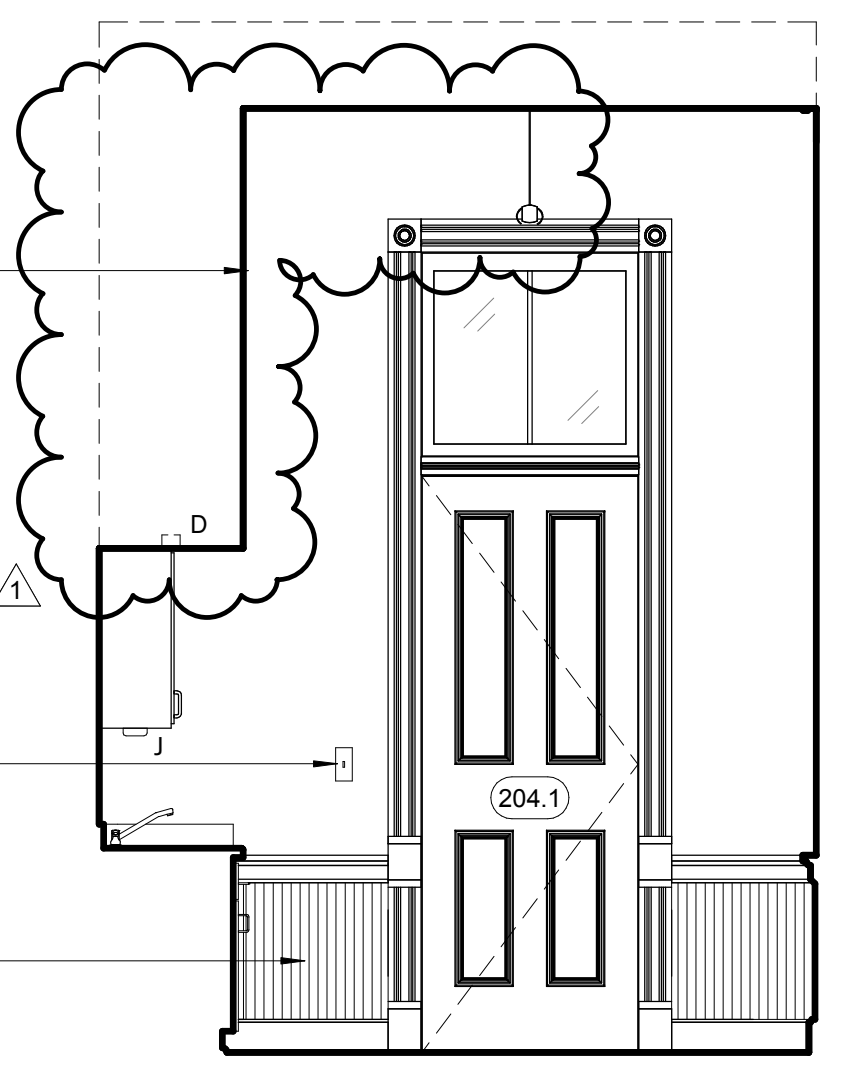

3 204 Jury Kitchen - West  
 3/8" = 1'-0"

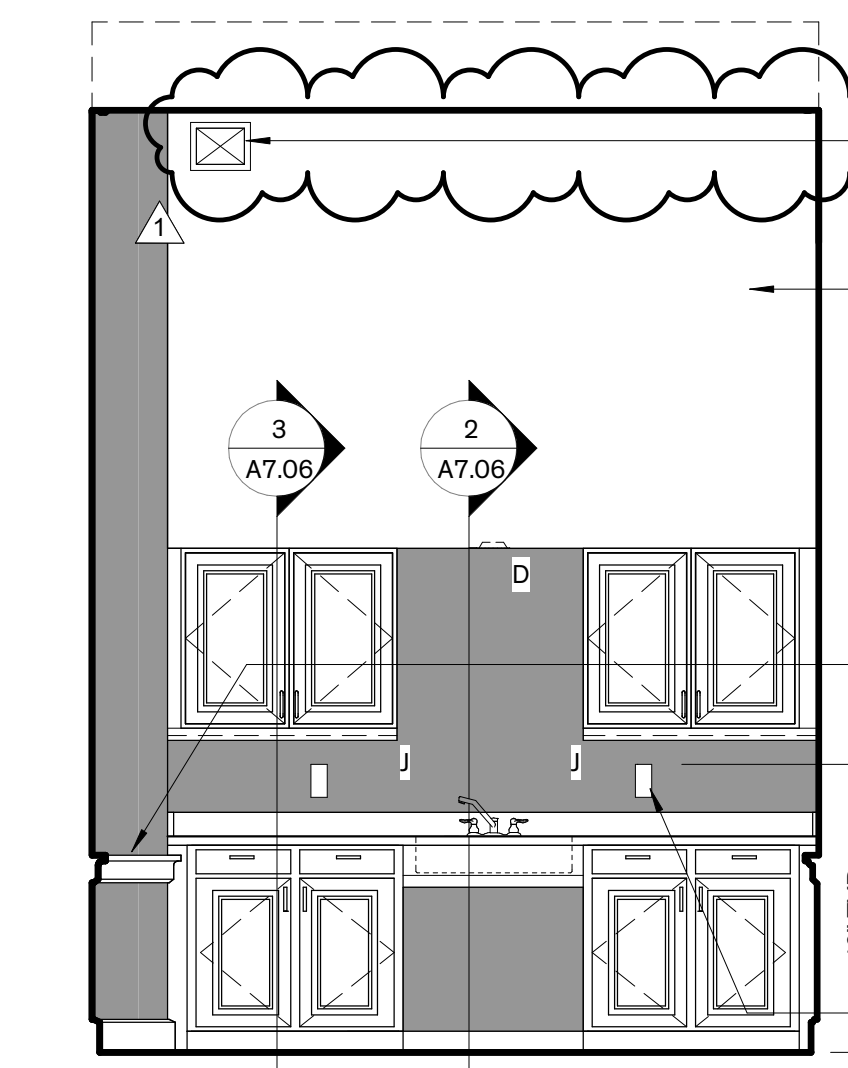

2 204 Jury Kitchen - South  
 3/8" = 1'-0"

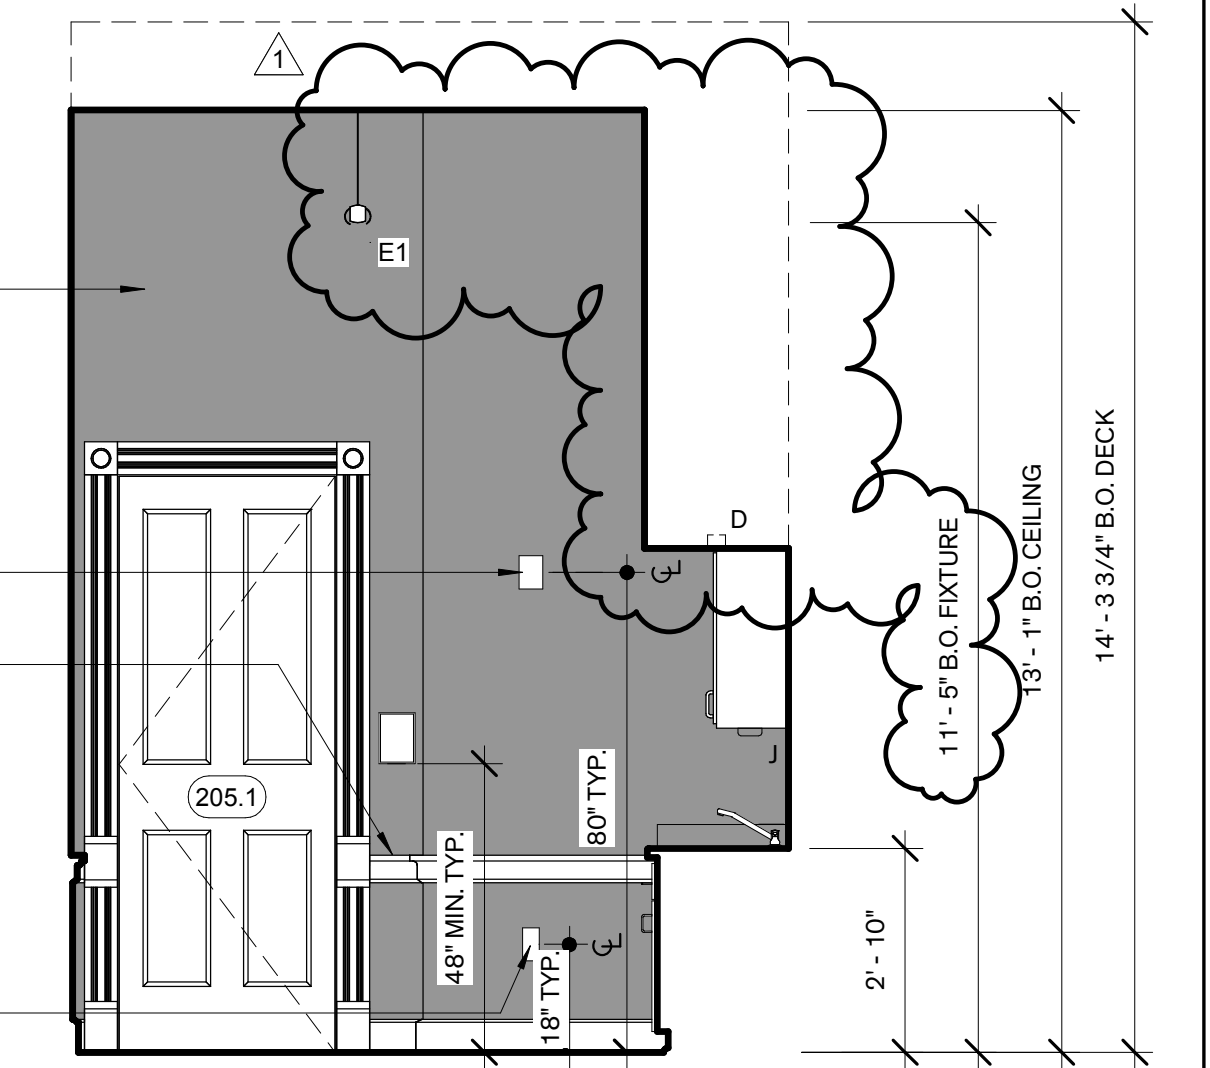

1 204 Jury Kitchen - East  
 3/8" = 1'-0"



FANNIN COUNTY COURTHOUSE  
 INTERIOR & EXTERIOR RESTORATION

101 E. Sam Rayburn Drive  
 Bonham, Texas 75418

**COPYRIGHT**  
 The Contractor shall verify and be responsible for all dimensions. DO NOT scale the drawing. Any errors or omissions shall be reported to Architexas without delay. The Copyrights to all designs and drawings are the property of Architexas. Reproduction or use for any purpose other than that authorized by Architexas is forbidden.

**REVISION HISTORY**  
 1 Oct. 16, 2018 Addendum #1

ISSUED FOR CONSTRUCTION




#18326 9/21/2018

Architexas No. 1737 Date SEPT. 21, 2018


Sheet Name INTERIOR ELEVATIONS - SECOND LEVEL

Sheet Number




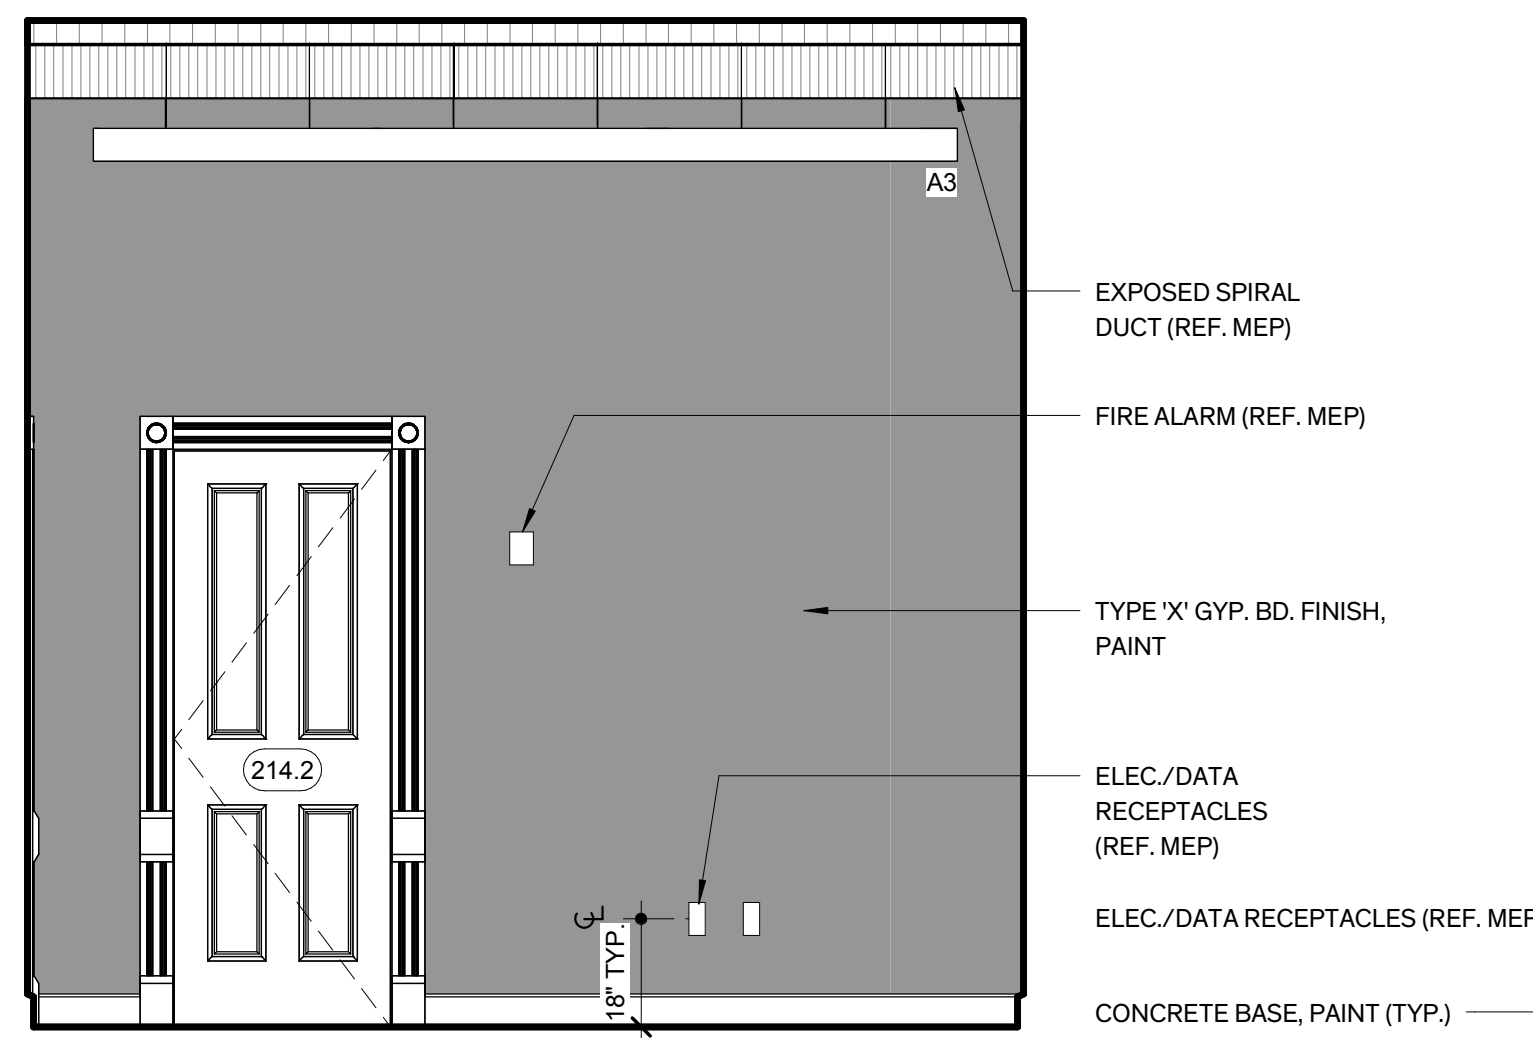


16 213 County Judge - North  
 3/8" = 1'-0"

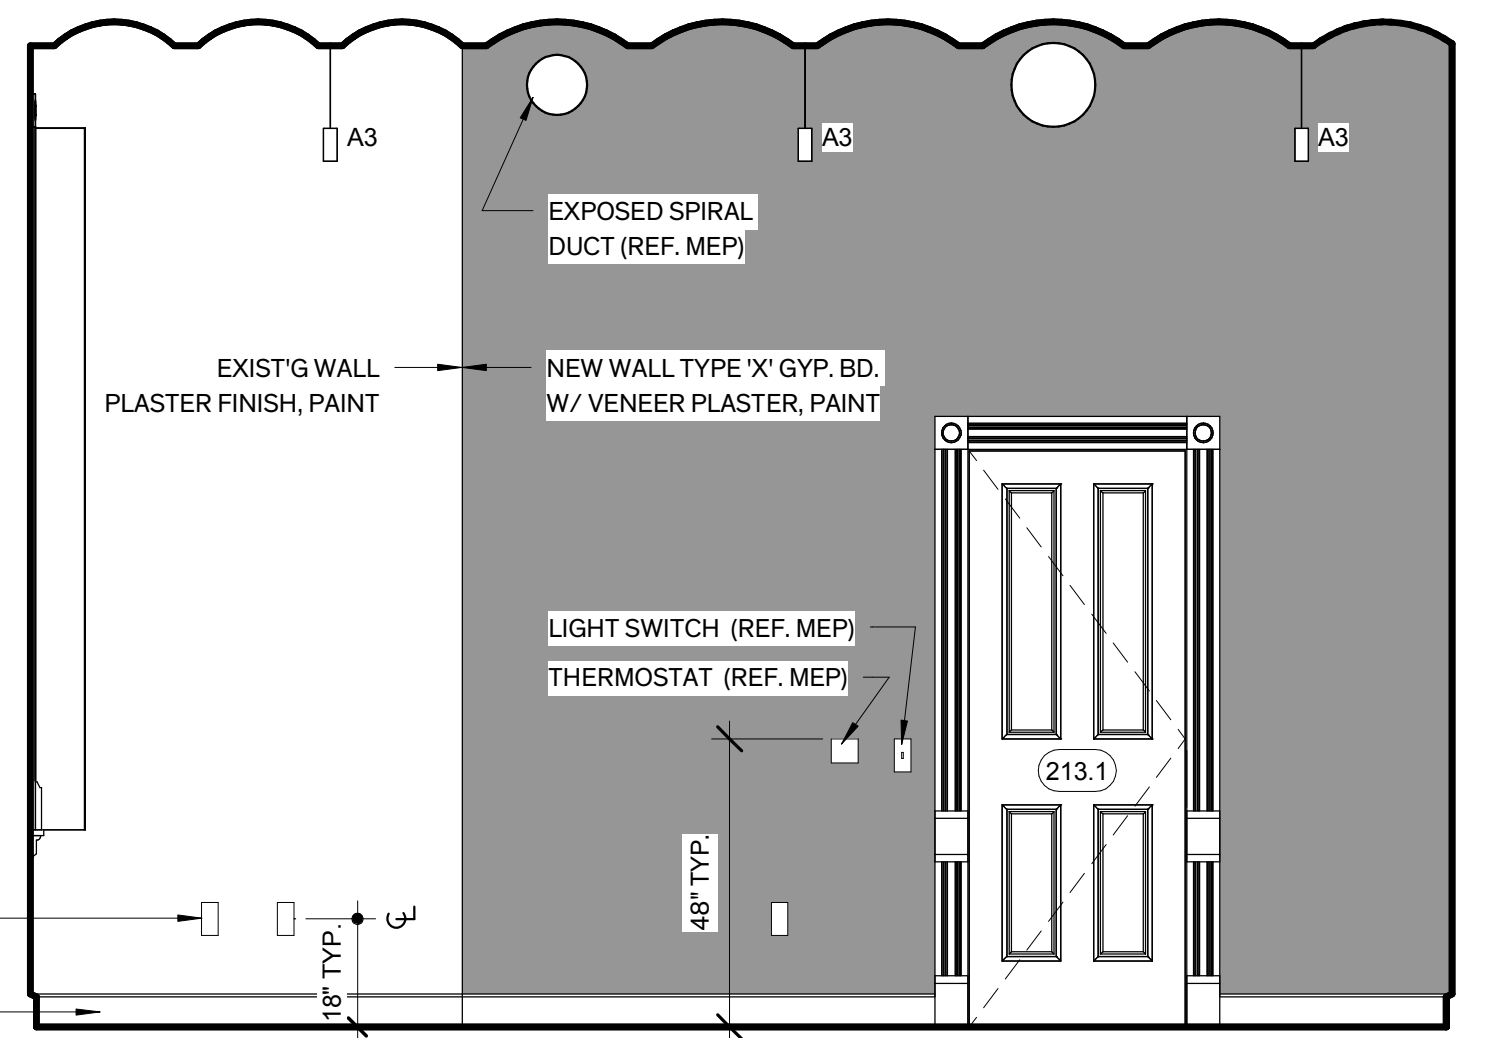


15 213 County Judge - West  
 3/8" = 1'-0"

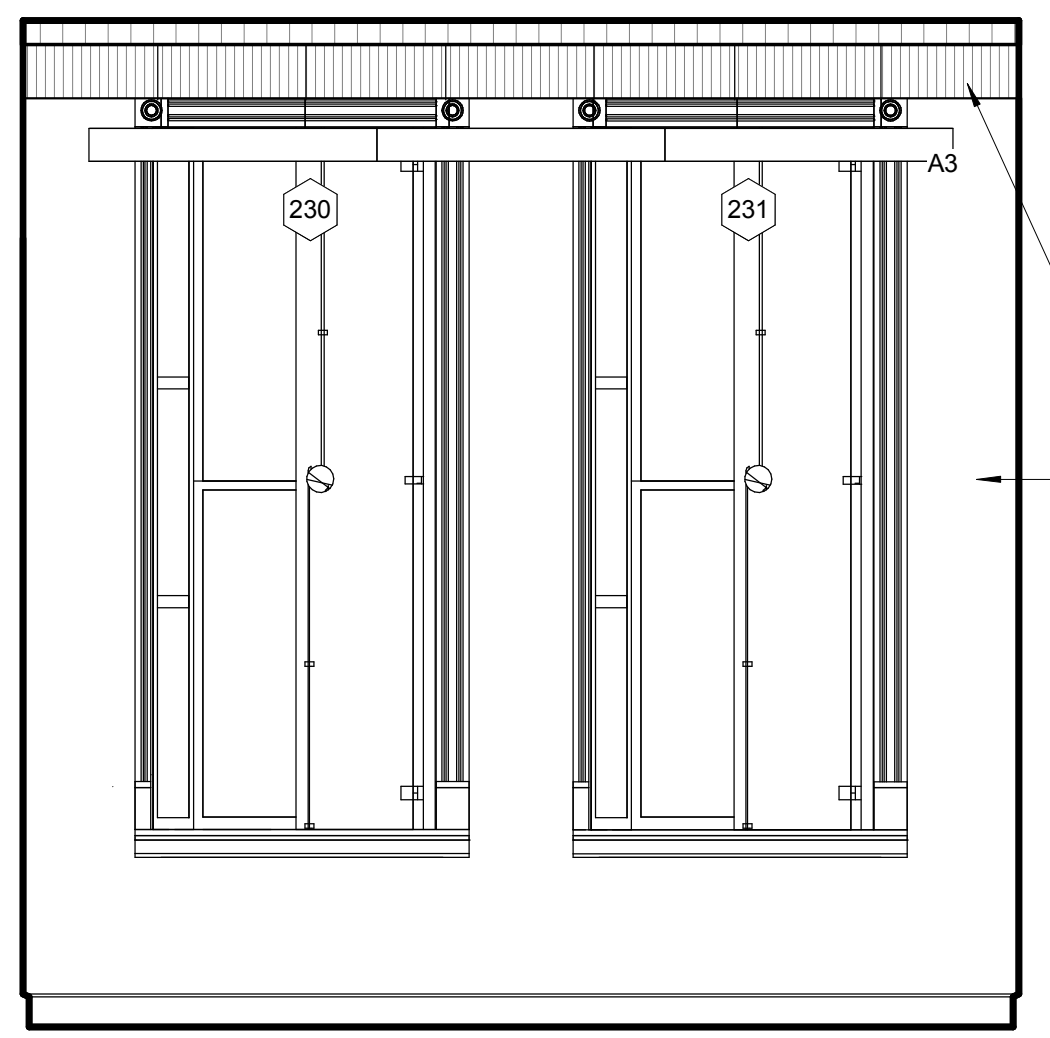


14 213 County Judge - South  
 3/8" = 1'-0"

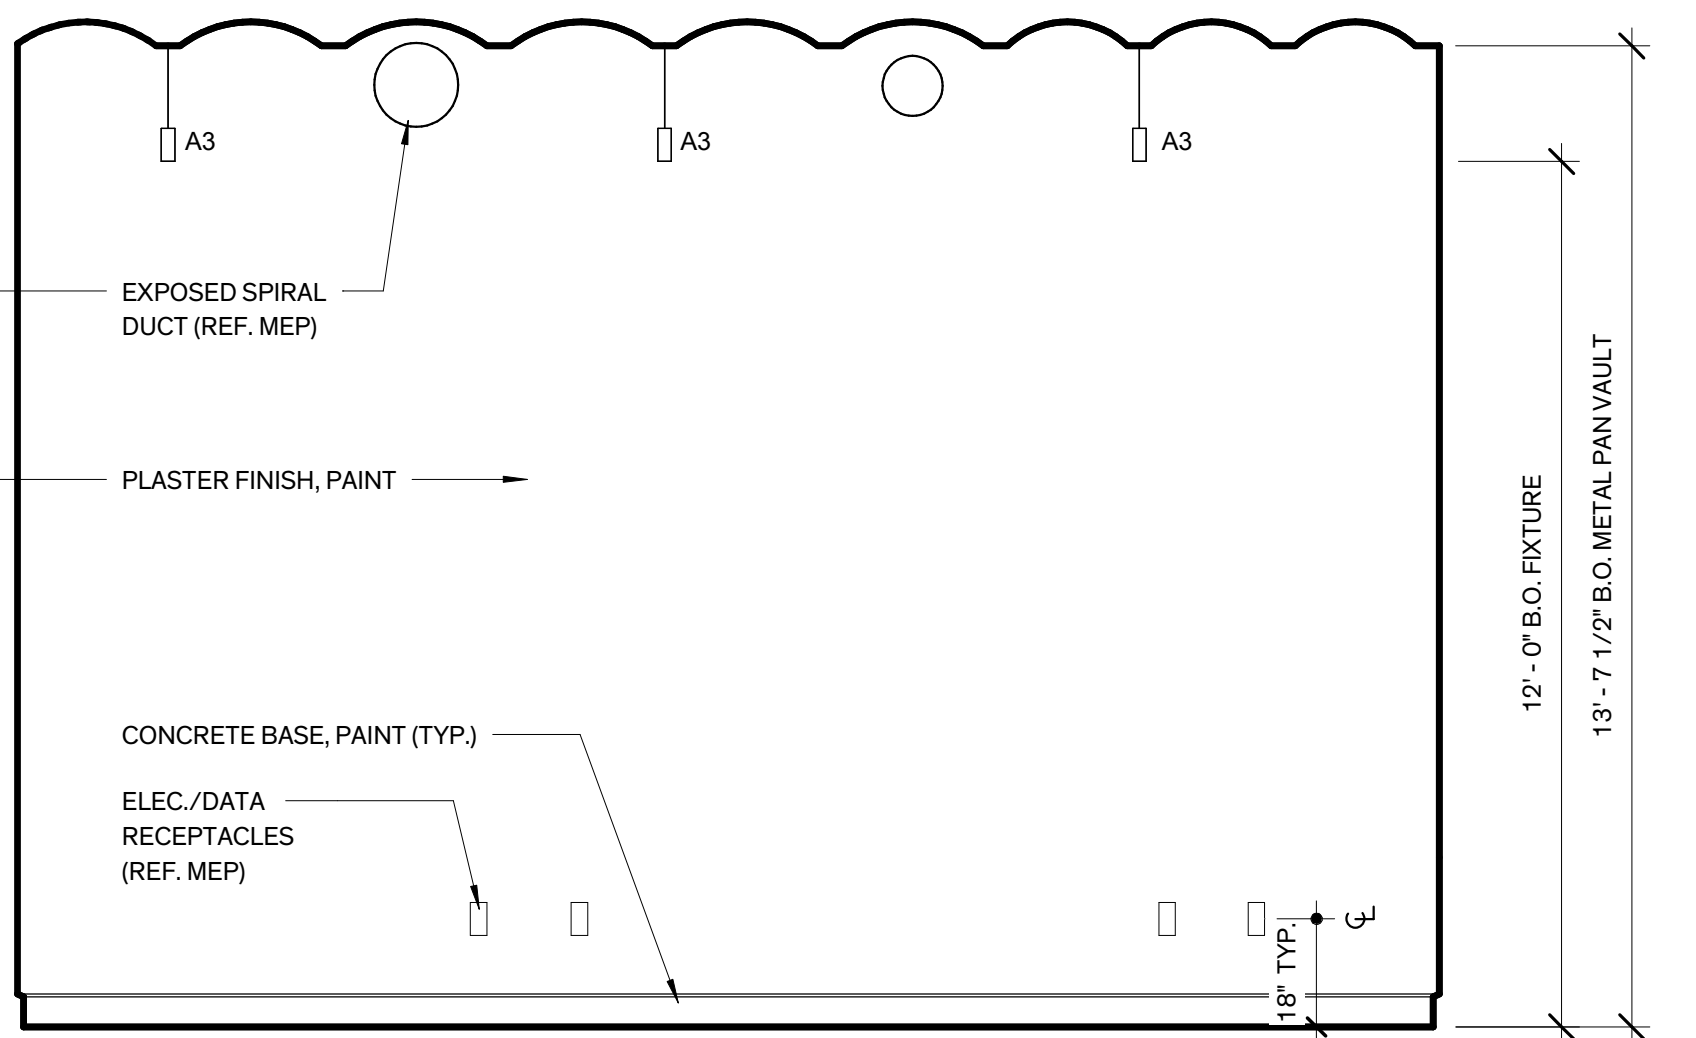


13 213 County Judge - East  
 3/8" = 1'-0"

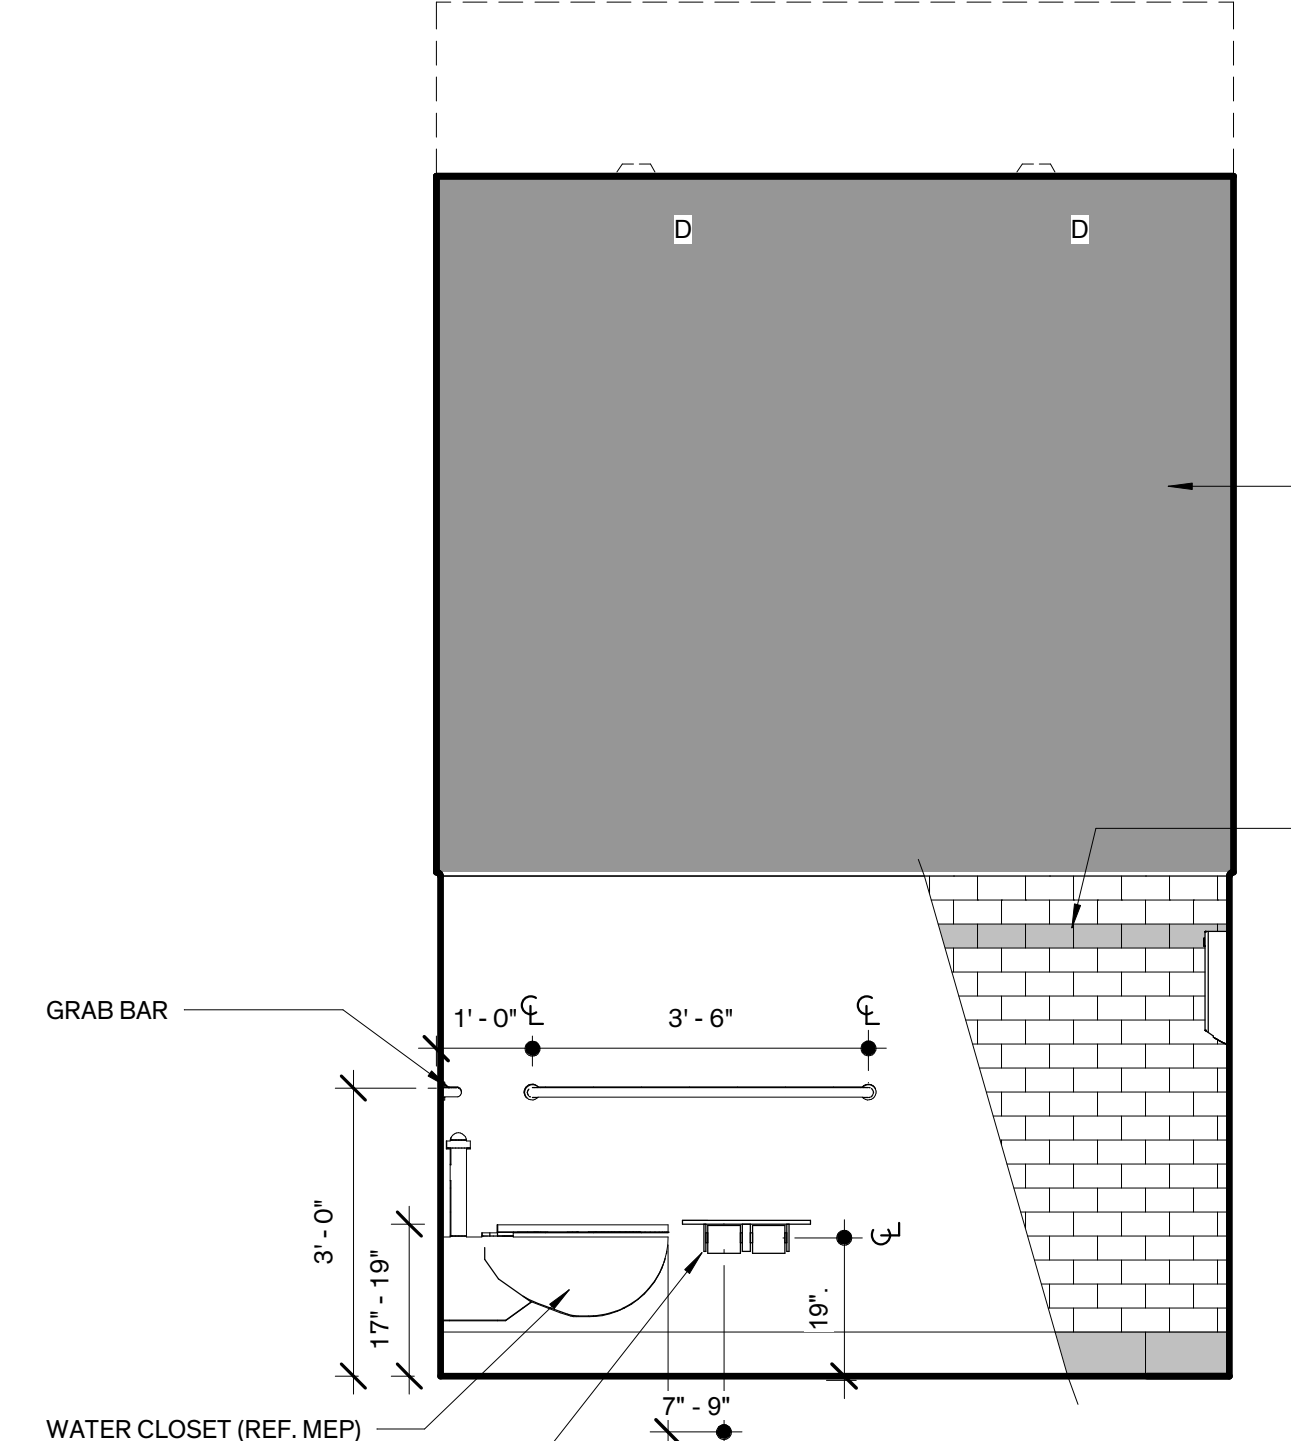


12 212 Restroom - North  
 1/2" = 1'-0"

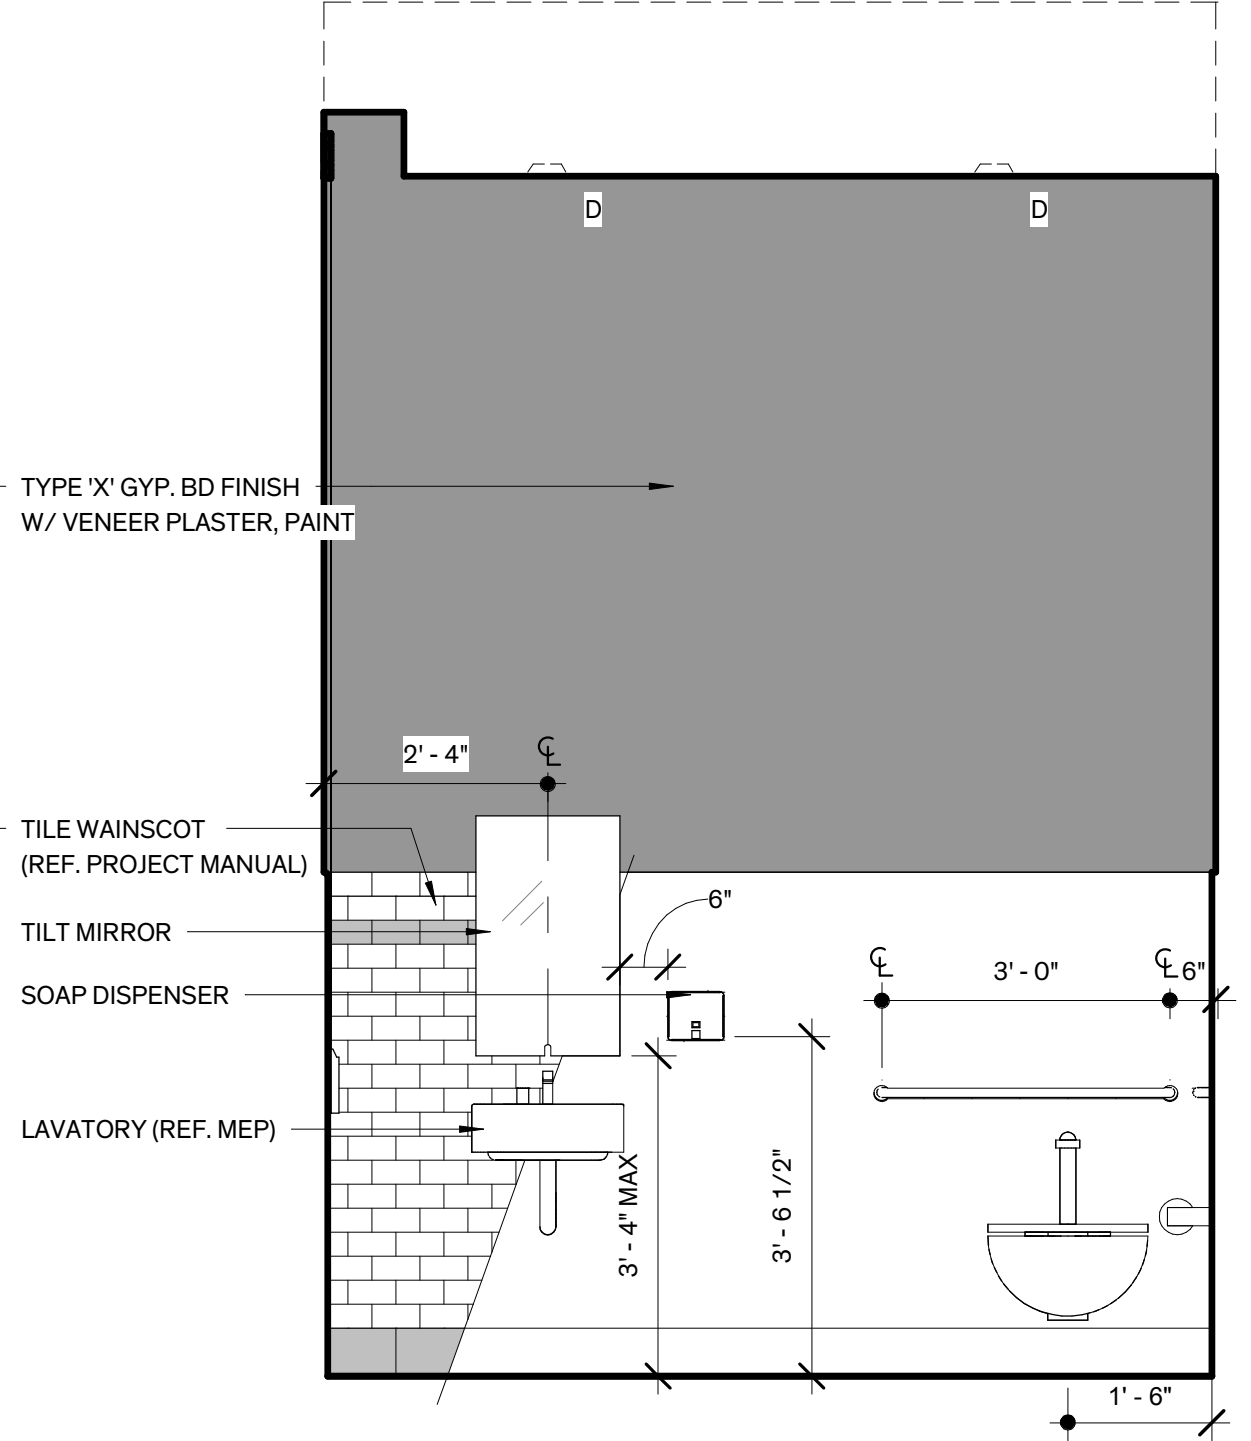


11 212 Restroom - West  
 1/2" = 1'-0"

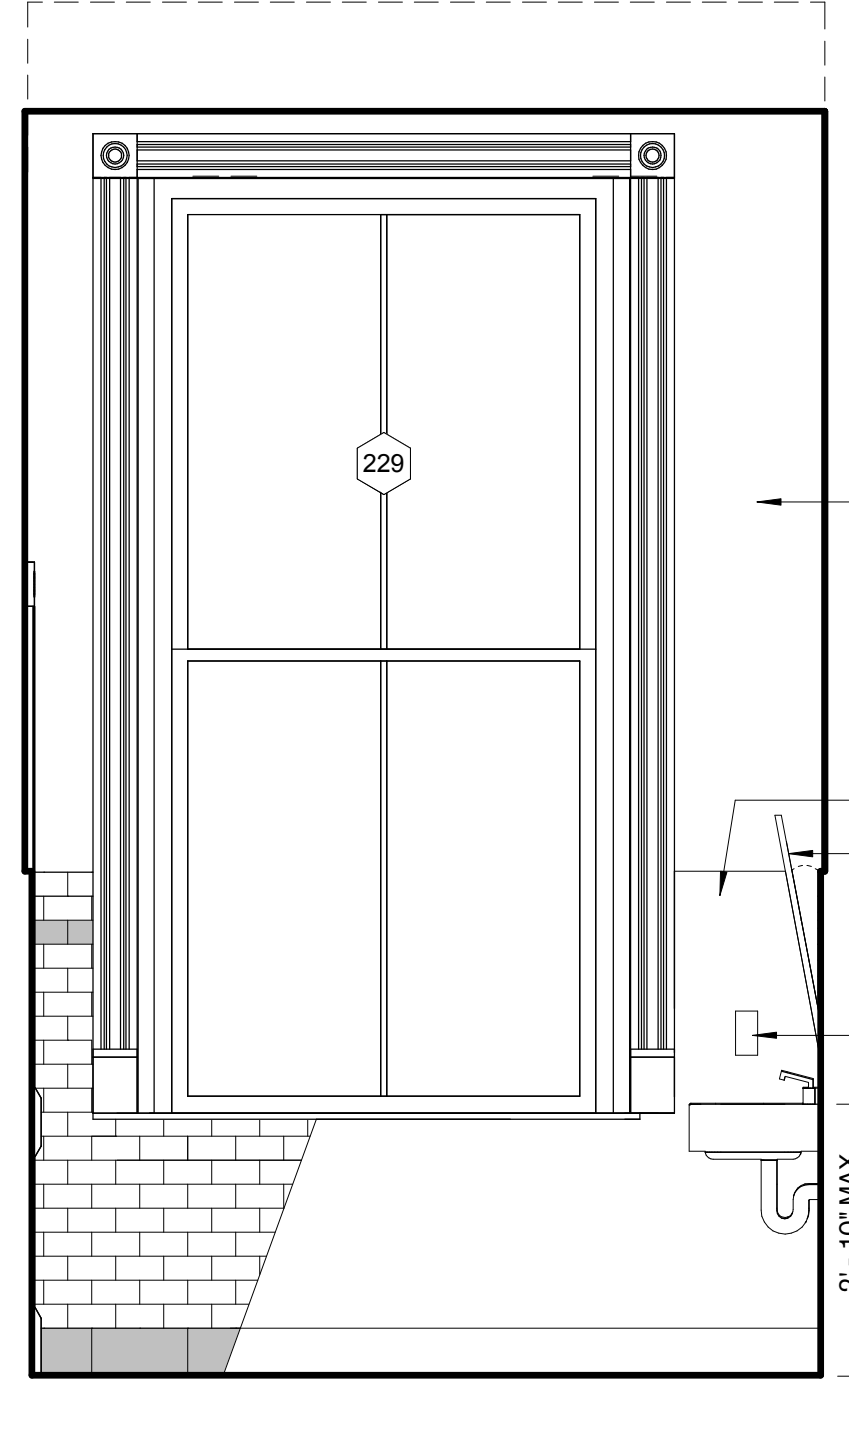


10 212 Restroom - South  
 1/2" = 1'-0"

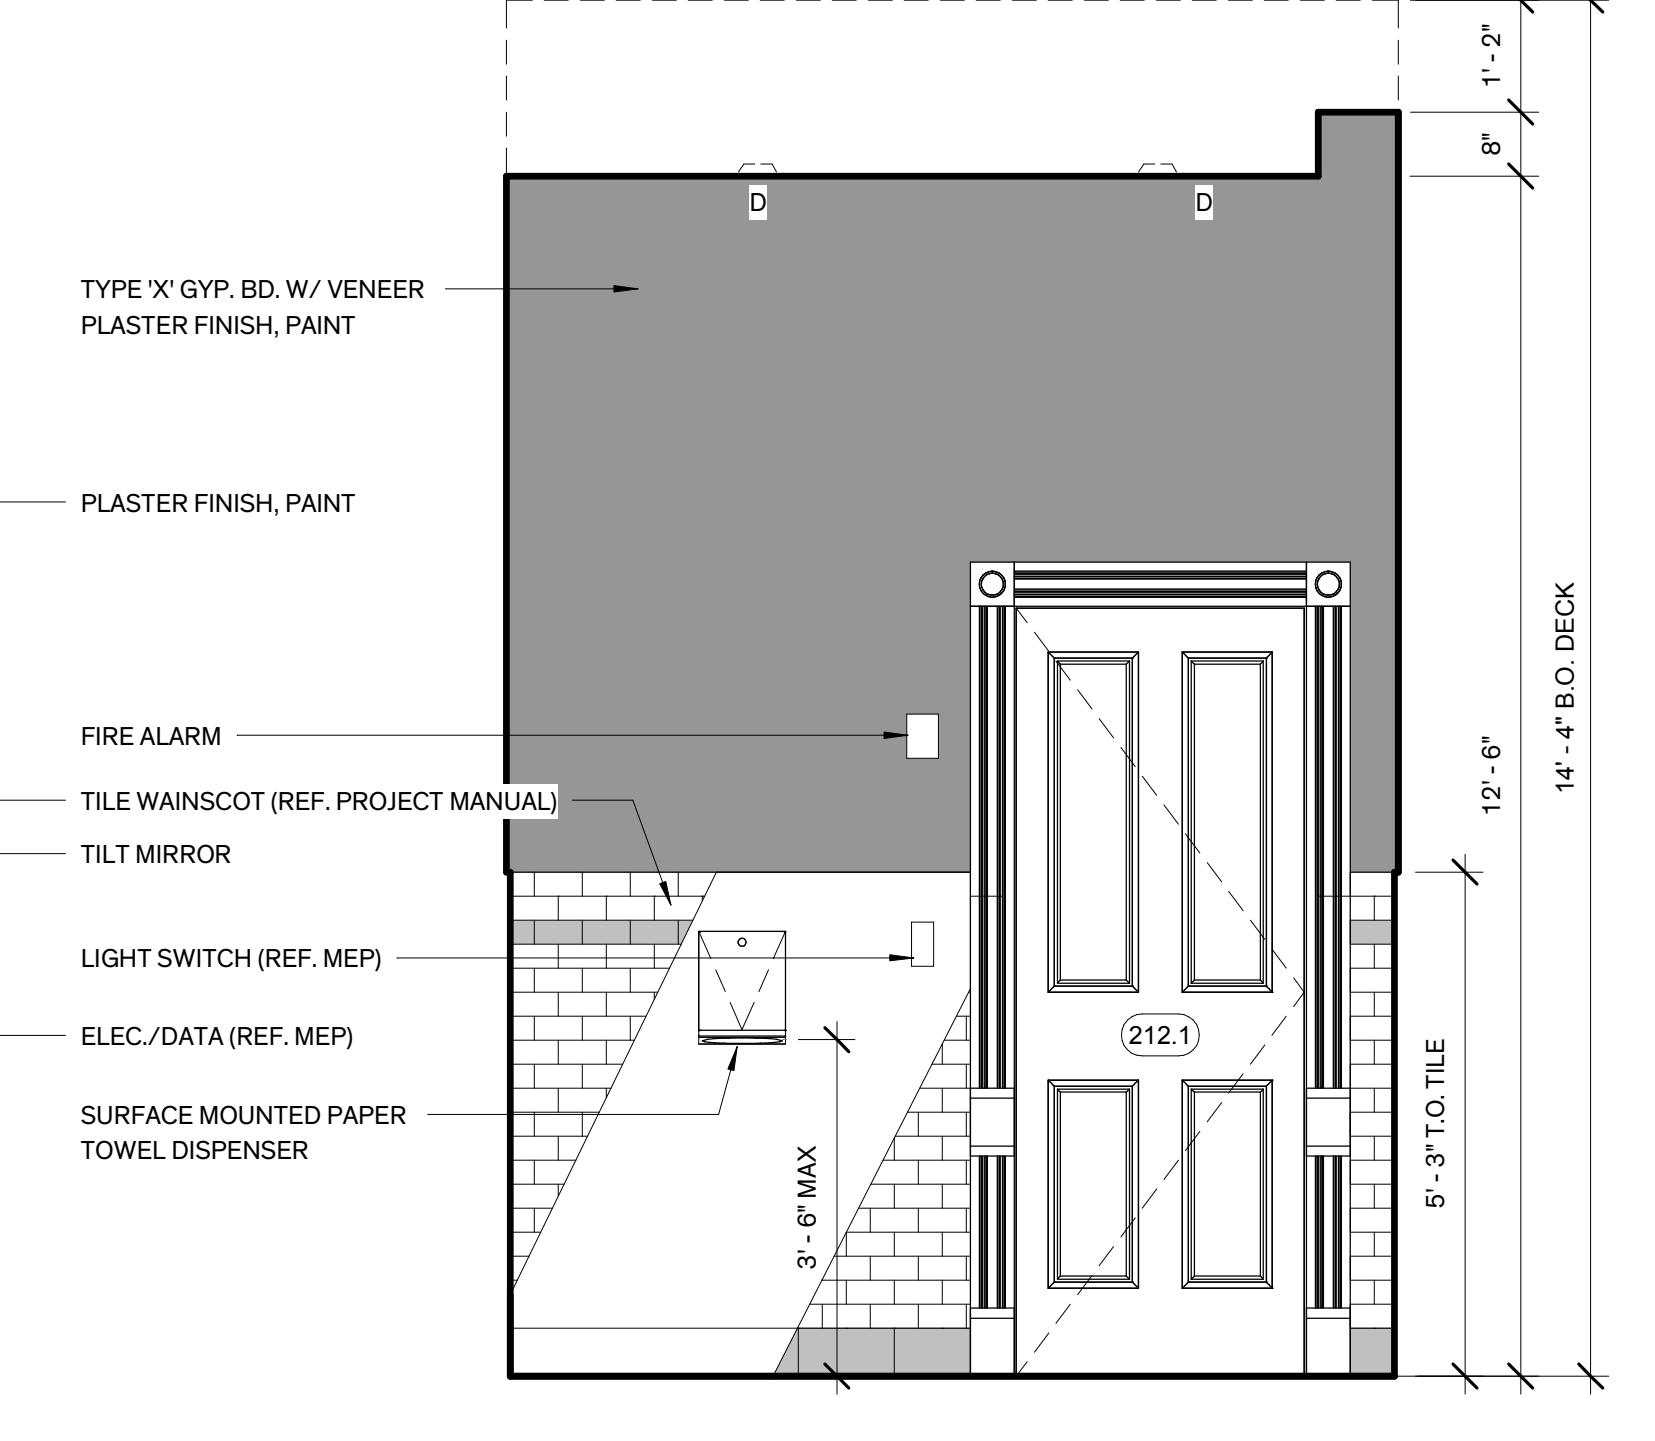


9 212 Restroom - East  
 1/2" = 1'-0"

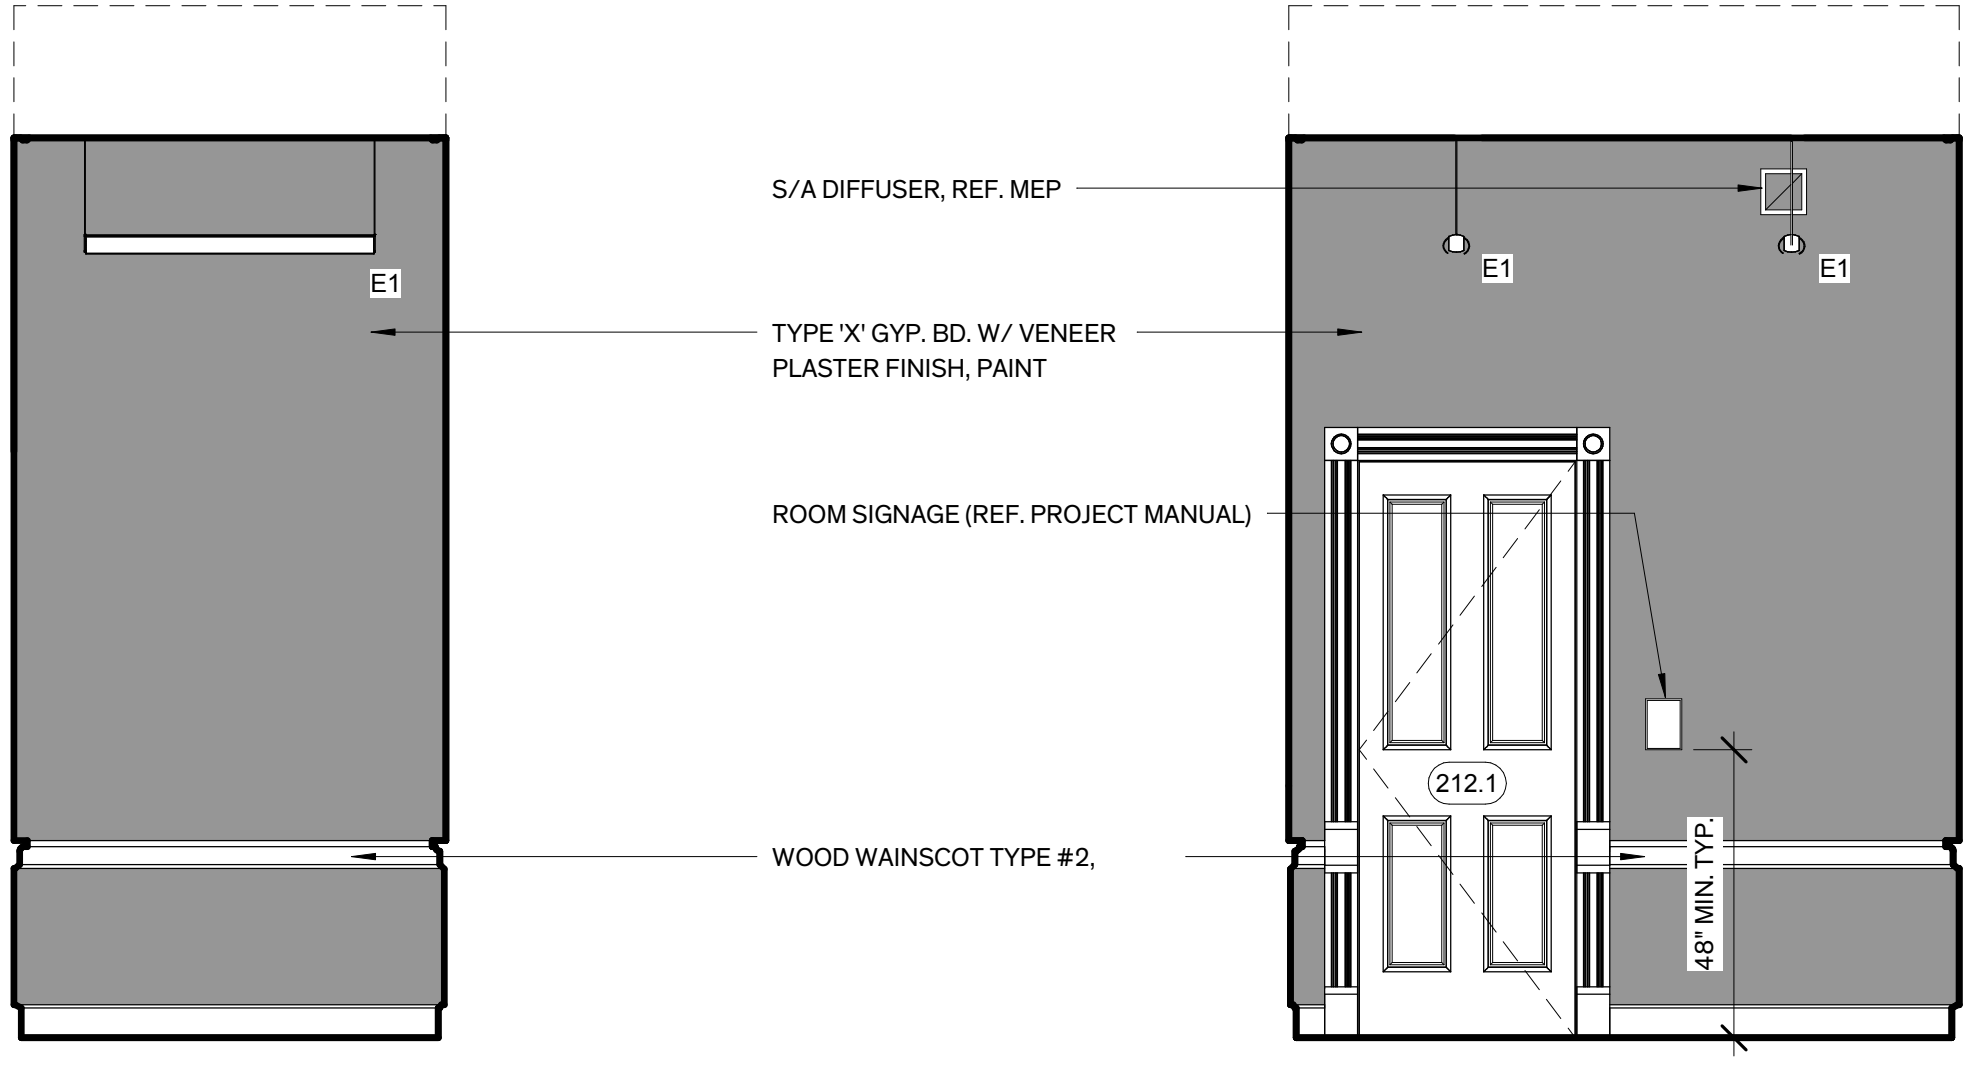


8 211 Vestibule - North  
 3/8" = 1'-0"

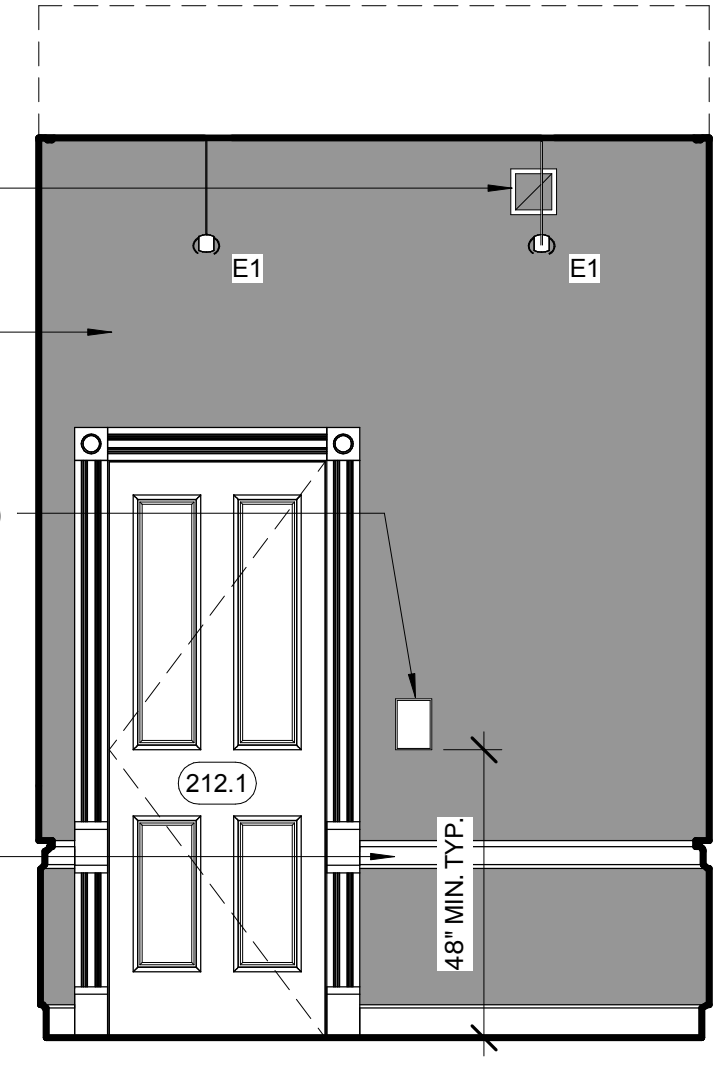


7 211 Vestibule - West  
 3/8" = 1'-0"

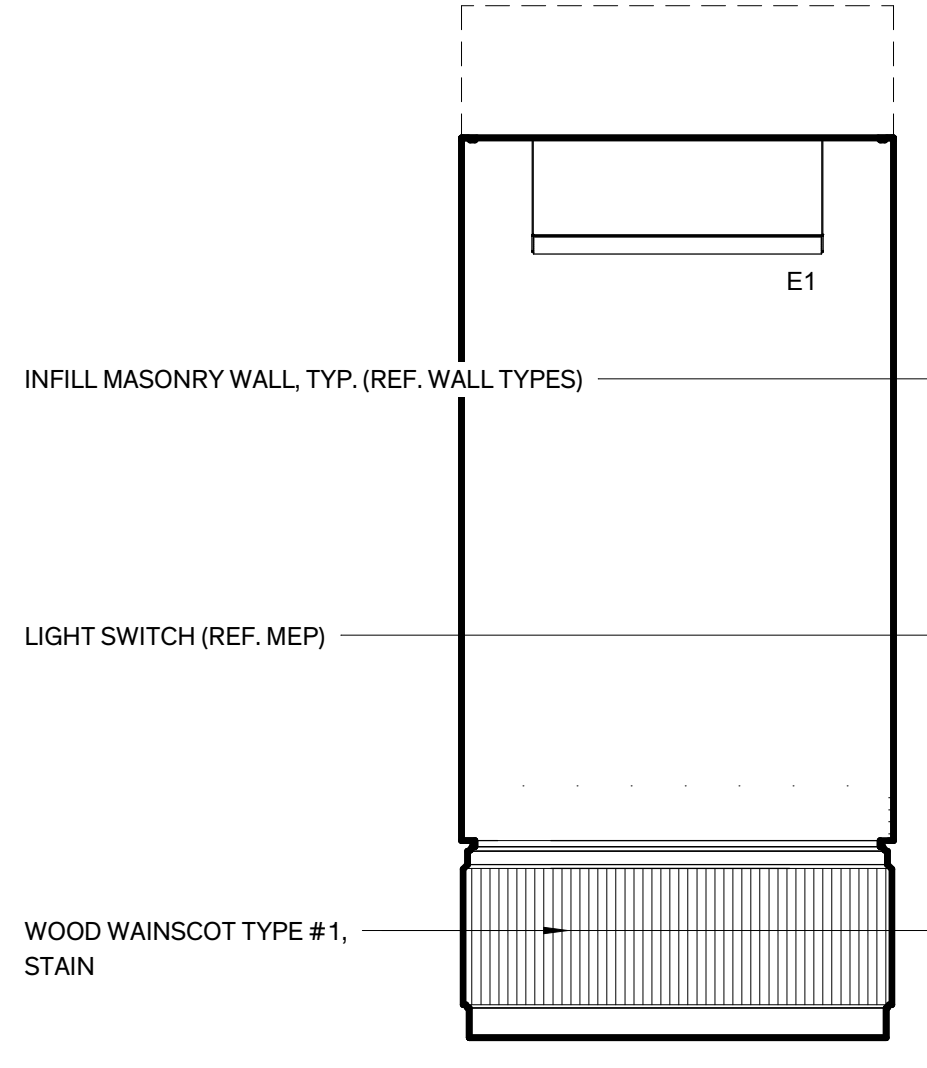


6 211 Vestibule - South  
 3/8" = 1'-0"

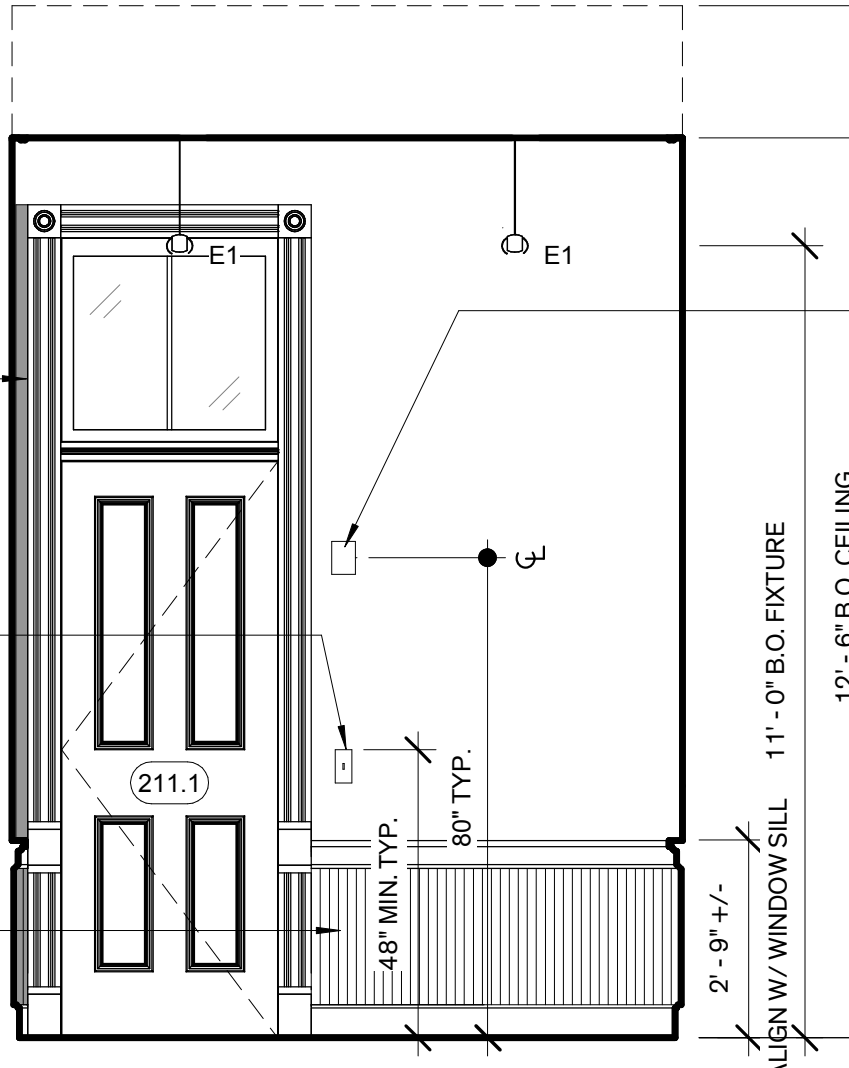


5 211 Vestibule - East  
 3/8" = 1'-0"

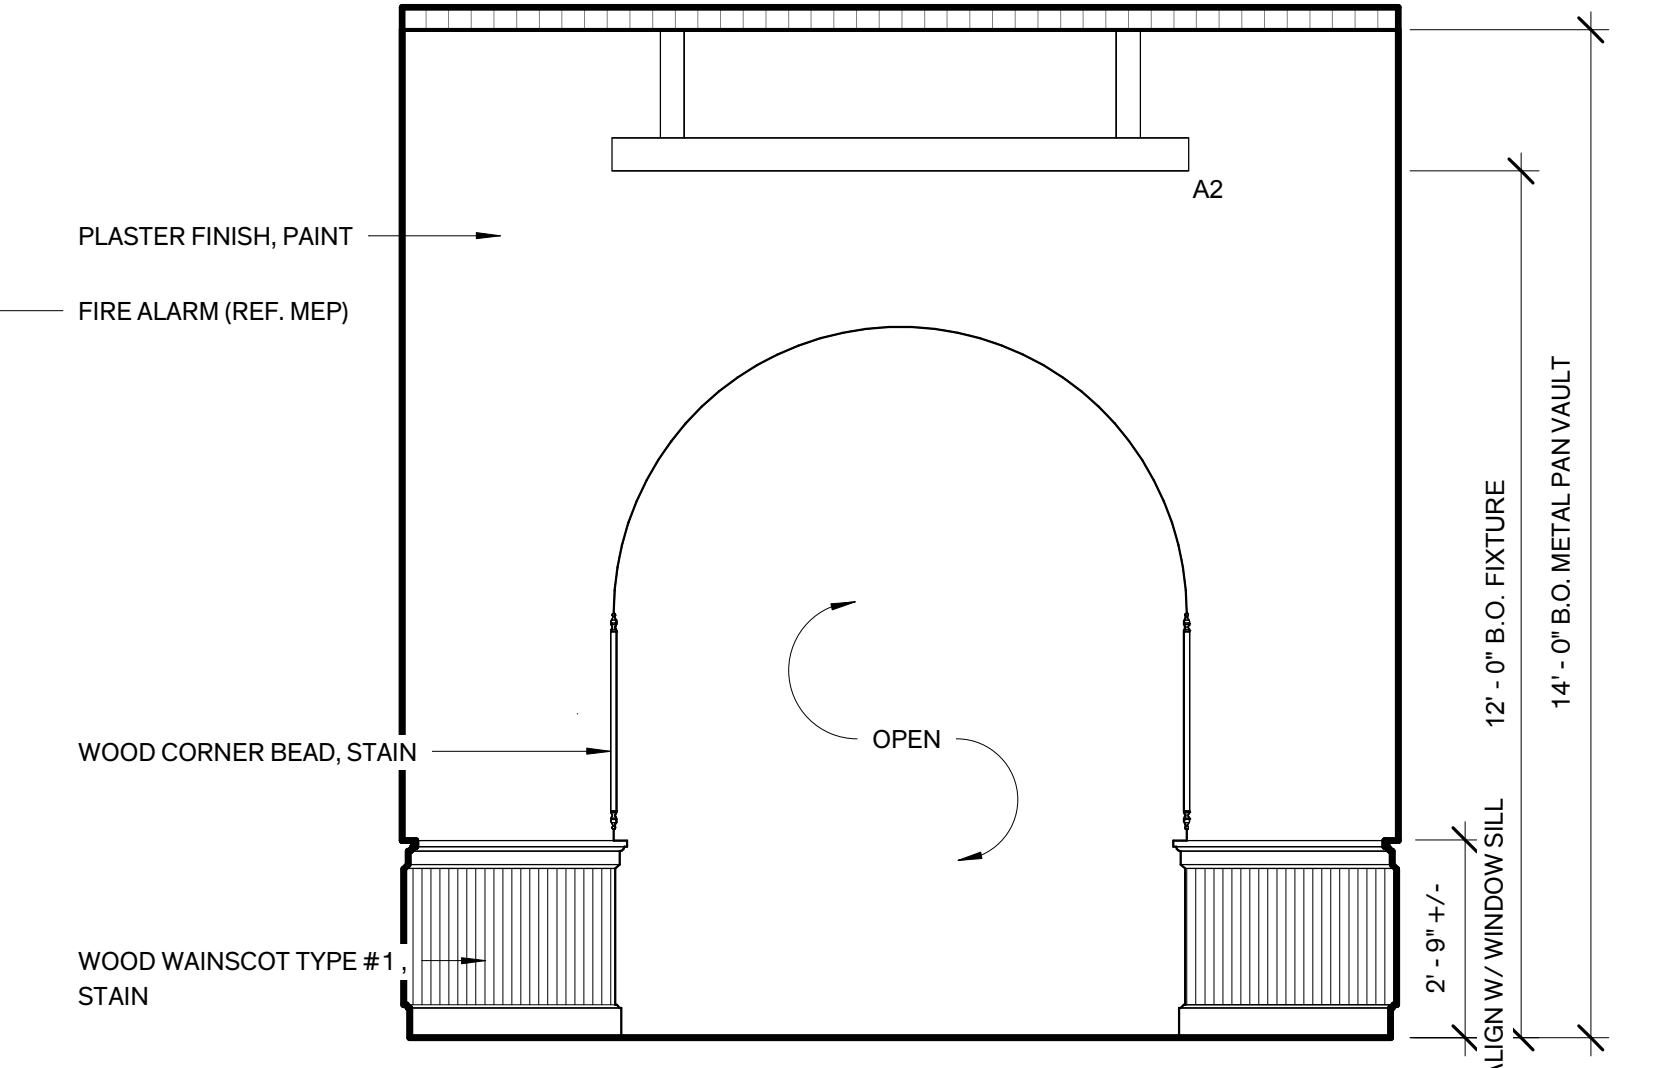


4 209 South Corridor - North  
 3/8" = 1'-0"

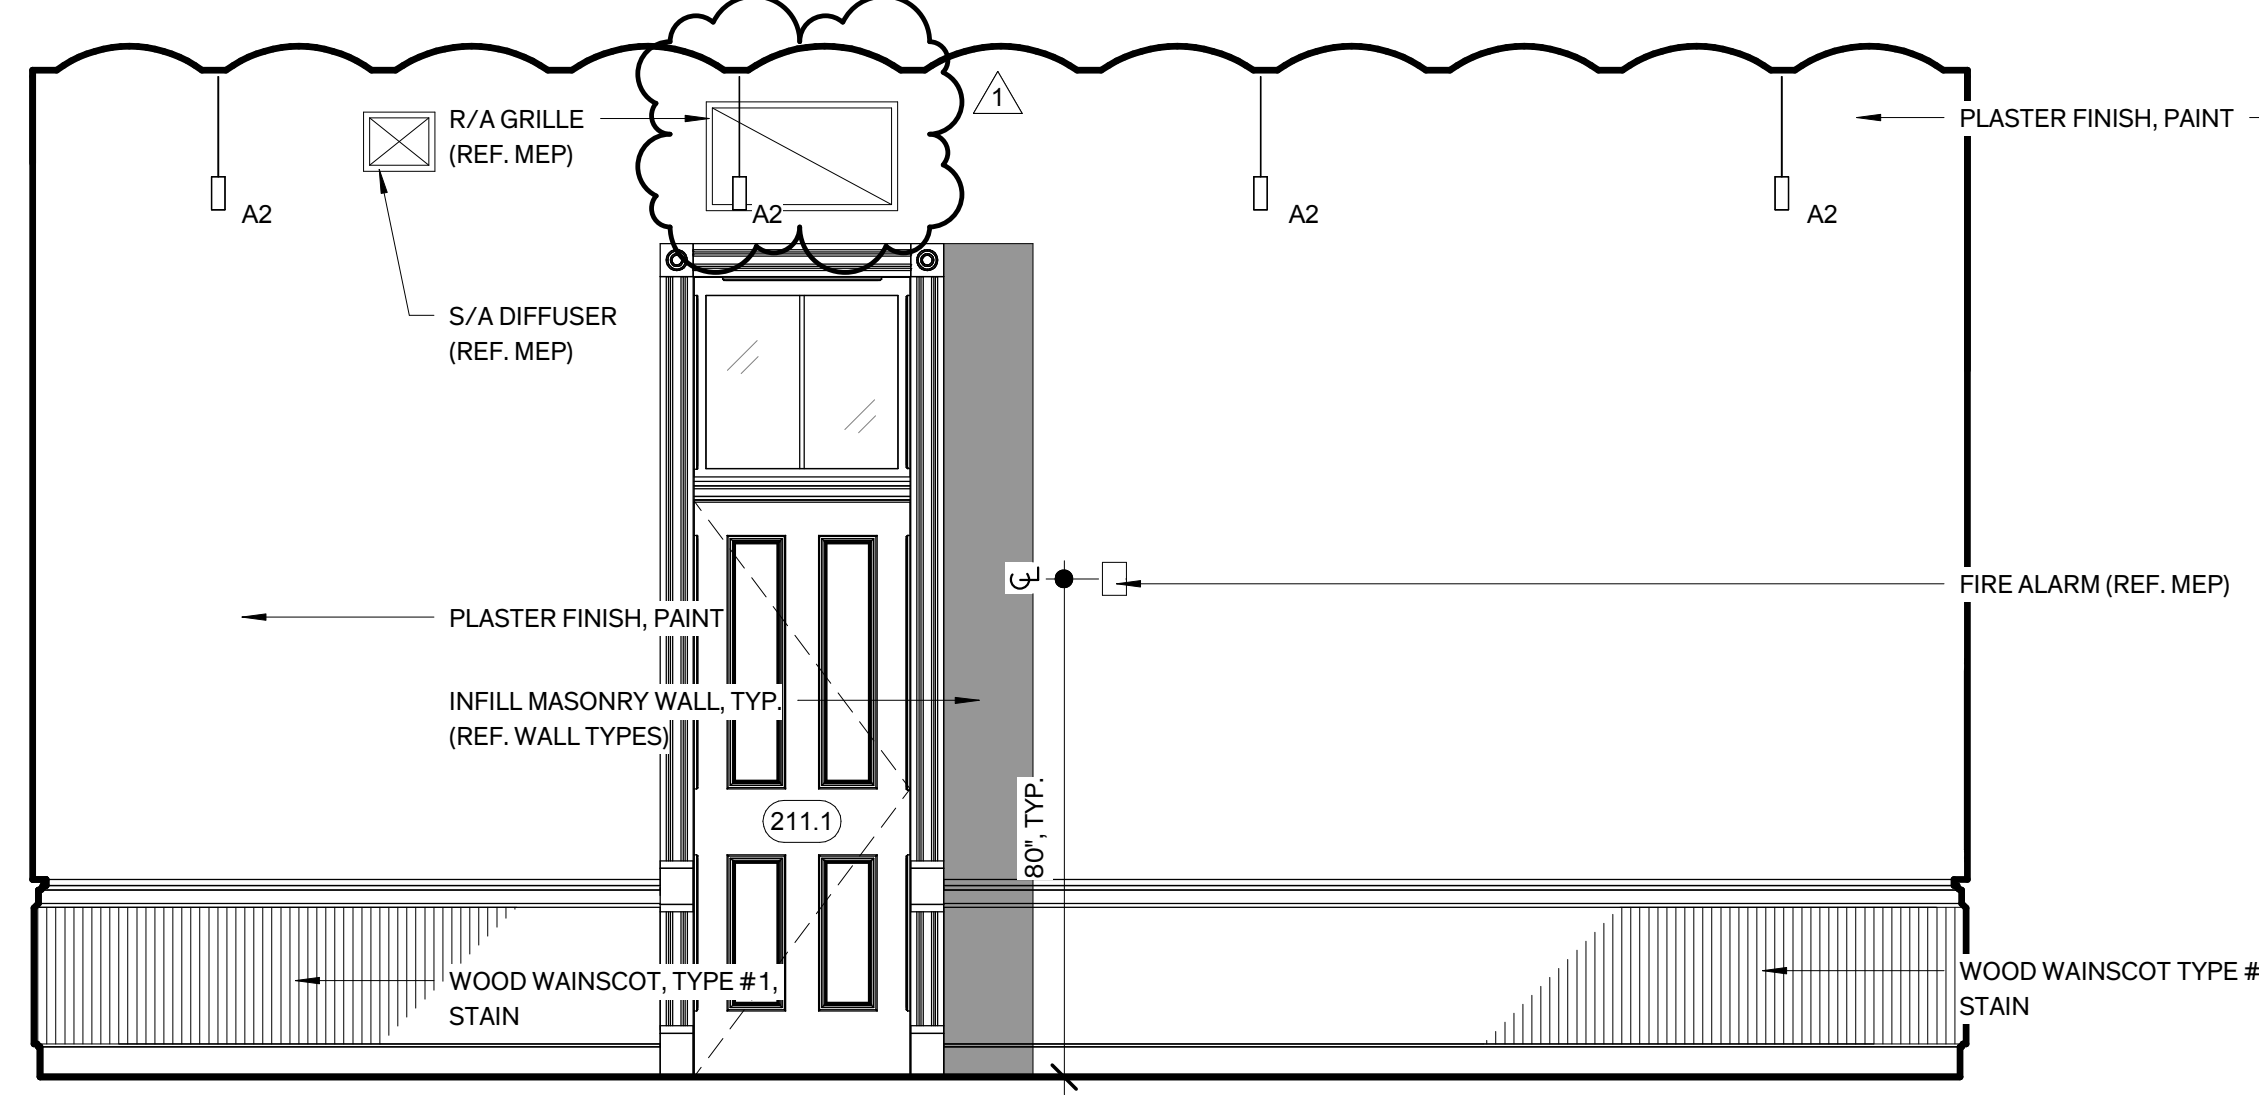

3 209 South Corridor - West  
 3/8" = 1'-0"

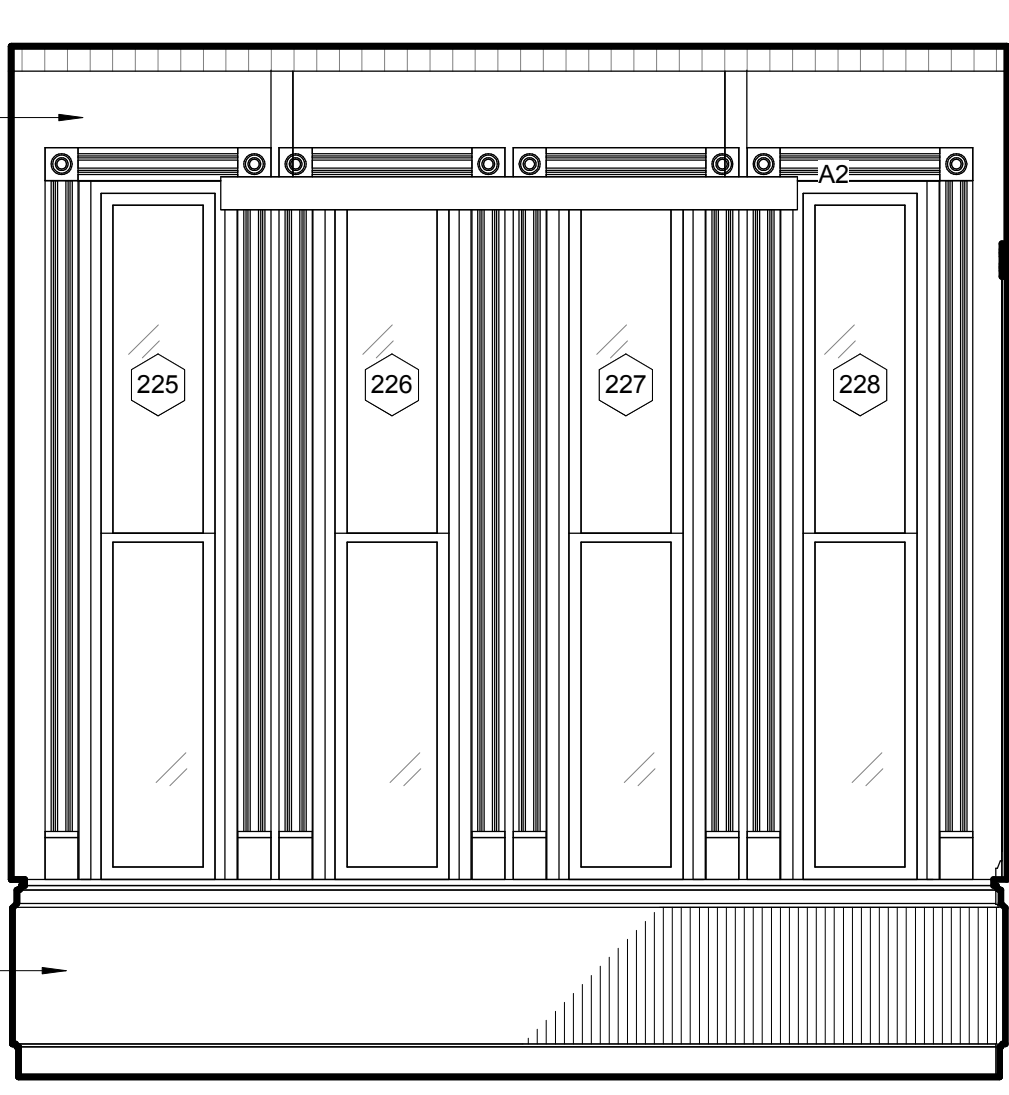

2 209 South Corridor - South  
 3/8" = 1'-0"

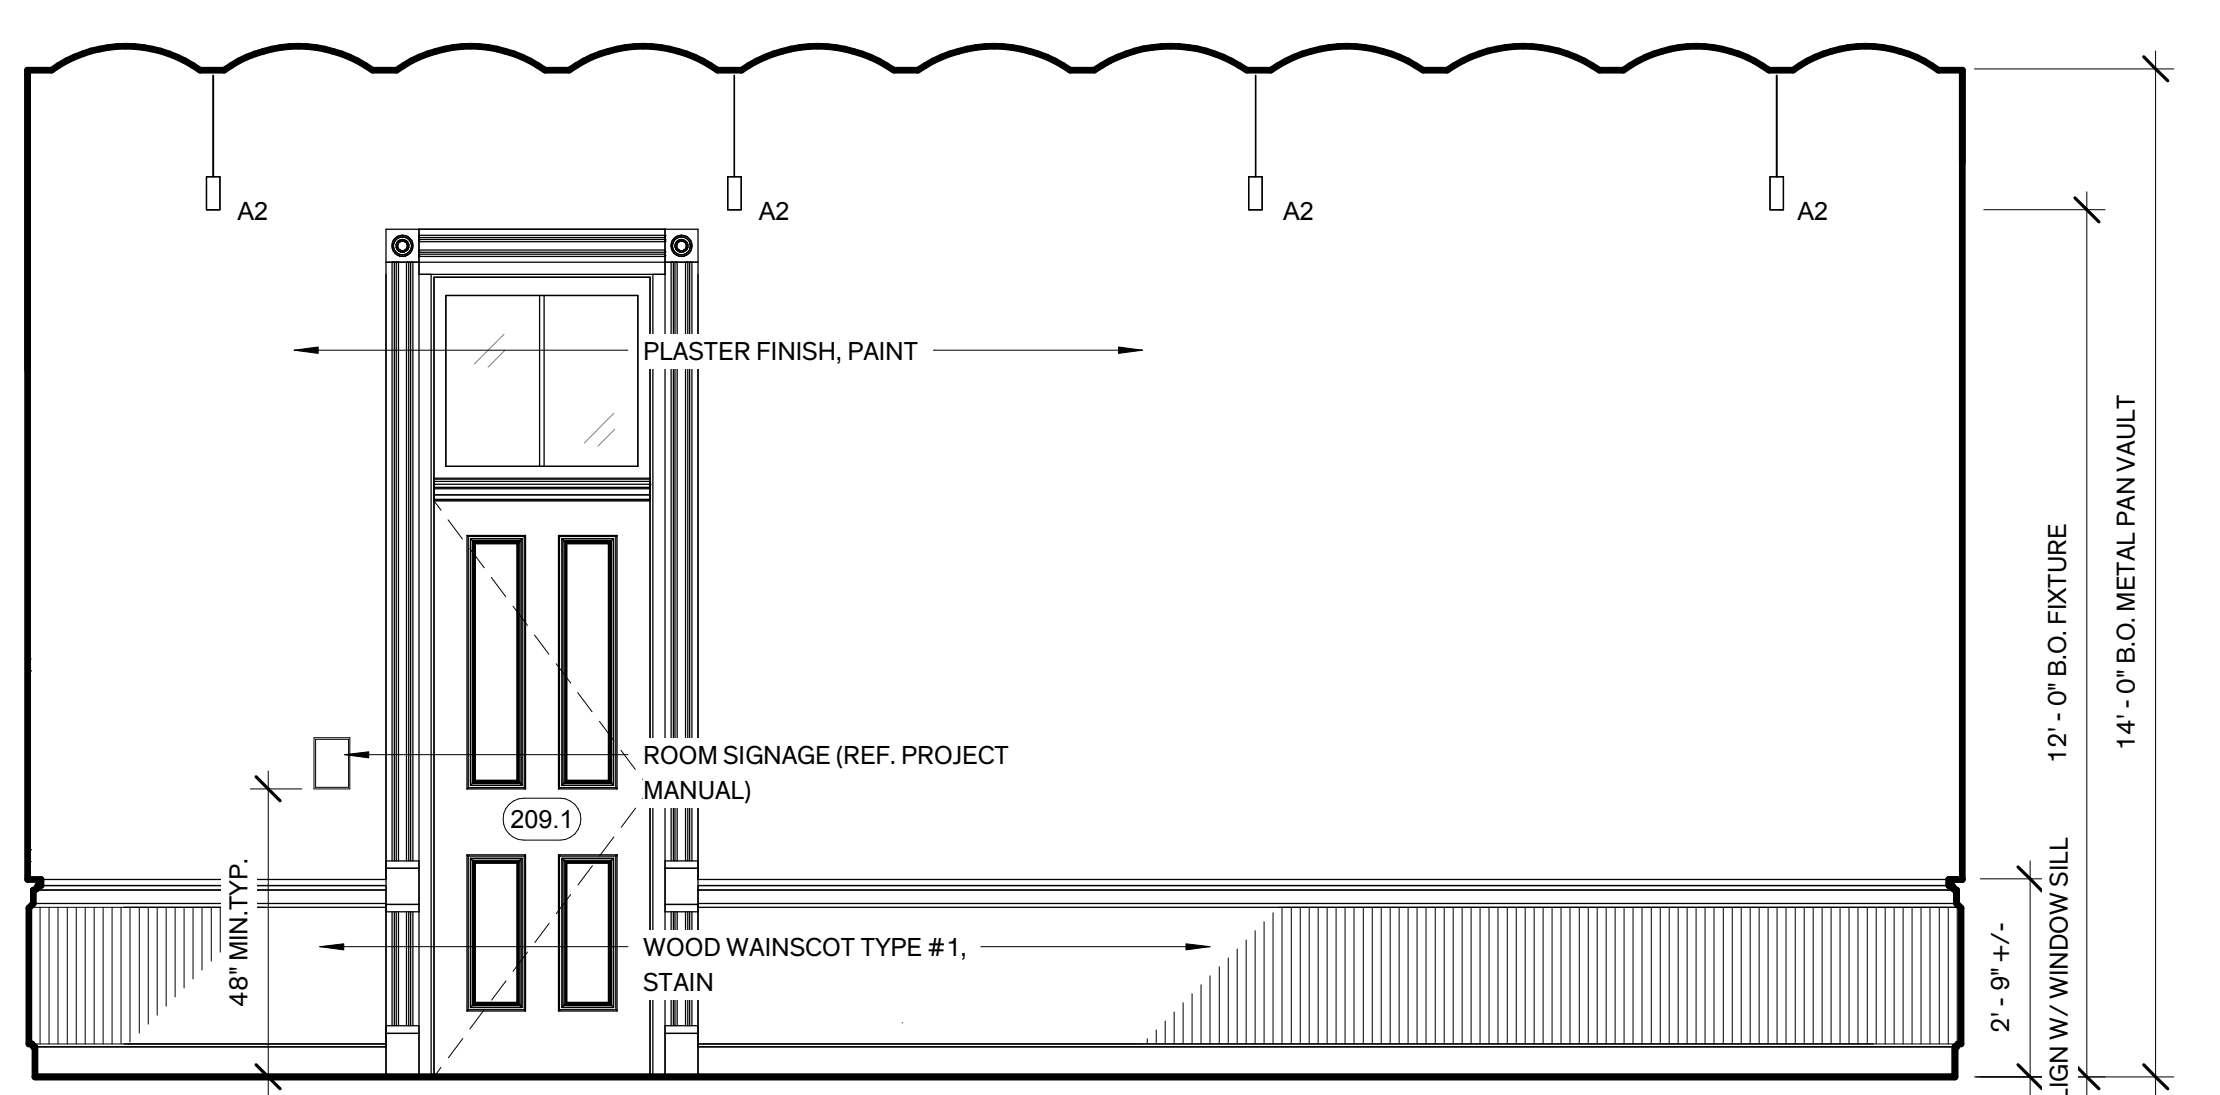

1 209 South Corridor - East  
 3/8" = 1'-0"



FANNIN COUNTY  
 COURTHOUSE  
 INTERIOR & EXTERIOR RESTORATION

101 E. Sam Rayburn Drive  
 Bonham, Texas 75418

**COPYRIGHT**  
 The Contractor shall verify and be responsible for all dimensions. DO NOT scale the drawing. Any errors or omissions shall be reported to Architexas without delay. The Copyrights to all designs and drawings are the property of Architexas. Reproduction or use for any purpose other than that authorized by Architexas is forbidden.

**REVISION HISTORY**  
 1 Oct. 16, 2018 Addendum #1

ISSUED FOR CONSTRUCTION




#18326 9/21/2018


Architexas No. 1737 Date SEPT. 21, 2018

Sheet Name INTERIOR ELEVATIONS - SECOND LEVEL


Sheet Number A4.II

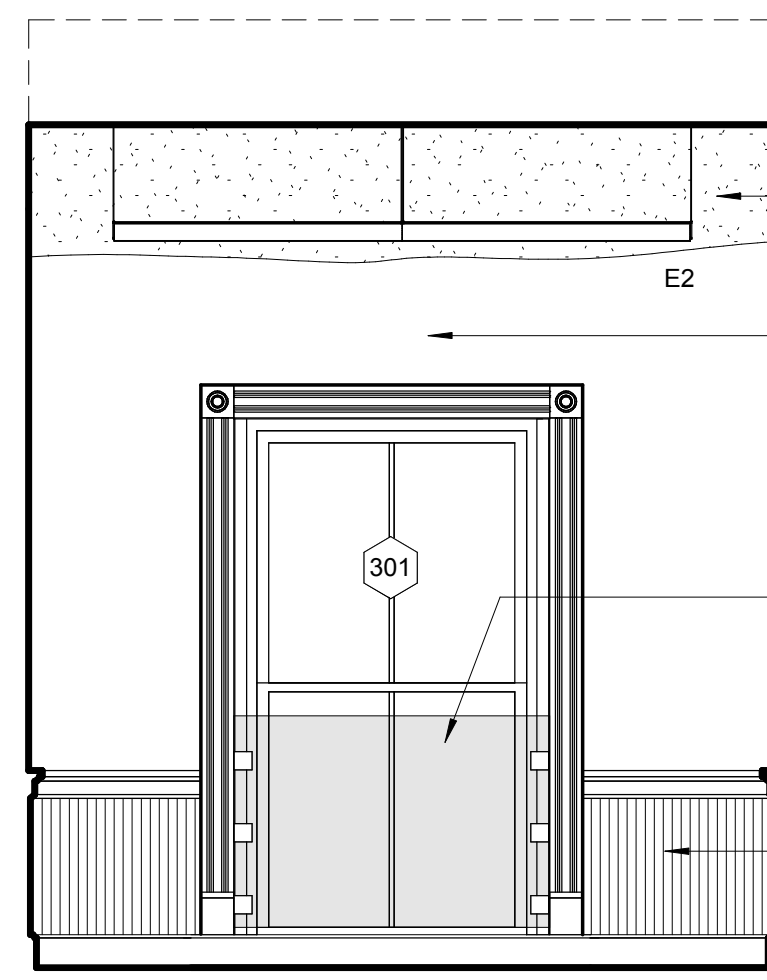


12 301 Purchasing - North  
 3/8" = 1'-0"

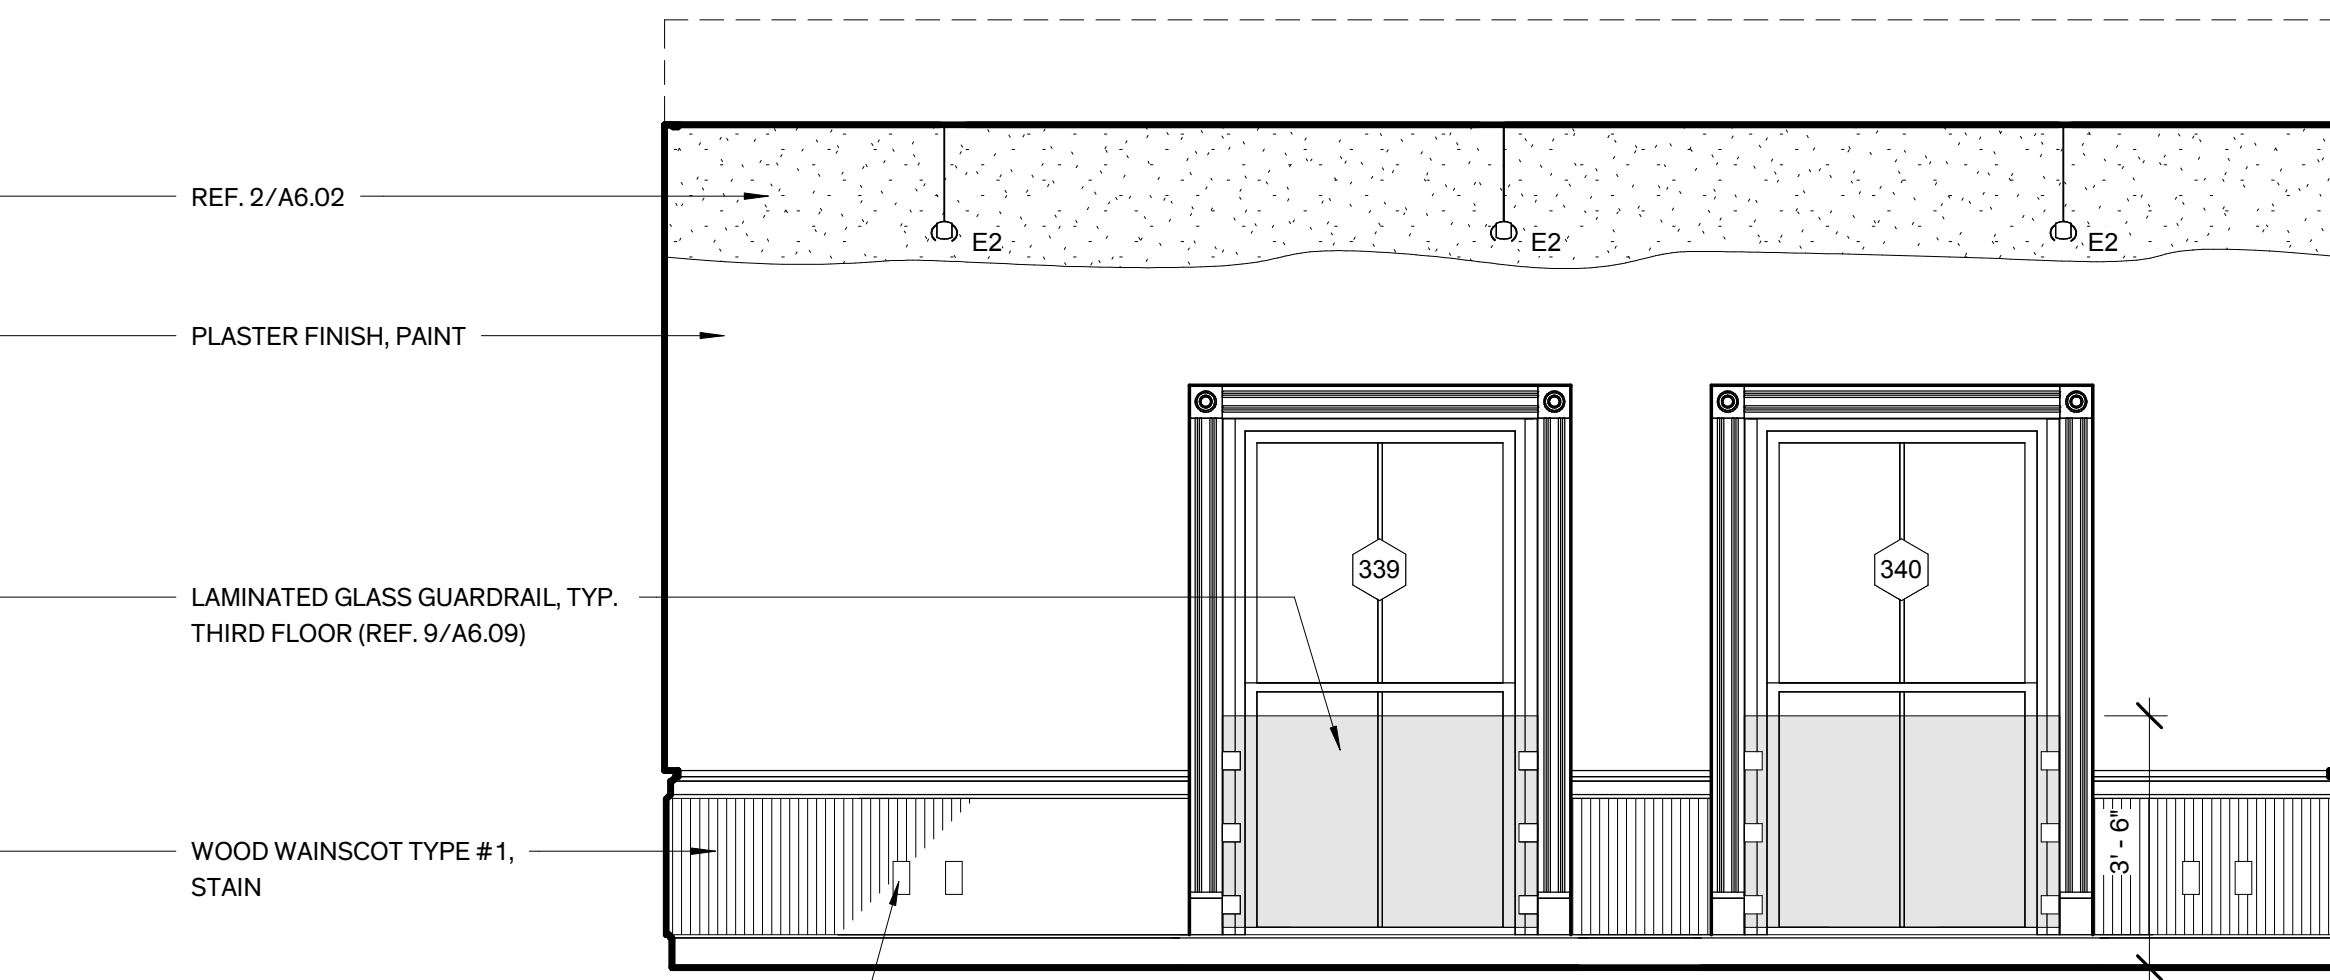


11 301 Purchasing - West  
 3/8" = 1'-0"

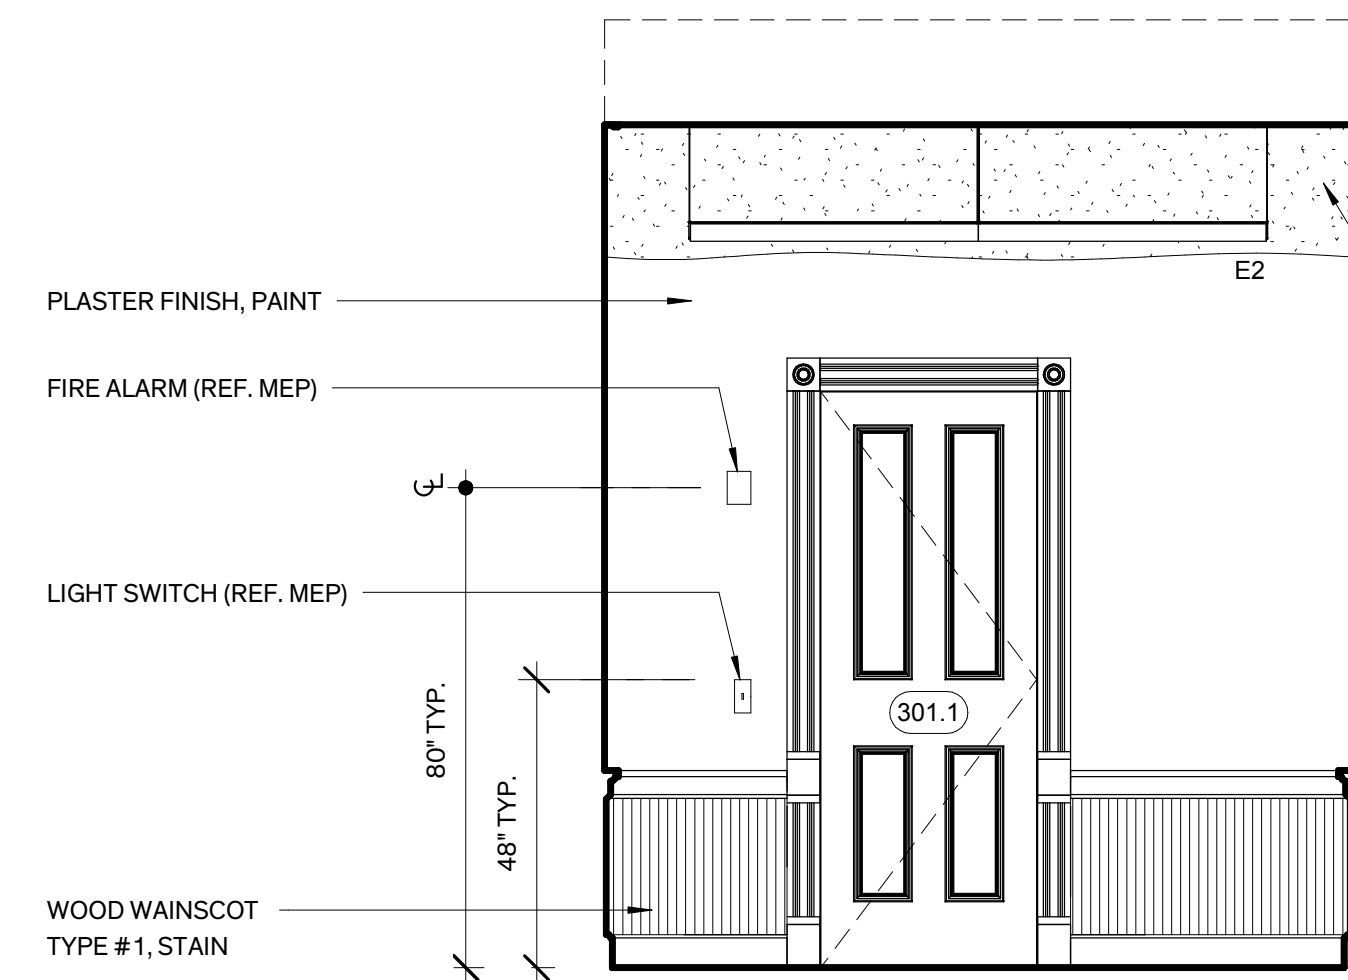


10 301 Purchasing - South  
 3/8" = 1'-0"

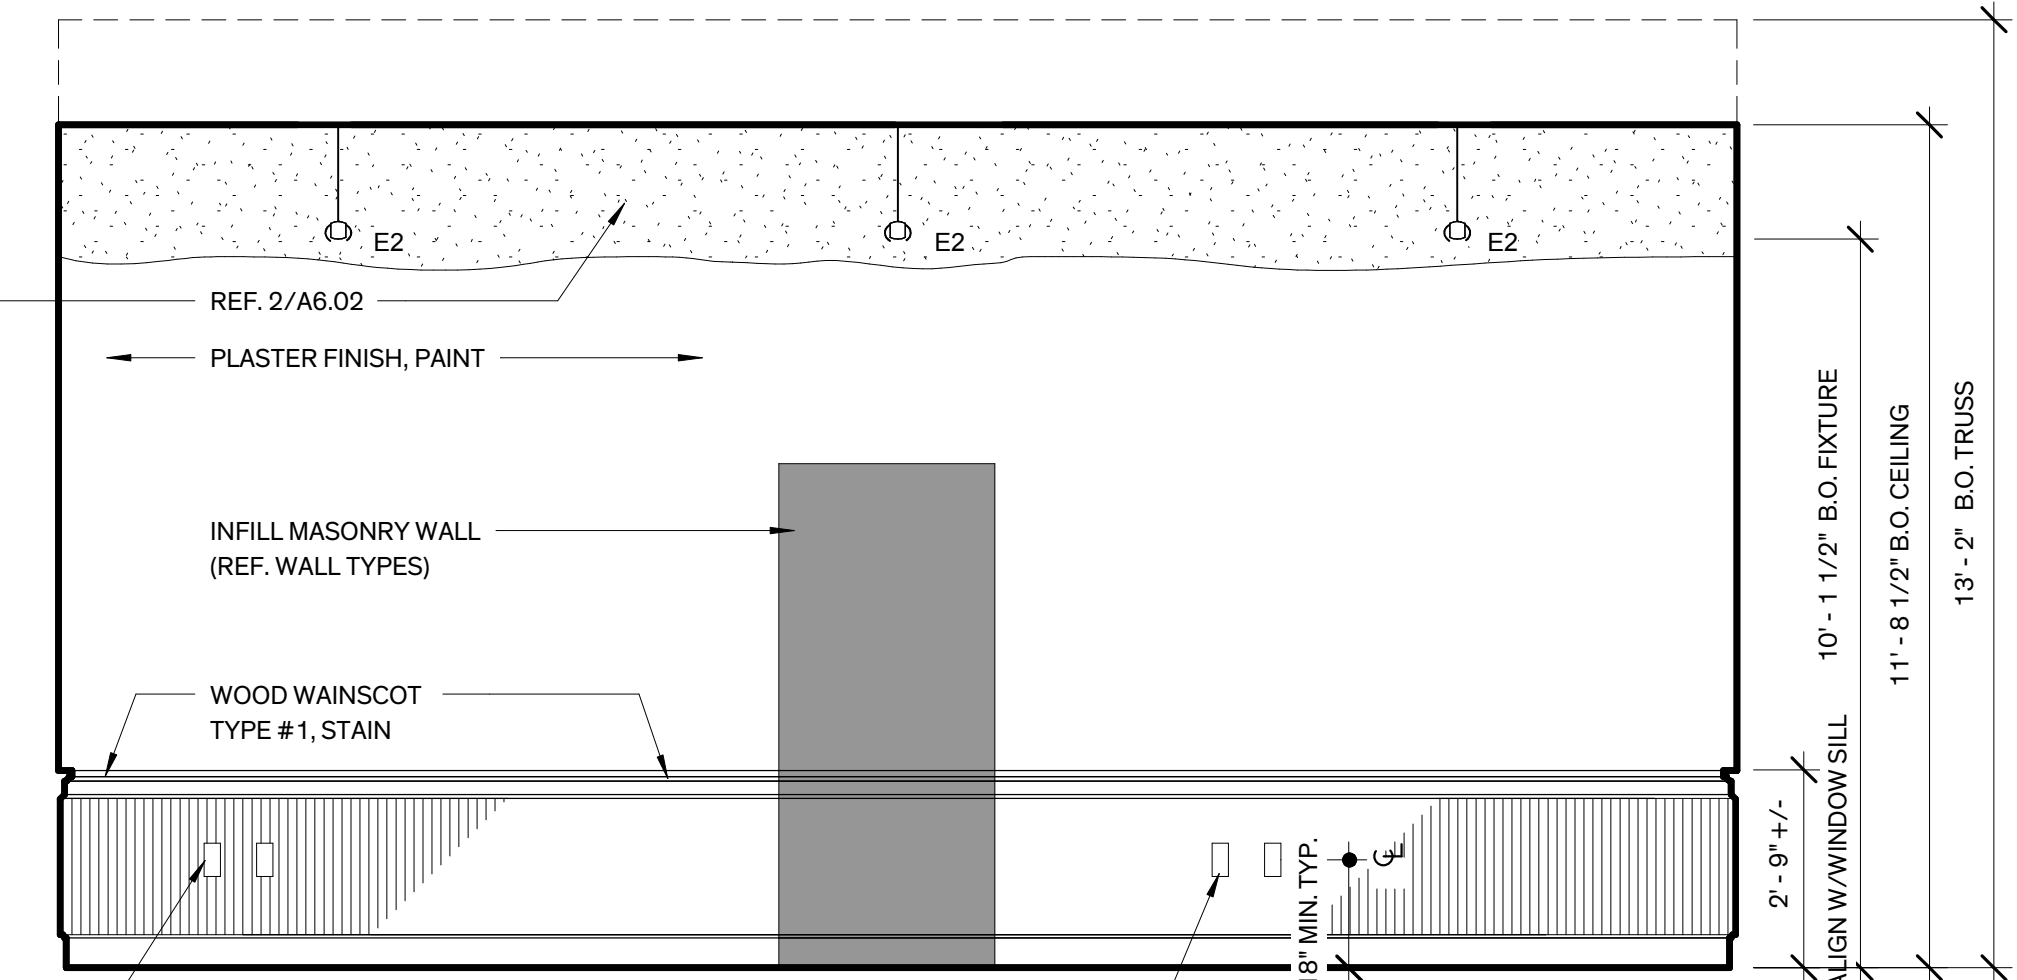


9 301 Purchasing - East  
 3/8" = 1'-0"

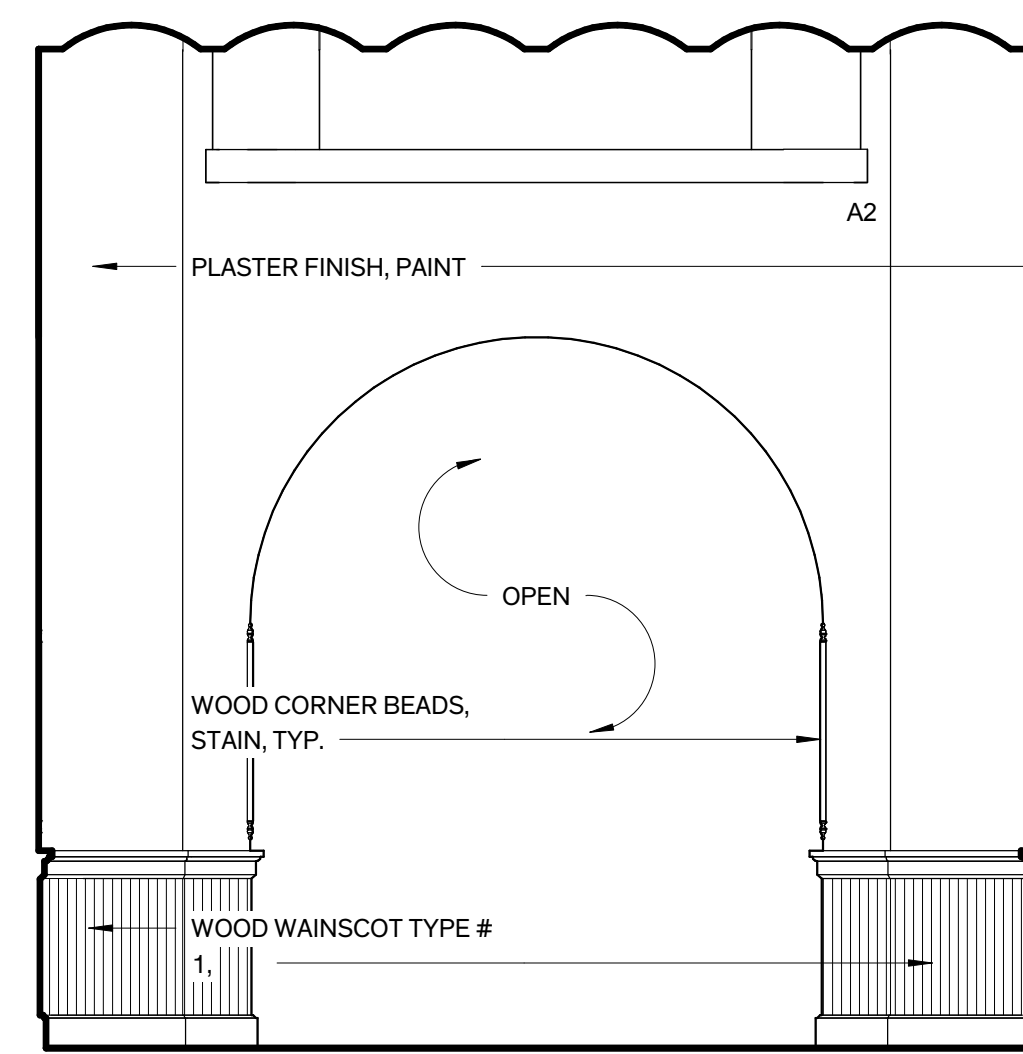


8 218 Central Corridor - North  
 3/8" = 1'-0"

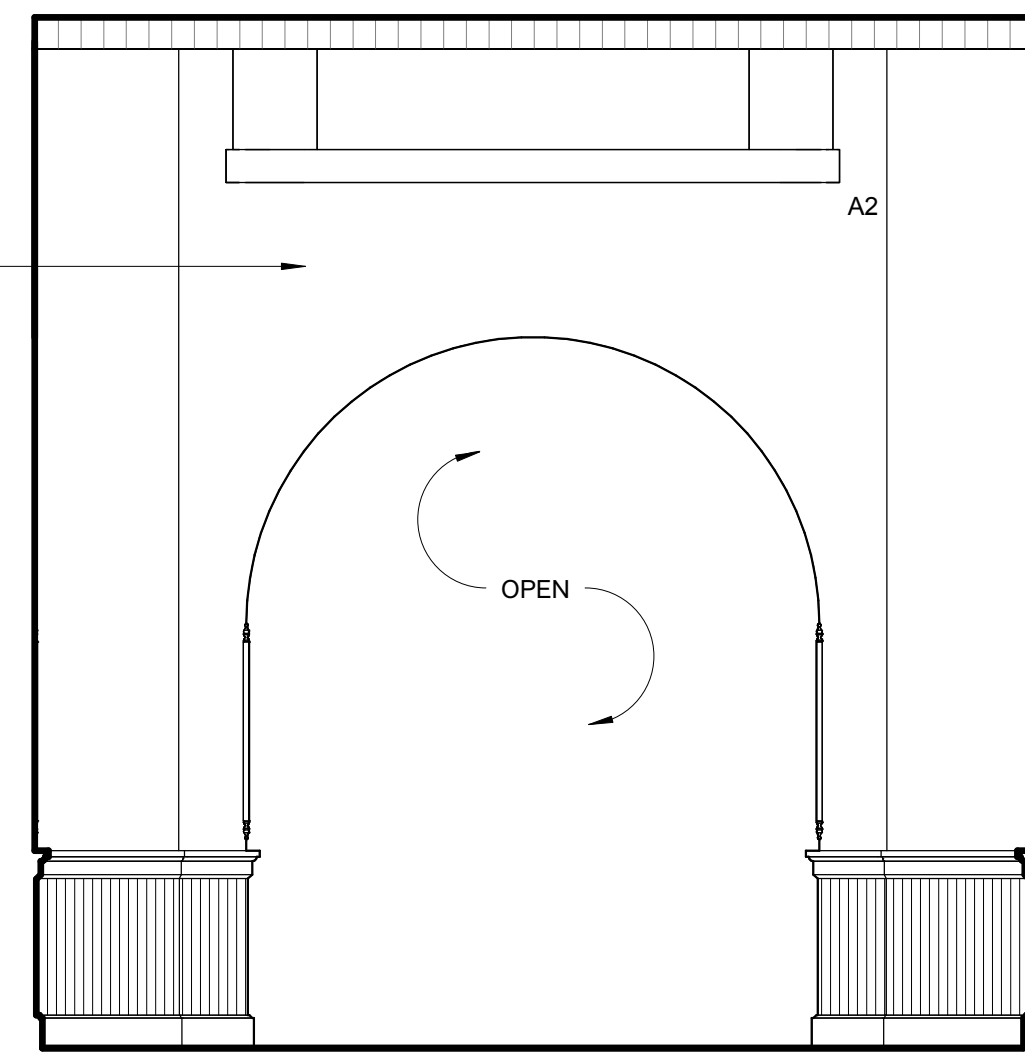


7 218 Central Corridor - West  
 3/8" = 1'-0"

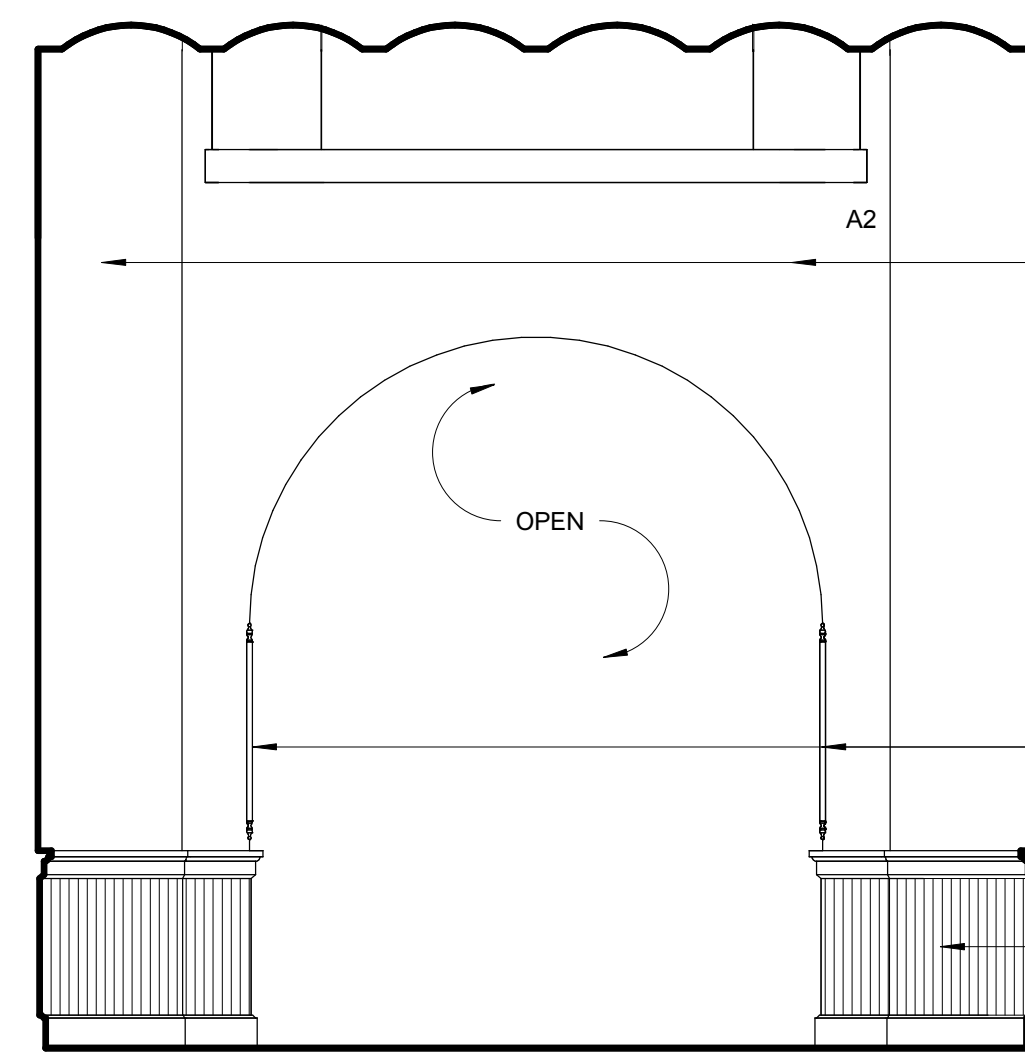


6 218 Central Corridor - South  
 3/8" = 1'-0"

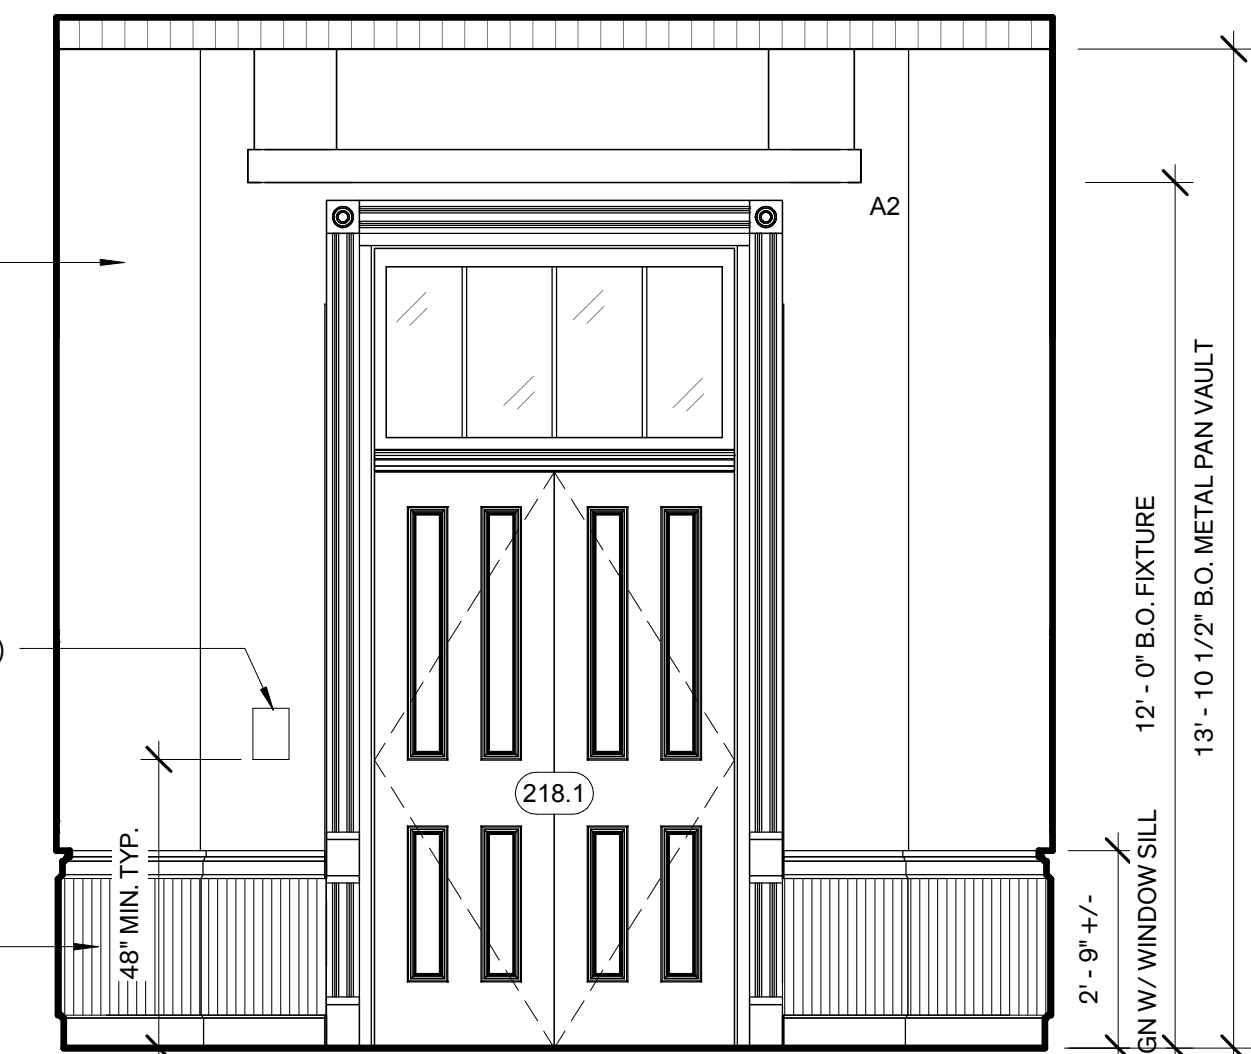


5 218 Central Corridor - East  
 3/8" = 1'-0"

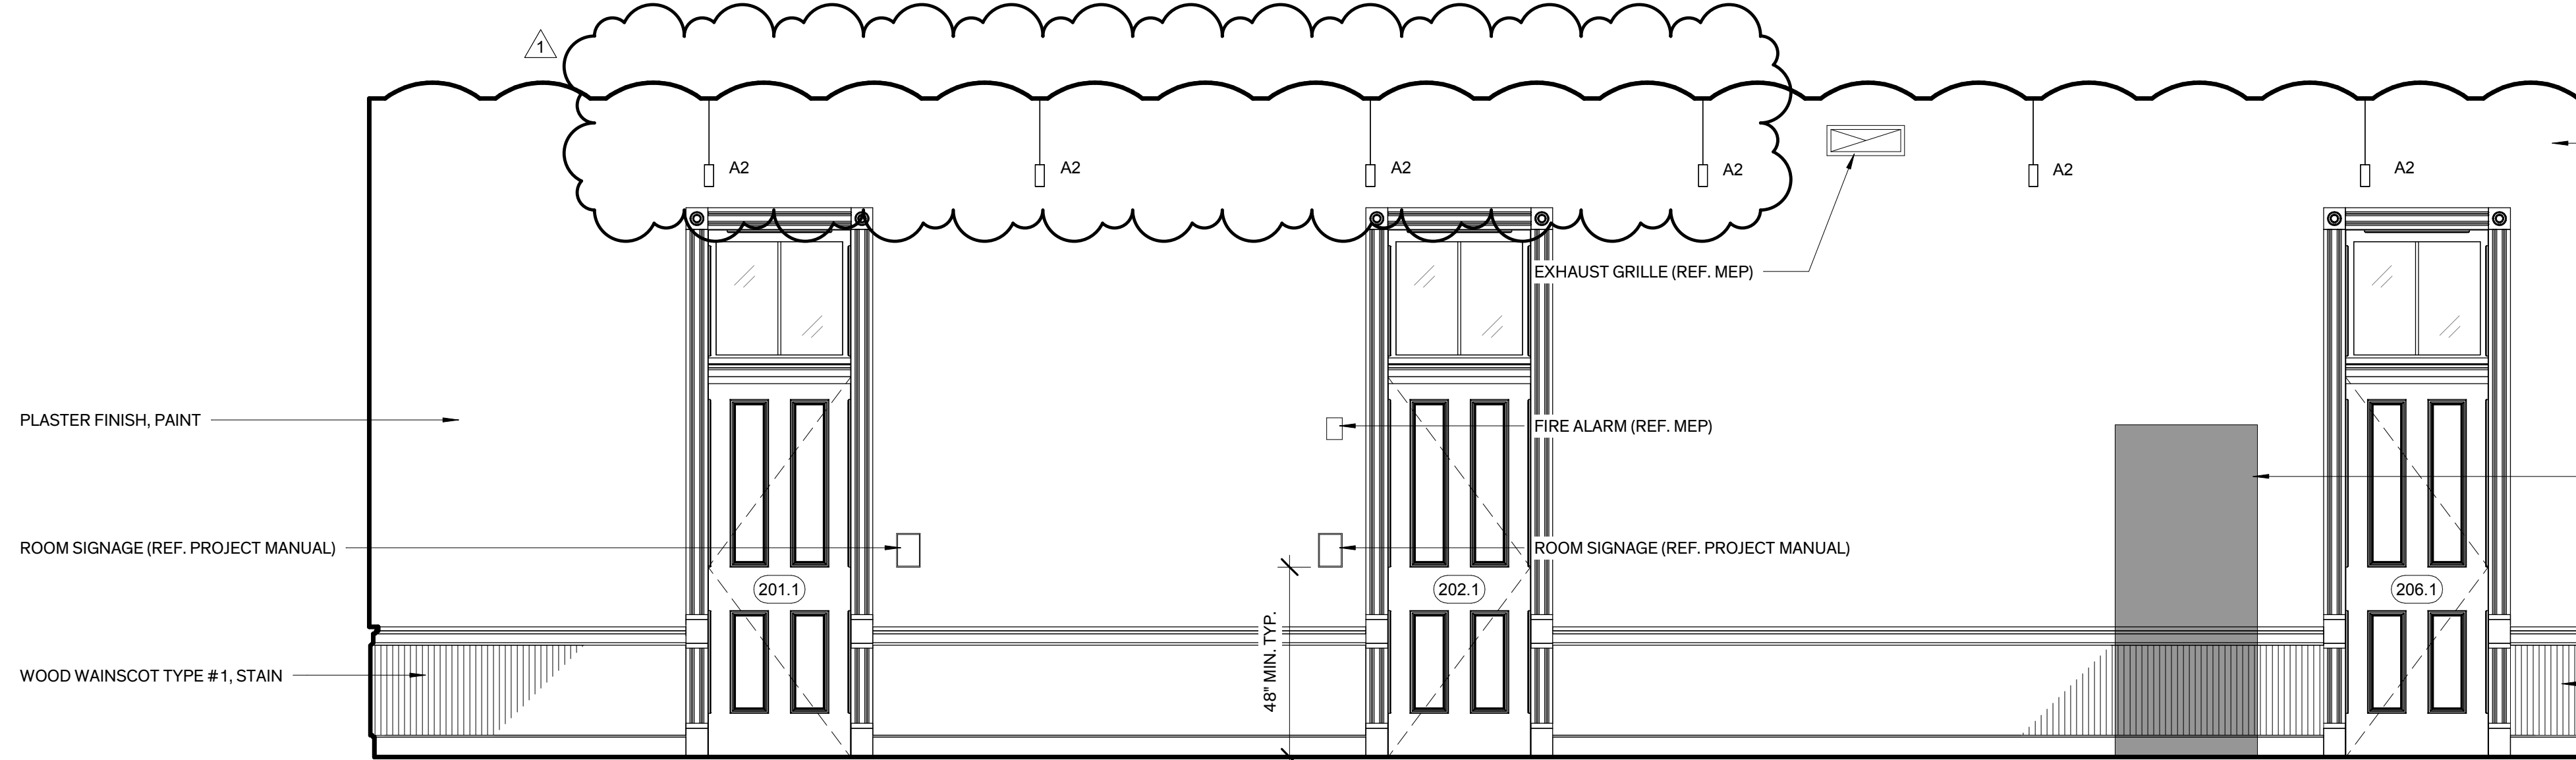


4 217 West Corridor - North  
 3/8" = 1'-0"

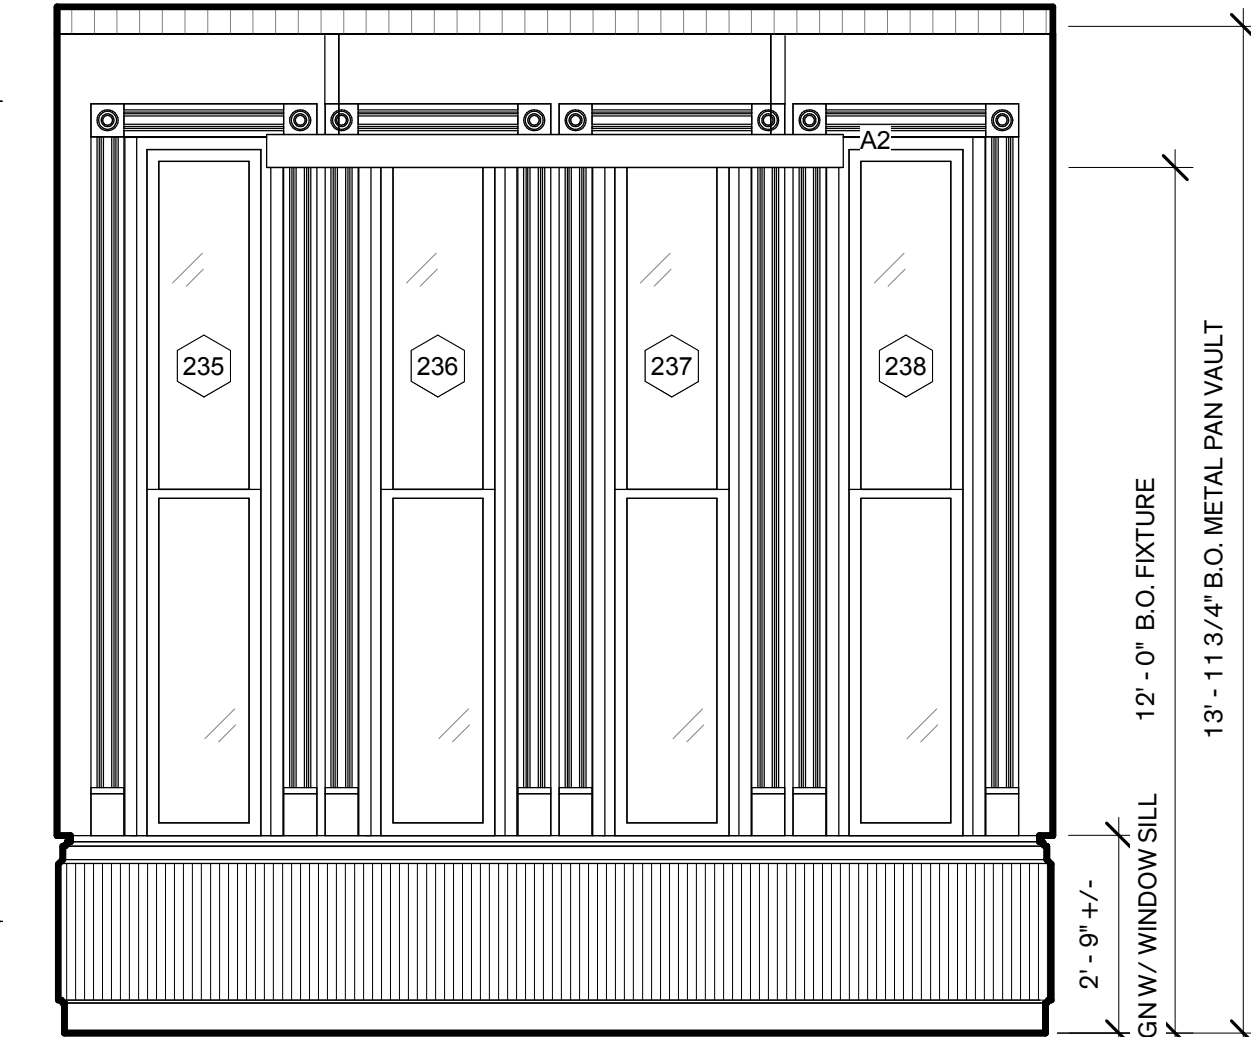

3 217 West Corridor - West  
 3/8" = 1'-0"

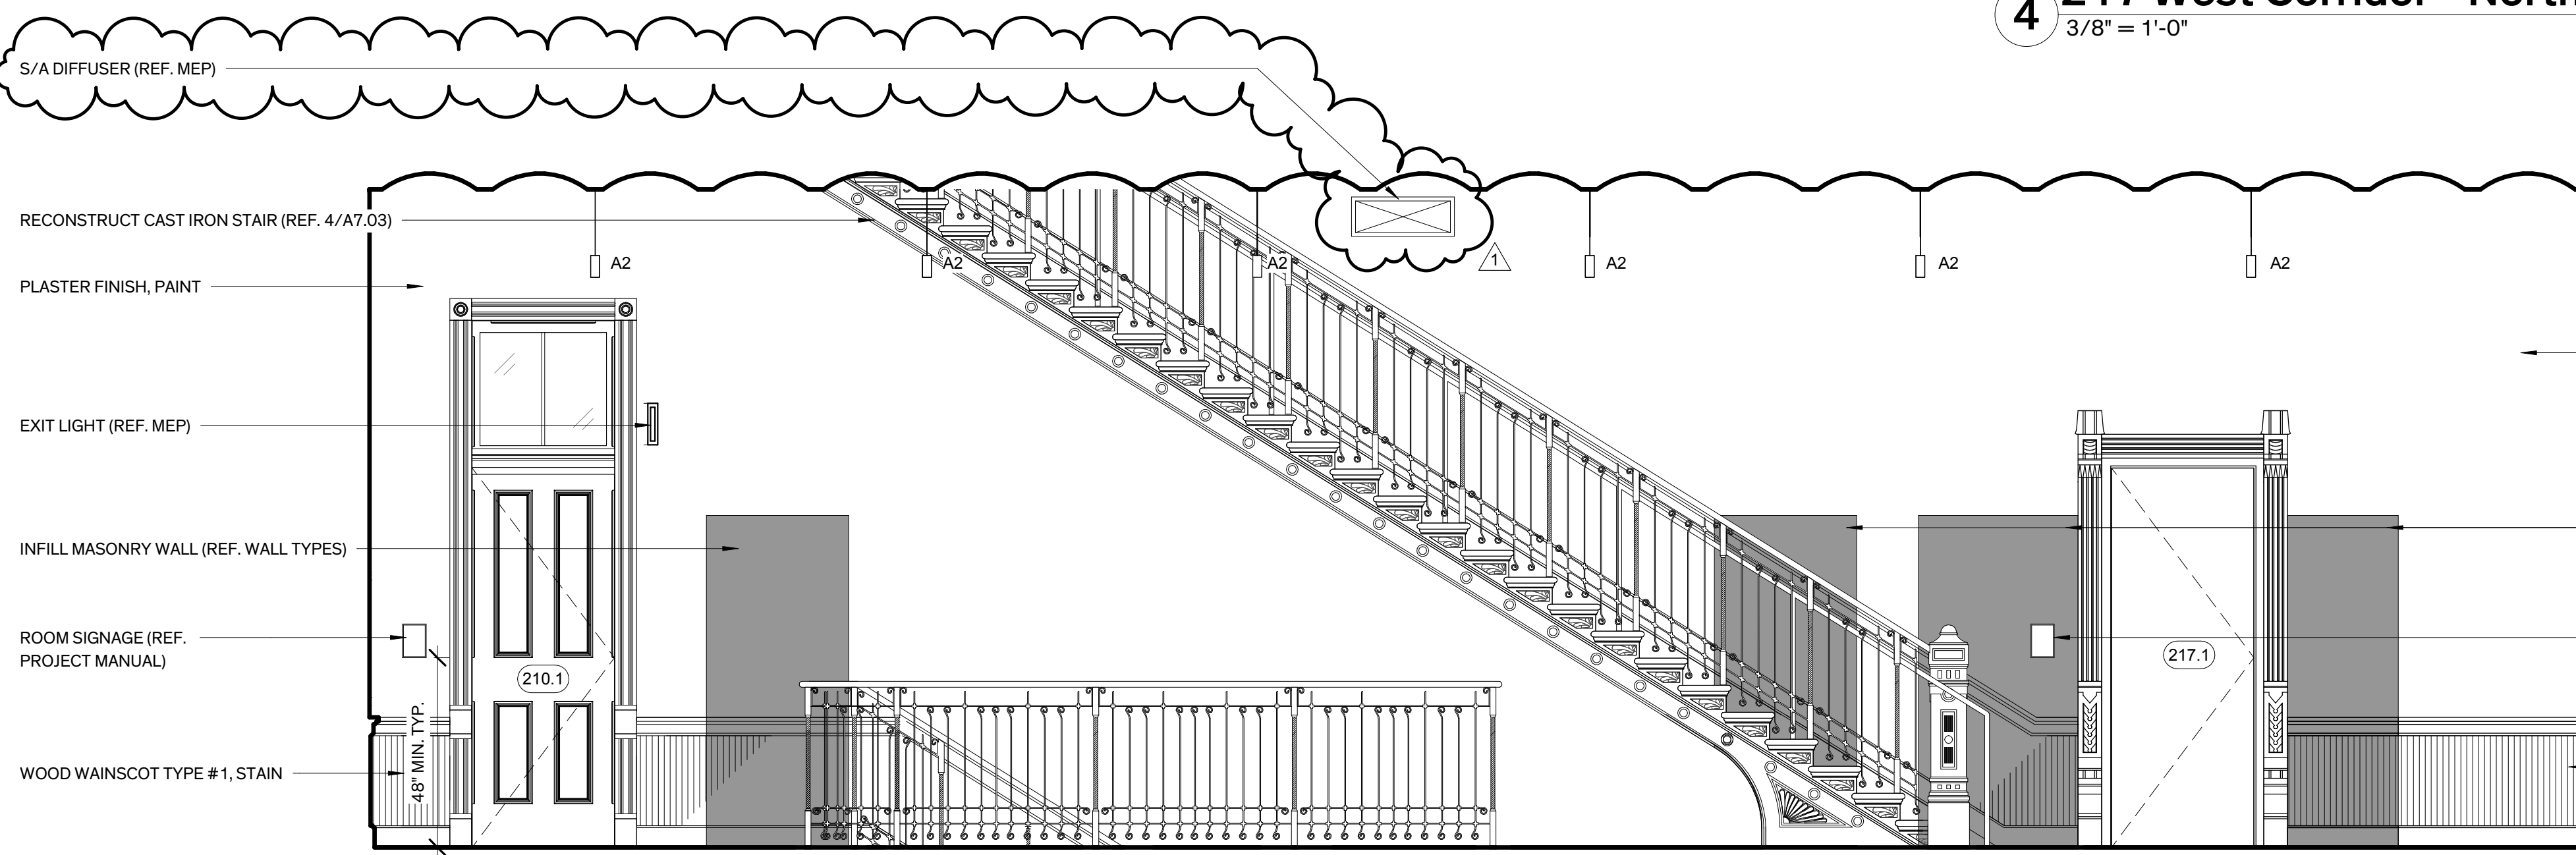

2 217 West Corridor - South  
 3/8" = 1'-0"

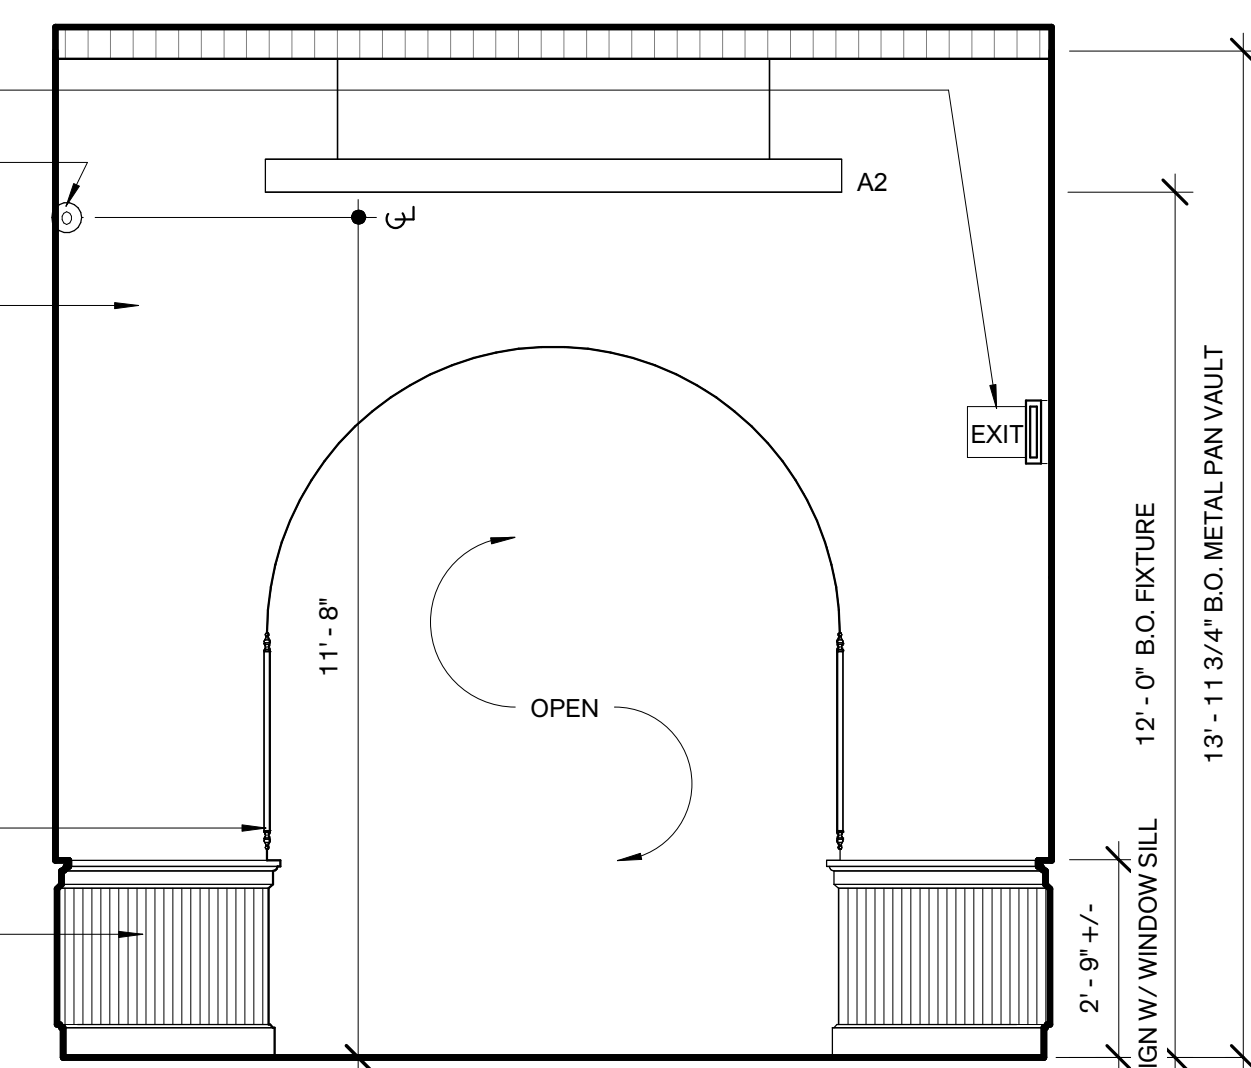

1 217 West Corridor - East  
 3/8" = 1'-0"



FANNIN COUNTY COURTHOUSE  
 INTERIOR & EXTERIOR RESTORATION

101 E. Sam Rayburn Drive  
 Bonham, Texas 75418

**COPYRIGHT**  
 The Contractor shall verify and be responsible for all dimensions. DO NOT scale the drawing. Any errors or omissions shall be reported to Architexas without delay. The Copyrights to all designs and drawings are the property of Architexas. Reproduction or use for any purpose other than that authorized by Architexas is forbidden.

**REVISION HISTORY**  
 1 Oct. 16, 2018 Addendum #1

ISSUED FOR CONSTRUCTION



#18326 9/21/2018

Architexas No. 1737 Date SEPT. 21, 2018

Sheet Name INTERIOR ELEVATIONS - SECOND AND THIRD LEVEL

Sheet Number A4.13

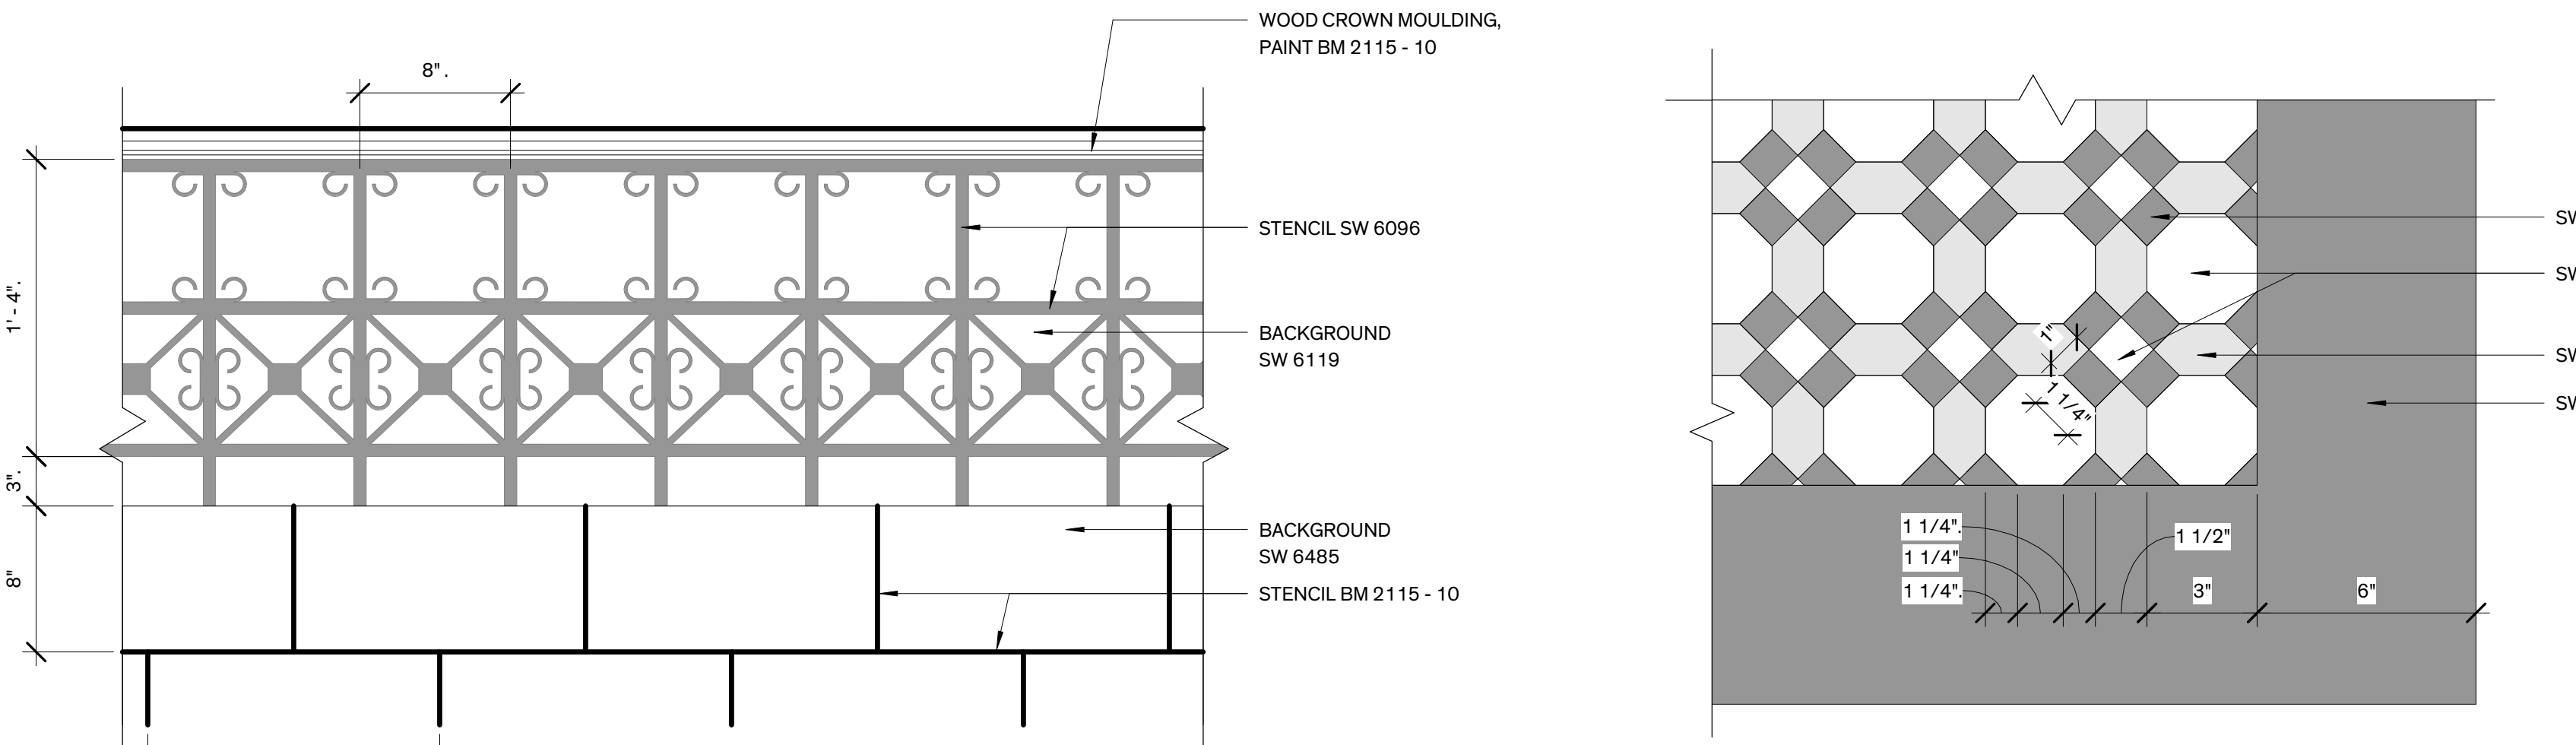


Table with 14 columns: ROOM #, ROOM NAME, FLOOR MATERIAL, FLOOR TYPE, BASE, WAINSCOT, WALL NORTH, EAST, SOUTH, WEST, CEILING MATERIAL, CEILING TYPE, CEILING HT. (V./F), REMARKS. Rows include PURCHASING, COUNTY TREASURER'S ASST., IT CLOSET, COUNTY TREASURER, ELEVATOR VESTIBULE, NORTH CORRIDOR, SOUTH CORRIDOR, STAIR, VESTIBULE, RESTROOM, COUNTY AUDITOR, COUNTY AUDITOR ASST., WEST CORRIDOR, CENTRAL CORRIDOR.

Table with 14 columns: ROOM #, ROOM NAME, FLOOR MATERIAL, FLOOR TYPE, BASE, WAINSCOT, WALL NORTH, EAST, SOUTH, WEST, CEILING MATERIAL, CEILING TYPE, CEILING HT. (V./F), REMARKS. Rows include COURT REPORTER, CONFERENCE/JURY ROOM, JURY BREAK ROOM, JURY RESTROOM, ELEVATOR VESTIBULE, NORTH CORRIDOR, COURTRROOM, SOUTH CORRIDOR, STAIR, VESTIBULE, RESTROOM, COUNTY JUDGE, RESTROOM, JUDGE ASST., VESTIBULE, WEST CORRIDOR, CENTRAL CORRIDOR.

Table with 14 columns: ROOM #, ROOM NAME, FLOOR MATERIAL, FLOOR TYPE, BASE, WAINSCOT, WALL NORTH, EAST, SOUTH, WEST, CEILING MATERIAL, CEILING TYPE, CEILING HT. (V./F), REMARKS. Rows include JP, JP CLERKS, IT CLOSET, JP CLERKS, ELEVATOR VESTIBULE, NORTH CORRIDOR, BALIFF, AV, JUDGE'S ASST., COUNTY COURT AT LAW JUDGE, EAST CORRIDOR, JURY ROOM, JP/COUNTY COURT AT LAW COURTRROOM, SOUTH CORRIDOR, STAIR, COMMISSIONER ASST., COMMISSIONER CONFERENCE ROOM, ATTORNEY CONFERENCE ROOM, WEST CORRIDOR, CENTRAL CORRIDOR.

Table with 14 columns: ROOM #, ROOM NAME, FLOOR MATERIAL, FLOOR TYPE, BASE, WAINSCOT, WALL NORTH, EAST, SOUTH, WEST, CEILING MATERIAL, CEILING TYPE, CEILING HT. (V./F), REMARKS. Rows include MECH., BREAK ROOM, STAIR, CORRIDOR, ELEVATOR CONTROL CLOSET, MECH., MECH., MECH., MEN, ELEVATOR VESTIBULE, ENTRY, WOMEN.




2 Wall Stencil Pattern 1 1/2" = 1'-0"

1 Custom Sheet Flooring Pattern 3" = 1'-0"


GENERAL NOTES

- GENERAL: FINISHES LISTED WITH 'X' DESIGNATION ARE EXISTING. FINISH EXPOSED SURFACES UNLESS NOTED OTHERWISE... ELECTRICAL BOXES AND ASSOCIATED ELEMENTS MUST BE RECESSED INTO WALLS... DIMENSIONS AT WALLS IS FINISHED FACE OF WALL TO FINISHED FACE OF WALL UNLESS NOTED OTHERWISE... FLOORS: EXISTING CONCRETE FLOORING... WAINSCOT & INTERIOR MILLWORK... CEILING: EXISTING METAL PAN VAULT (TYPE 5)...

WAINSCOT PROFILE INTERSECTION

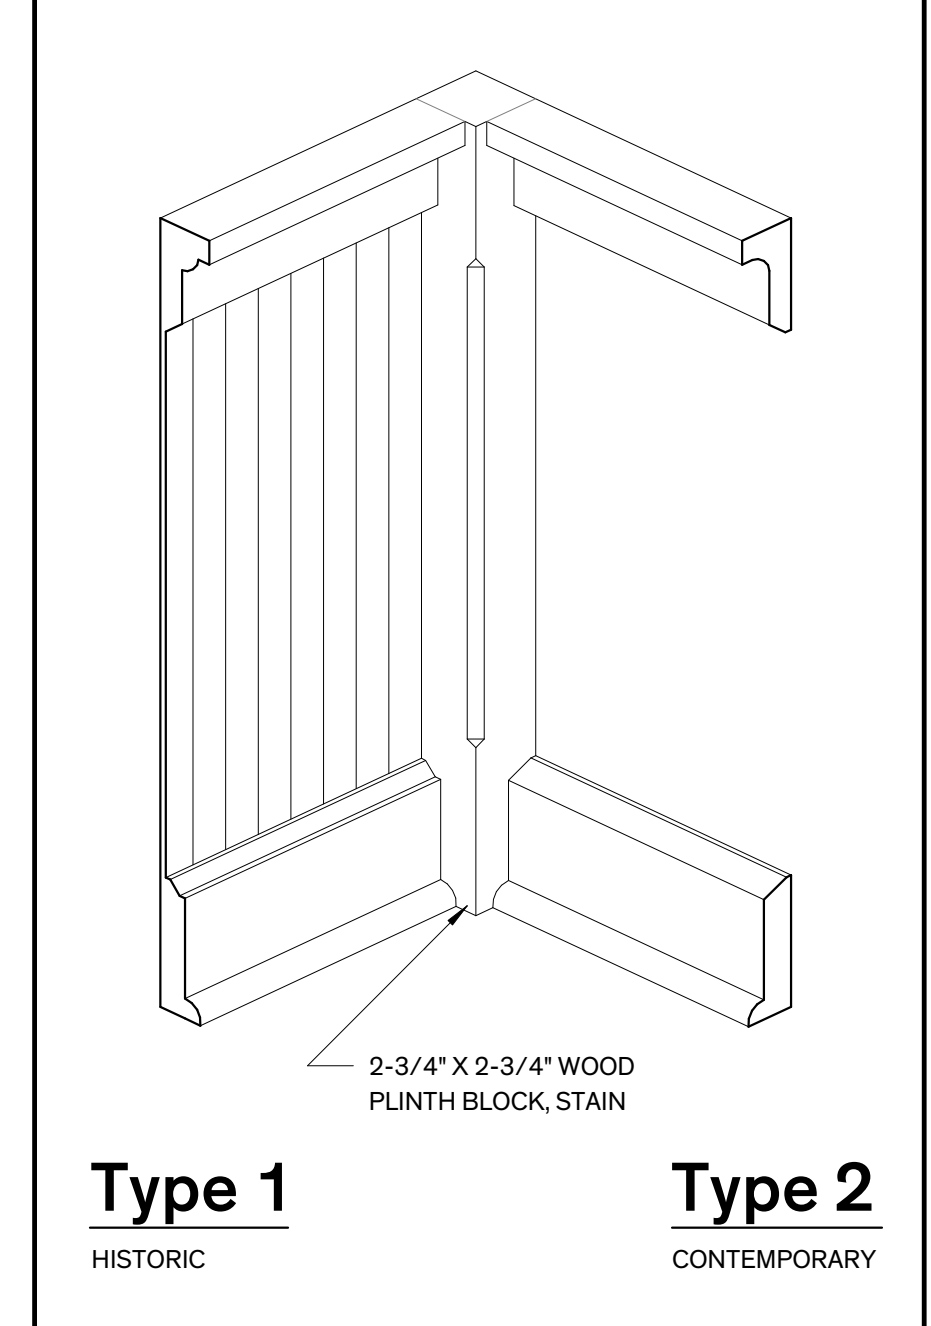

WAINSCOT PROFILES

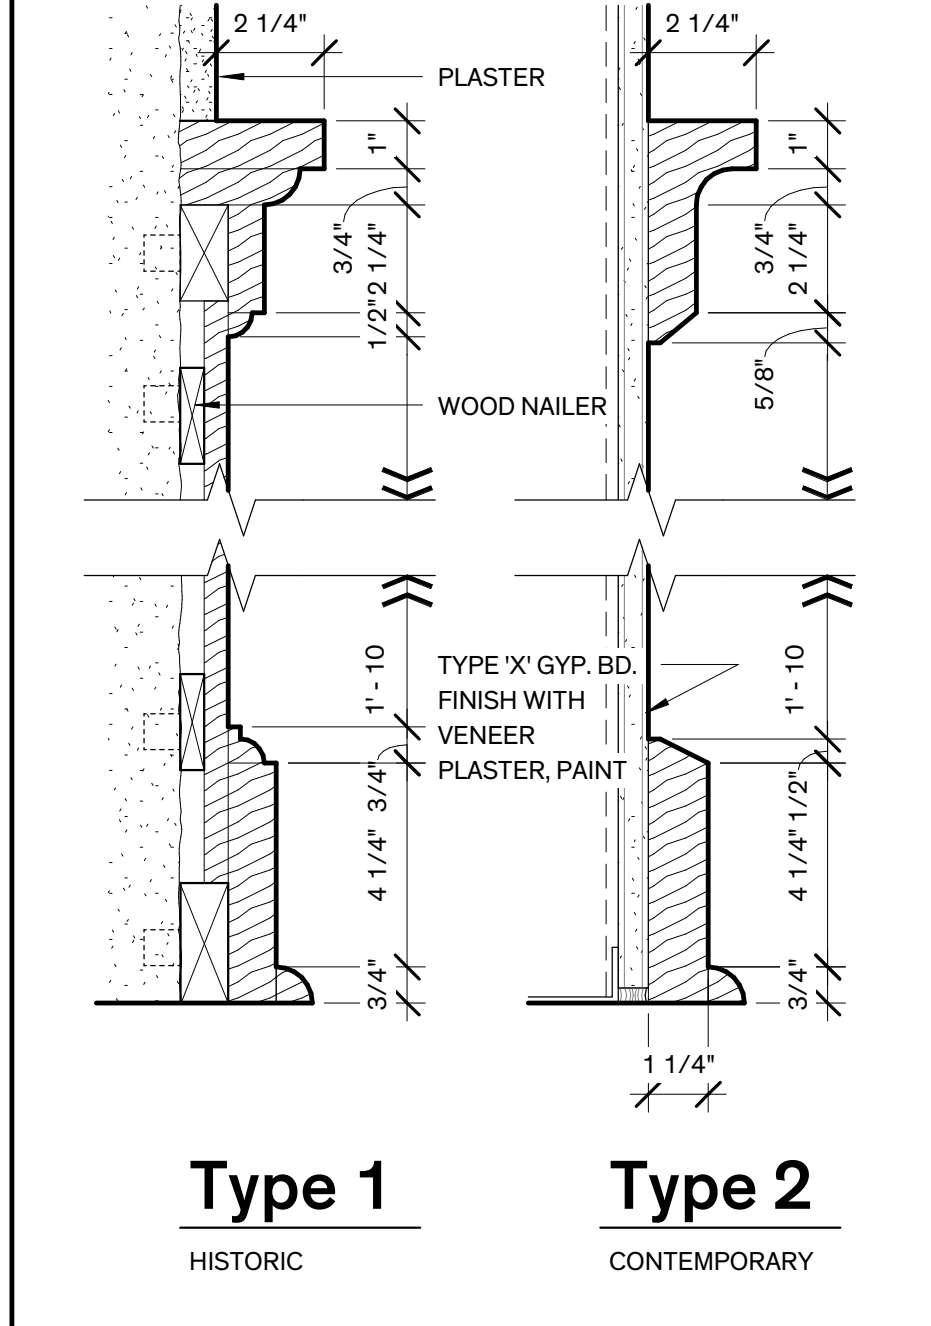

TEXAS HISTORICAL COMMISSION real places telling real stories




FANNIN COUNTY COURTHOUSE INTERIOR & EXTERIOR RESTORATION

101 E. Sam Rayburn Drive Bonham, Texas 75418

COPYRIGHT: The Contractor shall verify and be responsible for all dimensions. DO NOT scale the drawing. Any errors or omissions shall be reported to Architexas without delay.

REVISION HISTORY: 1 Oct. 16, 2018 Addendum #1

ISSUED FOR CONSTRUCTION

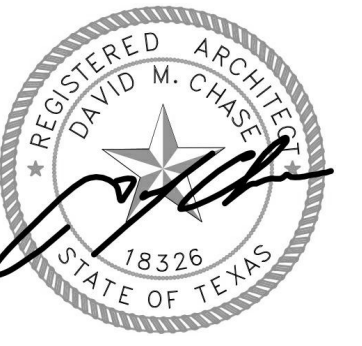


#18326 9/21/2018

Architexas No. 1737 Date SEPT. 21, 2018 Sheet Name FINISH SCHEDULE

Sheet Number A6.01


**WINDOW & CASING TYPES**

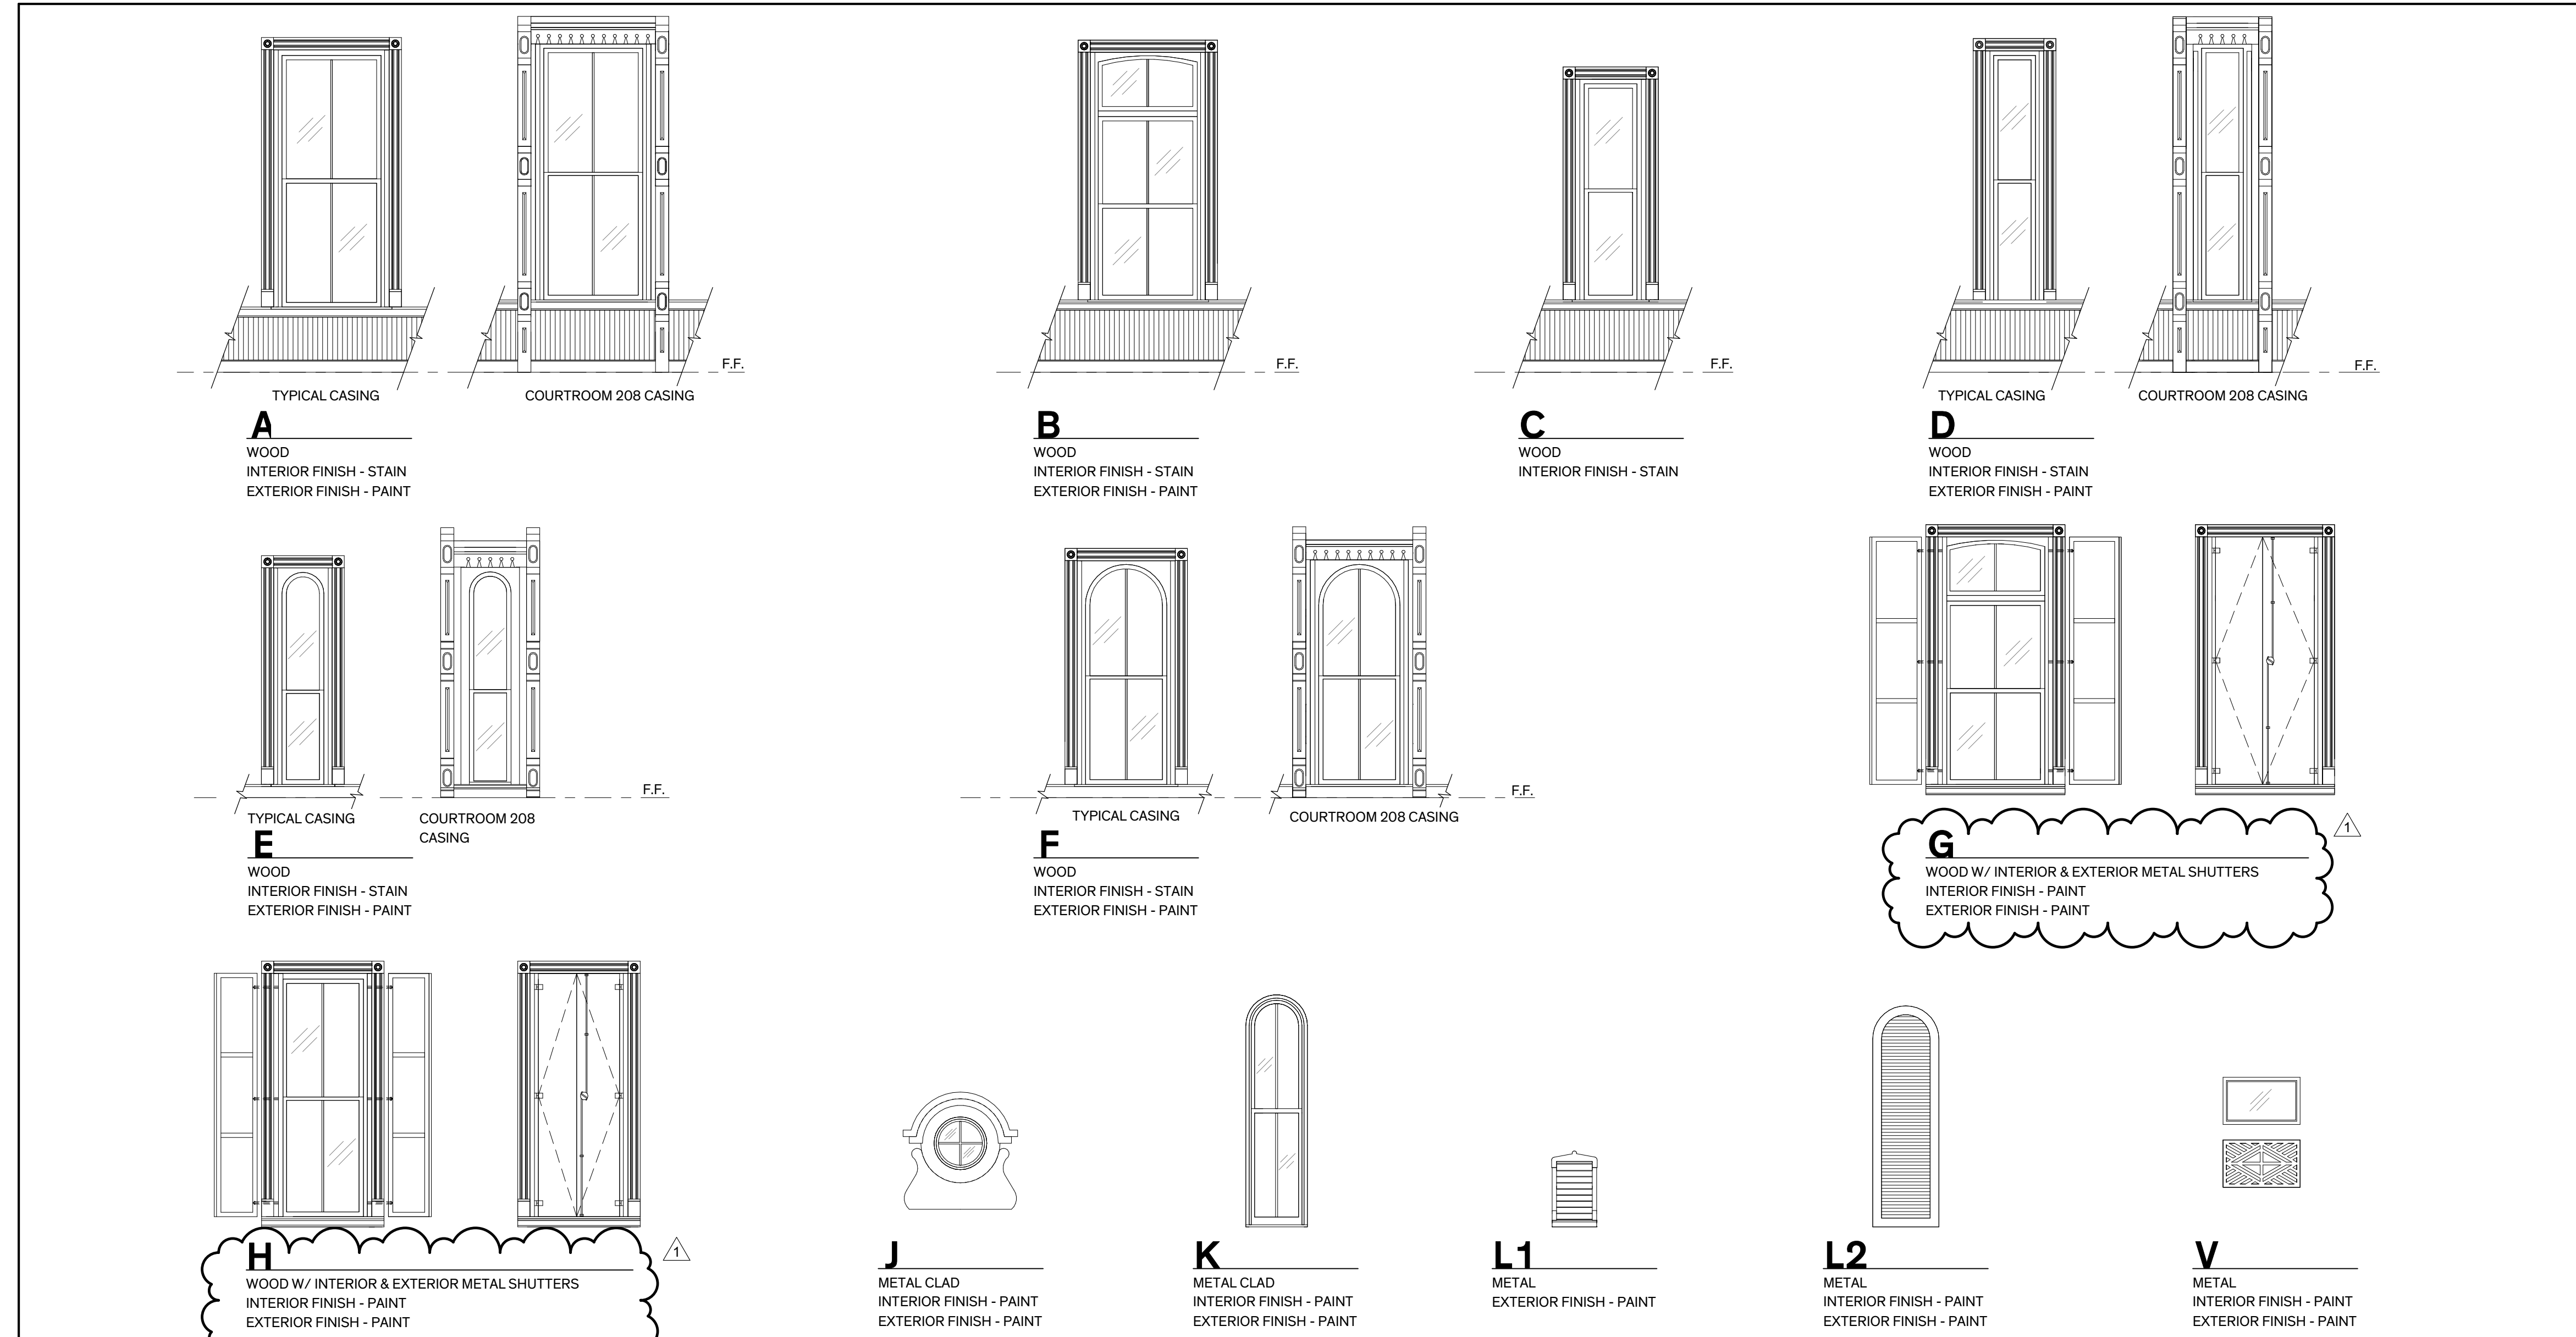

**GENERAL NOTES**

- GENERAL**
- SCOPE OF WORK INCLUDES THE FULL REPLACEMENT OF INTERIOR AND EXTERIOR WINDOWS, FRAMES, AND ASSOCIATED CASINGS. PROVIDE WINDOWS, FRAMES, CASING AND HARDWARE AS SPECIFIED IN THE WINDOW SCHEDULE AND PROJECT MANUAL. WINDOW SIZES AT EXISTING AND NEW MASONRY OPENINGS ARE APPROXIMATE. CONTRACTOR IS TO VERIFY ORIGINAL MASONRY OPENING SIZES IN FIELD.
  - PROVIDE TEMPORARY PROTECTION AS REQUIRED DURING DEMOLITION AND CONSTRUCTION OF WINDOWS TO PROTECT INTERIOR FROM WATER/ MOISTURE INTRUSION. SECURE LOOSE BLOCKING AND PROVIDE SUPPLEMENTAL BLOCKING AS NECESSARY FOR ATTACHMENT TO EXISTING AND NEW MATERIALS.
  - RESTORE SURROUND MATERIALS (STONE, MORTAR, ETC.). REFERENCE EXTERIOR ELEVATIONS FOR EXTENT OF RESTORATION WORK.
  - WOOD SPECIES FOR EXTERIOR AND INTERIOR WINDOW SASHES AND FRAMES TO BE SAPELE. CASING TRIM TO BE CLEAR VERTICAL GRAIN DOUGLAS FIR.
  - FINISHES:  
A) WOOD WINDOWS, FRAMES, TRANSOMS, AND CASINGS ARE TO RECEIVE A PAINTED FINISH ON THE EXTERIOR AND A STAINED FINISH ON THE INTERIOR, UNLESS NOTED OTHERWISE.  
B) METAL CLAD WINDOWS AND SHUTTERS AT ORIGINAL VAULT LOCATIONS ARE TO RECEIVE A PAINTED FINISH.
  - UPPER WINDOW SASH AND TRANSOMS TO BE FIXED; LOWER SASH TO BE OPERABLE.
  - HARDWARE:  
A) PROVIDE NEW HARDWARE AS SPECIFIED IN AND PROJECT MANUAL.  
B) COORDINATE PLACEMENT OF HARDWARE COMPONENTS WITH ARCHITECT PRIOR TO INSTALLATION.  
C) PROVIDE SCREWS AND ATTACHMENTS THAT MATCH FINISH OF SPECIFIED HARDWARE COMPONENTS.
  - COURTROOM 208 WINDOWS TO RECEIVE CUSTOM WOOD SHUTTERS, REF. 3/A6.09. TYPICAL WINDOW TO RECEIVE WOOD LOUVER BLINDS, REF. PROJECT MANUAL.
  - CONTRACTOR IS RESPONSIBLE FOR FINAL ADJUSTMENT OF OPERABLE WINDOWS, HARDWARE, AND WEATHERSTRIPPING.


**WINDOW CASING PROFILES**

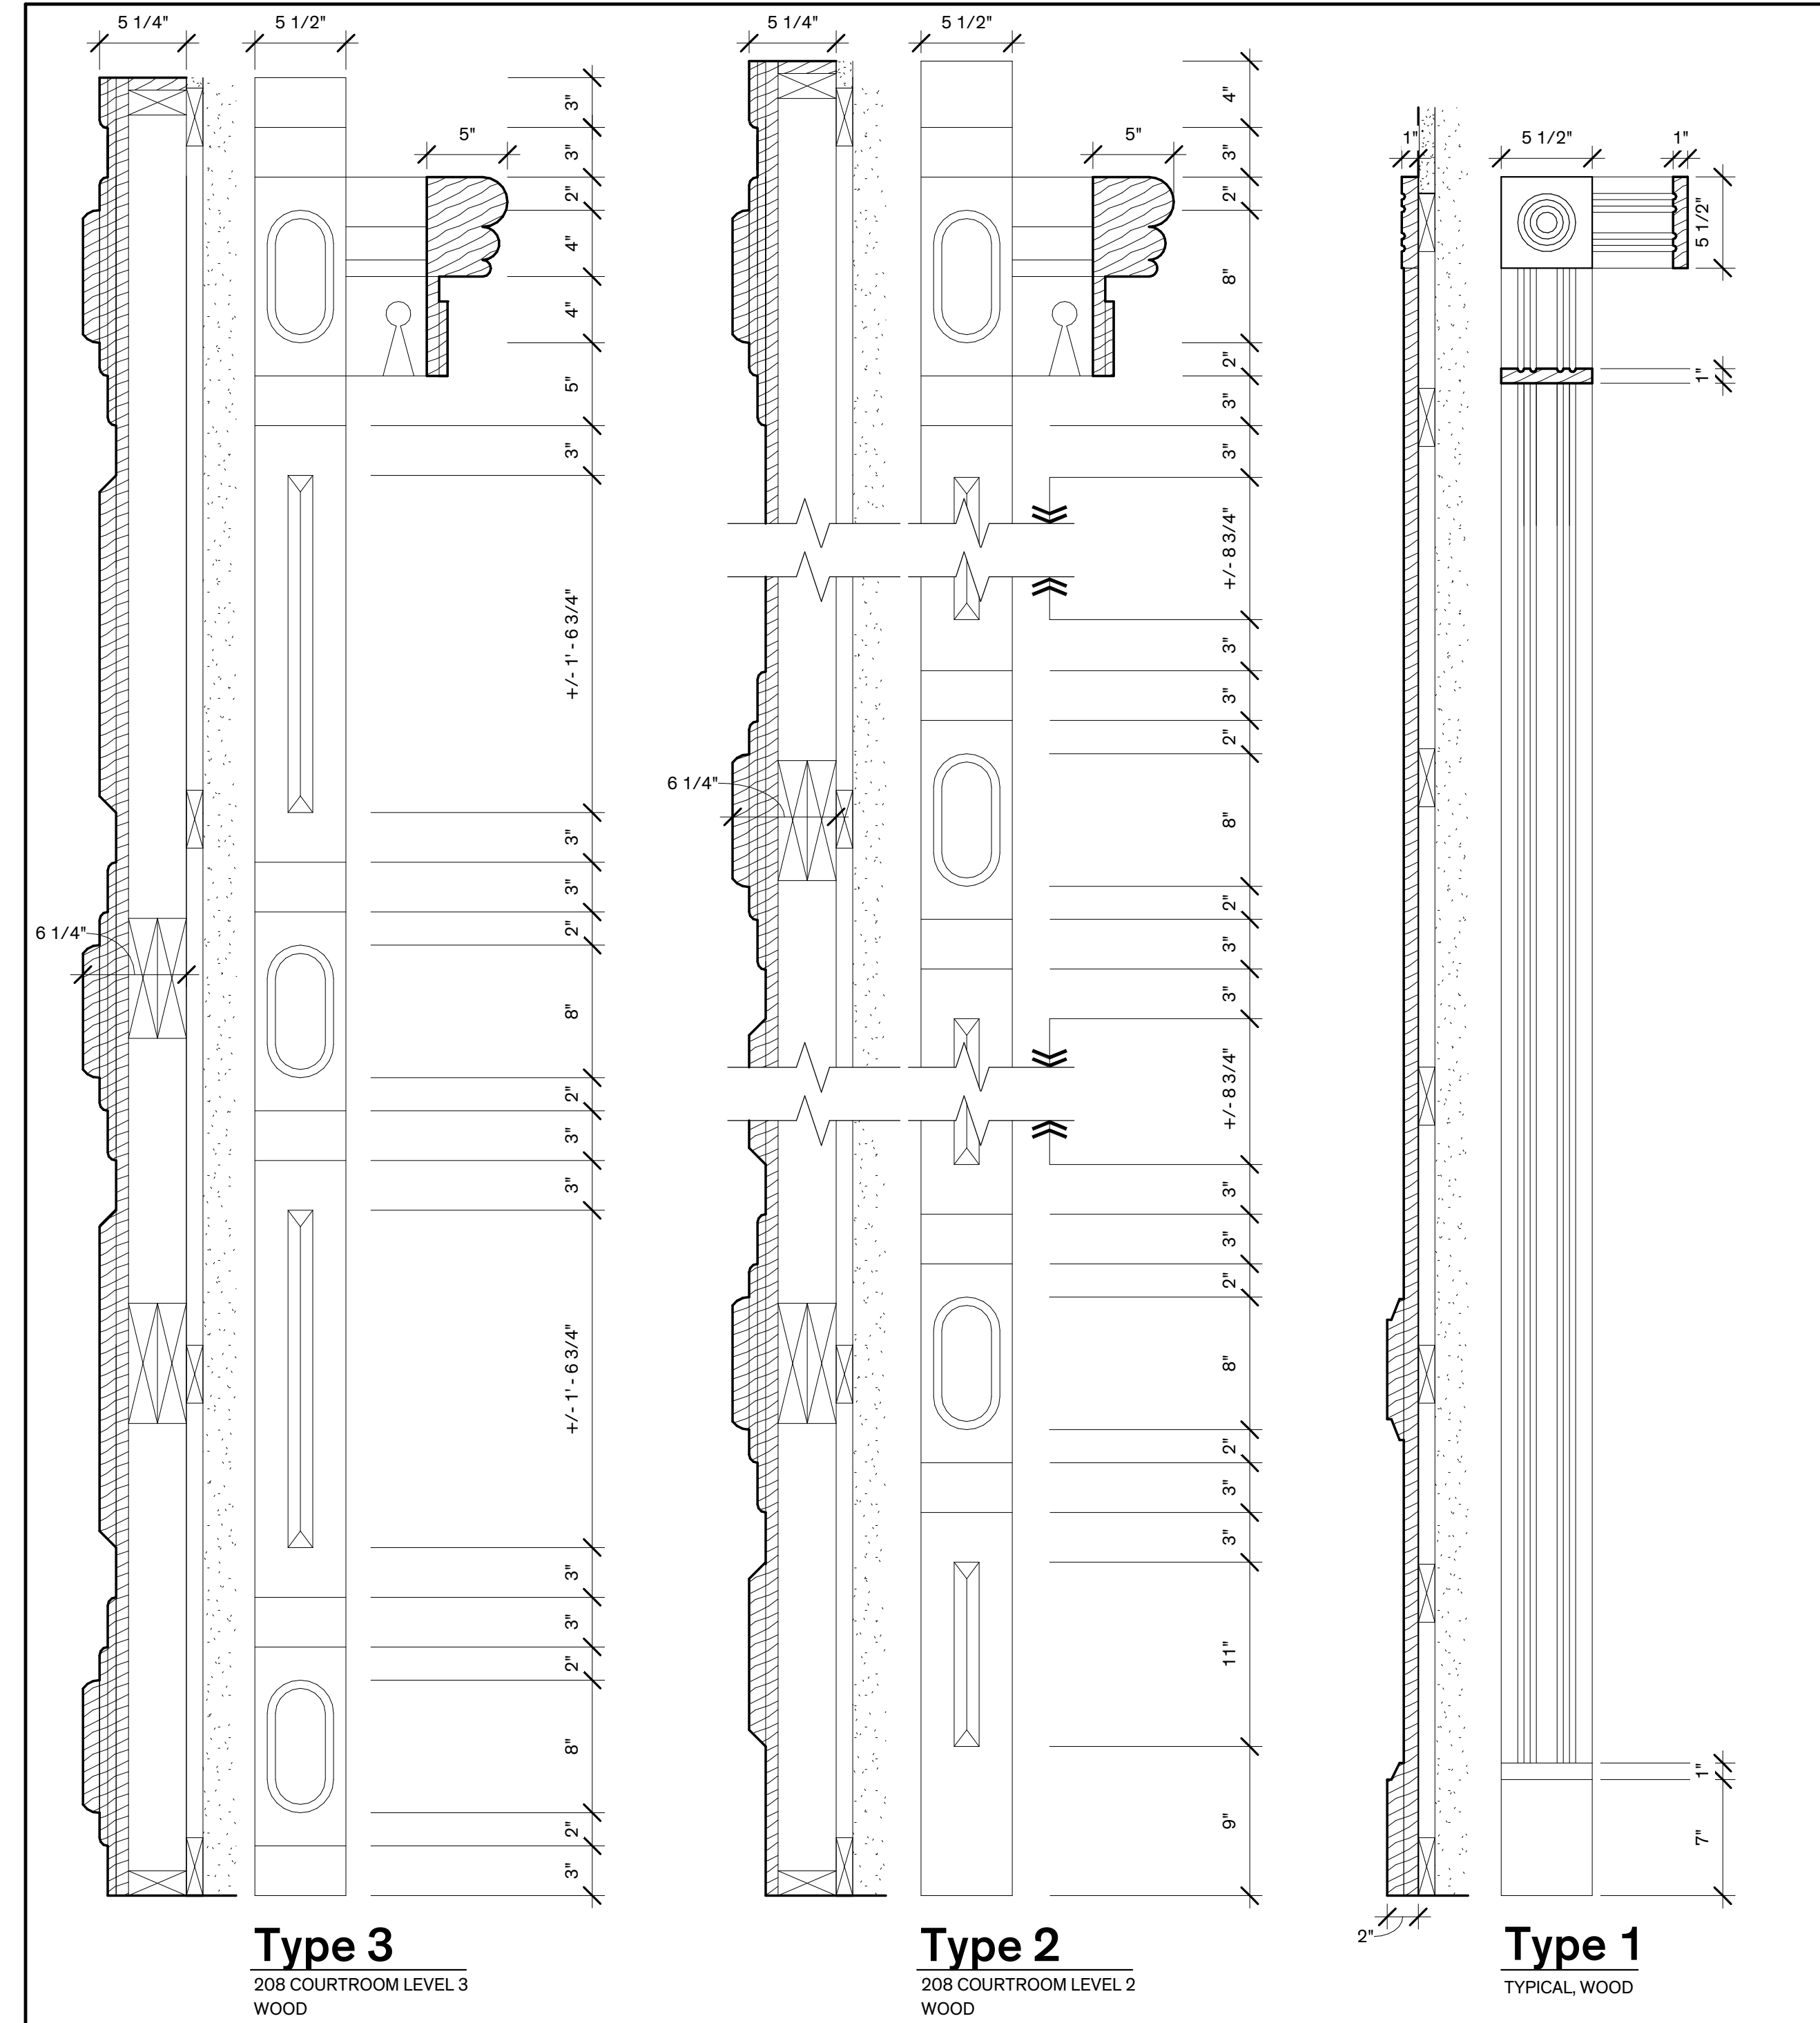

**COPYRIGHT**  
The Contractor shall verify and be responsible for all dimensions. DO NOT scale the drawing. Any errors or omissions shall be reported to Architexas without delay. The Copyrights to all designs and drawings are the property of Architexas. Reproduction or use for any purpose other than that authorized by Architexas is forbidden.

**REVISION HISTORY**  
1 Oct. 16, 2018 Addendum #1

ISSUED FOR CONSTRUCTION

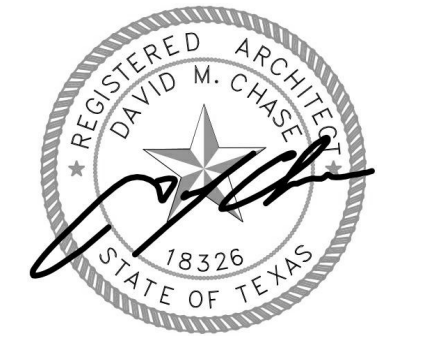


#18326 9/21/2018

Architexas No. 1737 Date SEPT. 21, 2018


Sheet Name WINDOW/ LOUVER/ VENT TYPES AND DETAILS

Sheet Number **A6.07**




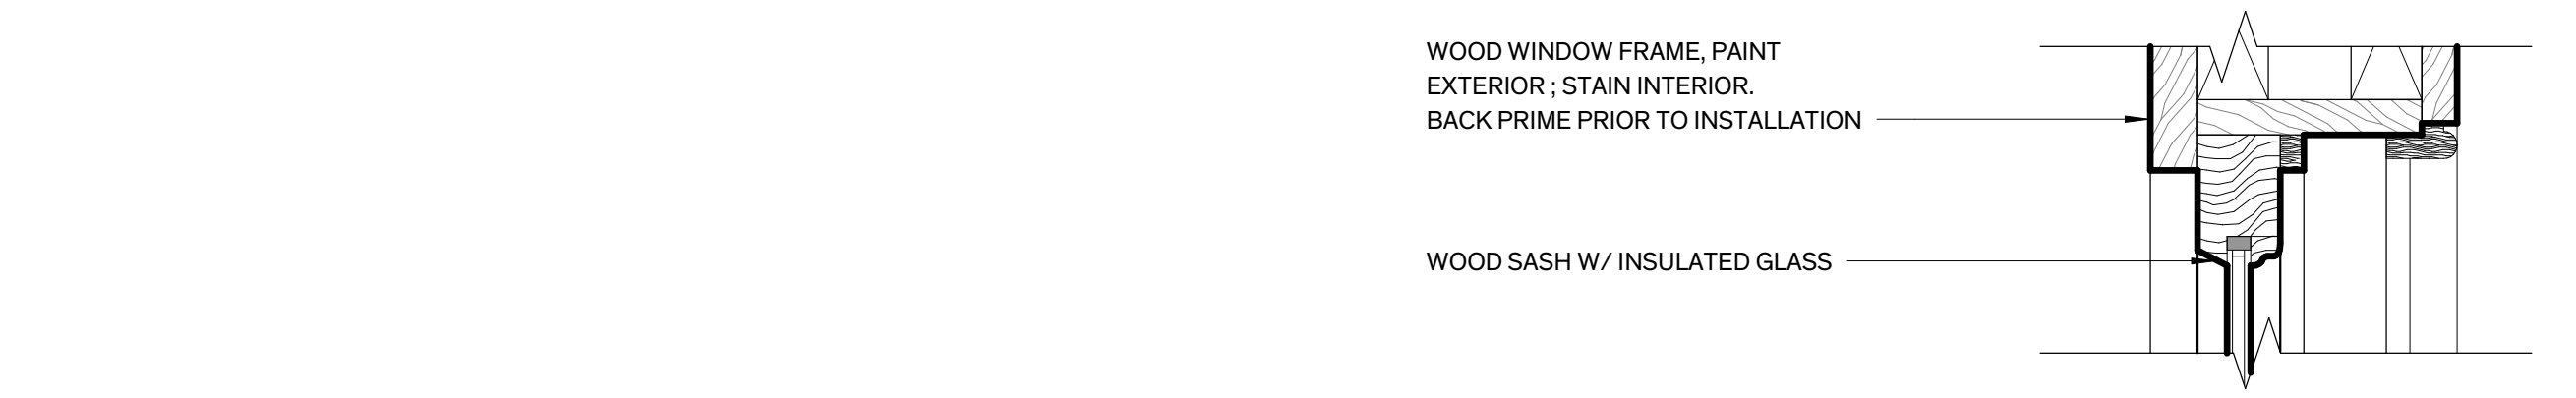


**20 Typ. Top Sash**  
3" = 1'-0"

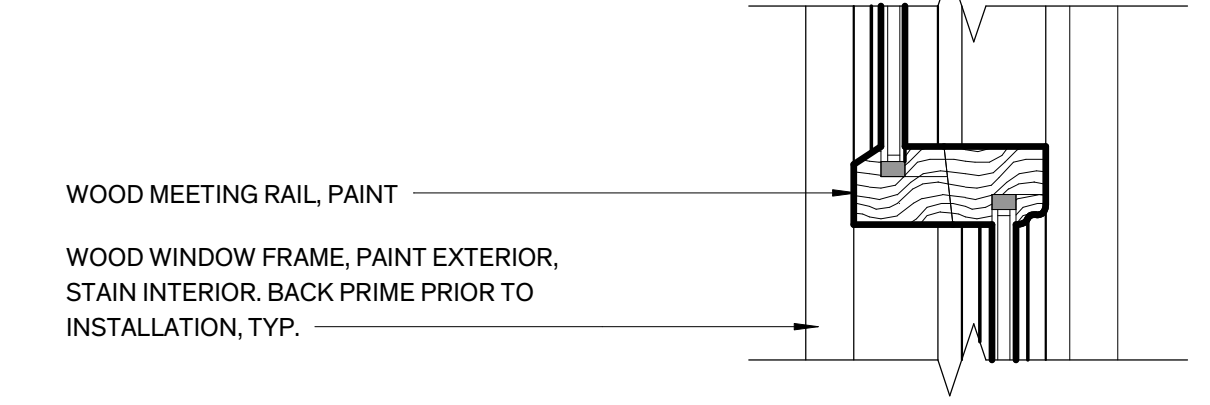


**19 Typ. Meeting Rail**  
3" = 1'-0"

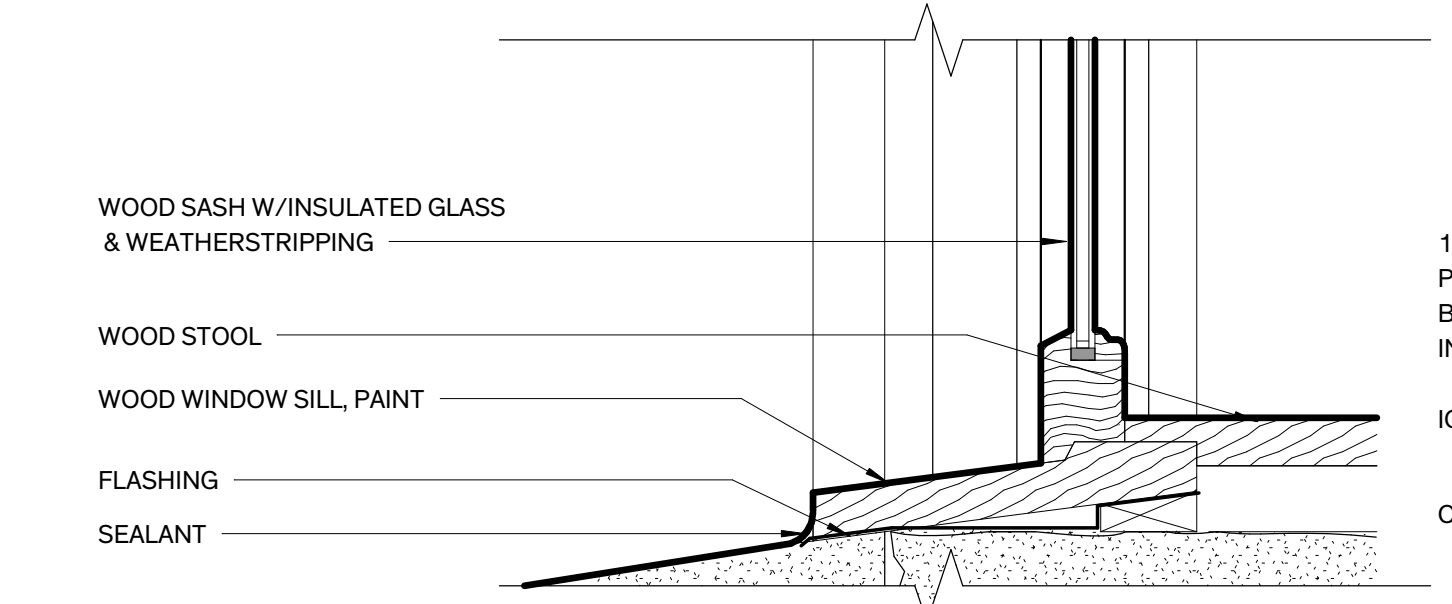


**18 Typ. Bottom Sash**  
3" = 1'-0"

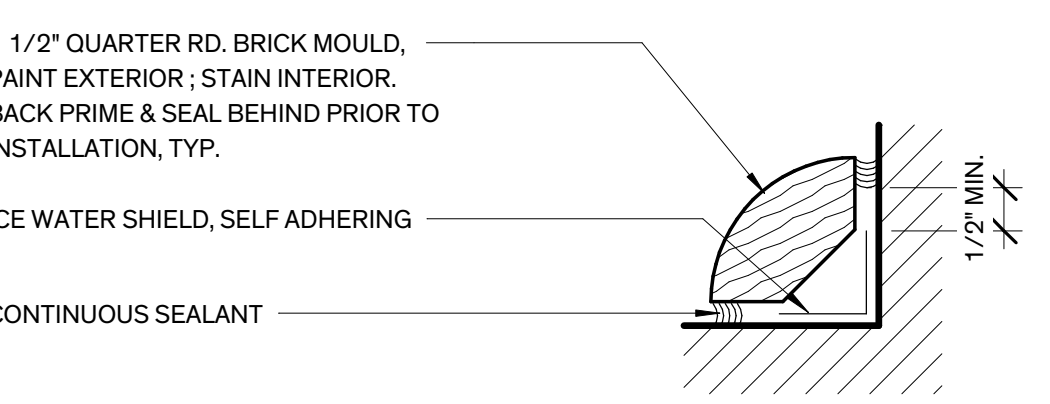


**17 Typ. Brick Mould**  
6" = 1'-0"

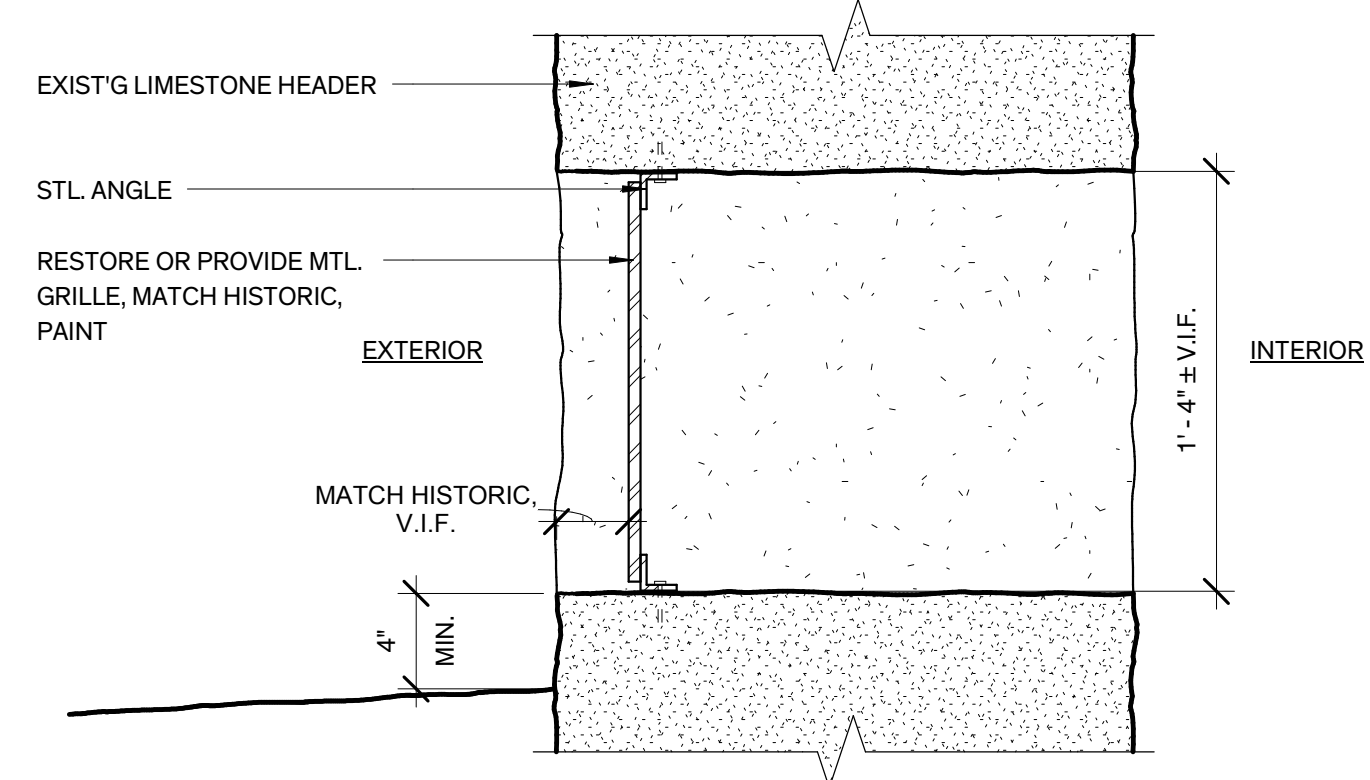


**16 Basement Vent Jamb Detail**  
1 1/2" = 1'-0"

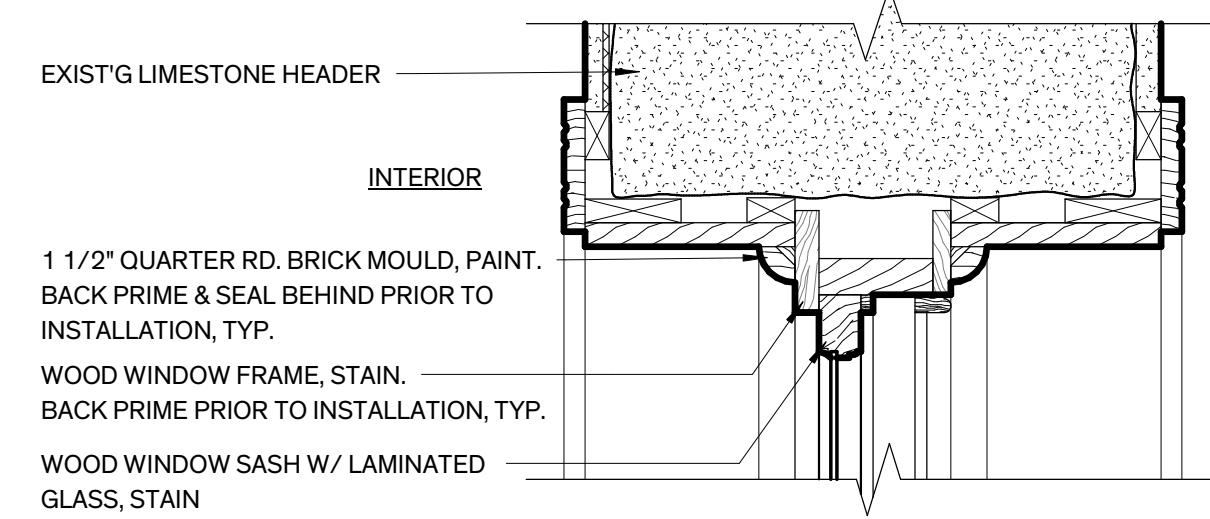


**15 Head Detail**  
1 1/2" = 1'-0"

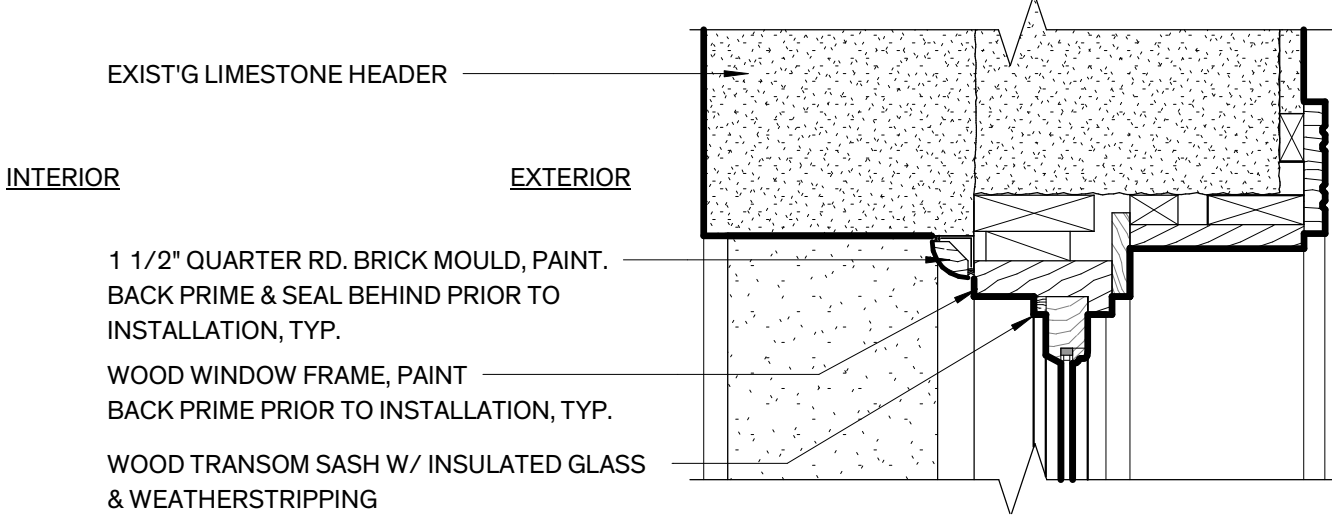


**14 Head Detail**  
1 1/2" = 1'-0"

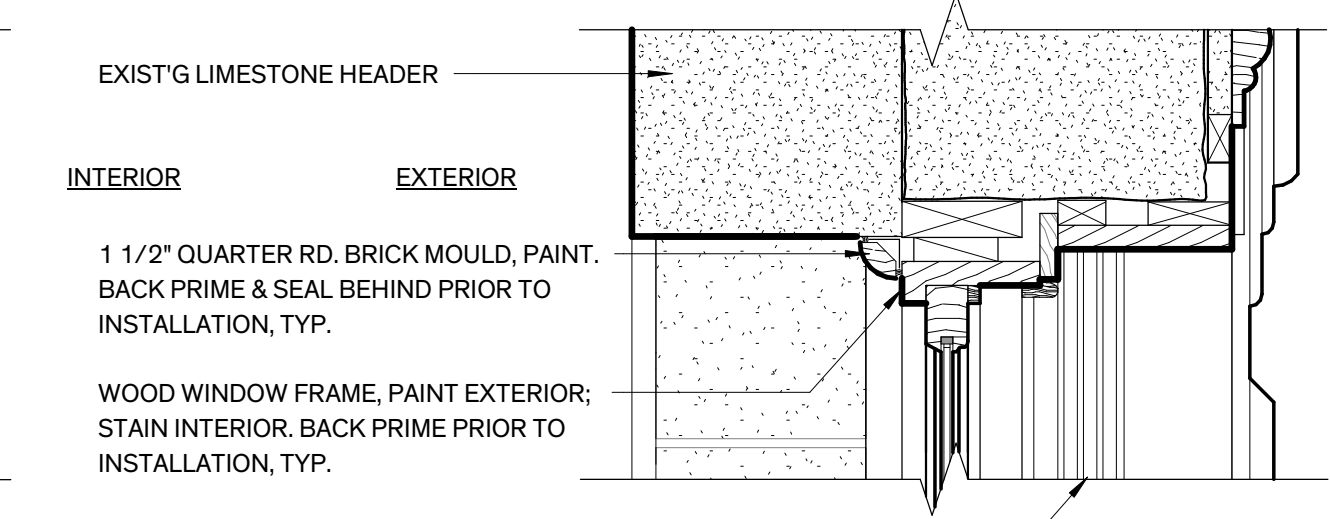


**13 Head Detail**  
1 1/2" = 1'-0"

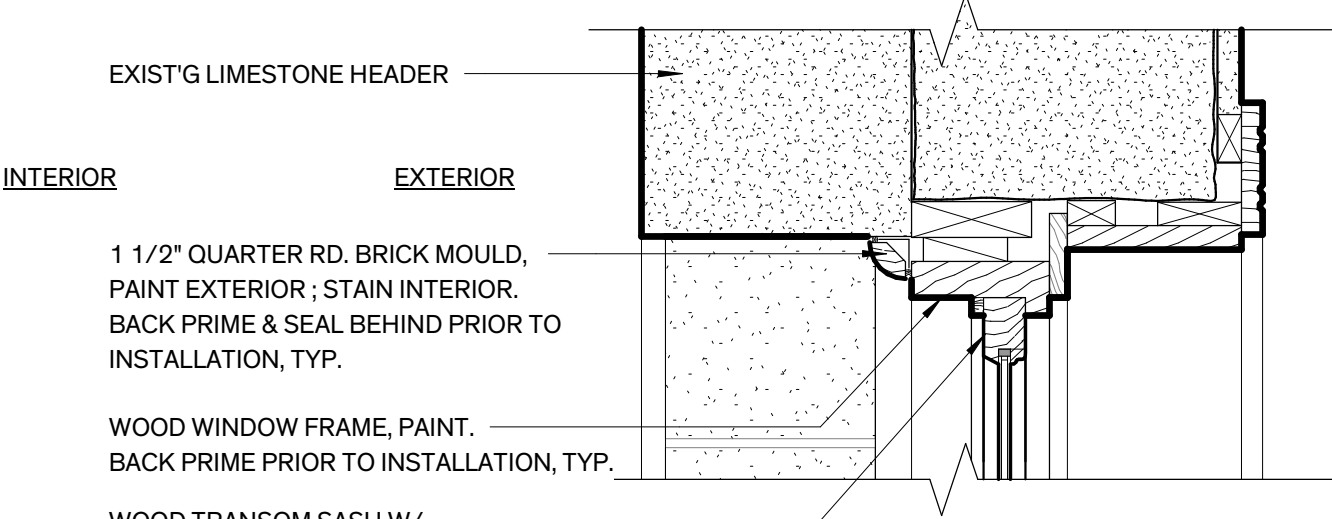


**12 Head Detail**  
1 1/2" = 1'-0"

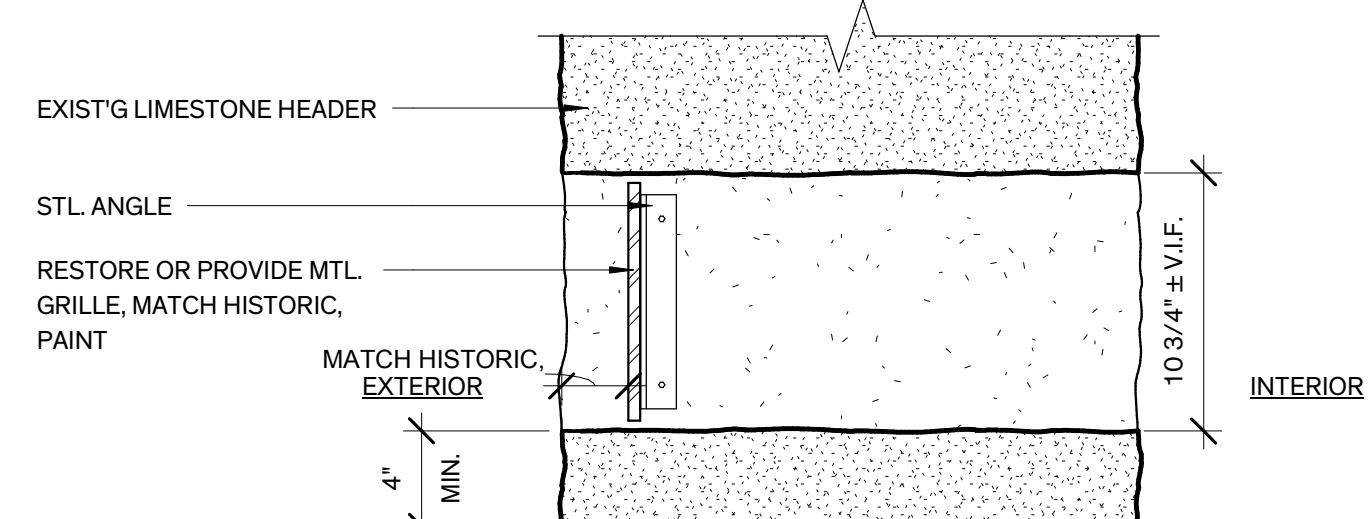


**11 Basement Vent Sill/Head Detail**  
1 1/2" = 1'-0"

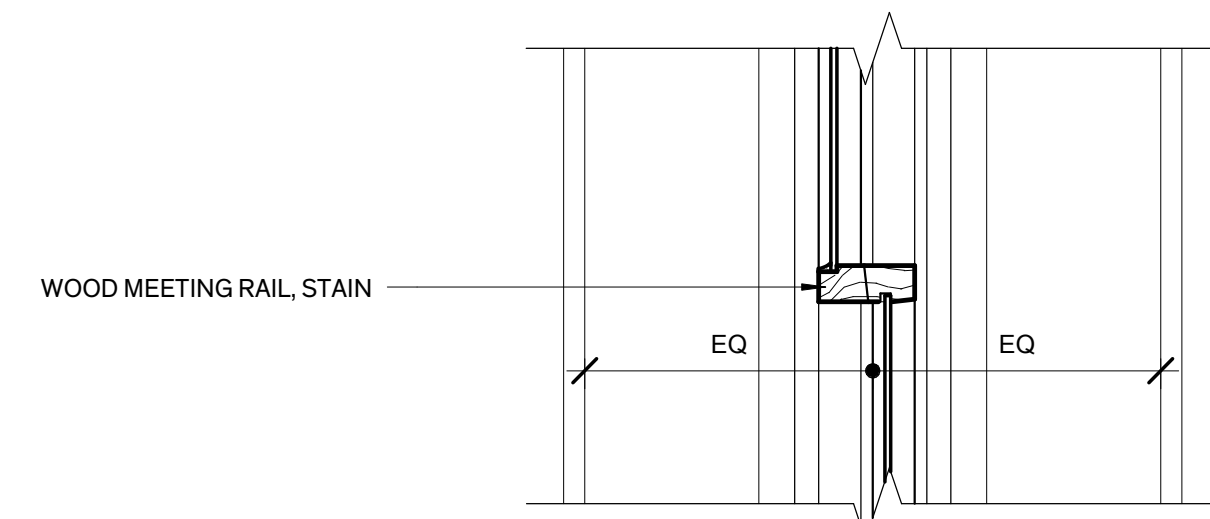


**9 Sill Detail**  
1 1/2" = 1'-0"

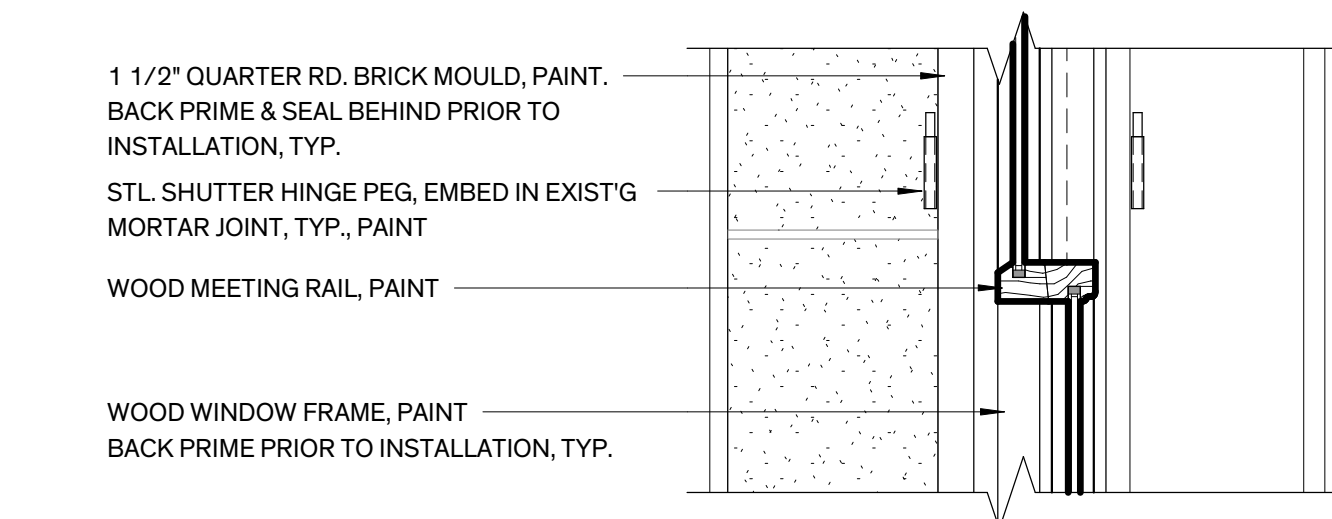


**8 Sill Detail**  
1 1/2" = 1'-0"

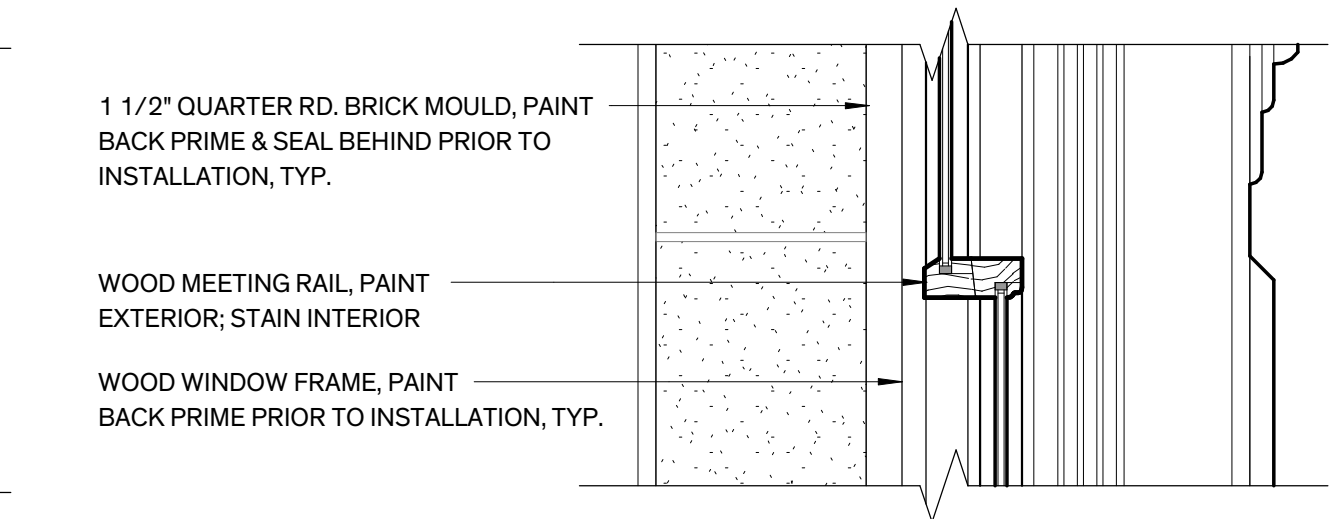


**7 Sill Detail**  
1 1/2" = 1'-0"

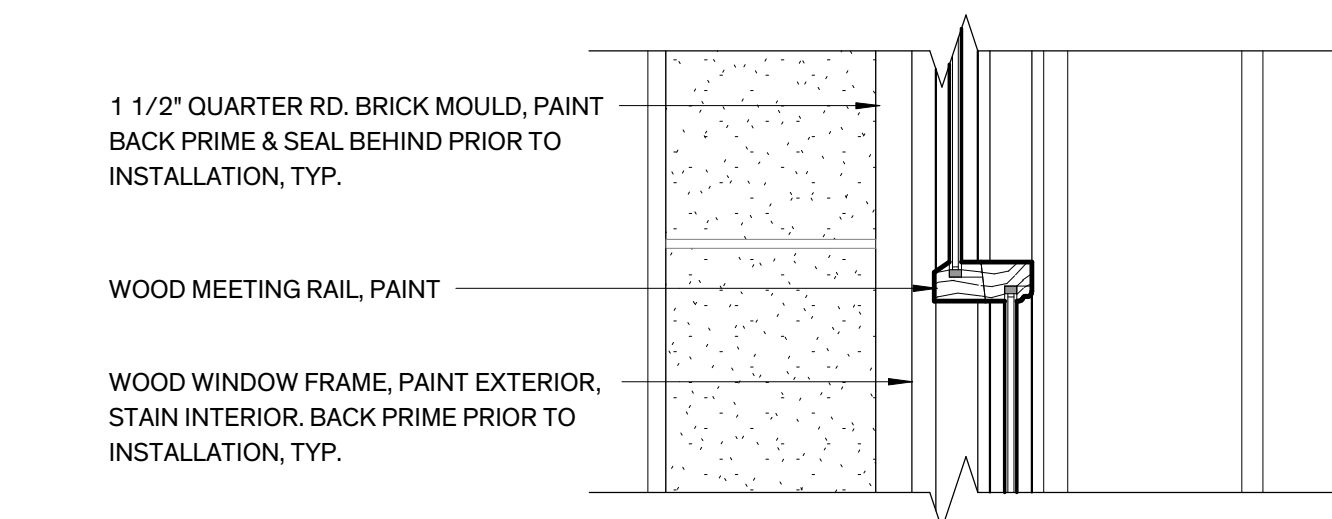


**6 Sill Detail**  
1 1/2" = 1'-0"

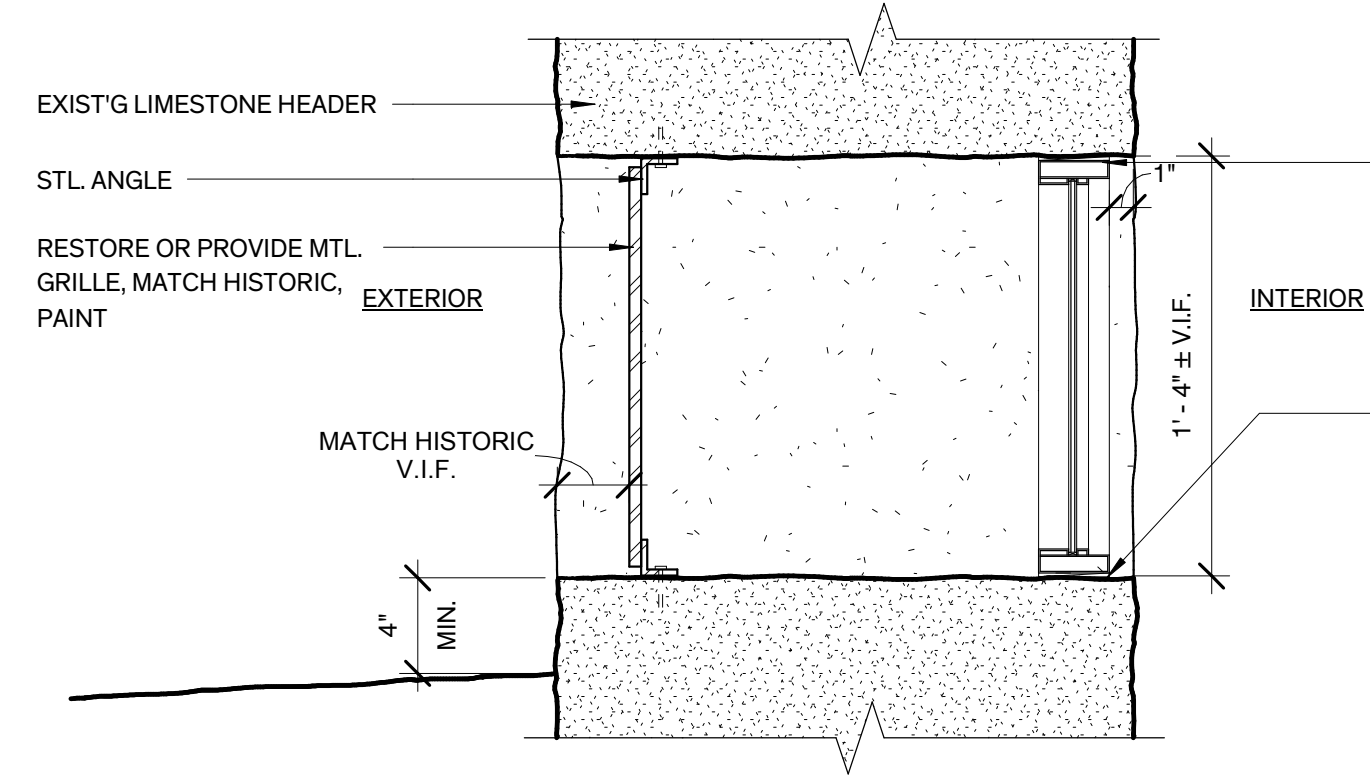


**10 Basement Vent Jamb Detail**  
1 1/2" = 1'-0"

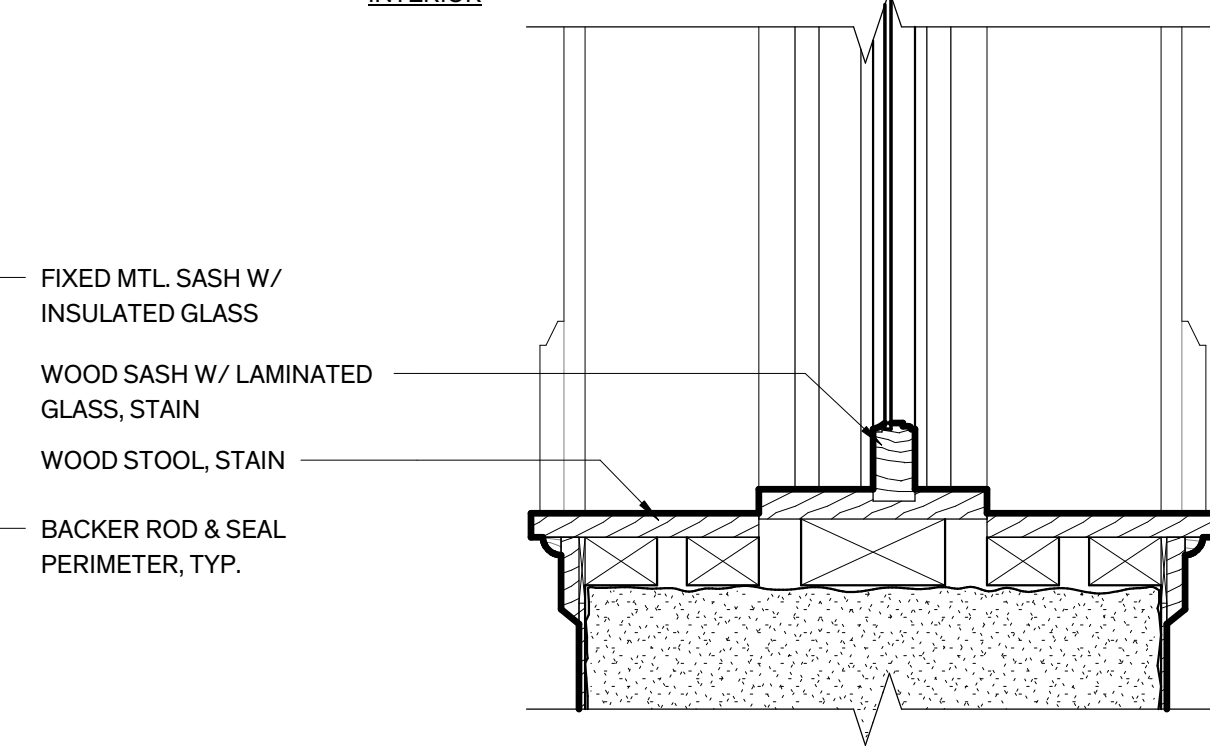


**4 Jamb Detail**  
1 1/2" = 1'-0"

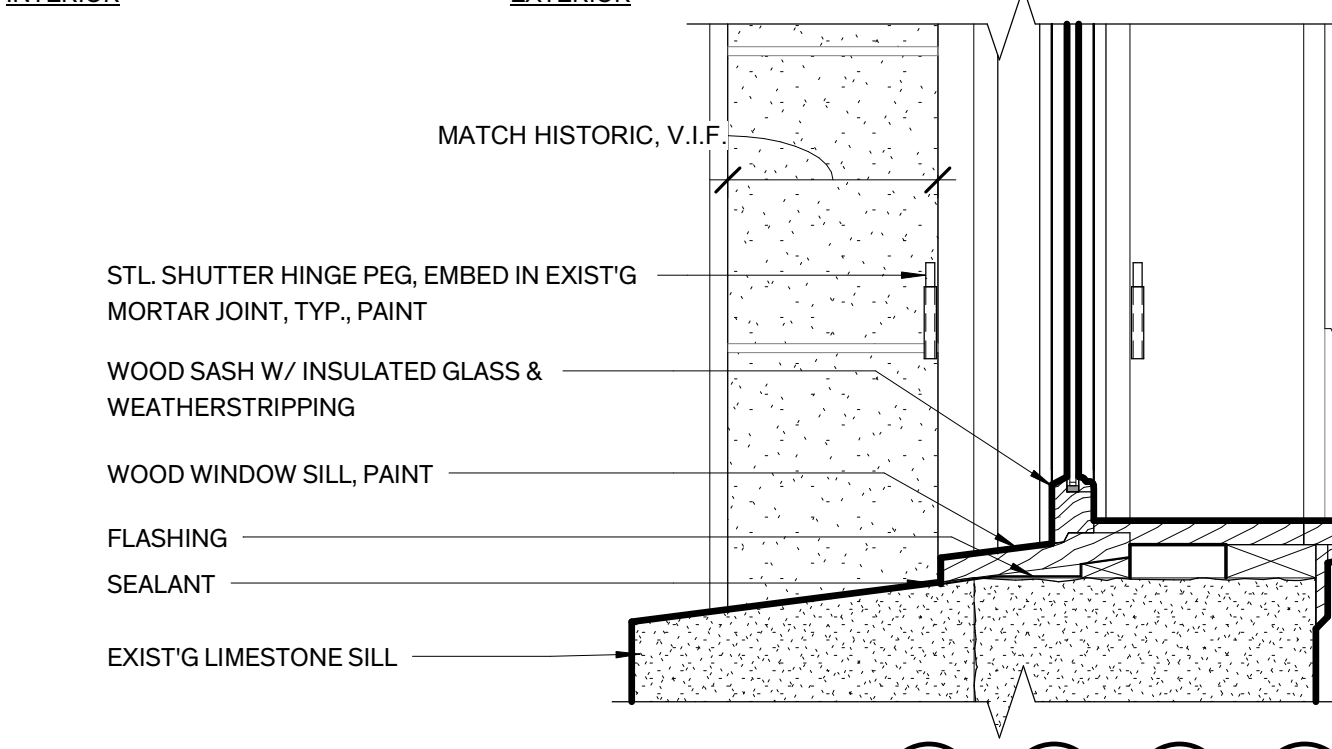


**3 Jamb Detail**  
1 1/2" = 1'-0"

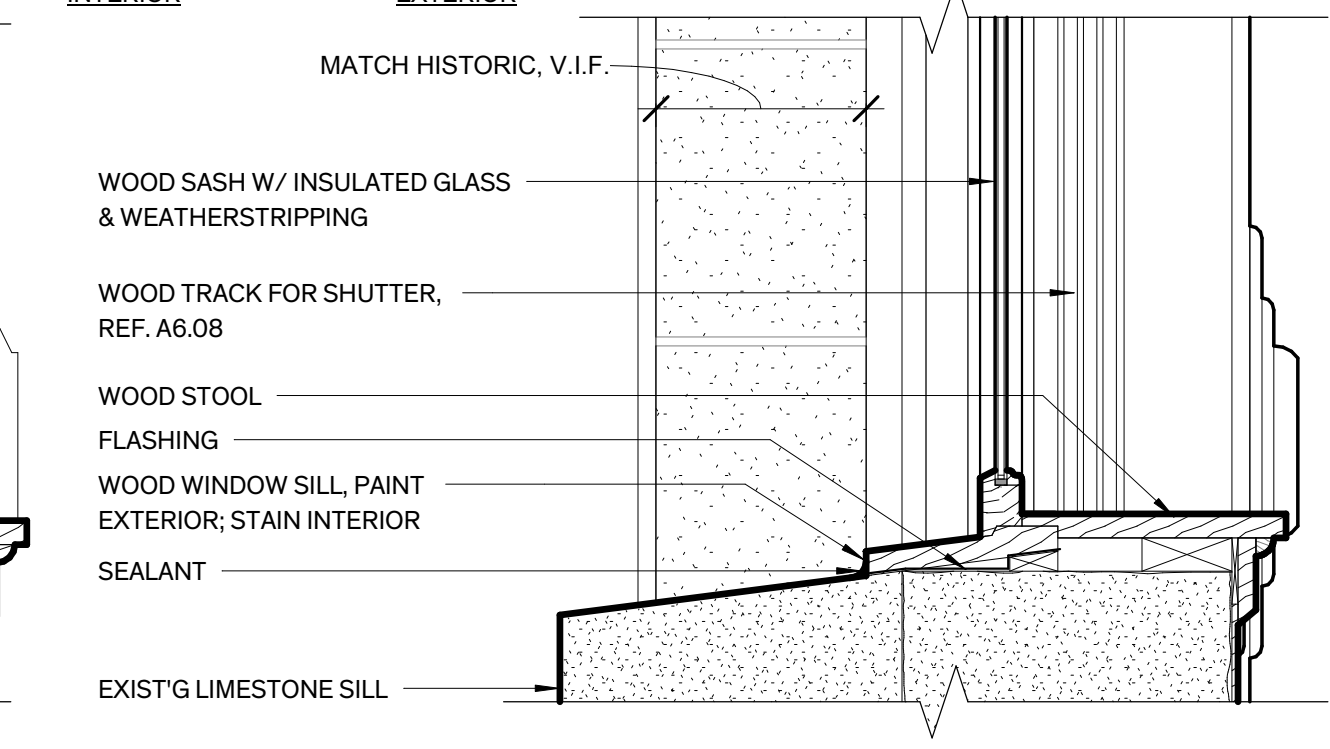



**2 Jamb Detail**  
1 1/2" = 1'-0"

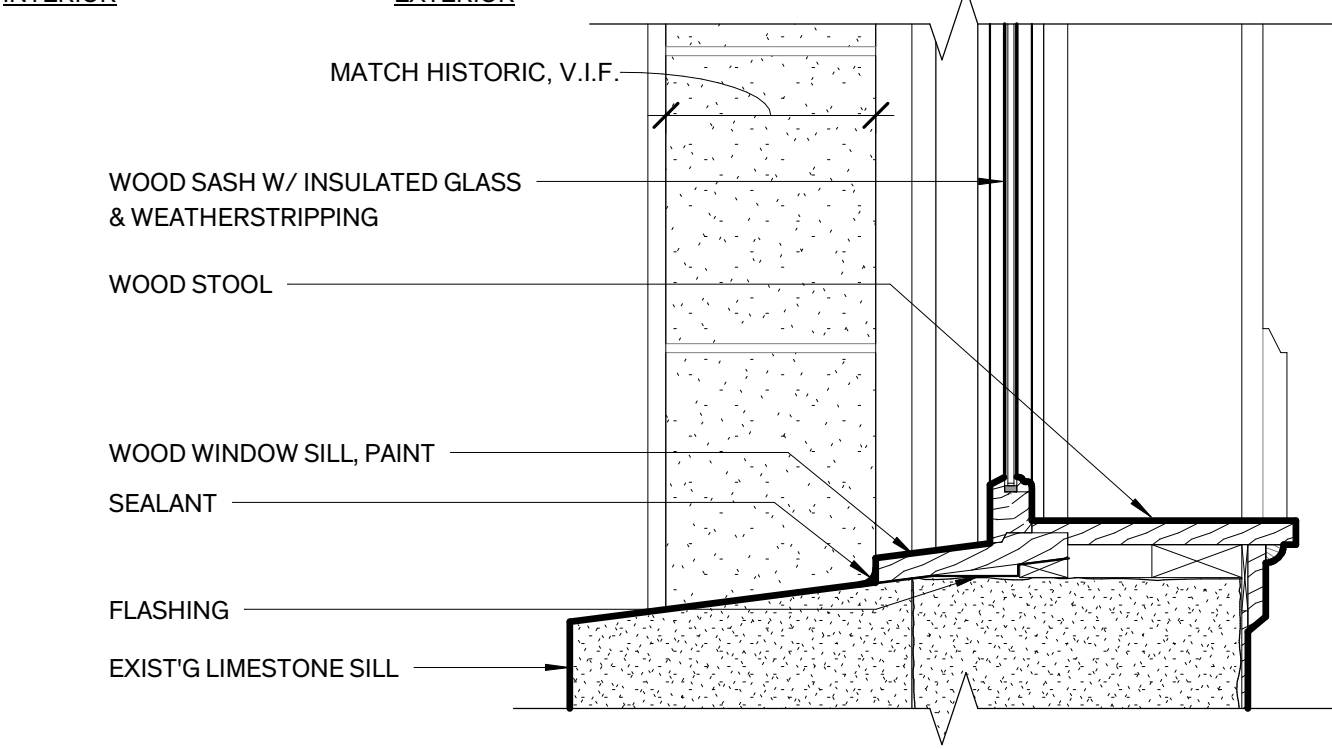


**1 Jamb Detail**  
1 1/2" = 1'-0"

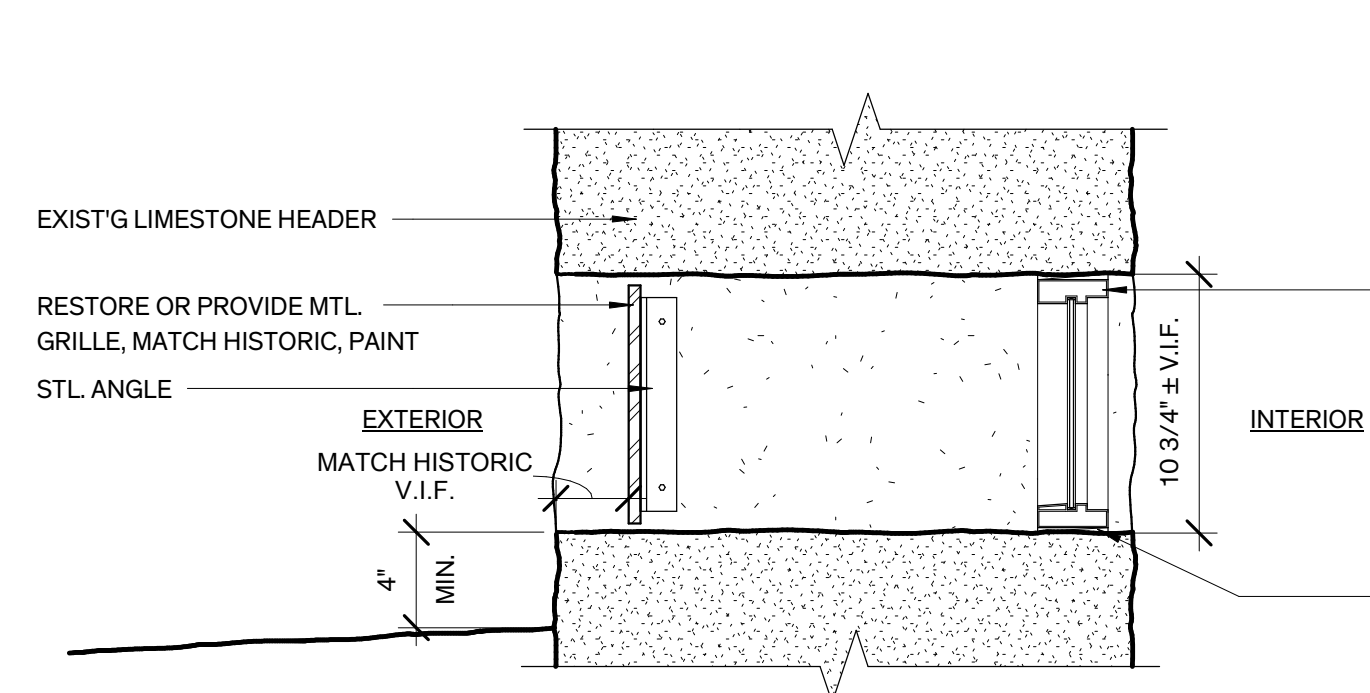


**5 Basement Vent Sill Detail**  
1 1/2" = 1'-0"

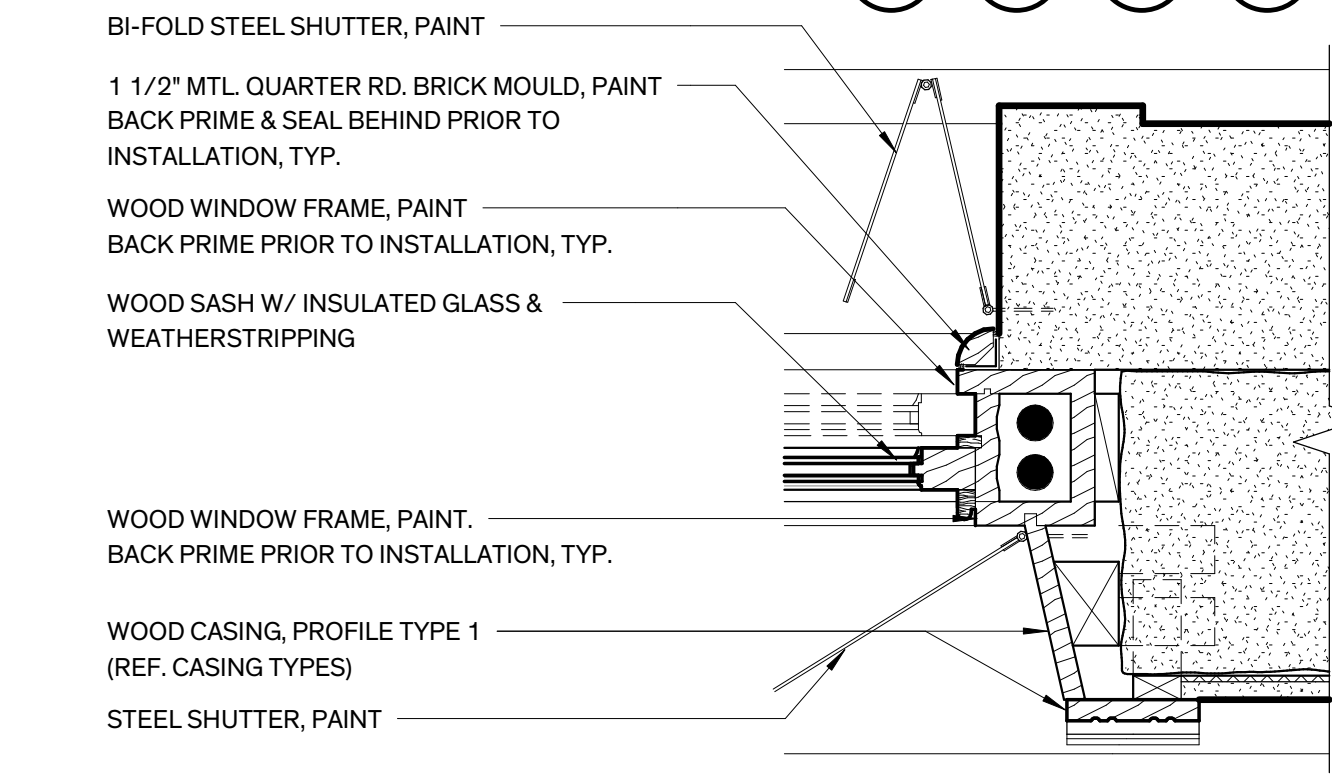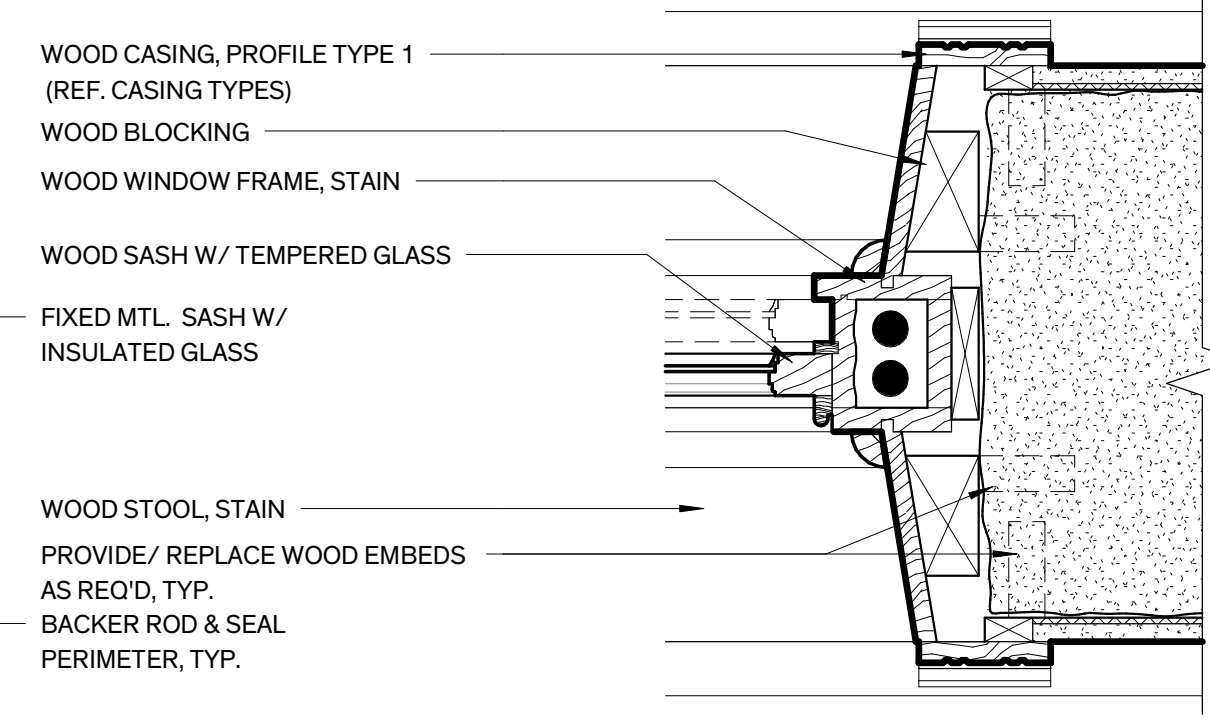

**3 Jamb Detail**  
1 1/2" = 1'-0"

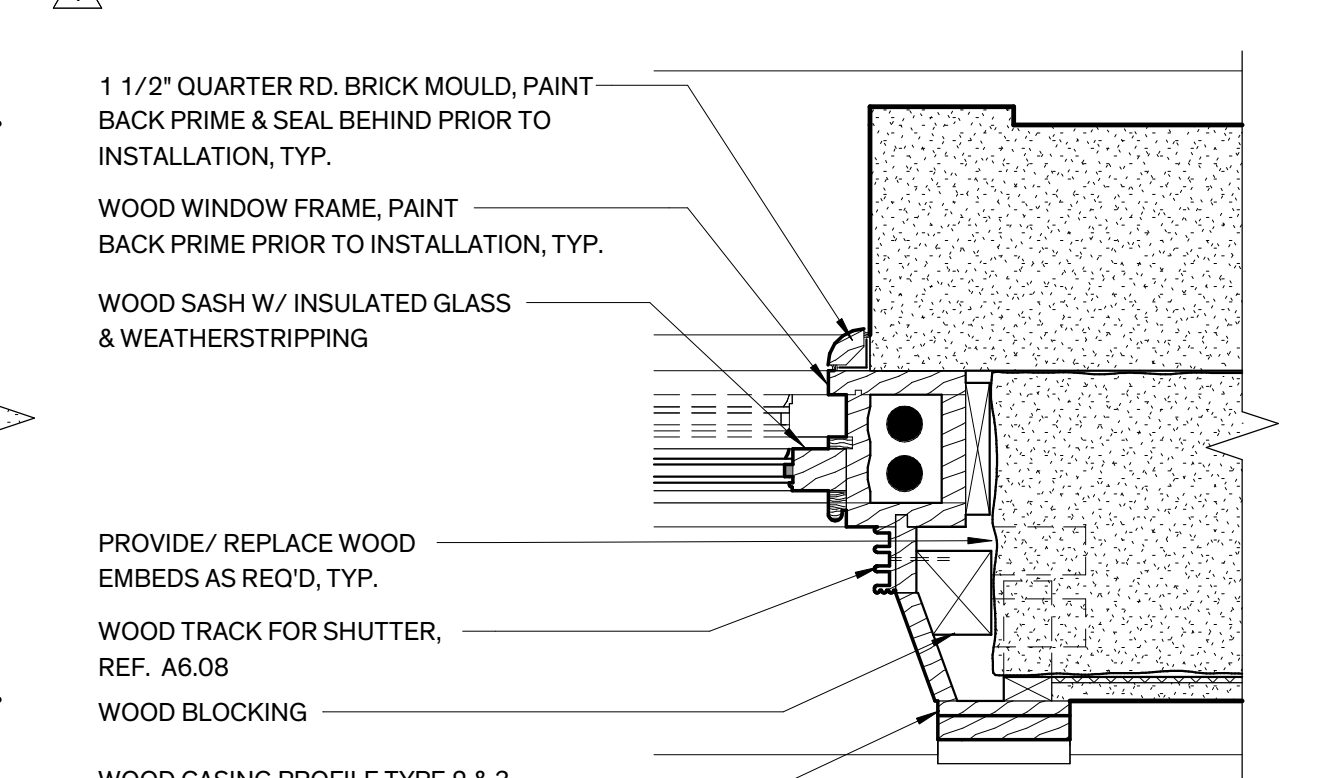

**2 Jamb Detail**  
1 1/2" = 1'-0"

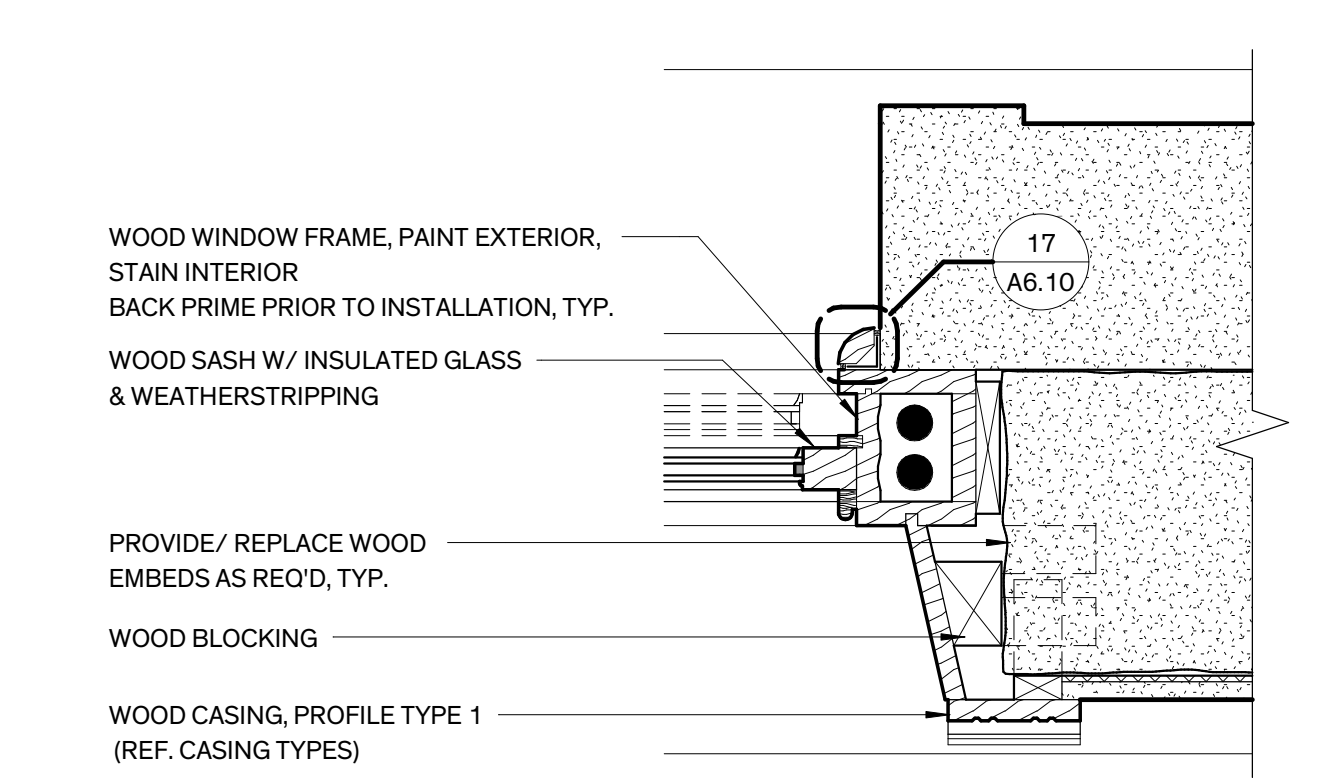


FANNIN COUNTY COURTHOUSE  
INTERIOR & EXTERIOR RESTORATION

101 E. Sam Rayburn Drive  
Bonham, Texas 75418

**COPYRIGHT**  
The Contractor shall verify and be responsible for all dimensions. DO NOT scale the drawing. Any errors or omissions shall be reported to Architexas without delay. The Copyrights to all designs and drawings are the property of Architexas. Reproduction or use for any purpose other than that authorized by Architexas is forbidden.

**REVISION HISTORY**  
1 Oct. 16, 2018 Addendum #1

ISSUED FOR CONSTRUCTION

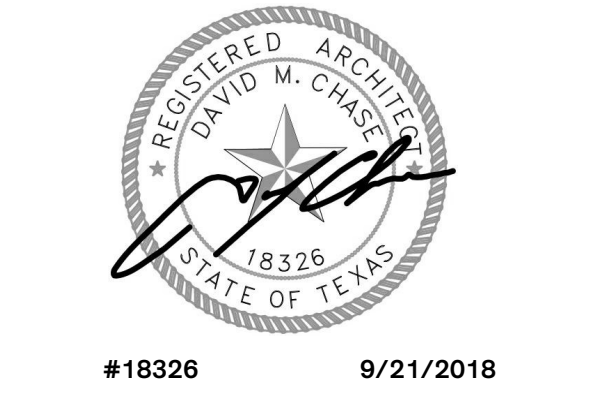


#18326 9/21/2018

Architexas No. 1737 Date SEPT. 21, 2018

Sheet Name WINDOW DETAILS


Sheet Number A6.10



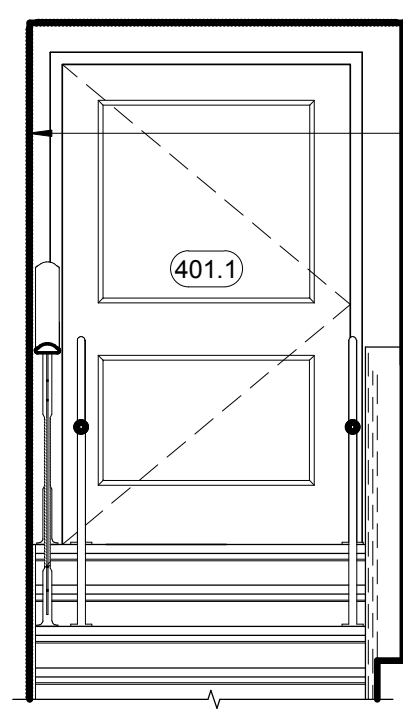

**6 Attic Elevation**  
 3/8" = 1'-0"


CORRUGATED METAL AT WALL TO MATCH TYPE 2B CEILING

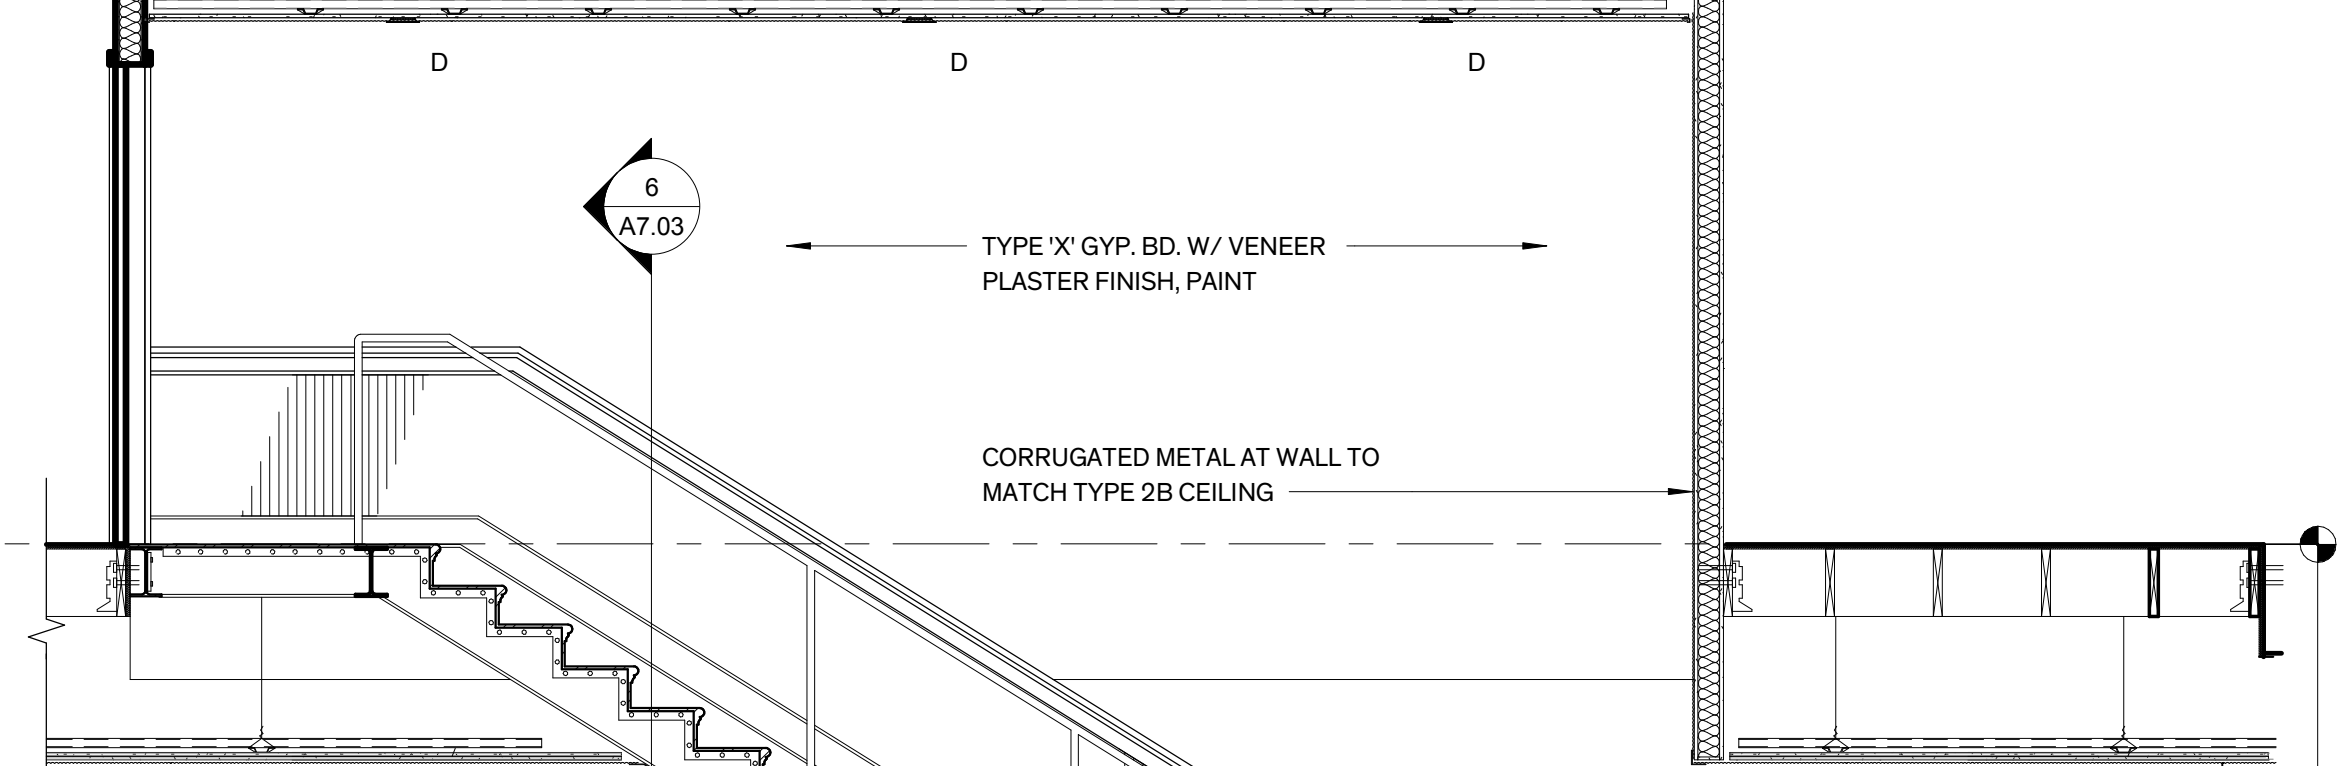


TYPE 'X' GYP. BD. W/ VENEER PLASTER FINISH, PAINT

CORRUGATED METAL AT WALL TO MATCH TYPE 2B CEILING

NEW CONCRETE CAP  
 144' - 5" +/- V.I.F.

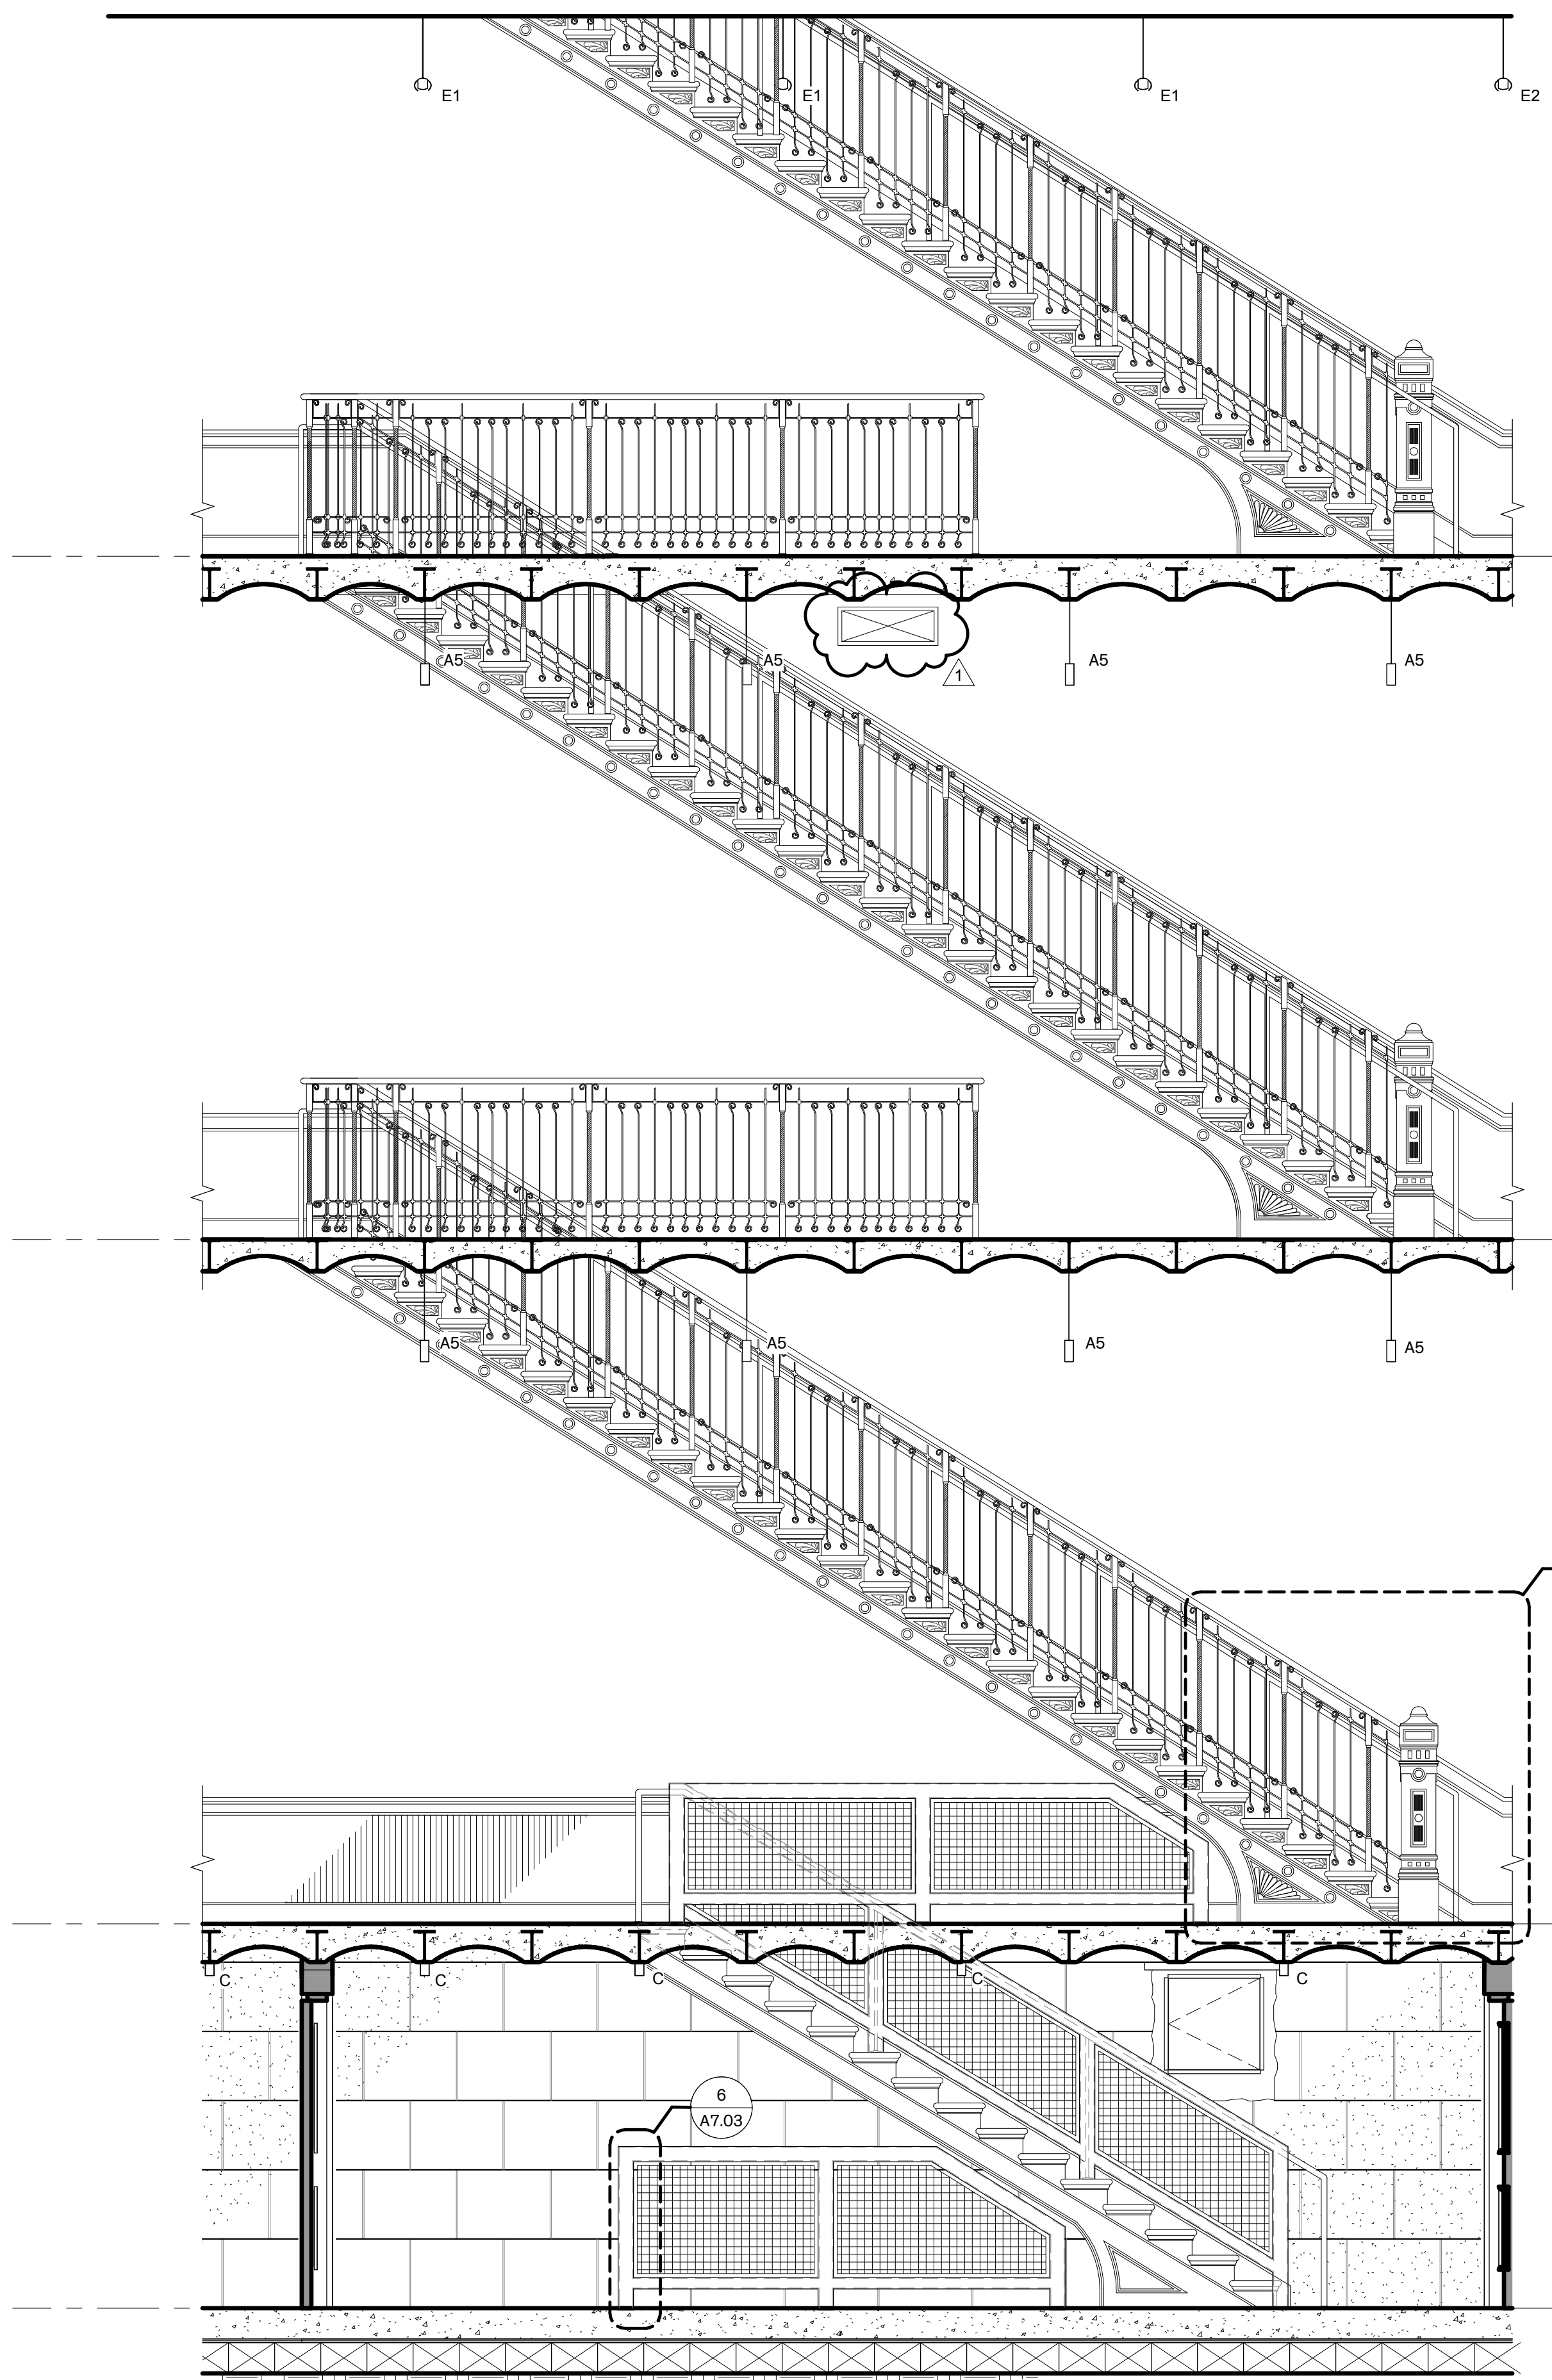

**5 West Corridor Stair Elevation**  
 3/8" = 1'-0"

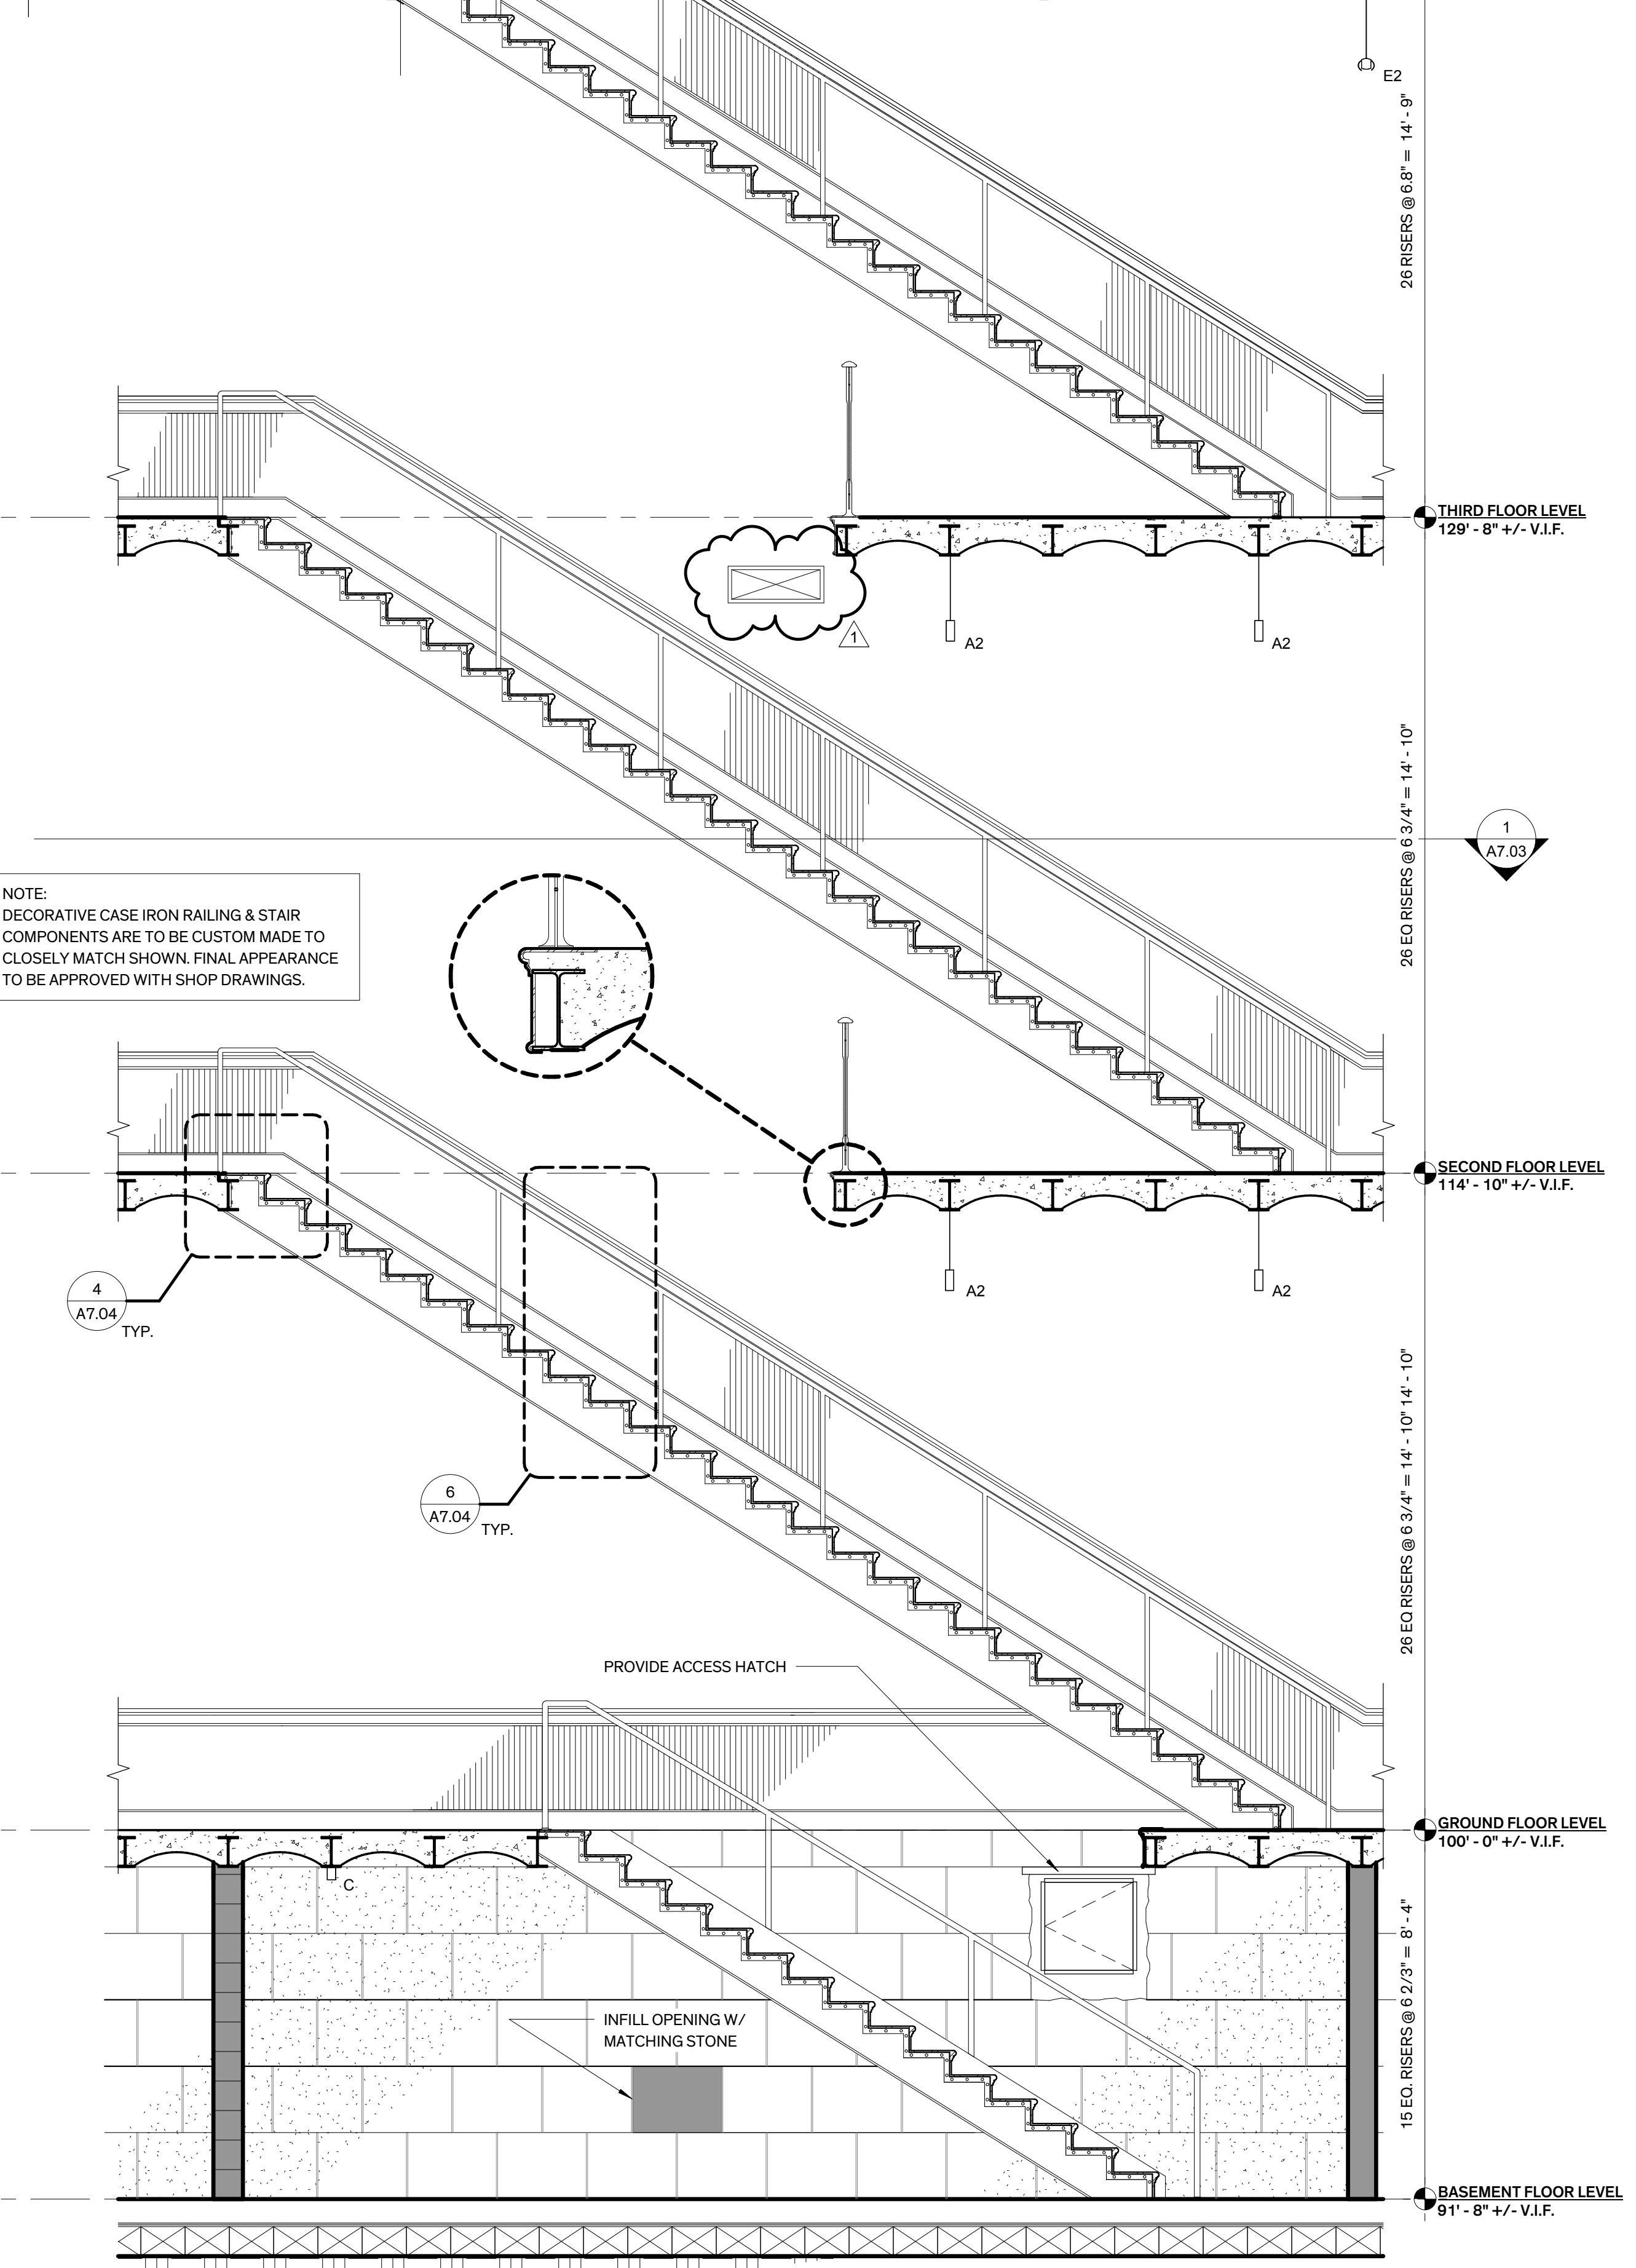

NOTE:  
 DECORATIVE CASE IRON RAILING & STAIR COMPONENTS ARE TO BE CUSTOM MADE TO CLOSELY MATCH SHOWN. FINAL APPEARANCE TO BE APPROVED WITH SHOP DRAWINGS.

PROVIDE ACCESS HATCH


INFILL OPENING W/ MATCHING STONE

THIRD FLOOR LEVEL  
 129' - 5" +/- V.I.F.

SECOND FLOOR LEVEL  
 114' - 10" +/- V.I.F.


GROUND FLOOR LEVEL  
 100' - 0" +/- V.I.F.

BASEMENT FLOOR LEVEL  
 91' - 8" +/- V.I.F.

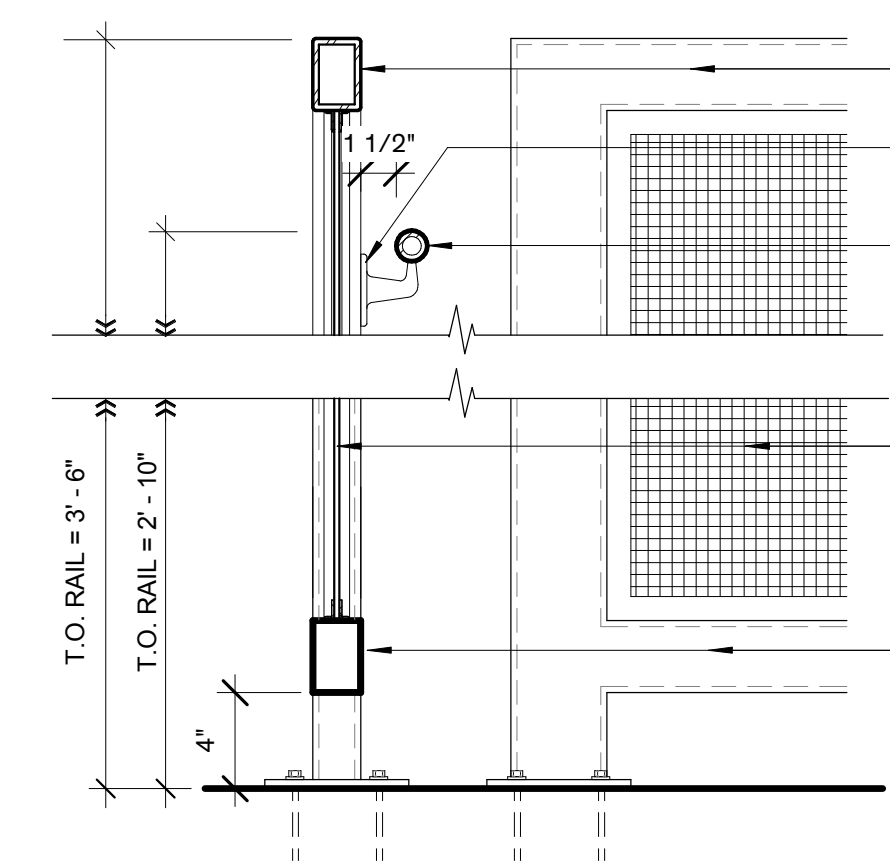


**3 Metal Rail**  
 1 1/2" = 1'-0"

TUBE STL. GUARDRAIL PER STAIR MANUFACTURER, PAINT, TYP.  
 WALL BRACKET, JULIUS BLUM 275 OR SIM  
 1 1/4" STEEL PIPE HANDRAIL, PAINT  
 PAINTED 4" X .250 WIRE CLOTH INFILL WITH STL. ANGLE FRAME, PAINT, TYP.  
 TUBE STL. GUARDRAIL PER STAIR MANUFACTURER, PAINT, TYP.

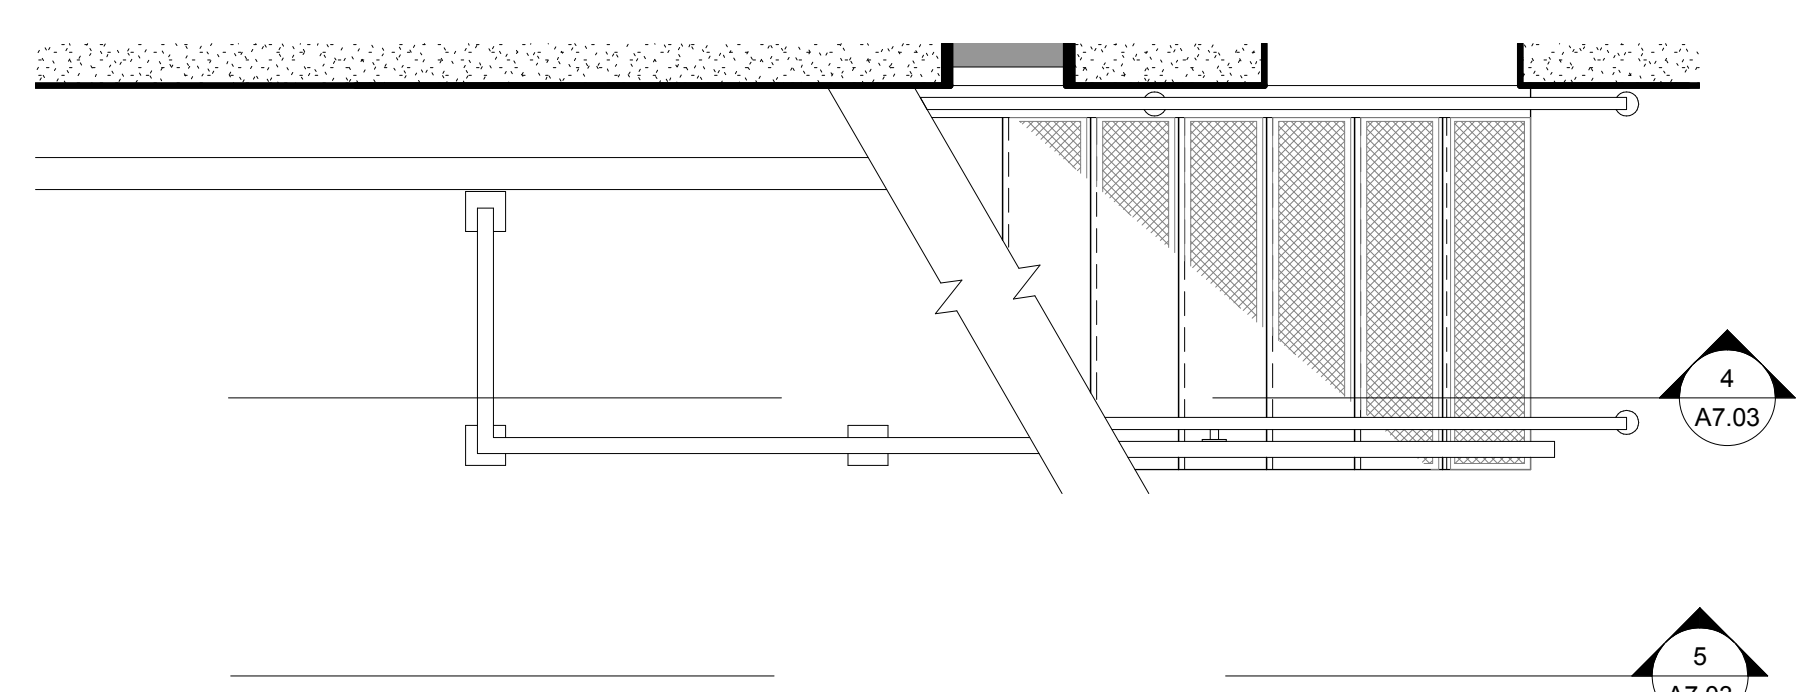

**2 Cast Iron Stair Plan**  
 1/2" = 1'-0"

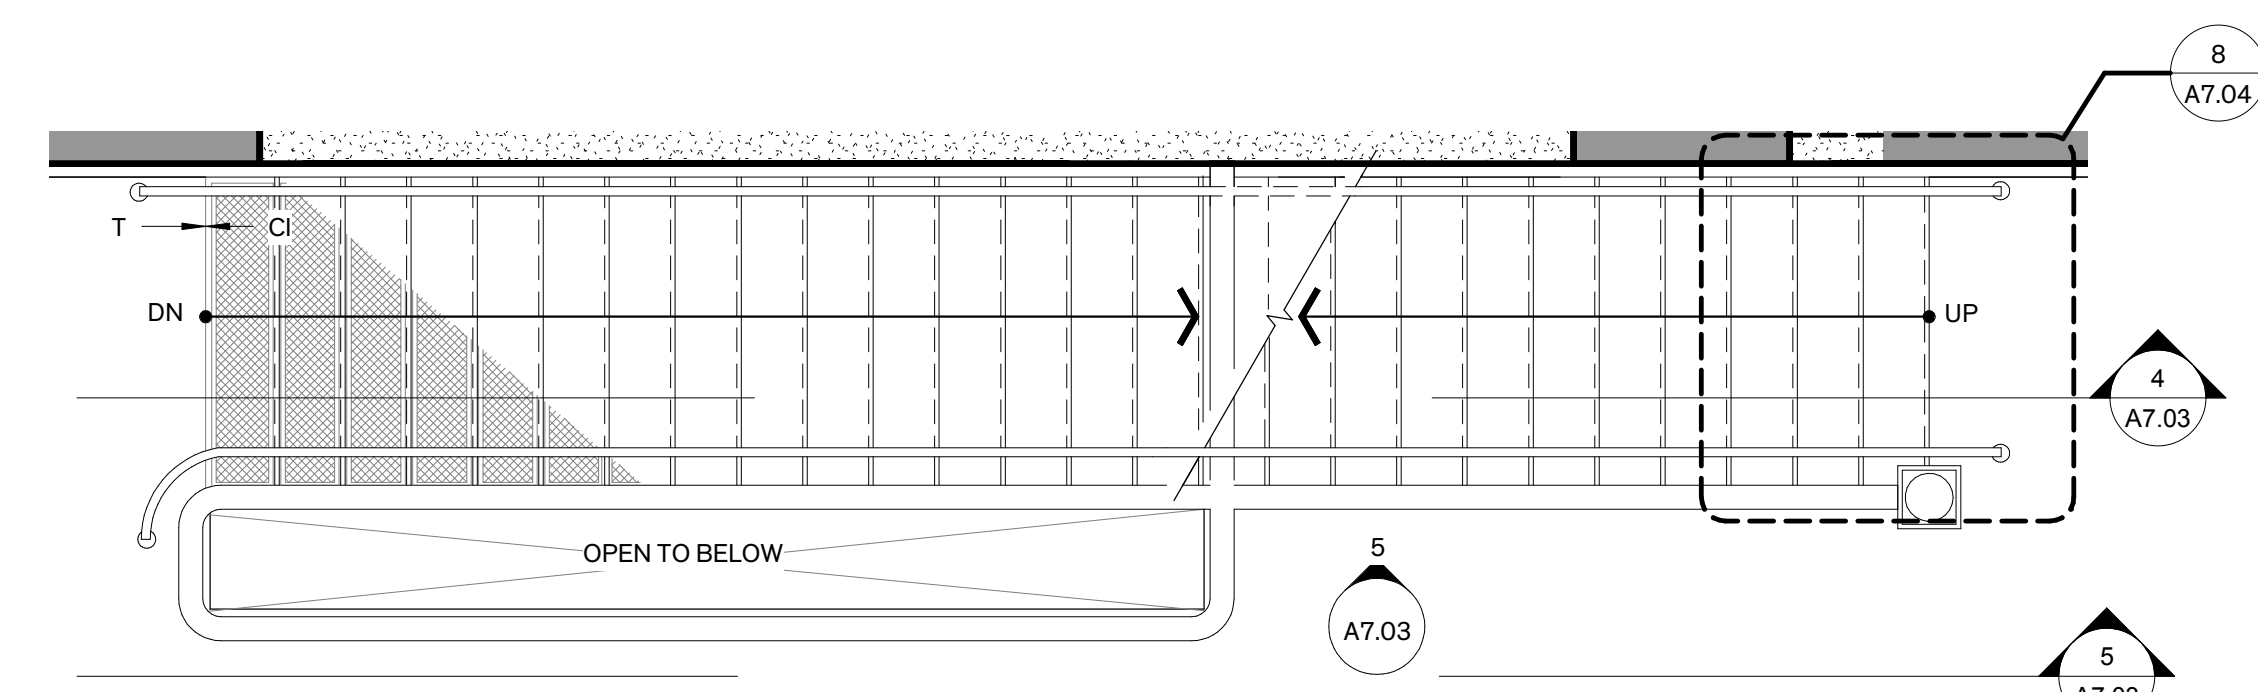

**4 West Corridor Stair Section**  
 3/8" = 1'-0"

**1 Cast Iron Stair Plan**  
 3/8" = 1'-0"




**FANNIN COUNTY COURTHOUSE**  
 INTERIOR & EXTERIOR RESTORATION  
 101 E. Sam Rayburn Drive  
 Bonham, Texas 75418

**COPYRIGHT**  
 The Contractor shall verify and be responsible for all dimensions. DO NOT scale the drawing. Any errors or omissions shall be reported to Architexas without delay. The Copyrights to all designs and drawings are the property of Architexas. Reproduction or use for any purpose other than that authorized by Architexas is forbidden.

**REVISION HISTORY**  
 1 Oct. 16, 2018 Addendum #1

ISSUED FOR CONSTRUCTION

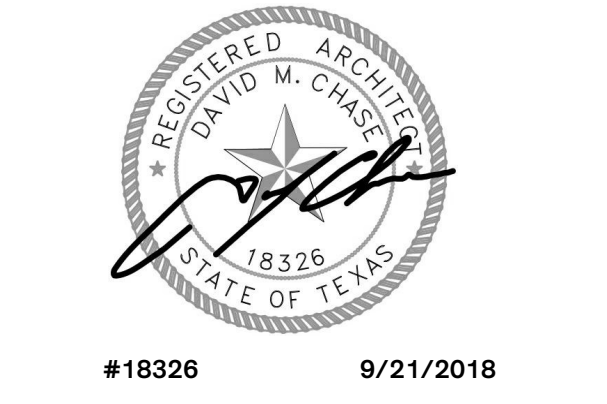

Architexas No. 1737 Date SEPT. 21, 2018

Sheet Name CAST IRON STAIRS PLANS, SECTIONS, AND DETAILS

Sheet Number A7.03



TEXAS HISTORICAL COMMISSION  
*real places telling real stories*



FANNIN COUNTY  
 COURTHOUSE  
 INTERIOR & EXTERIOR RESTORATION

101 E. Sam Rayburn Drive  
 Bonham, Texas 75418

**COPYRIGHT**  
 The Contractor shall verify and be responsible for all dimensions. DO NOT scale the drawing. Any errors or omissions shall be reported to Architexas without delay. The Copyrights to all designs and drawings are the property of Architexas. Reproduction or use for any purpose other than that authorized by Architexas is forbidden.

**REVISION HISTORY**  
 1 Oct. 16, 2018 Addendum #1

ISSUED FOR CONSTRUCTION




#18326 9/21/2018

Architexas No. 1737 Date SEPT. 21, 2018


Sheet Name MILWORK DETAILS

Sheet Number


A7.07

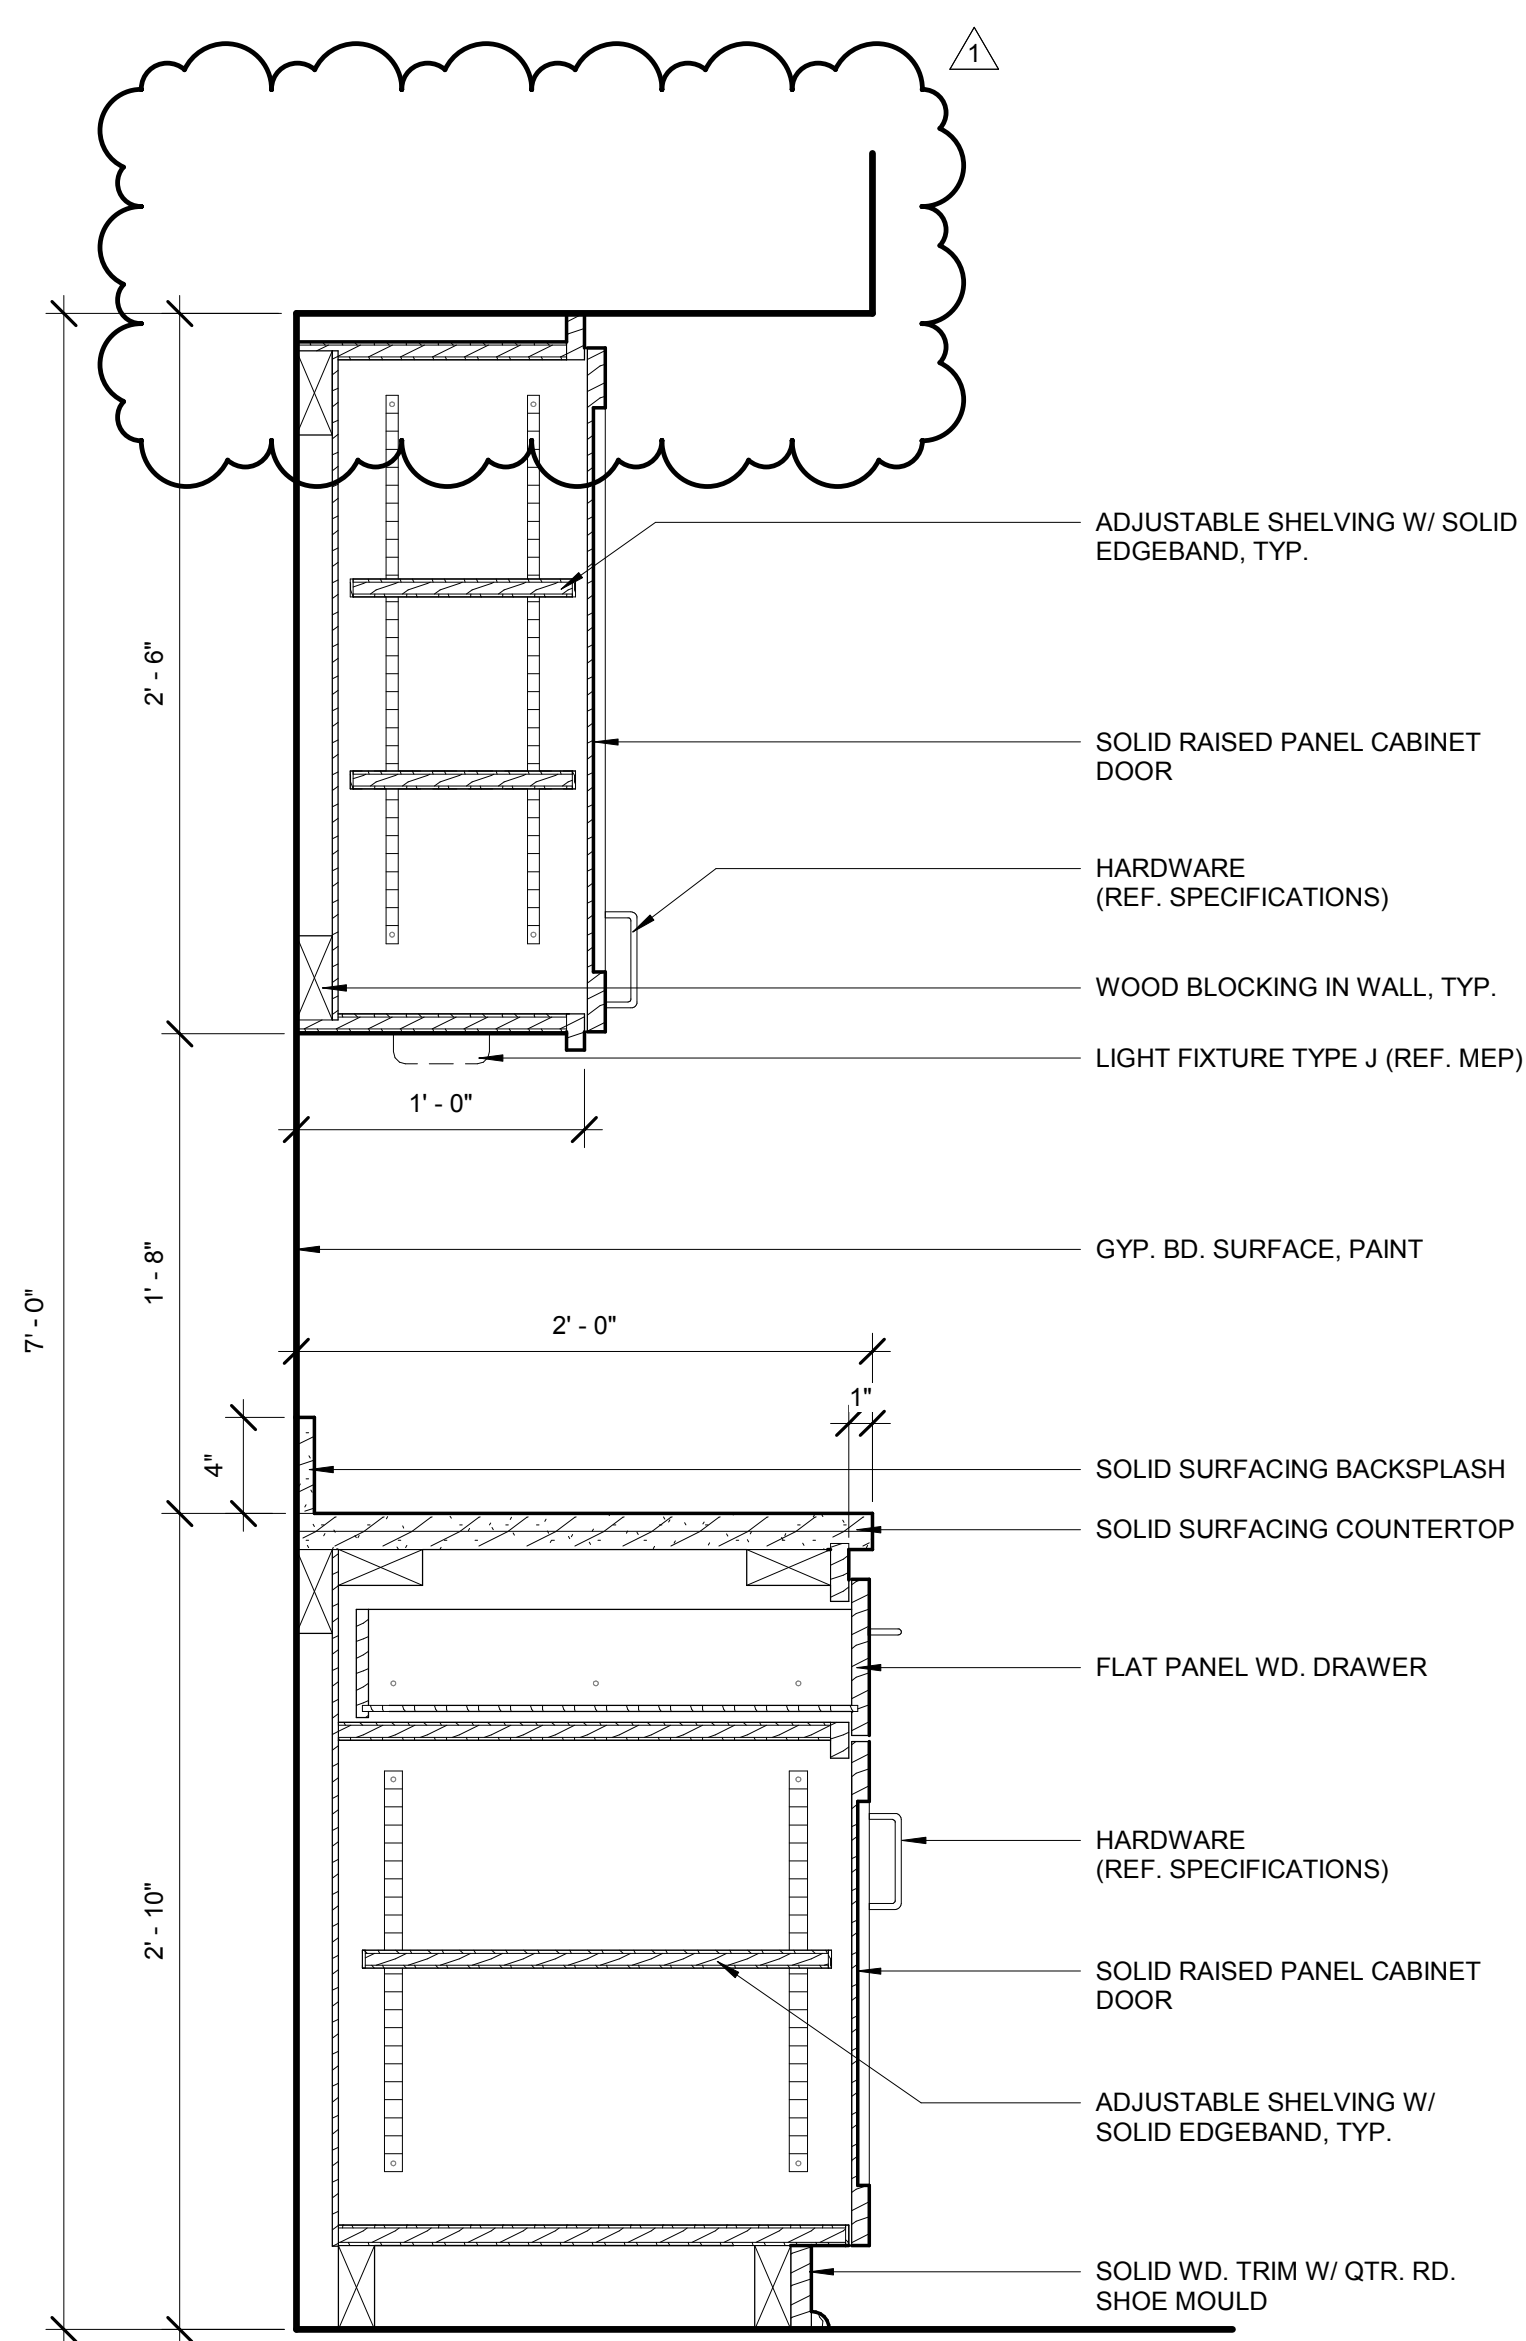

**3 Break Room Cabinet Detail**  
 1 1/2" = 1'-0"

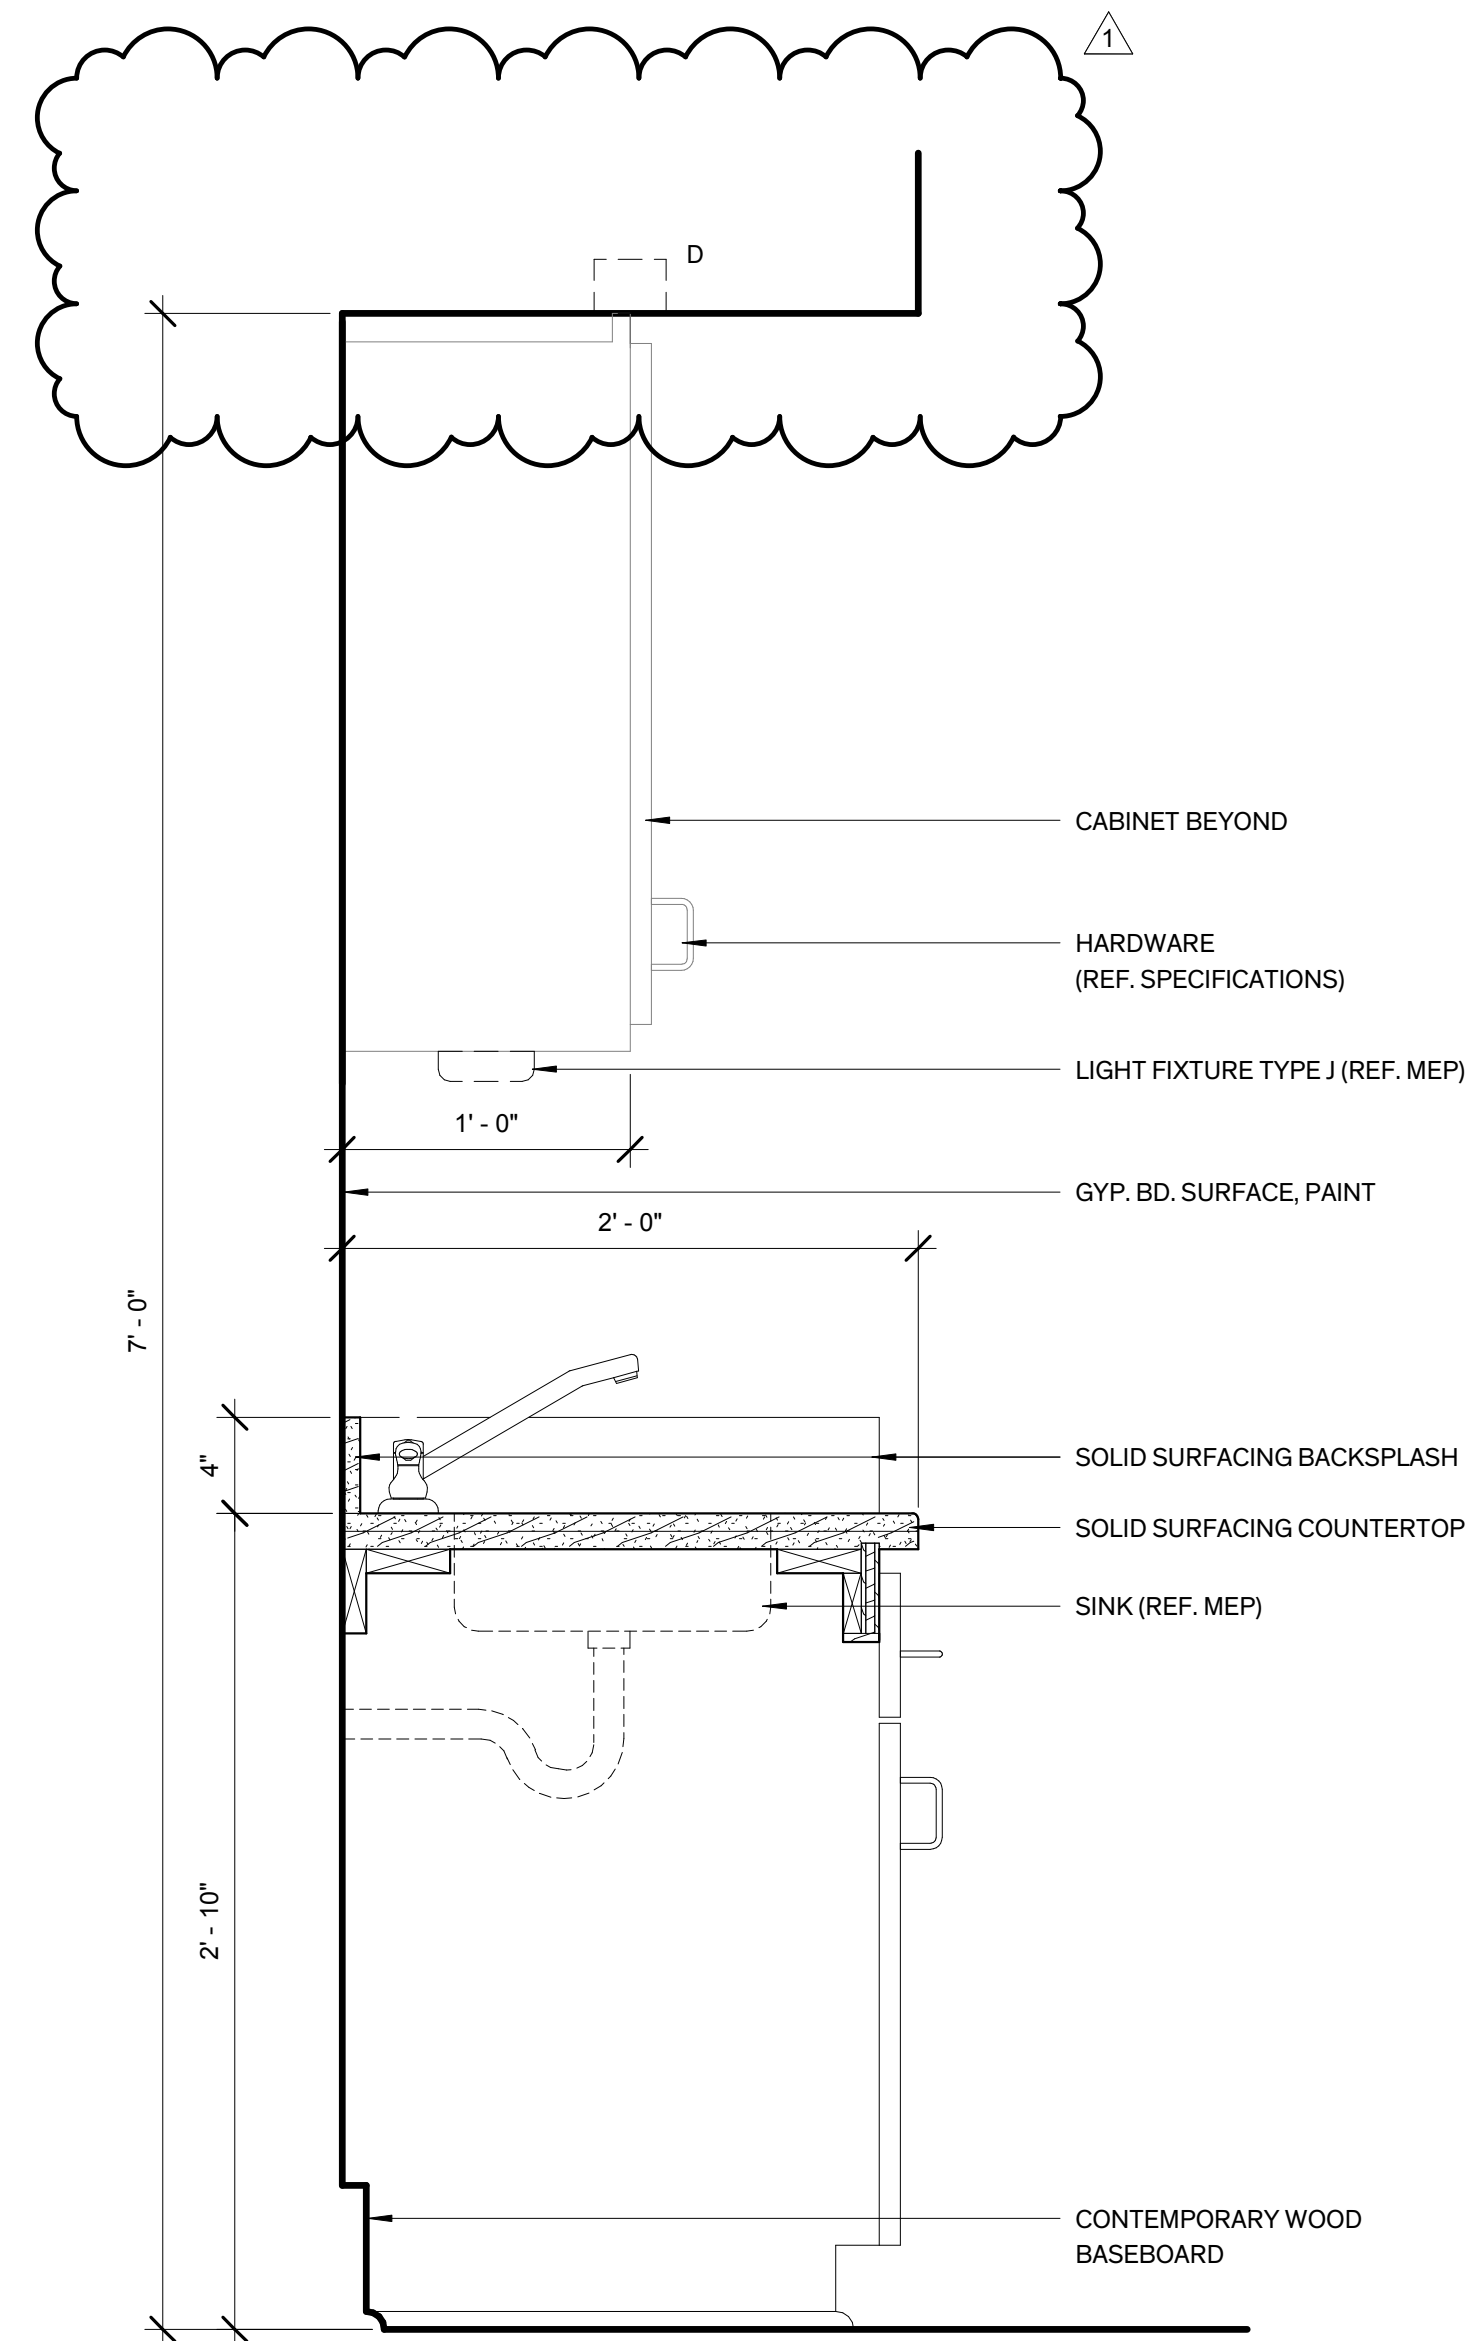

**2 Break Room Cabinet Detail**  
 1 1/2" = 1'-0"

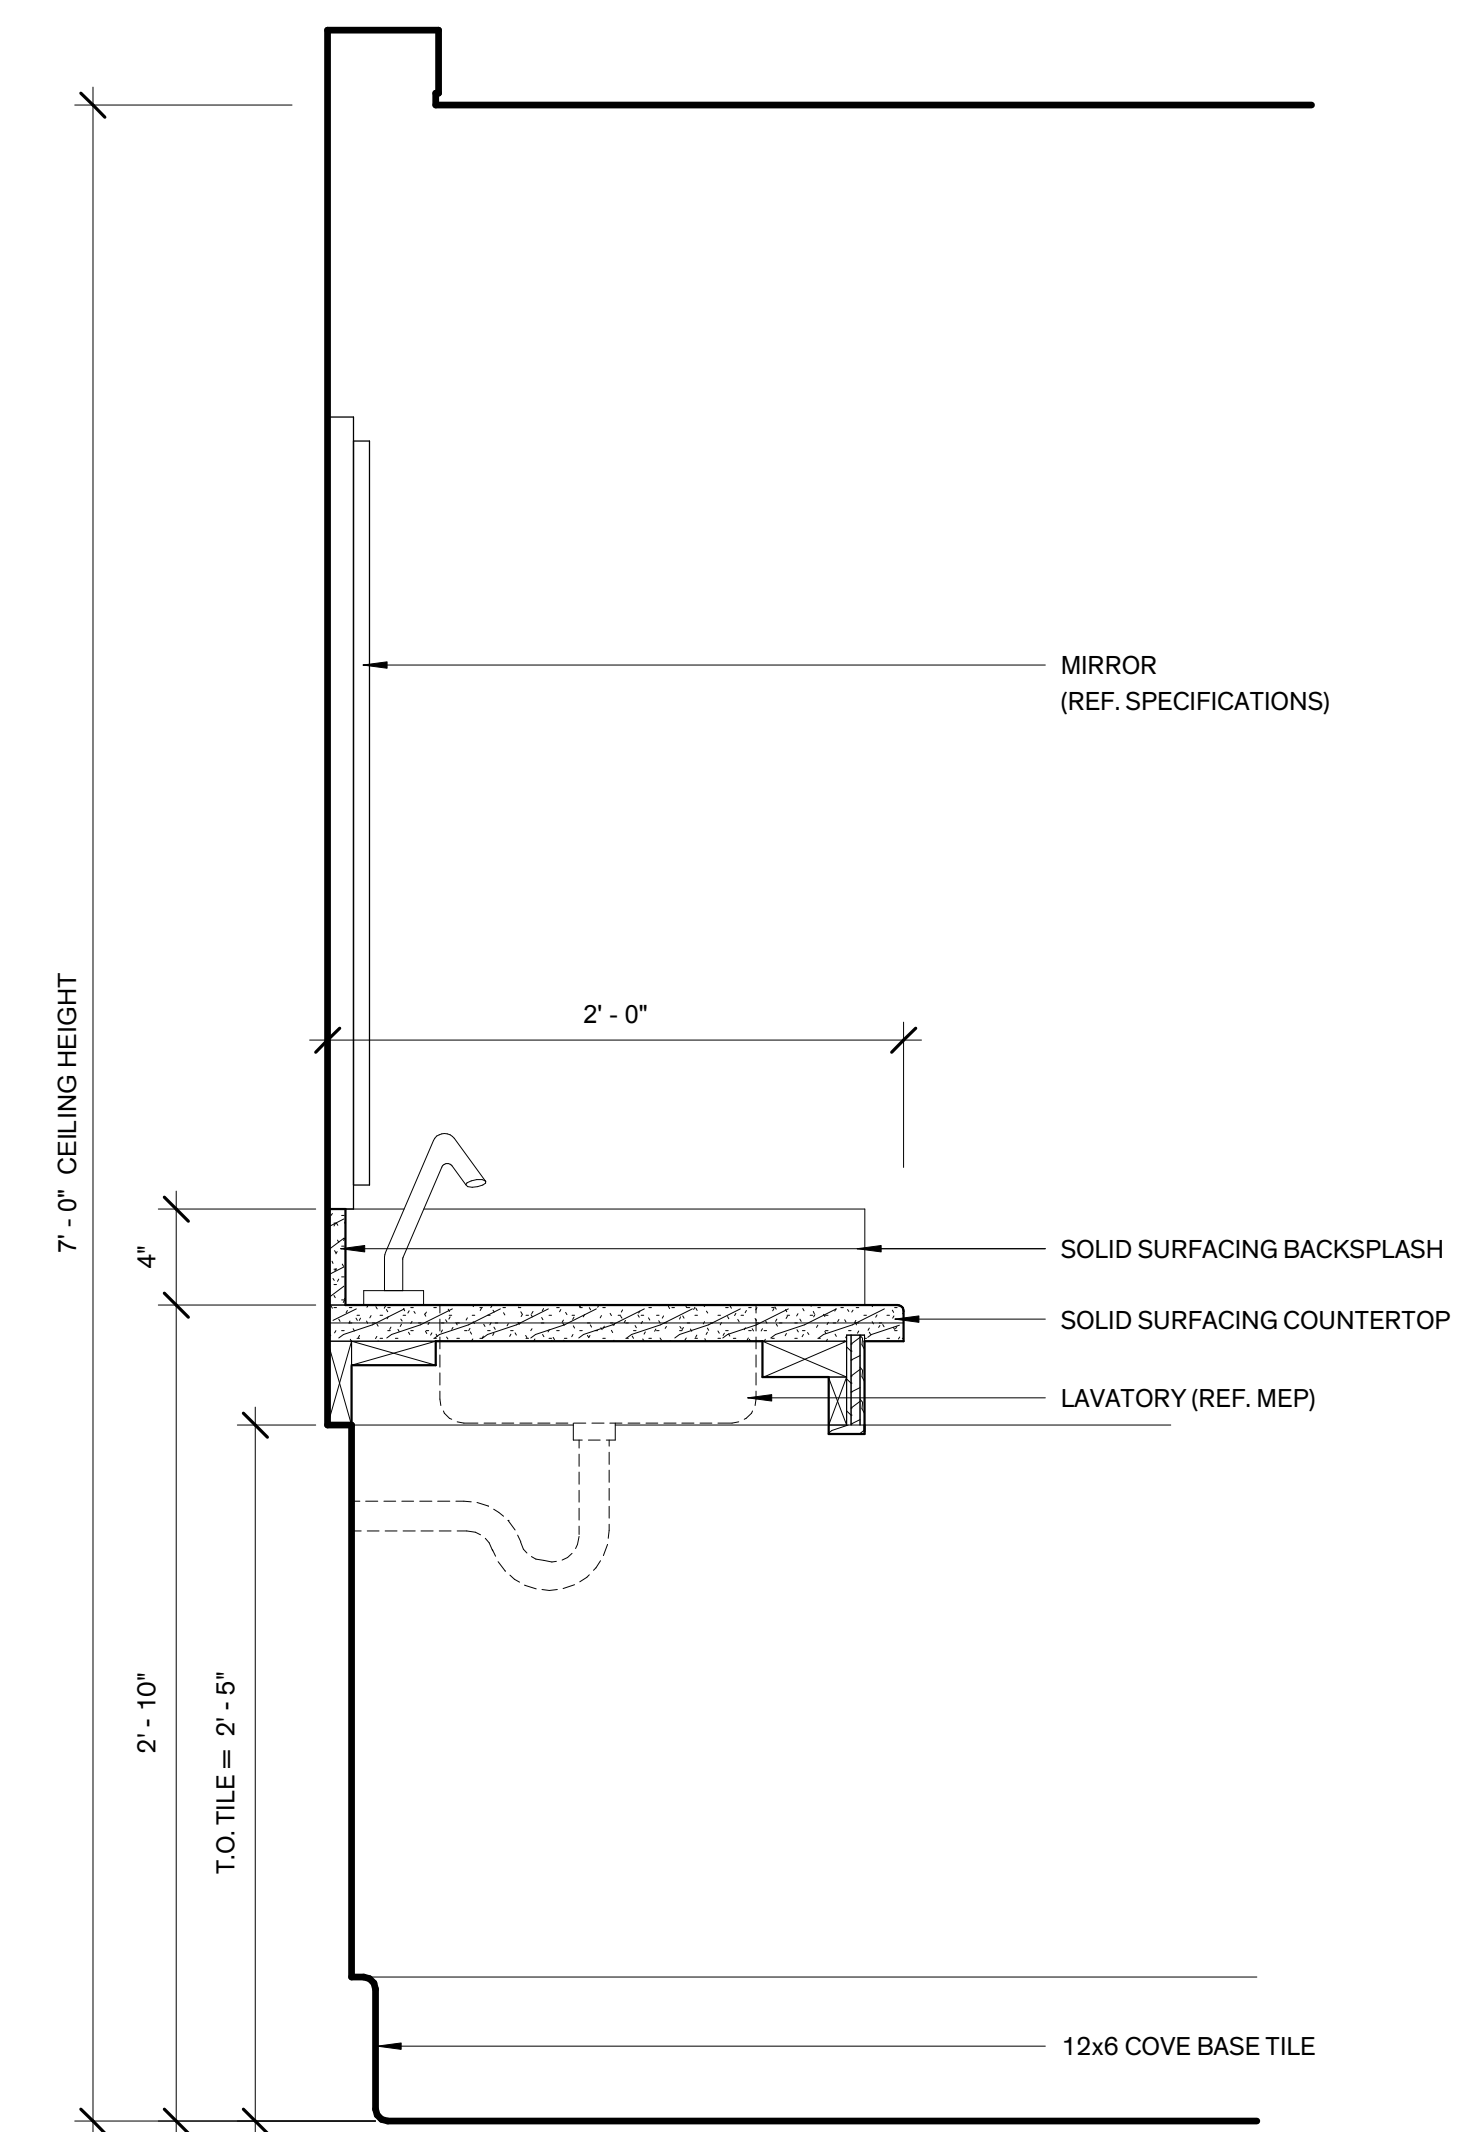

**1 Countertop Section**  
 1 1/2" = 1'-0"





TEXAS HISTORICAL COMMISSION  
real places telling real stories



FANNIN COUNTY  
COURTHOUSE  
INTERIOR & EXTERIOR RESTORATION

101 E. Sam Rayburn Drive  
Bonham, Texas 75418

**COPYRIGHT**  
The Contractor shall verify and be responsible for all dimensions. DO NOT scale the drawing. Any errors or omissions shall be reported to Architexas without delay. The Copyrights to all designs and drawings are the property of Architexas. Reproduction or use for any purpose other than that authorized by Architexas is forbidden.

**REVISION HISTORY**  
1 Oct. 16, 2018 Addendum #1

ISSUED FOR CONSTRUCTION




#18326 9/21/2018


Architexas No. 1737 Date SEPT. 21, 2018

Sheet Name BALCONY DETAILS


Sheet Number A7.08

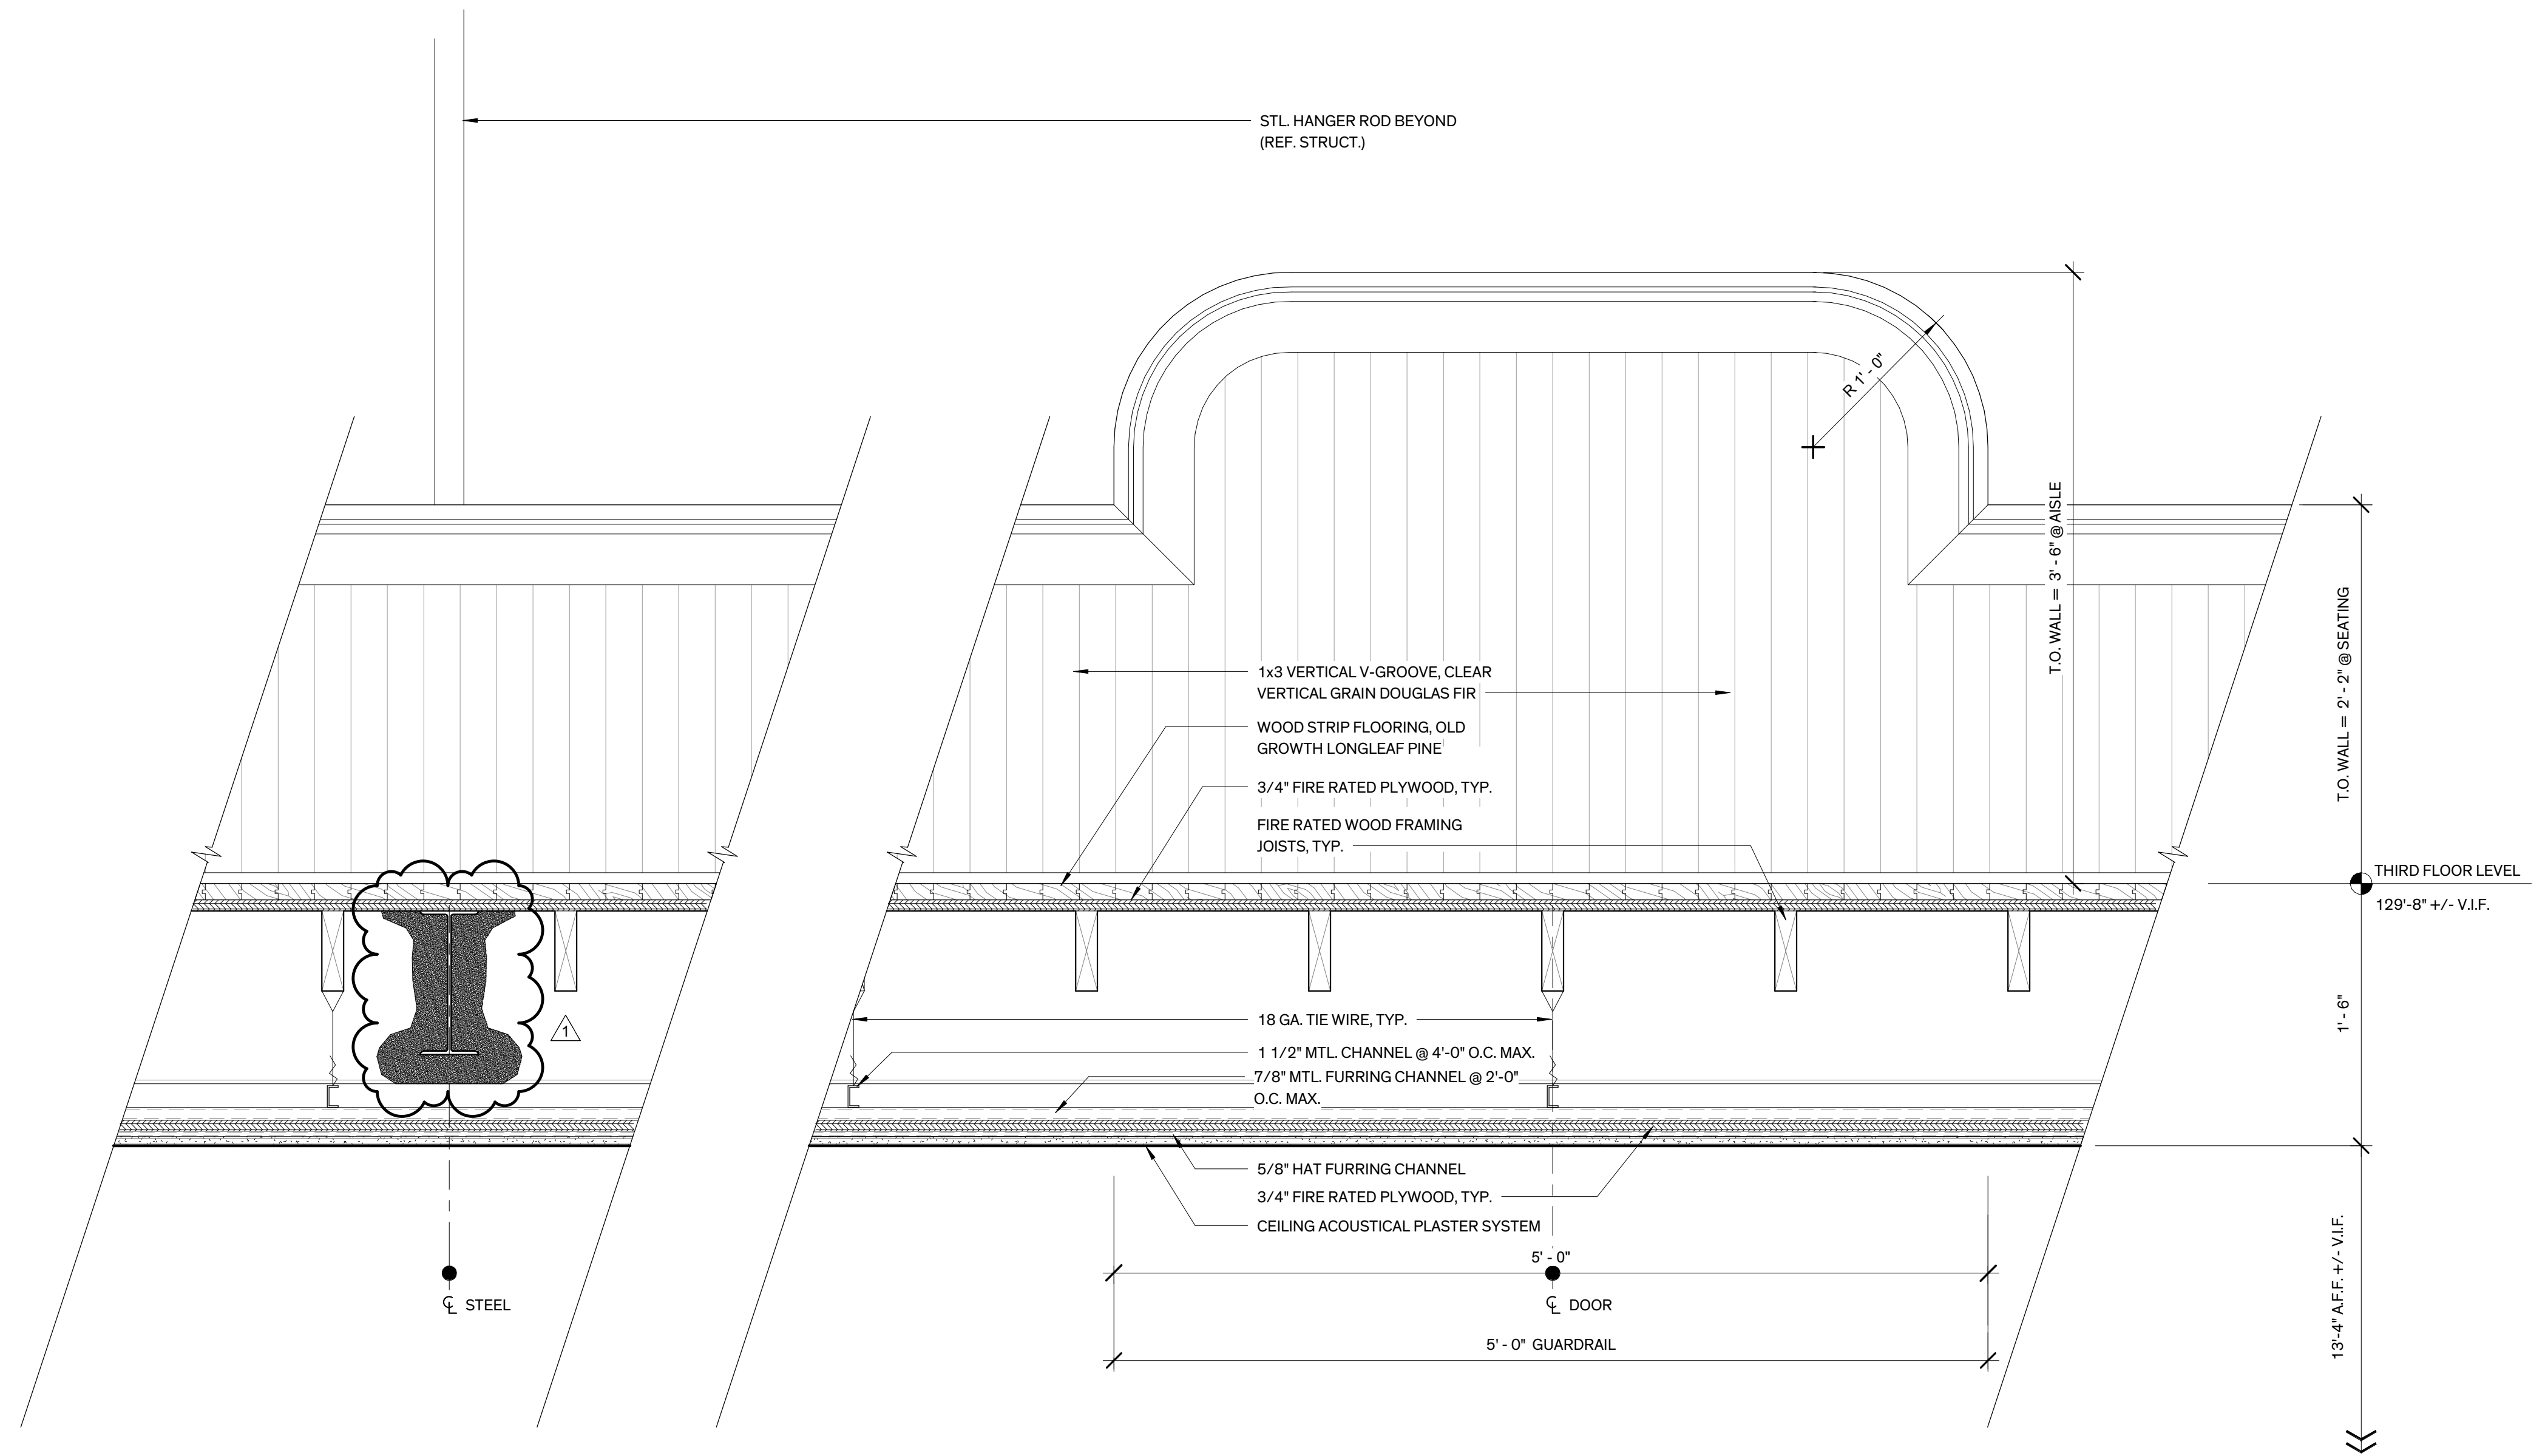

**3 Section @ Balcony Aisle**  
1 1/2" = 1'-0"

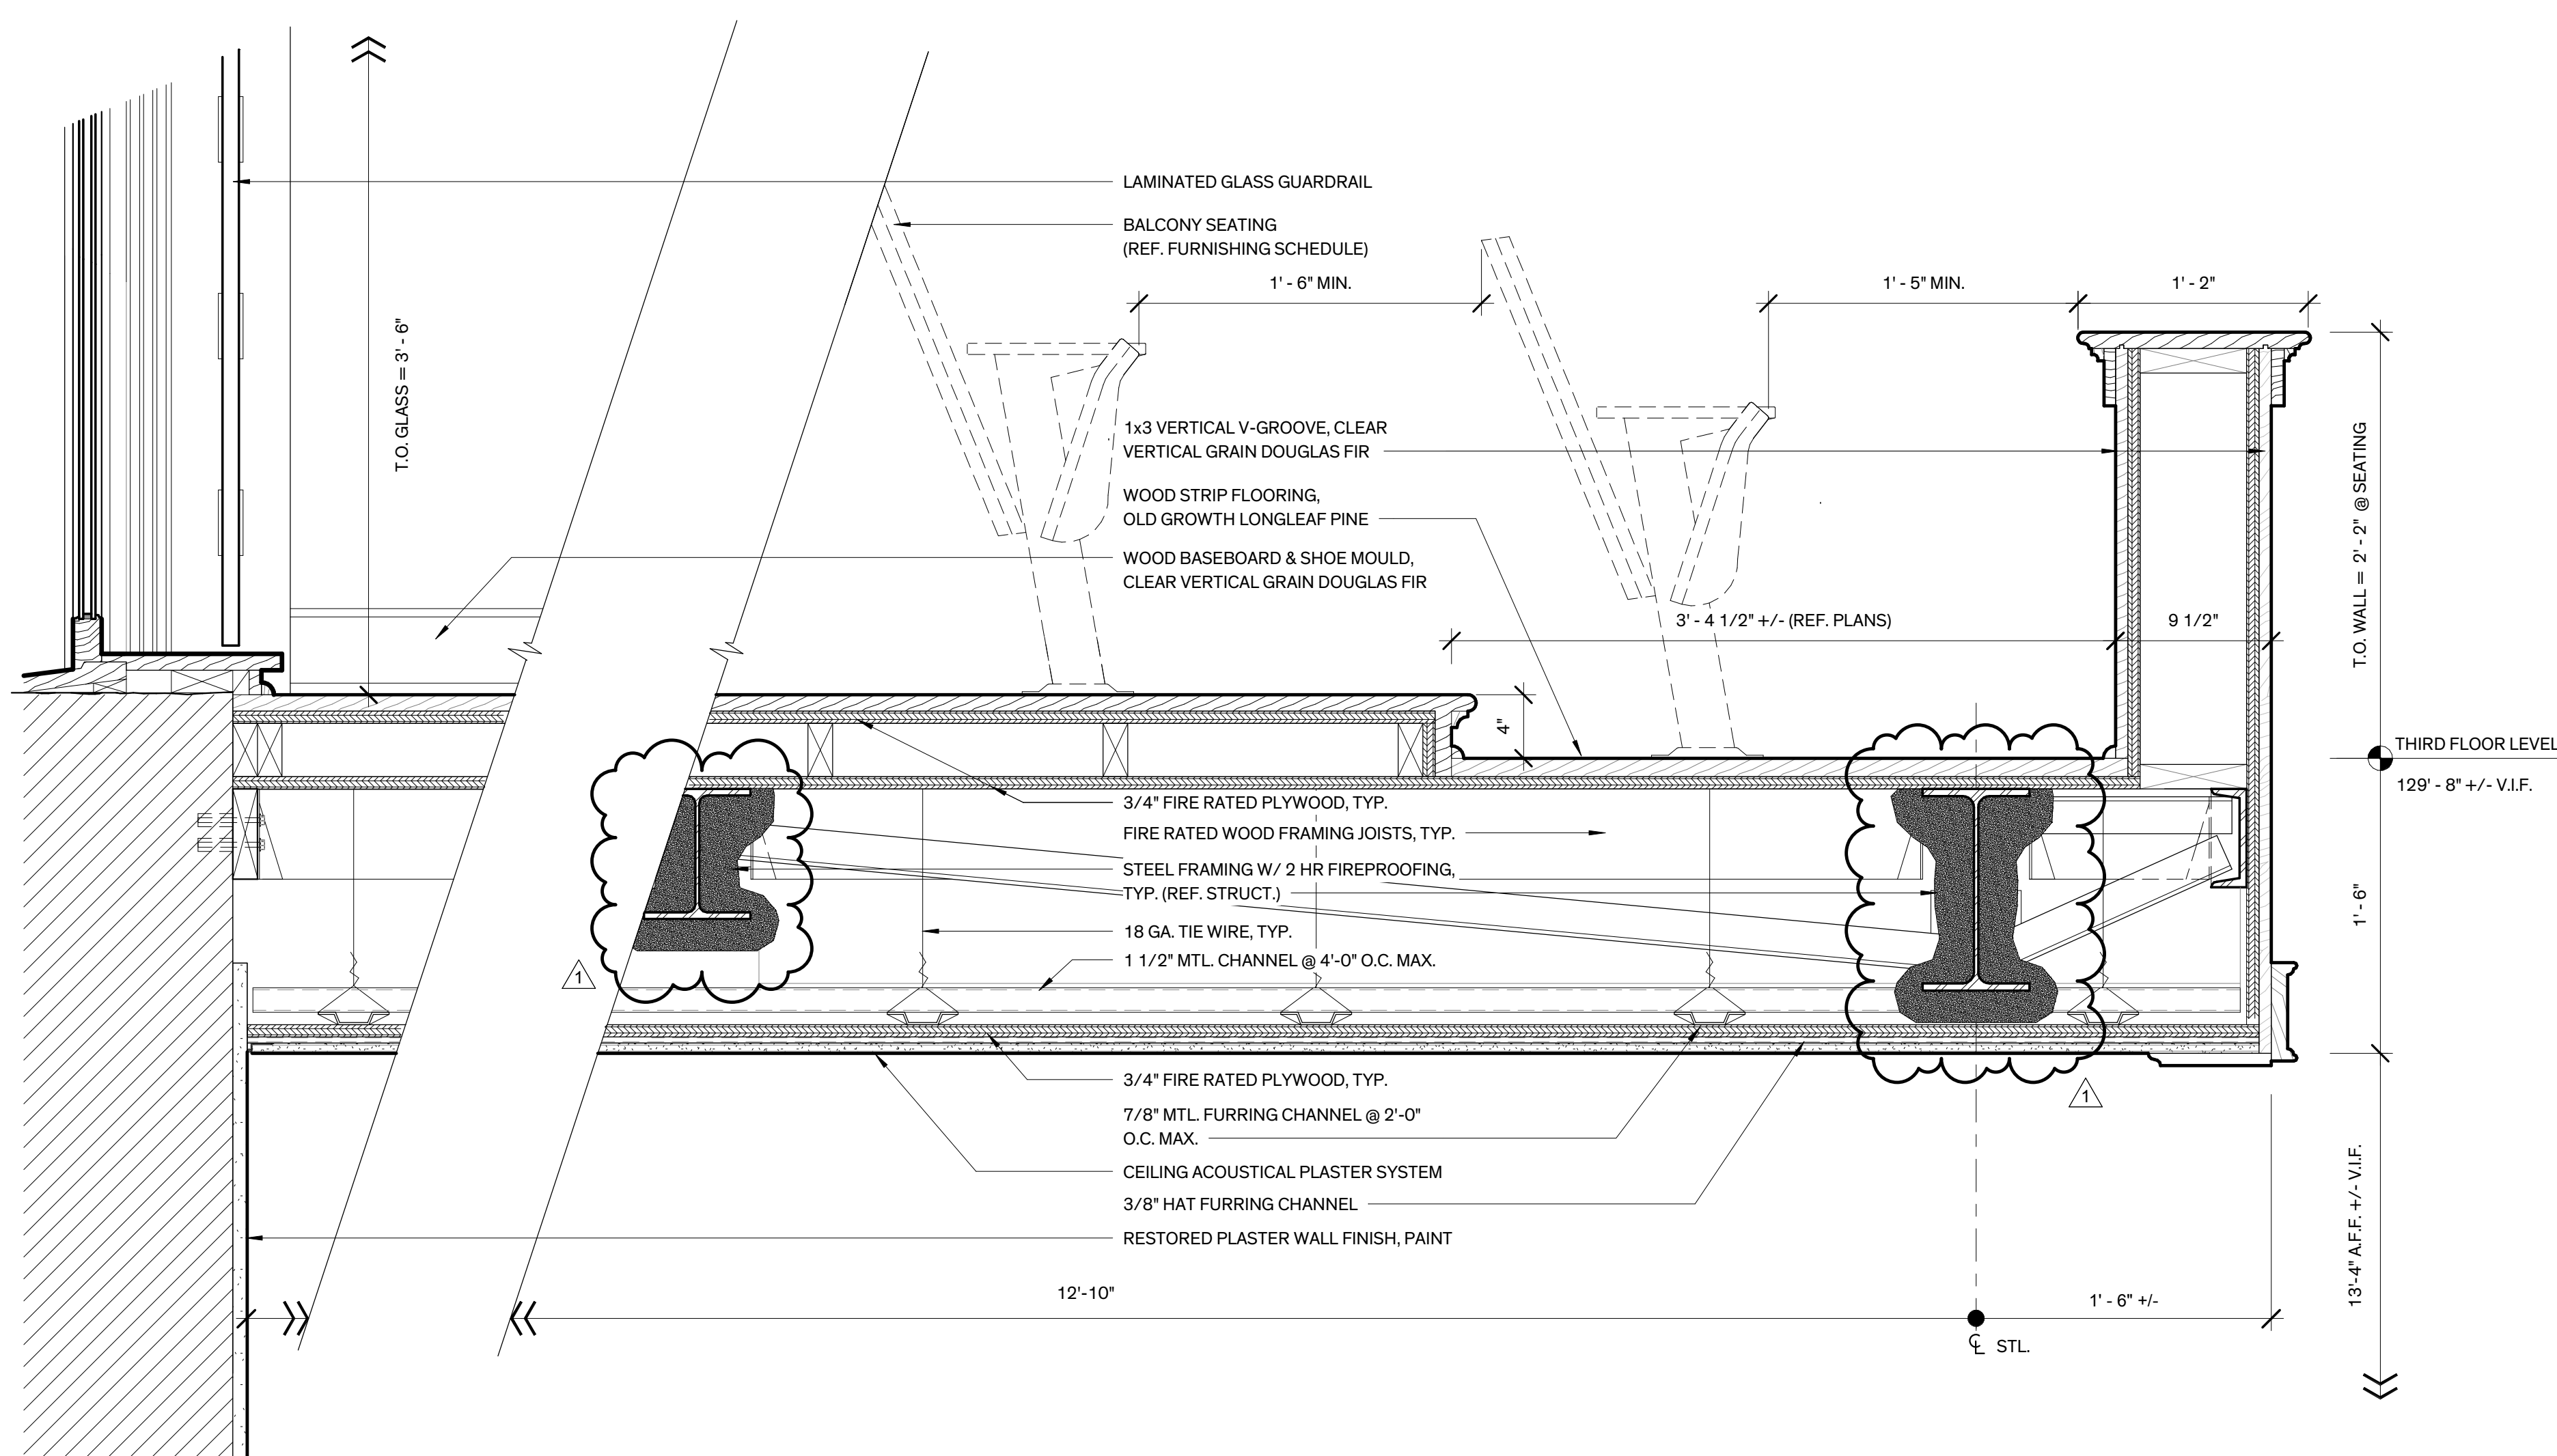


**2 Section @ Balcony**  
1 1/2" = 1'-0"

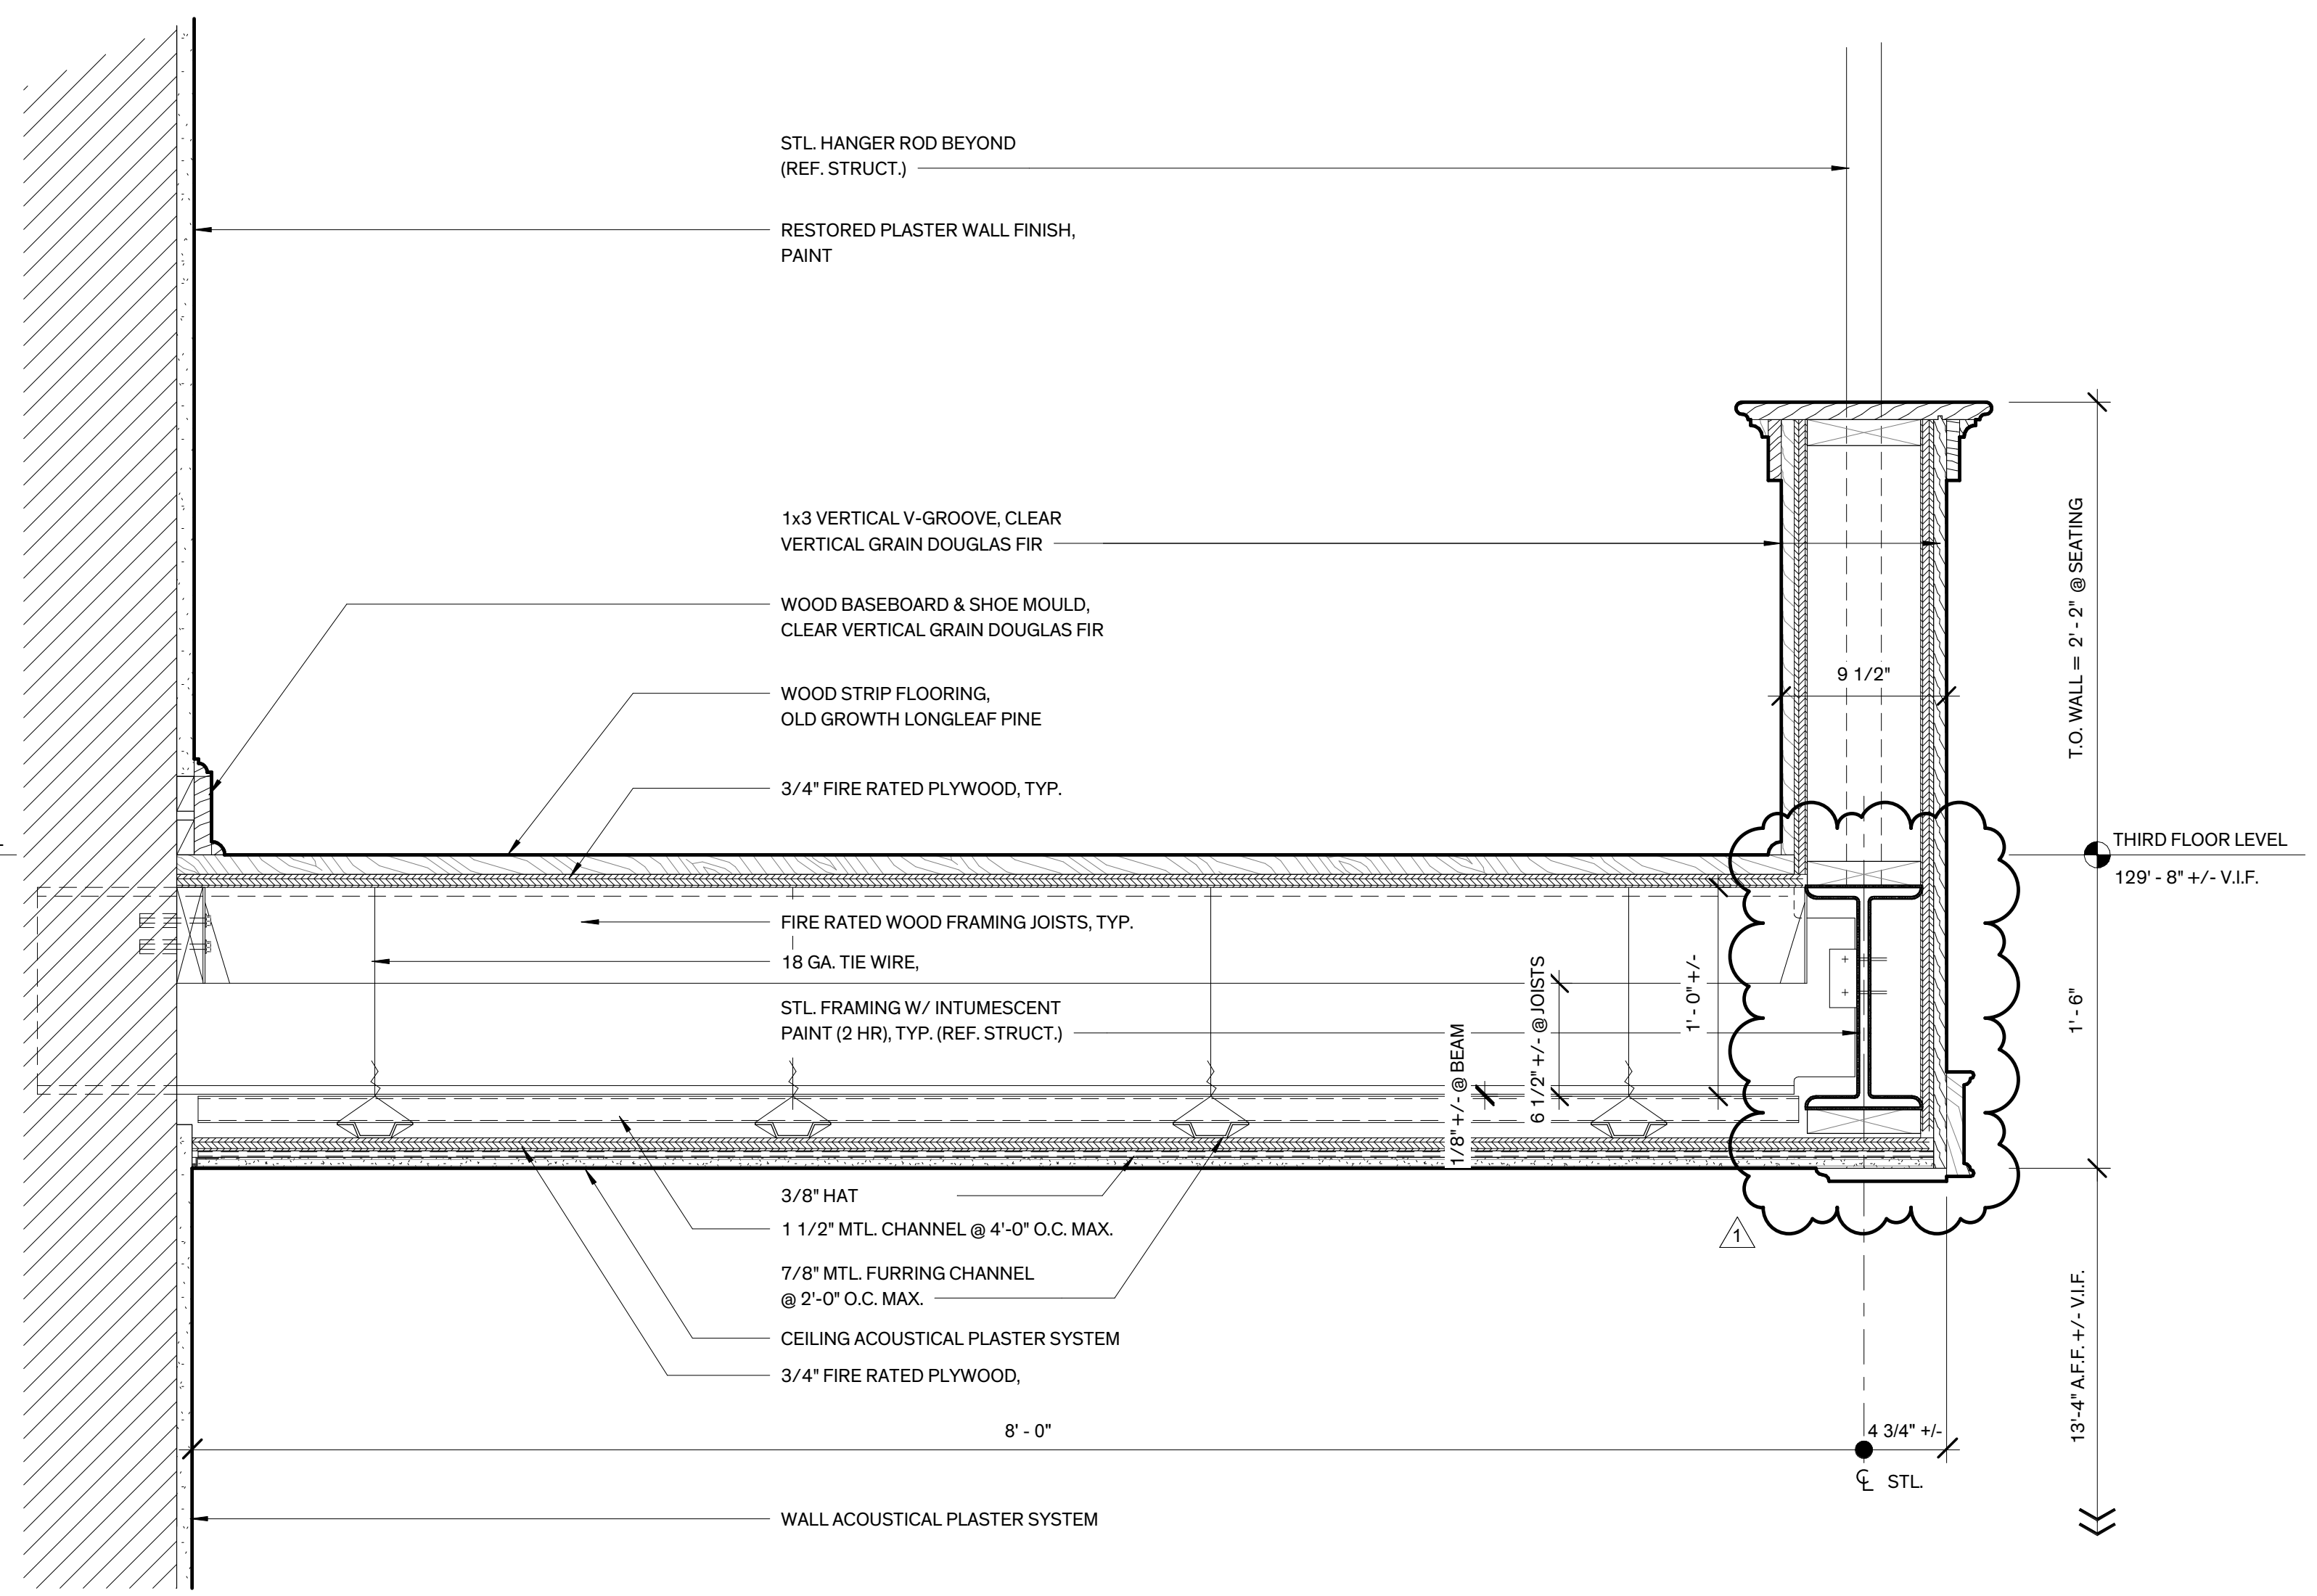


**1 Section @ Balcony**  
1 1/2" = 1'-0"

**GENERAL NOTES**


- GENERAL**
- PROVIDE CUPOLA WORK SHOWN ON THE DRAWINGS AND SPECIFICATIONS AND AS NEEDED FOR A COMPLETE AND PROPER INSTALLATION. PREFABRICATED ALUMINUM CUPOLA ASSEMBLY, INCLUDING:
    - A) ALUMINUM STRUCTURAL FRAMING.
    - B) ALUMINUM CLADDING AND BAKED ON KYNAR FINISHES IN COLOR SELECTED BY THE ARCHITECT.
    - C) U.L. APPROVED SYSTEM FROM BASE OF CUPOLA TO TOP, WITH U.L. APPROVED LIGHTNING AIR TERMINAL.
    - D) CLOCK SYSTEM INCLUDING DIALS, HANDS, NUMERALS, MOVEMENTS AND ILLUMINATION.
  - DIMENSIONS PROVIDED ARE FOR DESIGN INTENT ONLY. FINAL DIMENSIONS TO BE COORDINATED & CONFIRMED BY TOWER MANUFACTURER.
- SUBMITTALS**
- PRODUCT DATA: INCLUDE CONSTRUCTION DETAILS, MATERIAL DESCRIPTIONS, DIMENSIONS OF INDIVIDUAL COMPONENTS, PROFILES AND FINISHES FOR EACH TYPE OF METAL PANEL AND ACCESSORY. SUBMIT COMPREHENSIVE SHOP DRAWINGS CLEARLY ILLUSTRATING FABRICATION AND INSTALLATION LAYOUTS OF METAL PANELS; DETAILS OF EDGE CONDITIONS, JOINTS, PANEL PROFILE, CORNERS, ANCHORAGES, TRIM, FLASHING, CLOSURES AND ACCESSORIES; AND SPECIAL DETAILS, DISTINGUISH BETWEEN FACTORY - ASSEMBLY AND FIELD ASSEMBLY WORK.
  - INCLUDE THE FOLLOWING:
    - A) PLAN AND ELEVATIONS
    - B) FRAMING AND ANCHORAGE DETAILS
    - C) FLASHING DETAILS
    - D) LIGHTNING PROTECTION AIR TERMINAL MOUNTED TO CUPOLA DOME
    - E) VENTILATION LOUVERS
    - F) ACCESSORY COMPONENTS
  - IF REQUIRED PROVIDE STAMPED AND SEALED DRAWINGS OF A PROFESSIONAL ENGINEER, LICENSED IN THE STATE OF TEXAS ON FINAL APPROVED DRAWINGS.
  - SUBMIT KYNAR COLOR SAMPLES OF EXTERIOR COVERING, SAMPLES FOR INITIAL SELECTION, FOR FACTORY APPLIED COLOR FINISHES.

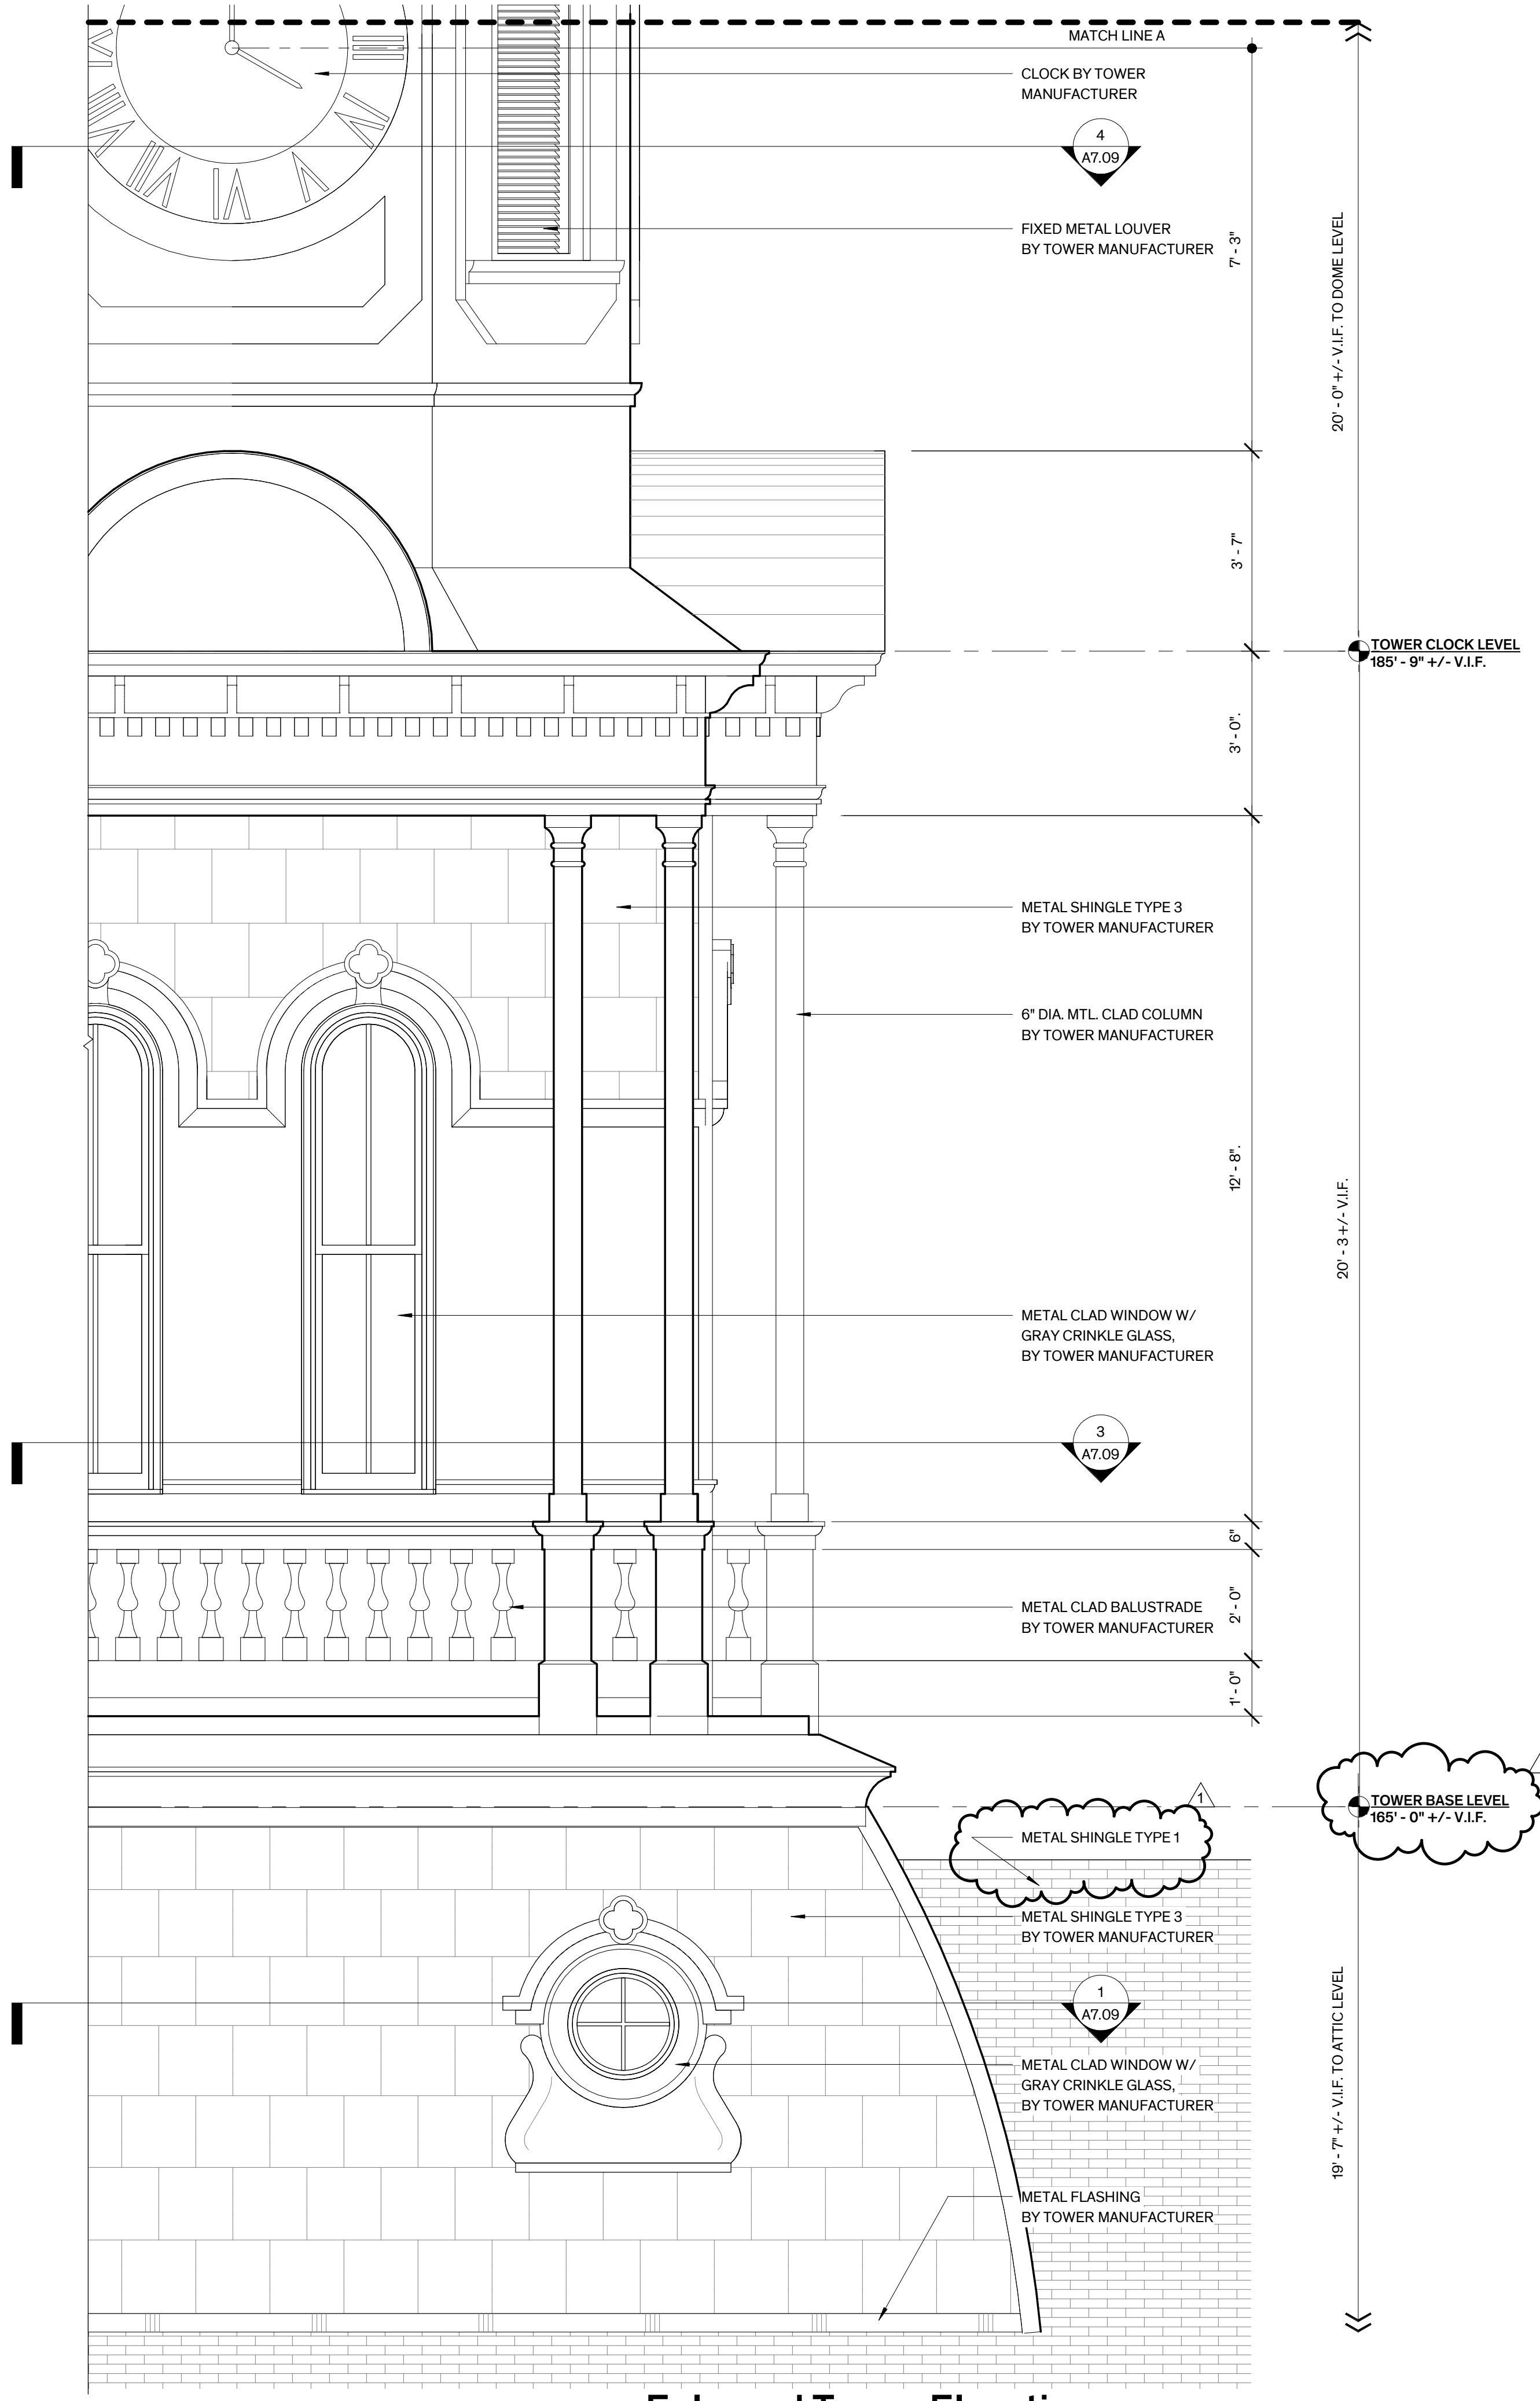


**2 Enlarged Tower Elevation**  
 1/2" = 1'-0"

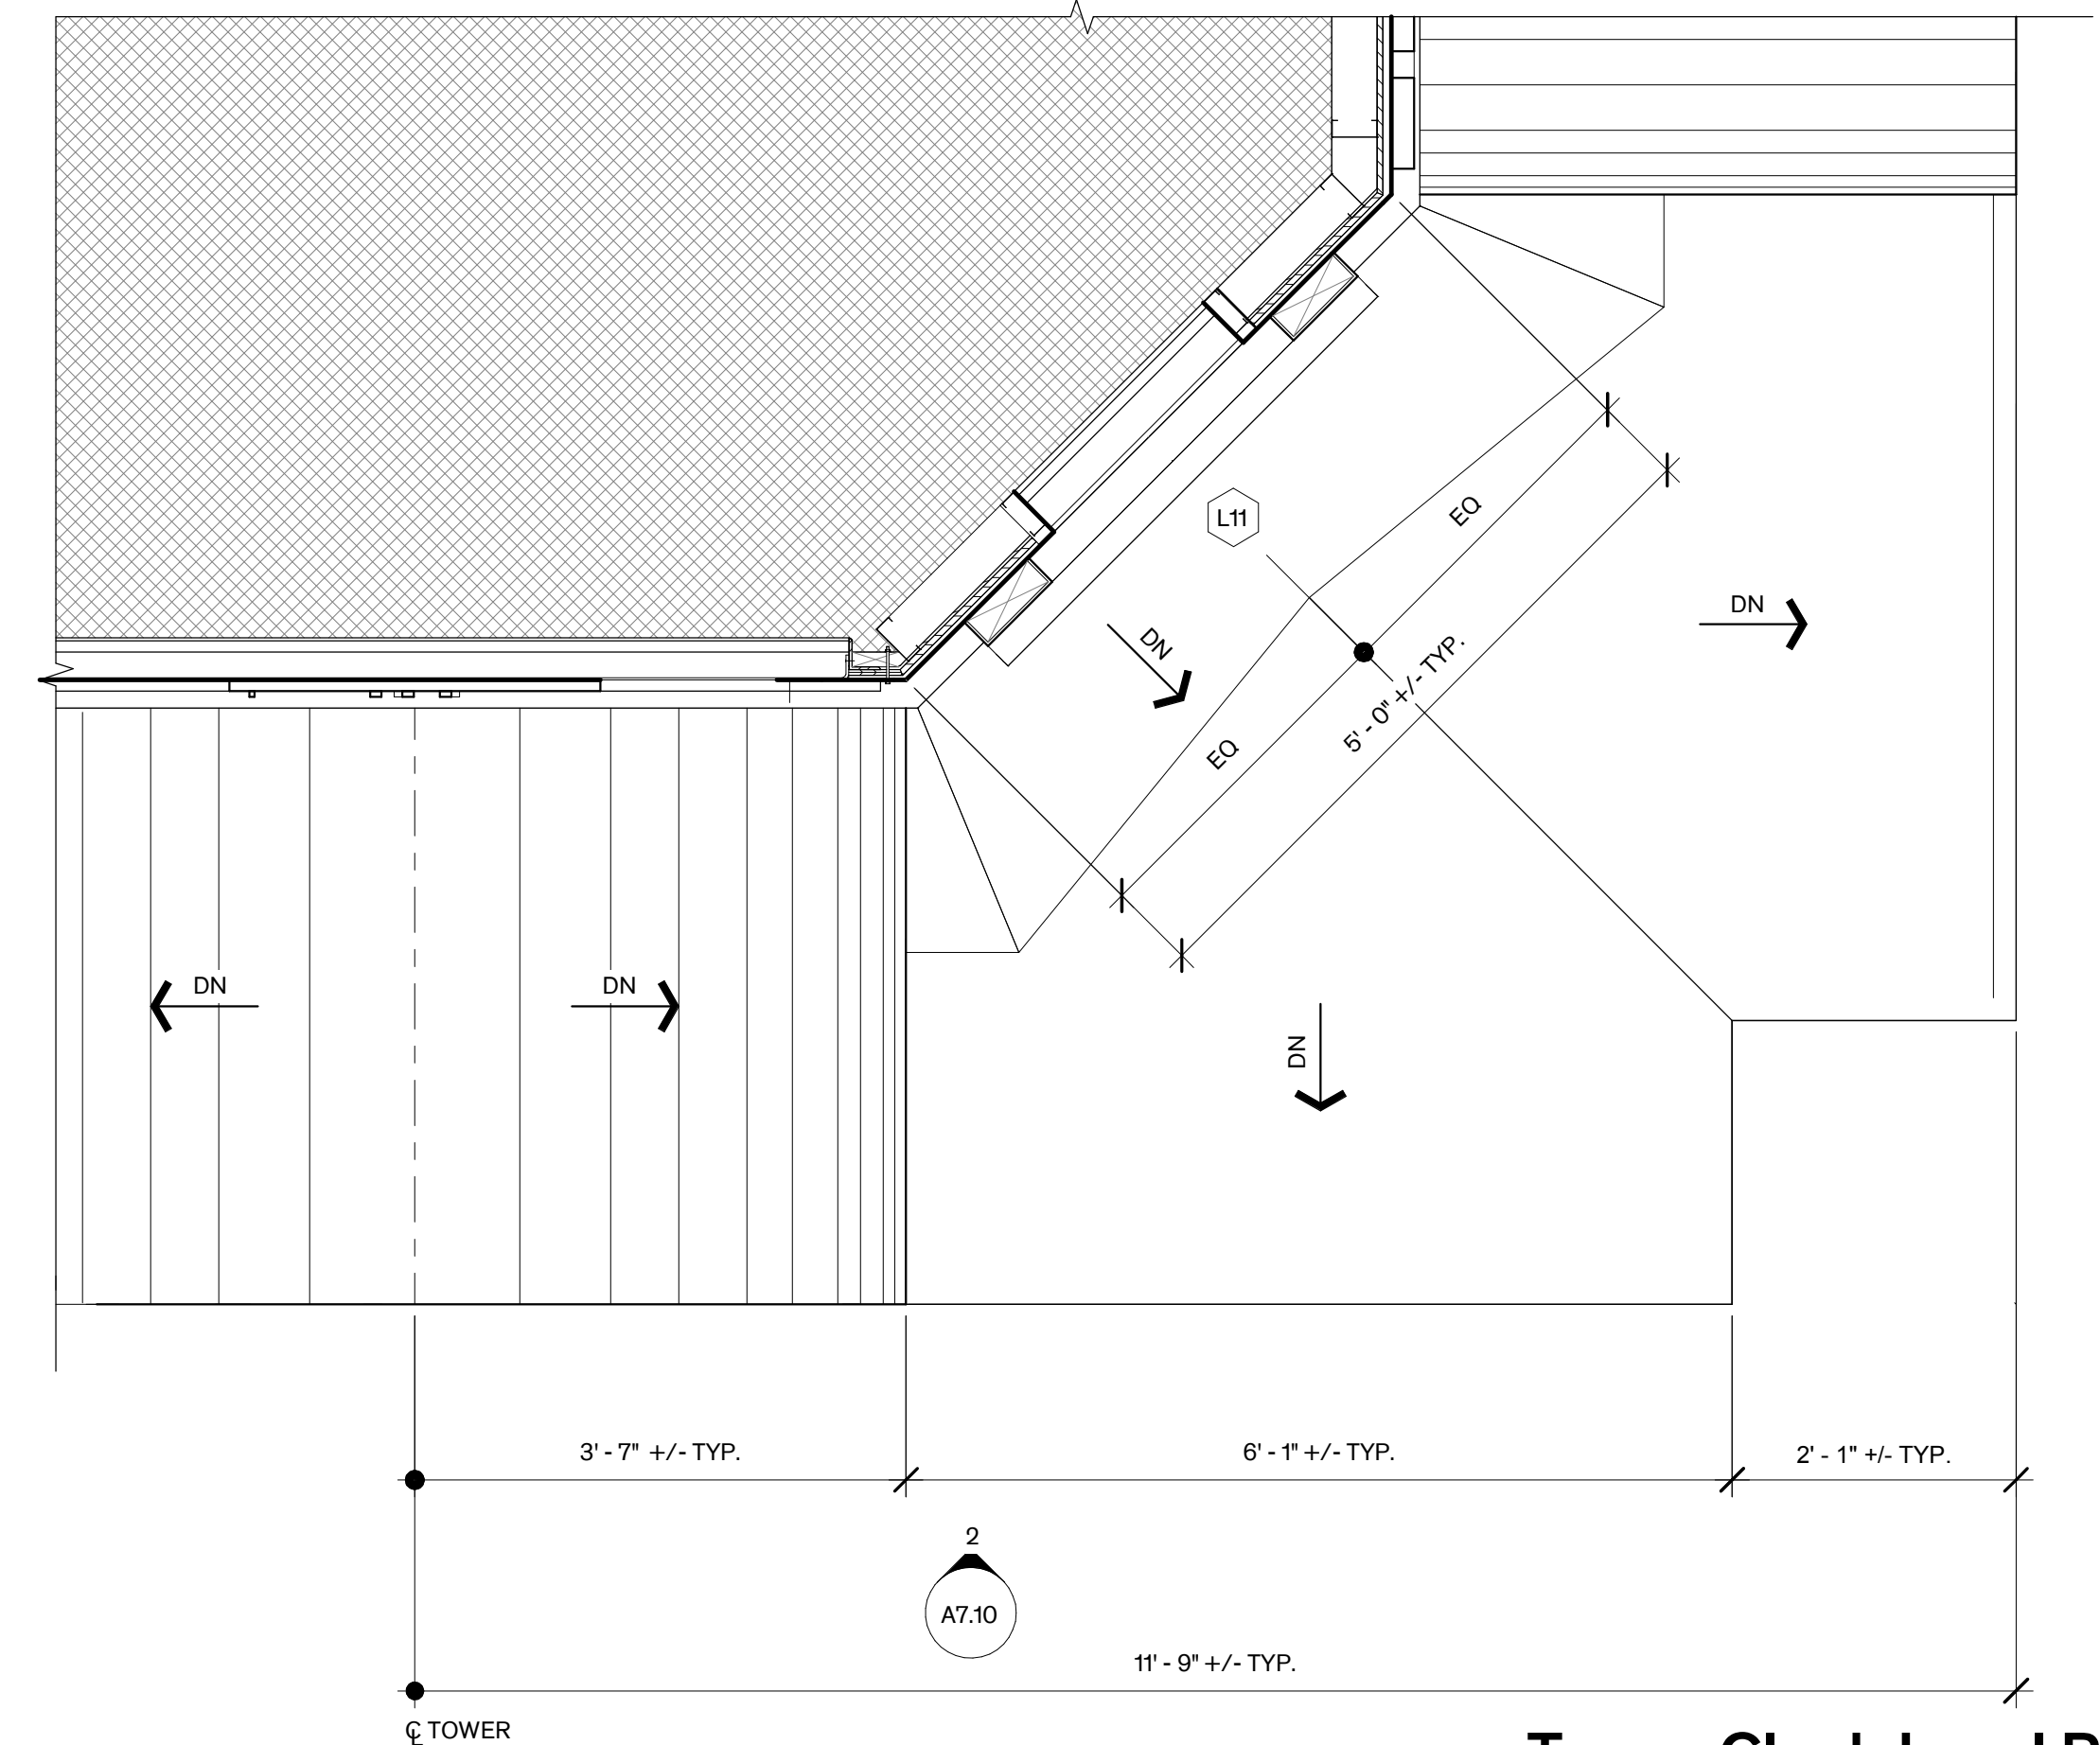

**4 Tower Clock Level Plan**  
 3/4" = 1'-0"

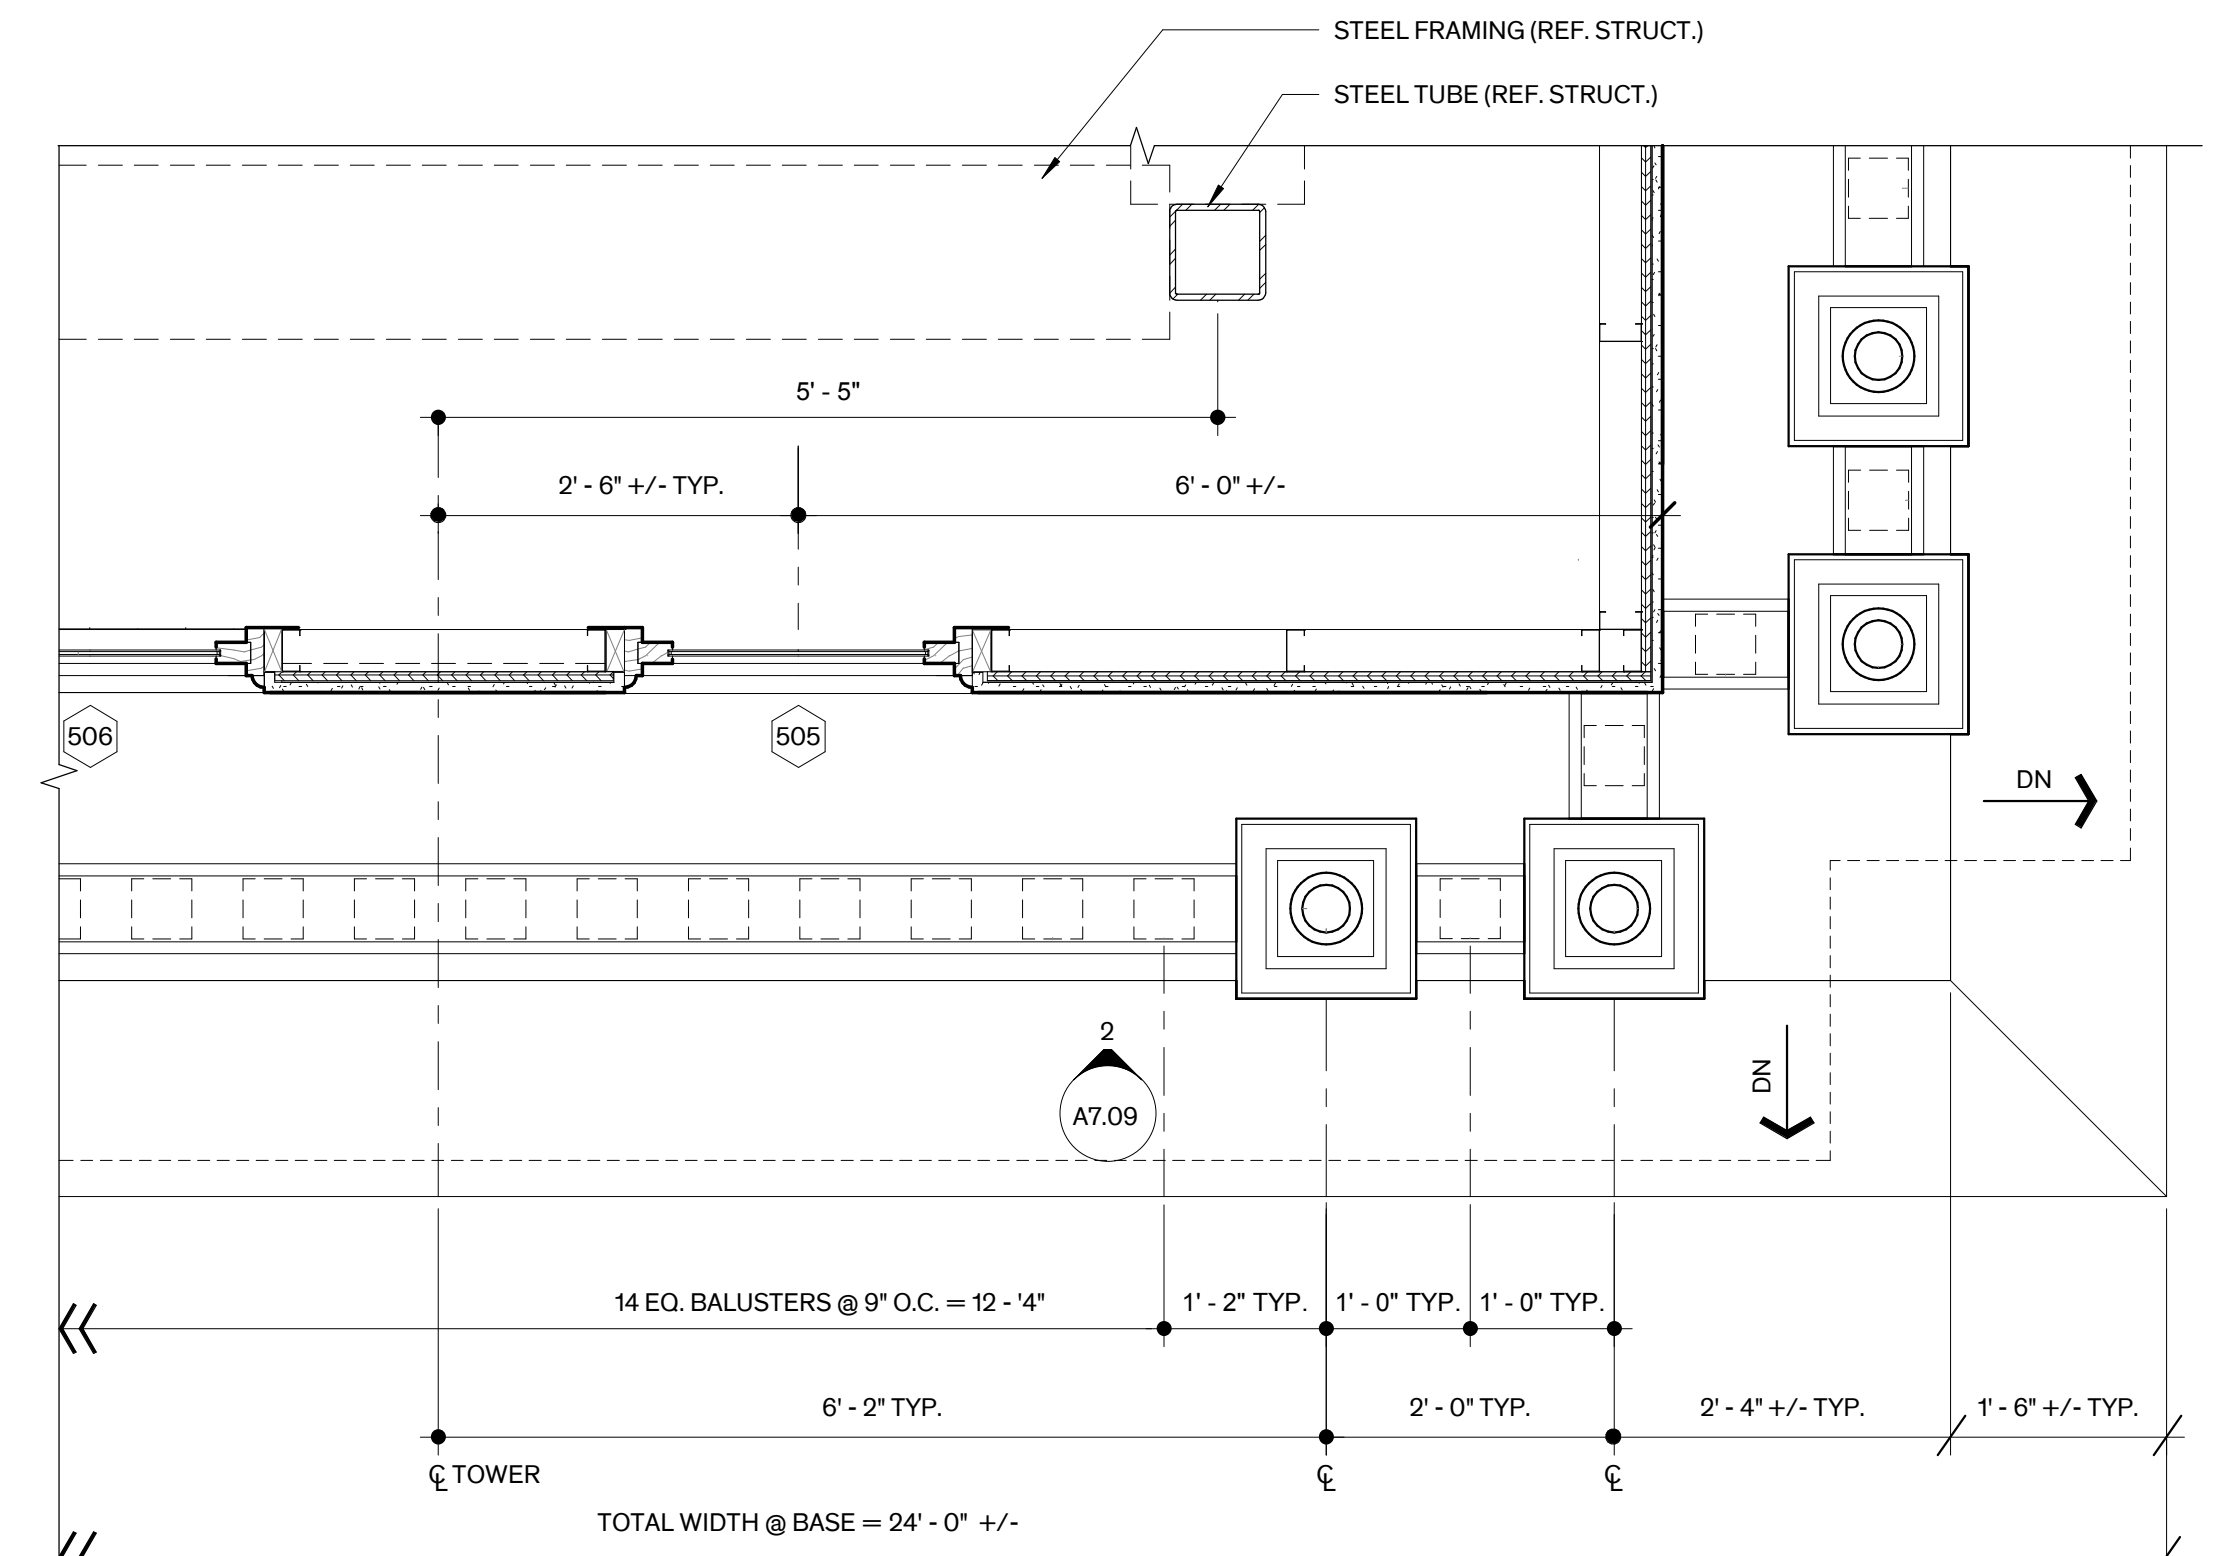

**3 Tower Base Level Plan**  
 3/4" = 1'-0"

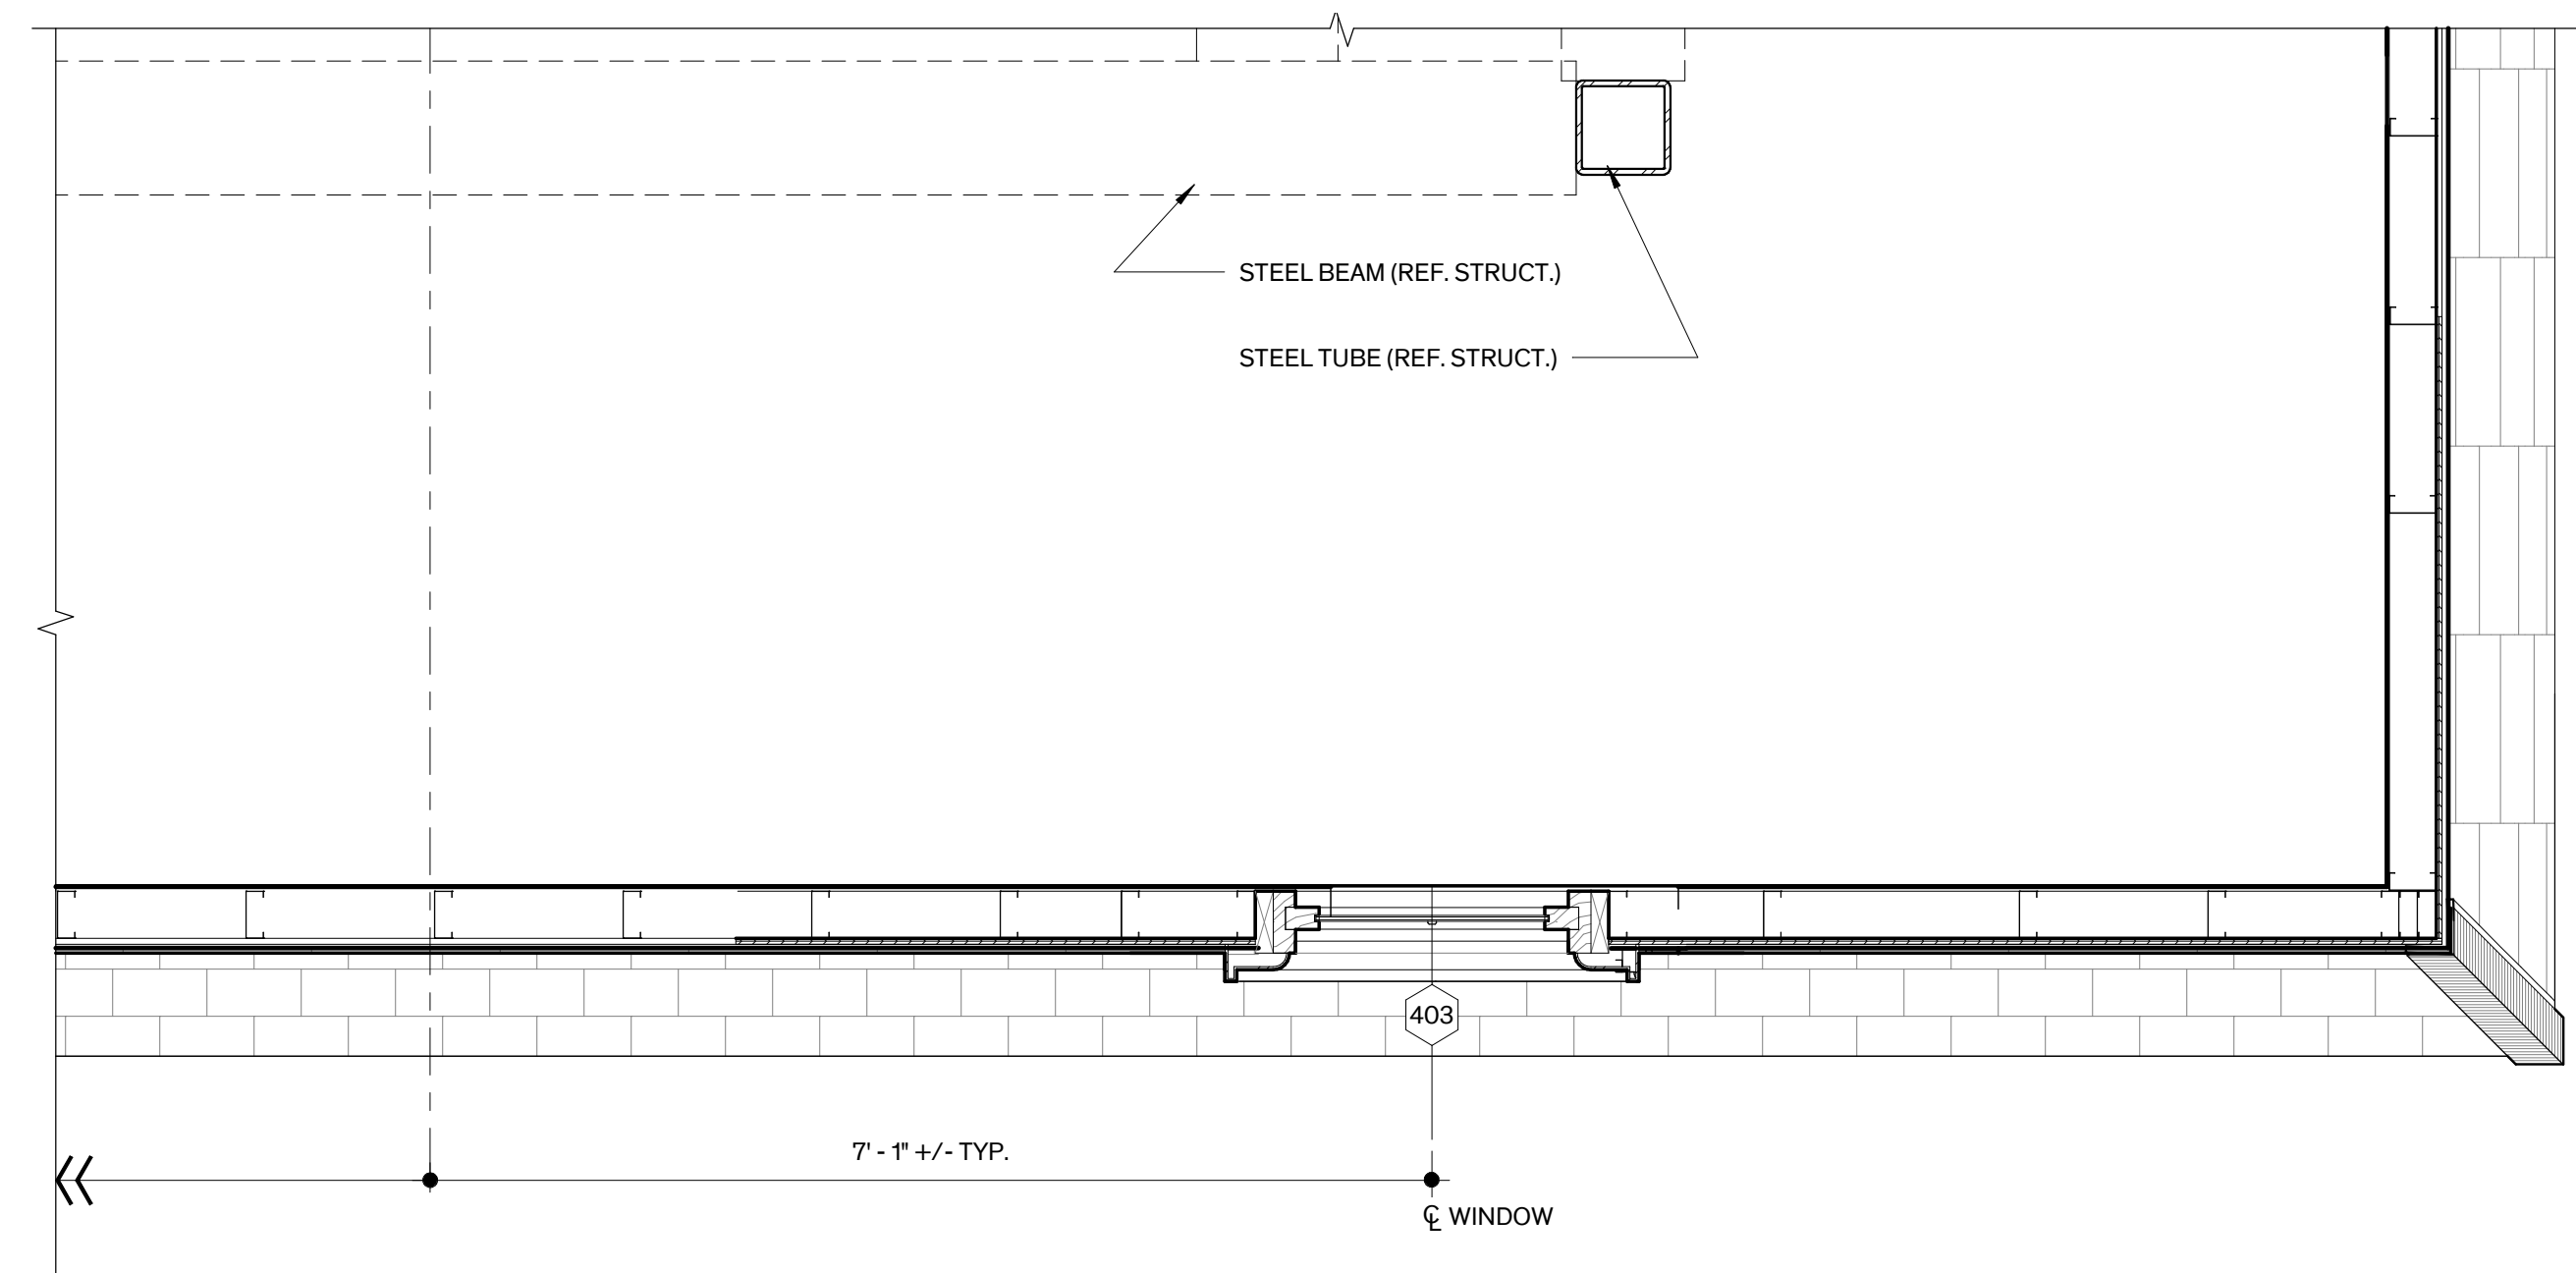

**1 Tower Dormer Base Level Plan**  
 3/4" = 1'-0"



**FANNIN COUNTY COURTHOUSE**  
 INTERIOR & EXTERIOR RESTORATION

101 E. Sam Rayburn Drive  
 Bonham, Texas 75418

**COPYRIGHT**  
 The Contractor shall verify and be responsible for all dimensions. DO NOT scale the drawing. Any errors or omissions shall be reported to Architexas without delay. The Copyrights to all designs and drawings are the property of Architexas. Reproduction or use for any purpose other than that authorized by Architexas is forbidden.

**REVISION HISTORY**

1	Oct. 16, 2018	Addendum #1
---	---------------	-------------

ISSUED FOR CONSTRUCTION




#18326 9/21/2018

Architexas No. 1737 Date SEPT. 21, 2018


Sheet Name TOWER PLANS AND ELEVATIONS

Sheet Number A7.09



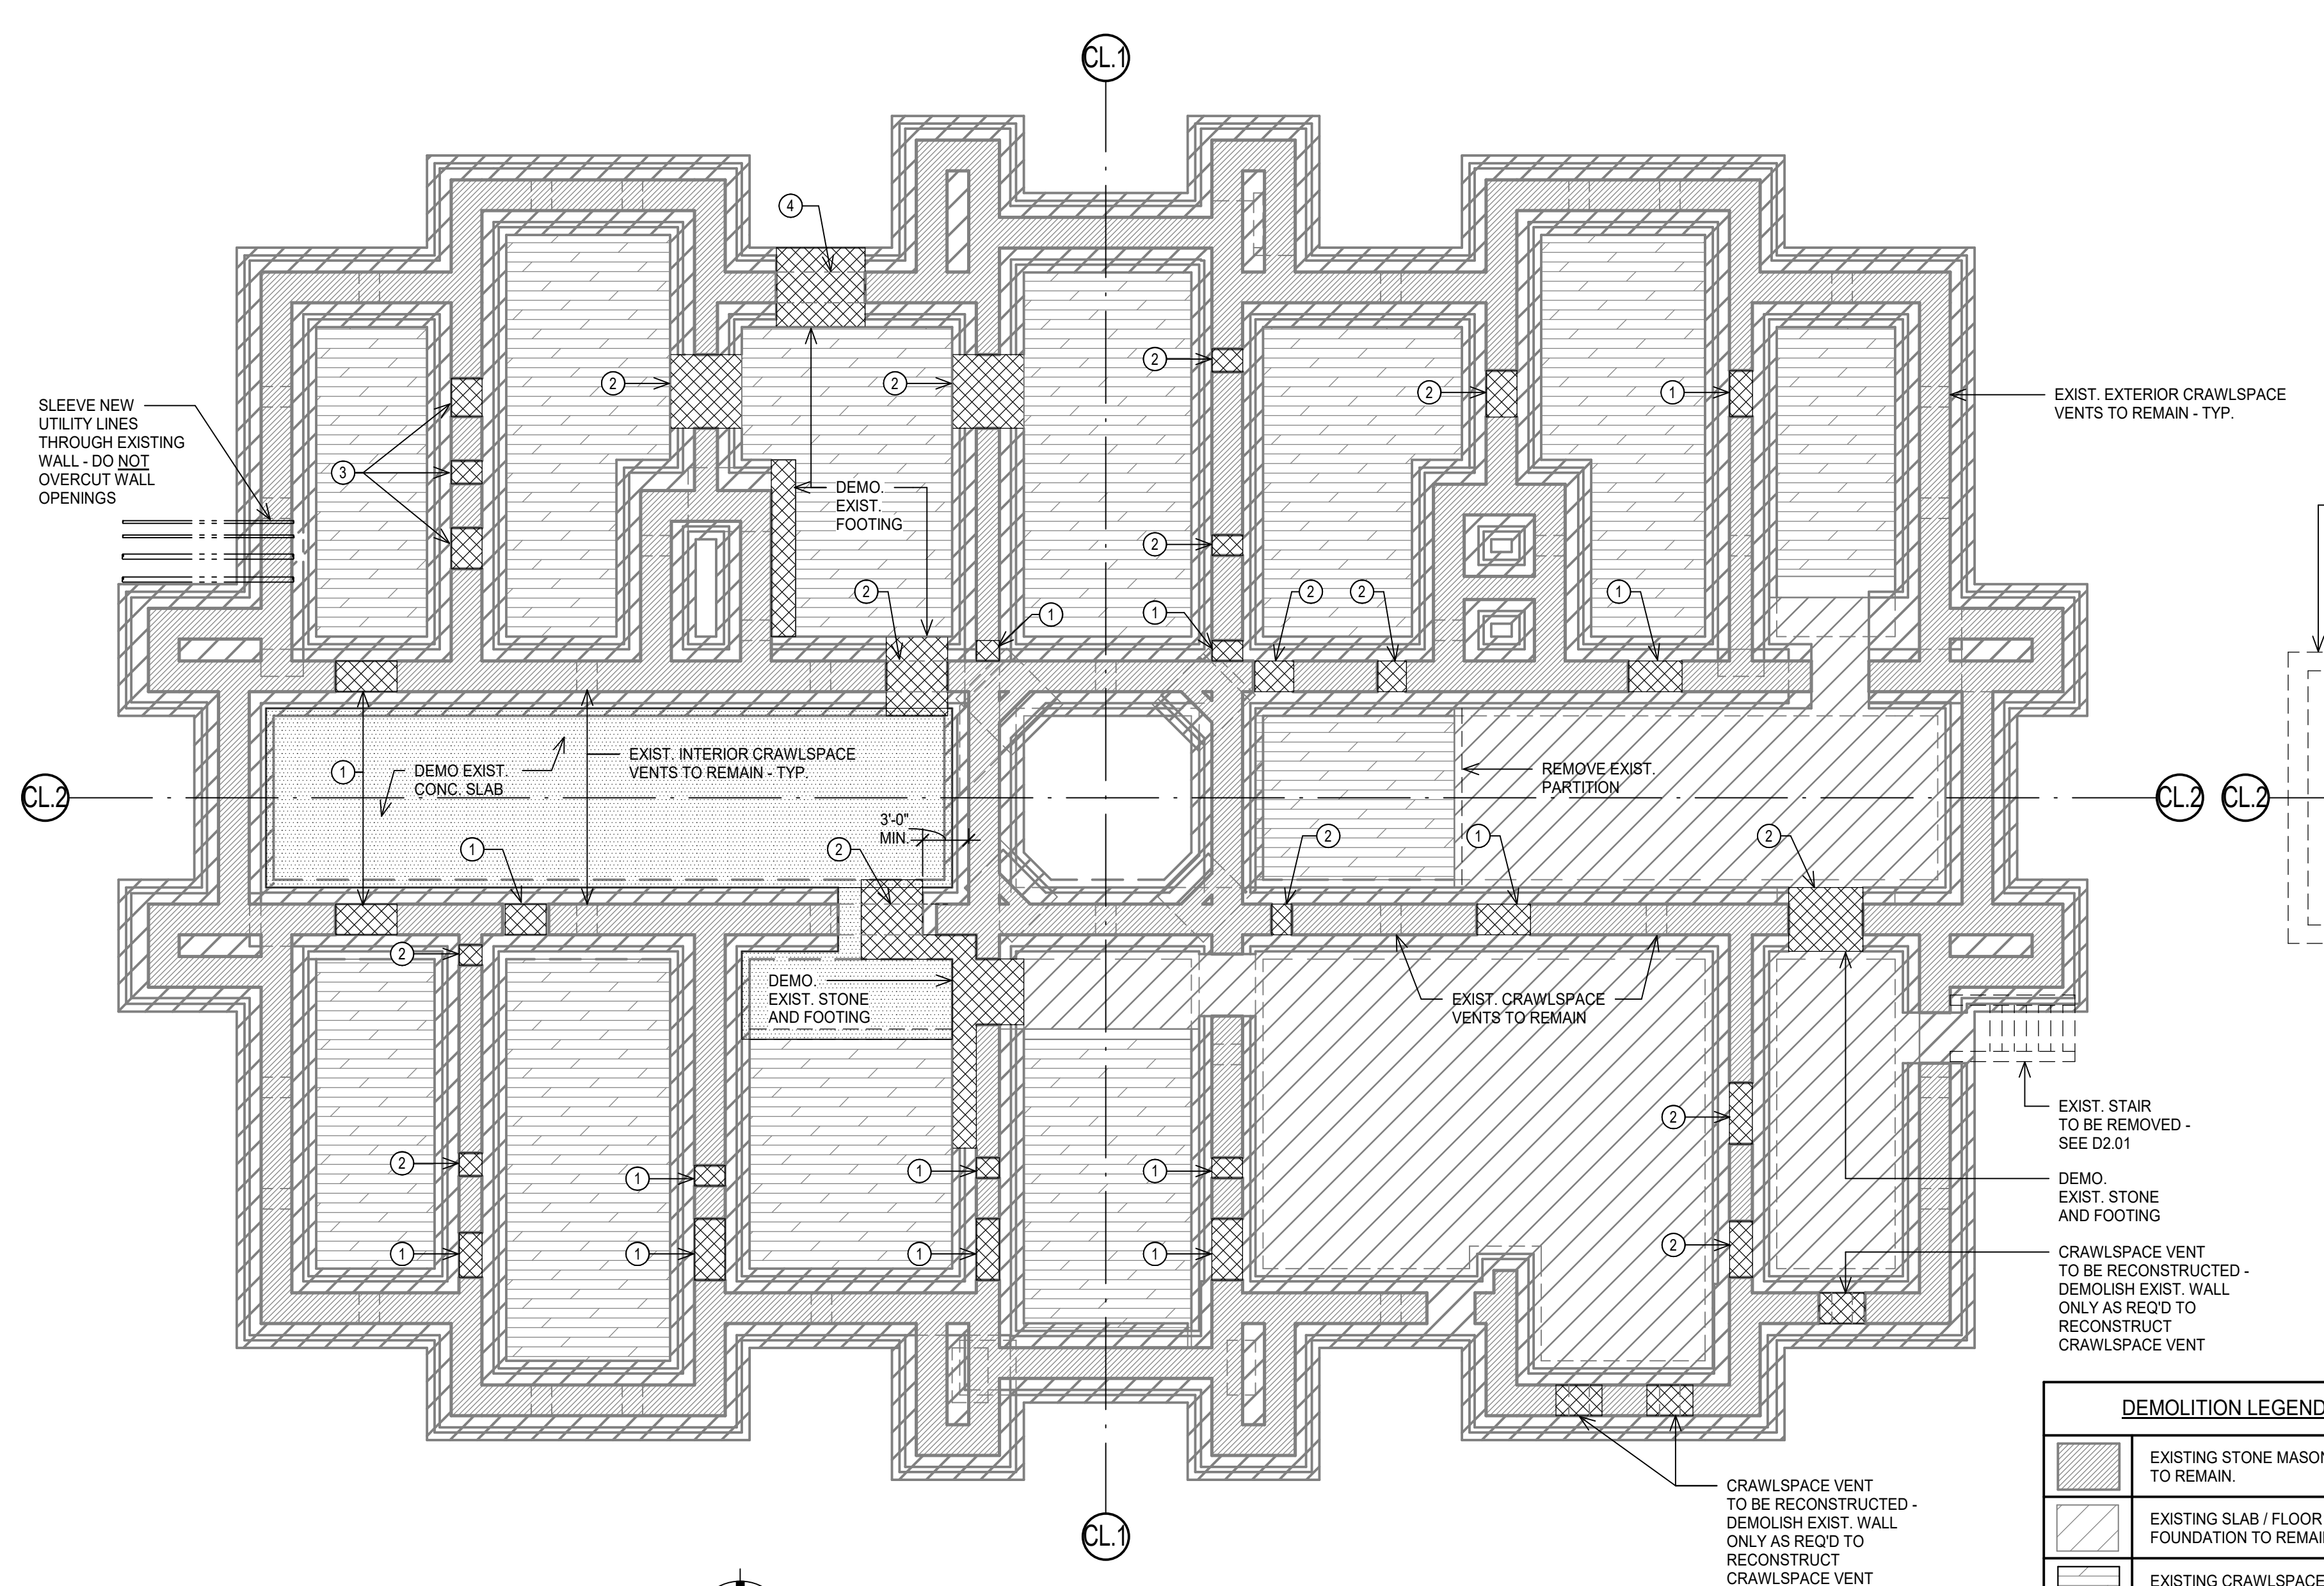


1 BASEMENT DEMOLITION PLAN  
SCALE: 1/8" = 1'-0"

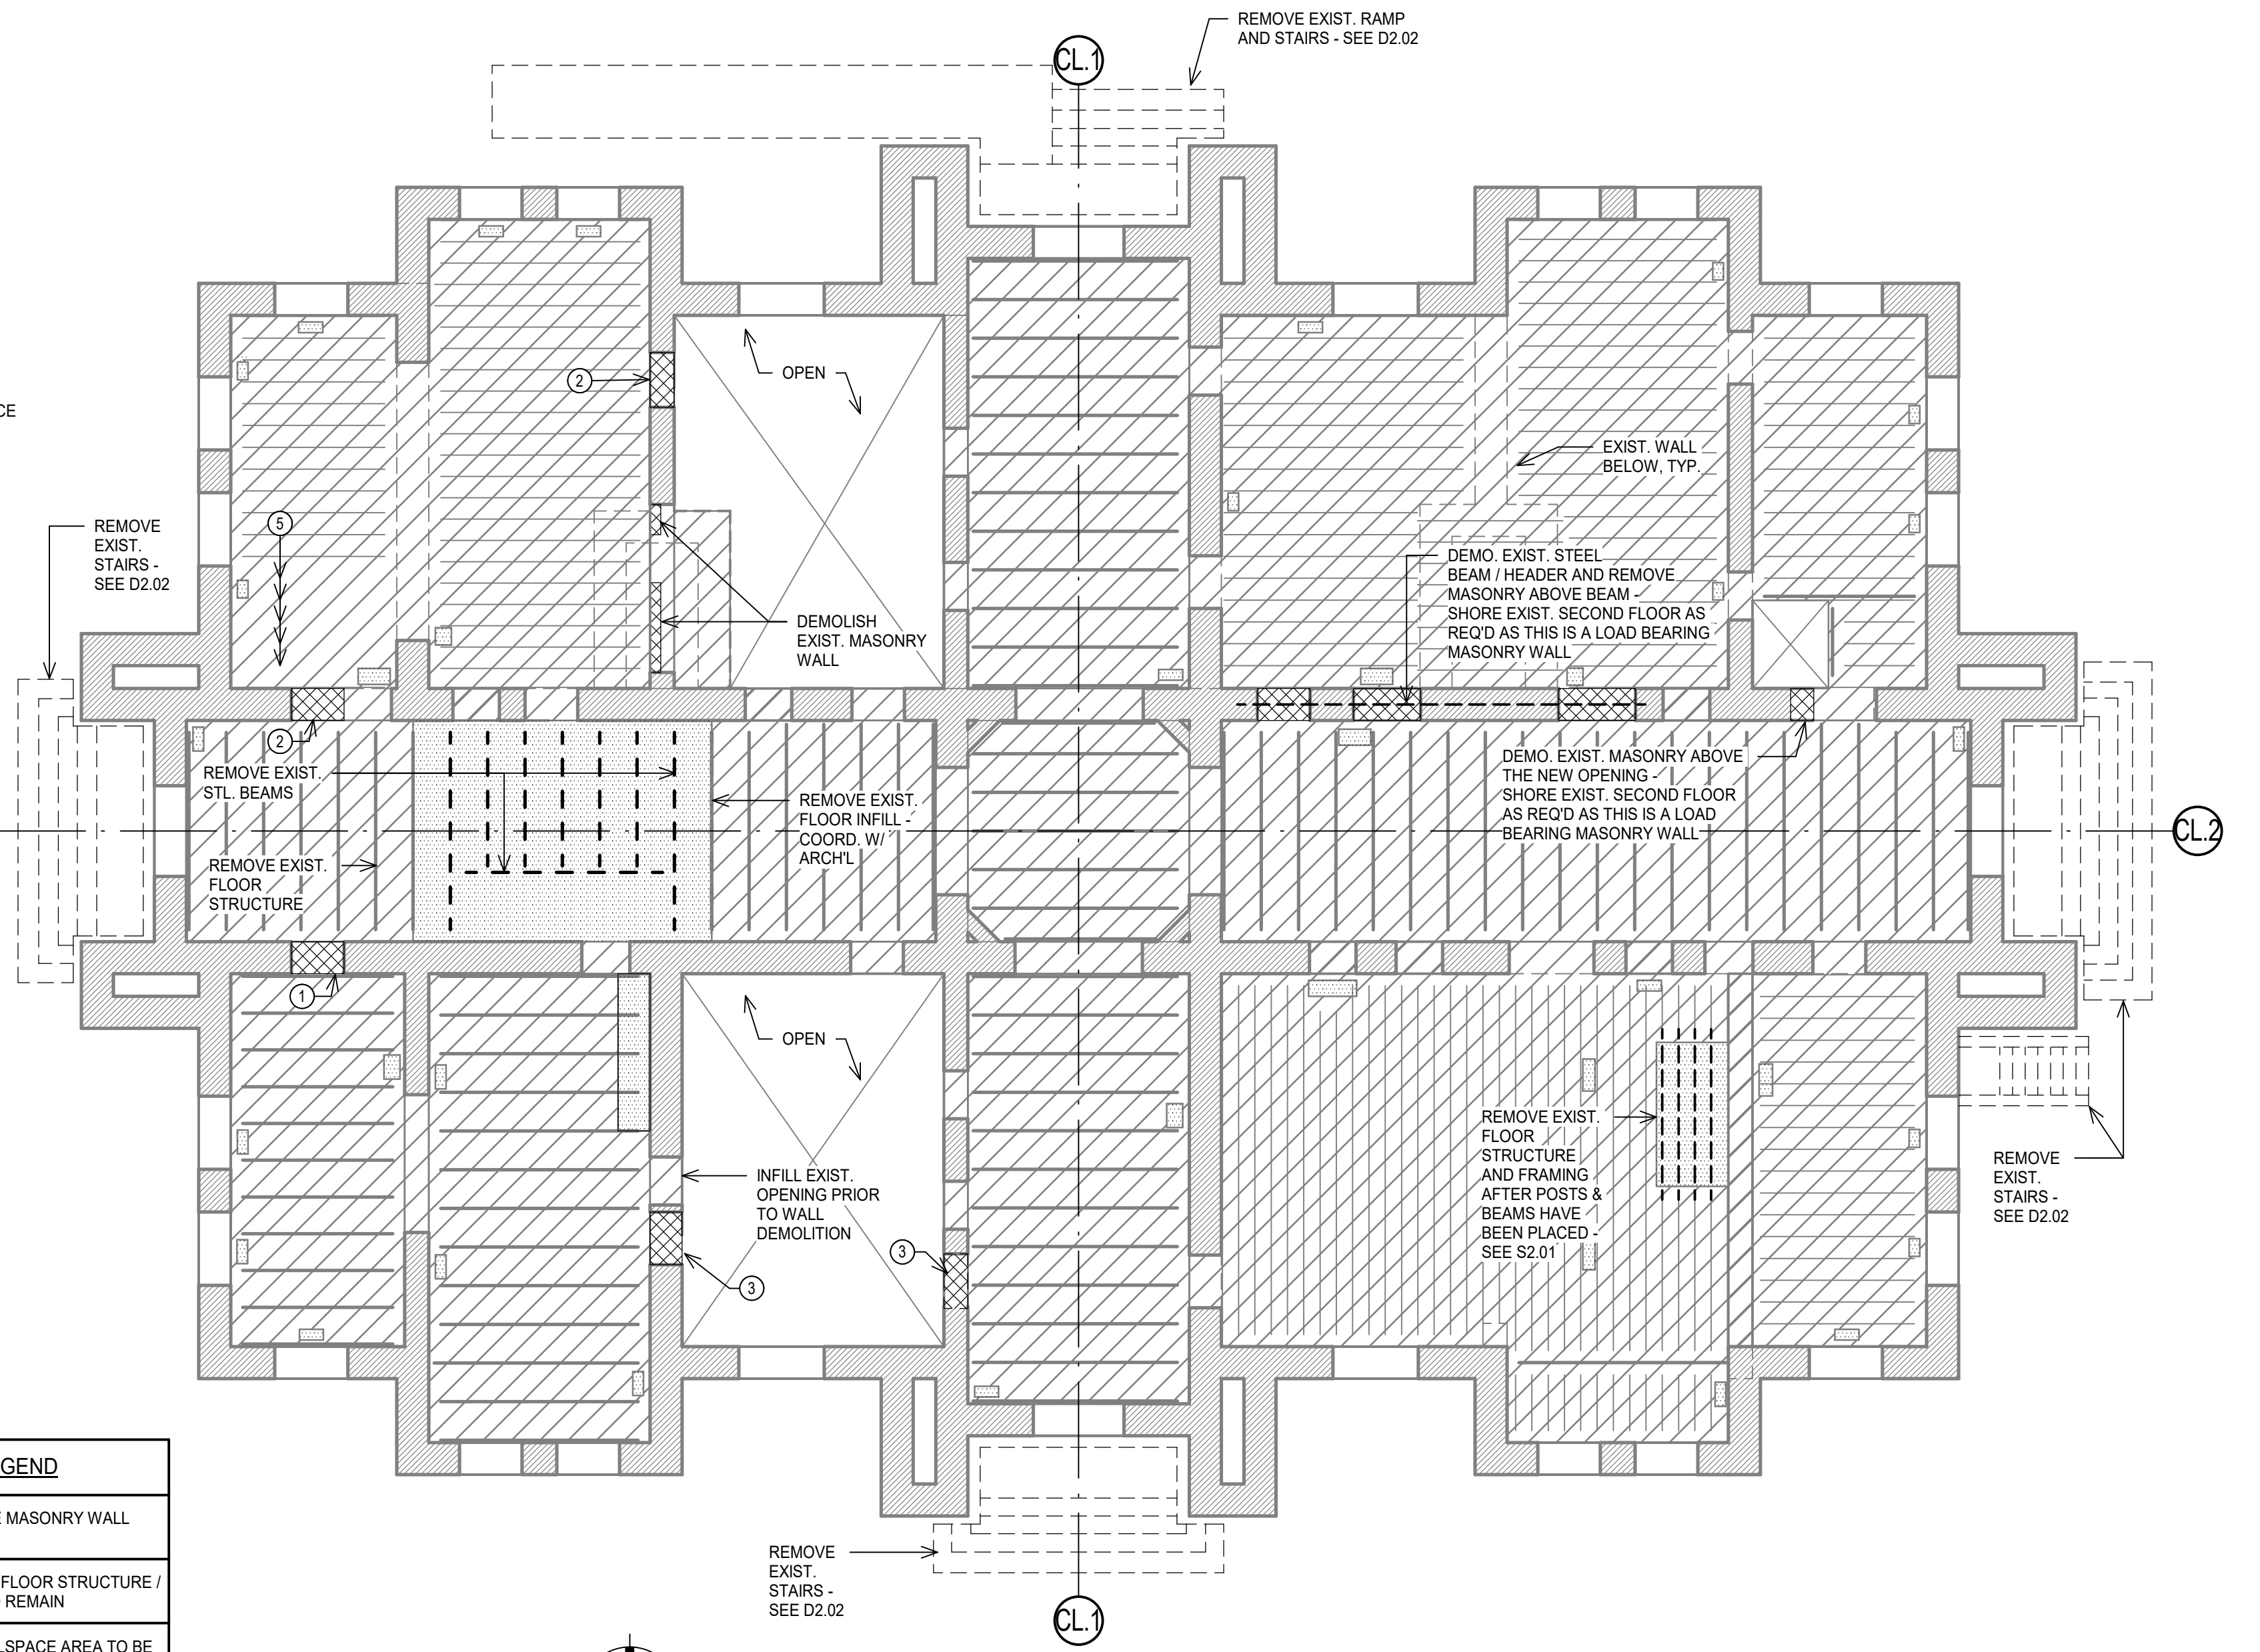


2 GROUND FLOOR DEMOLITION PLAN  
SCALE: 1/8" = 1'-0"

DEMOLITION LEGEND	
	EXISTING STONE MASONRY WALL TO REMAIN
	EXISTING SLAB / FLOOR STRUCTURE / FOUNDATION TO REMAIN
	EXISTING CRAWLSPACE AREA TO BE EXCAVATED - SEE ARCH'L
	EXISTING WALL TO BE REMOVED FOR NEW OPENING
	EXISTING FLOOR STRUCTURE TO BE REMOVED

- DEMOLITION KEY PLAN NOTES:
- ① NEW WALL OPENING - SEE 3/SD1.01
  - ② NEW WALL OPENING - SEE 4/SD1.01
  - ③ NEW WALL OPENING - SEE 1/SD1.01
  - ④ NEW EXTERIOR WALL OPENING - SEE 7/SD1.01
  - ⑤ DEMOLISH EXISTING TEMPORARY CMU BLOCK FOUNDATIONS AND RECONSTRUCT / SISTER WOOD FRAMING AND REPLACE DECK AS REQUIRED

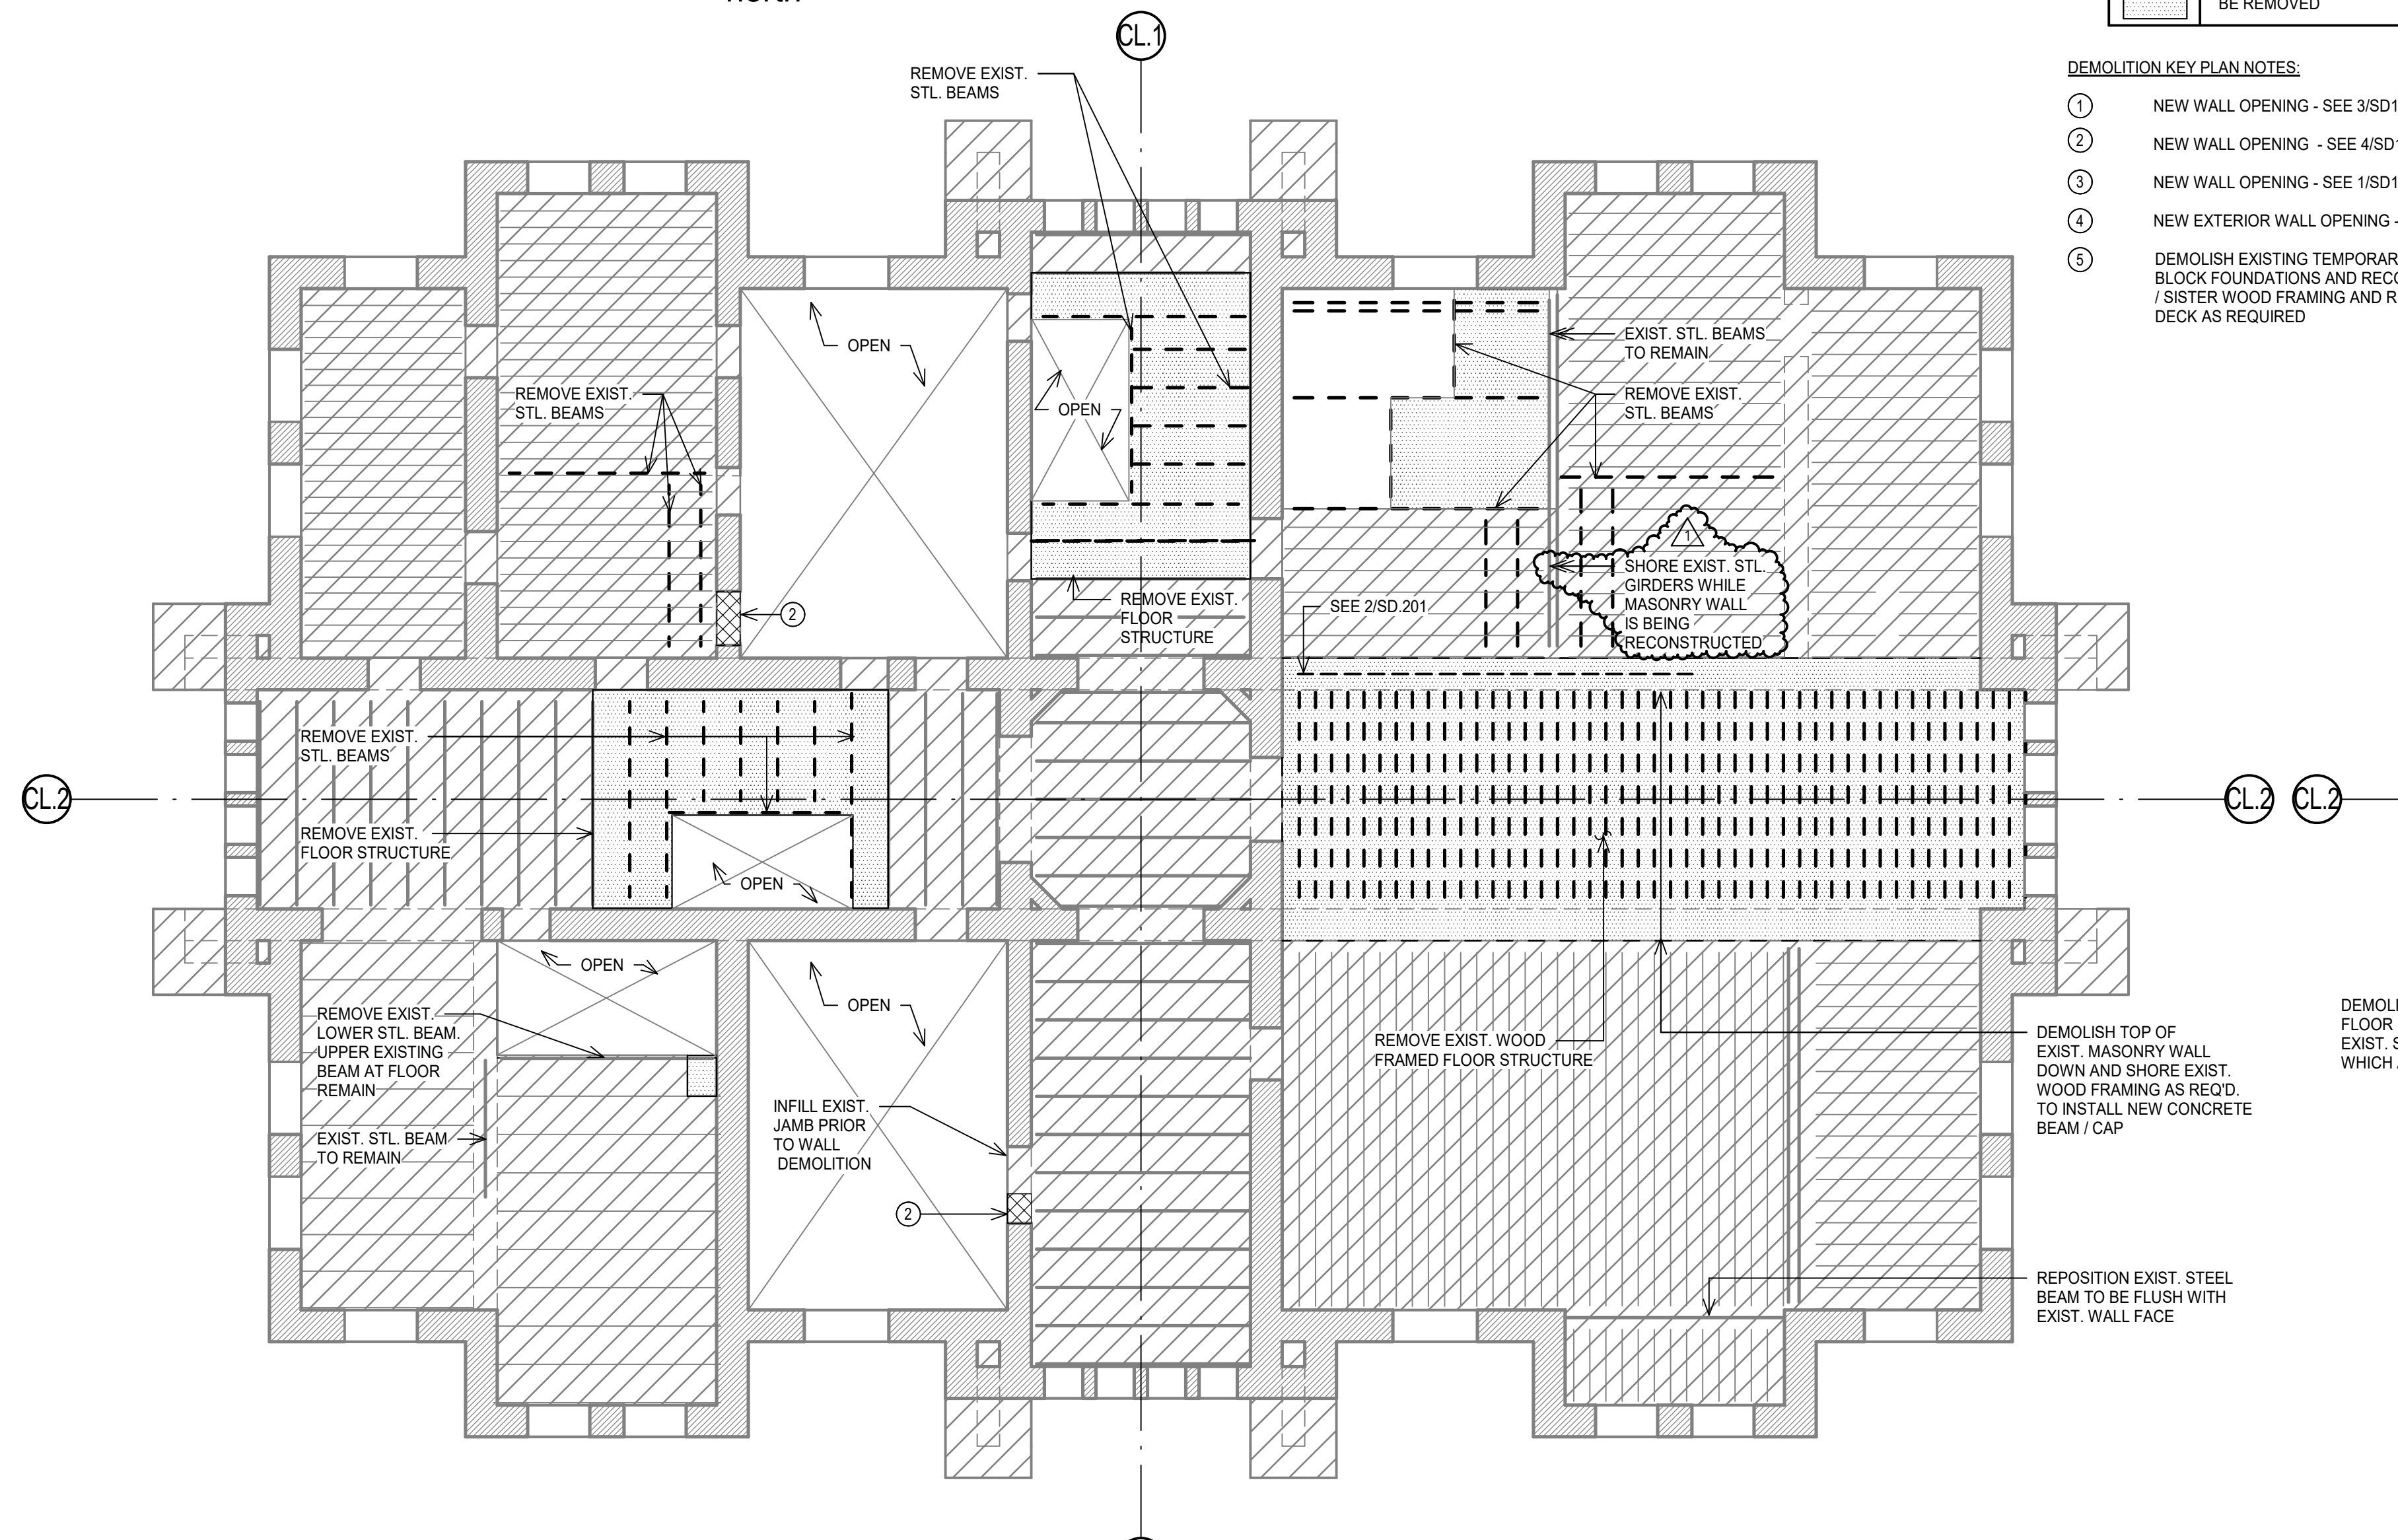

3 SECOND FLOOR DEMOLITION PLAN  
SCALE: 1/8" = 1'-0"

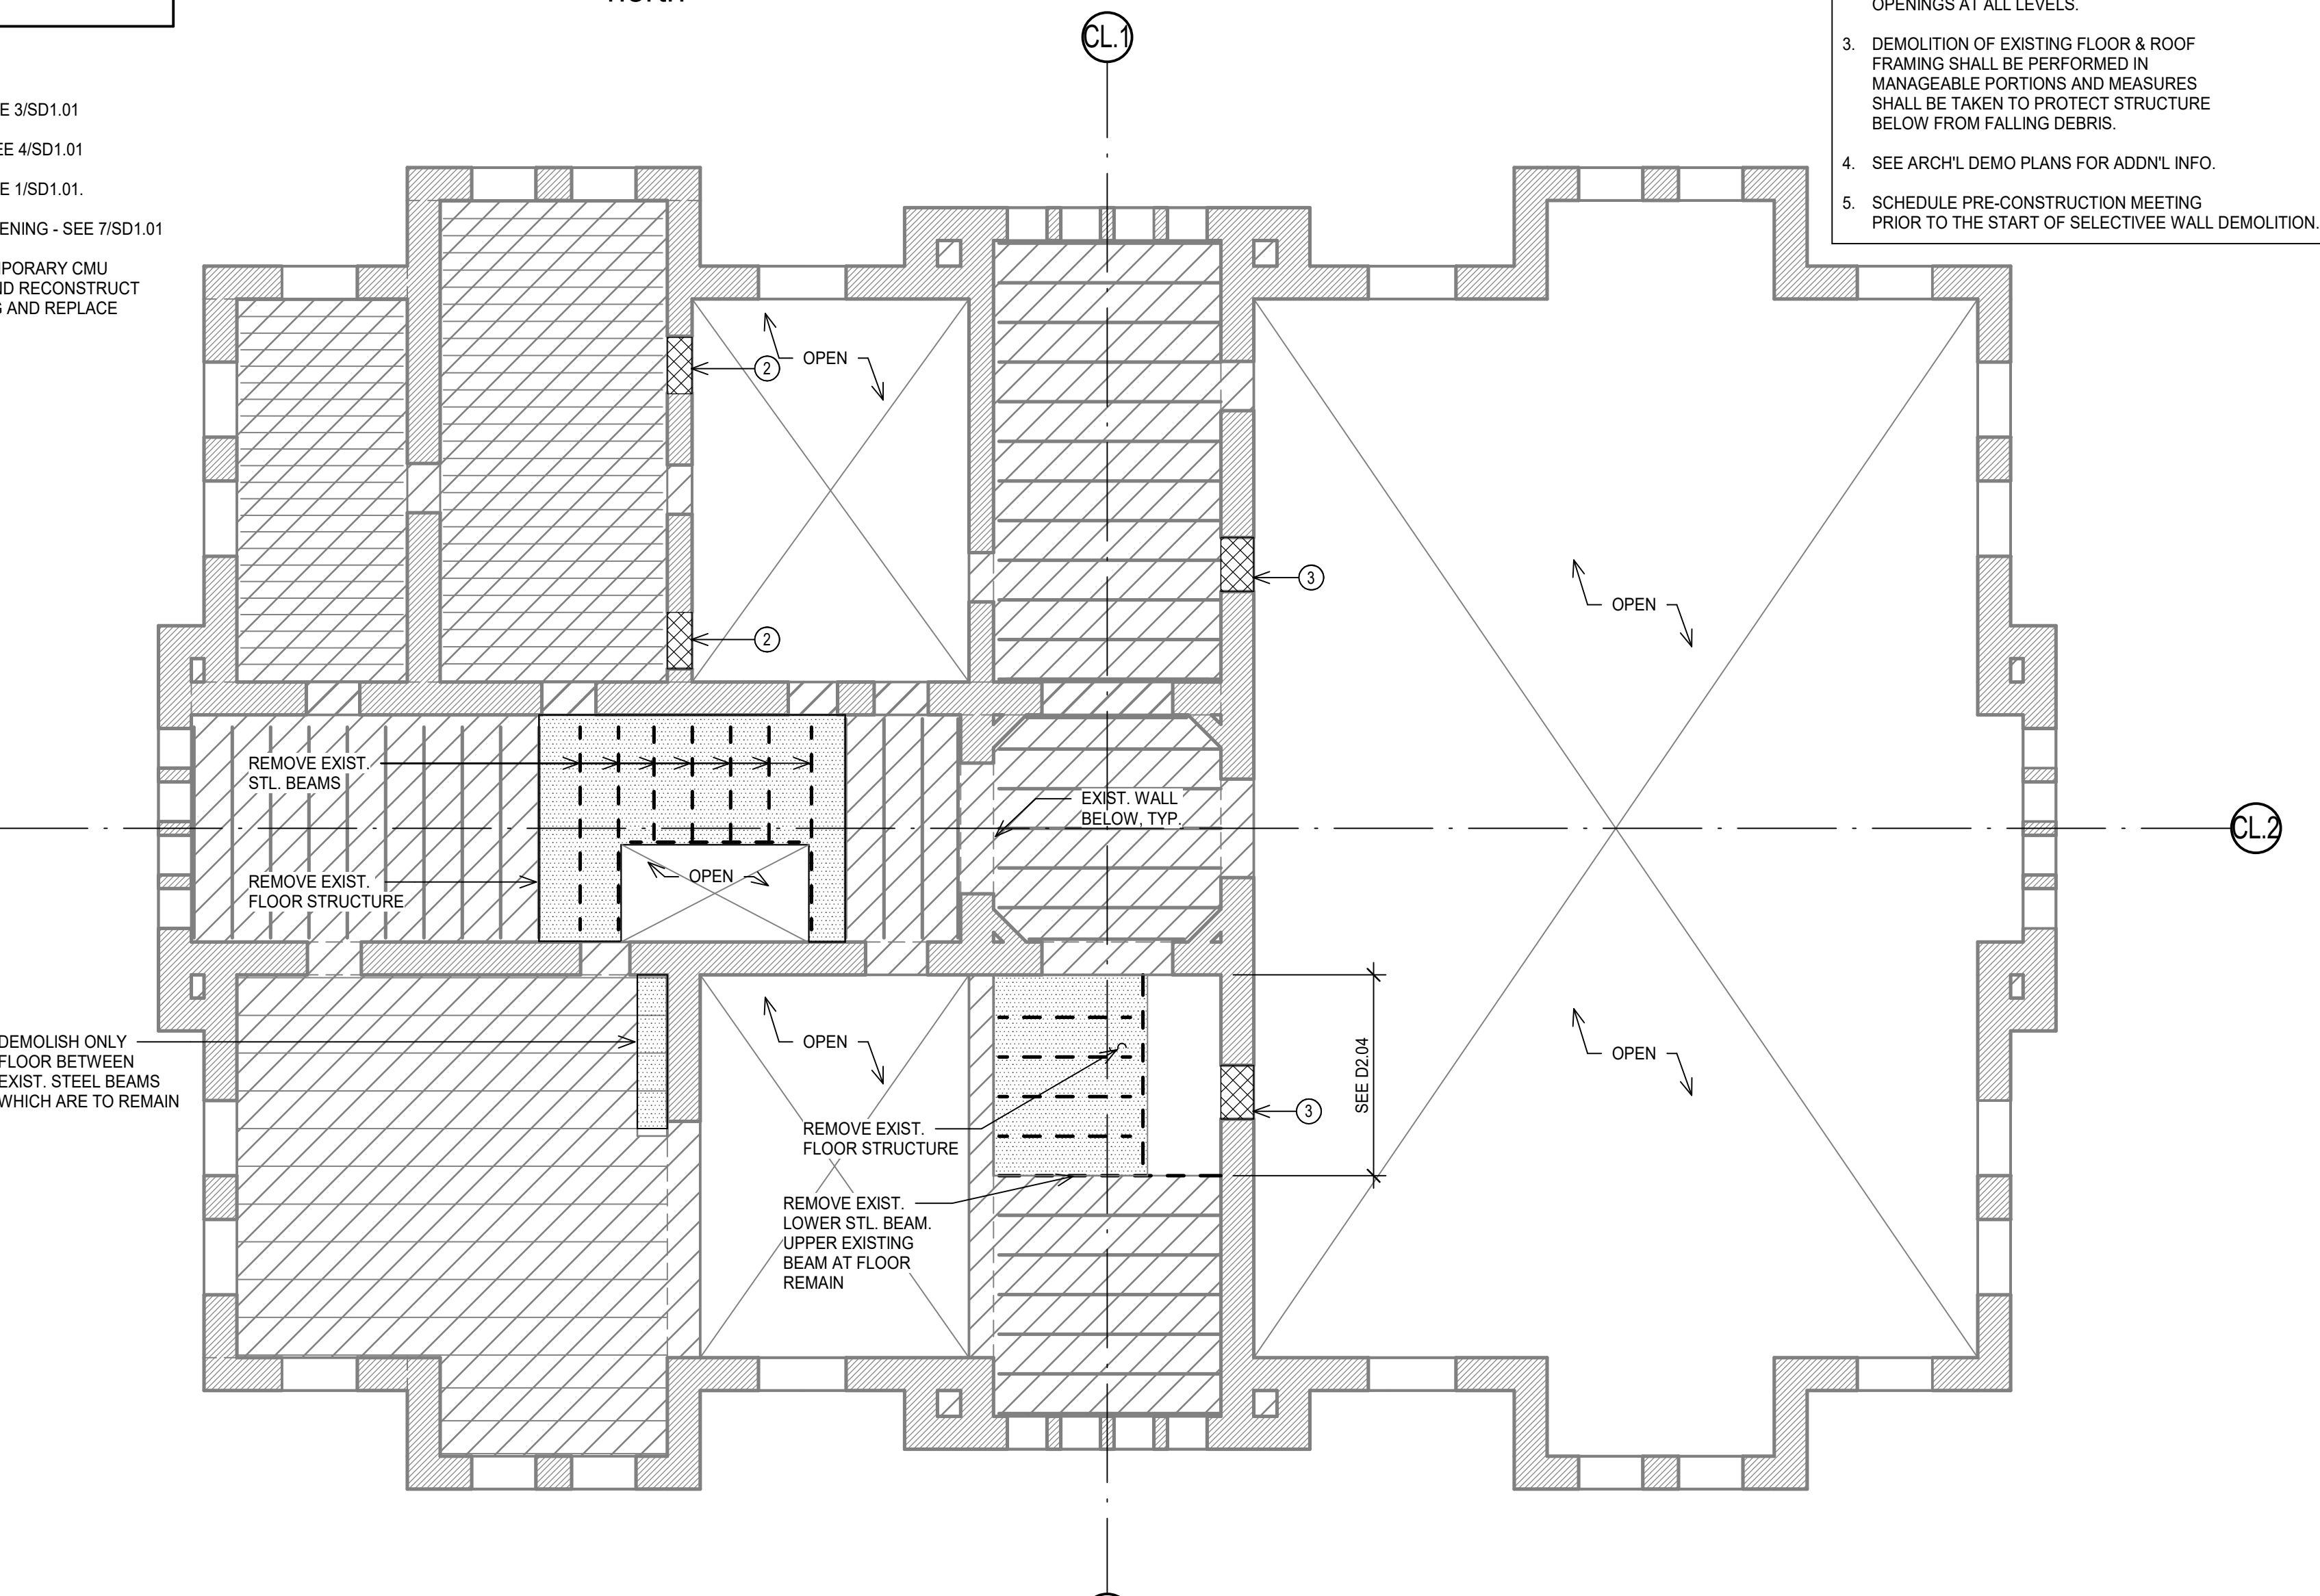

4 THIRD FLOOR DEMOLITION PLAN  
SCALE: 1/8" = 1'-0"

- DEMOLITION NOTES:
1. SEE ARCH'L DEMO PLANS FOR SELECTIVE FLOOR DEMOLITION AT BASEMENT LEVEL.
  2. SEE ARCH'L DEMO PLANS FOR SMALL OPENINGS AT ALL LEVELS.
  3. DEMOLITION OF EXISTING FLOOR & ROOF FRAMING SHALL BE PERFORMED IN MANAGEABLE PORTIONS AND MEASURES SHALL BE TAKEN TO PROTECT STRUCTURE BELOW FROM FALLING DEBRIS.
  4. SEE ARCH'L DEMO PLANS FOR ADDNL INFO.
  5. SCHEDULE PRE-CONSTRUCTION MEETING PRIOR TO THE START OF SELECTIVE WALL DEMOLITION.




FANNIN COUNTY COURTHOUSE  
INTERIOR & EXTERIOR RESTORATION

101 E. Sam Rayburn Drive  
Bonham, Texas 75418

COPYRIGHT  
The Contractor shall verify and be responsible for all dimensions. DO NOT scale the drawing. Any errors or omissions shall be reported to Architexas without delay. The Copyrights to all designs and drawings are the property of Architexas. Reproduction or use for any purpose other than that authorized by Architexas is forbidden.

REVISION HISTORY  
1 10/16/18 ADDENDUM #1

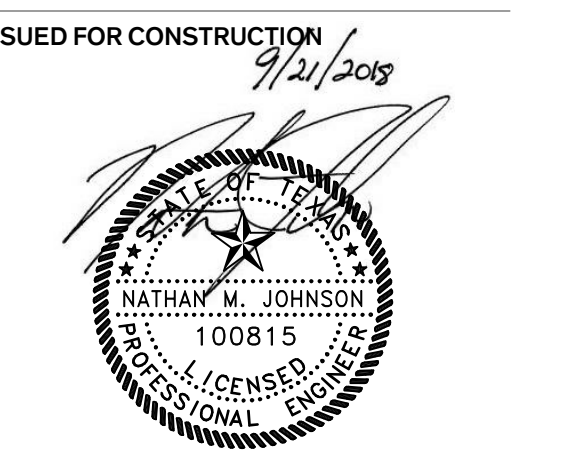

Architexas No. 1737 Date SEPT. 21.2018

Sheet Name STRUCTURAL DEMOLITION PLANS

Sheet Number SD2.01



shaping the built environment

**JQ**

JQ ENGINEERING, LLP  
100 SILAS STREET  
214.753.9098  
PROJECT NO. 3170377

DALLAS, TEXAS 75207  
JQENG.COM  
TYPE FIRM F-1294



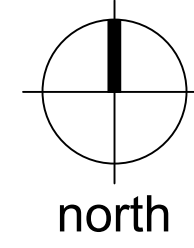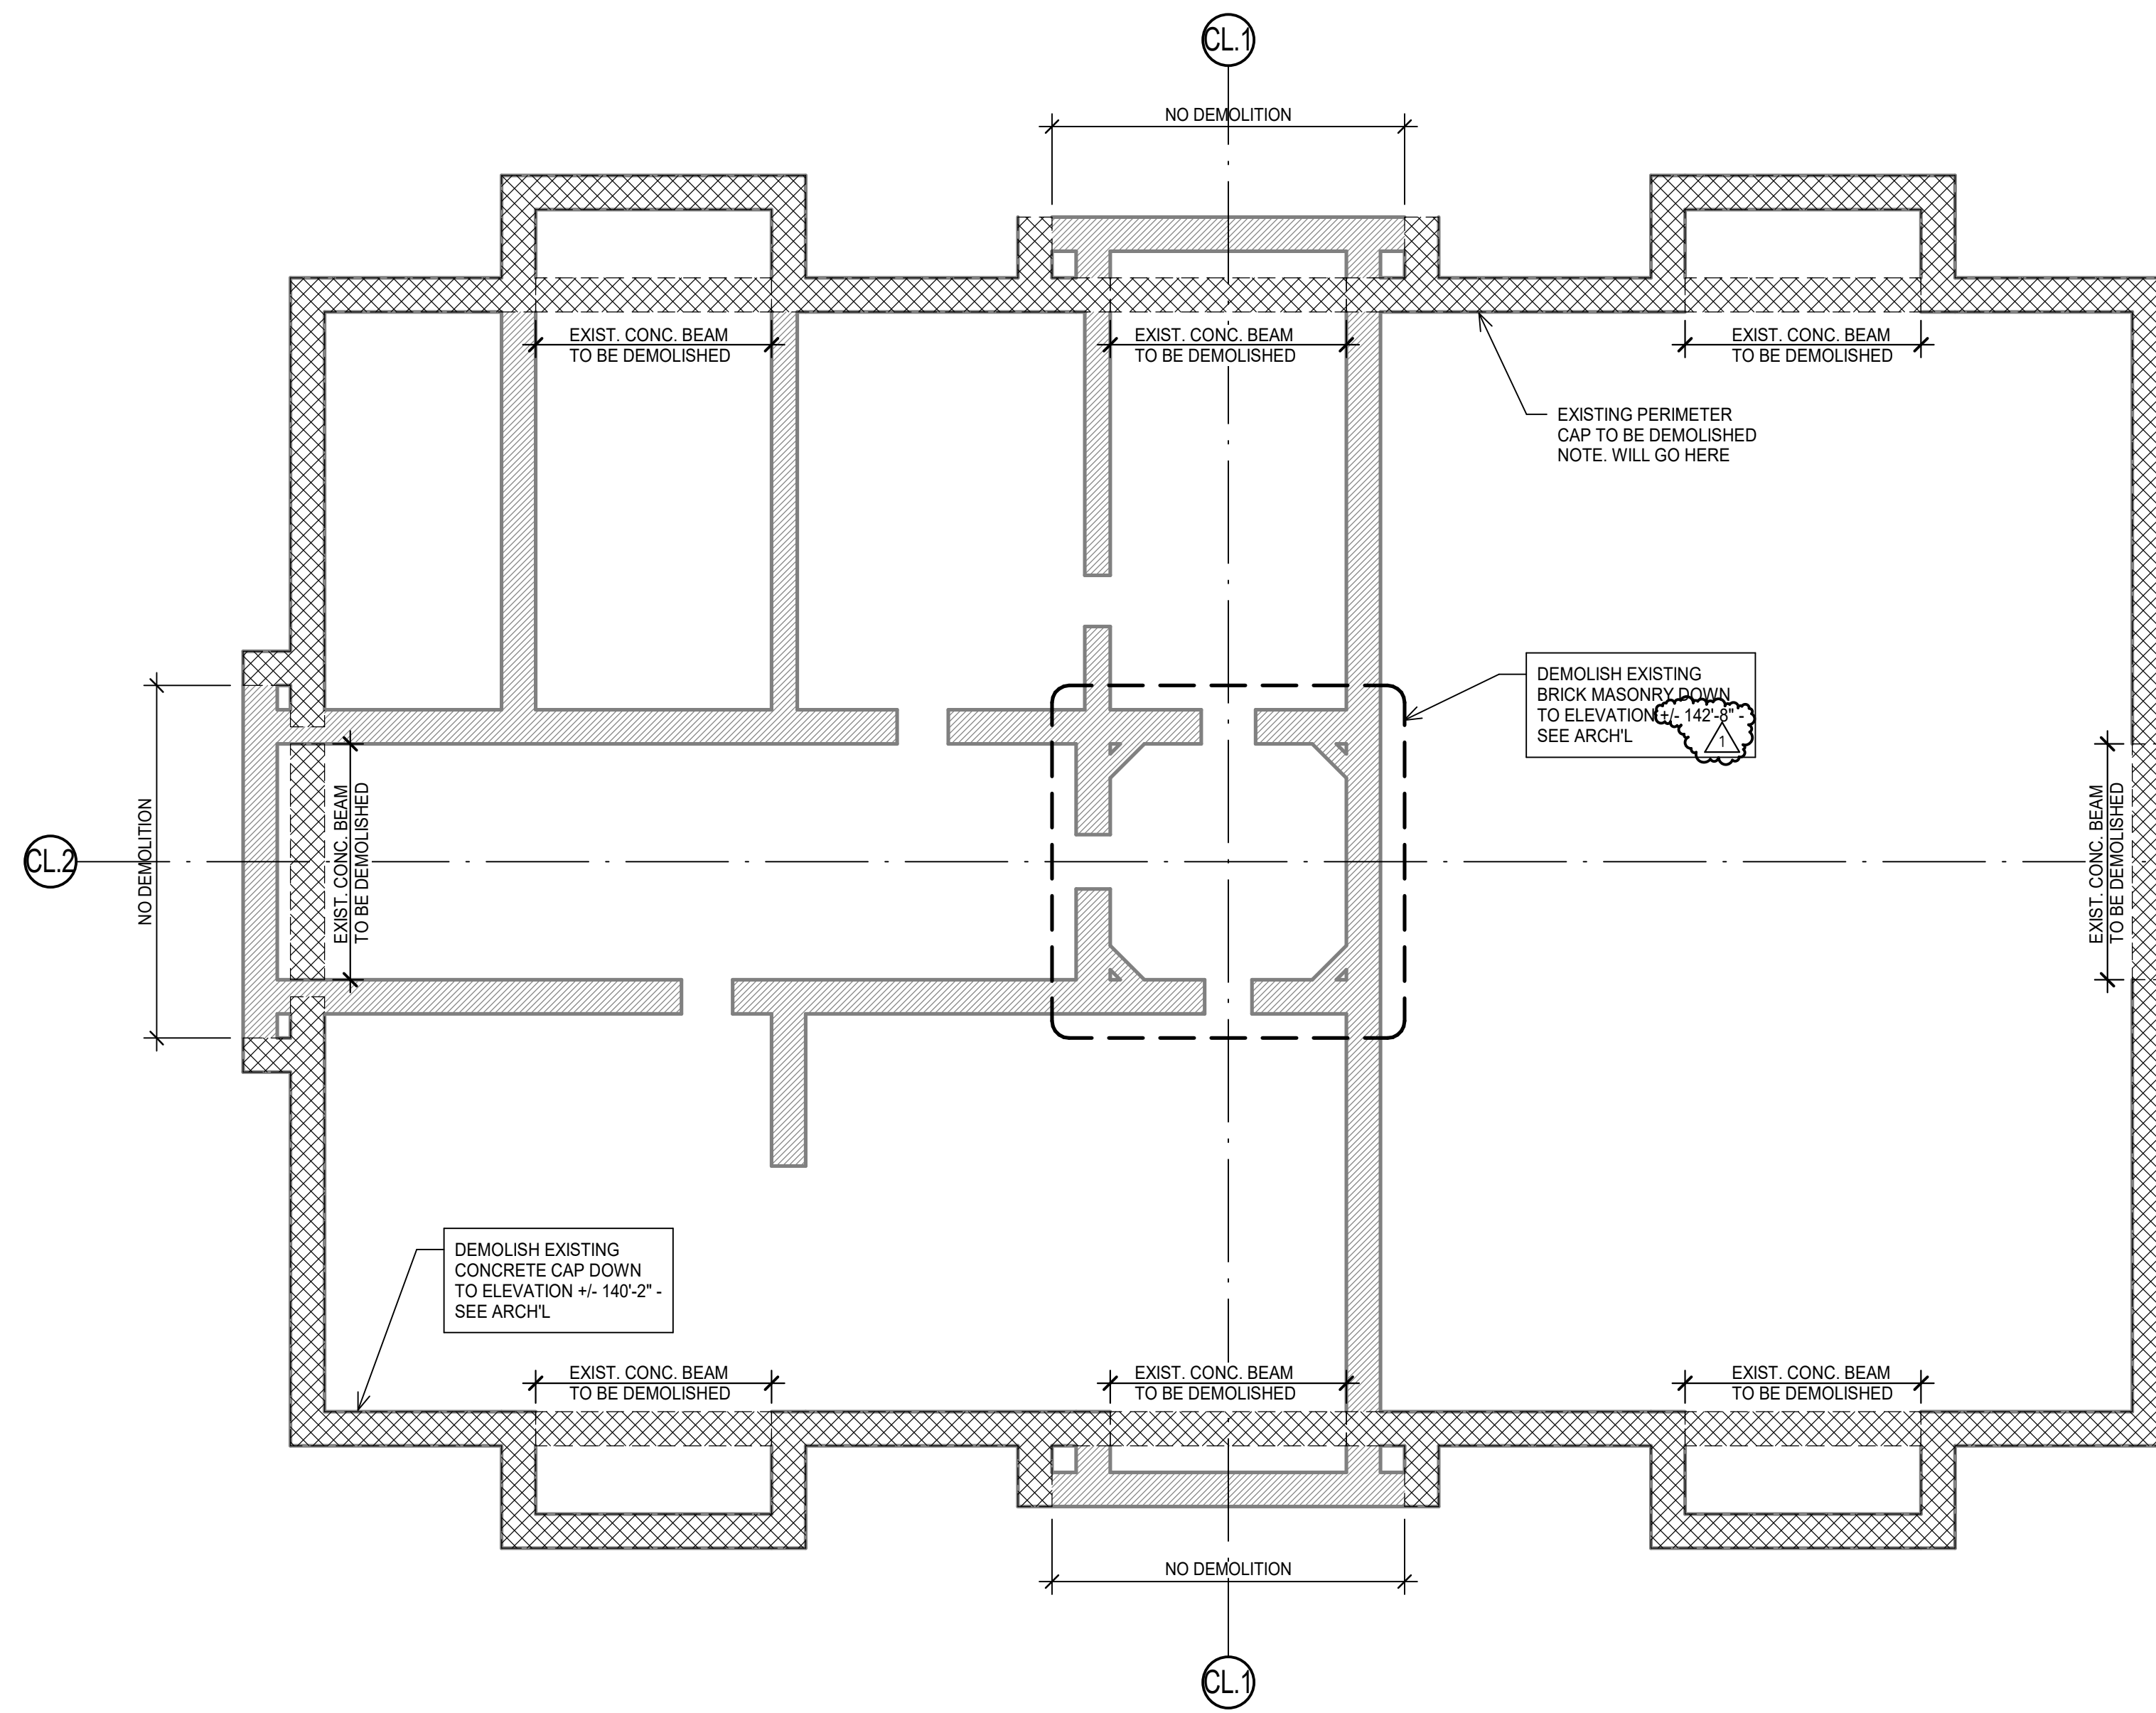


**1 ATTIC LEVEL DEMOLITION PLAN**  
SCALE: 1/8" = 1'-0"

- DEMOLITION NOTES:**
- SEE ARCH'L DEMO. PLANS FOR SELECTIVE FLOOR DEMOLITION AT BASEMENT LEVEL.
  - SEE ARCH'L DEMO PLANS FOR SMALL OPENINGS AT ALL LEVELS.
  - DEMOLITION OF EXISTING FLOOR & ROOF FRAMING SHALL BE PERFORMED IN MANAGEABLE PORTIONS AND MEASURES SHALL BE TAKEN TO PROTECT STRUCTURE BELOW FROM FALLING DEBRIS.
  - SEE ARCH'L DEMO PLANS FOR ADD'L INFO.
  - SEE 1/SD2.02 FOR DEMOLITION LIMITS OF THE EXISTING BEARING WALLS WHICH SUPPORT THE EXISTING STEEL ROOF FRAMING.
  - PROVIDE TEMPORARY BRACING FOR EXISTING STONE WALL BEFORE EXISTING ROOF STRUCTURE IS DEMOLISHED.
  - SCHEDULE PRE-CONSTRUCTION MEETING PRIOR TO THE START OF THE SELECTIVE WALL DEMOLITION.

DEMOLITION LEGEND	
	EXISTING STONE MASONRY WALL TO REMAIN.
	EXISTING SLAB / FLOOR STRUCTURE / FOUNDATION TO REMAIN
	EXISTING CONCRETE TO BE REMOVED
	EXISTING ROOF DECK TO BE REMOVED

- ROOF DEMOLITION KEY PLAN NOTES:**
- DEMOLISH EXISTING STEEL TRUSS
  - DEMOLISH EXISTING STEEL GIRDER / BEAM
  - DEMOLISH EXISTING STEEL ROOF FRAMING
  - DEMOLISH EXISTING ROOF DECK (ENTIRE ROOF)

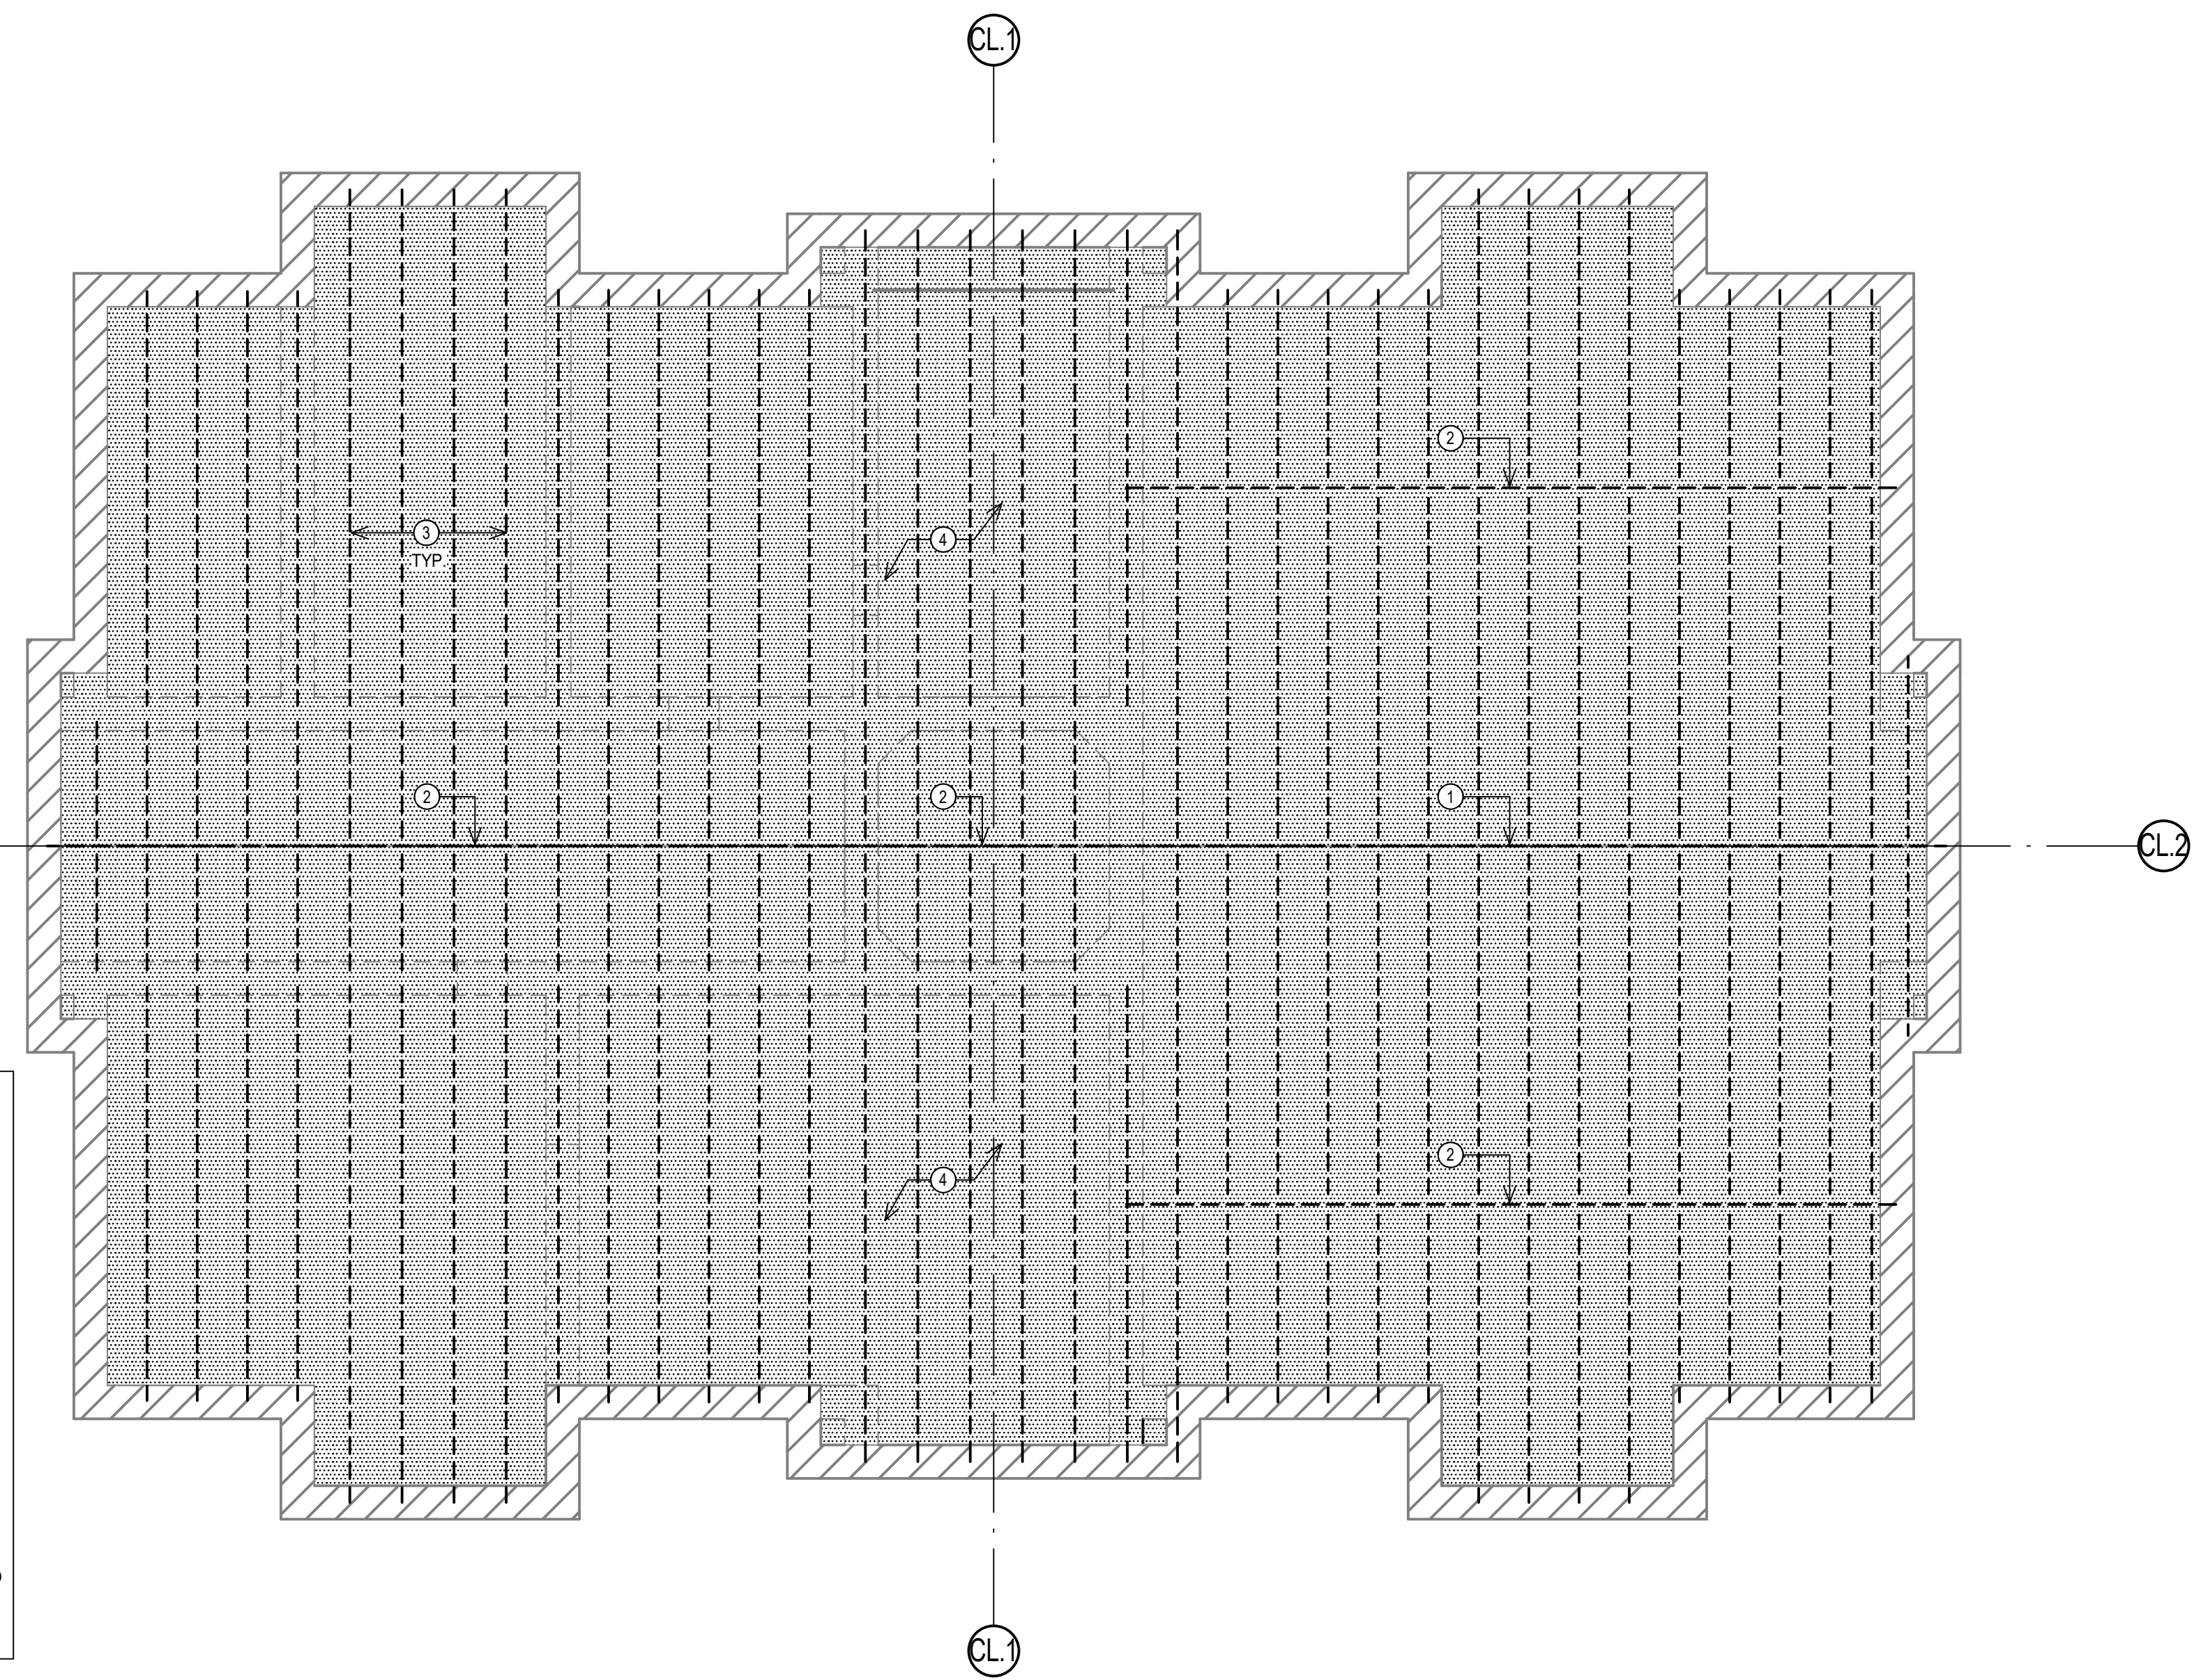

**2 ROOF LEVEL DEMOLITION PLAN**  
SCALE: 1/8" = 1'-0"




**FANNIN COUNTY COURTHOUSE**  
INTERIOR & EXTERIOR RESTORATION

101 E. Sam Rayburn Drive  
Bonham, Texas 75418

**COPYRIGHT**  
The Contractor shall verify and be responsible for all dimensions. DO NOT scale the drawing. Any errors or omissions shall be reported to Architexas without delay. The Copyrights to all designs and drawings are the property of Architexas. Reproduction or use for any purpose other than that authorized by Architexas is forbidden.

REVISION HISTORY	
1	10/16/18 ADDENDUM #1

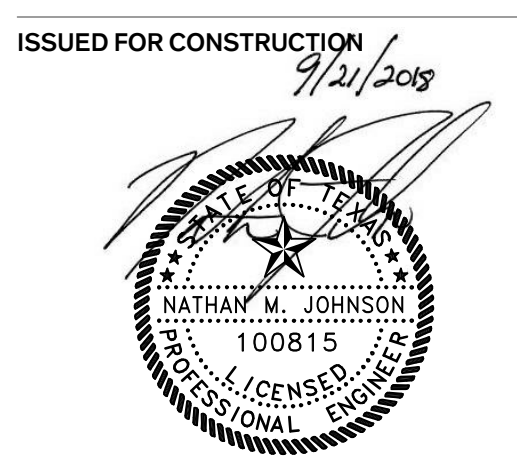

Architexas No. 1737 Date SEPT. 21.2018

Sheet Name **STRUCTURAL DEMOLITION PLANS**


Sheet Number **SD2.02**

shaping the built environment


**JQ ENGINEERING, LLP**  
100 SILAS STREET  
214.753.9098  
PROJECT NO. 3170377

DALLAS, TEXAS 75207  
JQENG.COM  
TBP# FIRM F-1294



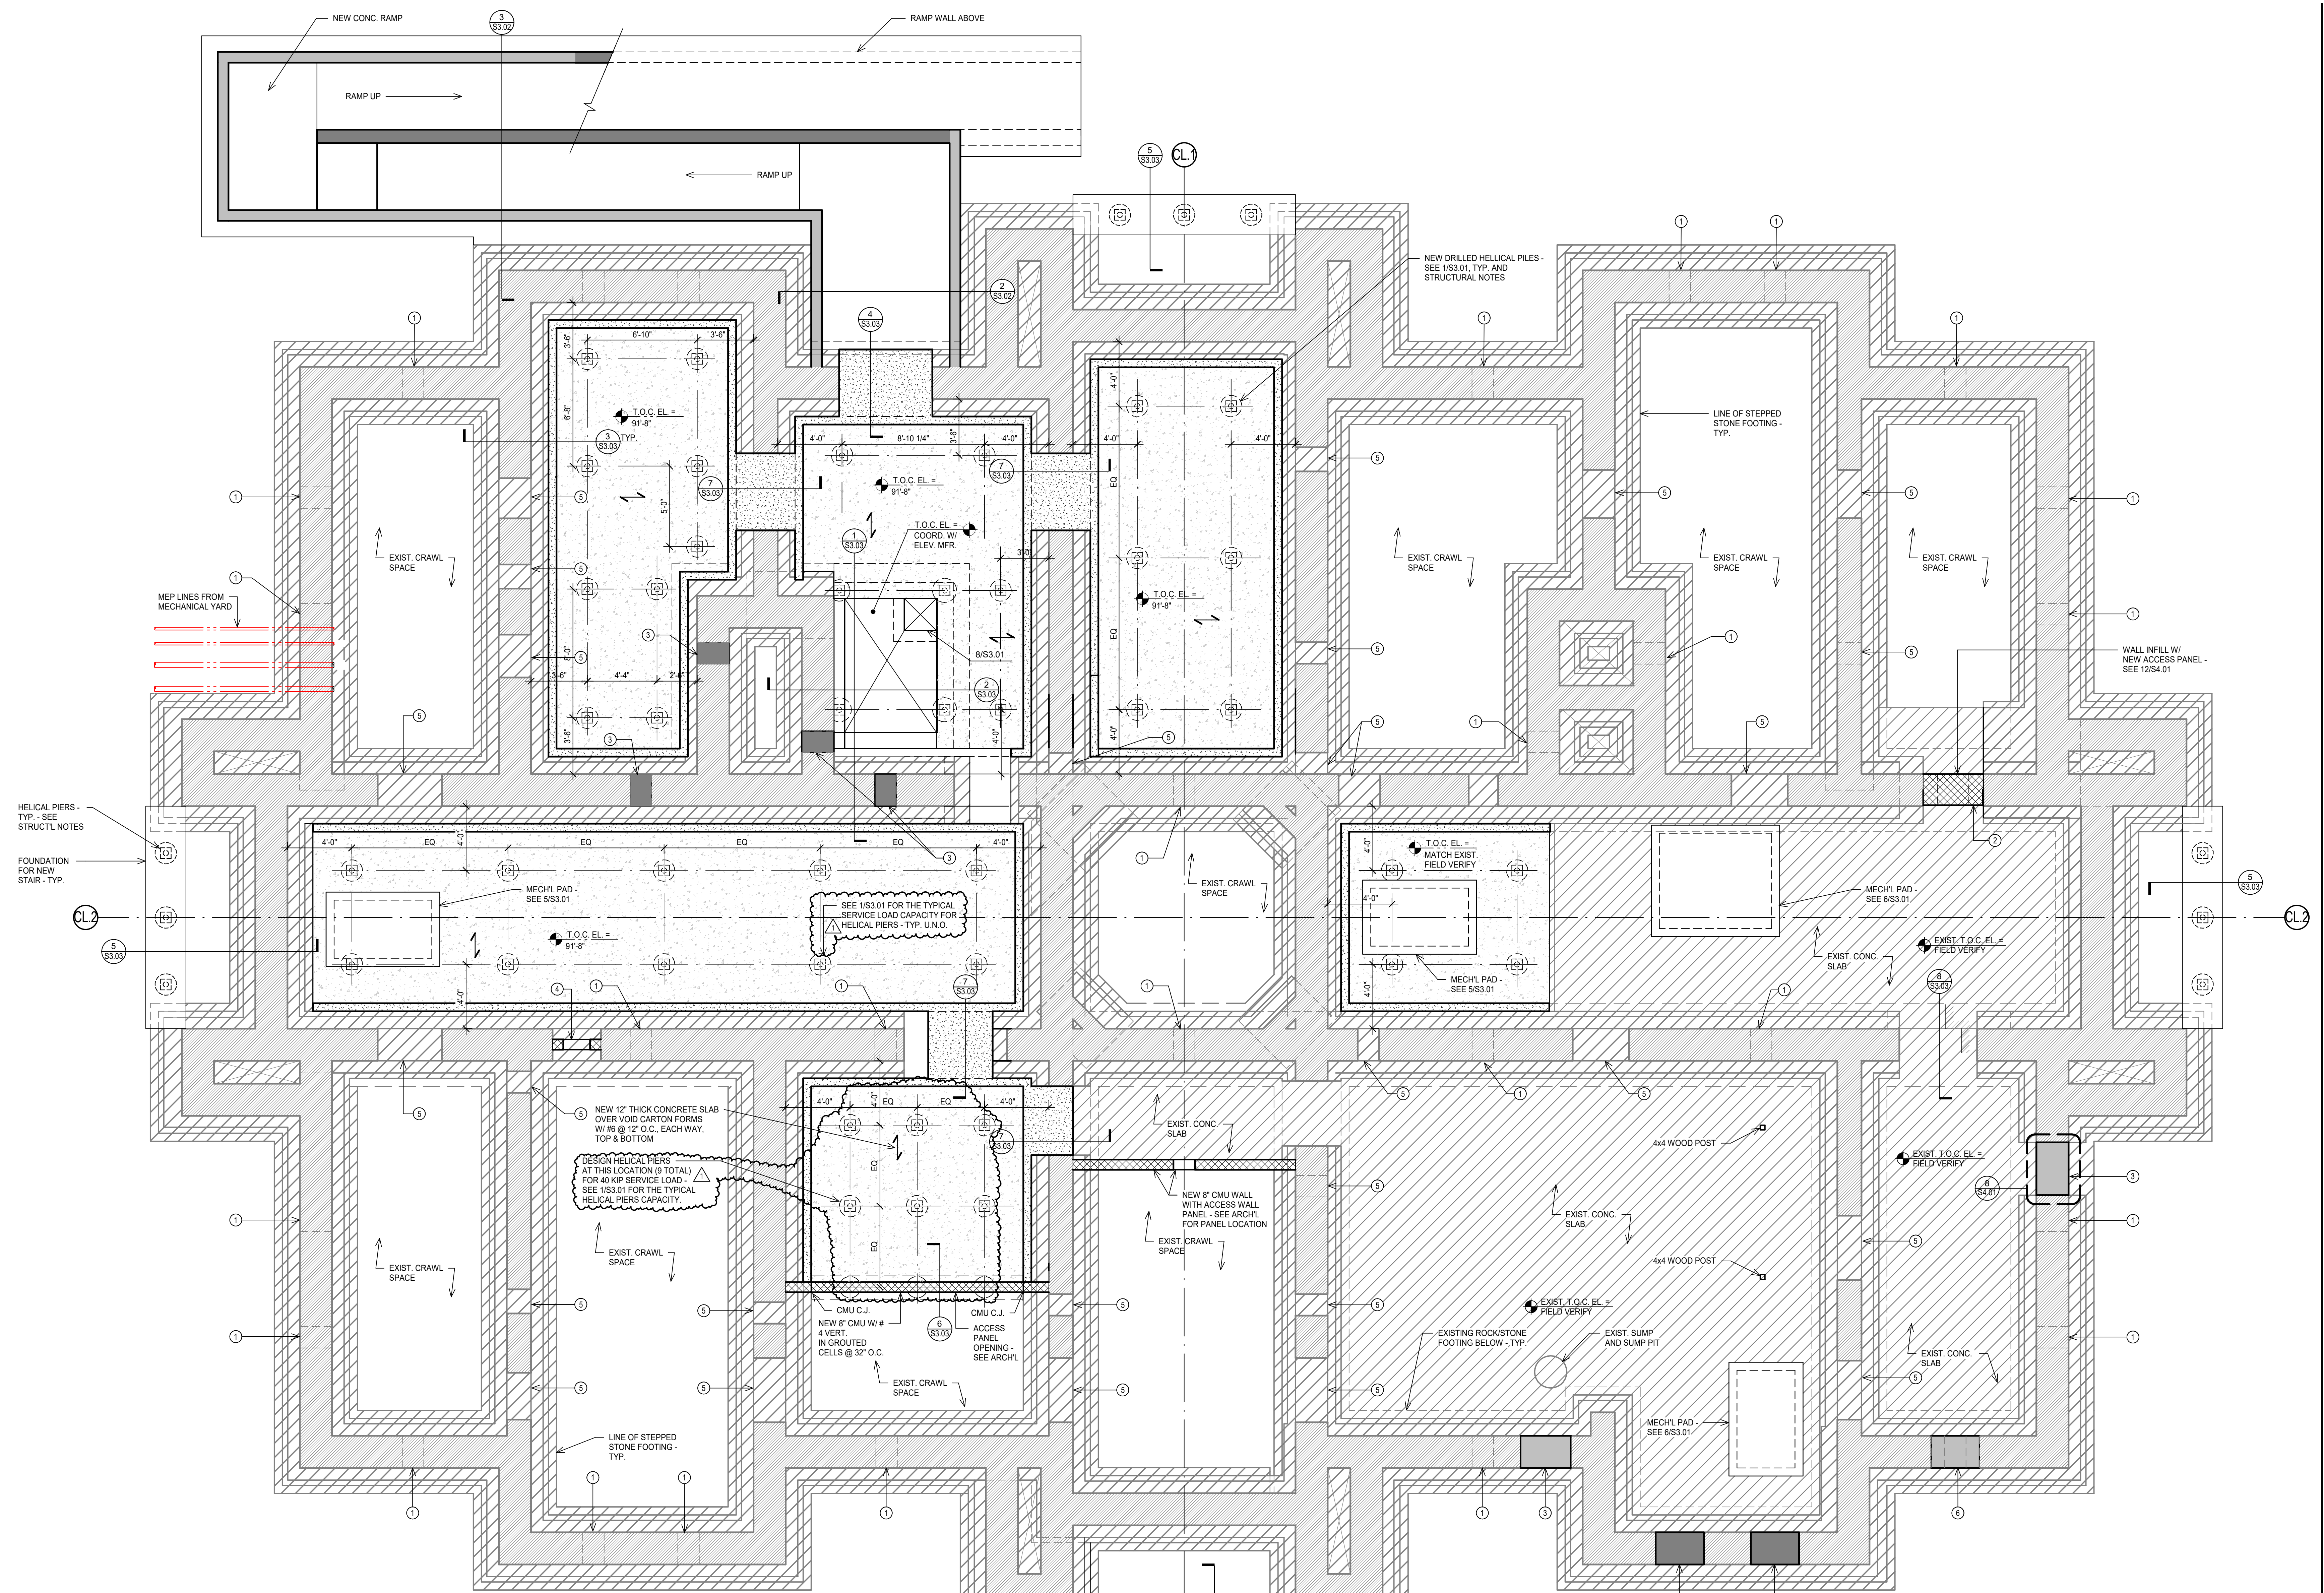

- KEY PLAN NOTES:**
- EXISTING CRAWLSPACE VENT TO REMAIN
  - NEW CMU WALL INFILL @ EXIST. OPENING - SEE 6/S3.01
  - NEW MASONRY WALL INFILL - SEE ARCH'L
  - NEW ACCESS OPENING - SEE 11/S4.01
  - NEW DUCTWORK/DOOR OPENING IN WALL - SEE SHEET SD2.01. REUSE NEARBY EXISTING OPENING WHERE POSSIBLE -
  - NEW WALL INFILL - SEE ARCH'L CRAWLSPACE VENT TO BE RECONSTRUCTED
- LEGEND:**
- NEW 8" THICK CONCRETE SLAB OVER VOID CARTON FORMS W/ #5 @ 12" TOP & BOT. EA. WAY - TYP. U.N.O.
  - EXIST. SLAB-ON-GRADE TO REMAIN
  - EXIST. CRAWL SPACE
  - EXIST. STONE MASONRY WALL/FOUNDATION
  - NEW BRICK OR STONE INFILL
  - NEW CMU WALL INFILL
  - CONCRETE FILL OVER EXIST FOOTING

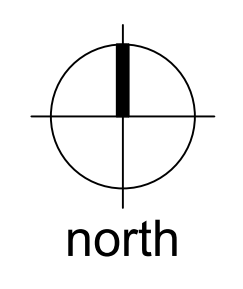

**1 BASEMENT FRAMING PLAN**  
 SCALE: 1/4" = 1'-0"

JQ HAS ATTEMPTED BY VISUAL OBSERVATION AND STUDY OF ORIGINAL CONSTRUCTION DOCUMENTS TO DETERMINE EXISTING DIMENSIONS, THE CONDITION OF VARIOUS STRUCTURAL ELEMENTS AND EXISTING CONDITIONS.

HOWEVER, AS SOME CONDITIONS CANNOT BE DETERMINED UNTIL AFTER DEMOLITION OF THE EXISTING BUILDING FINISHES, THE CONTRACTOR MUST CONSIDER AND ALLOW FOR THE FACT THAT DIMENSIONS, THE CONDITION OF STRUCTURAL ELEMENTS, AND DETAIL CONDITIONS MAY BE DIFFERENT FROM THOSE SHOWN ON THESE DRAWINGS.

NOTIFY ENGINEER WHERE CONDITIONS ARE DIFFERENT FROM THOSE SHOWN ON THESE DRAWINGS.

shaping the built environment

**JQ ENGINEERING, LLP**  
 100 SILAS STREET  
 DALLAS, TEXAS 75201  
 214.753.9098  
 PROJECT NO. 3170377




**FANNIN COUNTY COURTHOUSE**  
 INTERIOR & EXTERIOR RESTORATION

101 E. Sam Rayburn Drive  
 Bonham, Texas 75418

**COPYRIGHT**  
 The Contractor shall verify and be responsible for all dimensions. DO NOT scale the drawing. Any errors or omissions shall be reported to Architexas without delay. The Copyrights to all designs and drawings are the property of Architexas. Reproduction or use for any purpose other than that authorized by Architexas is forbidden.

**REVISION HISTORY**  
 1 10/16/18 ADDENDUM #1

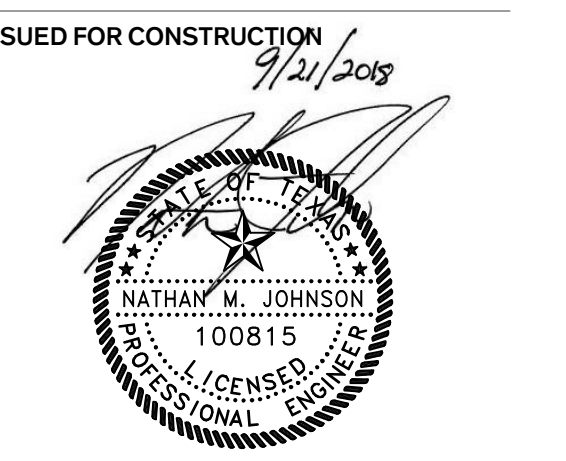


Architexas No. 1737 Date SEPT. 21, 2018


Sheet Name **BASEMENT FRAMING PLAN**

Sheet Number **S2.00**




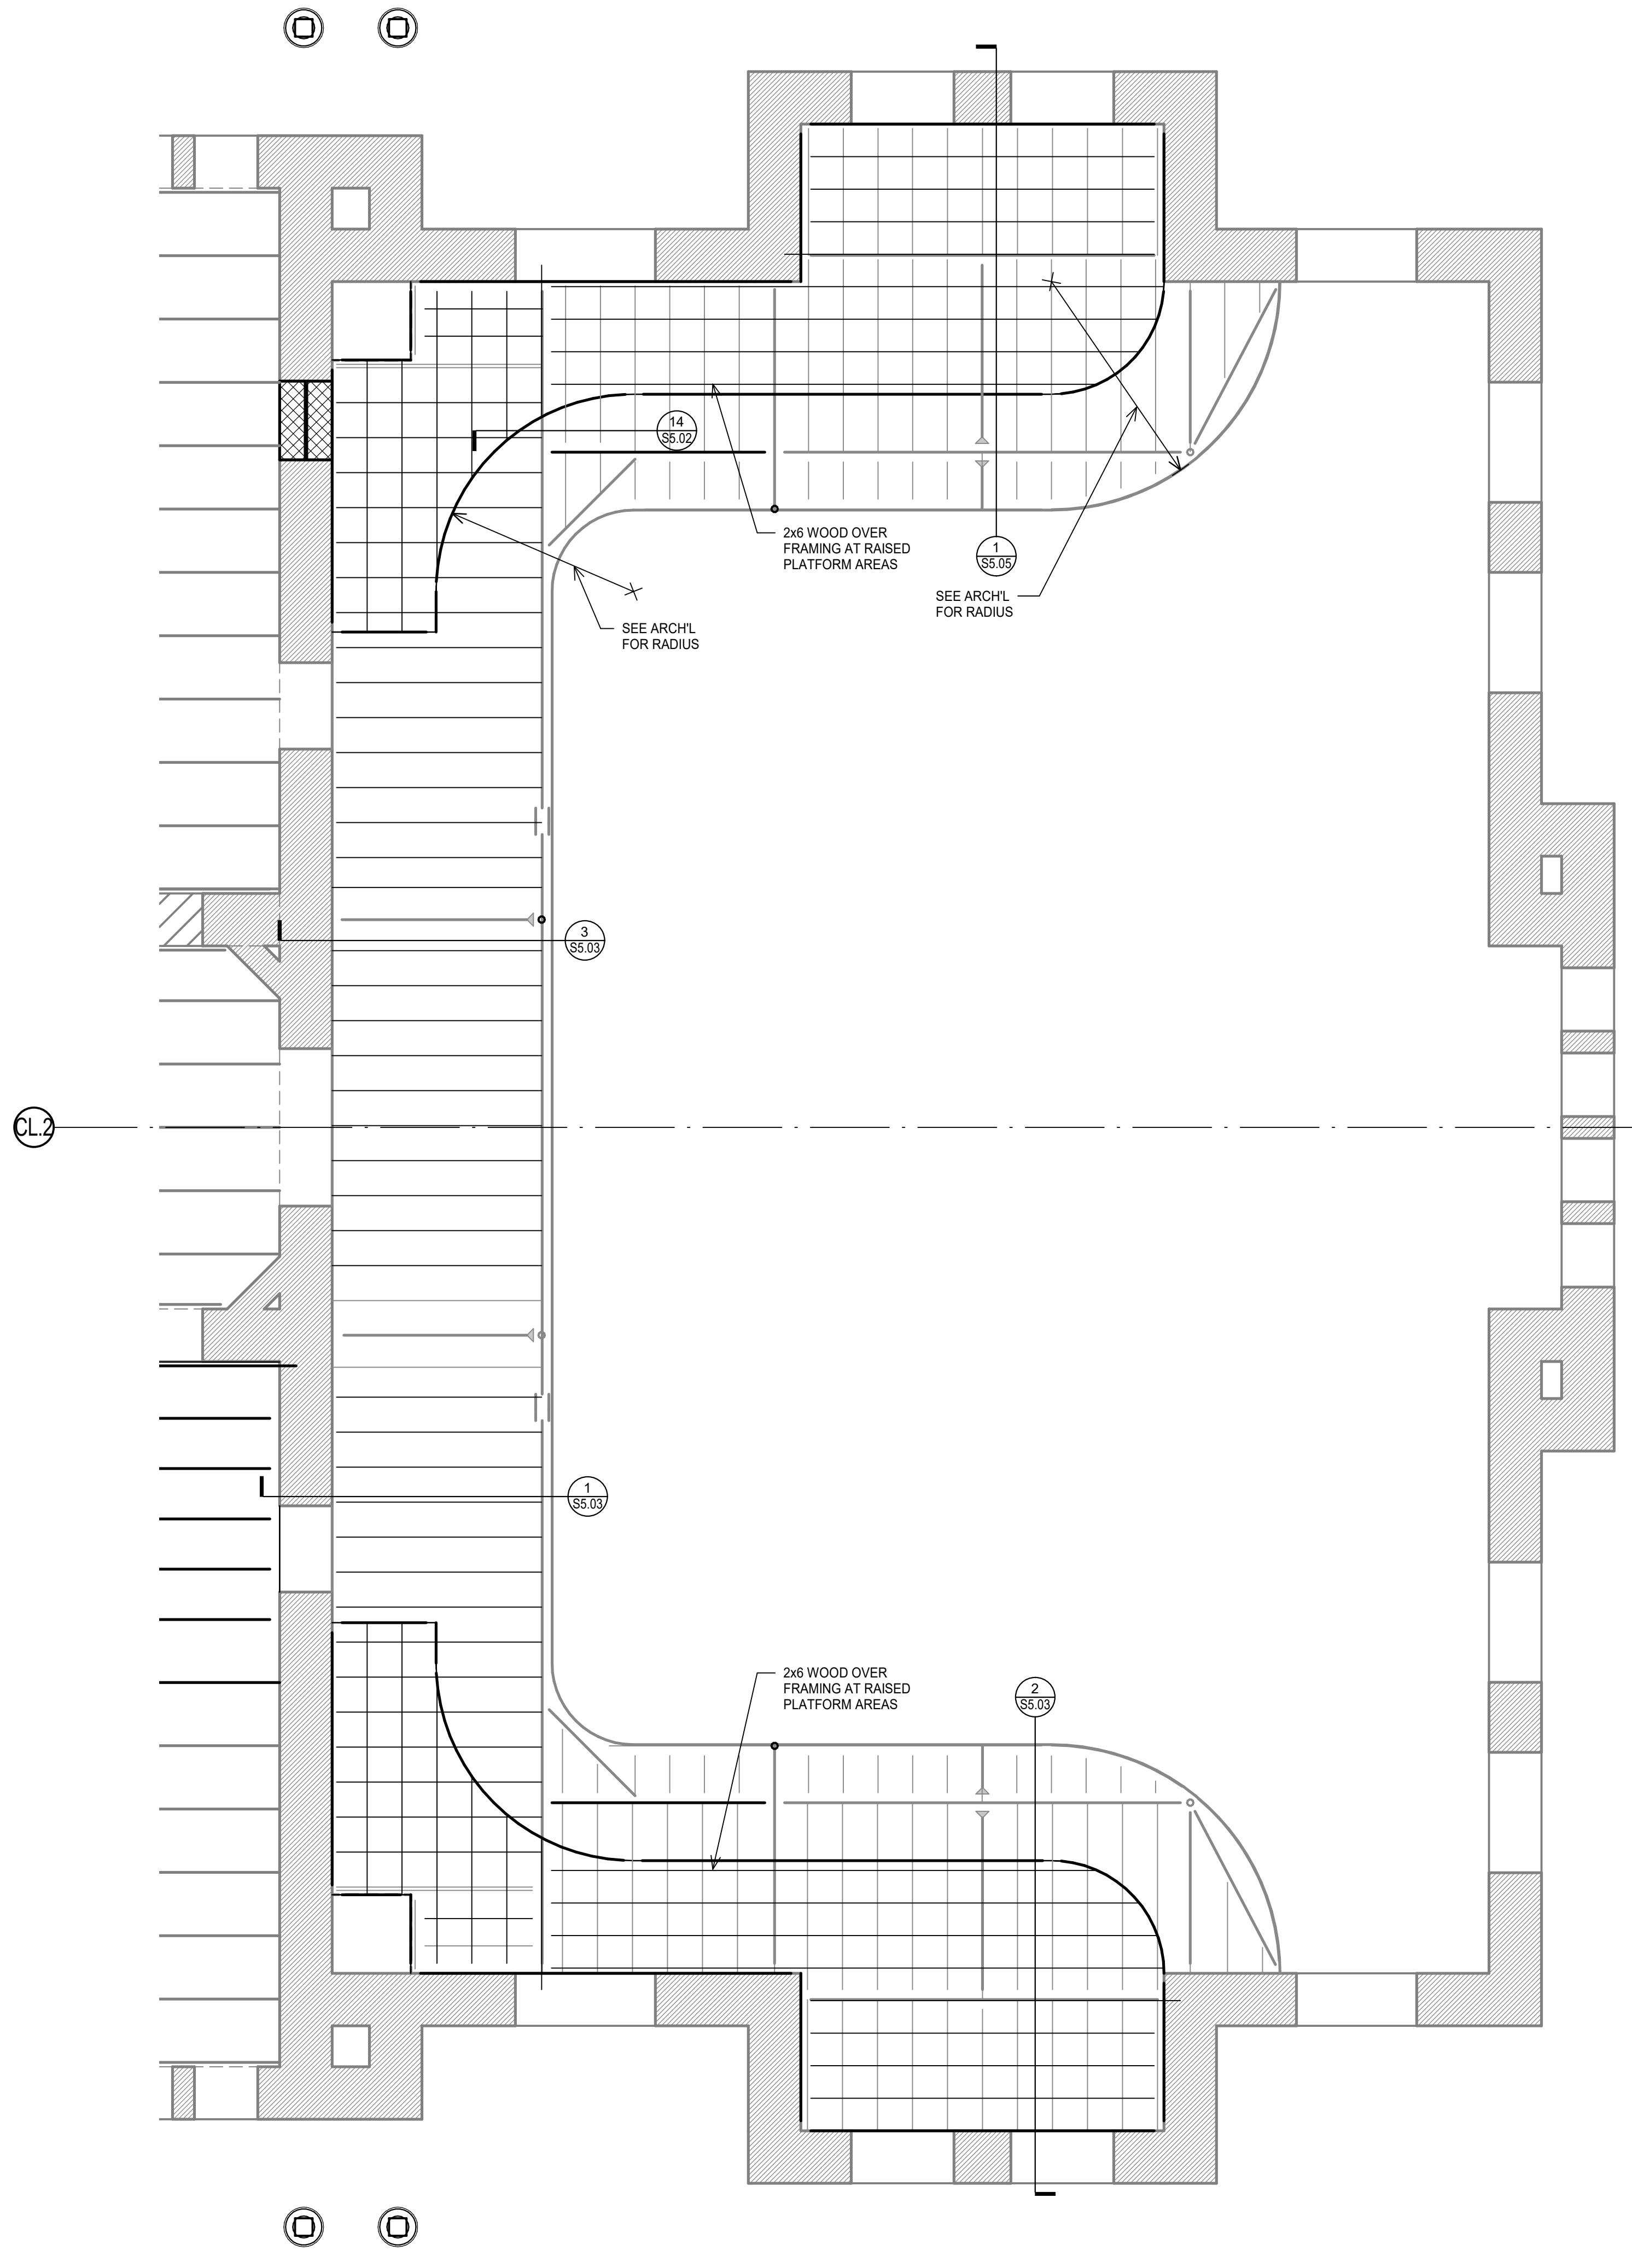


**1 THIRD LEVEL FRAMING PLAN**  
 SCALE: 1/4" = 1'-0"  
 north

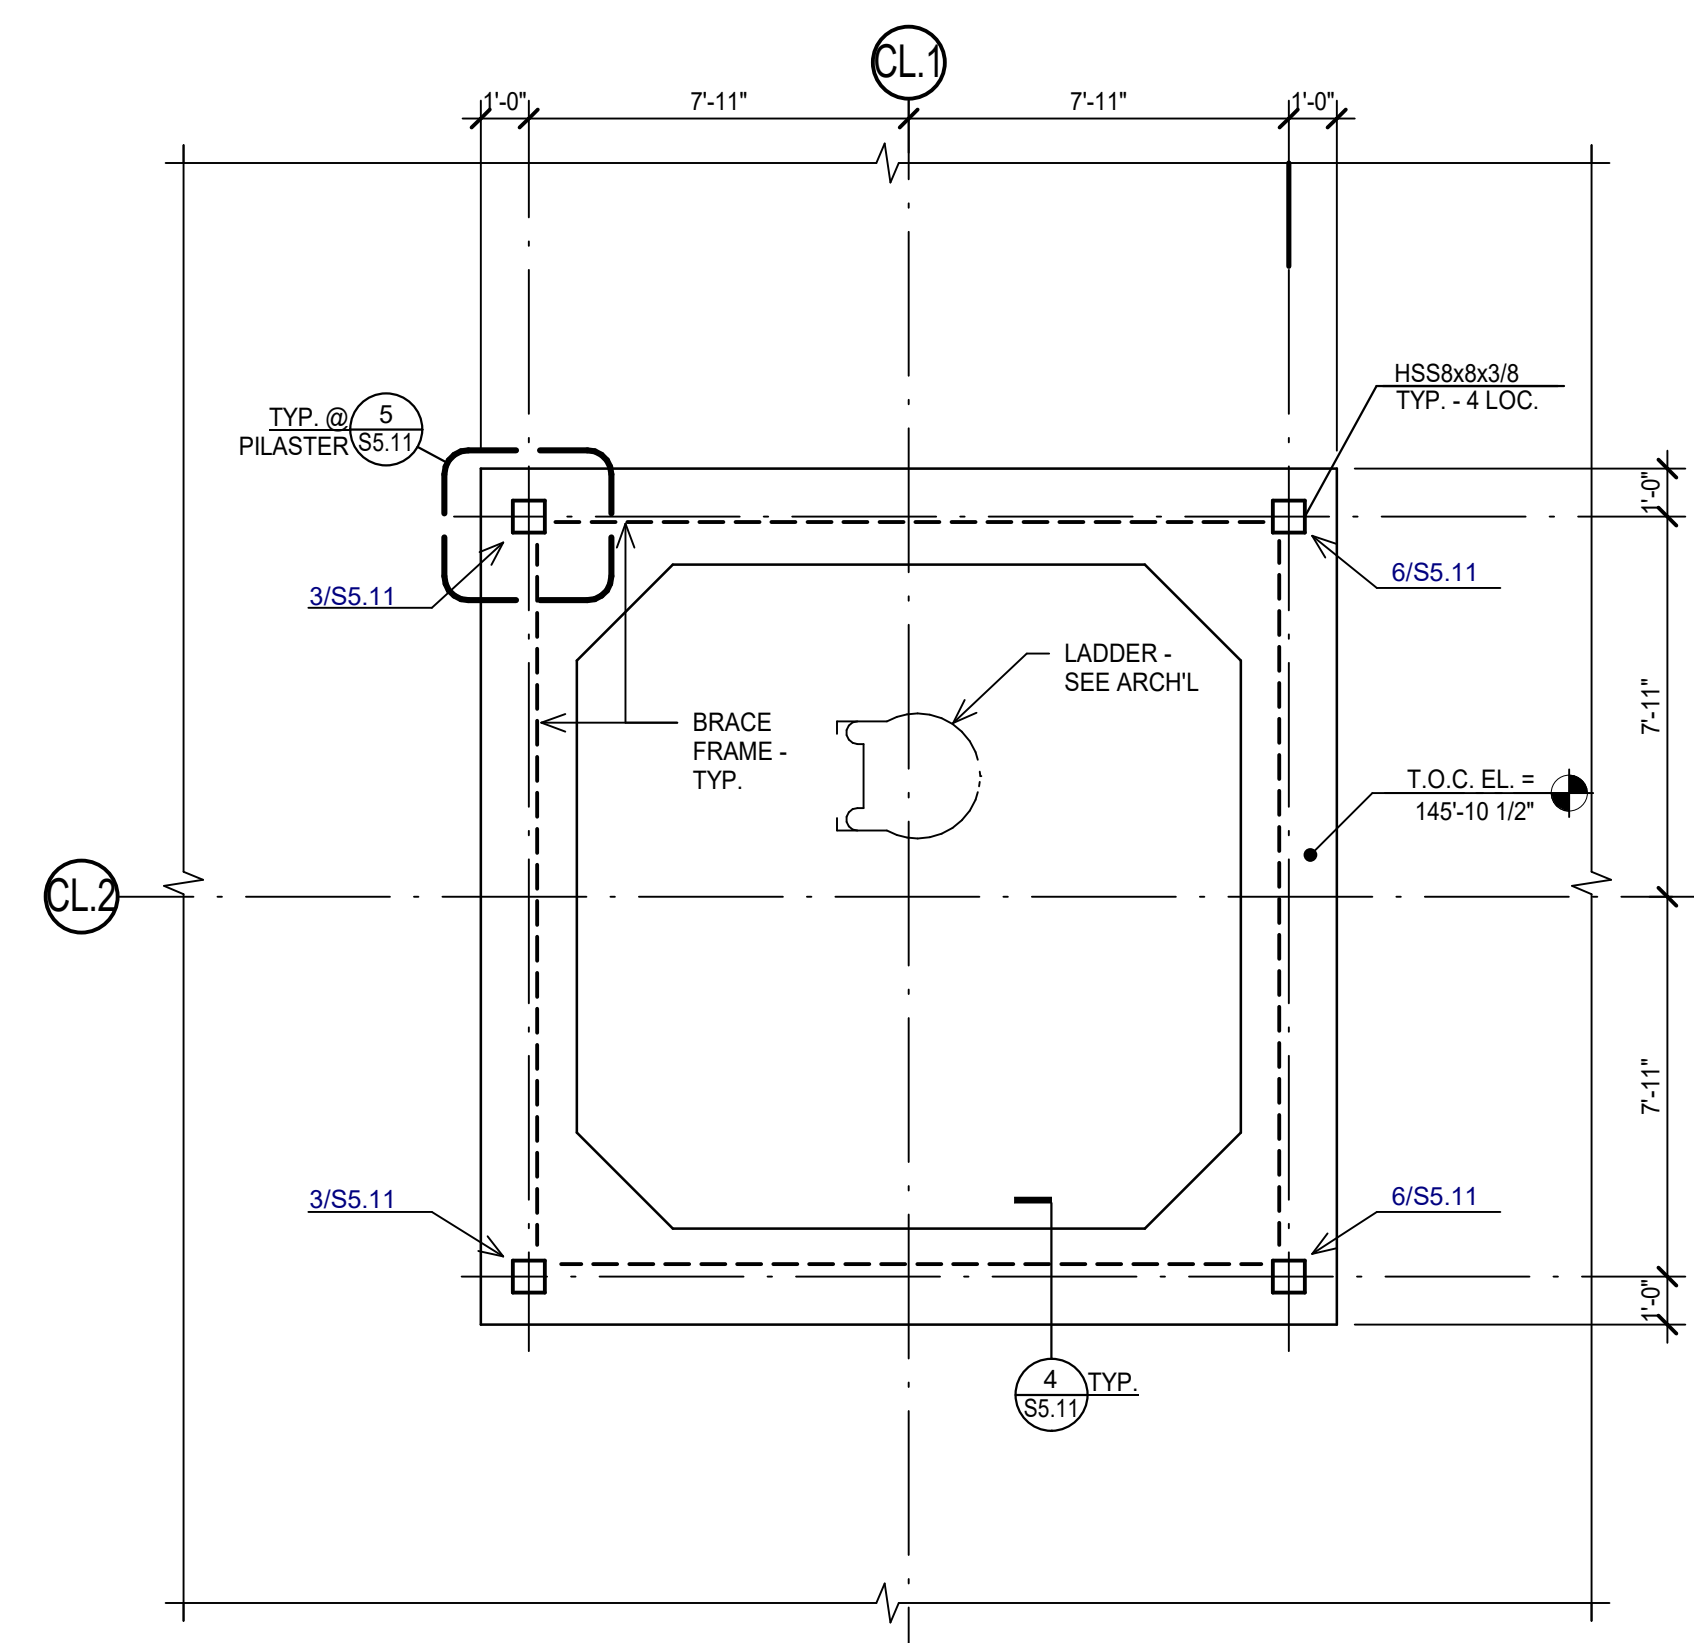


**2 TOWER BASE**  
 SCALE: 1/4" = 1'-0"  
 north

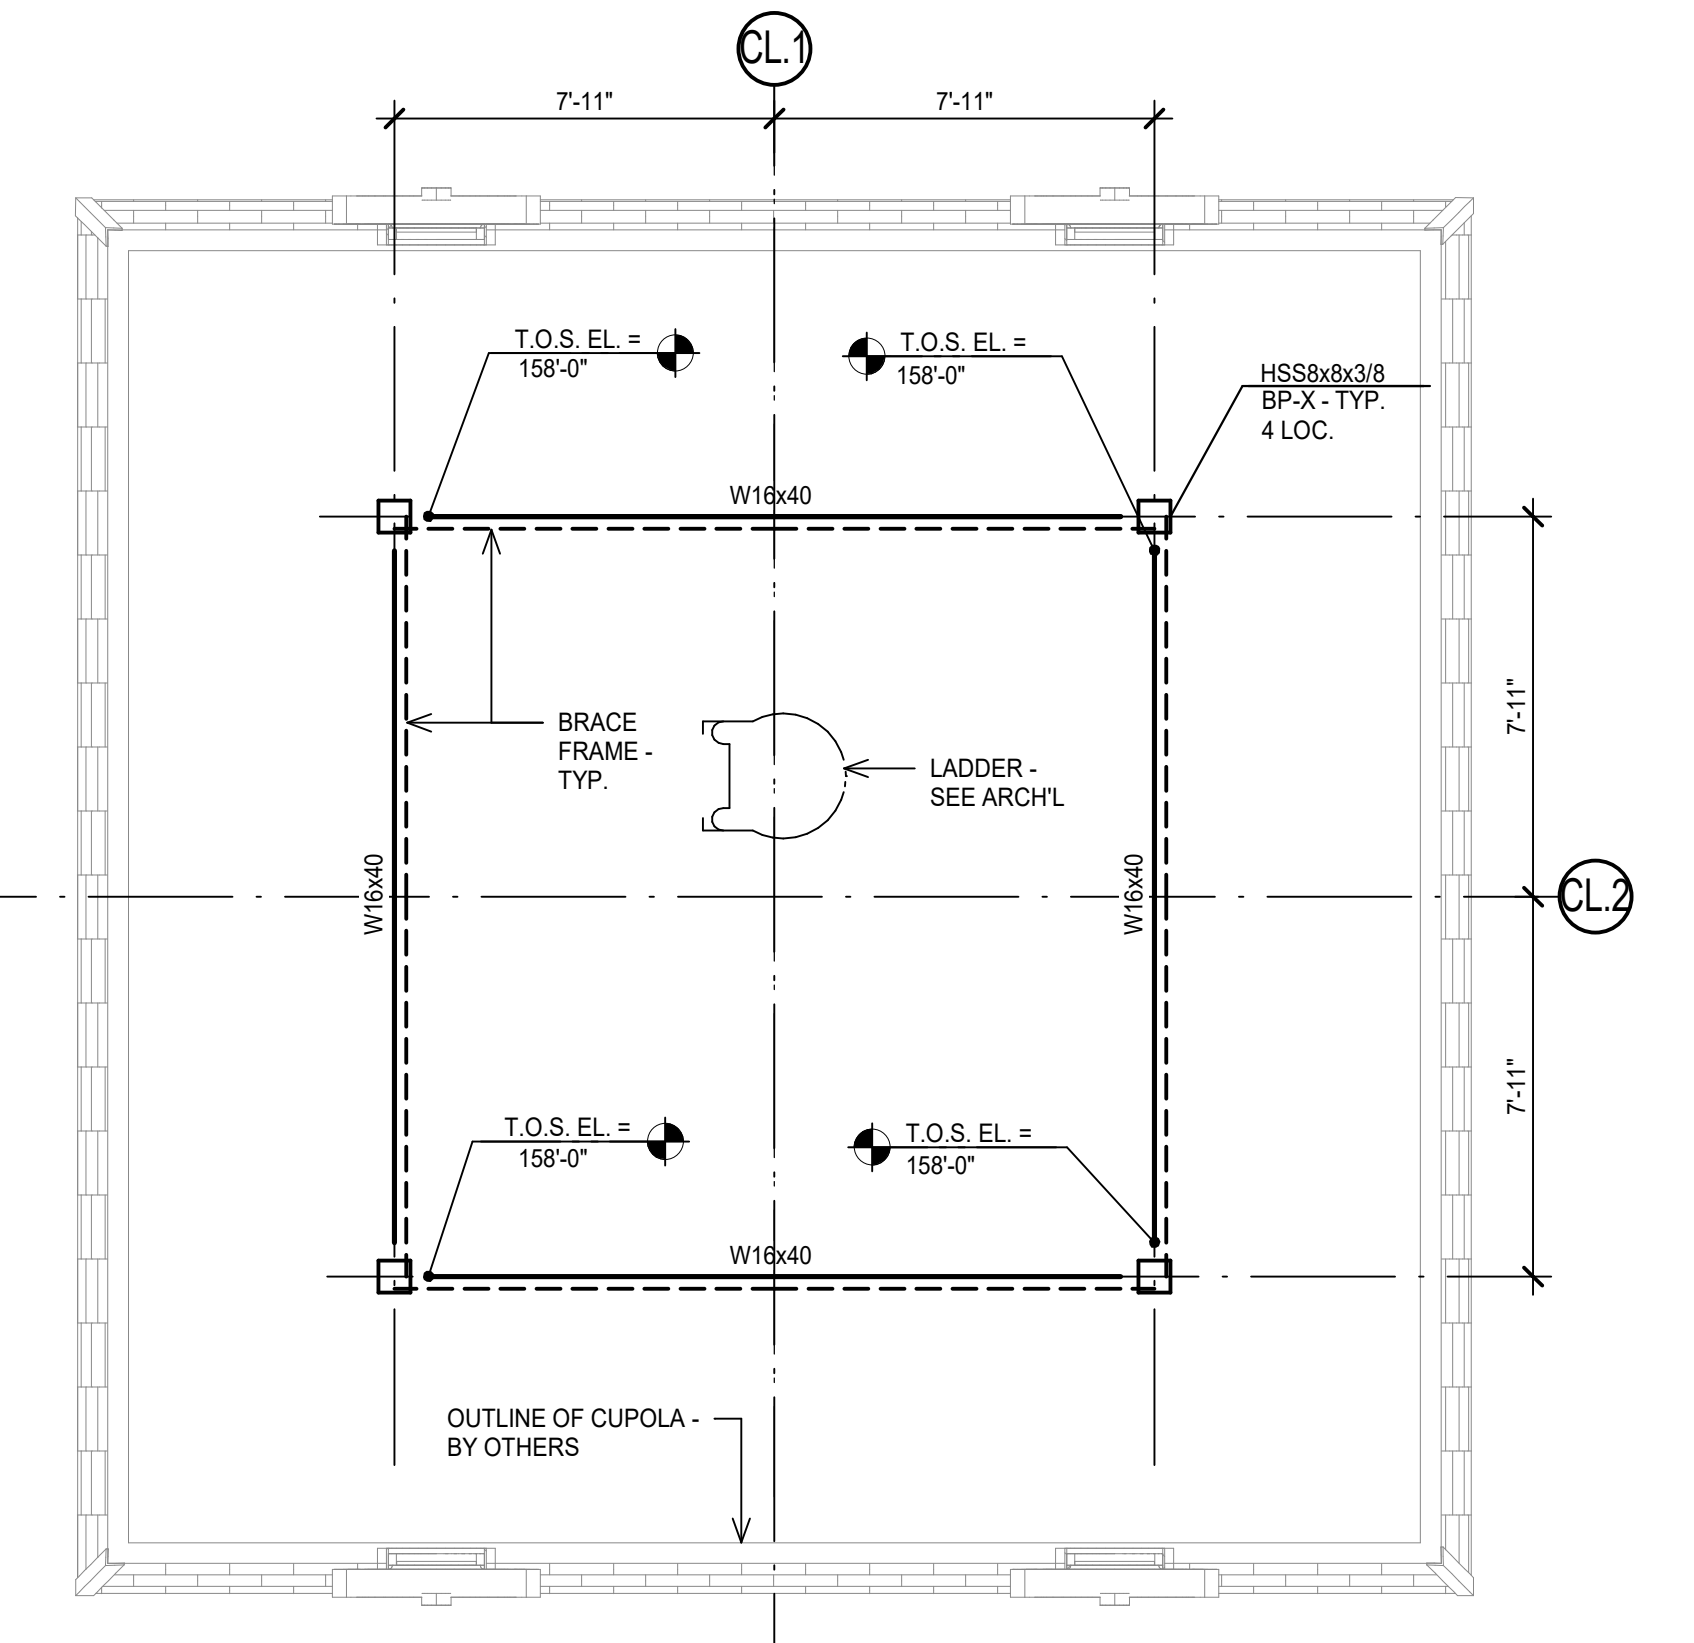


**3 TOWER BASE FRAME - LOWER LEVEL**  
 SCALE: 1/4" = 1'-0"  
 north

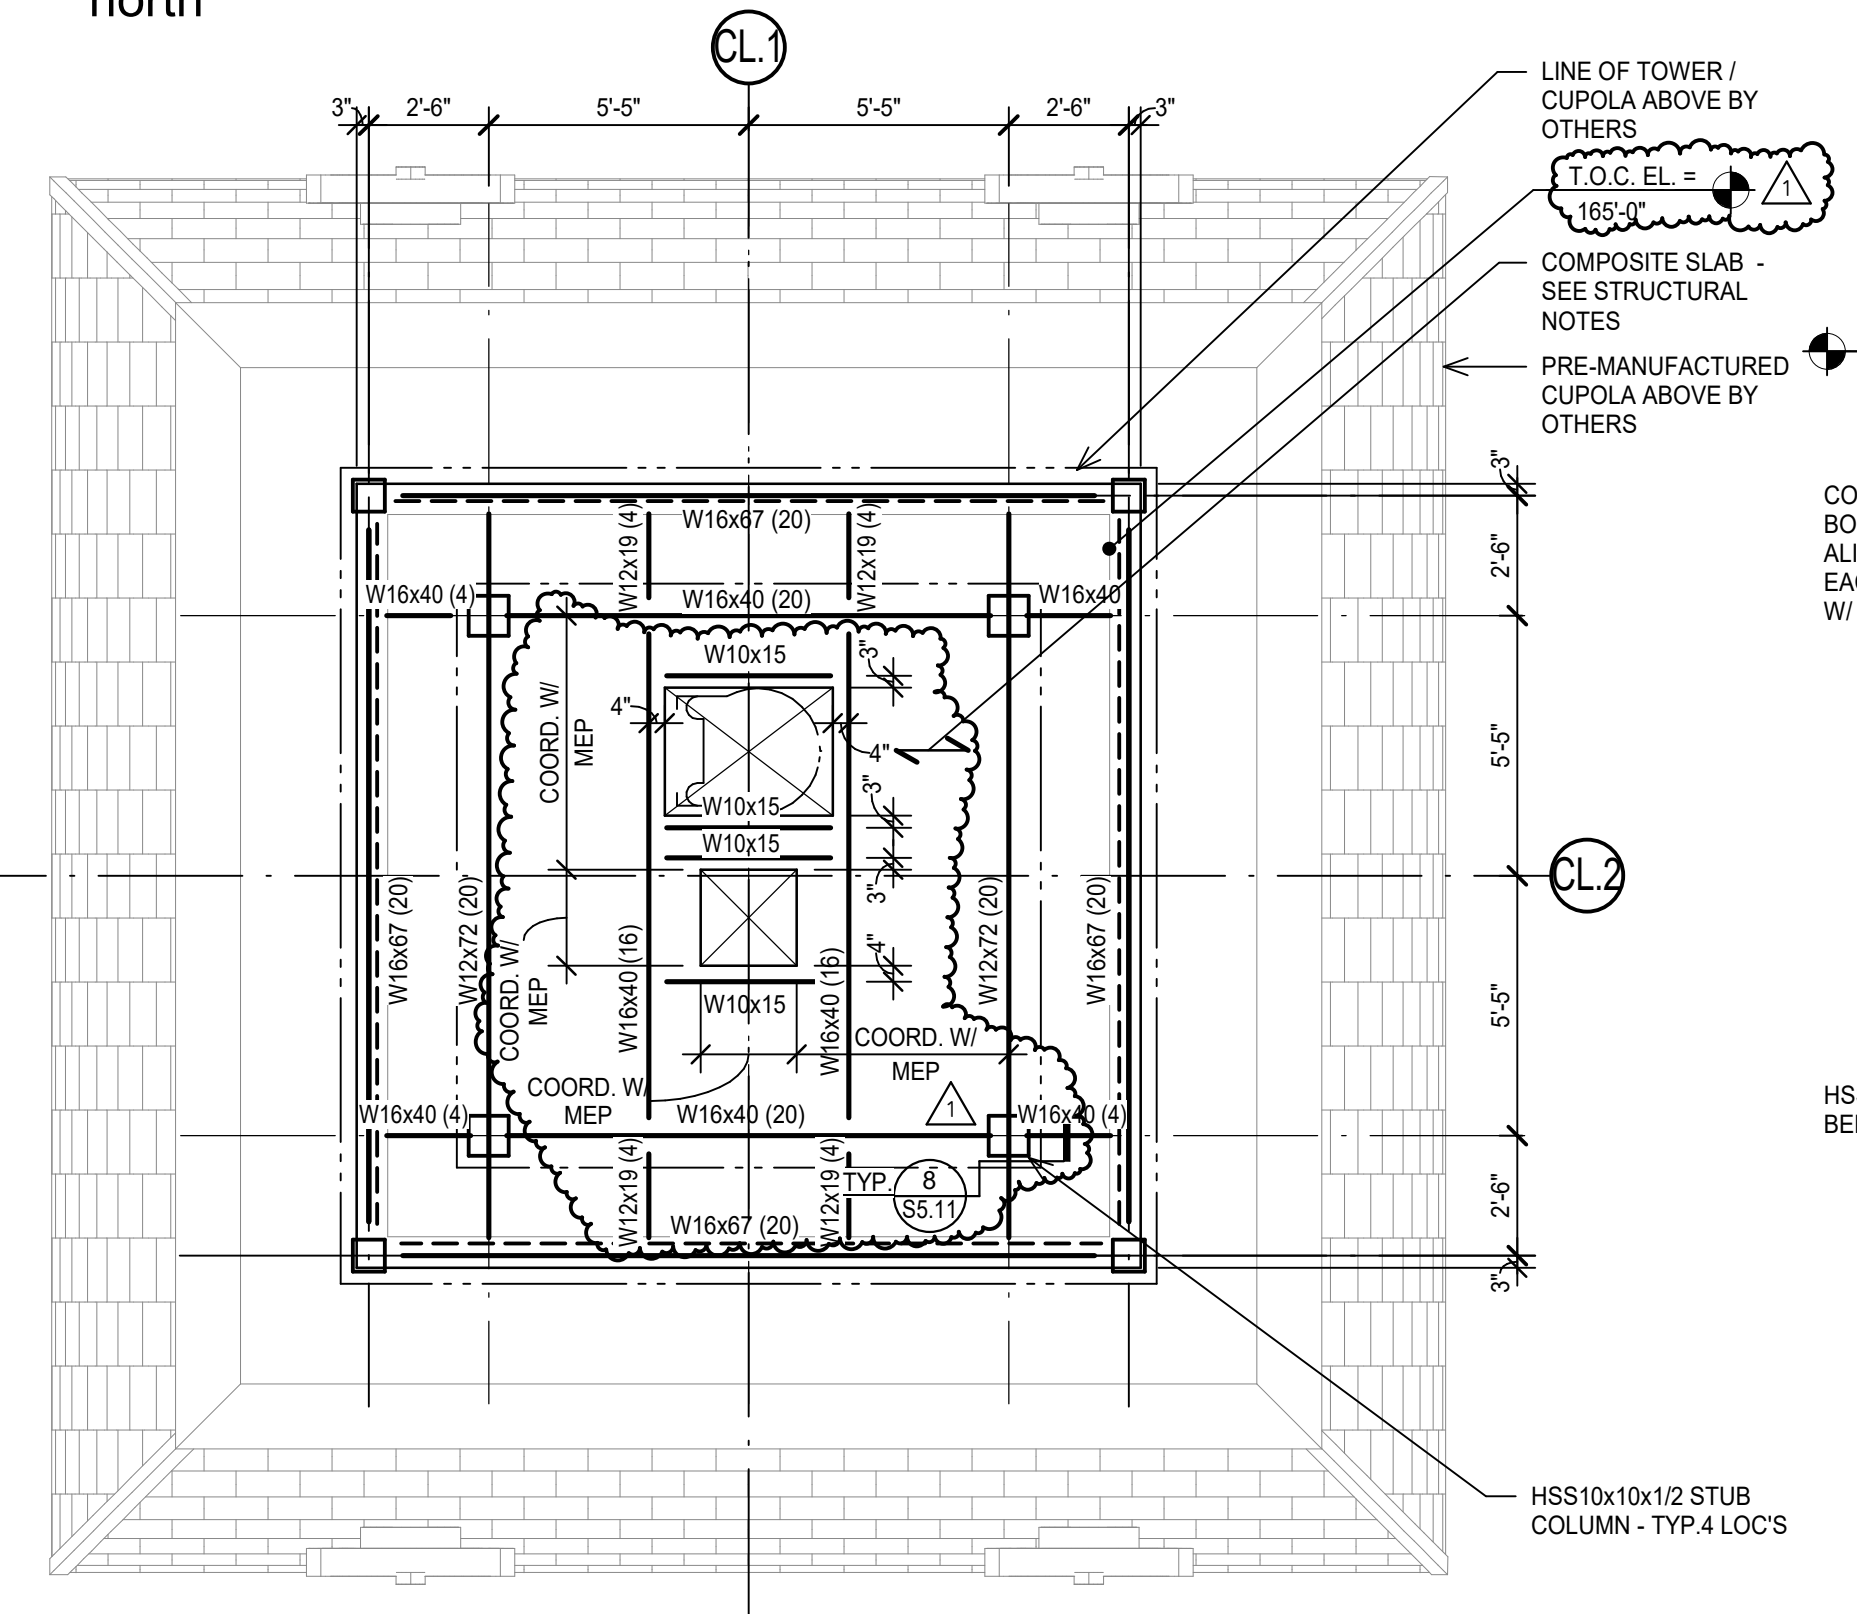


**4 TOWER BASE FRAME - UPPER LEVEL**  
 SCALE: 1/4" = 1'-0"  
 north

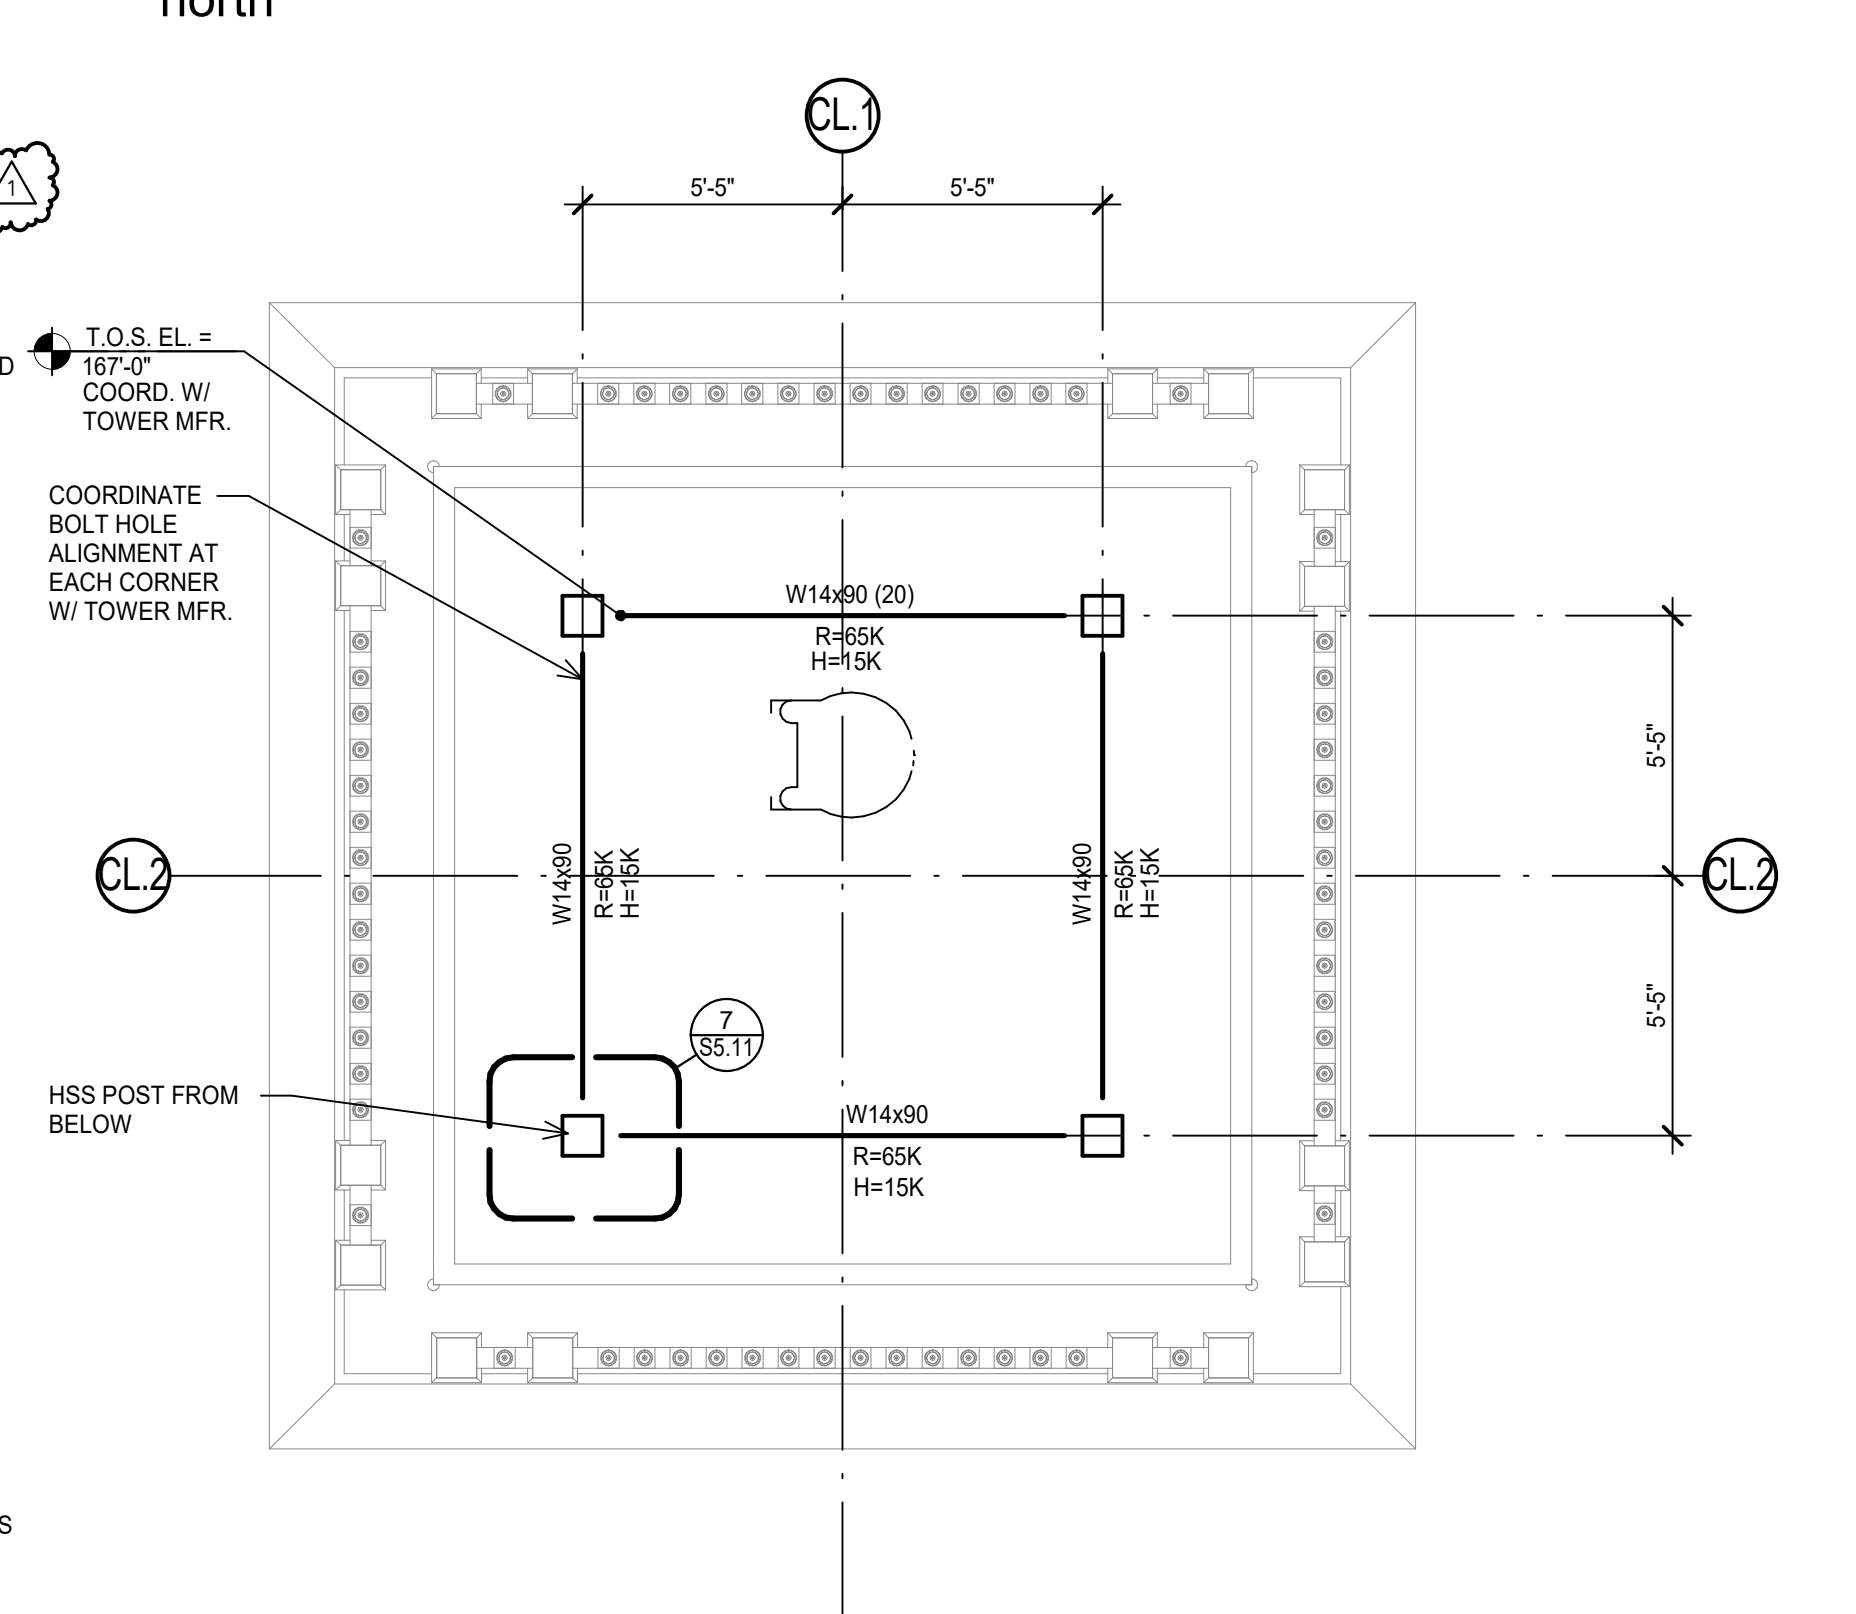

**5 TOWER BASE FRAME - CUPOLA CONNECTION LEVEL**  
 SCALE: 1/4" = 1'-0"  
 north

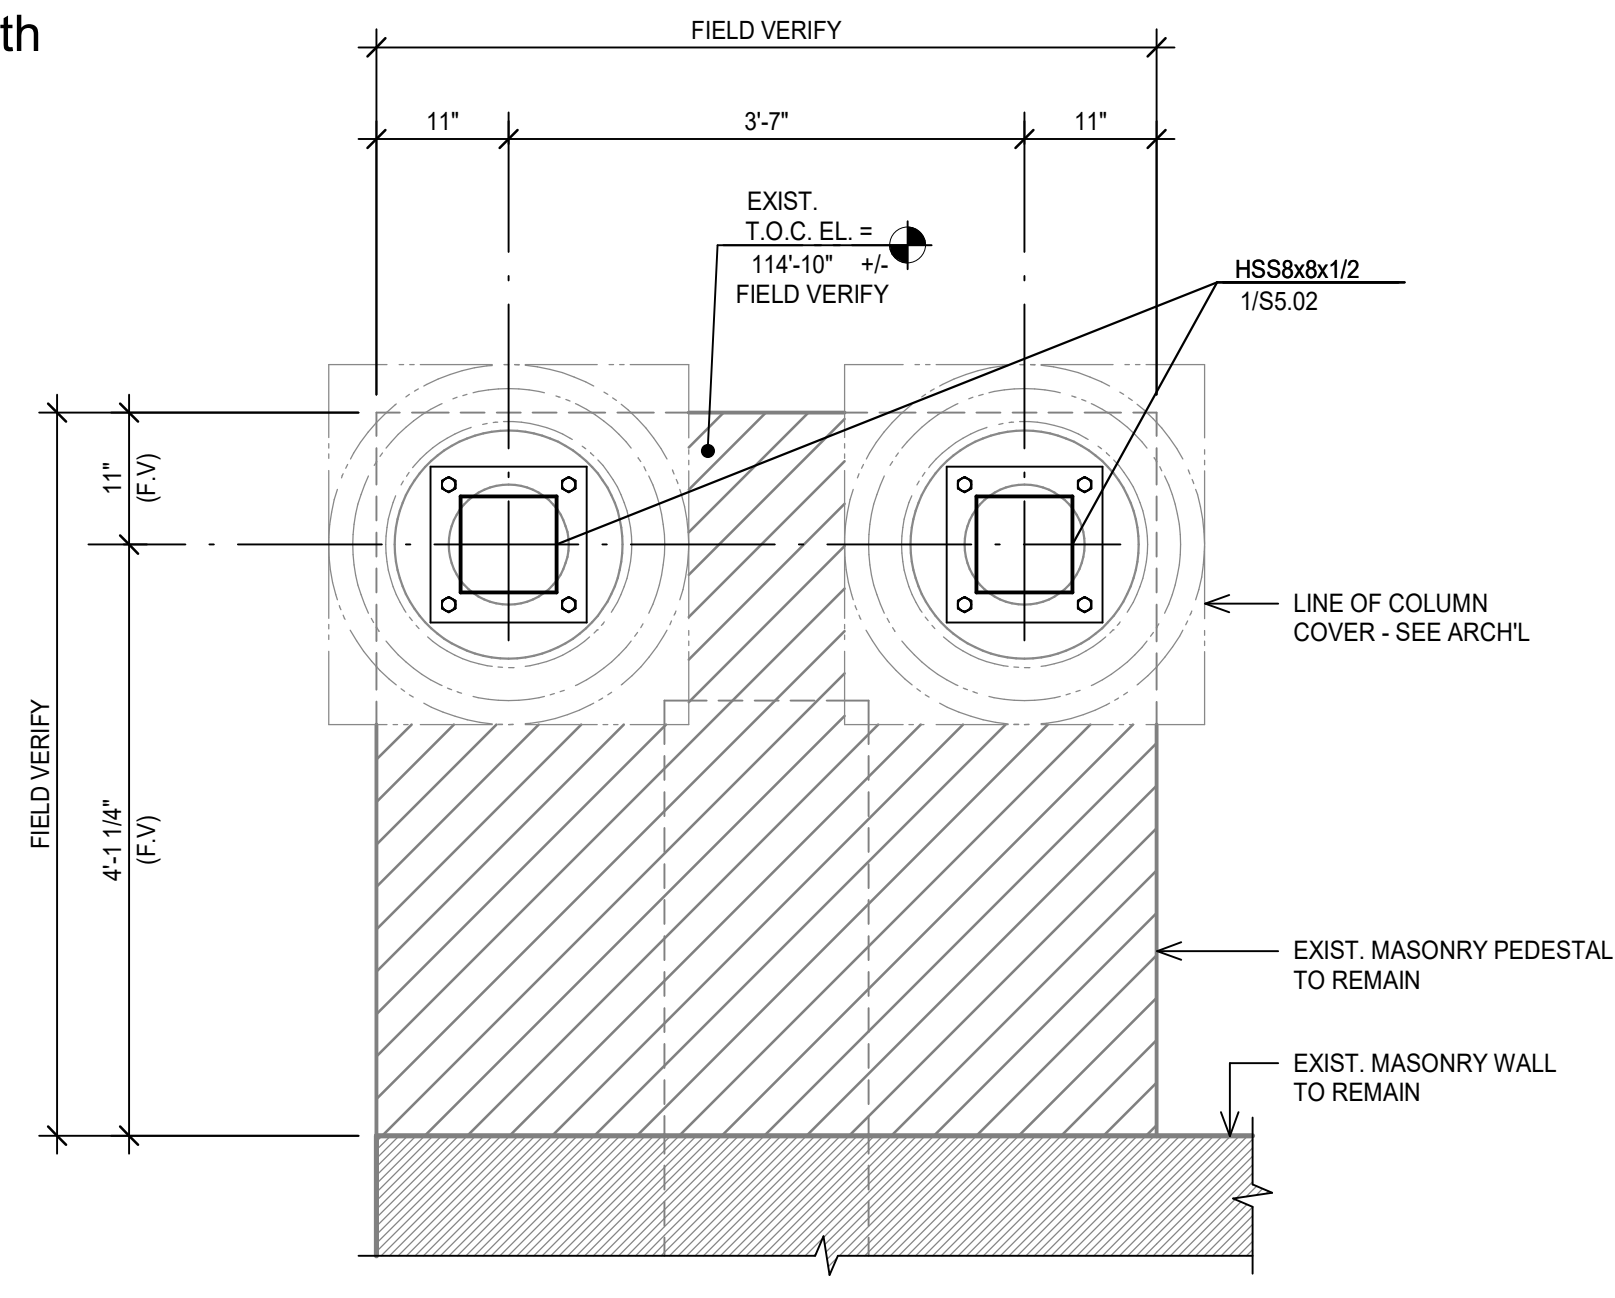

**6 ENTRY COLUMN ENLARGED FRAMING PLAN - SECOND LEVEL**  
 SCALE: 3/4" = 1'-0"  
 north

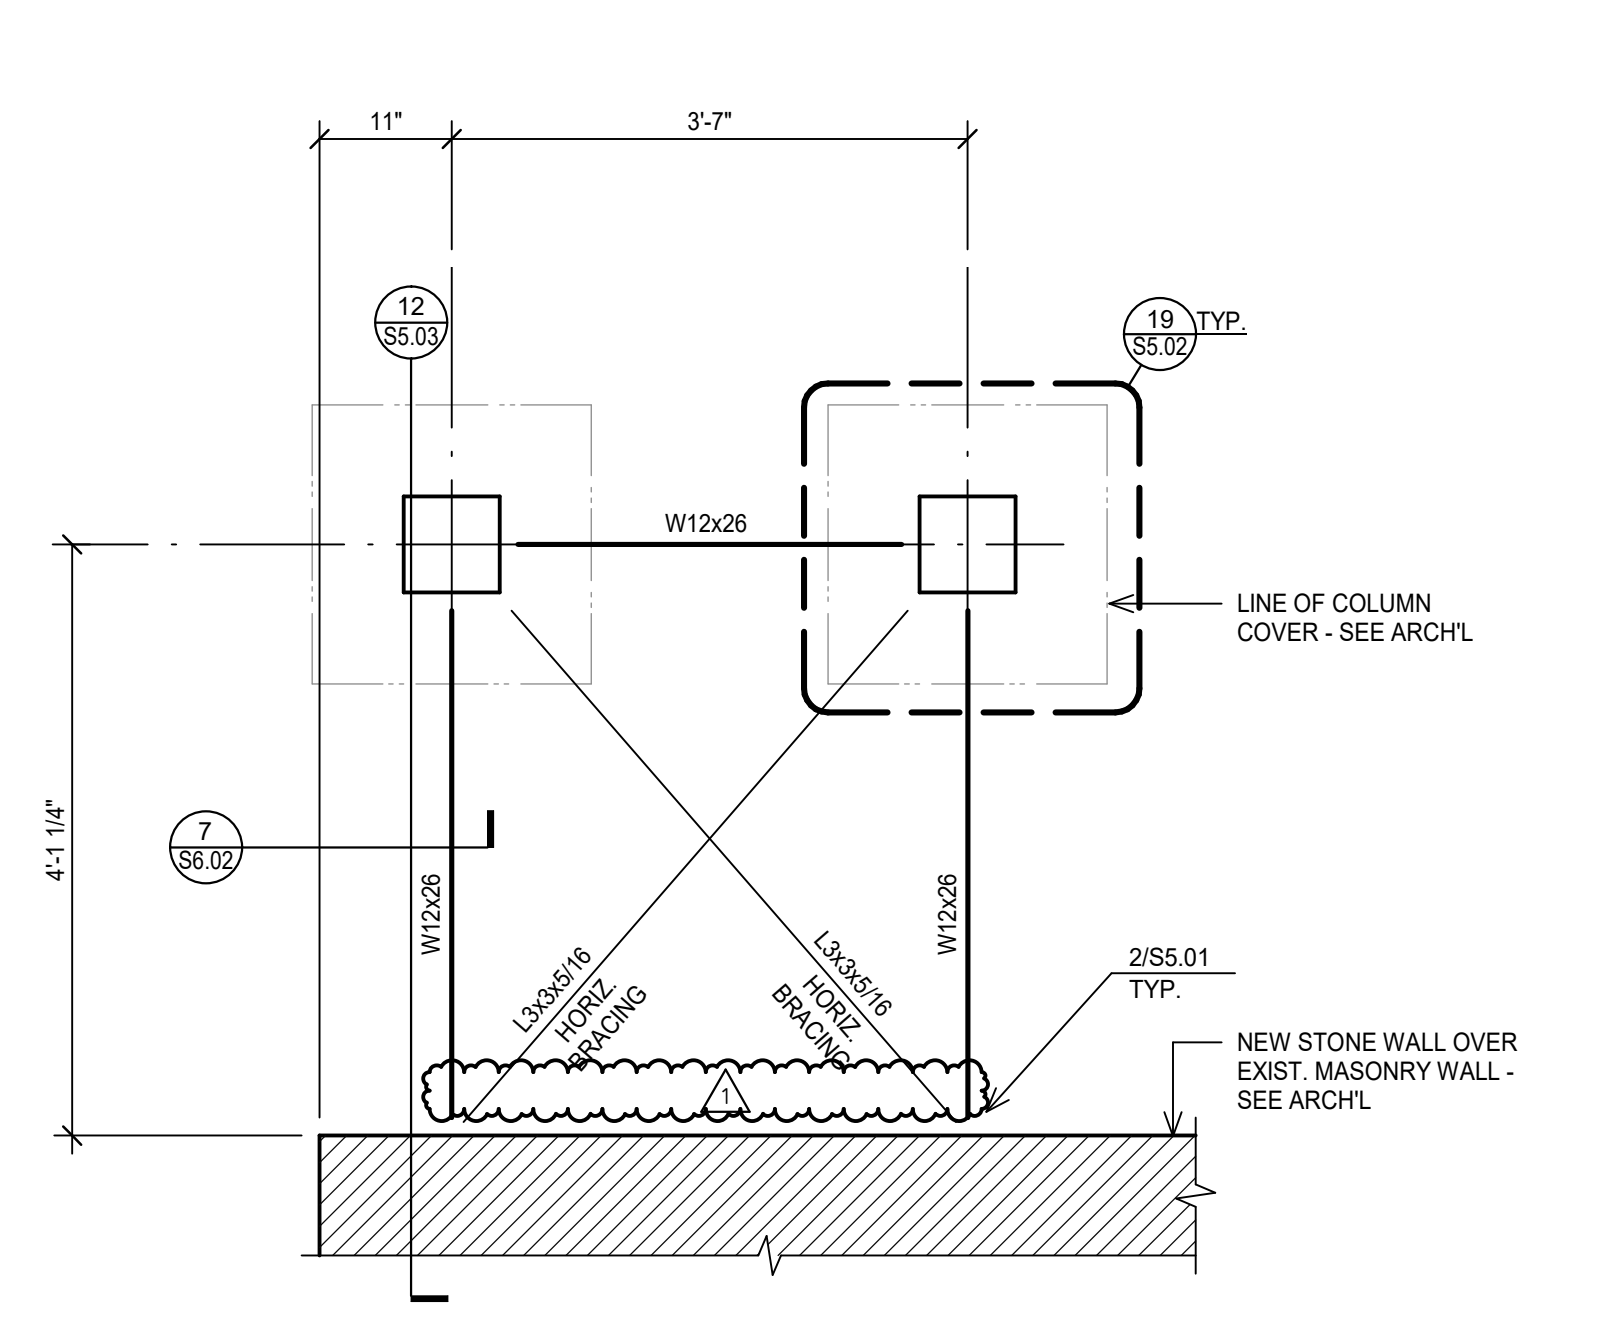

**7 ENTRY COLUMN ENLARGED FRAMING PLAN - UPPER LEVEL**  
 SCALE: 3/4" = 1'-0"  
 north




**FANNIN COUNTY COURTHOUSE**  
 INTERIOR & EXTERIOR RESTORATION

101 E. Sam Rayburn Drive  
 Bonham, Texas 75418

**COPYRIGHT**  
 The Contractor shall verify and be responsible for all dimensions. DO NOT scale the drawing. Any errors or omissions shall be reported to Architexas without delay. The Copyrights to all designs and drawings are the property of Architexas. Reproduction or use for any purpose other than that authorized by Architexas is forbidden.

REVISION HISTORY	ADDENDUM #1
1 10/16/18	

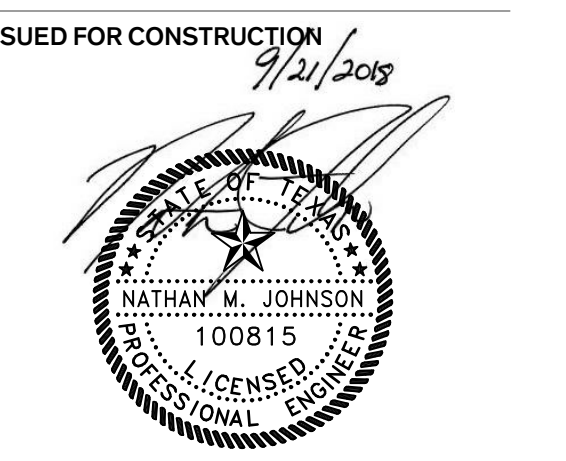

Architexas No. 1737 Date SEPT.21.2018  
 Sheet Name ENLARGED PLANS

Sheet Number **S2.06**


shaping the built environment

**JQ ENGINEERING, LLP**  
 100 SILAS STREET  
 DALLAS, TEXAS 75207  
 214.753.9098  
 PROJECT NO. 3170377

**JQ**



DALLAS, TEXAS 75207  
 JQENG.COM  
 TYPE FIRM F-1294



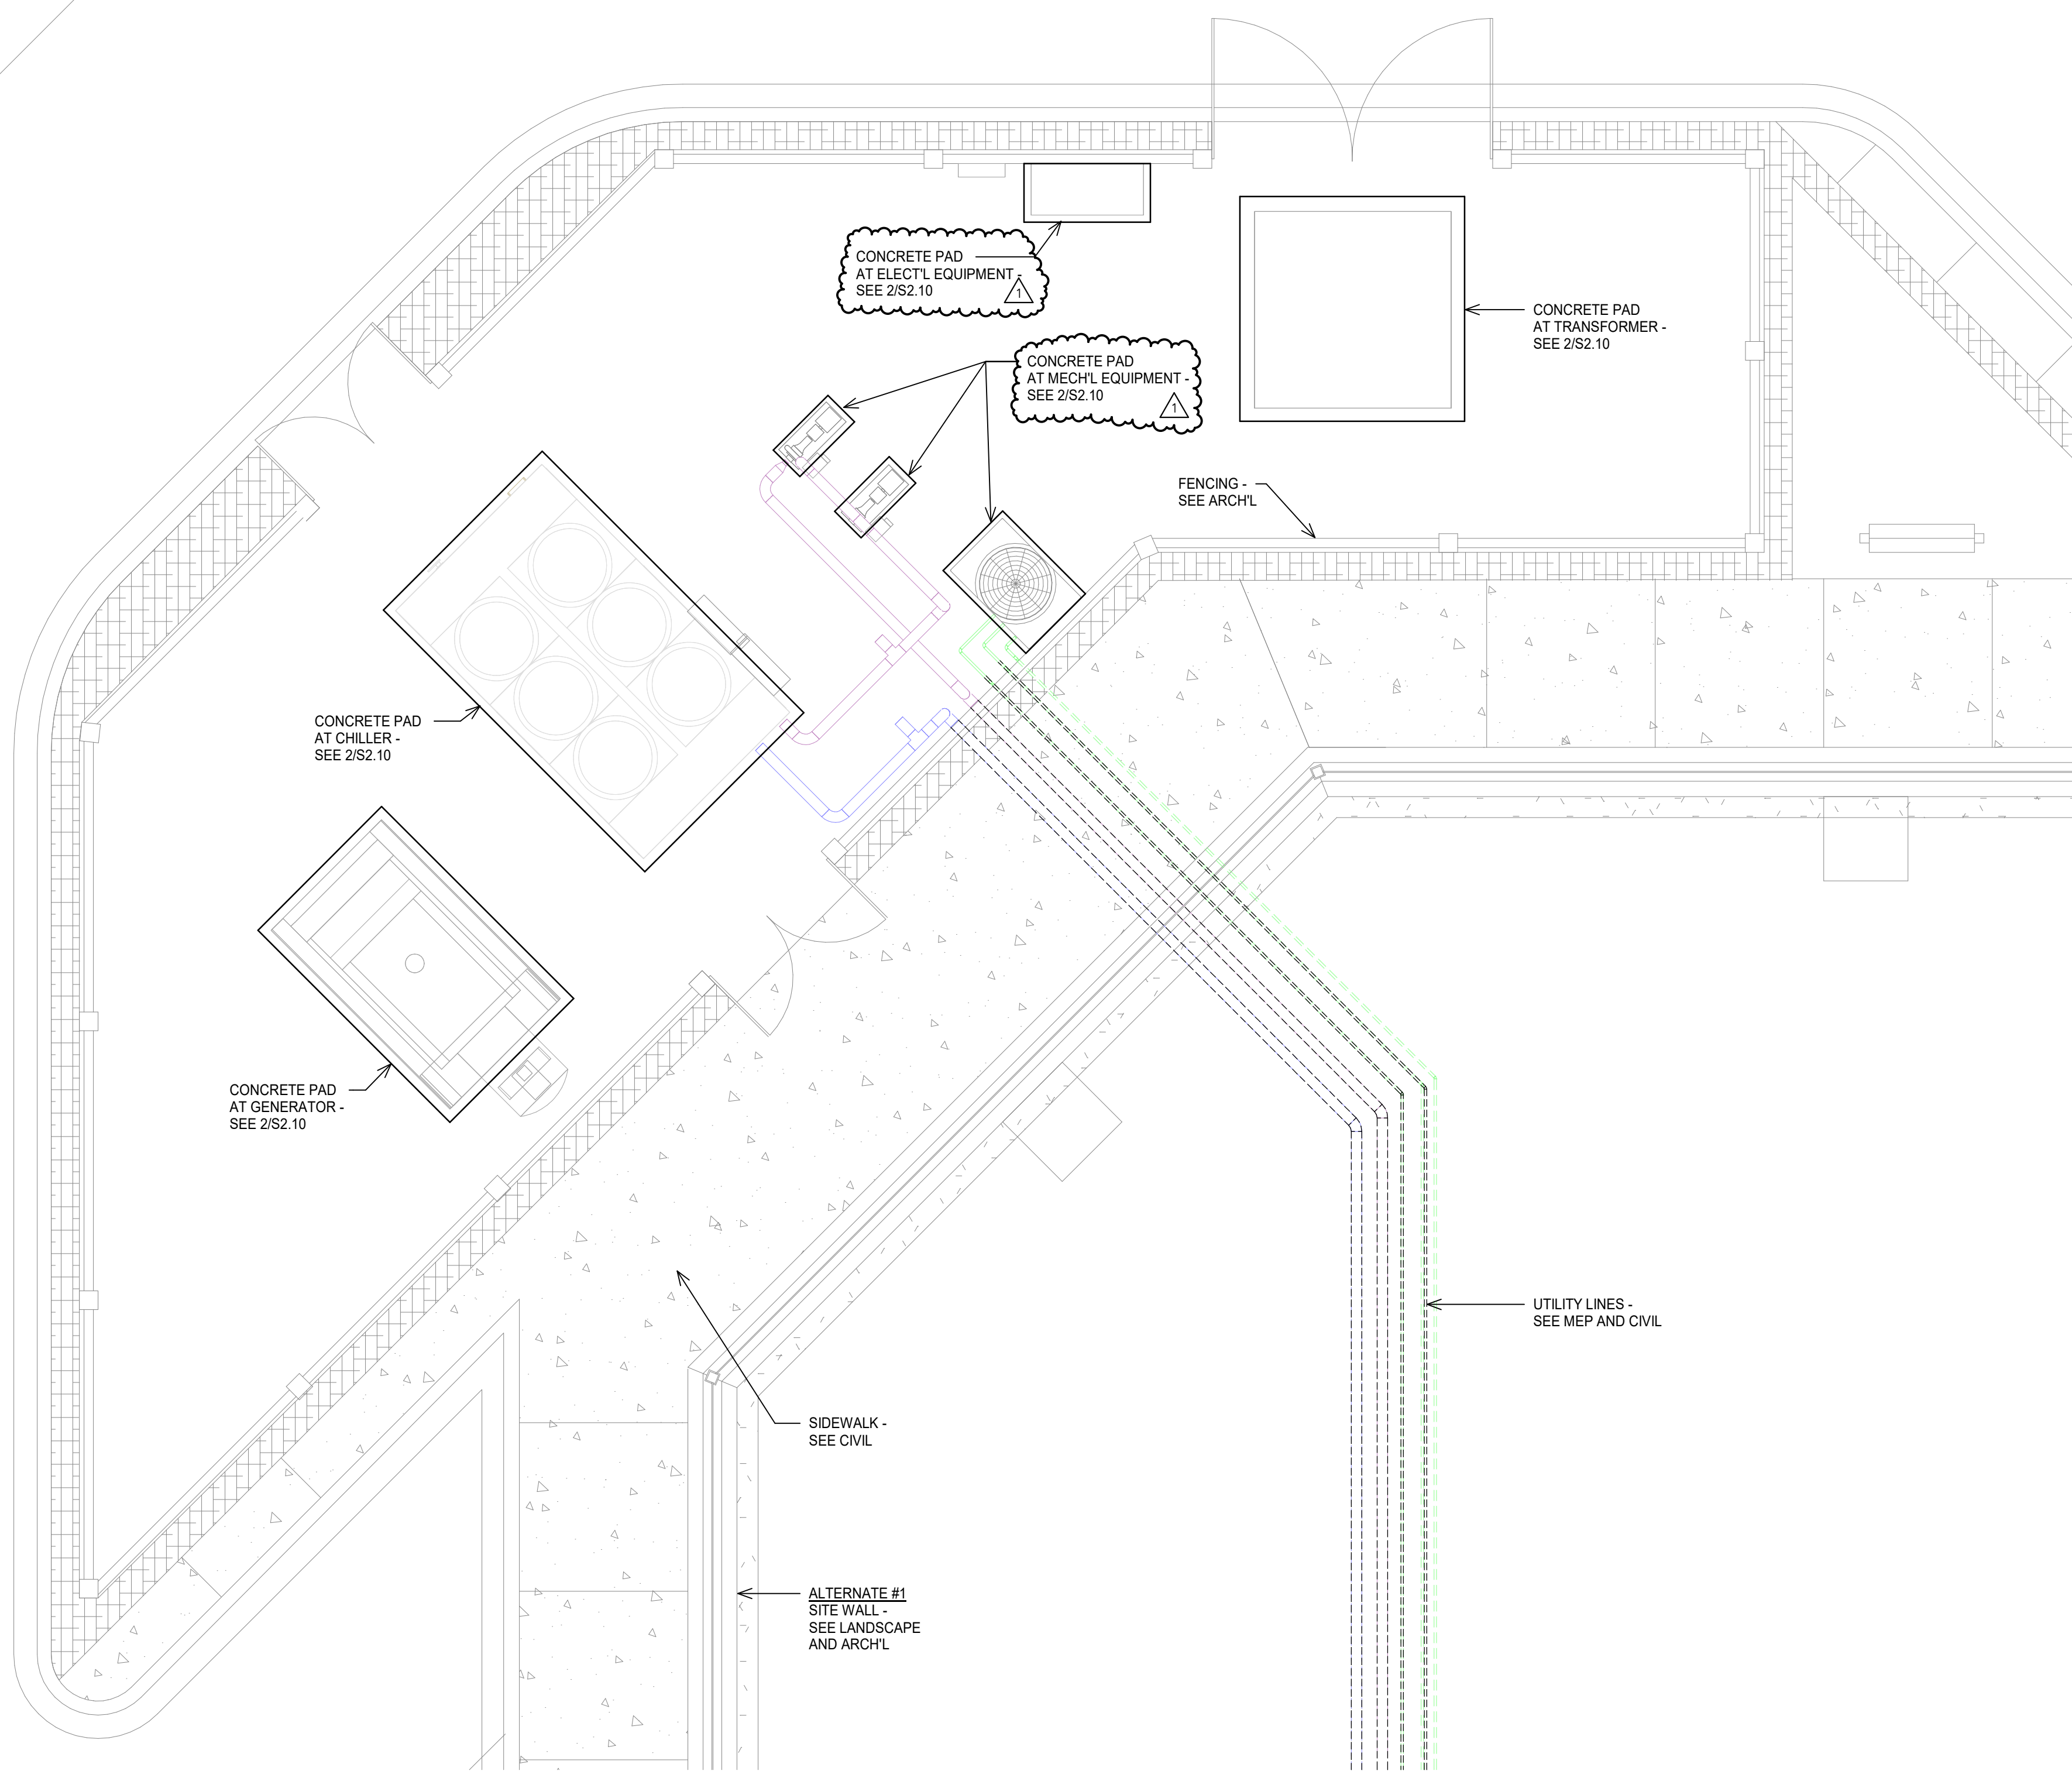

1 MECHANICAL YARD FOUNDATION PLAN

SCALE: 1/4" = 1'-0"

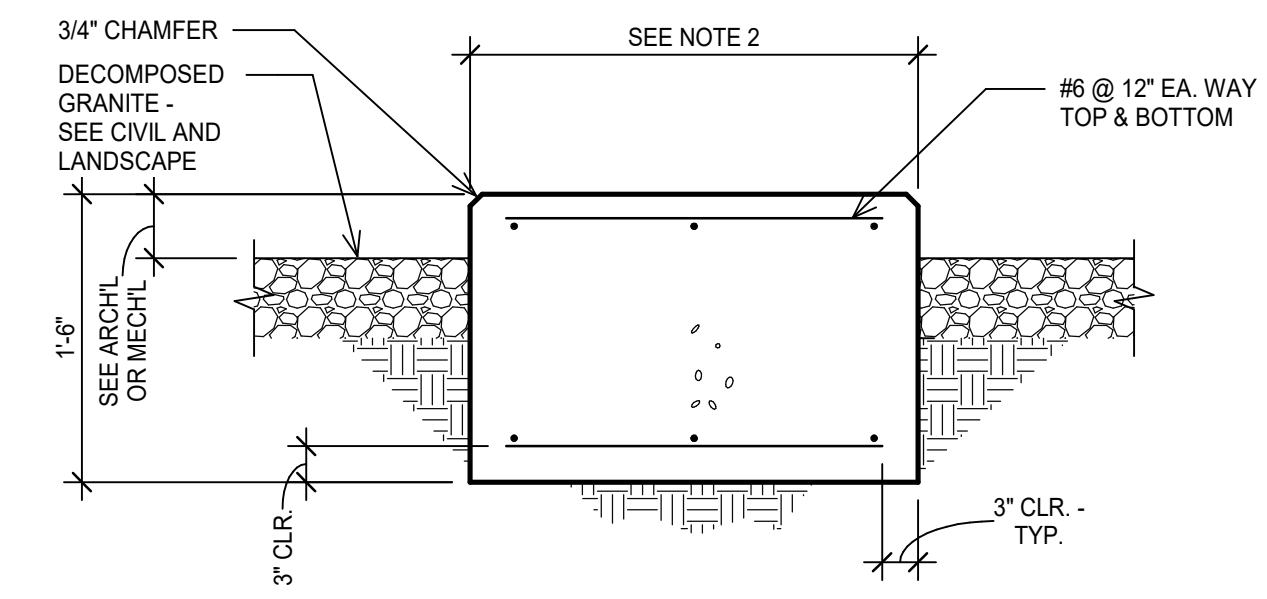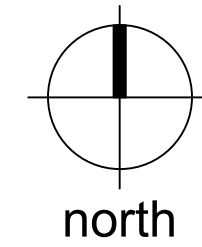

NOTES:

1. ISOLATION PADS TO BE PROVIDED WHERE NOTED ON THE MEP DRAWINGS.
2. COORDINATE MECHANICAL PAD SIZE, LOCATION AND EMBEDDED ITEMS WITH MEP DRAWINGS AND EQUIPMENT MANUFACTURER.

2 TYPICAL EQUIPMENT ISOLATION PAD DETAIL

NO SCALE



TEXAS HISTORICAL COMMISSION  
real places telling real stories




FANNIN COUNTY  
COURTHOUSE  
INTERIOR & EXTERIOR RESTORATION

101 E. Sam Rayburn Drive  
Bonham, Texas 75418

**COPYRIGHT**  
The Contractor shall verify and be responsible for all dimensions. DO NOT scale the drawing. Any errors or omissions shall be reported to Architexas without delay. The Copyrights to all designs and drawings are the property of Architexas. Reproduction or use for any purpose other than that authorized by Architexas is forbidden.

REVISION HISTORY	
1	10/16/18 ADDENDUM #1

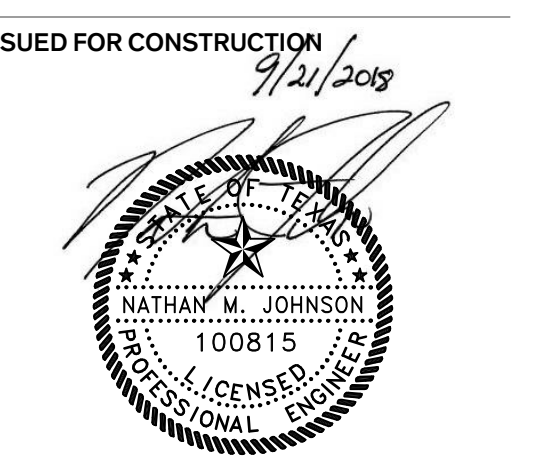

Architexas No. 1737 Date SEPT.21.2018

Sheet Name MECHANICAL YARD PLAN AND DETAILS

Sheet Number S2.10

shaping the built environment


**JQ ENGINEERING, LLP**  
100 SILAS STREET  
214.753.9098  
PROJECT NO. 3170377

DALLAS, TEXAS 75207  
JQENG.COM  
TBE FIRM # 1294



NOTES:


- HELICAL PILES SHALL BE DESIGNED BY ENGINEER LICENSED IN THE STATE OF TEXAS BASED ON GEOTECHNICAL REPORT FOR THIS PROJECT.
- G.C. SHALL COORDINATE ADEQUATE ACCESS FOR HELICAL PILE INSTALLATION WITH HELICAL PILE MFR.
- INCLUDE 4 HELICAL PILES AT ELEVATOR PIT SLAB.

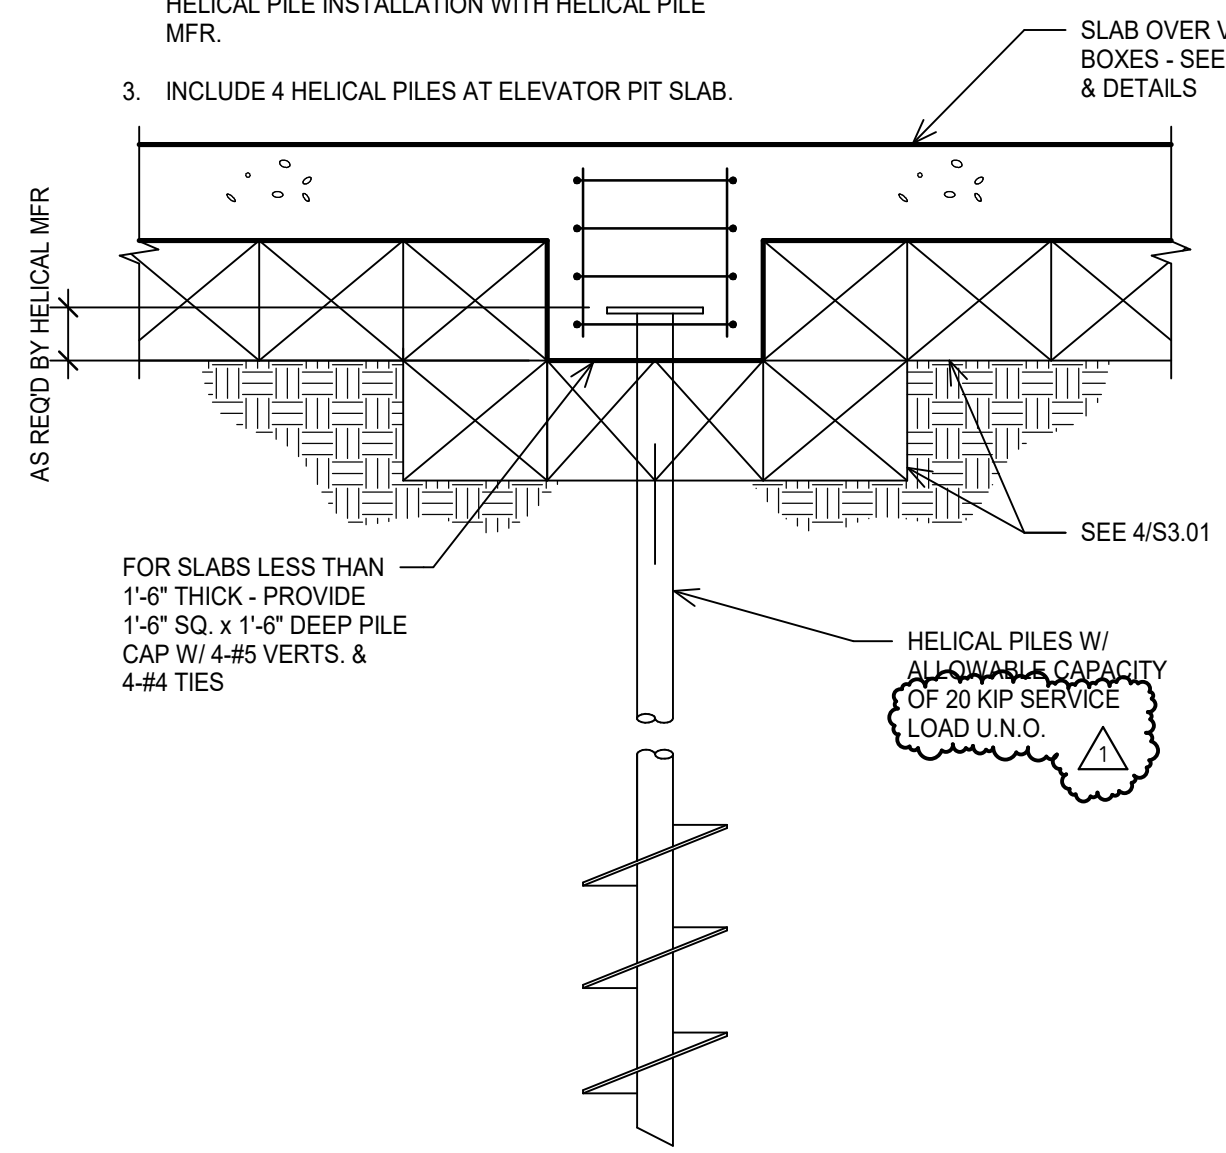


1 TYPICAL HELICAL PILE DETAIL  
NO SCALE

NOTES:


- MATCH SIZE, LOCATION AND NUMBER OF HORIZONTAL BEAM AND WALL BARS, EXCEPT THAT WHERE THERE ARE MORE THAN 2 TOP OR BOTTOM BARS, ONLY THE INSIDE AND OUTSIDE BARS MUST BE MATCHED.
- WHERE 90 DEGREE HOOKS ARE PROVIDED FOR TOP BARS CORNER BARS MAY BE OMITTED AT TOP, WHERE 90 DEGREE HOOKS ARE PROVIDED FOR BOTTOM BARS, CORNER BARS MAY BE OMITTED AT BOTTOM.

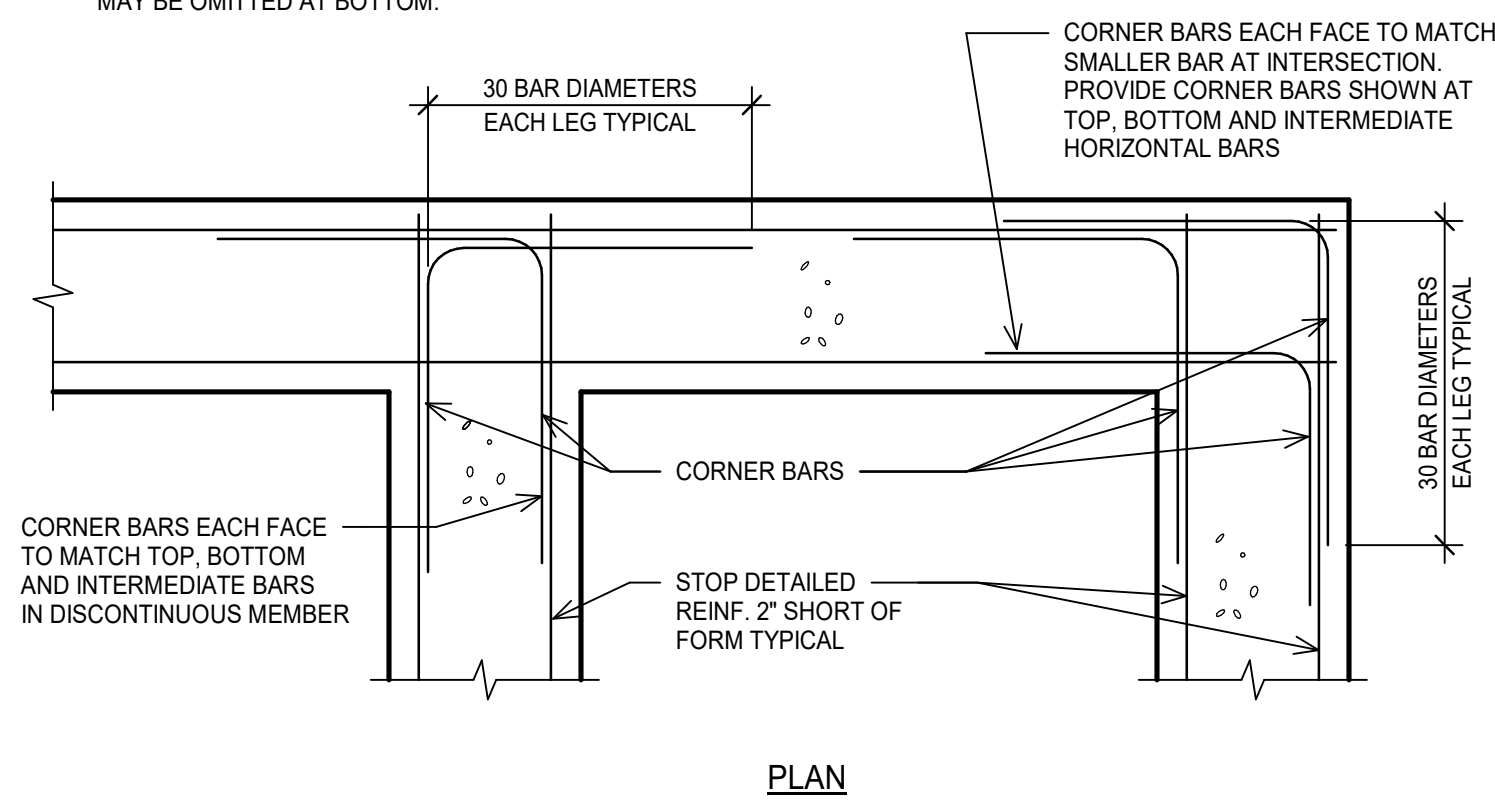


2 TYPICAL CORNER BARS AT WALL OR GRADE BEAM INTERSECTION DETAIL  
NO SCALE

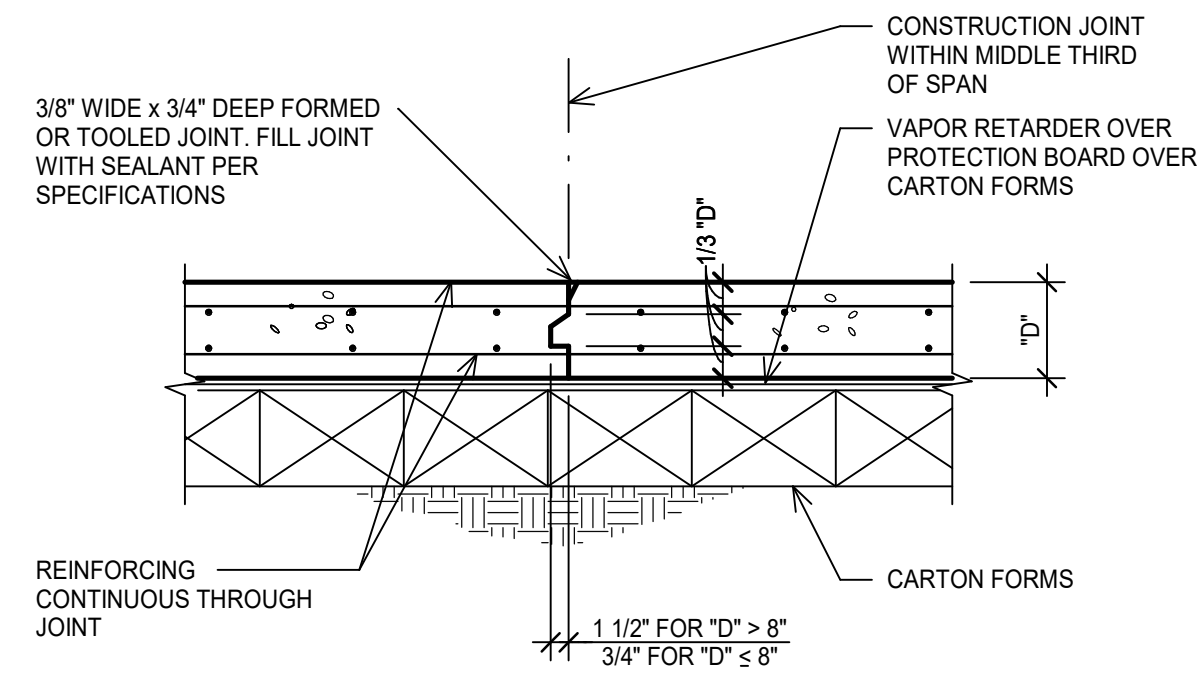


3 TYPICAL STRUCTURAL SLAB CONSTRUCTION JOINT DETAIL  
NO SCALE

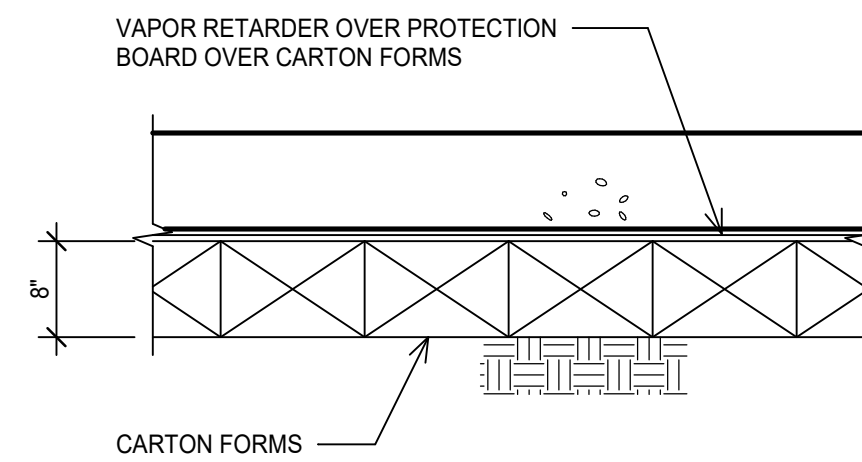


4 TYPICAL SLAB-ON-VOID DETAIL  
NO SCALE

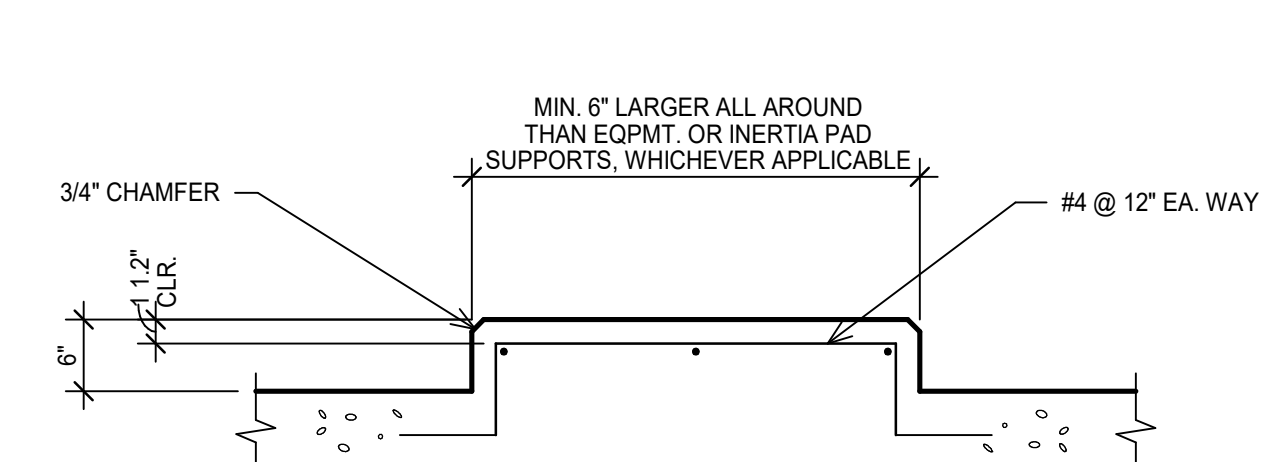


5 TYPICAL MECHANICAL PAD @ NEW SLAB DETAIL  
NO SCALE

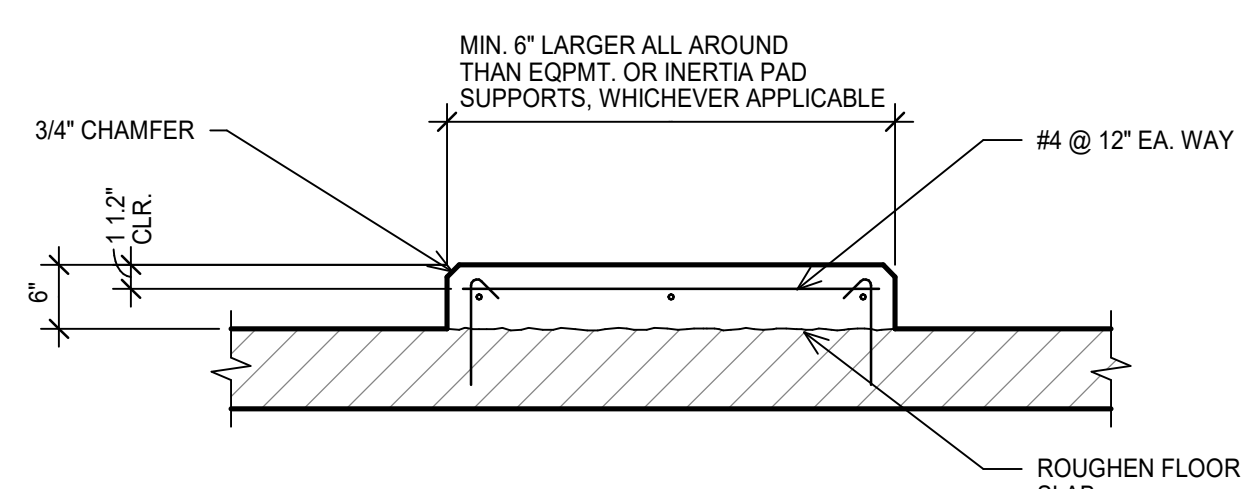


6 TYPICAL MECHANICAL PAD @ EXIST. SLAB DETAIL  
NO SCALE

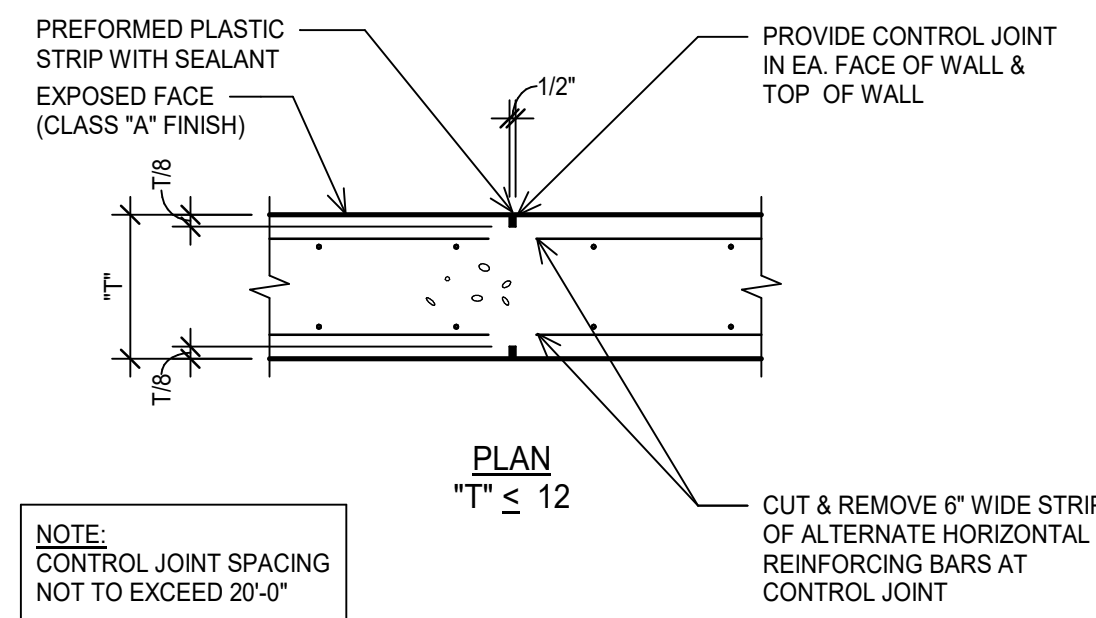


7 TYPICAL RAMP WALL CONTROL JOINT DETAIL  
NO SCALE

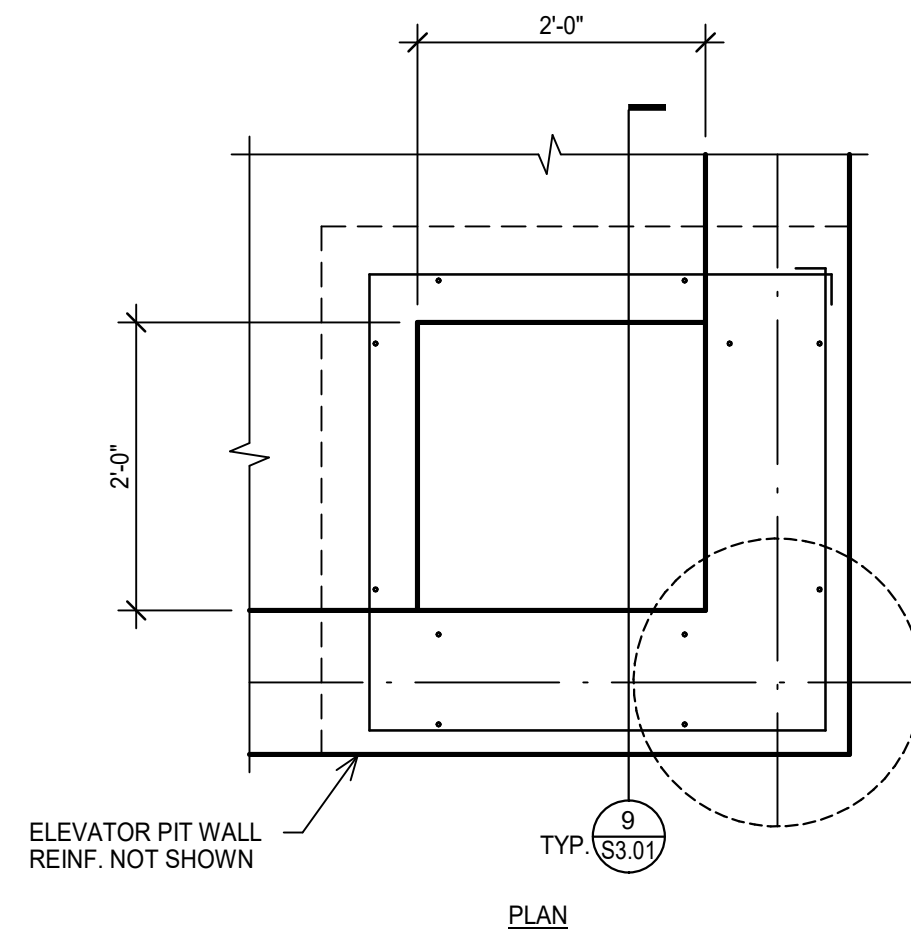

8 TYPICAL ELEVATOR SUMP PIT DETAIL  
NO SCALE

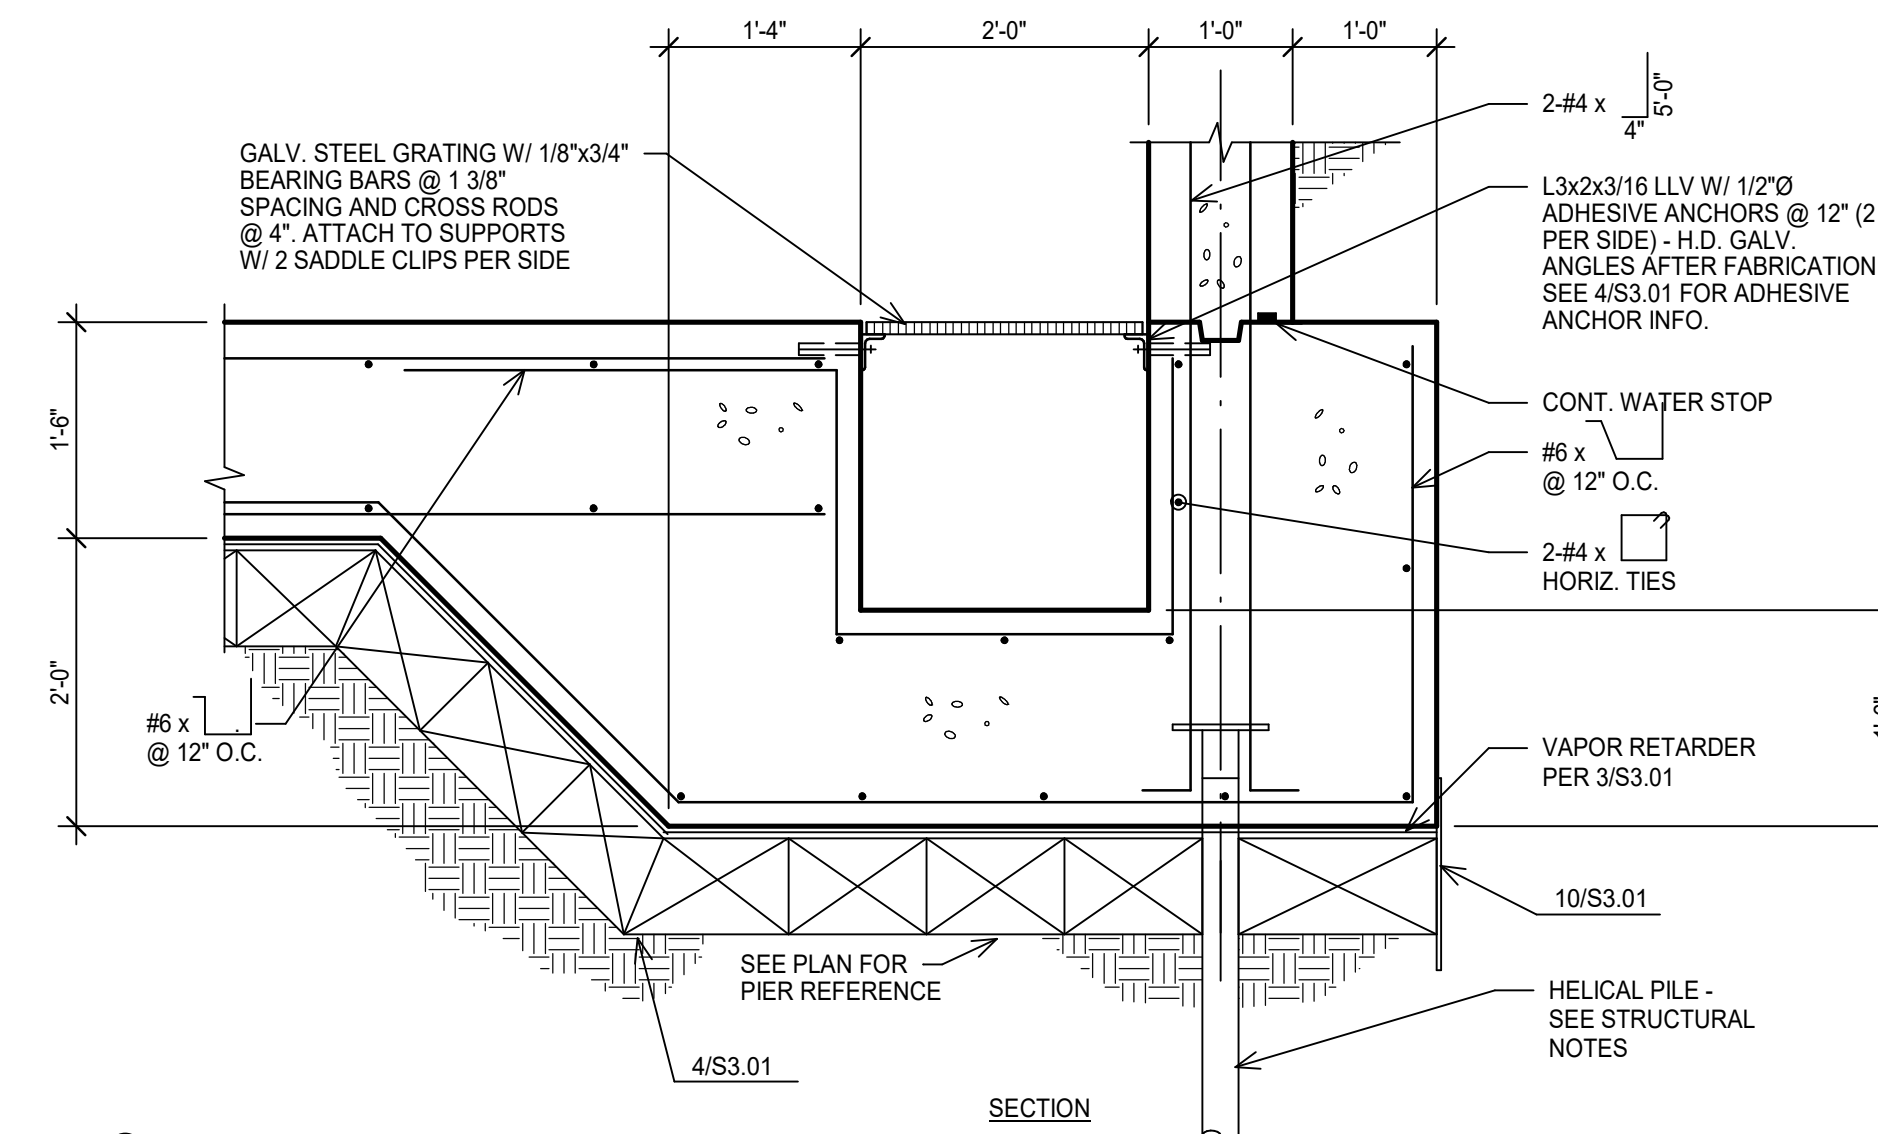


9 TYPICAL ELEVATOR SUMP PIT DETAIL  
NO SCALE

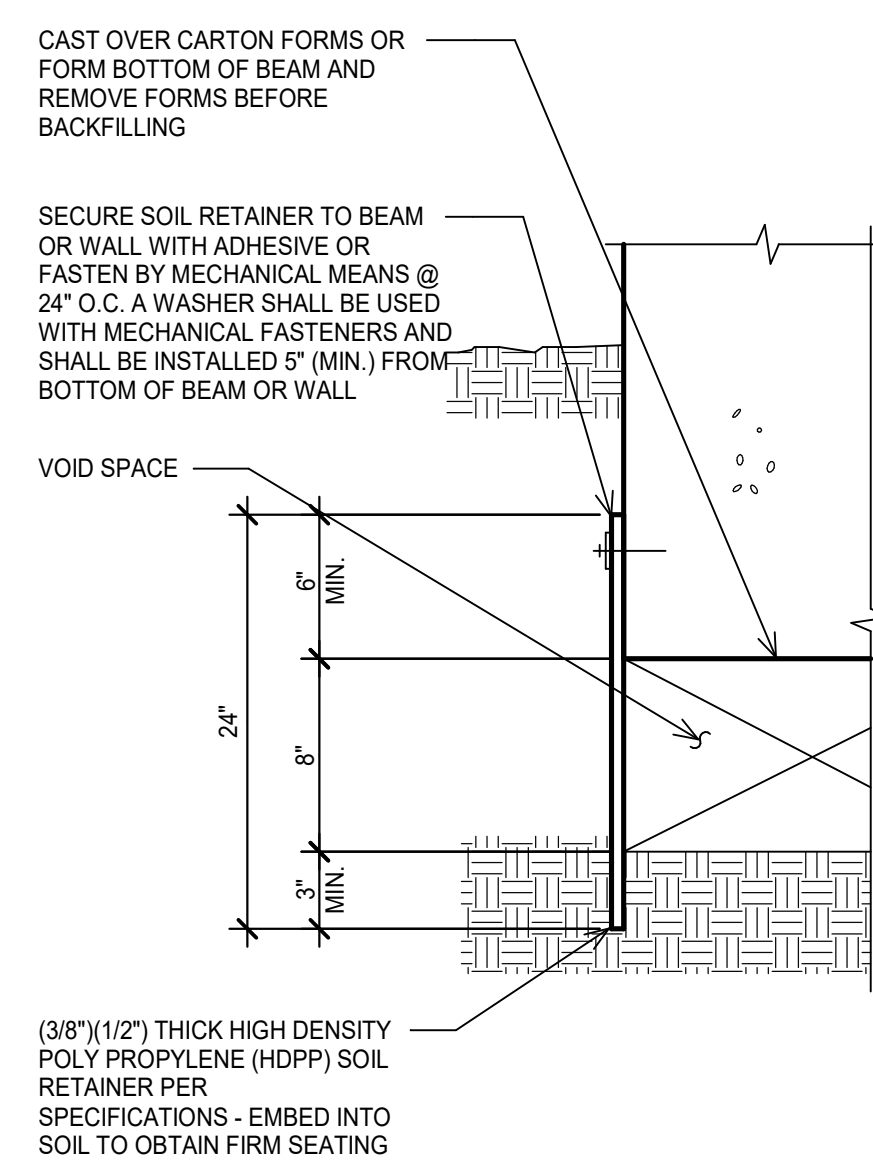

10 TYPICAL HDPP SOIL RETAINER DETAIL  
NO SCALE

NOTES:

- FORM ALL SIDES OF ALL BELOW GRADE BEAMS, WALLS, PILASTERS, AND PIER CAPS. EARTH FORMING IS NOT PERMITTED.
- PLACE SOIL RETAINERS AT SIDES OF VOID SPACE UNDER ALL STRUCTURAL CONCRETE PIER CAPS, PILASTERS, GRADE BEAMS, AND WALLS BELOW GRADE.
- INSTALL SOIL RETAINERS IN STRICT ACCORDANCE WITH MANUFACTURER'S RECOMMENDATIONS AND AS FOLLOWS:
  - PLACE BASE OF SOIL RETAINER IN A 3" DEEP TRENCH CUT IN UNDISTURBED SOIL OR COMPACTED FILL.
  - STARTING AT END OF BEAM OR WALL PANEL LAY SOIL RETAINER IN TRENCH AND PLACE VERTICAL AGAINST BEAM OR WALL PANEL. OVERLAP ENDS OF ADJACENT SOIL RETAINERS 6" MIN. & SECURE TO BEAM OR WALL THROUGH OVERLAP.
  - CUT TO FIT ENDS OF BEAMS OR WALL PANELS. CUT LENGTHS LESS THAN 1'-0" IN LENGTH SHALL NOT BE USED.
  - PLACE BACKFILL AS SPECIFIED AFTER COMPLETION OF SOIL RETAINER INSTALLATION. TAKE NECESSARY PRECAUTIONS TO PROTECT SOIL RETAINERS FROM DAMAGE FROM COMPACTION EQUIPMENT.
- STORE RETAINERS FLAT AND PROTECTED FROM DIRECT SUNLIGHT TO AVOID WARPAGE.

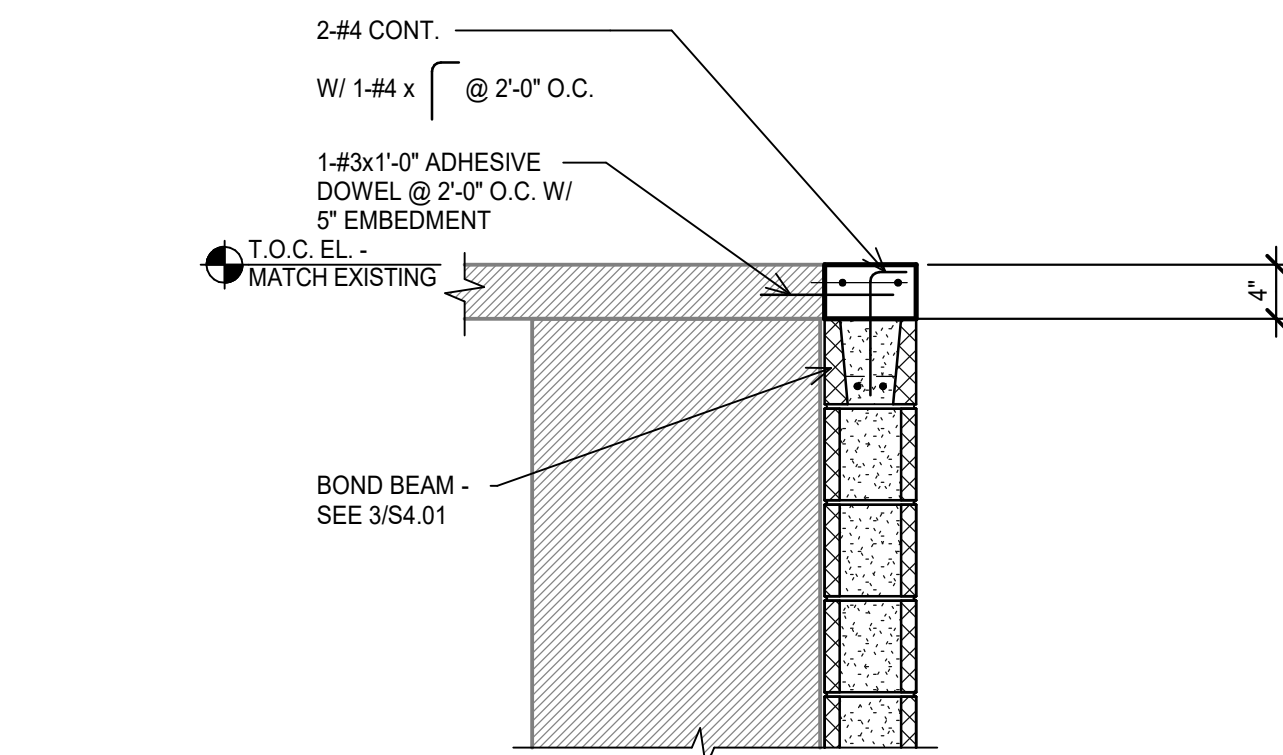

11 SECTION  
SCALE: 3/4" = 1'-0"




FANNIN COUNTY COURTHOUSE INTERIOR & EXTERIOR RESTORATION

101 E. Sam Rayburn Drive Bonham, Texas 75418

**COPYRIGHT**  
The Contractor shall verify and be responsible for all dimensions. DO NOT scale the drawing. Any errors or omissions shall be reported to Architexas without delay. The Copyrights to all designs and drawings are the property of Architexas. Reproduction or use for any purpose other than that authorized by Architexas is forbidden.

**REVISION HISTORY**


NO.	DATE	ADDENDUM #1
1	10/16/18	

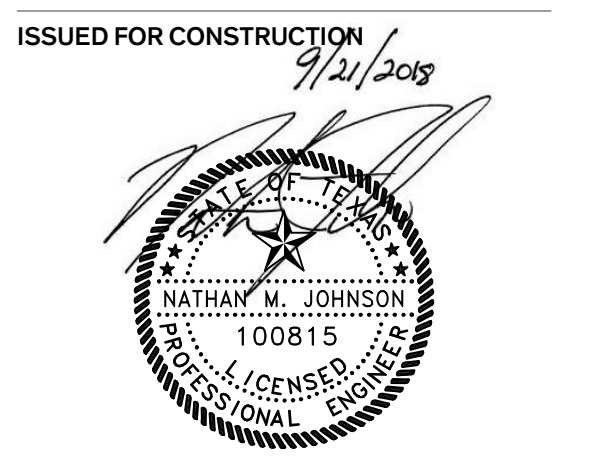

Architexas No. 1737 Date SEPT.21.2018


Sheet Name TYPICAL CONCRETE SECTIONS & DETAILS

Sheet Number S3.01

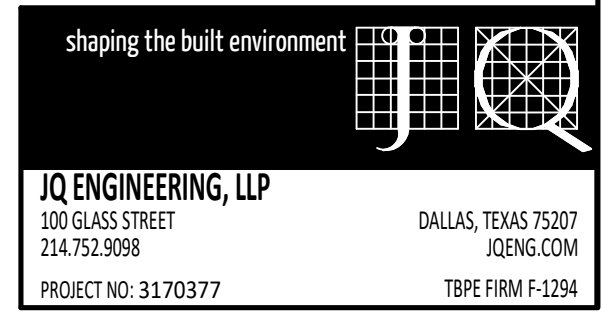


JQ ENGINEERING, LLC  
100 SILAS STREET  
DALLAS, TEXAS 75201  
214.753.9098  
PROJECT NO. 3170377



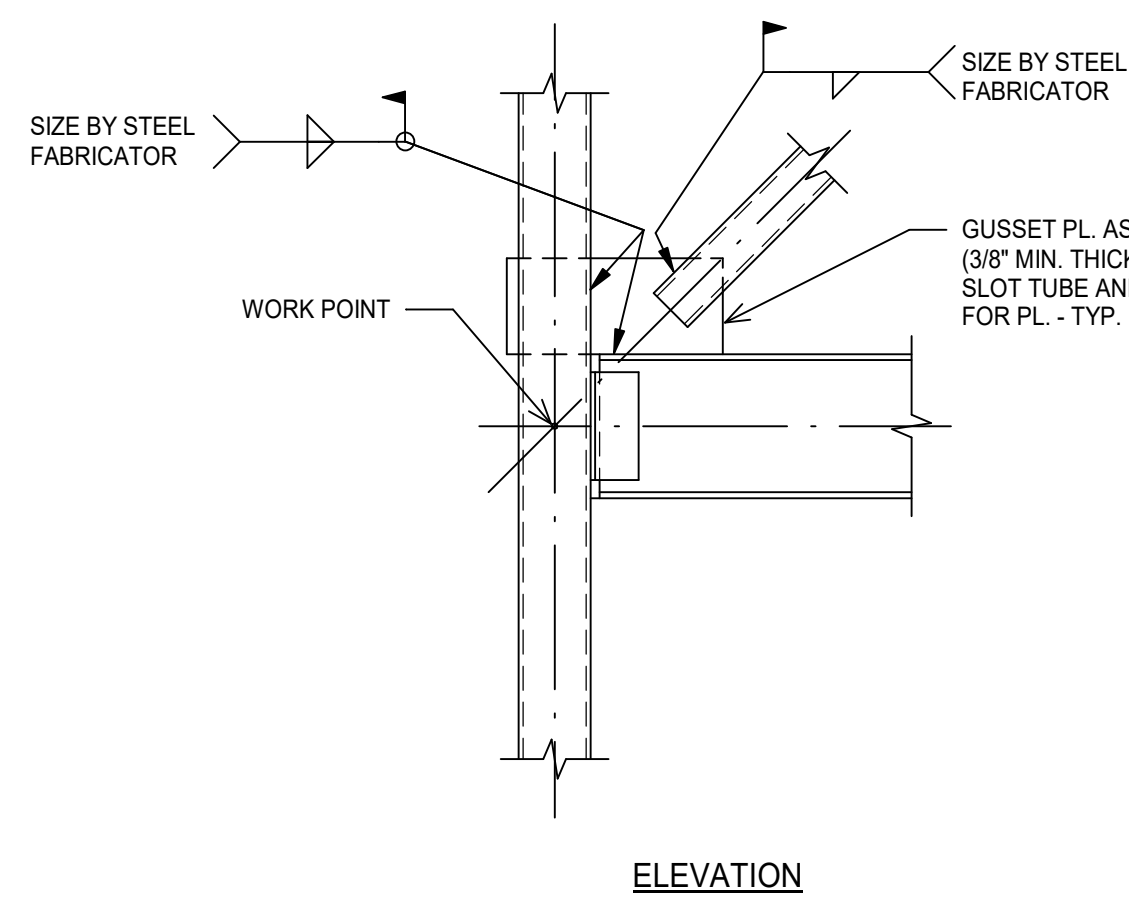


NOTE:  
1. SEE BRACE ELEVATIONS AND STRUCTURAL NOTES FOR FORCES AND CONNECTION DESIGN CRITERIA.

1 TYPICAL BRACE CONNECTION DETAIL  
NO SCALE


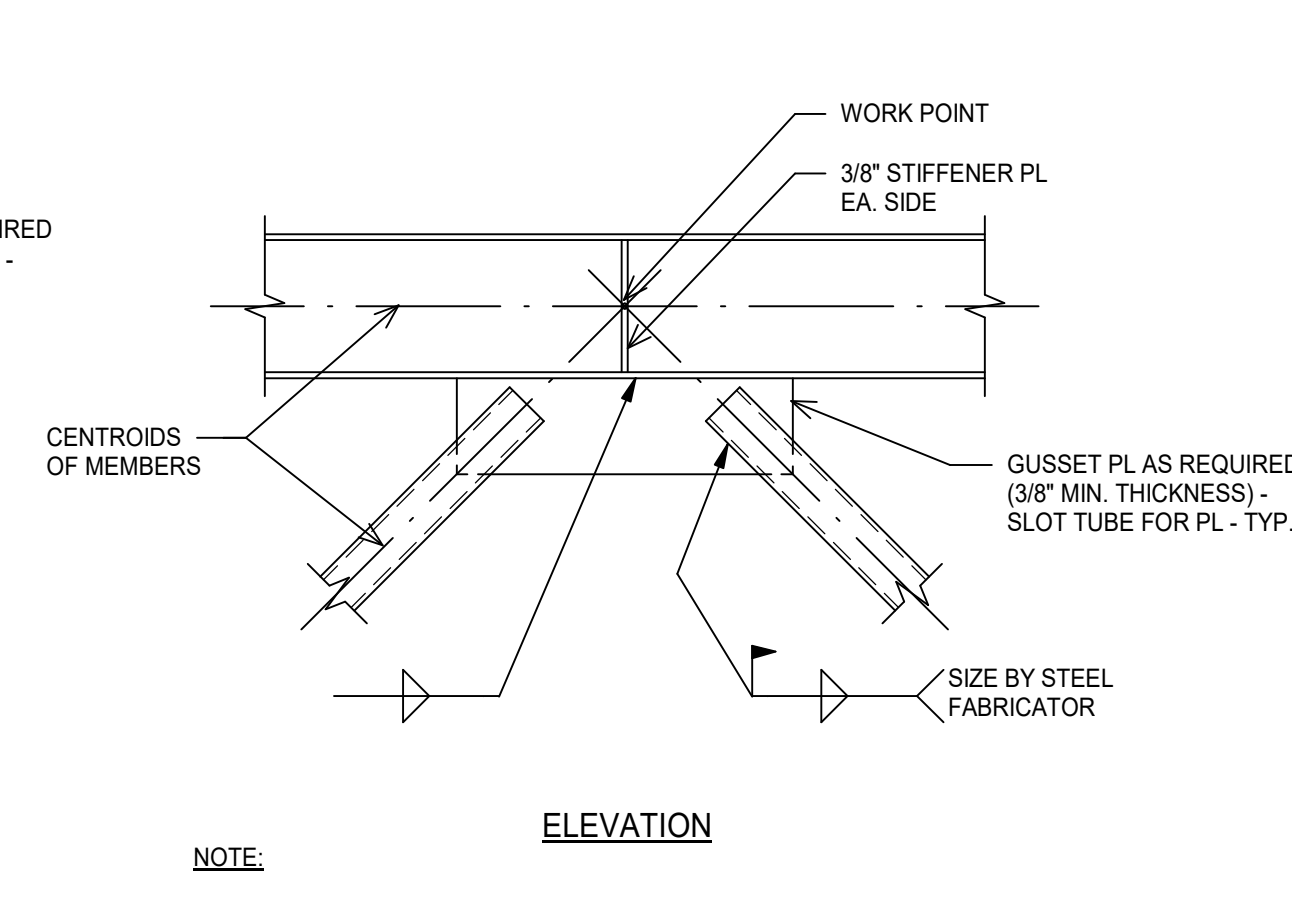


NOTE:  
1. SEE BRACE ELEVATIONS AND STRUCTURAL NOTES FOR FORCES AND CONNECTION DESIGN CRITERIA.


2 TYPICAL BRACE CONNECTION DETAIL  
NO SCALE

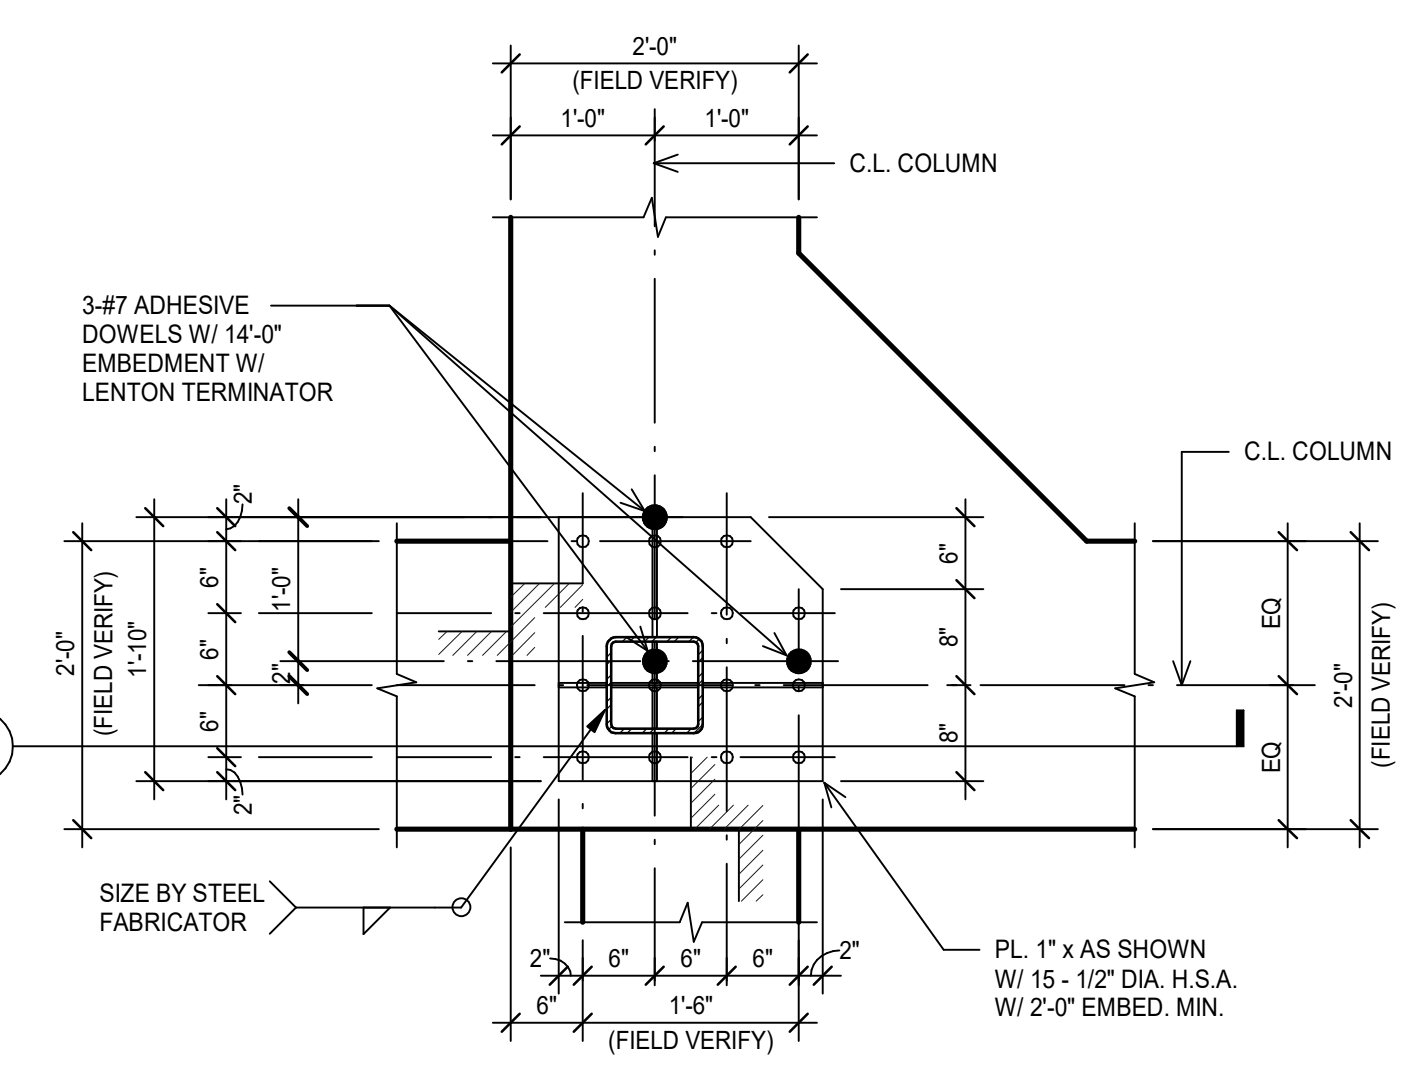


3 BRACE CONNECTION DETAIL  
SCALE: 3/4" = 1'-0"

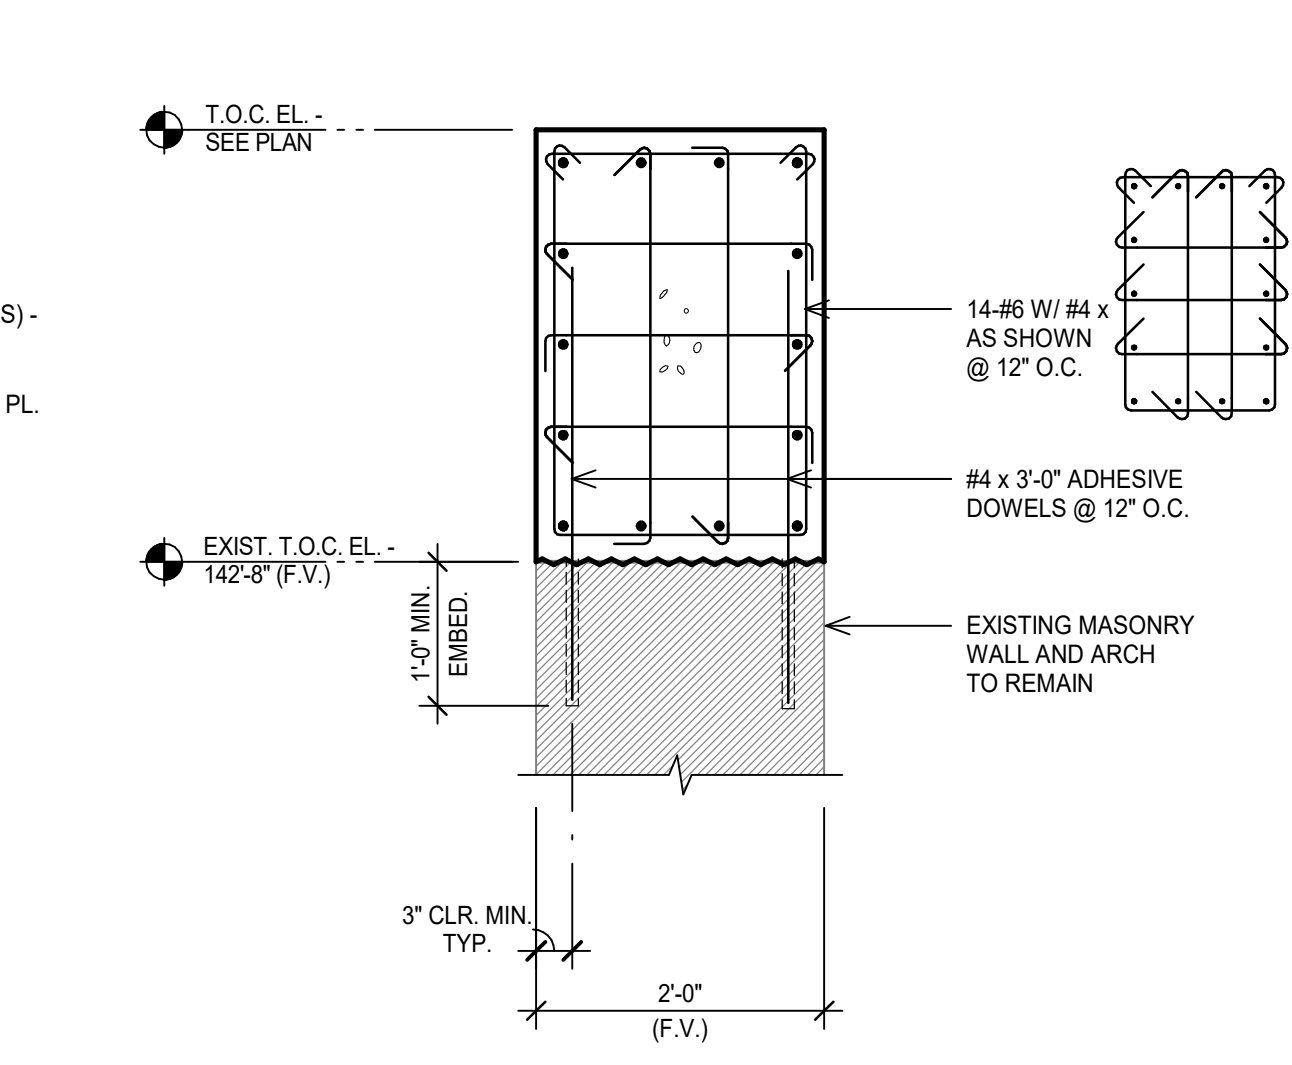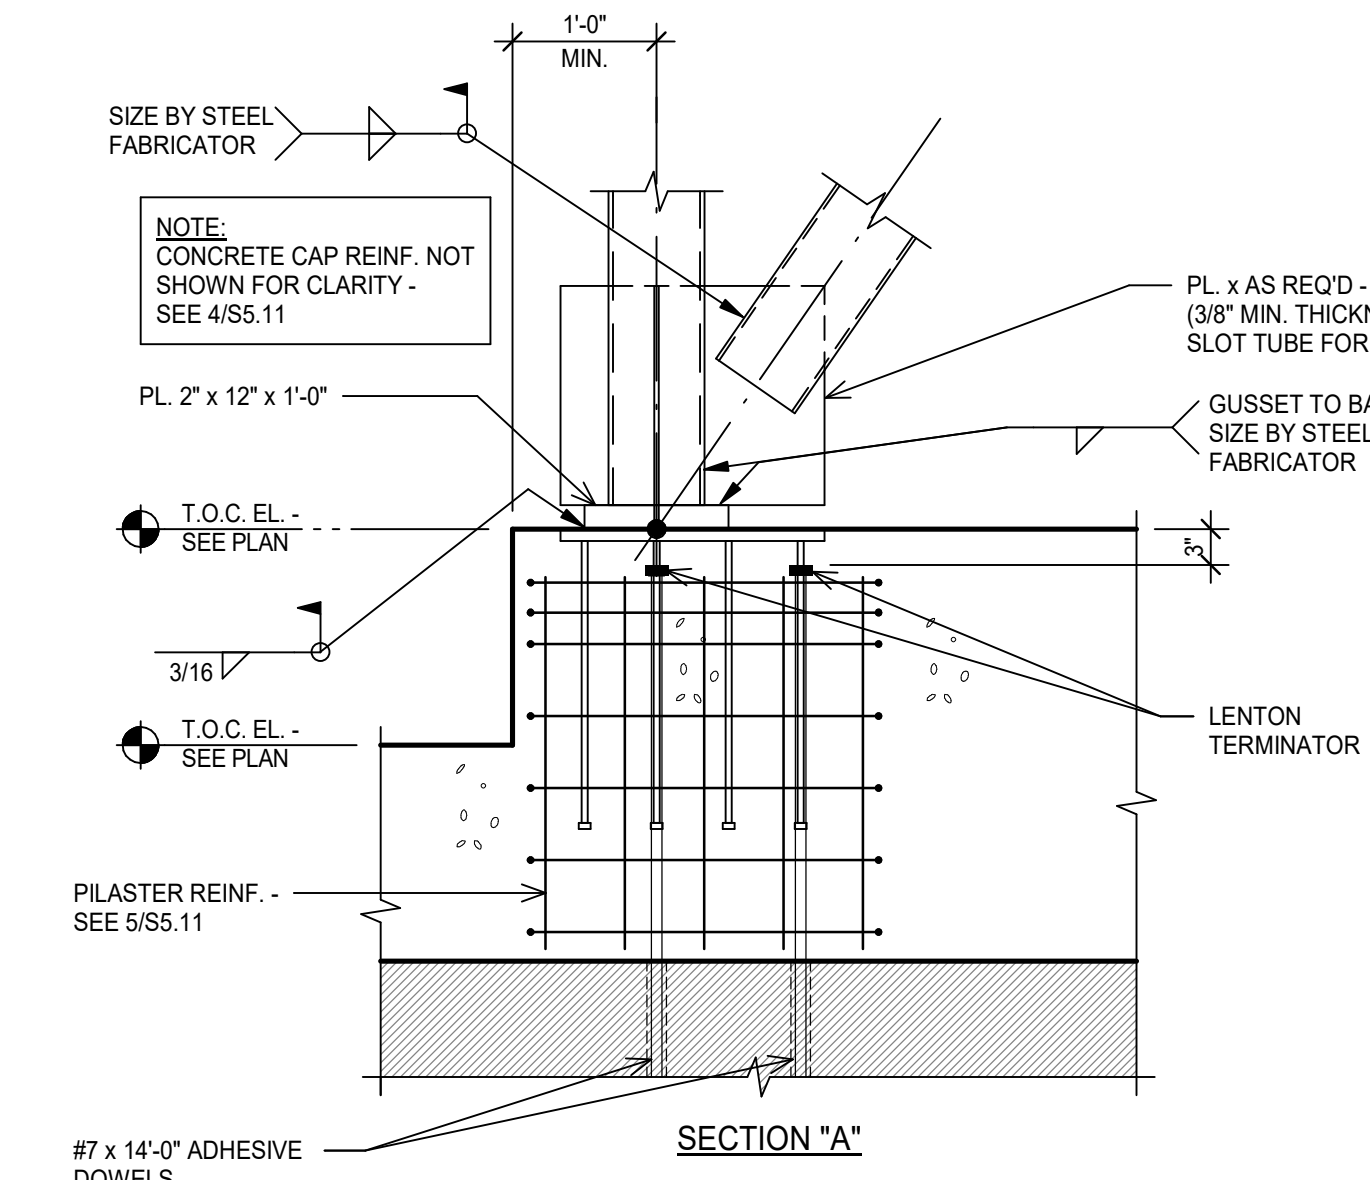




4 CONCRETE CAP SECTION  
SCALE: 3/4" = 1'-0"

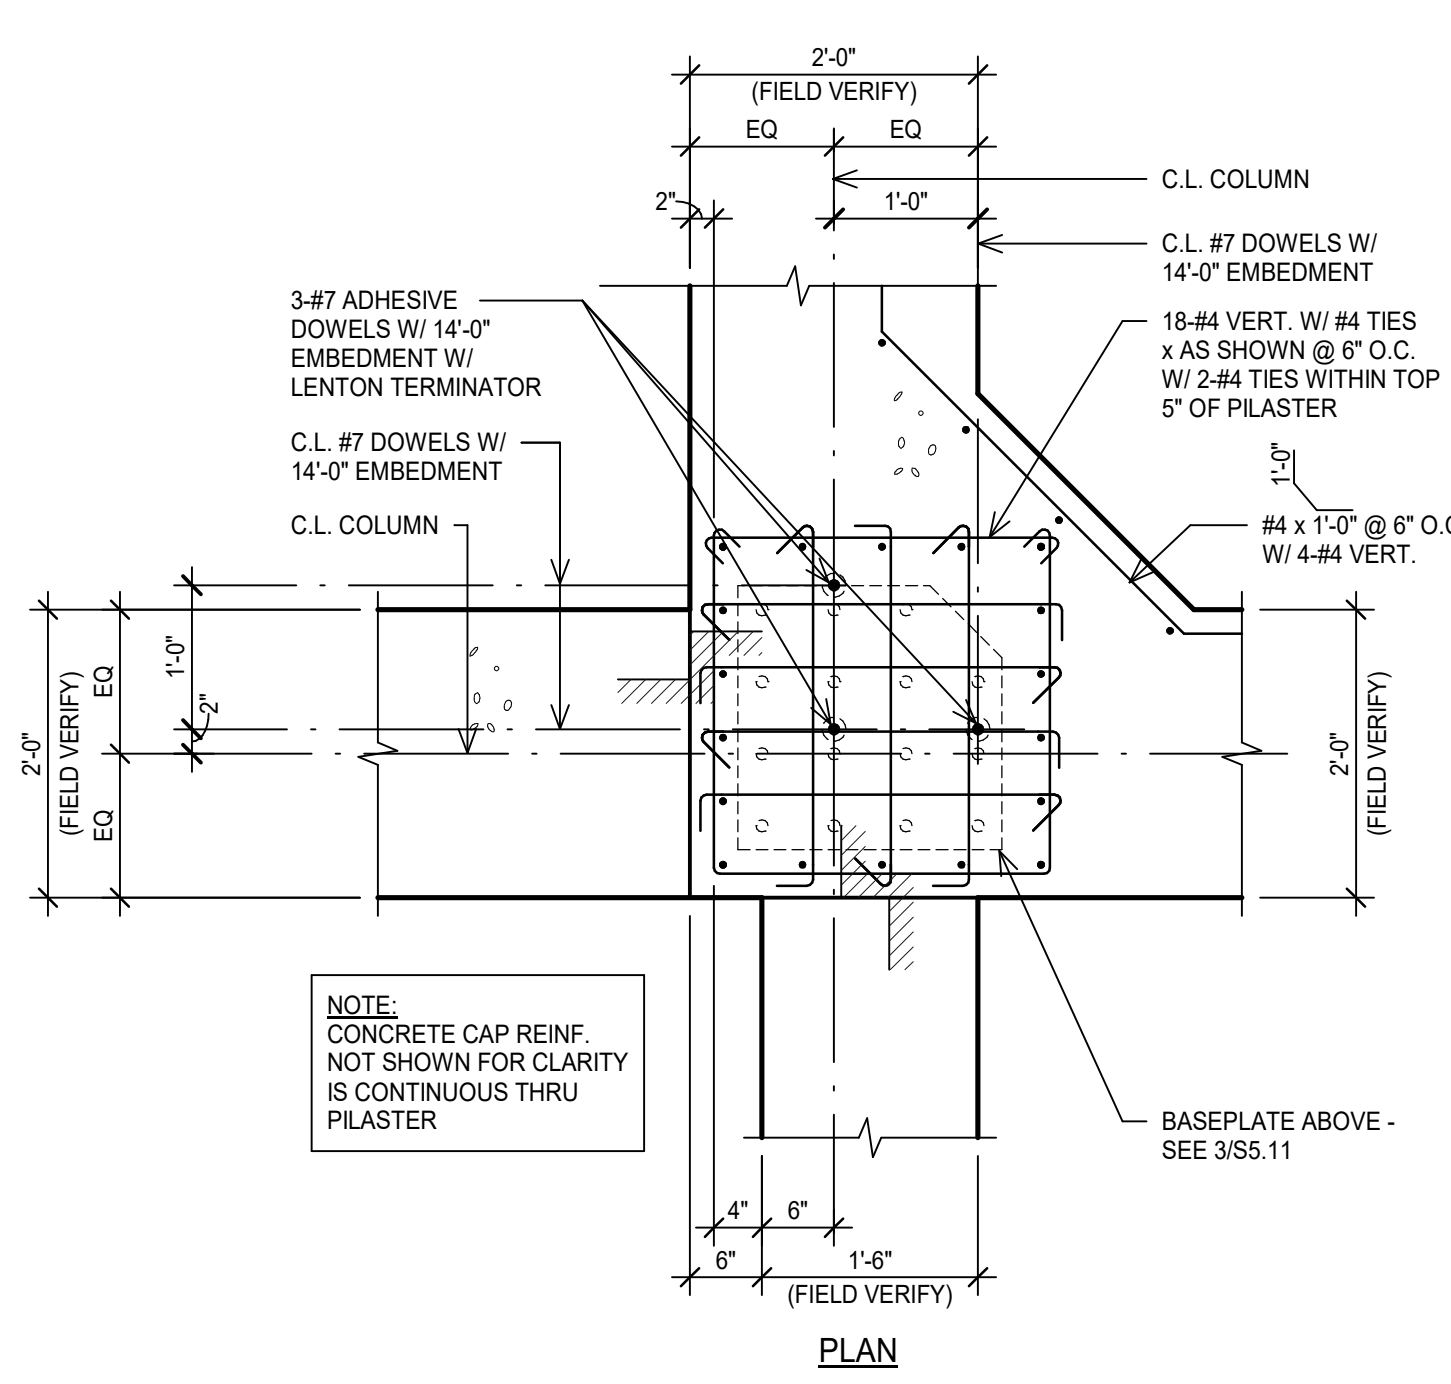


5 PILASTER SECTION  
SCALE: 3/4" = 1'-0"

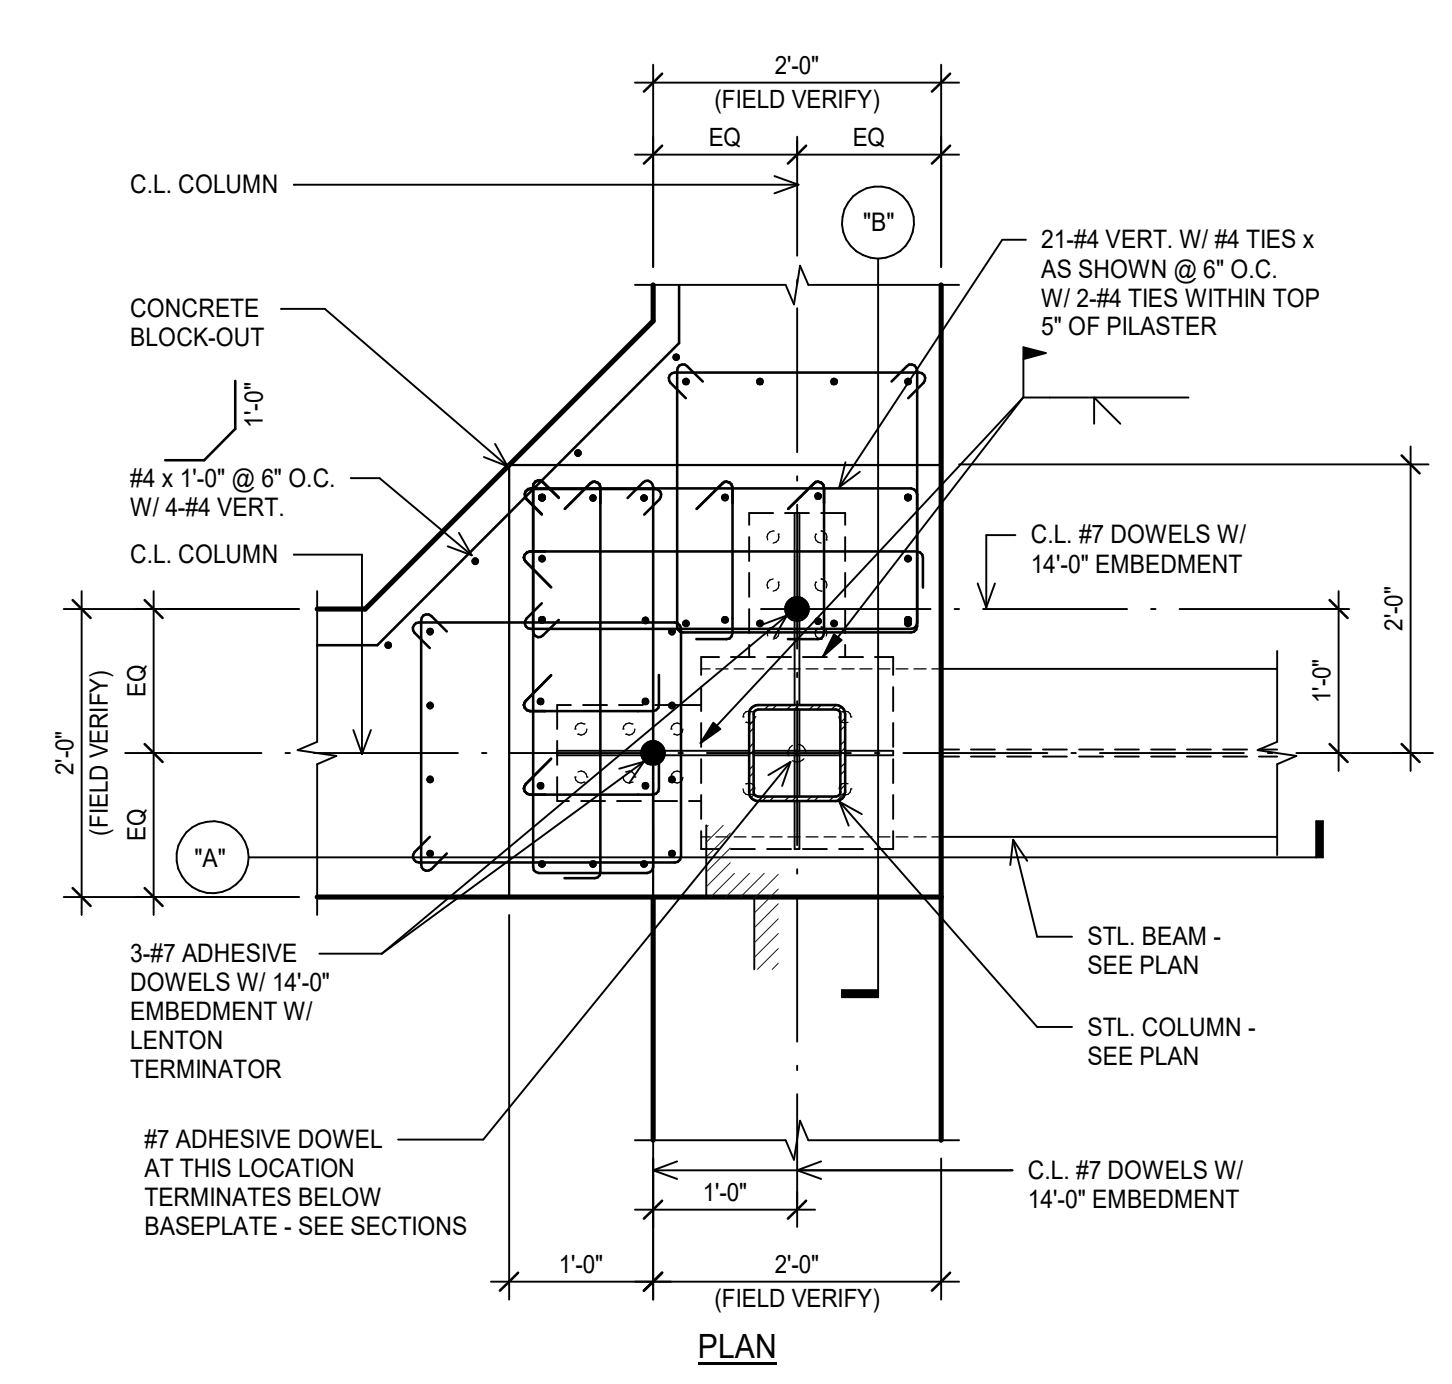

6 BRACE SECTION  
SCALE: 3/4" = 1'-0"

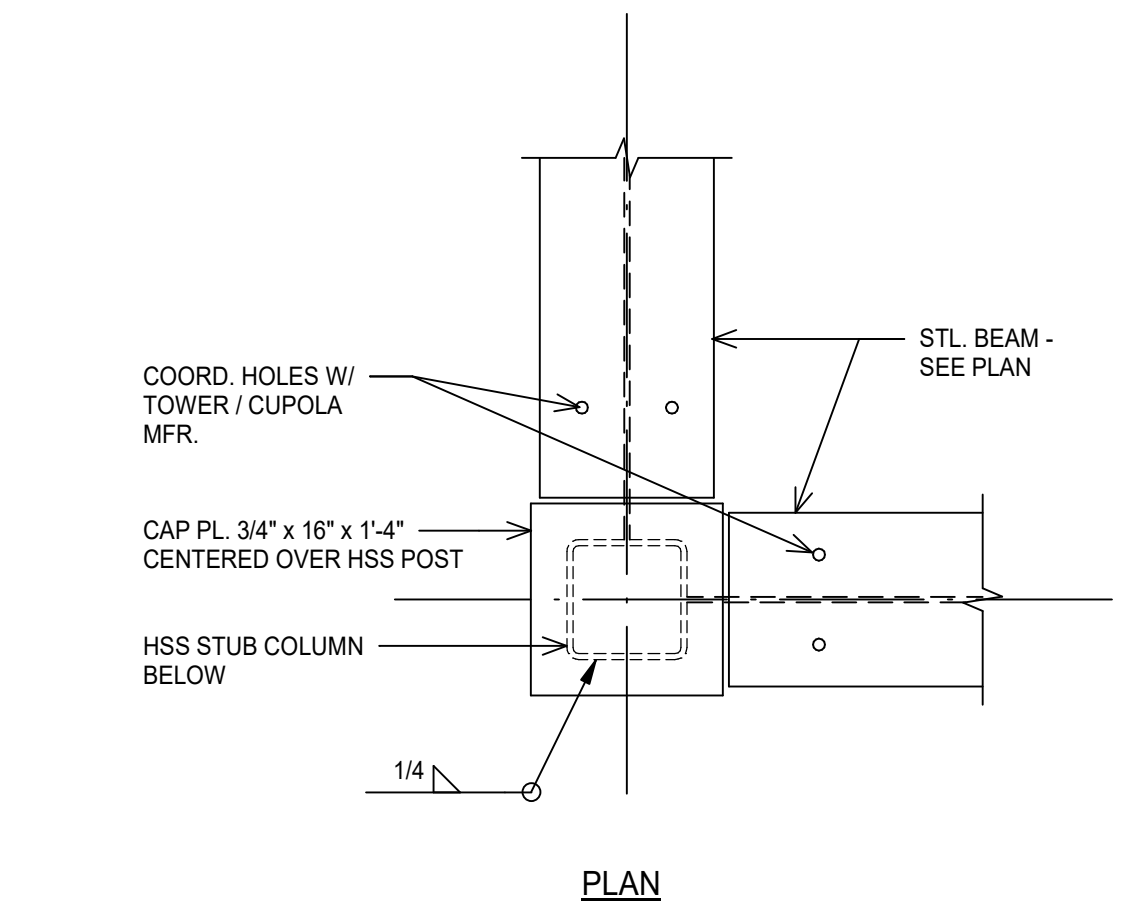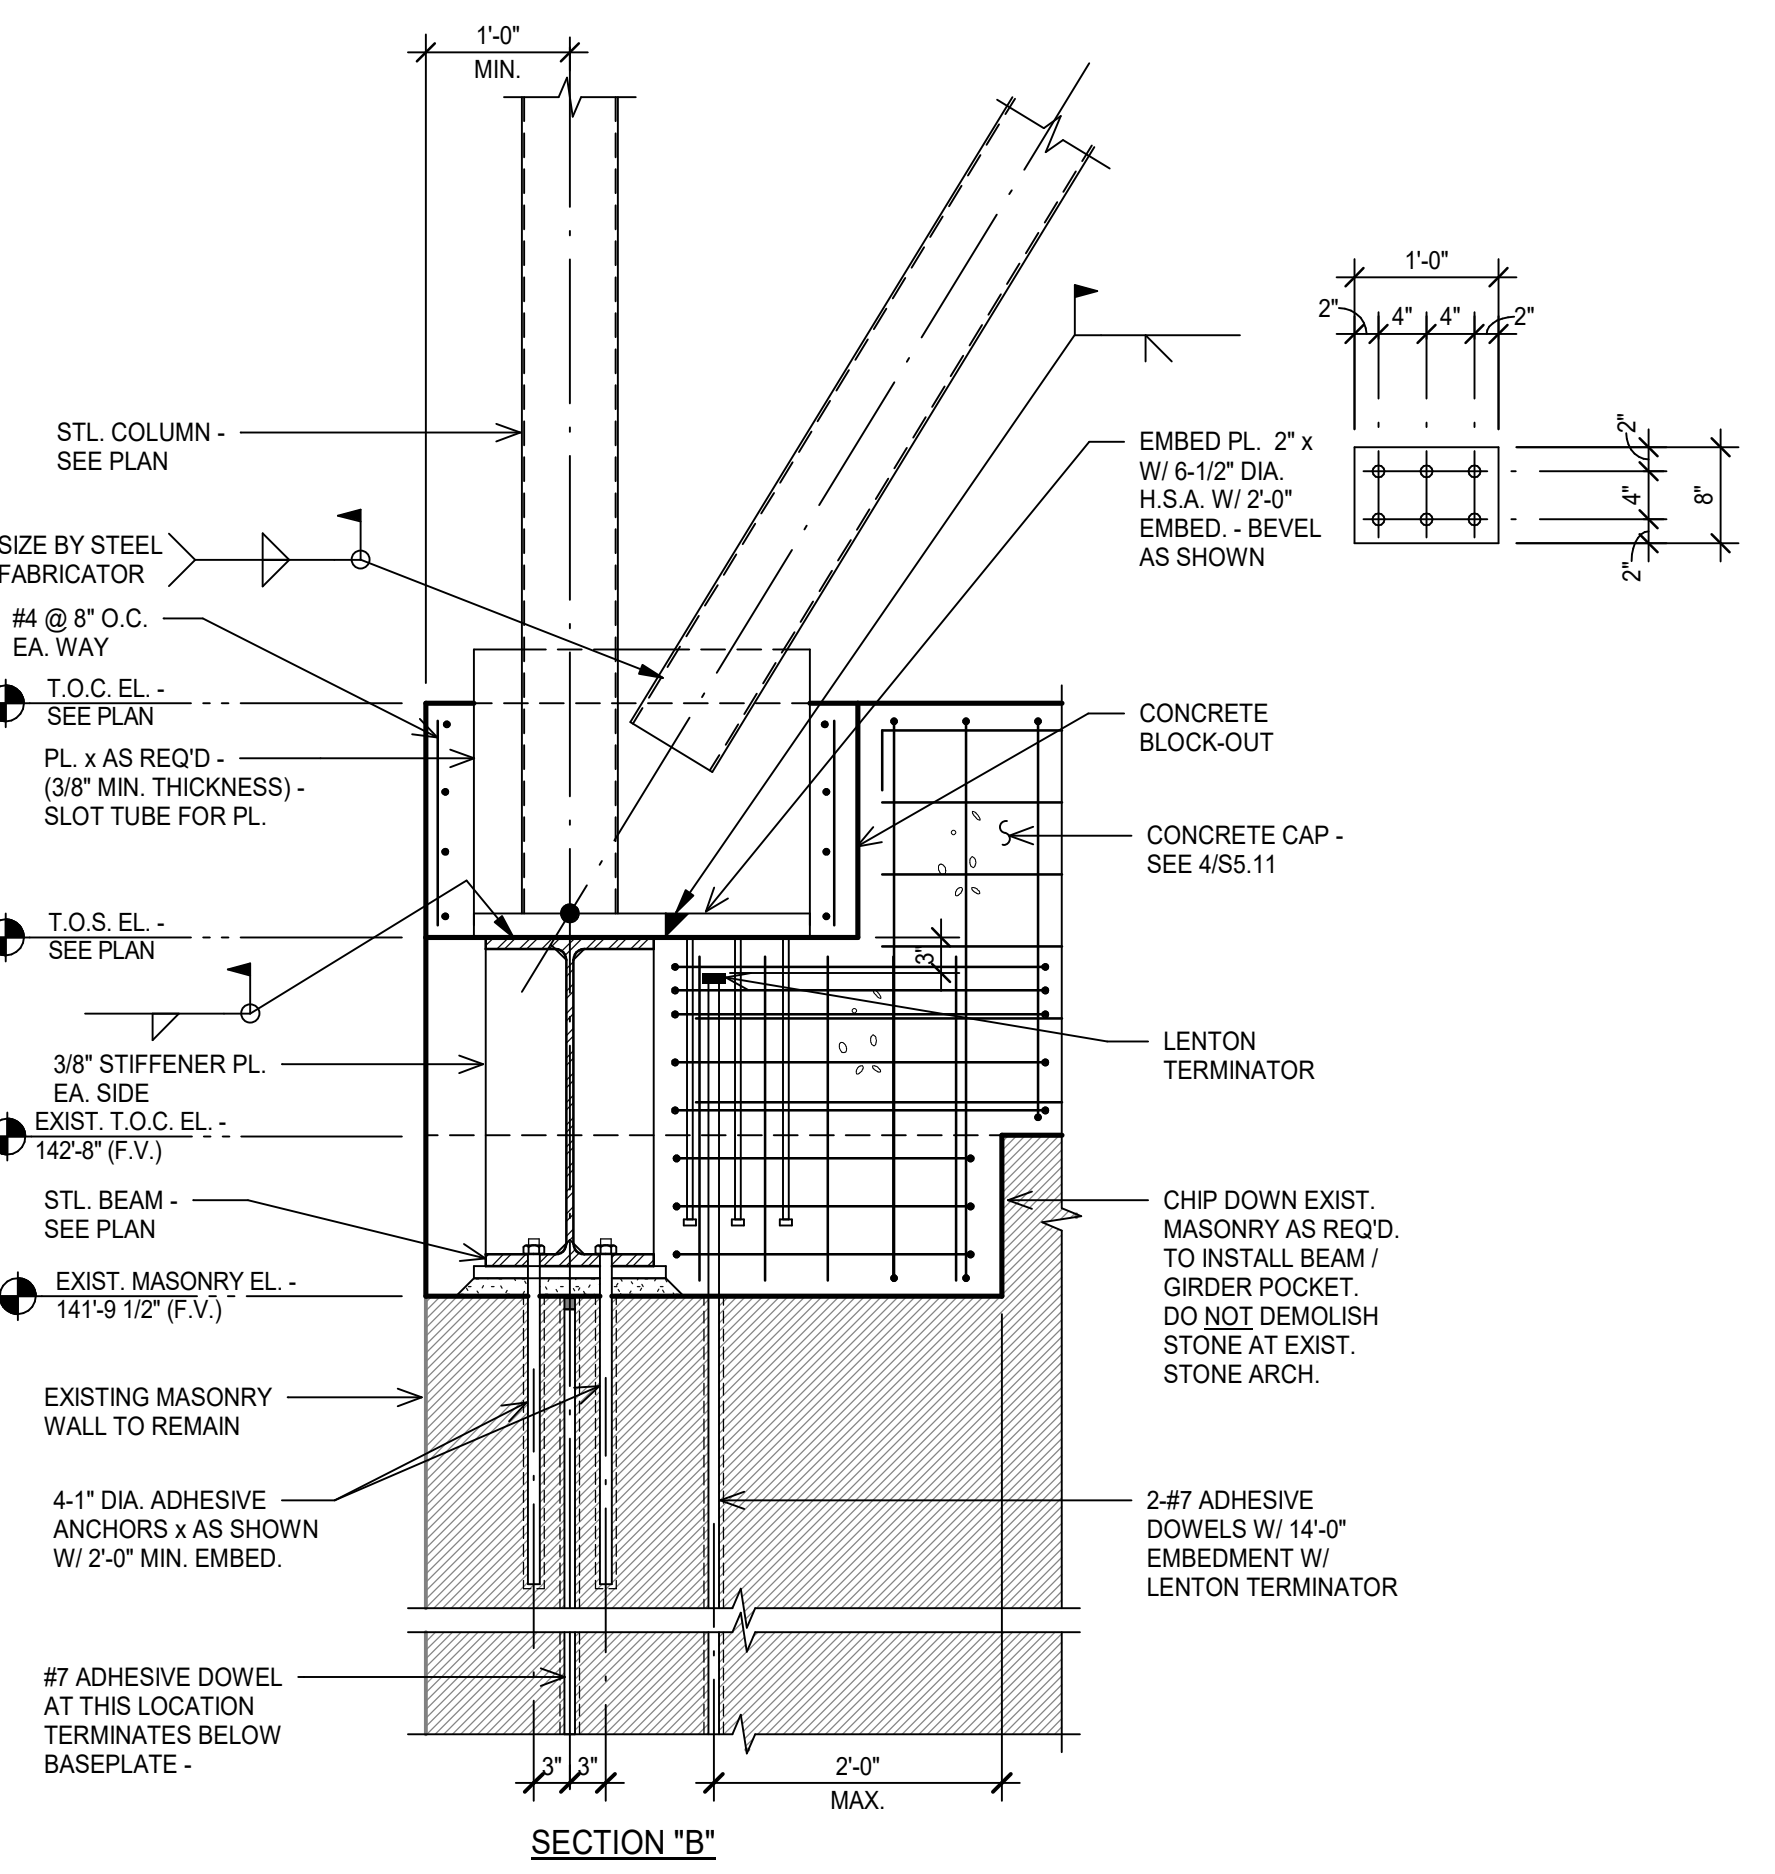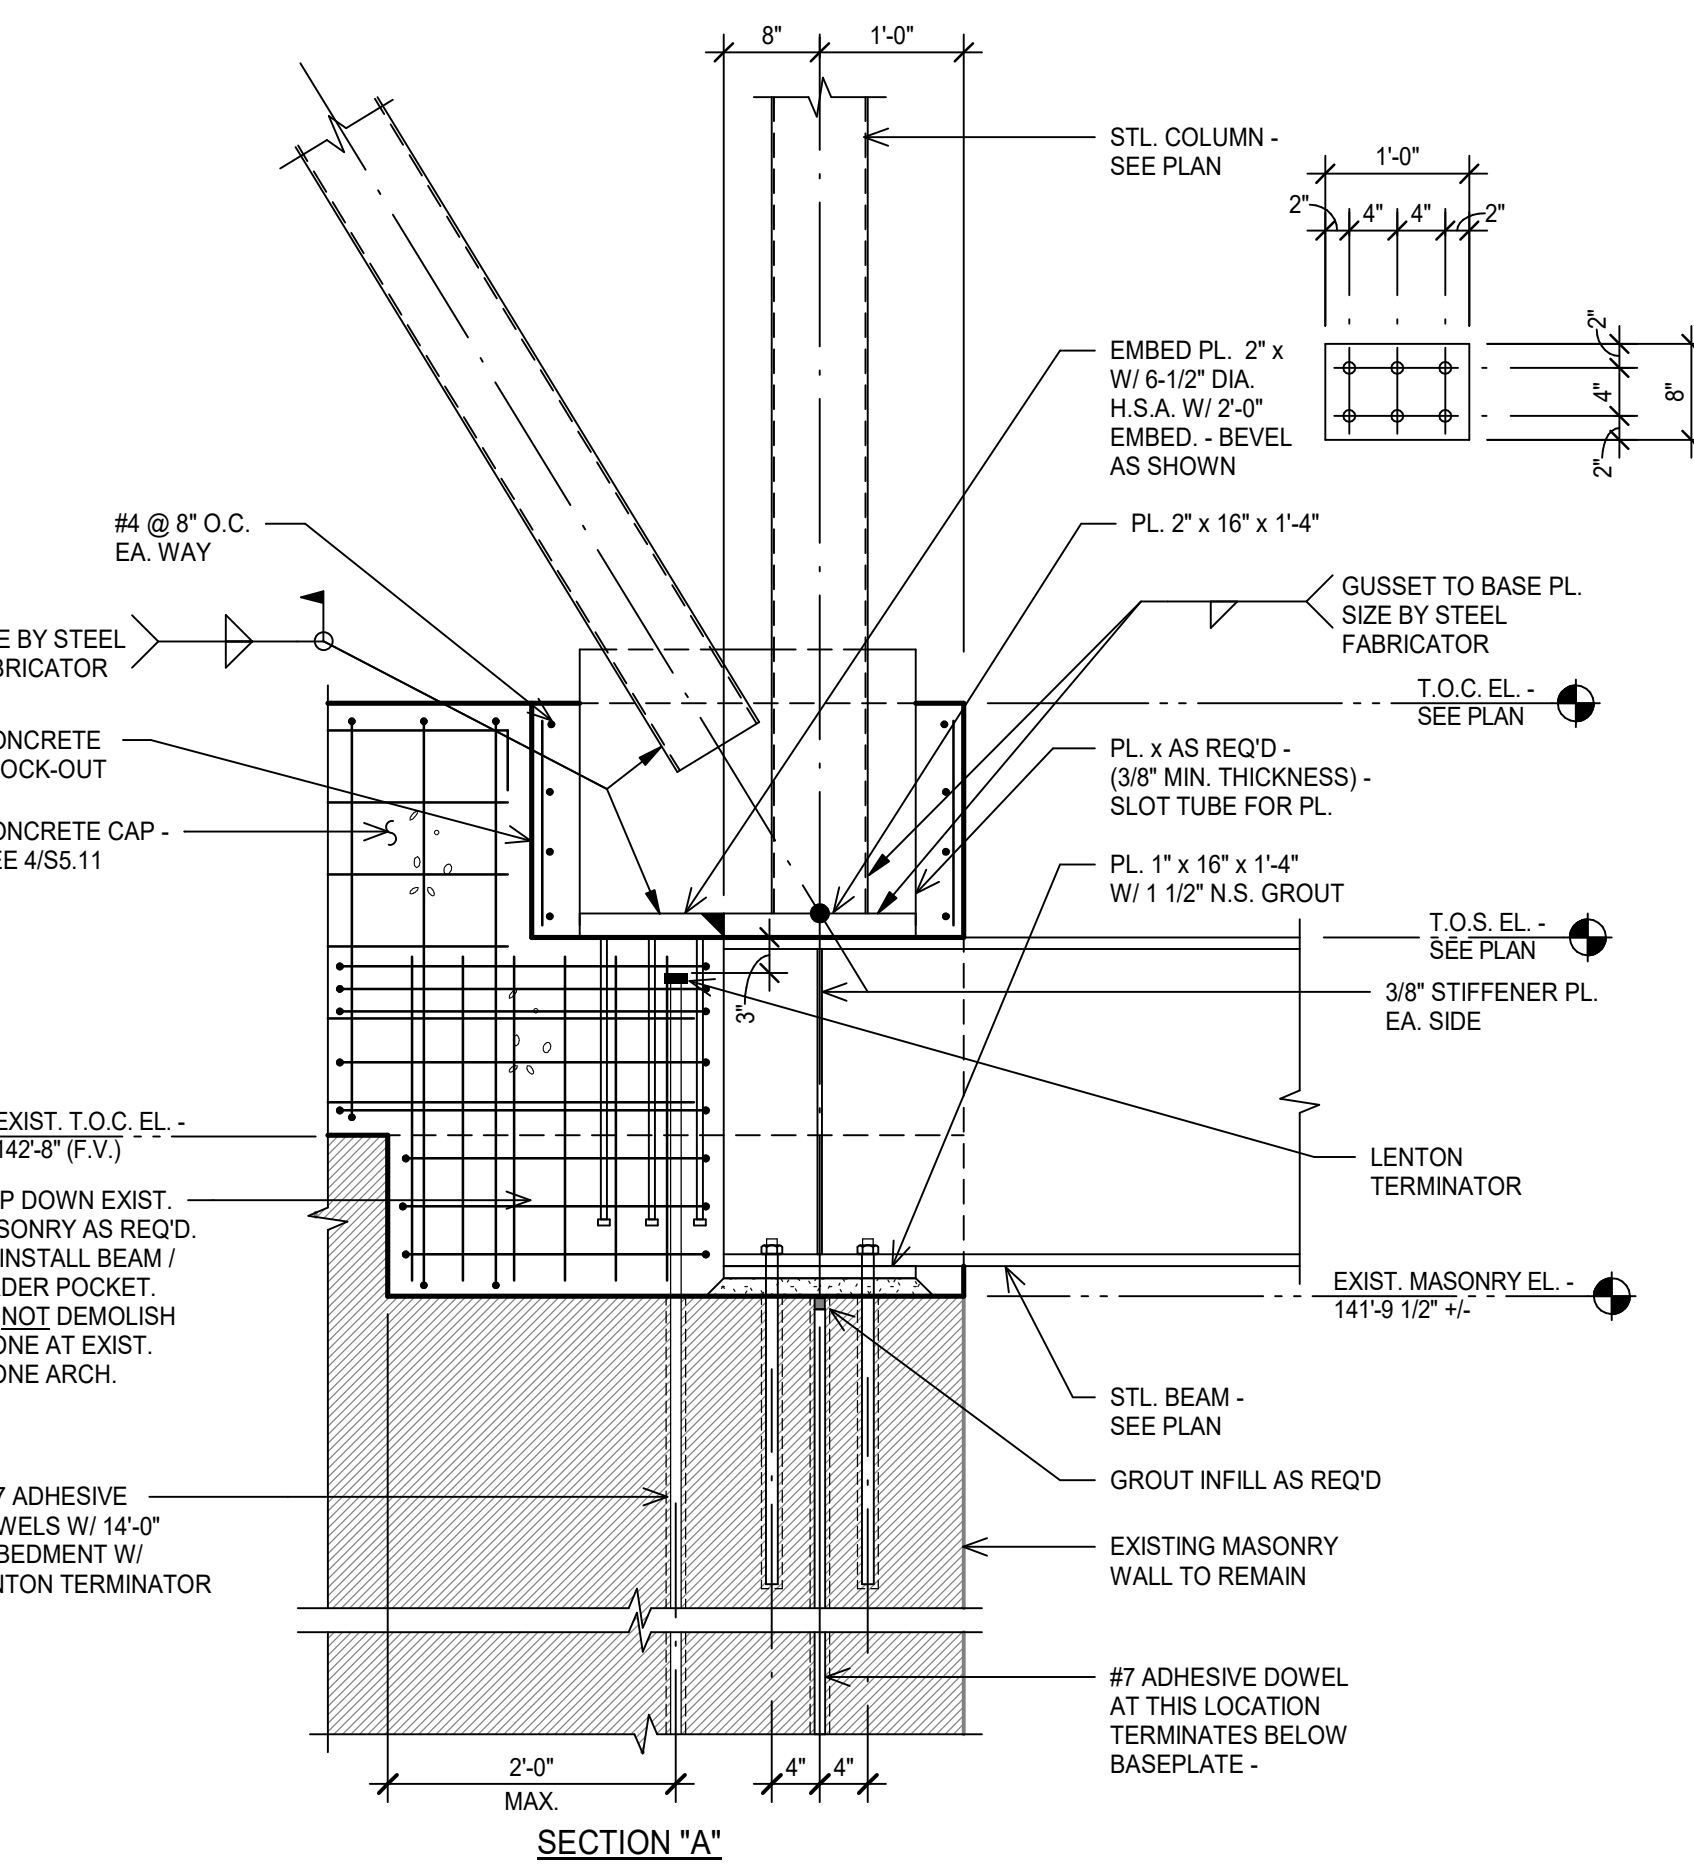

7 TOP OF COLUMN DETAIL  
SCALE: 3/4" = 1'-0"

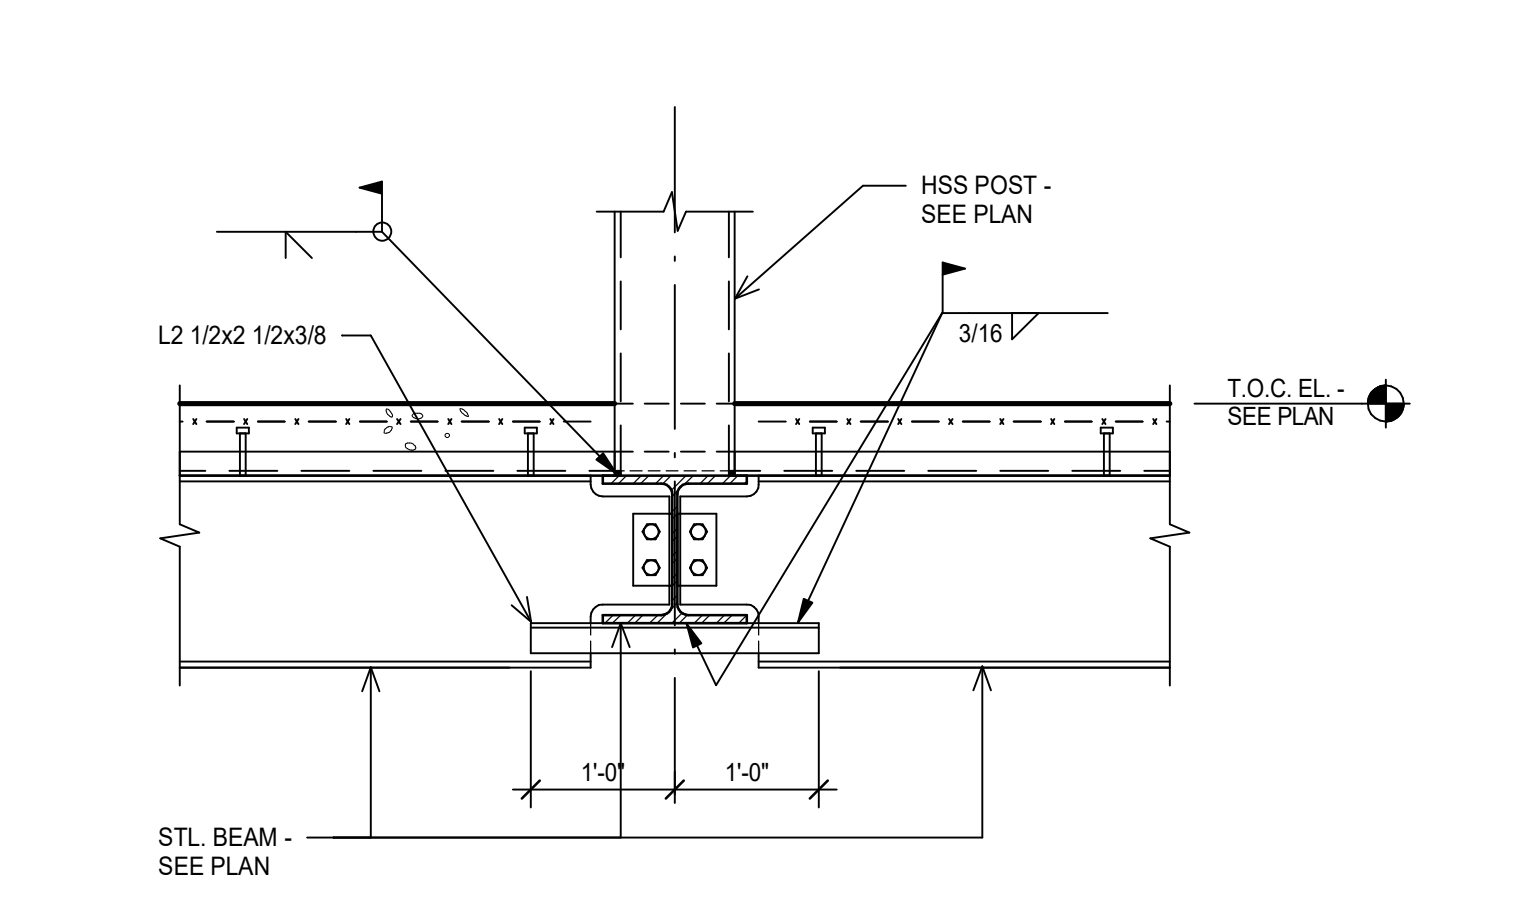

8 POST BASE CONNECTION DETAIL  
SCALE: 3/4" = 1'-0"



FANNIN COUNTY  
COURTHOUSE  
INTERIOR & EXTERIOR RESTORATION

101 E. Sam Rayburn Drive  
Bonham, Texas 75418

COPYRIGHT  
The Contractor shall verify and be responsible for all dimensions. DO NOT scale the drawing. Any errors or omissions shall be reported to Architexas without delay. The Copyrights to all designs and drawings are the property of Architexas. Reproduction or use for any purpose other than that authorized by Architexas is forbidden.


REVISION HISTORY  
1 10/16/18 ADDENDUM #1



Architexas No. 1737 Date SEPT. 21. 2018


Sheet Name TOWER FRAMING DETAILS

Sheet Number

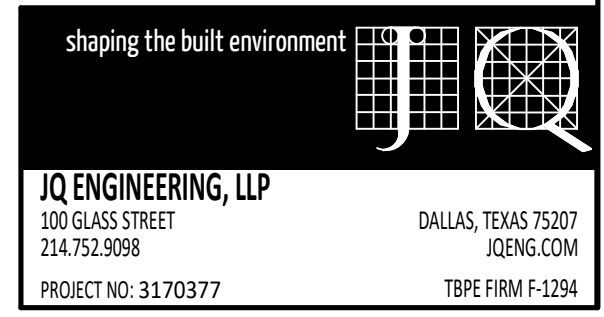

IQ ENGINEERING, LLC  
100 SILAS STREET  
DALLAS, TEXAS 75207  
214-753-9098  
IQENG.COM  
PROJECT NO. 3170377



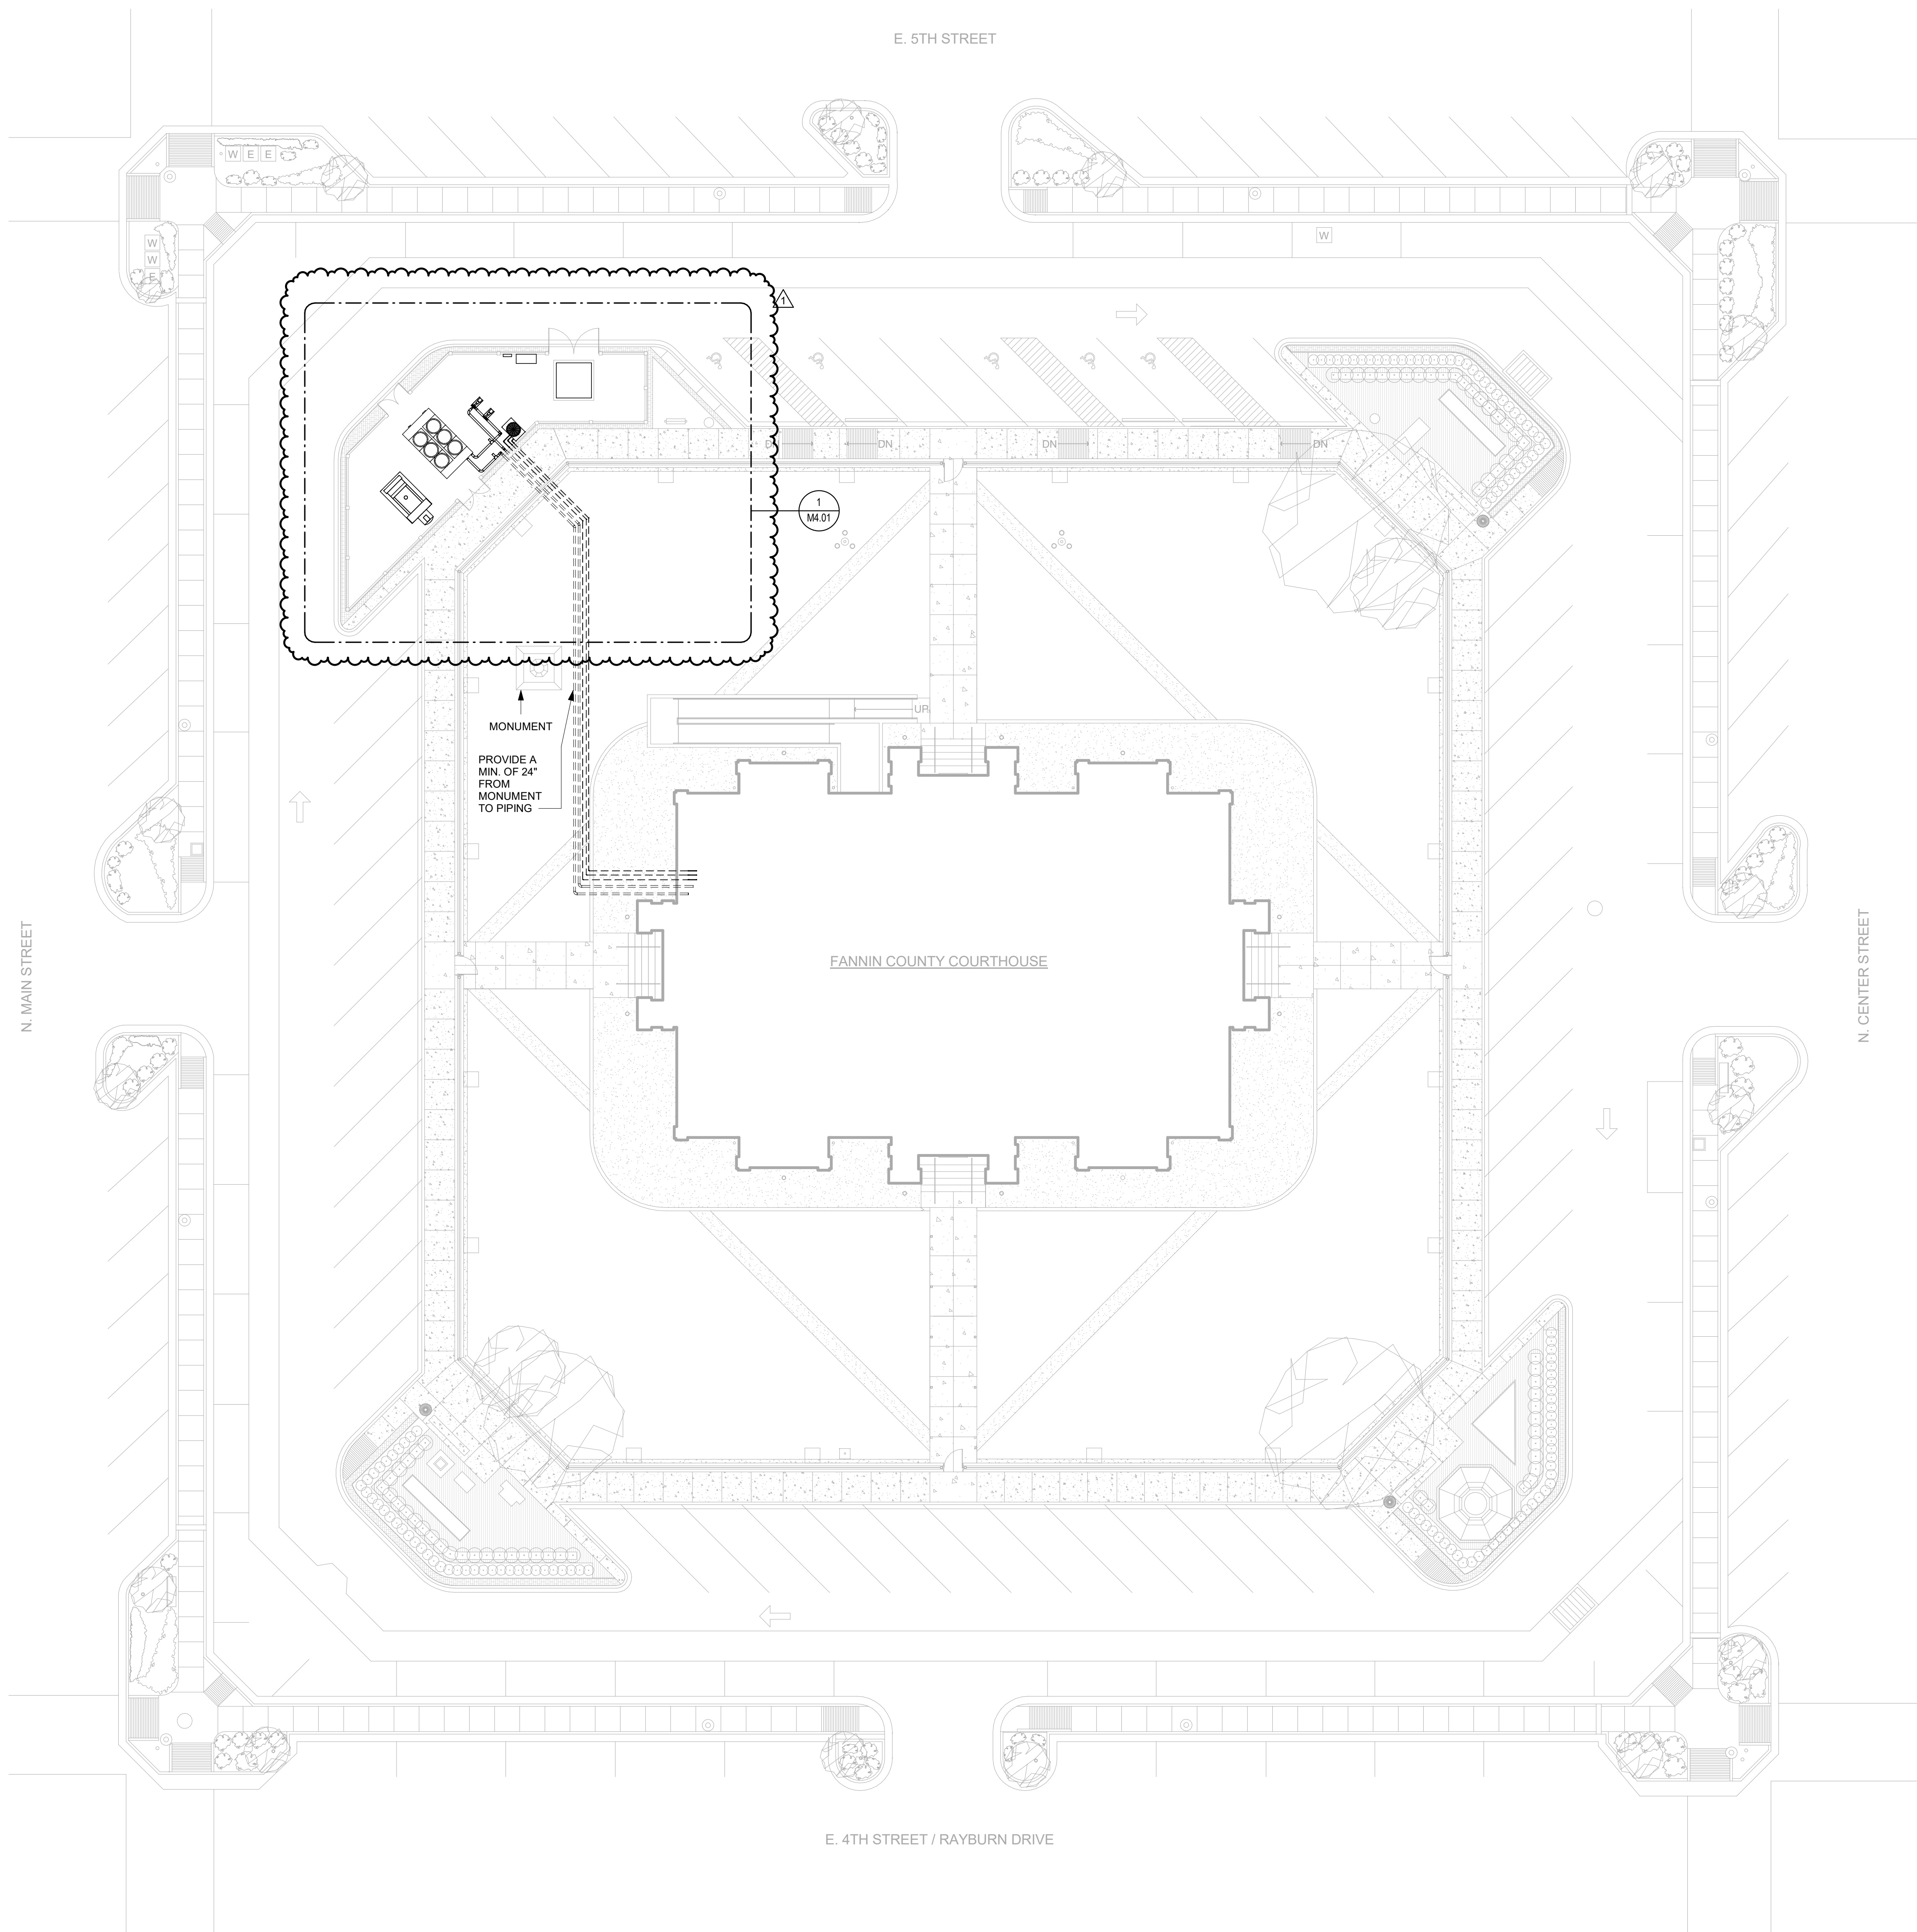

Engineering Firm: F-4050  
 Dallas/Fort Worth, Texas  
 www.mepce.com  
 972-870-0060  
 PROJECT CODE  
 17.022.003



TEXAS HISTORICAL COMMISSION  
*real places telling real stories*



FANNIN COUNTY  
 COURTHOUSE  
 INTERIOR AND EXTERIOR  
 RESTORATION 101 E. Sam Rayburn Drive  
 Bonham, Texas 75418

**COPYRIGHT**  
 The Contractor shall verify and be responsible for all dimensions. DO NOT scale the drawing. Any errors or omissions shall be reported to Architexas without delay. The Copyrights to all designs and drawings are the property of Architexas. Reproduction or use for any purpose other than that authorized by Architexas is forbidden.

**REVISION HISTORY**

1	10/16/18	Addendum 1
---	----------	------------

ADDENDUM 1



Architexas No. 1737 Date OCTOBER 16, 2018

Sheet Name MECHANICAL SITE PLAN

Sheet Number

1 MECHANICAL SITE PLAN  
 1/16" = 1'-0"





Engineering Firm: F-4050  
 Dallas/Fort Worth, Texas  
 www.mepce.com  
 972-870-0960  
 PROJECT CODE  
 17.022.003




TEXAS HISTORICAL COMMISSION  
 real places telling real stories



FANNIN COUNTY  
 COURTHOUSE  
 INTERIOR AND EXTERIOR  
 RESTORATION  
 101 E. Sam Rayburn Drive  
 Bonham, Texas 75418

**COPYRIGHT**  
 The Contractor shall verify and be responsible for all dimensions. DO NOT scale the drawing. Any errors or omissions shall be reported to Architexas without delay. The Copyrights to all designs and drawings are the property of Architexas. Reproduction or use for any purpose other than that authorized by Architexas is forbidden.

**REVISION HISTORY**  
 1 10/16/18 Addendum 1

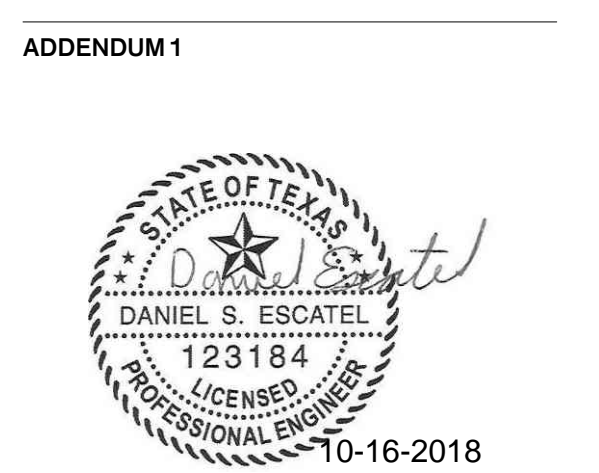


Architexas No. 1737 Date OCTOBER 16, 2018

Sheet Name GROUND LEVEL MECHANICAL FLOOR PLAN


Sheet Number M2.01

GENERAL NOTES	
1.	PROVIDE BALANCING DAMPERS FOR ALL DIFFUSERS AND RETURN AIR GRILLES.
2.	ALL MITERED ELBOW SHALL BE WITH TURNING VANES.
3.	INSTALL ALL HVAC EQUIPMENT TO ALLOW FOR ACCESS FROM AN 8 FT. LADDER.
4.	ALL AIR DEVICES SHOWN ON THE GROUND FLOOR REGISTERS REFER TO SHEET M2.00 FOR CONTINUATION. COORDINATE ALL FLOOR PENETRATIONS WITH STRUCTURAL.

NOTES BY SYMBOL	
1	DUCT WORK TO BE INSTALLED CONCEALED ABOVE CEILING. COORDINATE WALL PENETRATION WITH STRUCTURAL.
2	INSTALL BOTTOM OF DIFFUSER APPROXIMATELY 8'-0" AFF. COORDINATE EXACT LOCATION WITH ARCHITECT.

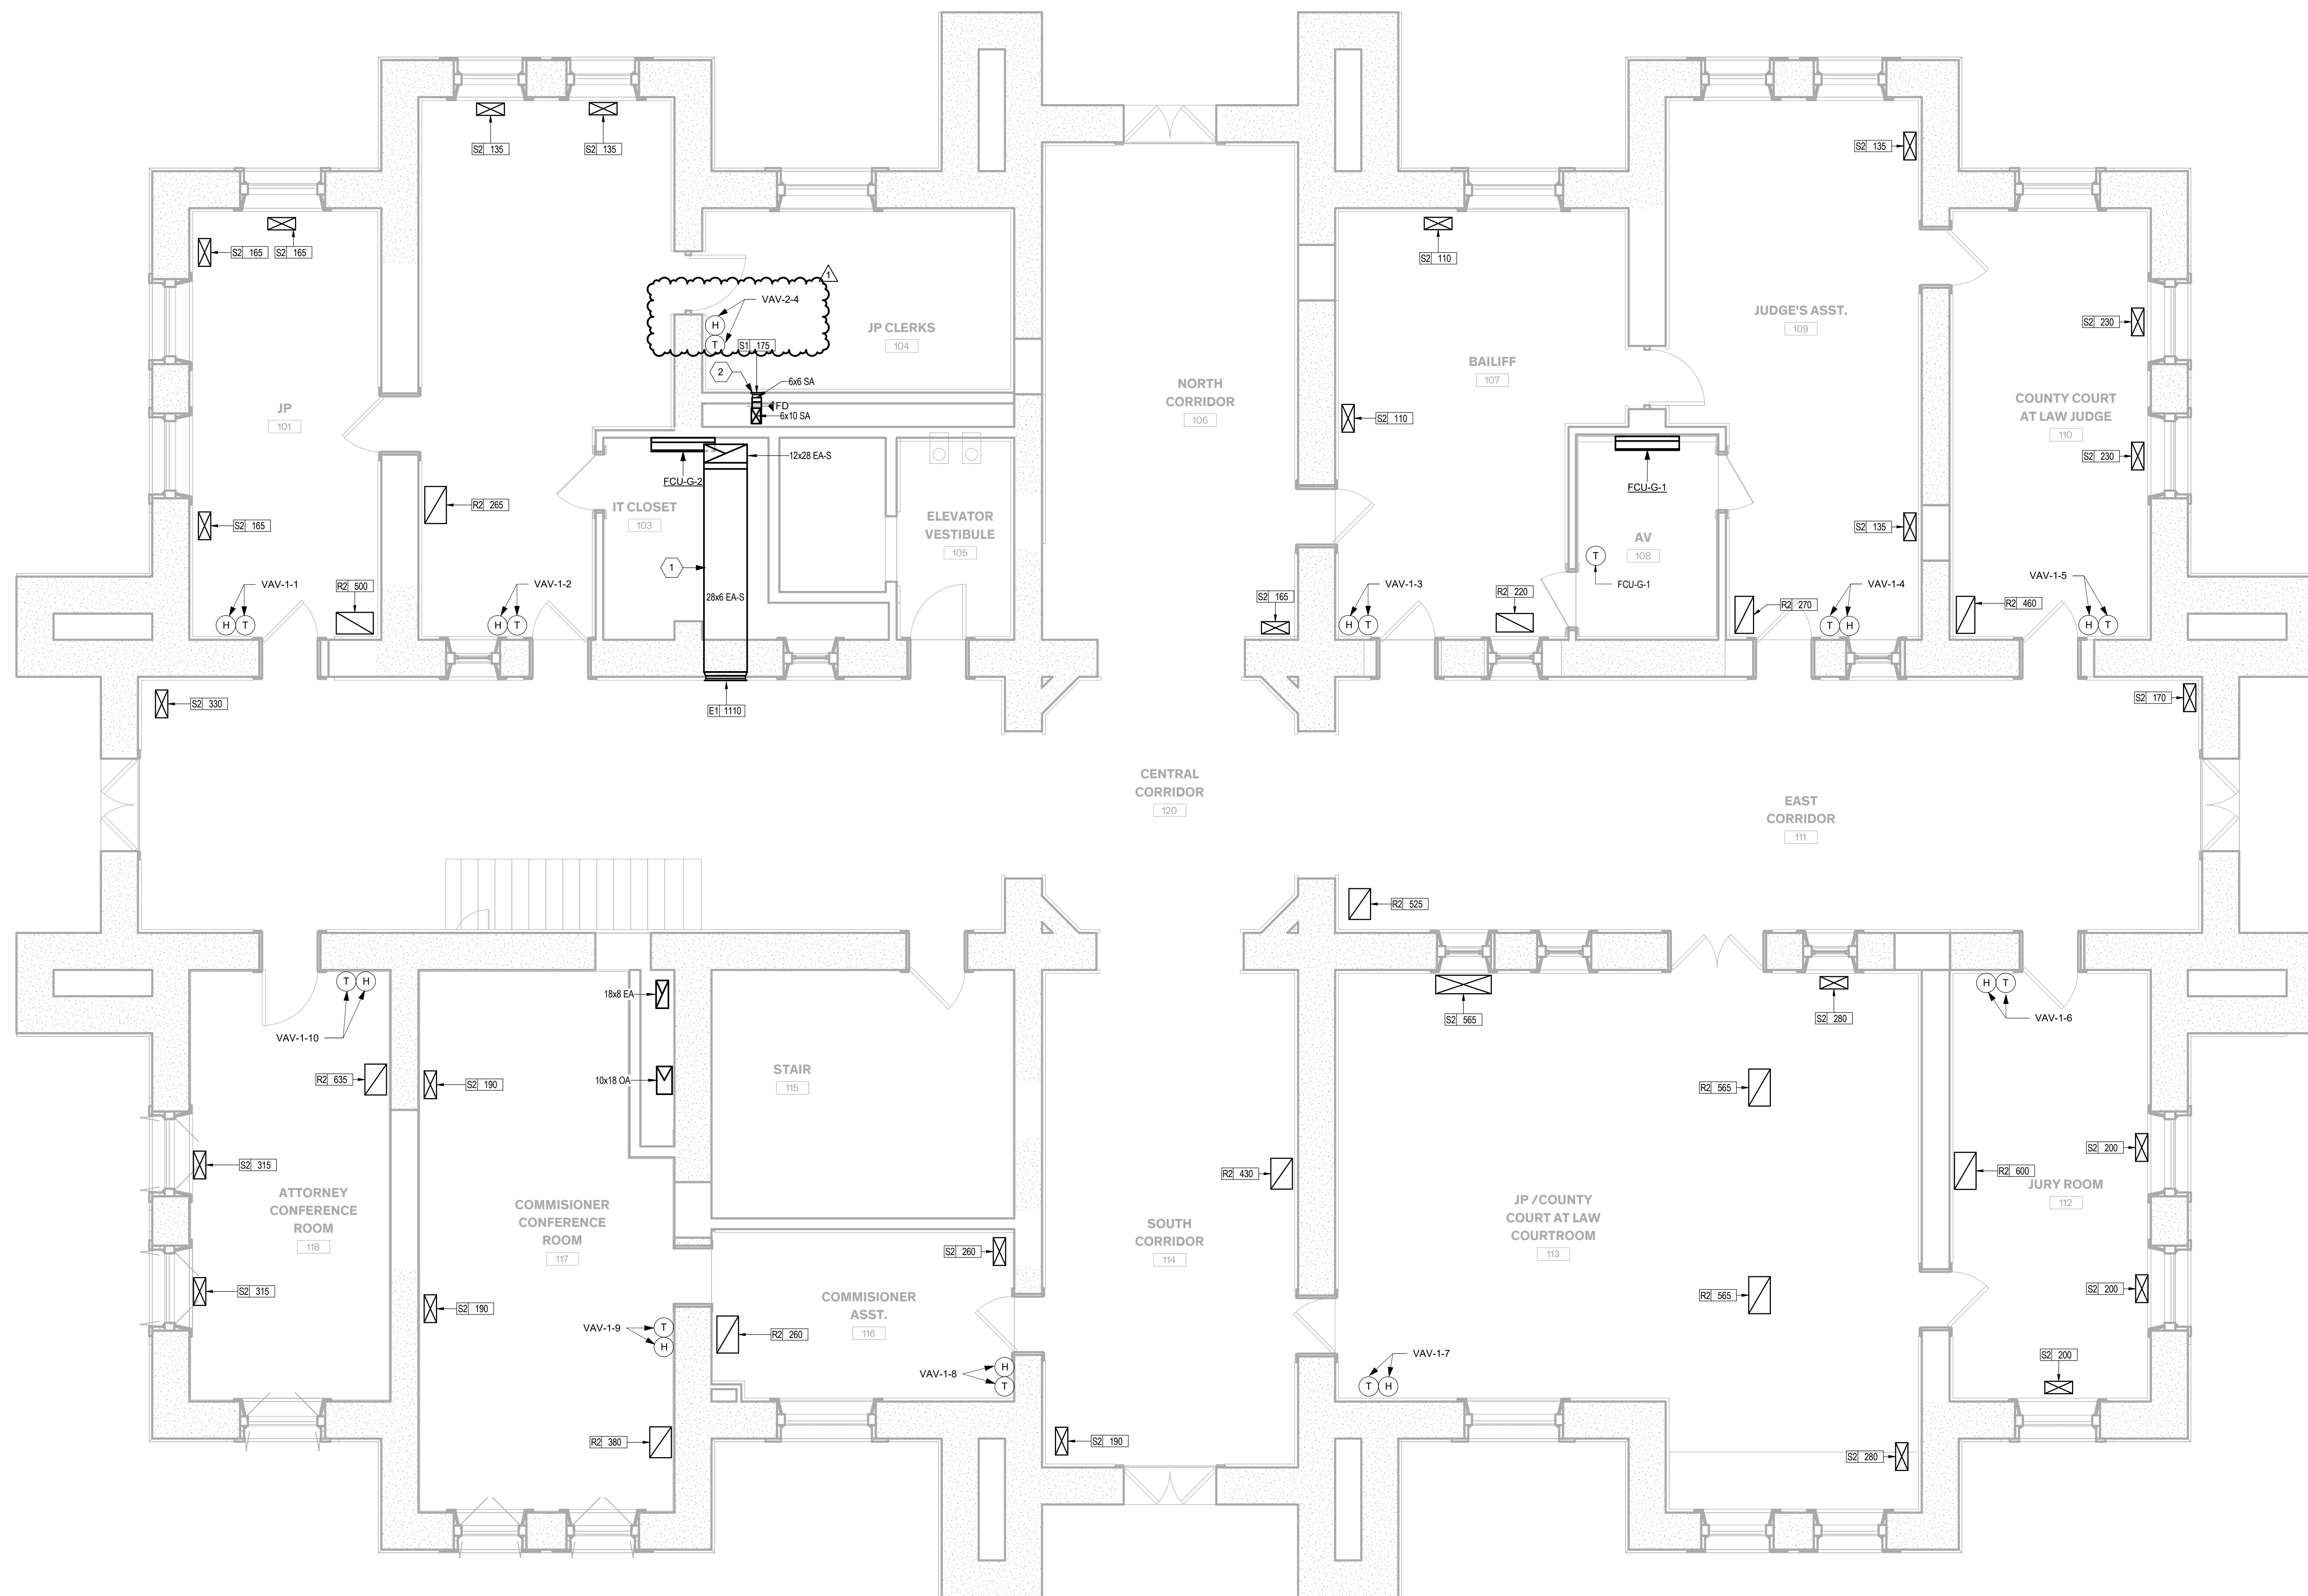

1 GROUND LEVEL MECHANICAL FLOOR PLAN  
 1/4" = 1'-0"

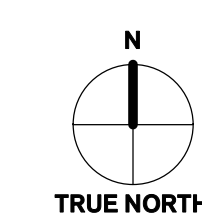



Engineering Firm: F-4050  
Dallas/Fort Worth, Texas  
www.mepce.com  
972-870-0960  
PROJECT CODE  
17.022.003



TEXAS HISTORICAL COMMISSION  
real places telling real stories



FANNIN COUNTY  
COURTHOUSE  
INTERIOR AND EXTERIOR  
RESTORATION  
101 E. Sam Rayburn Drive  
Bonham, Texas 75418

**COPYRIGHT**  
The Contractor shall verify and be responsible for all dimensions. DO NOT scale the drawing. Any errors or omissions shall be reported to Architexas without delay. The Copyrights to all designs and drawings are the property of Architexas. Reproduction or use for any purpose other than that authorized by Architexas is forbidden.

**REVISION HISTORY**  
1 10/16/18 Addendum 1

ADDENDUM 1




Architexas No. 1737 Date OCTOBER 16, 2018

Sheet Name SECOND LEVEL MECHANICAL FLOOR PLAN

Sheet Number M2.02

GENERAL NOTES	
1.	PROVIDE BALANCING DAMPERS FOR ALL DIFFUSERS AND RETURN AIR GRILLES.
2.	ALL MITERED ELBOW SHALL BE WITH TURNING VANES.
3.	INSTALL ALL HVAC EQUIPMENT TO ALLOW FOR ACCESS FROM AN 8 FT. LADDER.
4.	COORDINATE ALL WALL PENETRATIONS WITH STRUCTURAL.
5.	PROVIDE YOUNG'S REGULATOR FOR ALL SUPPLY, RETURN, AND EXHAUST DIFFUSERS AND GRILLES LOCATED IN AREAS WHERE ABOVE CEILING CANNOT BE ACCESSED.

NOTES BY SYMBOL	
1	PROVIDE LIGHT SHIELD FOR RETURN SLOT SIMILAR OR EQUAL TO TITUS MODEL FBR.
2	PROVIDE INTERNALLY LINED SPIRAL DUCTWORK WHERE DUCT IS EXPOSED. INSTALL ROUND DUCT WORK AS TIGHT TO CEILING AS POSSIBLE, SUCH THAT DUCT WORK NESTS INSIDE RIBBED CEILING.
3	FURNISH SIDEWALL SUPPLY ON SIDE OF ARCHITECTURALLY PROVIDED FUR OUT.

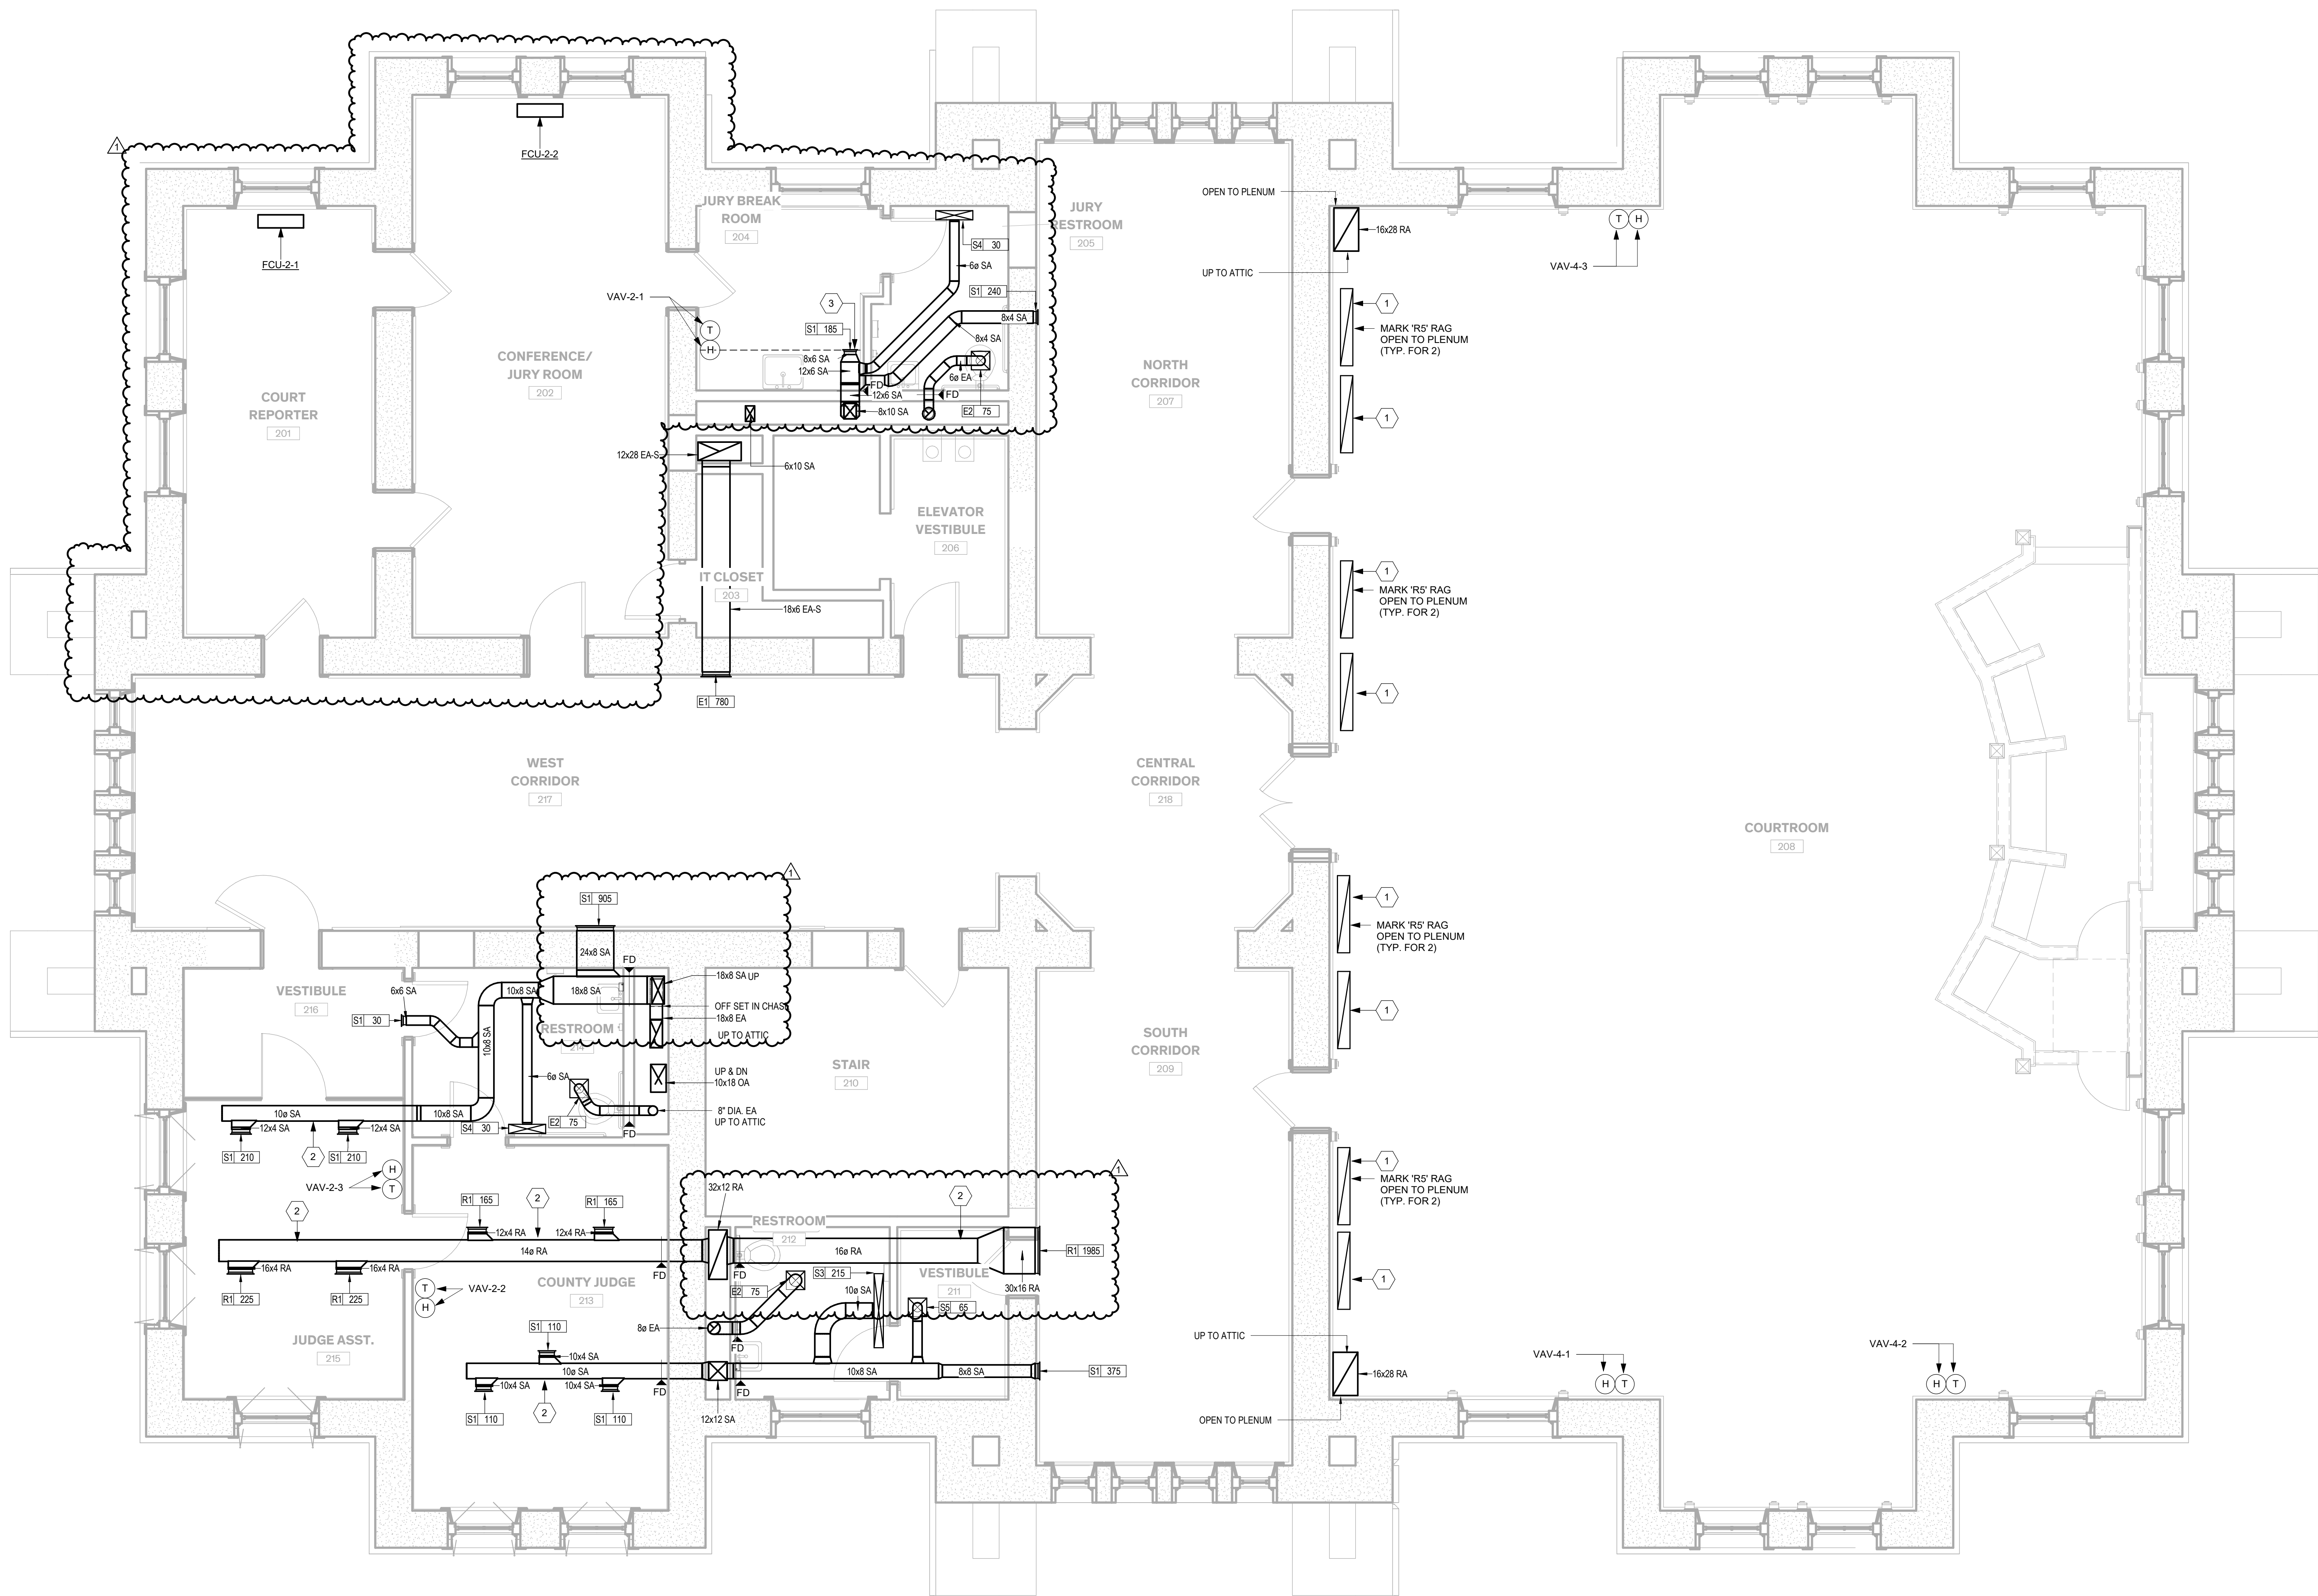

1 SECOND LEVEL MECHANICAL FLOOR PLAN  
1/4" = 1'-0"





Engineering Firm: F-4050  
Dallas/Fort Worth, Texas  
www.mepce.com  
972-870-0960  
PROJECT CODE  
17.022.003



TEXAS HISTORICAL COMMISSION  
real places telling real stories



FANNIN COUNTY  
COURTHOUSE  
INTERIOR AND EXTERIOR  
RESTORATION 101 E. Sam Rayburn Drive  
Bonham, Texas 75418

**COPYRIGHT**  
The Contractor shall verify and be responsible for all dimensions. DO NOT scale the drawing. Any errors or omissions shall be reported to Architexas without delay. The Copyrights to all designs and drawings are the property of Architexas. Reproduction or use for any purpose other than that authorized by Architexas is forbidden.

**REVISION HISTORY**  
1 10/16/18 Addendum 1

ADDENDUM 1





Architexas No. 1737 Date OCTOBER 16, 2018

Sheet Name THIRD LEVEL MECHANICAL FLOOR PLAN

Sheet Number

M2.03

- GENERAL NOTES**
1. PROVIDE BALANCING DAMPERS FOR ALL DIFFUSERS AND RETURN AIR GRILLES.
  2. ALL MITERED ELBOW SHALL BE WITH TURNING VANES.
  3. INSTALL ALL HVAC EQUIPMENT TO ALLOW FOR ACCESS FROM AN 8 FT. LADDER.
  4. UNLESS OTHERWISE INDICATED ALL AIR DEVICES SHOWN ON THE THIRD FLOOR MECHANICAL PLAN ARE CEILING REGISTERS. REFER TO SHEET M2.04 FOR CONTINUATION.
  5. PROVIDE YOUNG'S REGULATOR FOR ALL SUPPLY, RETURN AND EXHAUST DIFFUSERS AND GRILLES LOCATED IN AREAS WHERE ABOVE CEILING CANNOT BE ACCESSED.

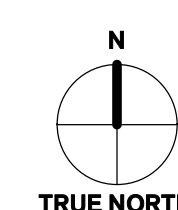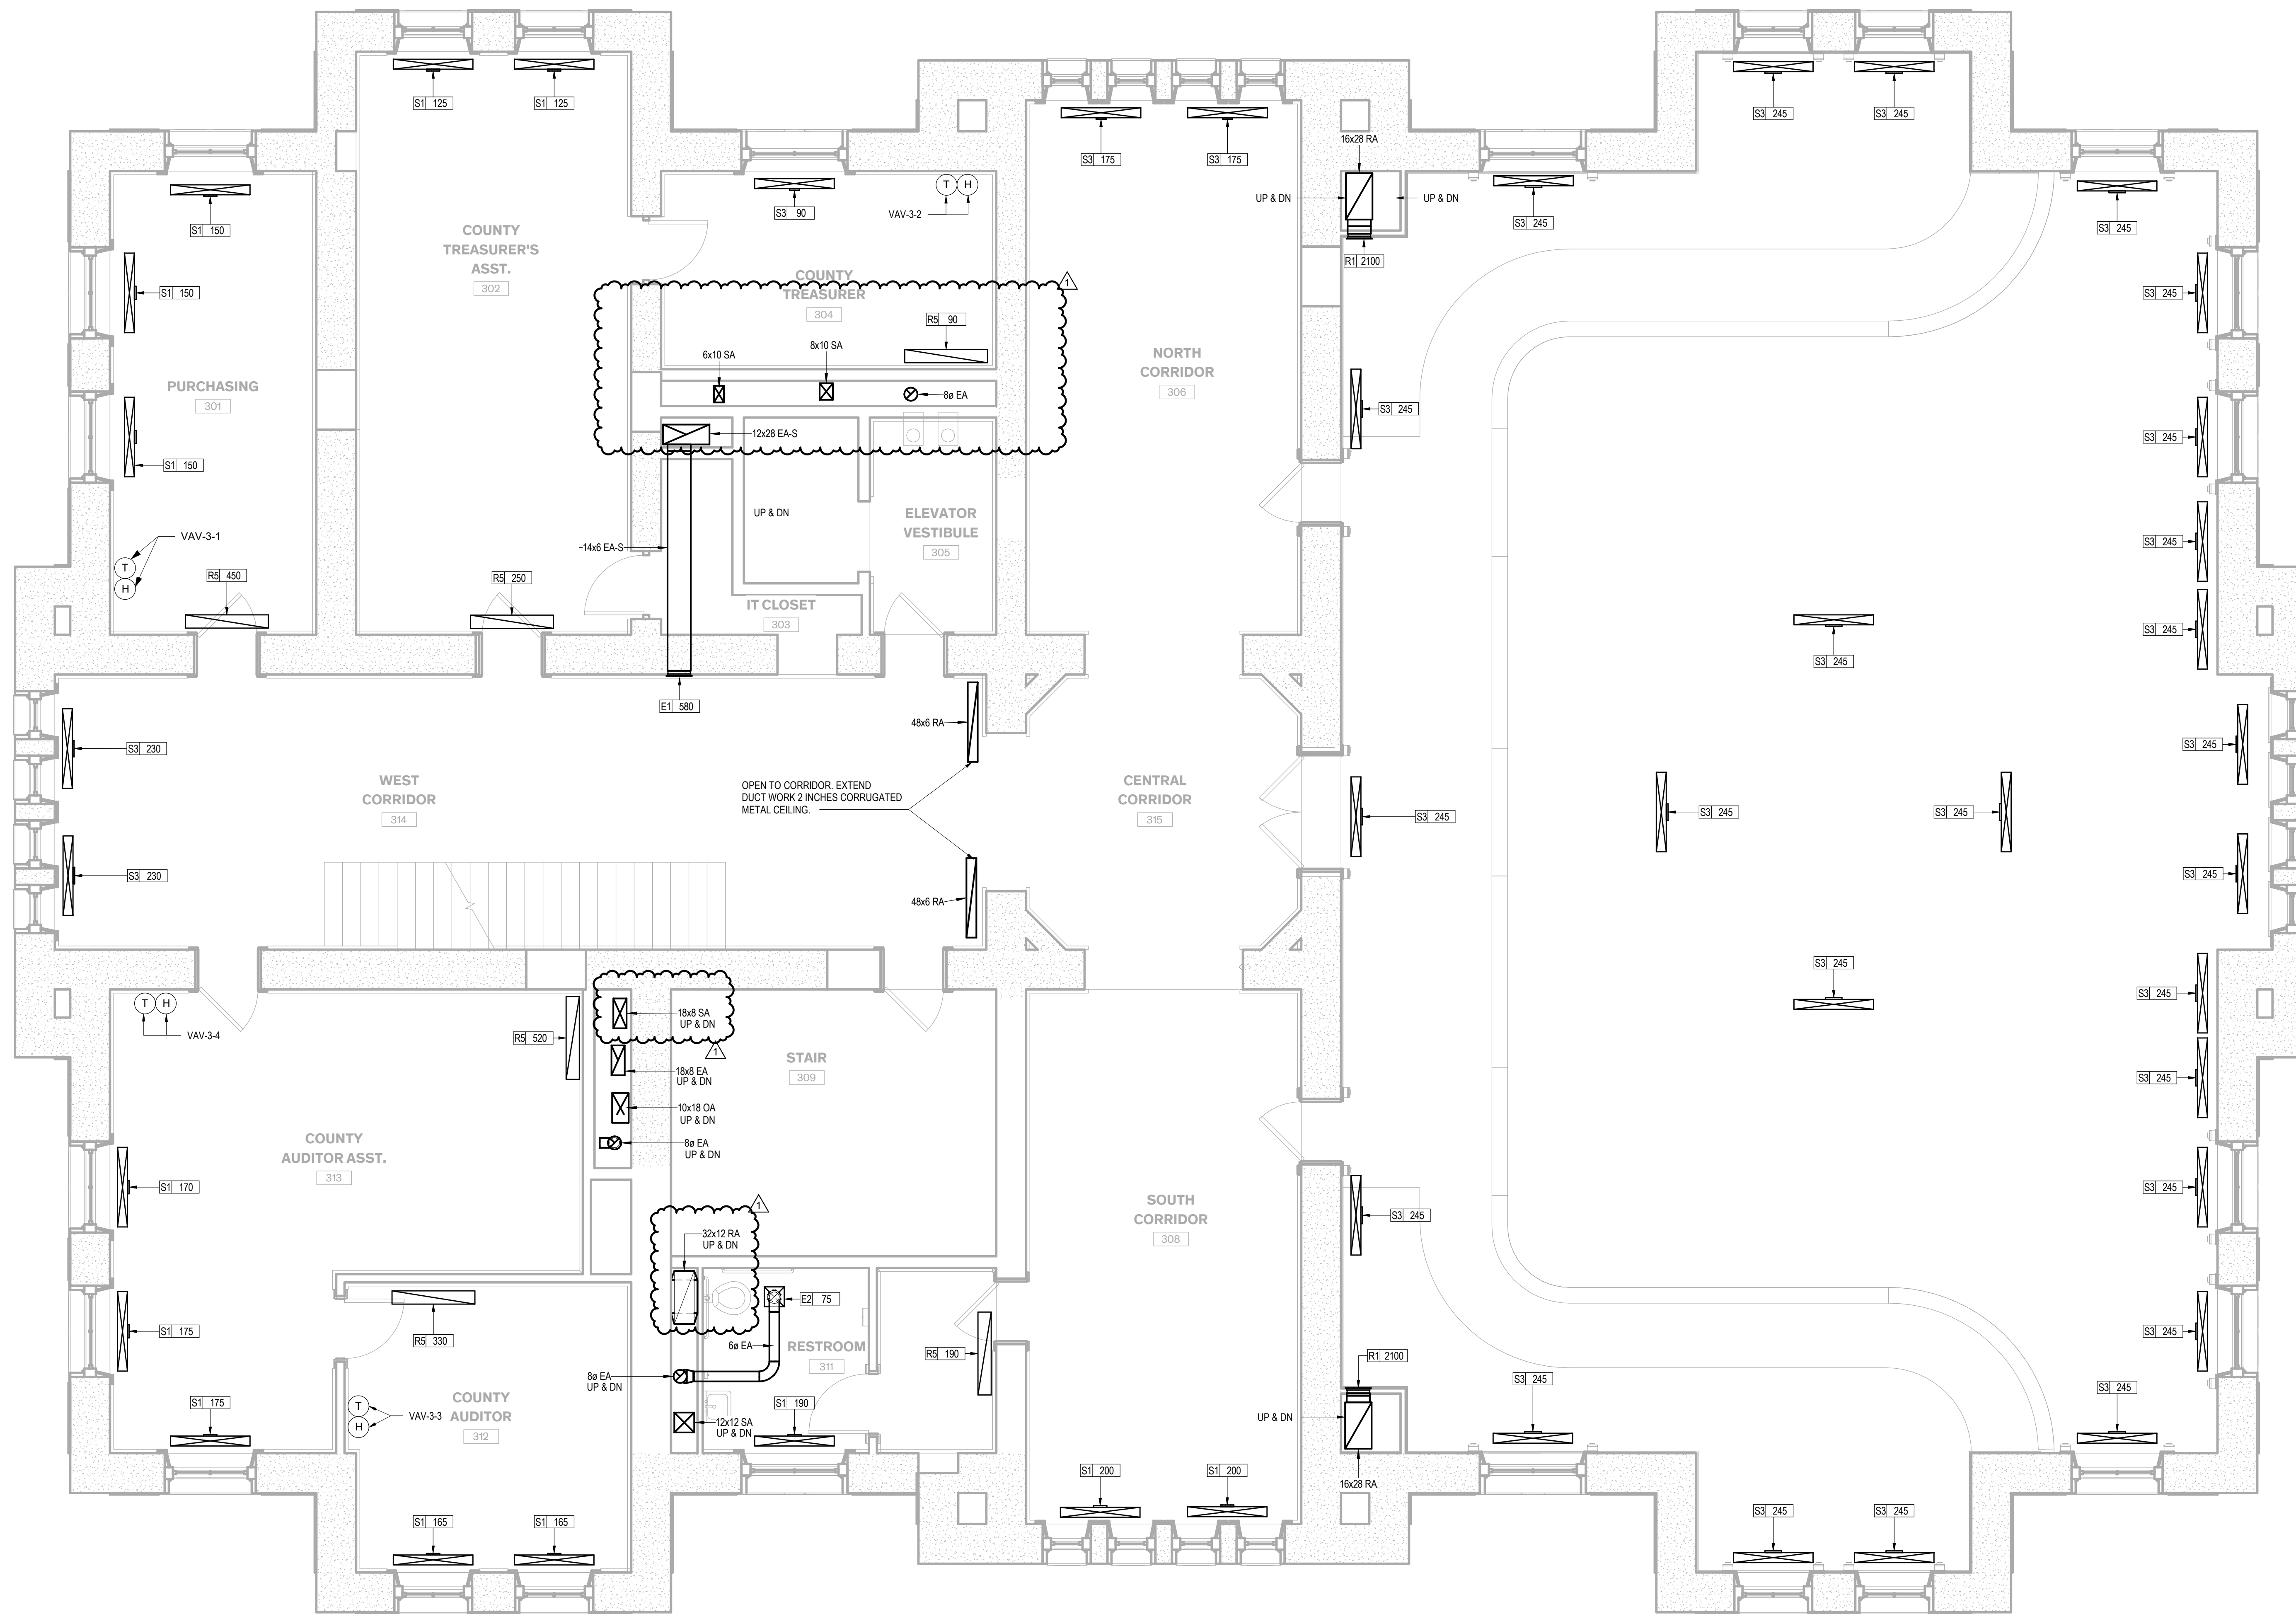

1 THIRD LEVEL MECHANICAL FLOOR PLAN  
1/4" = 1'-0"



Engineering Firm: F-4050  
Dallas/Fort Worth, Texas  
www.mepce.com  
972-870-0960

PROJECT CODE  
17.022.003




TEXAS HISTORICAL COMMISSION  
real places telling real stories



FANNIN COUNTY  
COURTHOUSE  
INTERIOR AND EXTERIOR  
RESTORATION  
101 E. Sam Rayburn Drive  
Bonham, Texas 75418

**COPYRIGHT**  
The Contractor shall verify and be responsible for all dimensions. DO NOT scale the drawing. Any errors or omissions shall be reported to Architexas without delay. The Copyrights to all designs and drawings are the property of Architexas. Reproduction or use for any purpose other than that authorized by Architexas is forbidden.

**REVISION HISTORY**  
1 10/16/18 Addendum 1

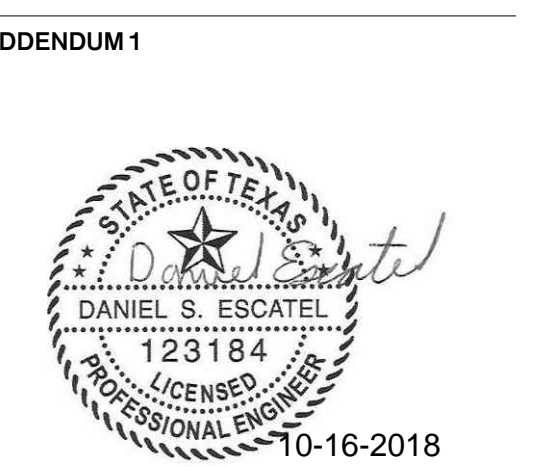



Architexas No. 1737 Date OCTOBER 16, 2018

Sheet Name ATTIC LEVEL MECHANICAL FLOOR PLAN

Sheet Number M2.04

GENERAL NOTES	
1.	PROVIDE BALANCING DAMPERS FOR ALL DIFFUSERS AND RETURN AIR GRILLES.
2.	ALL MITERED ELBOW SHALL BE WITH TURNING VANES.
3.	INSTALL ALL HVAC EQUIPMENT TO ALLOW FOR ACCESS FROM AN 8 FT. LADDER.
4.	CONTRACTOR TO INSTALL ALL EQUIPMENT AND DUCT WORK SUCH THAT MINIMUM 4'-0" WALKING ACCESS IS AVAILABLE TO ALL AHUS AND VAV BOXES.

NOTES BY SYMBOL	
1	AIR HANDLING UNIT SHALL BE MOUNTED ON WOOD CURB ON WOOD PLATFORM.
2	CONNECT SMOKE REMOVAL DUCT TO DORMER.
3	CONNECT EXHAUST DUCT TO DORMER.
4	INSTALL RETURN AIR MOTORIZED DAMPER IN MAIN RETURN DUCT, MATCH MAIN RETURN DUCT SIZE.
5	INSTALL OUTSIDE AIR MOTORIZED DAMPER IN MAIN OUTSIDE AIR DUCT, MATCH MAIN OUTSIDE AIR DUCT SIZE.
6	PROVIDE 18"x12" DUCT OPENING WITH BAROMETRIC RELIEF DAMPER ON RETURN AIR DUCT.

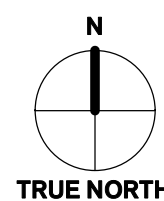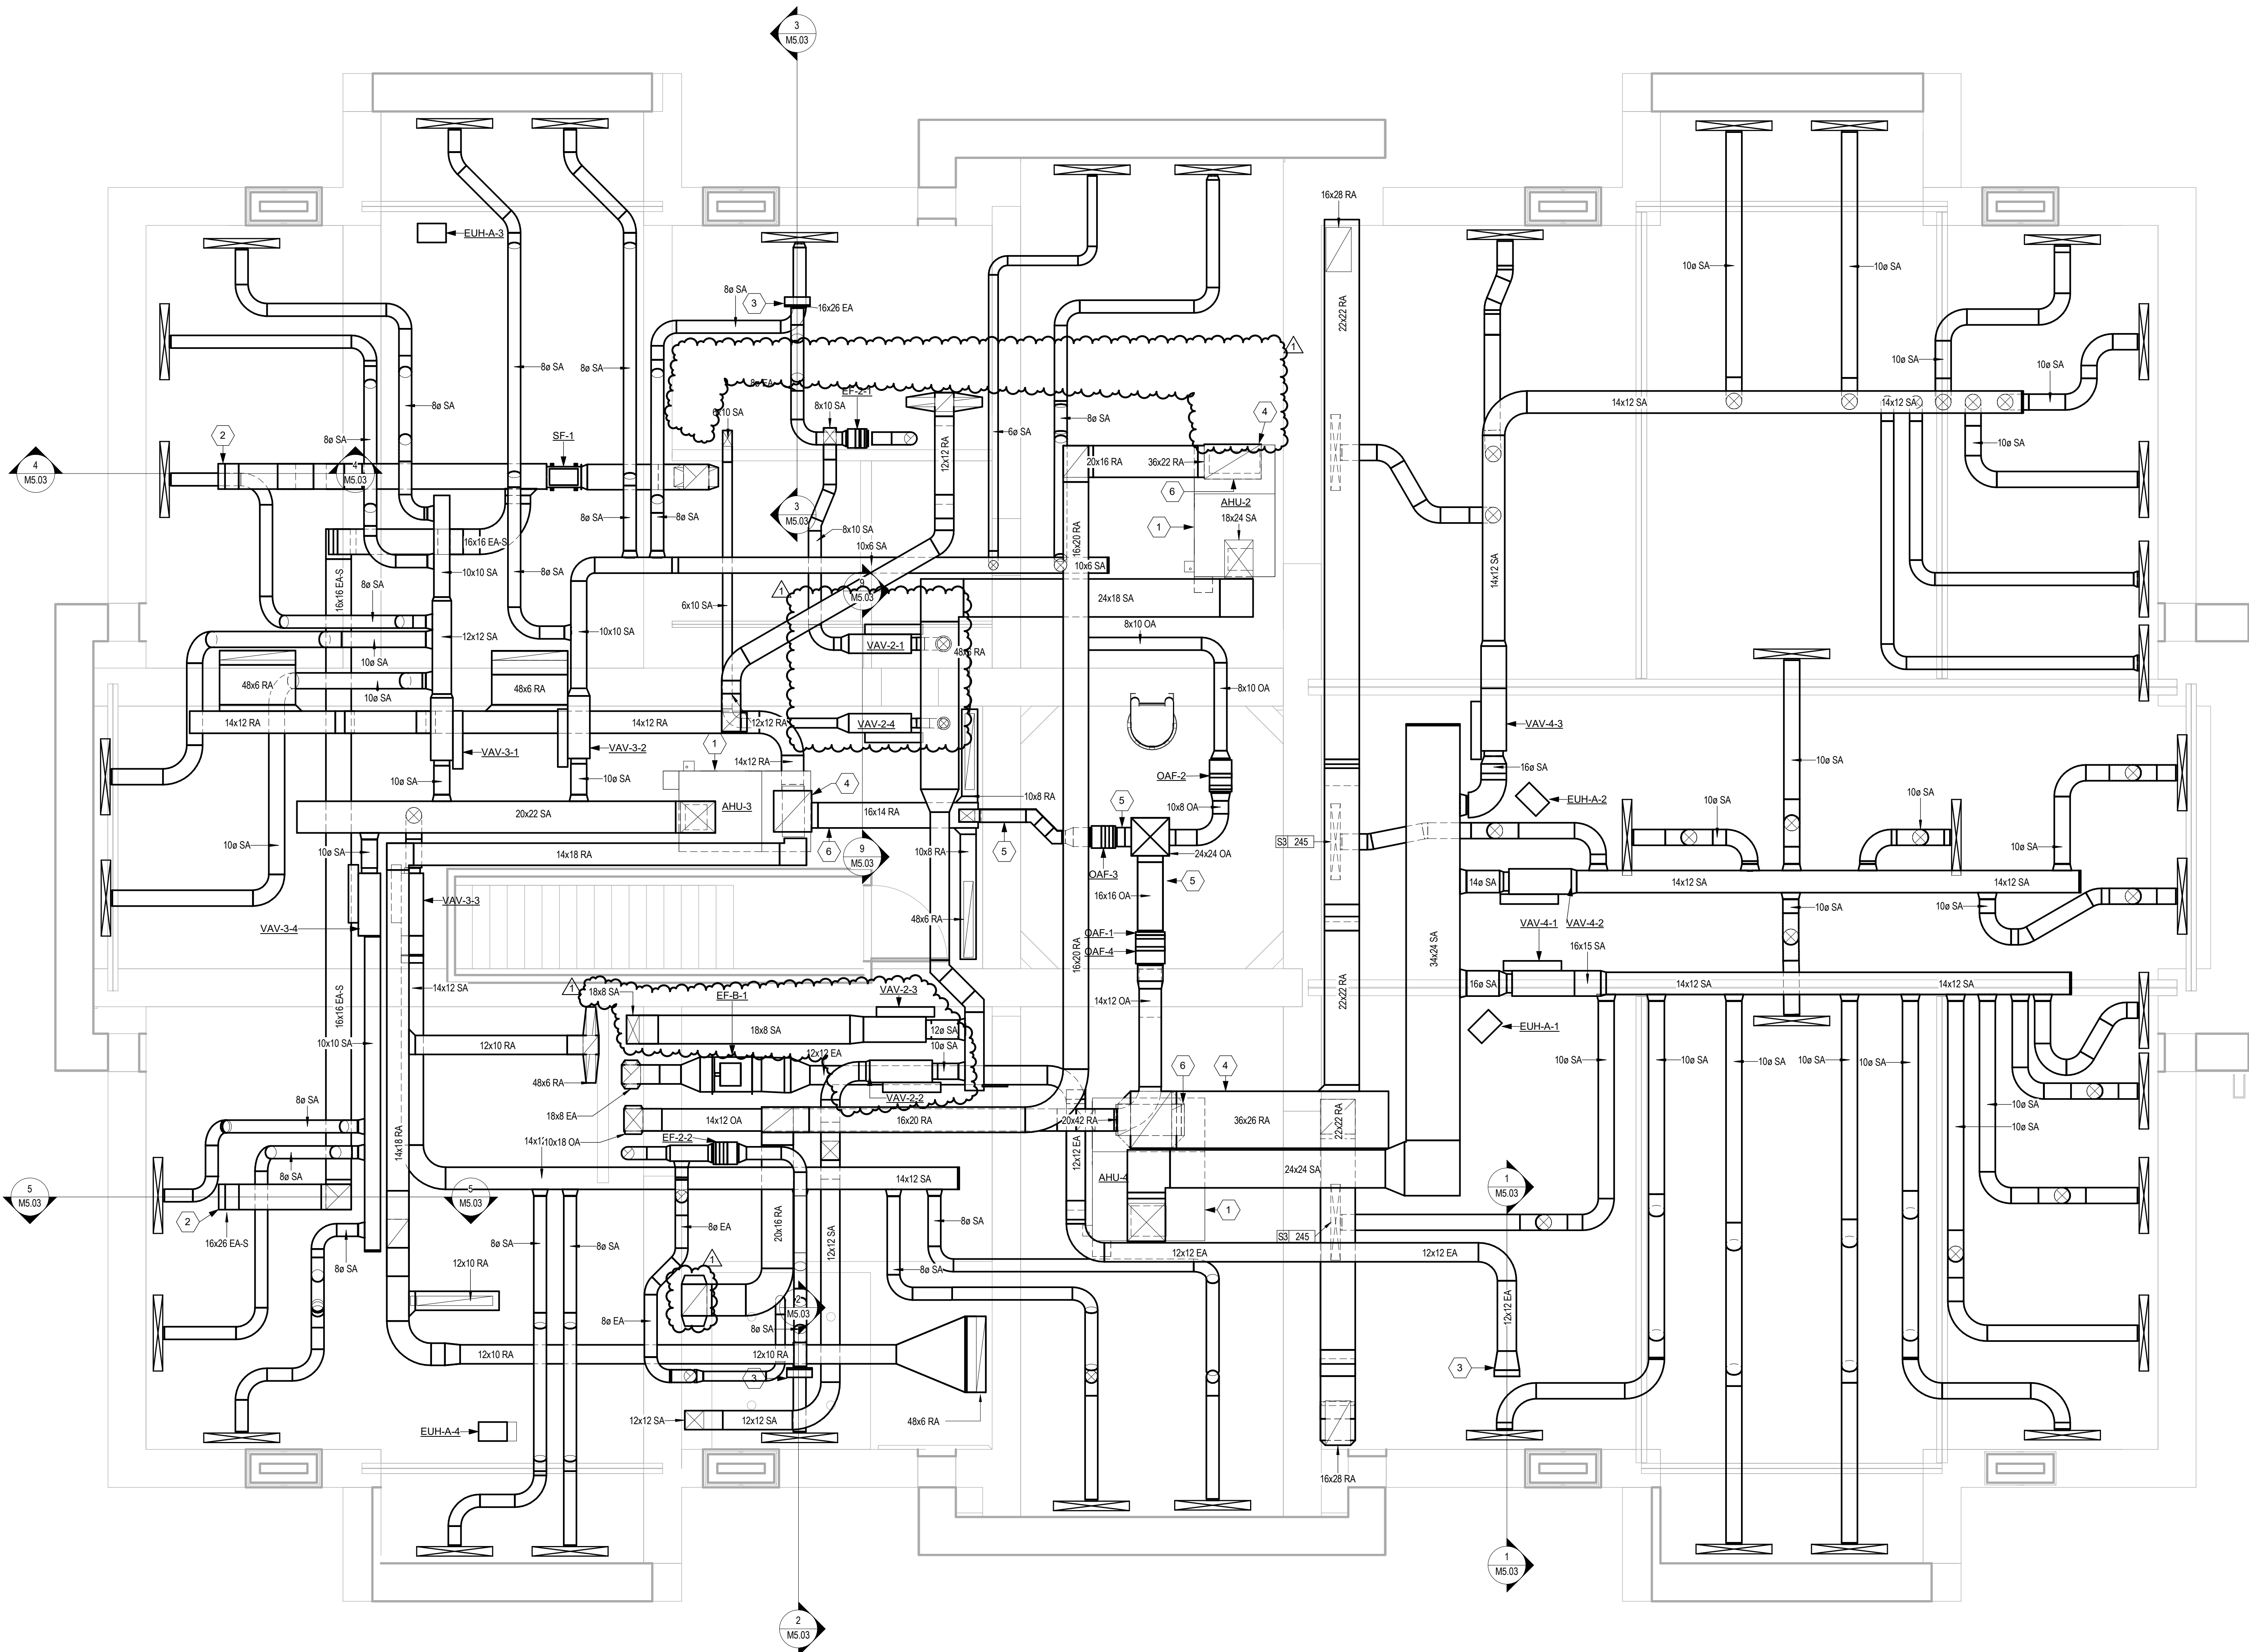

1 ATTIC LEVEL MECHANICAL FLOOR PLAN  
1/4" = 1'-0"




GENERAL NOTES

1. REFER TO M5.02 FOR ALL CHILLED WATER PIPE ACCESSORY (VALVE, STRAINERS, CHECK VALVES, ETC.) LOCATIONS.


2. CONTRACTOR TO CONFIRM REFRIGERANT PIPE SIZES WITH MANUFACTURER.

NOTES BY SYMBOL

1 PROVIDE BALL VALVES FOR EACH REFRIGERANT PIPE AT UNIT.

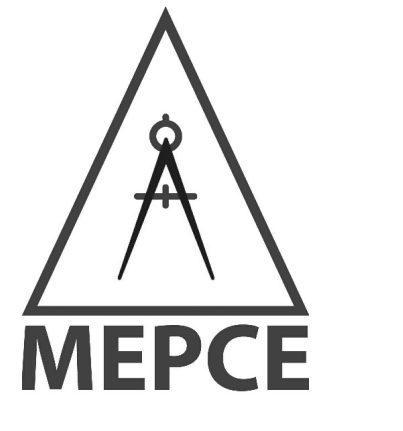

Engineering Firm: F-4050  
 Dallas/Fort Worth, Texas  
 www.mepce.com  
 972-870-0060  
 PROJECT CODE  
 17.022.003

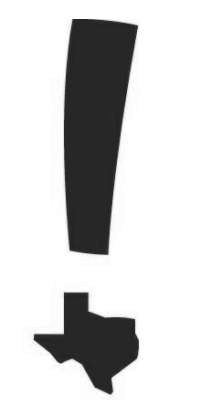


TEXAS HISTORICAL COMMISSION  
*real places telling real stories*



FANNIN COUNTY  
 COURTHOUSE  
 INTERIOR AND EXTERIOR  
 RESTORATION  
 101 E. Sam Rayburn Drive  
 Bonham, Texas 75418

COPYRIGHT  
 The Contractor shall verify and be responsible for all dimensions. DO NOT scale the drawing. Any errors or omissions shall be reported to Architexas without delay. The Copyrights to all designs and drawings are the property of Architexas. Reproduction or use for any purpose other than that authorized by Architexas is forbidden.

REVISION HISTORY  
 1 10/16/18 Addendum 1

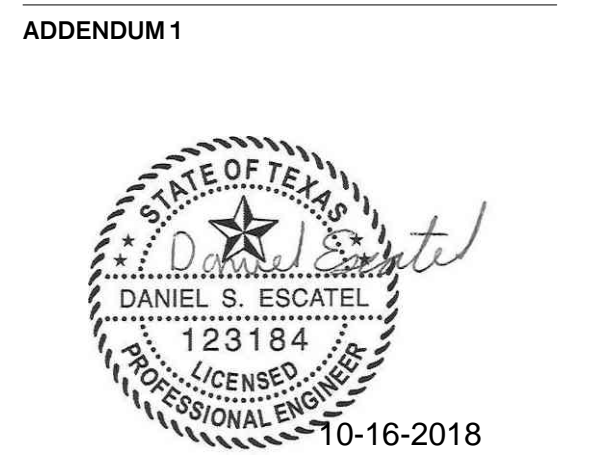


Architexas No. 1737 Date OCTOBER 16, 2018

Sheet Name BASEMENT LEVEL MECHANICAL PIPING FLOOR PLAN

Sheet Number

M3.00

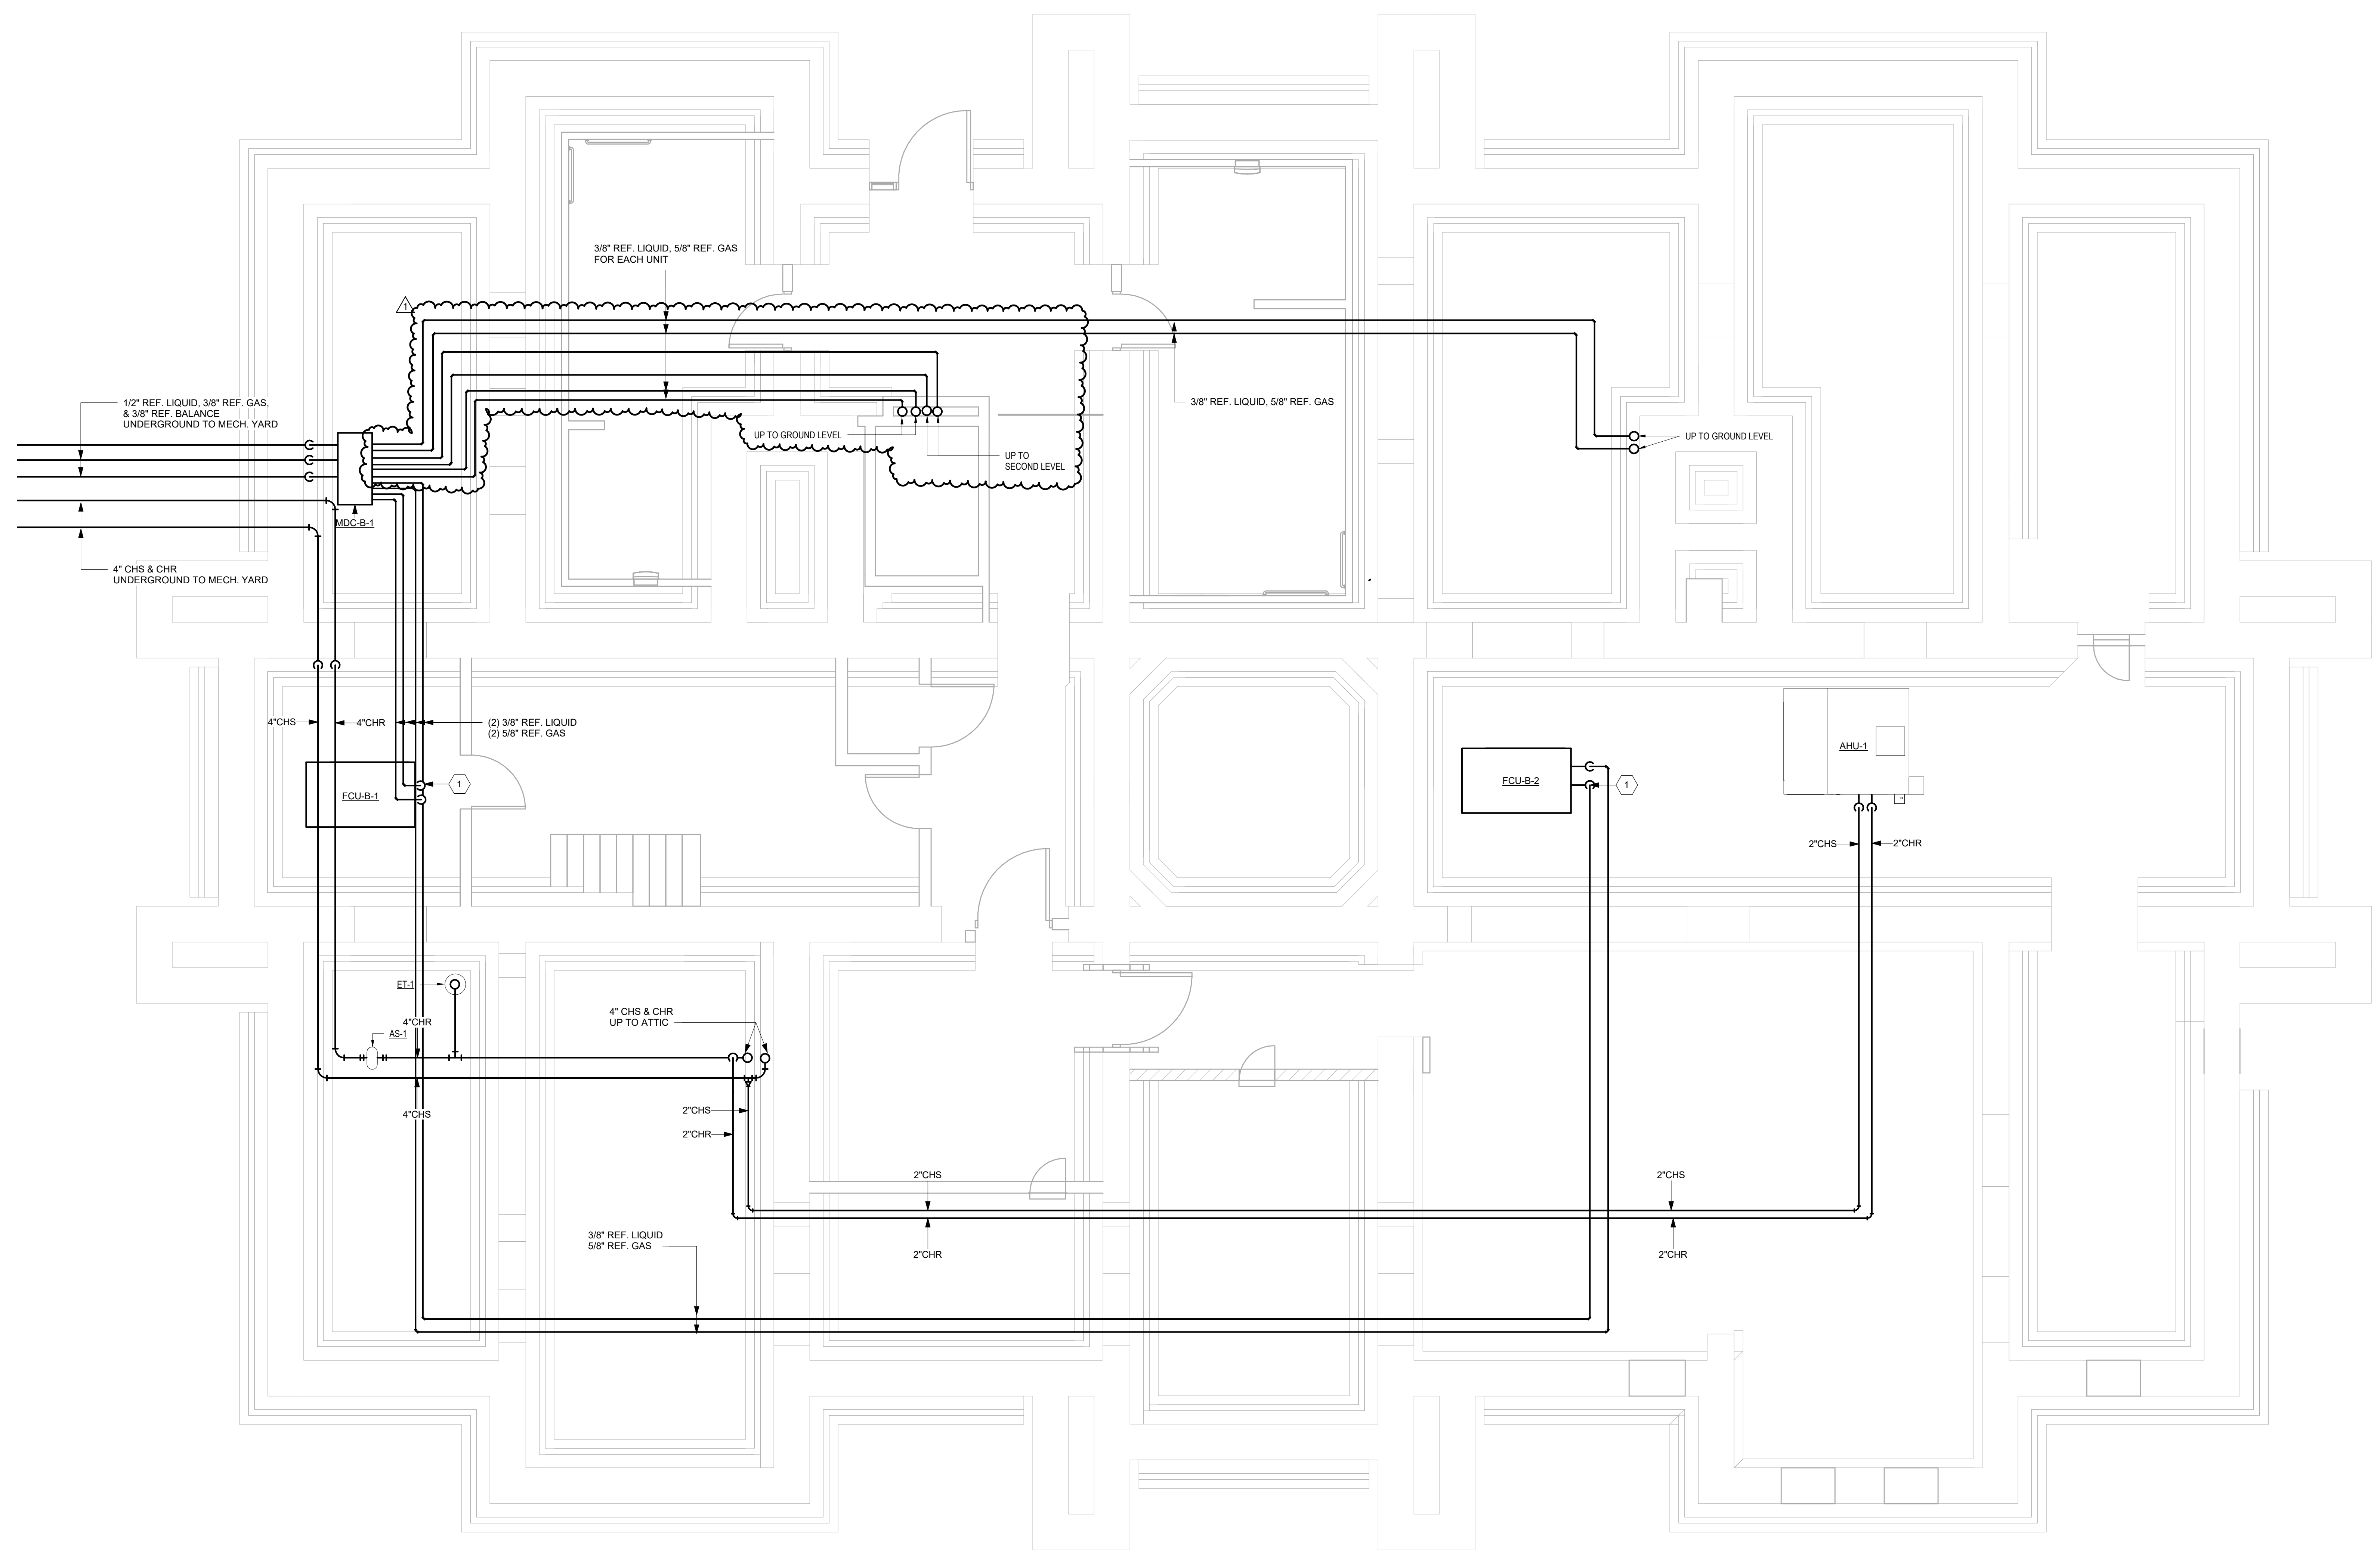

1 BASEMENT LEVEL MECHANICAL PIPING FLOOR PLAN  
 1/4" = 1'-0"



Engineering Firm: F-4050  
 Dallas/Fort Worth, Texas  
 www.mepce.com  
 972-870-0960

PROJECT CODE  
 17.022.003



TEXAS HISTORICAL COMMISSION  
*real places telling real stories*



FANNIN COUNTY  
 COURTHOUSE  
 INTERIOR AND EXTERIOR  
 RESTORATION  
 101 E. Sam Rayburn Drive  
 Bonham, Texas 75418

**COPYRIGHT**  
 The Contractor shall verify and be responsible for all dimensions. DO NOT scale the drawing. Any errors or omissions shall be reported to Architexas without delay. The Copyrights to all designs and drawings are the property of Architexas. Reproduction or use for any purpose other than that authorized by Architexas is forbidden.

**REVISION HISTORY**  
 1 10/16/18 Addendum 1

ADDENDUM 1




Architexas No. 1737 Date OCTOBER 16, 2018

Sheet Name GROUND LEVEL MECHANICAL PIPING FLOOR PLAN

Sheet Number M3.01

**GENERAL NOTES**  
 1. REFER TO M5.02 FOR ALL CHILLED WATER PIPE ACCESSORY (VALVE, STRAINERS, CHECK VALVES, ETC.) LOCATIONS.  
 2. CONTRACTOR TO CONFIRM REFRIGERANT PIPE SIZES WITH MANUFACTURER.

**NOTES BY SYMBOL**  
 1 PROVIDE BALL VALVES FOR EACH REFRIGERANT PIPE AT UNIT.  
 2 COORDINATE EXACT LOCATION OF FCU WITH I.T. ROOM WITH DATA EQUIPMENT.

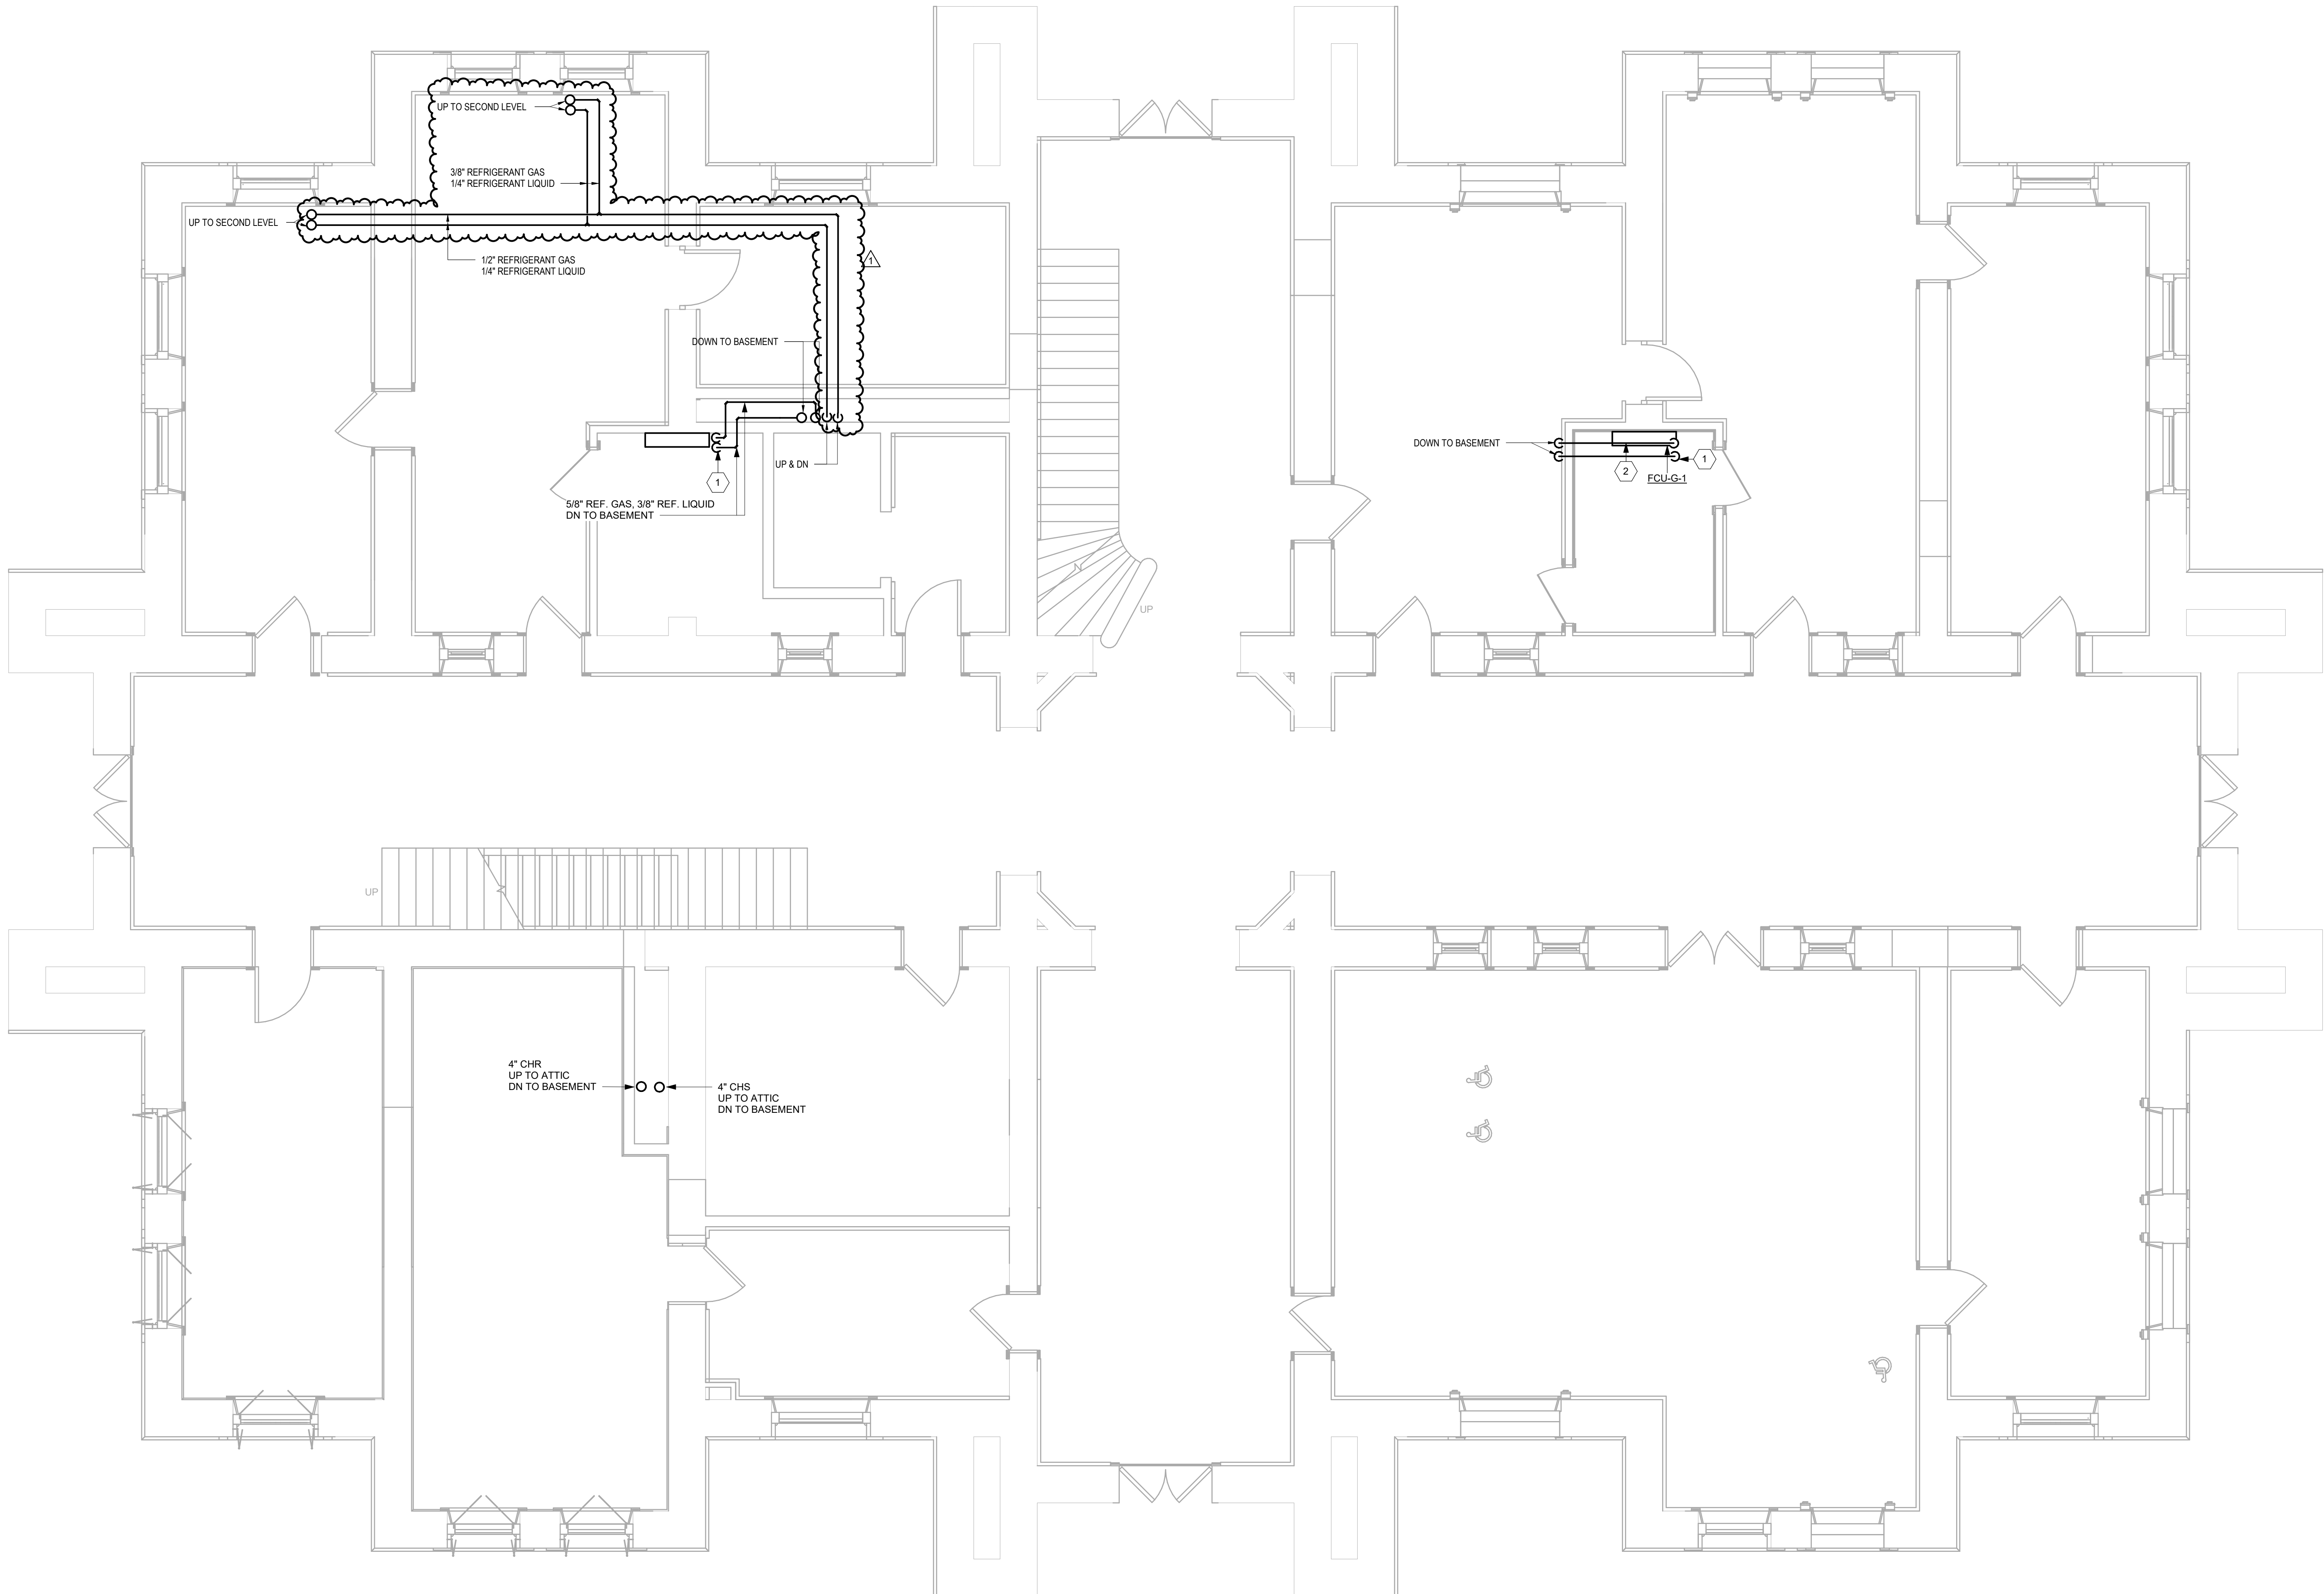


**GROUND LEVEL MECHANICAL PIPING FLOOR PLAN**  
 1/4" = 1'-0"




GENERAL NOTES  
 1. REFER TO M3.02 FOR ALL CHILLED WATER PIPE ACCESSORY (VALVE, STRAINERS, CHECK VALVES, ETC.) LOCATIONS.  
 2. CONTRACTOR TO CONFIRM REFRIGERANT PIPE SIZES WITH MANUFACTURER.

NOTES BY SYMBOL  
 1 PROVIDE BALL VALVES FOR EACH REFRIGERANT PIPE AT UNIT.

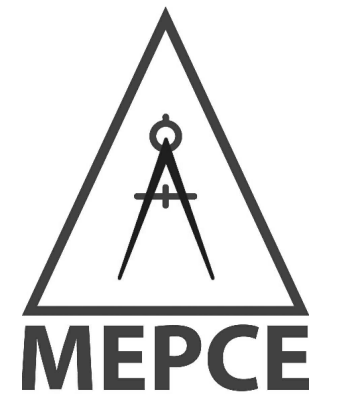

Engineering Firm: F-4050  
 Dallas/Fort Worth, Texas  
 www.mepce.com  
 972-870-0960  
 PROJECT CODE  
 17.022.003

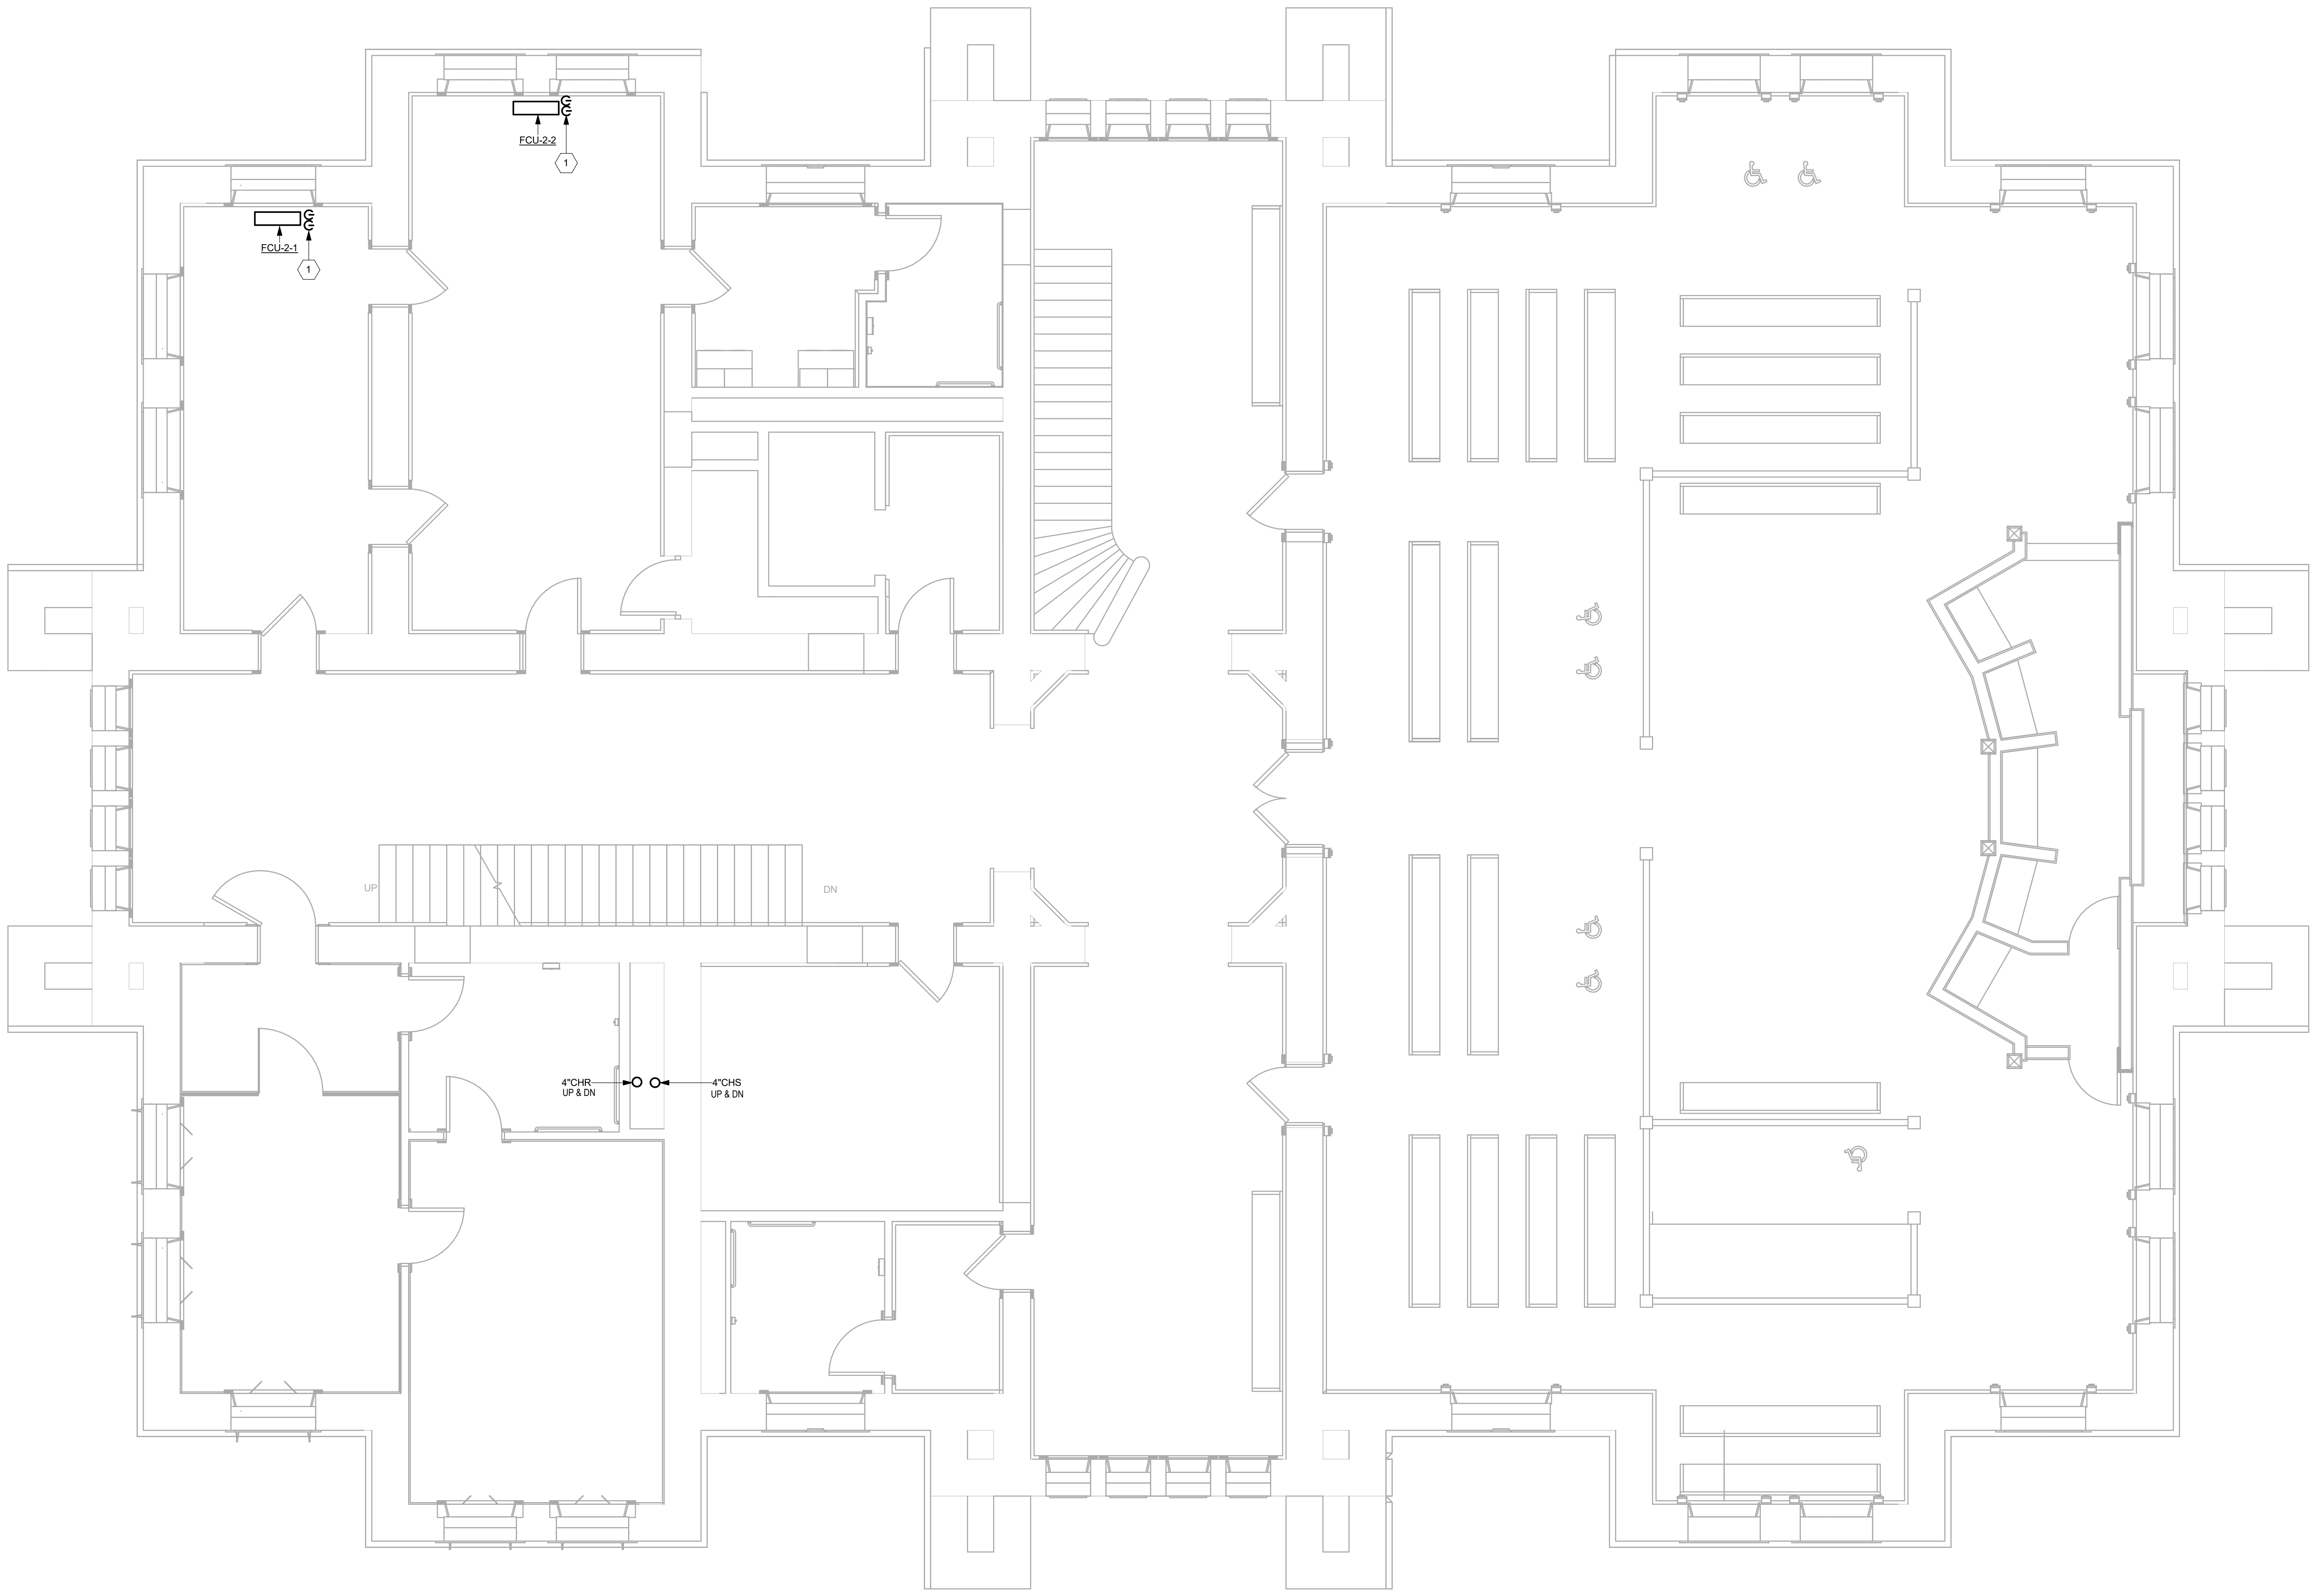


TEXAS HISTORICAL COMMISSION  
*real places telling real stories*



FANNIN COUNTY  
 COURTHOUSE  
 INTERIOR AND EXTERIOR  
 RESTORATION 101 E. Sam Rayburn Drive  
 Bonham, Texas 75418

COPYRIGHT  
 The Contractor shall verify and be responsible for all dimensions. DO NOT scale the drawing. Any errors or omissions shall be reported to Architexas without delay. The Copyrights to all designs and drawings are the property of Architexas. Reproduction or use for any purpose other than that authorized by Architexas is forbidden.

REVISION HISTORY  
 1 10/16/18 Addendum 1

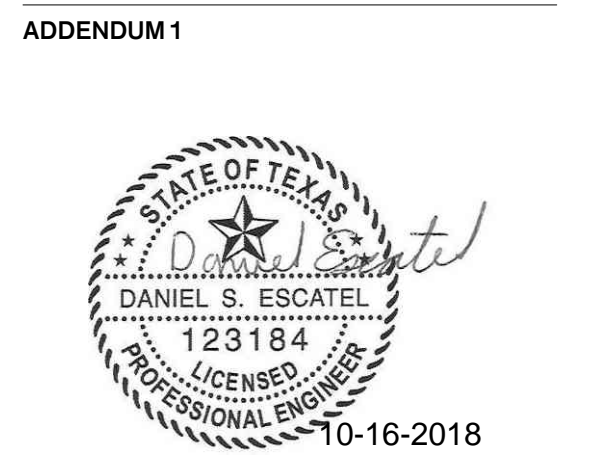

**1 SECOND LEVEL MECHANICAL PIPING FLOOR PLAN**  
 1/4" = 1'-0"

Architexas No. 1737 Date OCTOBER 16, 2018

Sheet Name  
 SECOND LEVEL MECHANICAL  
 PIPING FLOOR PLAN


Sheet Number  
 M3.02

GENERAL NOTES	
1	REFER TO M5.02 FOR ALL CHILLED WATER PIPE ACCESSORY (VALVE, STRAINERS, CHECK VALVES, ETC.) LOCATIONS.

NOTES BY SYMBOL	
1	PROVIDE HEAT TRACE FOR ALL ABOVE GROUND CHILLED WATER PIPING.
2	VFD SHALL BE MOUNTED TO UNI-STRUT FRAME IN A NEMA TYPE 3R ENCLOSURE. CONSULT WITH VFD MANUFACTURER FOR ENCLOSURE VENTING REQUIREMENTS.
3	4" TEMPORARY CONNECTIONS WITH GATE VALVE.
4	PROVIDE BALL VALVES FOR EACH REFRIGERANT PIPE AT UNIT.



Engineering Firm: F-4050  
 Dallas/Fort Worth, Texas  
 www.mepce.com  
 972-870-0060  
 PROJECT CODE  
 17.022.003

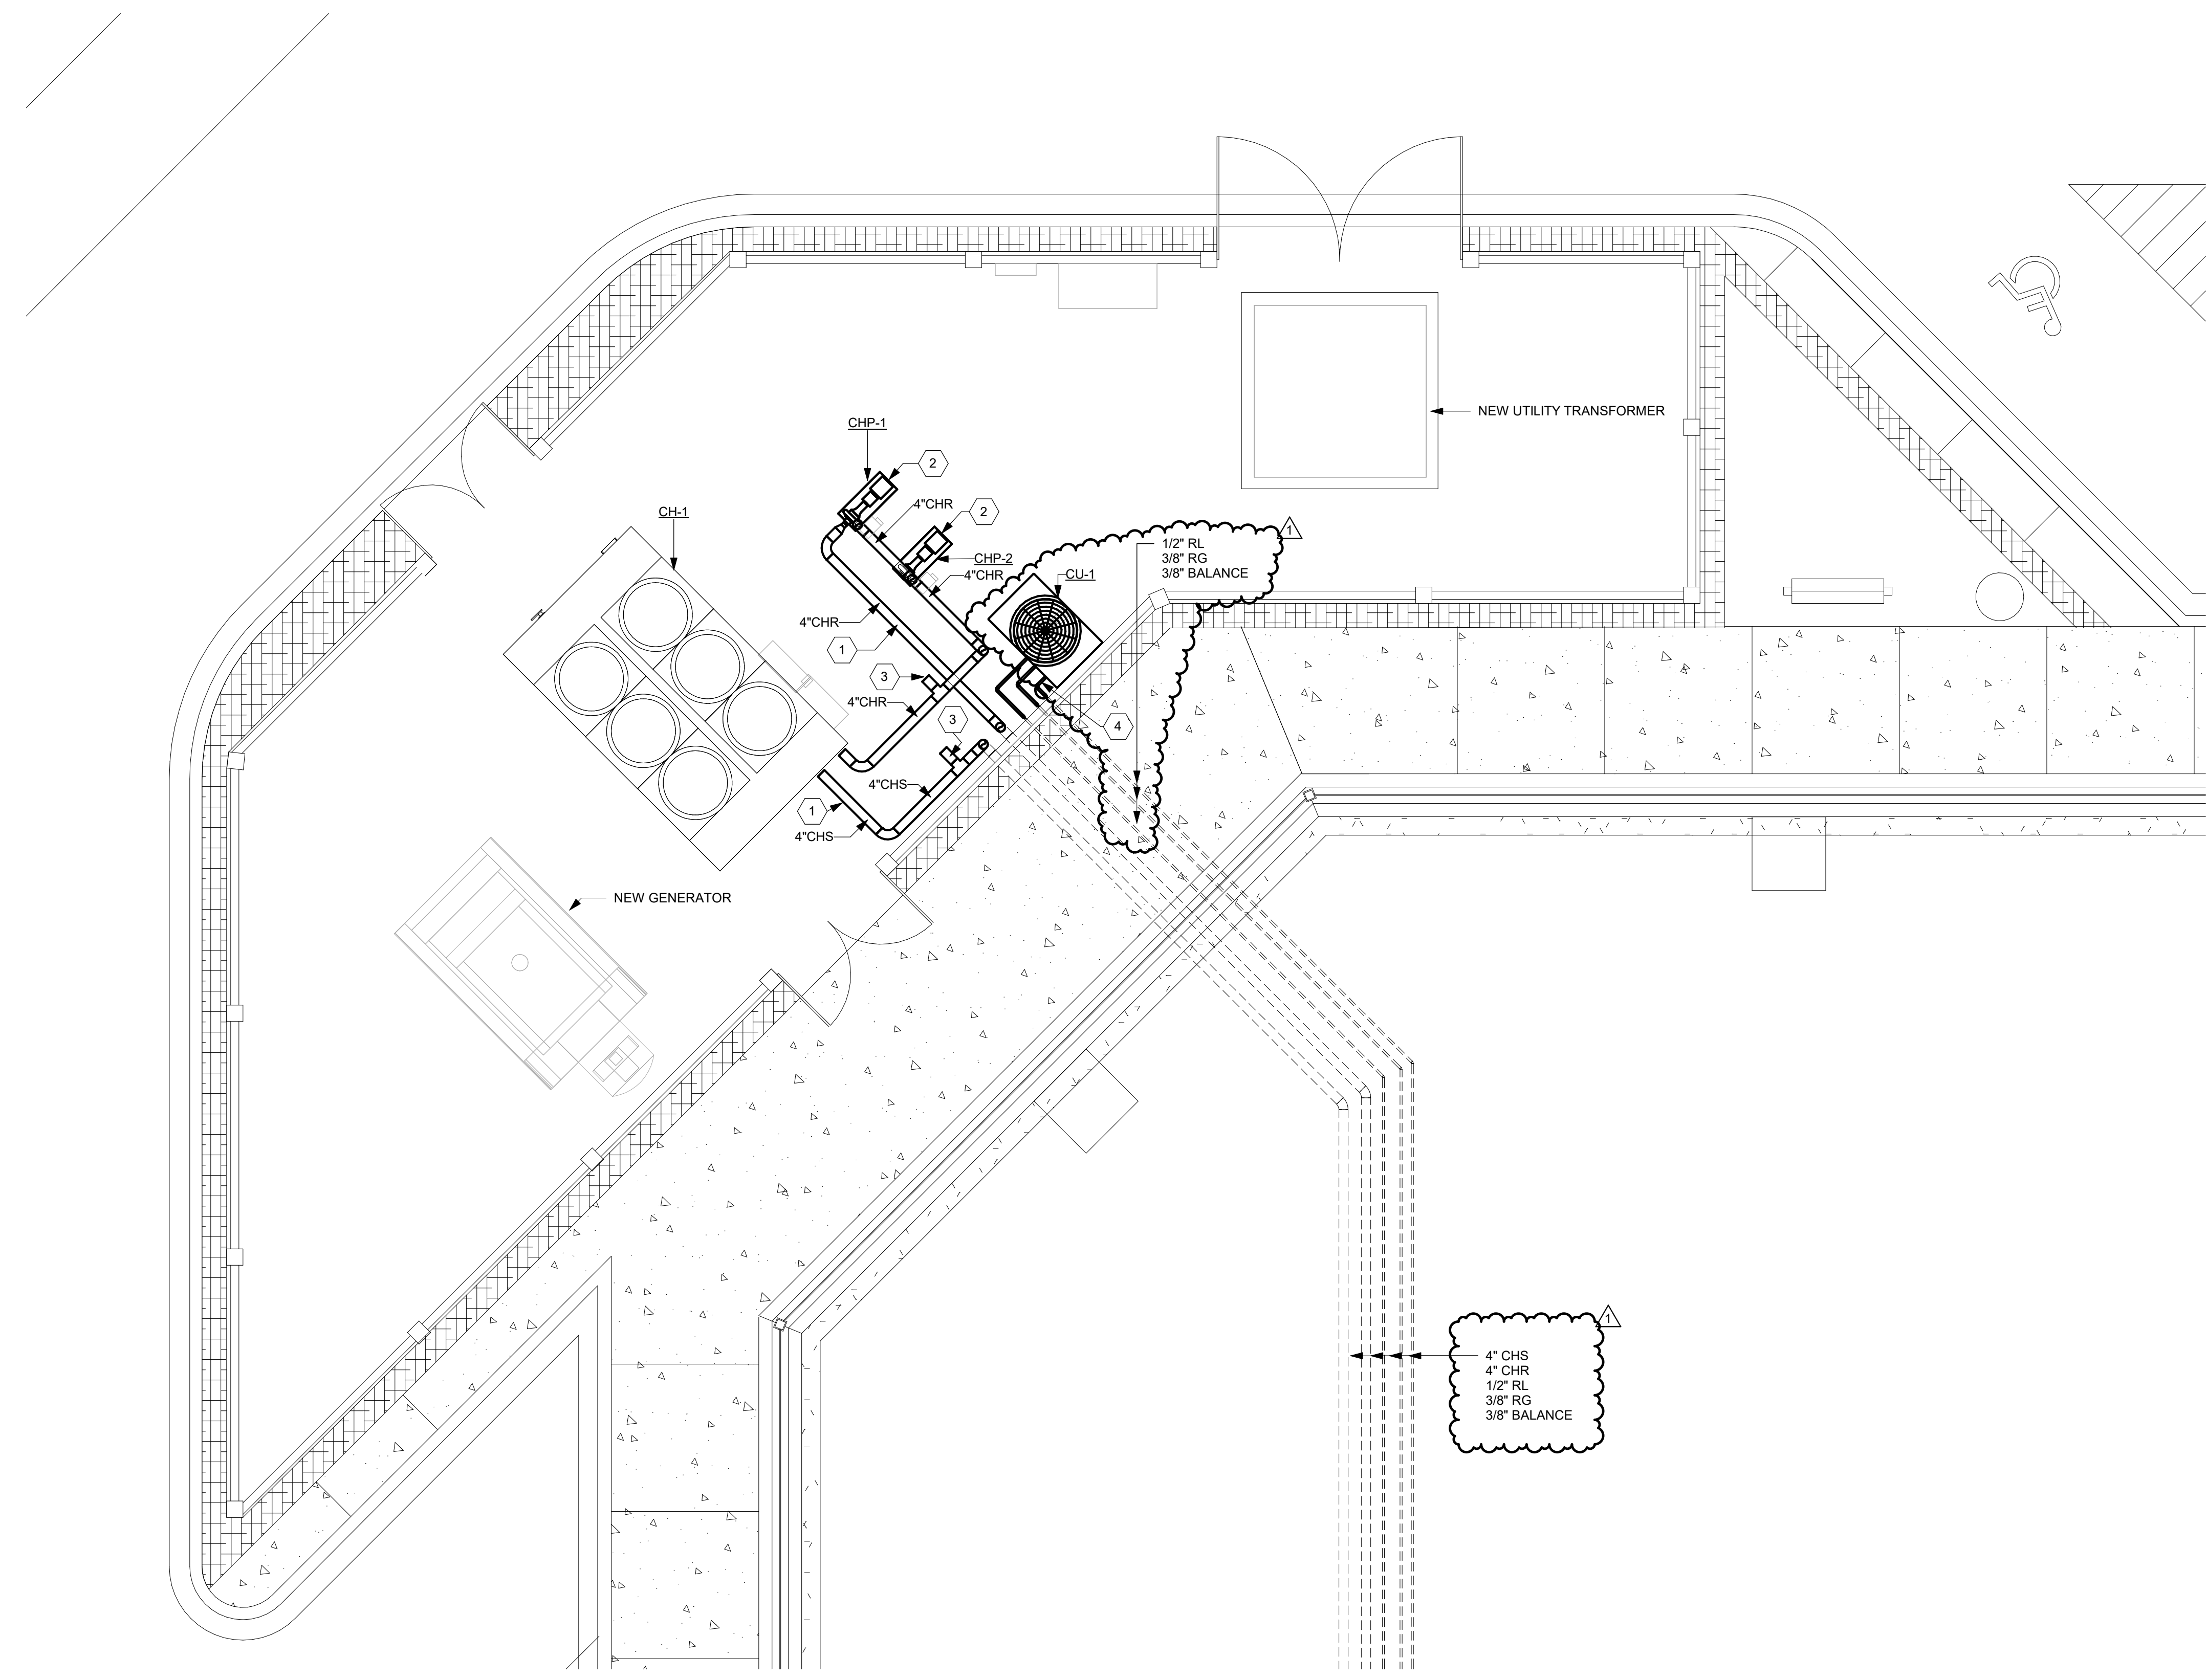


TEXAS HISTORICAL COMMISSION  
*real places telling real stories*



**FANNIN COUNTY COURTHOUSE**  
 INTERIOR AND EXTERIOR RESTORATION  
 101 E. Sam Rayburn Drive  
 Bonham, Texas 75418


**COPYRIGHT**  
 The Contractor shall verify and be responsible for all dimensions. DO NOT scale the drawing. Any errors or omissions shall be reported to Architexas without delay. The Copyrights to all designs and drawings are the property of Architexas. Reproduction or use for any purpose other than that authorized by Architexas is forbidden.

REVISION HISTORY	
1	10/16/18 Addendum 1

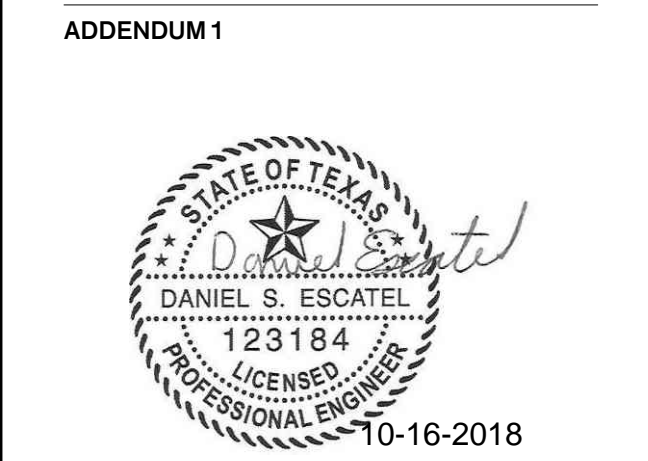

**MECHANICAL YARD ENLARGED PLAN**  
 1  
 1/4" = 1'-0"  
 TRUE NORTH



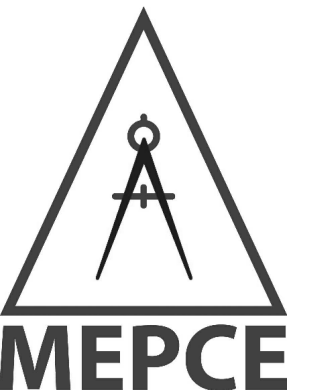

Engineering Firm: F-4050  
 Dallas/Fort Worth, Texas  
 www.mepce.com  
 972-870-0960

PROJECT CODE  
 17.022.003



TEXAS HISTORICAL COMMISSION  
 real places telling real stories



FANNIN COUNTY  
 COURTHOUSE  
 INTERIOR AND EXTERIOR  
 RESTORATION  
 101 E. Sam Rayburn Drive  
 Bonham, Texas 75418

COPYRIGHT  
 The Contractor shall verify and be responsible for all dimensions. DO NOT scale the drawing. Any errors or omissions shall be reported to Architexas without delay. The Copyrights to all designs and drawings are the property of Architexas. Reproduction or use for any purpose other than that authorized by Architexas is forbidden.

REVISION HISTORY  
 1 10/16/18 Addendum 1

ADDENDUM 1



Architexas No. 1737 Date OCTOBER 16, 2018  
 Sheet Name MECHANICAL SCHEDULES

Sheet Number

### AIR HANDLING UNIT SCHEDULE

TAG	TYPE	SUPPLY AIR (CFM)	OUTSIDE AIR (CFM)	ESP (IN. WC)	FAN DRIVE TYPE	FAN QTY	BHP	HP	COOLING COIL						ELECTRICAL DATA				OPERATING WEIGHT (LBS.)	MANUFACTURER	MODEL NO.				
									SUPPLY AIR (CFM)	SENSIBLE CAPACITY (MBH)	TOTAL CAPACITY (MBH)	ENTERING AIR TEMPERATURE (DB°F/WB°F)	LEAVING AIR TEMPERATURE (DB°F/WB°F)	ENTERING WATER TEMPERATURE (°F)	LEAVING WATER TEMPERATURE (°F)	GPM	MAX COIL FACE VELOCITY (FPS)	MAX ROWS				MAX FINS/IN.	VOLTAGE / PHASE	MCA	MOCP
AHU-1	VAV	5800	850	2.5	DIRECT	1	8.2	10	5800	186.1	233.3	80.5 / 64.7	51.3 / 50.8	42	52	46.5	500	6	9	208 / 3	53	90	1500	TRANE	UCCAG12A
AHU-2	VAV	3050	330	2.5	DIRECT	1	5.2	7.5	3300	95.4	111.8	79.4 / 64.0	52.2 / 51.8	42	52	22.3	500	6	9	208 / 3	35.5	60	1200	TRANE	UCCA08A
AHU-3	VAV	2800	230	2.5	DIRECT	1	4.2	5.0	2800	81.6	93.4	78.1 / 63.9	51.5 / 51.2	42	52	18.6	500	6	9	208 / 3	28.0	50	1100	TRANE	UCCA08A
AHU-4	VAV	6100	1150	2.5	DIRECT	1	7.0	7.5	6100	199.4	272.6	81.7 / 66.4	52.0 / 51.4	42	52	54.3	500	6	8.6	208 / 3	35	60	1600	TRANE	CSAA

1. PROVIDE ALL UNITS WITH UNIT MOUNTED VARIABLE FREQUENCY DRIVE.
2. ECONOMIZER REQUIREMENT OF 2018 IECC DOES NOT APPLY PER C501.6. TEXAS HISTORIC COMMISSION MAY PROVIDE LETTER TO STATING THE DEGRADATION TO THE HISTORIC FANNIN COUNTY COURT HOUSE BUILDING IF LOUVERS ARE INSTALLED TO COMPLY WITH THE ECONOMIZER REQUIREMENT.

### DX FAN COIL SYSTEM SCHEDULE

INDOOR UNIT													OUTDOOR UNIT														
MARK	NOMINAL TONNAGE	SUPPLY AIR (CFM)	ESP (IN. WC)	FAN MOTOR (W)	GROSS COOLING PERFORMANCE			HEATING PERFORMANCE		ELECTRICAL DATA				MANUFACTURER	MODEL	NOTES	MARK	NOMINAL TONNAGE	COOLING PERFORMANCE		ELECTRICAL DATA				MANUFACTURER	MODEL	NOTES
					SENSIBLE (MBH)	TOTAL (MBH)	ENTERING CONDITIONS (DB°F/WB°F)	TOTAL (MBH)	VOLTAGE	PH	MCA	MOCP	CAPACITY (MBH)						AMBIENT AIR TEMPERATURE (°F)	VOLTAGE	PH	MCA	MOCP				
FCU-B-1	2.0	525	0.8	750	14.9	24.0	85/67	27.0	208	1	5.7	15	TOSHIBA	MMD4													
FCU-B-2	2.0	525	0.8	750	14.9	24.0	85/67	27.0	208	1	5.7	15	TOSHIBA	MMD4													
FCU-G-1	0.6	320	0.04	20	5.9	7.9	75/63	-	208	1	0.45	15	TOSHIBA	MMK3		CU-1	8	96.000	105	208	1	36	40	TOSHIBA	MMYH		
FCU-G-2	0.6	320	0.04	20	5.9	7.9	75/63	-	208	1	0.45	15	TOSHIBA	MMK3													
FCU-2-1	1.5	550	0.04	20	5.9	7.9	75/63	20	208	1	0.7	15	TOSHIBA	MML-AP													
FCU-2-2	1.0	460	0.04	20	5.9	7.9	75/63	13.5	208	1	0.6	15	TOSHIBA	MML-AP													
MDC-B-1									208	1	0.73	-	TOSHIBA	RBM													

1. PROVIDE AND INSTALL CONDENSATE FLOAT SWITCH IN CONDENSATE DRAIN PAN FOR HEAT PUMPS. FLOAT SWITCH SHALL DE-ENERGIZE UNIT IF CONDENSATE DRAIN LINE BECOMES BLOCKED.
2. PROVIDE AND INSTALL HAIL GUARDS ON HEAT PUMPS.
3. PROVIDE AND INSTALL 7-DAY PROGRAMMABLE THERMOSTAT FOR EACH HEAT PUMP.
4. UNITS FCU-G-1 AND FCU-G-2 SHALL BE COOLING ONLY.
5. CONTRACTOR TO VERIFY ALL REFRIGERANT PIPE SIZE WITH MANUFACTURER.
6. CONTRACTOR TO VERIFY THAT INSTALLATION OF ALL REFRIGERANT EQUIPMENT IS IN COMPLIANCE WITH ASHRAE 15.

### AIR DEVICE SCHEDULE

MARK	TYPE	DESCRIPTION	NECK SIZE (IN)	MANUFACTURER / MODEL NUMBER	MATERIAL
S1	SUPPLY	SIDE WALL DIFFUSER	SEE DRAWINGS	TITUS / 300RL	STEEL
S2	SUPPLY	FLOOR SUPPLY	18" x 12"	PRICE / LMBH	STEEL
S3	SUPPLY	LINEAR SLOT DIFFUSER	48" x 6"	TITUS / FL-10	ALUMINUM
S4	SUPPLY	LINEAR SLOT DIFFUSER	24" x 6"	TITUS / FL-10	ALUMINUM
S5	SUPPLY	12" x 12", 4-WAY THROW, THREE CONES	SEE NOTE 3	TITUS/TMS	STEEL
E1	EXHAUST	SIDE WALL DIFFUSER	SEE DRAWINGS	TITUS / 300RL	STEEL
E2	EXHAUST	PERFORATED CEILING DIFFUSER	SEE NOTE 3	TITUS/PAR	STEEL
R1	RETURN	SIDE WALL DIFFUSER	SEE DRAWINGS	TITUS / 300RL	STEEL
R2	RETURN	FLOOR RETURN	24" x 12"	PRICE/LMBH	STEEL
R3	RETURN	FLOOR RETURN	36" x 12"	PRICE/LMBH	STEEL
R4	RETURN	CEILING RETURN	24" x 6"	TITUS/50F	STEEL
R5	RETURN	CEILING RETURN	48" x 6"	TITUS/50F	STEEL

1. DEVICES SHALL BE FURNISHED WITH APPROPRIATE FRAMES, ETC. FOR MOUNTING IN RESPECTIVE CEILING TYPES.
2. SOUND VALUES SHALL NOT EXCEED 30 NC, UNLESS OTHERWISE NOTED.
3. SEE AIR DEVICE RUN-OUT SCHEDULE ON THIS SHEET.
3. FLOOR SUPPLY AND RETURN DIFFUSERS SHALL BE PENCIL AND HEEL PROOF.

### AIR DEVICE RUN-OUT SIZING

SUPPLY DUCTWORK		RETURN/EXHAUST DUCTWORK	
RUNOUT CFM	RUNOUT Ø	RUNOUT CFM	RUNOUT Ø
0-100	6"	0-75	6"
101-210	8"	76-170	8"
211-380	10"	171-310	10"
381-630	12"	311-500	12"
631-950	14"	501-770	14"
951-1400	16"	771-1100	16"
1401-1800	18"	1101-1500	18"

1. NECK SIZE SHALL BE THE SAME AS THE RUN-OUT SIZE.

### VAV TERMINAL BOX W/ ELECTRIC RE-HEAT SCHEDULE

TAG	SIZE	INLET SIZE (IN.)	MAX. AIR PRESSURE DROP (IN. WC)	MAX NOISE CRITERIA (NC)	COOLING		ELECTRIC HEATING COIL				ELECTRICAL			MANUFACTURER	MODEL NUMBER	
					SUPPLY AIR (CFM)	MIN. SUPPLY AIR (CFM)	SUPPLY AIR (CFM)	TOTAL CAPACITY (KW)	ENTERING AIR TEMPERATURE (°F)	LEAVING AIR TEMPERATURE (°F)	STAGES	VOLTS/PH	MCA			MOP
VAV-1-1	-	10	-	30	875	430	430	4.5	60	93.1	SCR	208/1	27	30	TITUS	DESV
VAV-1-2	-	8	-	30	270	180	180	2	60	95.1	SCR	208/1	12	15	TITUS	DESV
VAV-1-3	-	8	-	30	435	270	270	2.5	60	89.3	SCR	208/1	15	15	TITUS	DESV
VAV-1-4	-	8	-	30	320	290	290	3	60	92.7	SCR	208/1	18	20	TITUS	DESV
VAV-1-5	-	8	-	30	680	280	280	3	60	93.9	SCR	208/1	18	20	TITUS	DESV
VAV-1-6	-	8	-	30	700	310	310	3	60	88.7	SCR	208/1	18	20	TITUS	DESV
VAV-1-7	-	12	-	30	1225	635	635	6	60	89.9	SCR	208/1	36.1	40	TITUS	DESV
VAV-1-8	-	8	-	30	360	260	260	2.5	60	90.4	SCR	208/1	15	15	TITUS	DESV
VAV-1-9	-	8	-	30	430	210	210	2	60	90.1	SCR	208/1	12	15	TITUS	DESV
VAV-1-10	-	8	-	30	680	295	295	3	60	92.1	SCR	208/1	18	20	TITUS	DESV
VAV-2-1	-	8	-	30	455	345	345	3.5	60	92.1	SCR	208/1	21	25	TITUS	DESV
VAV-2-2	-	10	-	30	985	430	430	4.5	60	93.1	SCR	208/1	27	30	TITUS	DESV
VAV-2-3	-	12	-	30	1385	390	390	4.0	60	91.6	SCR	208/1	24	25	TITUS	DESV
VAV-2-4	-	6	-	30	225	100	100	1.0	60	91.6	SCR	208/1	6.0	15	TITUS	DESV
VAV-3-1	-	10	-	30	910	460	590	4.5	60	90.9	SCR	208/1	36.1	40	TITUS	DESV
VAV-3-2	-	10	-	30	690	450	450	4.5	60	91.6	SCR	208/1	27	30	TITUS	DESV
VAV-3-3	-	10	-	30	920	490	490	4.5	60	90.9	SCR	208/1	27	30	TITUS	DESV
VAV-3-4	-	8	-	30	520	340	340	3.5	60	92.5	SCR	208/1	21	25	TITUS	DESV
VAV-4-1	-	16	-	30	2205	1100	650	9.5	60	91.6	SCR	208/1	57.1	60	TITUS	DESV
VAV-4-2	-	14	-	30	1715	860	650	8.5	60	91.6	SCR	208/1	51.1	60	TITUS	DESV
VAV-4-3	-	16	-	30	2205	995	650	9.5	60	91.6	SCR	208/1	57.1	60	TITUS	DESV

1. MAXIMUM N.C. RELATES TO DISCHARGE AT 1.0" STATIC PRESSURE.
2. PROVIDE DIRECT DIGITAL CONTROLS AND SEQUENCE OF OPERATION AS PER CONTROL DIAGRAMS.
3. PROVIDE FACTORY MOUNTED AND WIRED DISCONNECT SWITCH.
4. TEST AND BALANCE CONTRACTOR SHALL BALANCE ALL VAV BOXES TO SUPPLY AIR CFM COLUMN.





Engineering Firm: F-4050  
Dallas/Fort Worth, Texas  
www.mepce.com  
972-870-0060

PROJECT CODE  
17.022.003




TEXAS HISTORICAL COMMISSION  
real places telling real stories



FANNIN COUNTY  
COURTHOUSE  
INTERIOR AND EXTERIOR  
RESTORATION  
101 E. Sam Rayburn Drive  
Bonham, Texas 75418

**COPYRIGHT**  
The Contractor shall verify and be responsible for all dimensions. DO NOT scale the drawing. Any errors or omissions shall be reported to Architexas without delay. The Copyrights to all designs and drawings are the property of Architexas. Reproduction or use for any purpose other than that authorized by Architexas is forbidden.

**REVISION HISTORY**  
1 10/16/18 Addendum 1

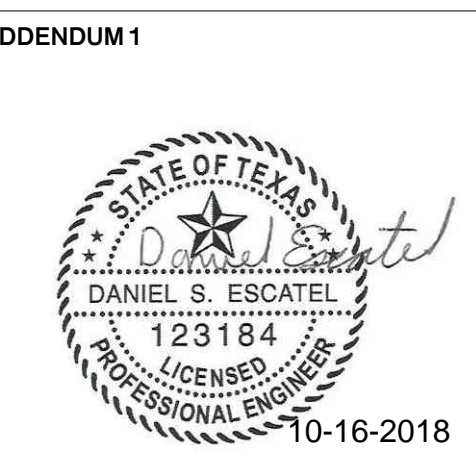


Architexas No. 1737 Date OCTOBER 16, 2018

Sheet Name Basement Level Plumbing Floor Plans


Sheet Number P2.01

**GENERAL NOTES**


1. FINAL LOCATION OF DEVICES, FIXTURES, EQUIPMENT, AND RECEPTACLES TO BE REVIEWED AND APPROVED BY ARCHITECT AND THE REPRESENTATIVE PRIOR TO COMMENCEMENT OF WORK AND INSTALLATION.
2. CONTRACTOR SHALL FIELD COORDINATE ALL UNDERGROUND PIPING WITH MECHANICAL, ELECTRICAL, CIVIL, AND LANDSCAPING DISCIPLINES. NEARBY FIRE HYDRANT FLOW TEST PER BONHAM FIRE DEPARTMENT - STATIC PRESSURE = 60 PSI, RESIDUAL PRESSURE = 50 PSI AND PITOT = 40 PSI. FIRE HYDRANT FLOW TEST TAKEN 4/25/2018.
3. CONTRACTOR SHALL SAW-CUT ALL SLAB PENETRATIONS AND ENSURE THAT THEY ARE PROPERLY SEALED AND REMAIN WATERTIGHT. REFER TO BELOW BASEMENT LEVEL FLOOR PLAN FOR SLAB TRENCHING LOCATIONS (HATCHED AREAS).
4. PROVIDE BELOW SLAB PIPE HANGER SYSTEM FOR ALL WASTE PIPING SHOWN ON BELOW BASEMENT LEVEL PLUMBING WASTE AND VENT FLOOR PLAN. REFER TO DETAIL 10 ON SHEET P4.01 FOR MORE INFORMATION.
5. ALL ABOVEGROUND COLD WATER, HOT WATER, HOT WATER RETURN PIPING SHALL BE ROUTED AS HIGH AS POSSIBLE ABOVE CEILINGS.
6. CONNECT 1" CD PIPING TO EACH AIR HANDLING UNIT. FURNISH EACH AIR HANDLING UNIT WITH VENTED P-TRAP PRIOR TO CONNECTION. PROVIDE WYE FITTINGS AND LONG RADIUS ELBOWS FOR ALL WASTE PIPING.
- 7.
- 8.

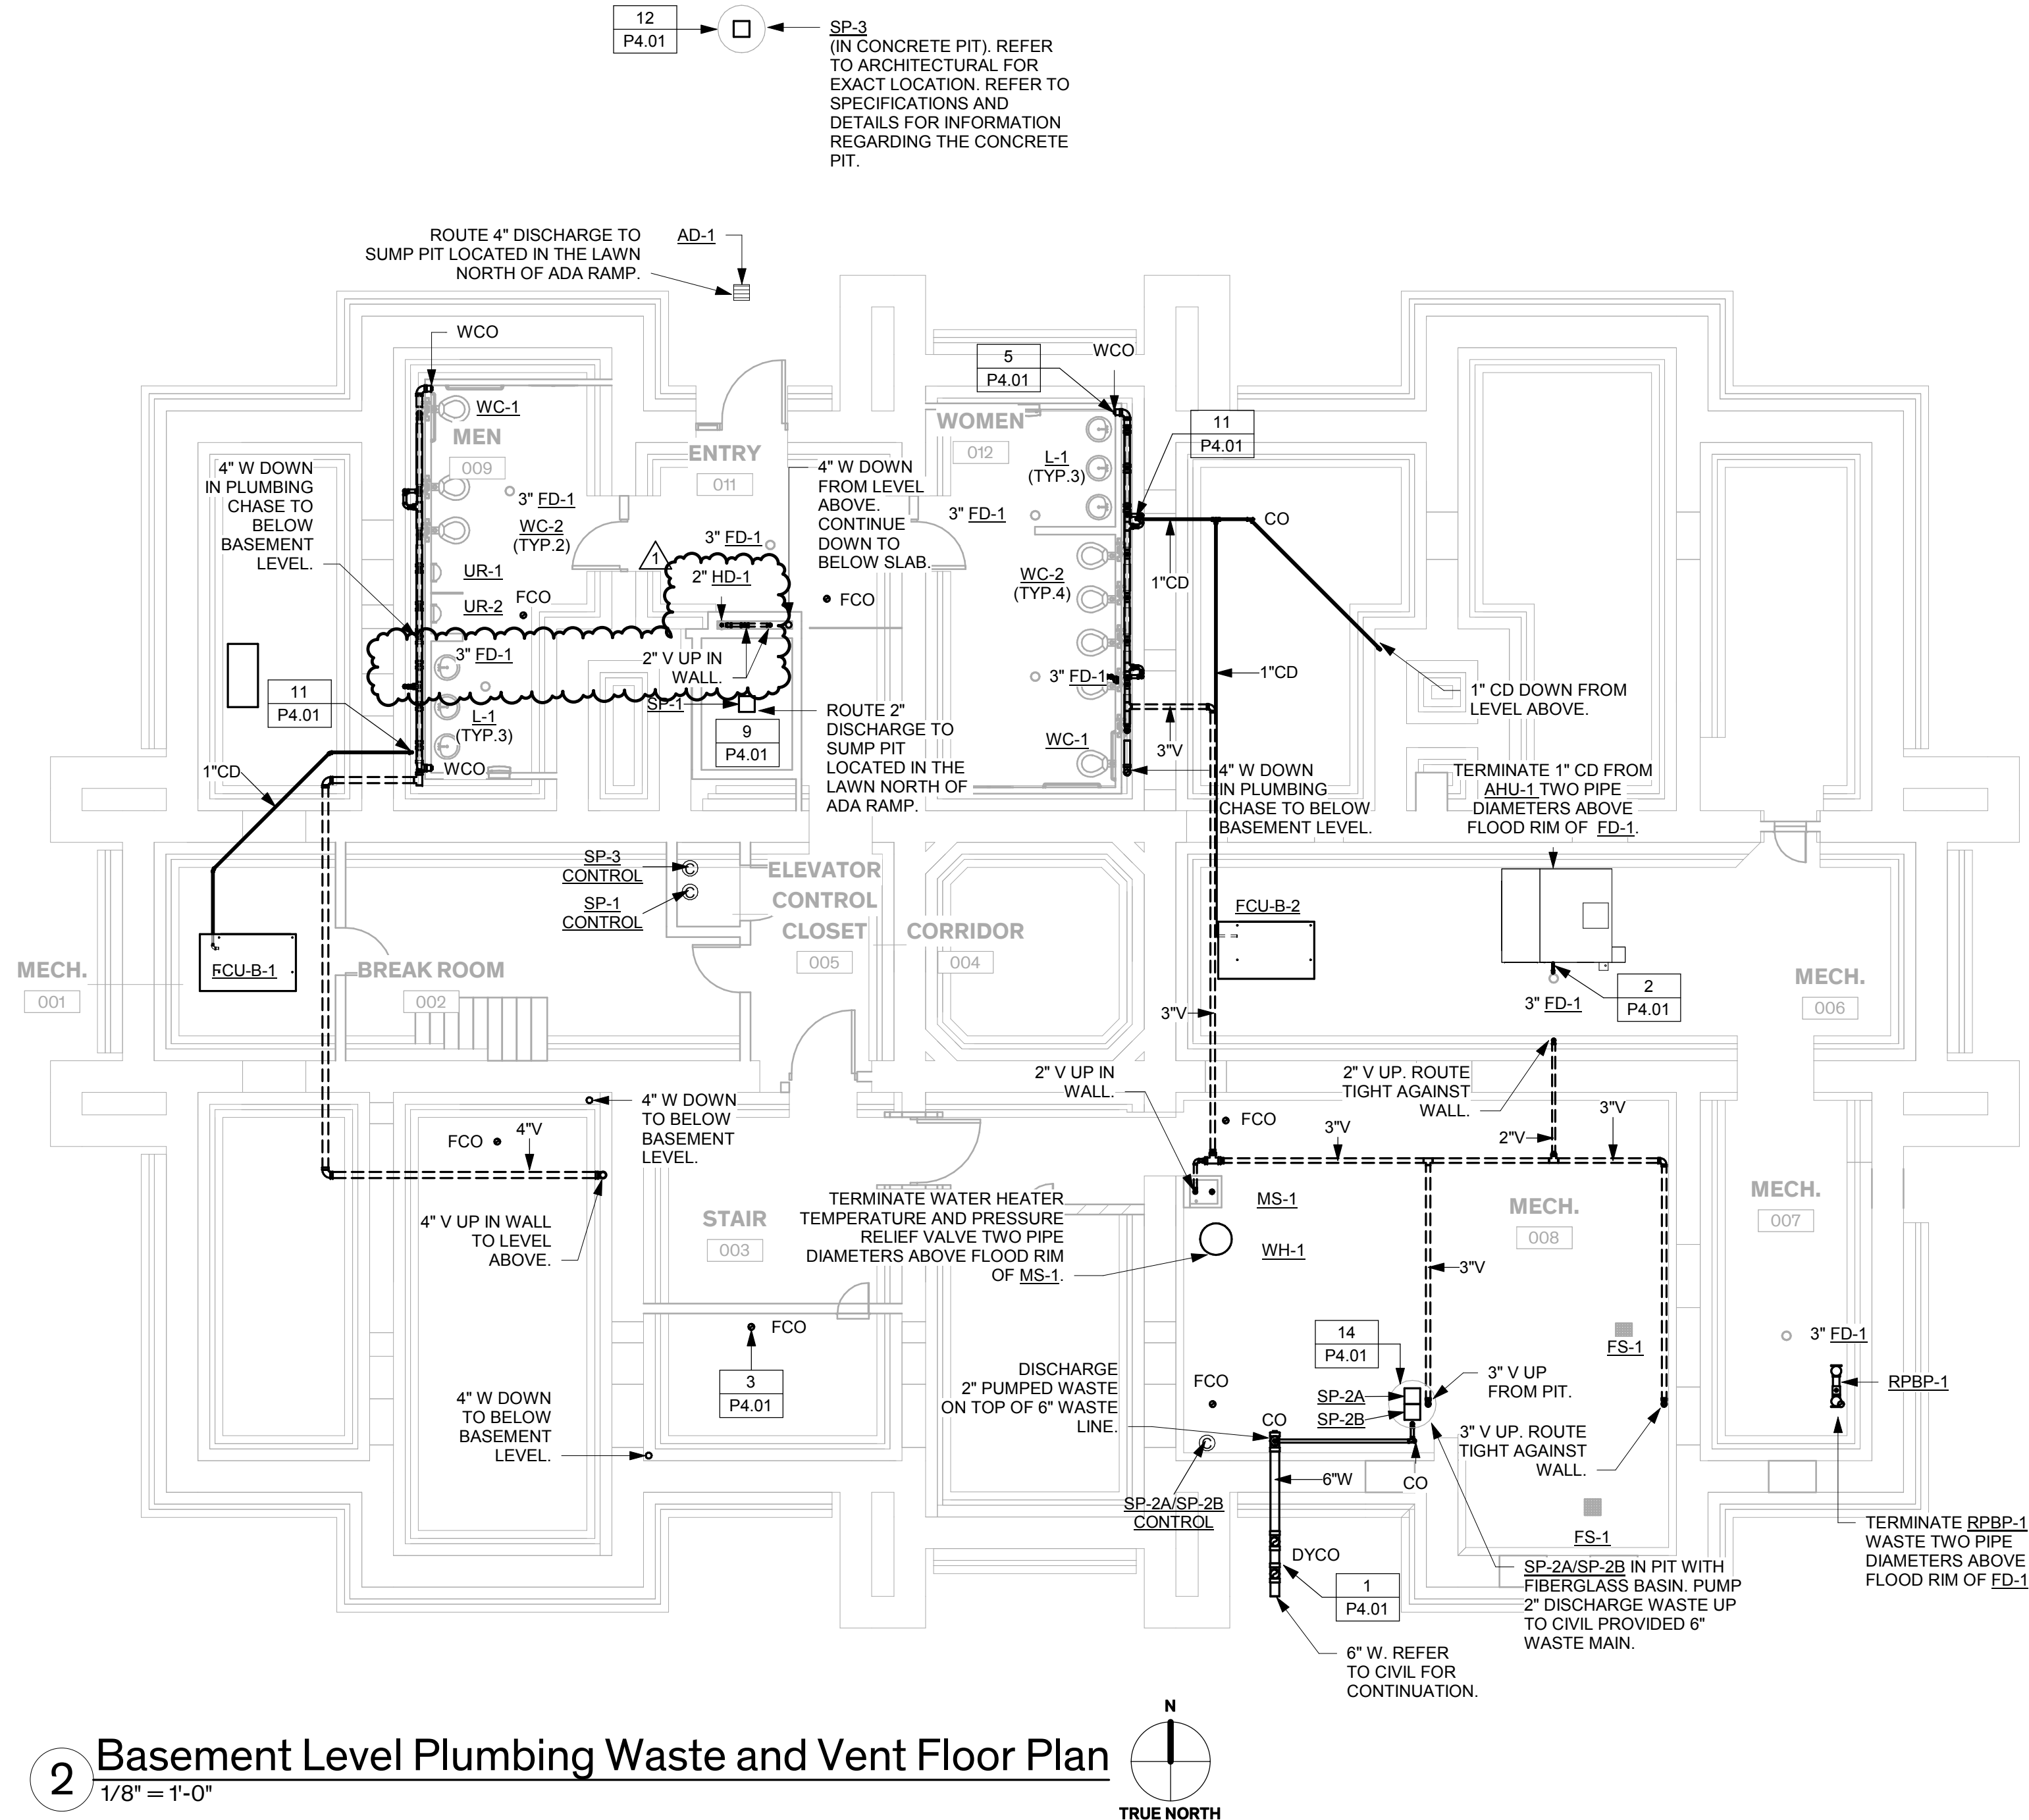

**2** Basement Level Plumbing Waste and Vent Floor Plan  
1/8" = 1'-0"


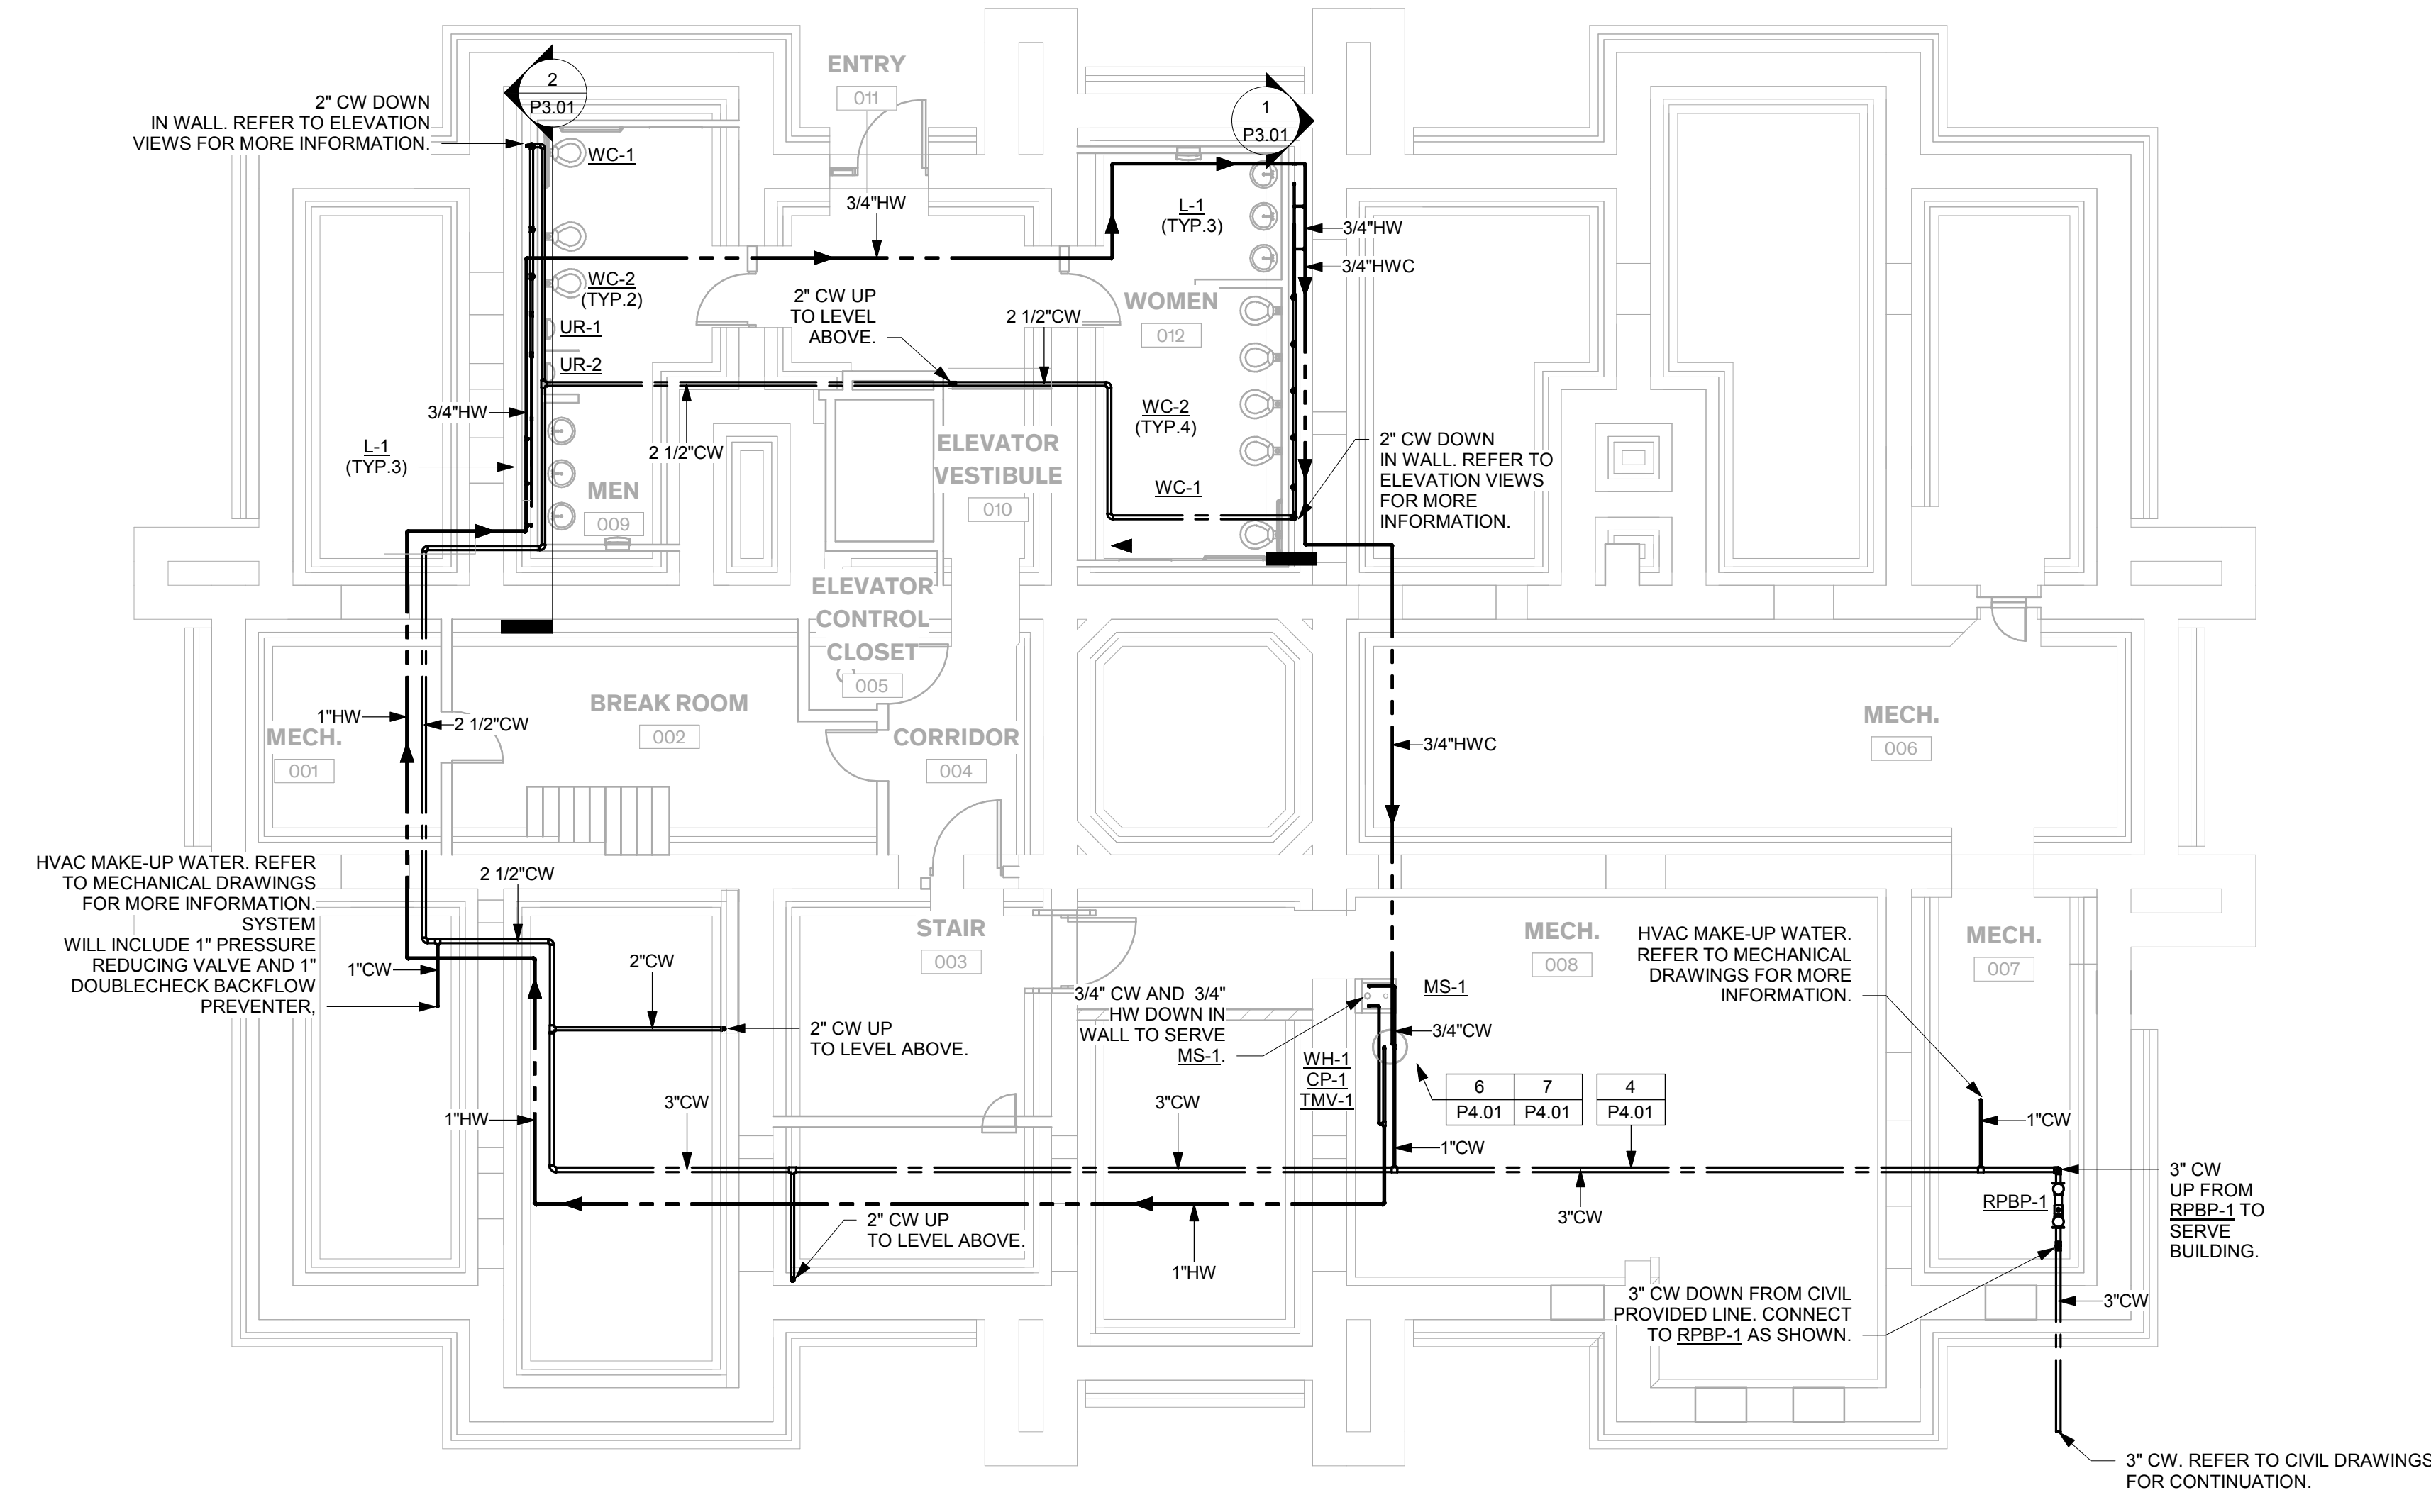


**1** Basement Level Plumbing Supply Floor Plan  
1/8" = 1'-0"


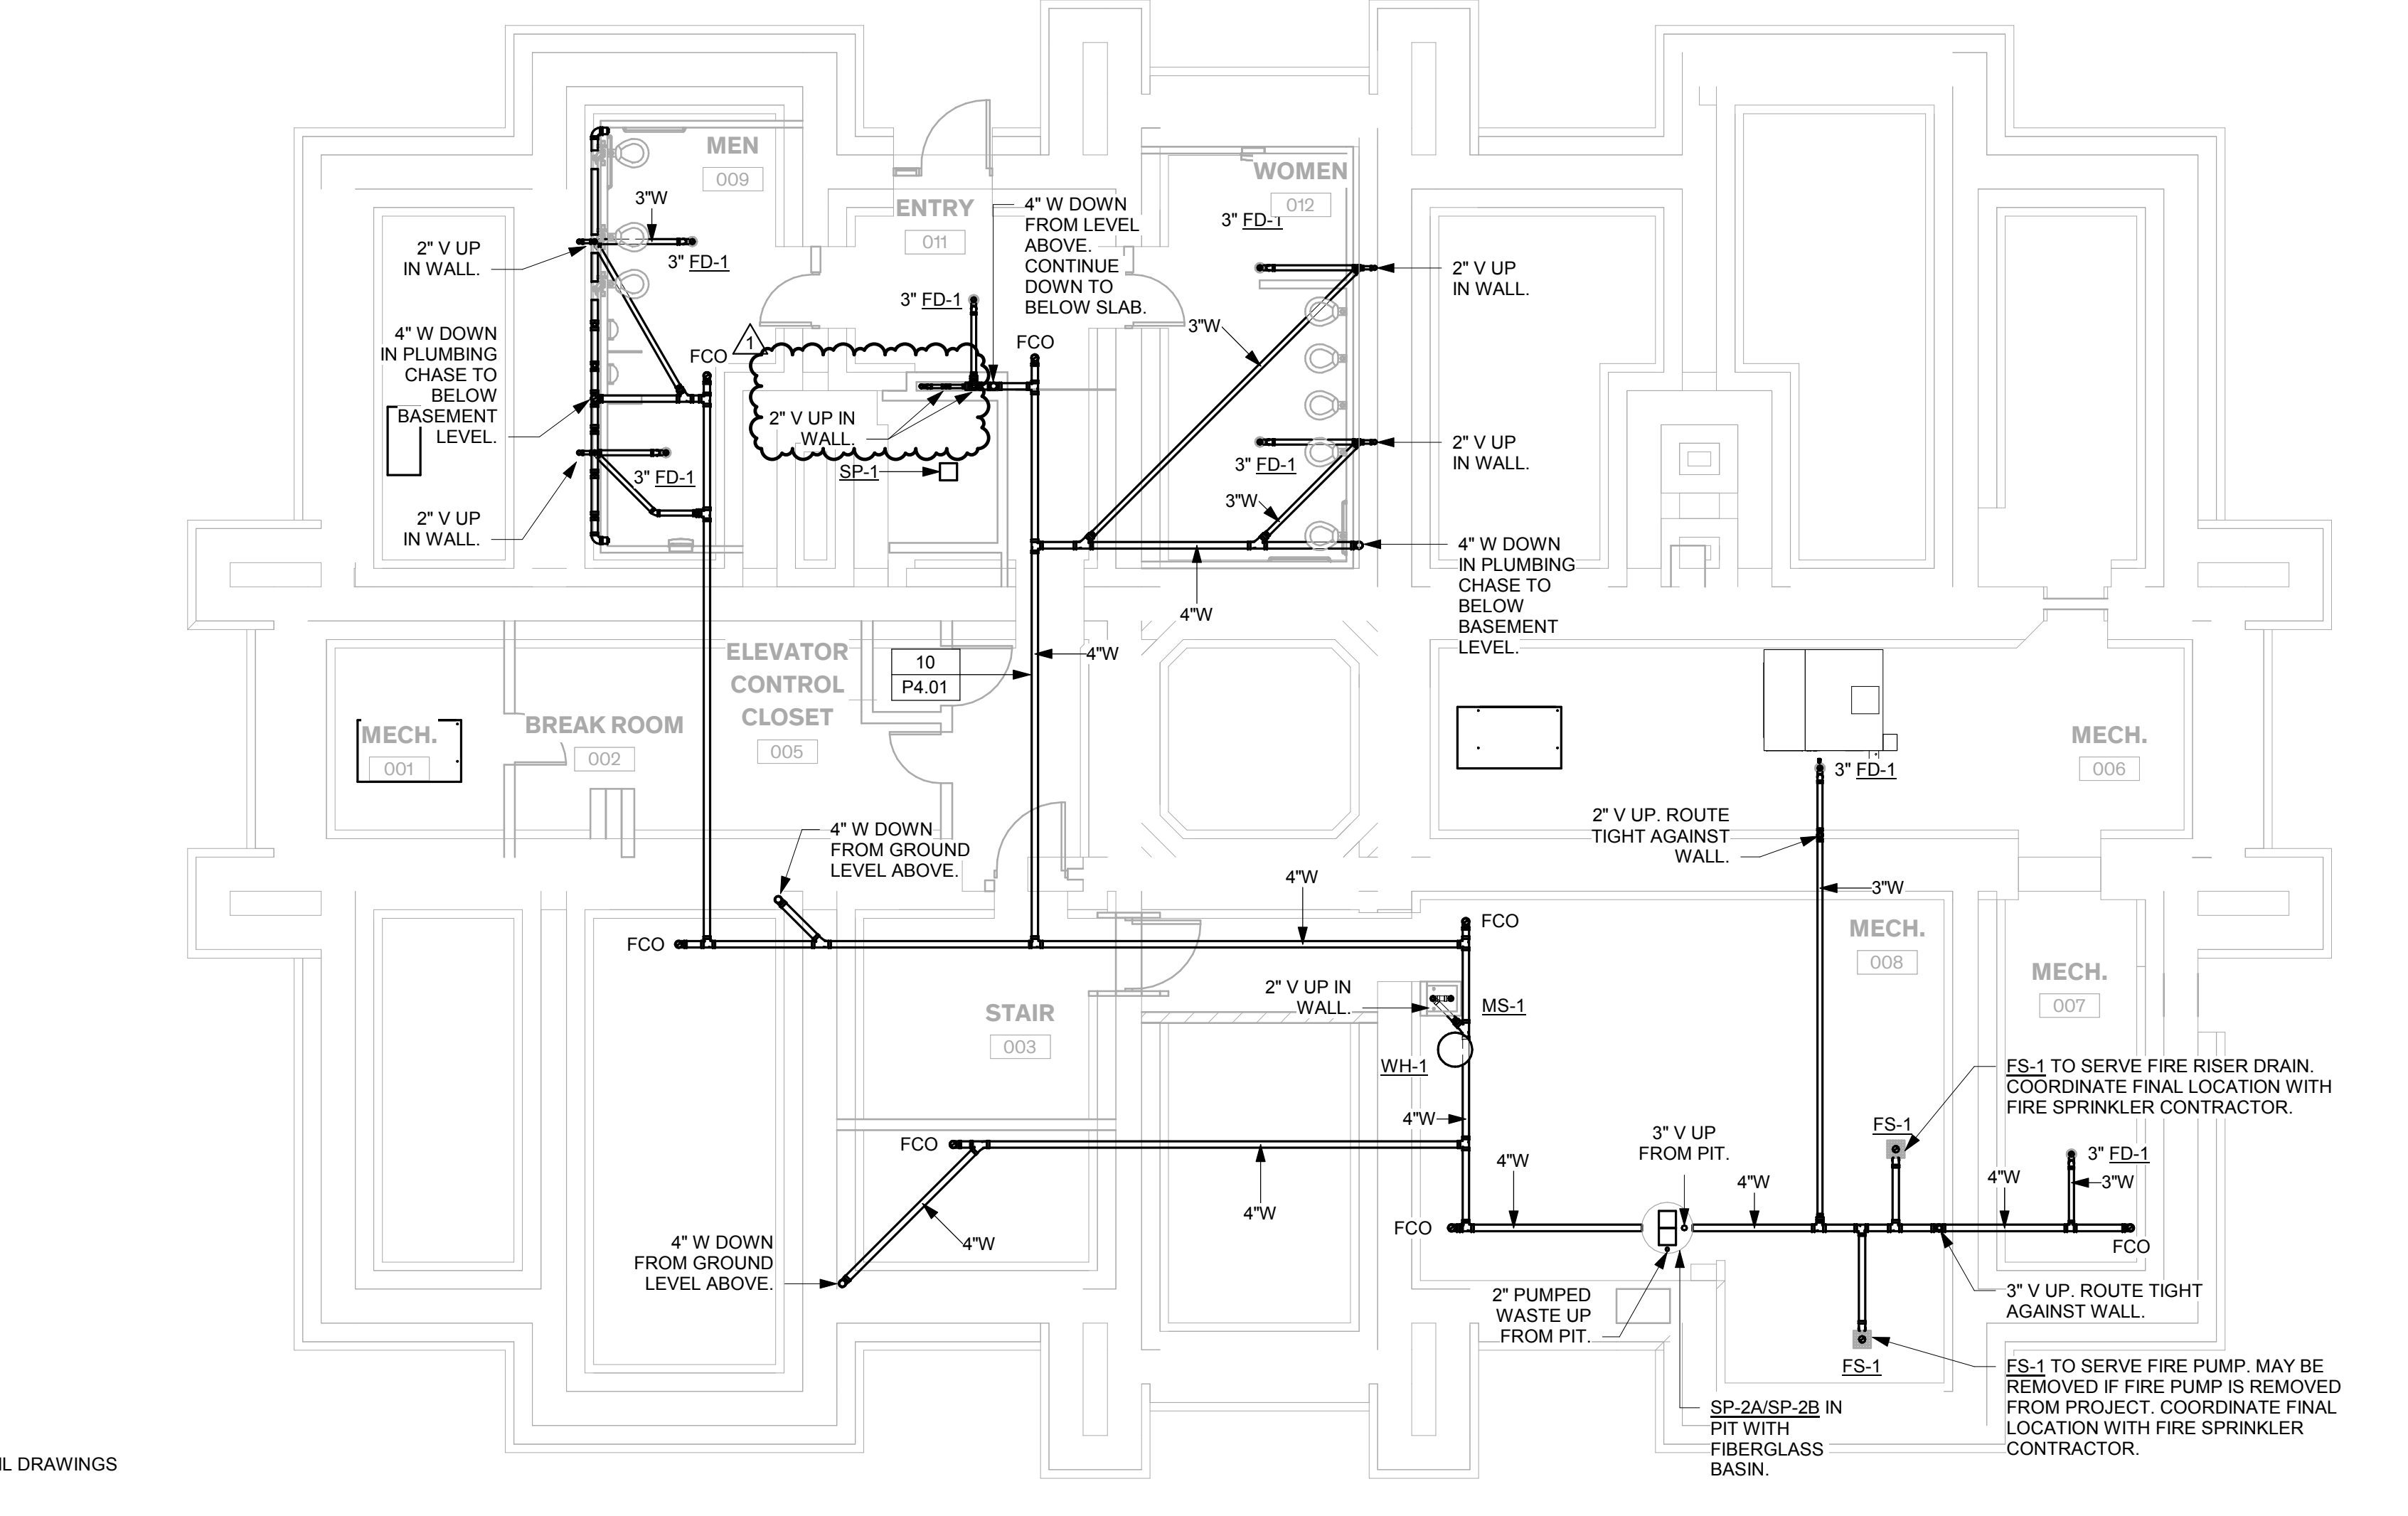


**3** Below Basement Level Plumbing Waste and Vent Floor Plan  
1/8" = 1'-0"



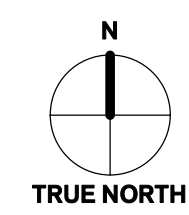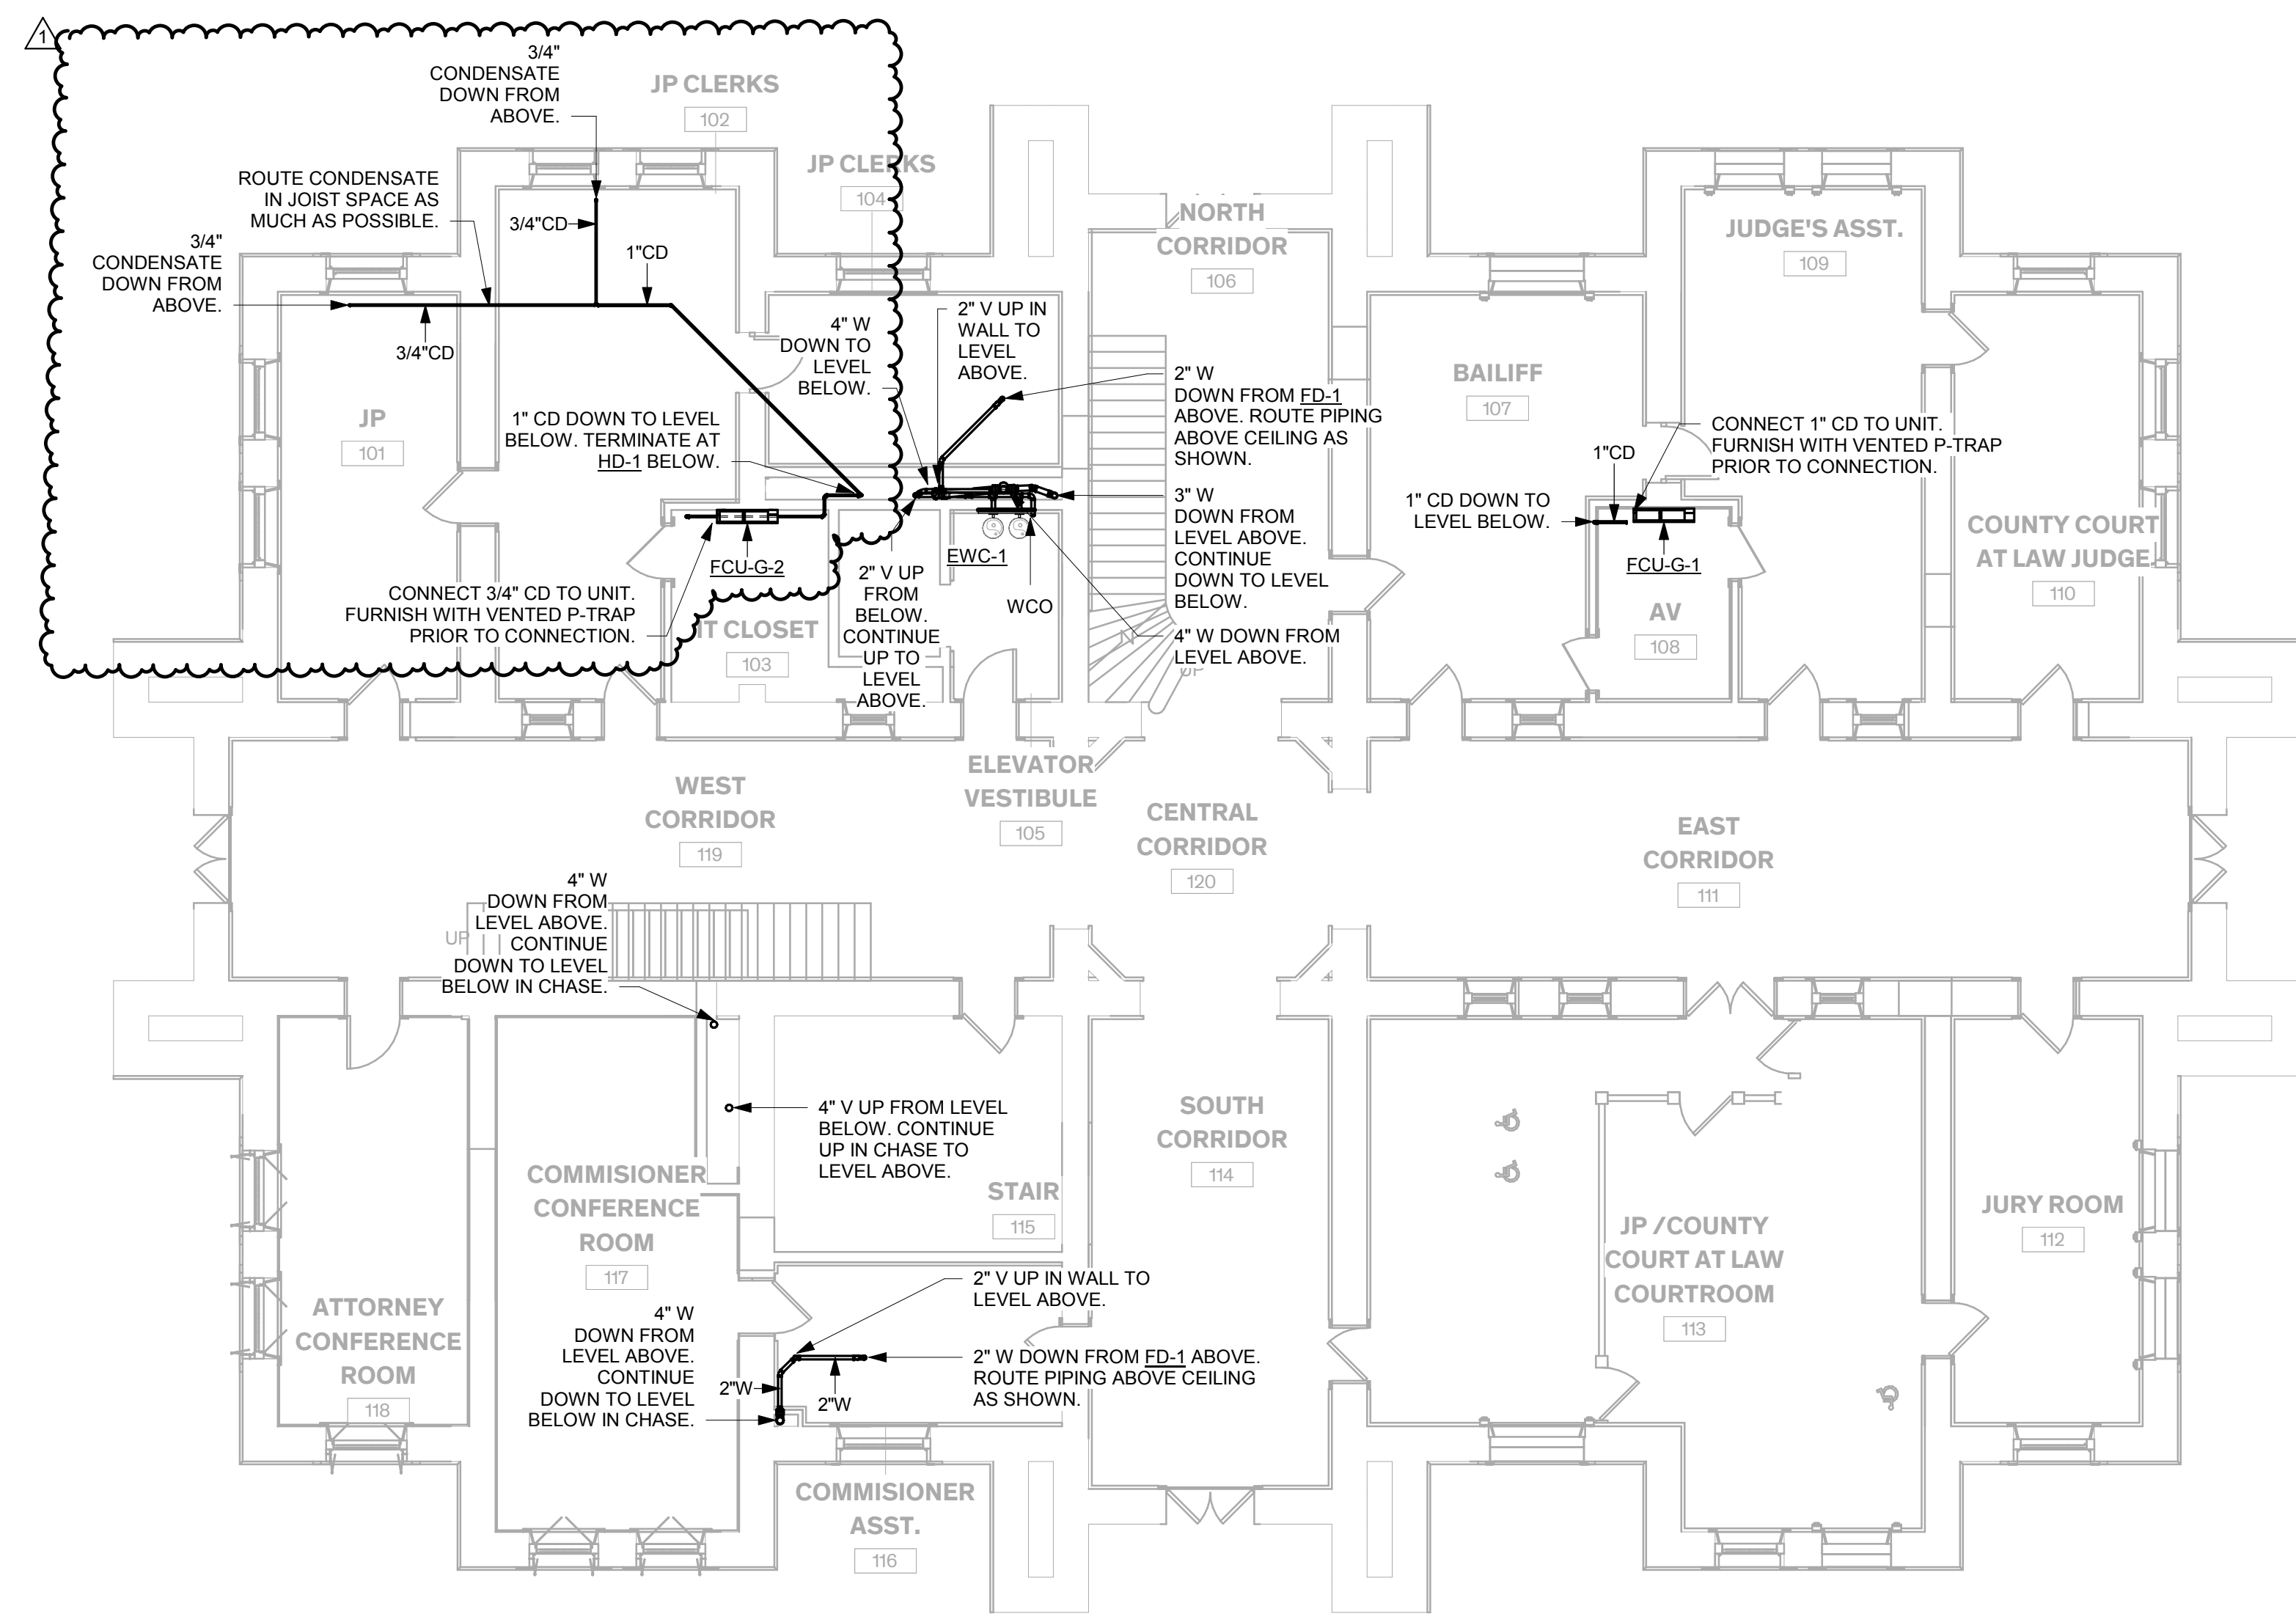


2 Ground Level Plumbing Waste and Vent Floor Plan  
1/8" = 1'-0"

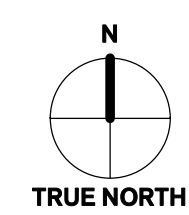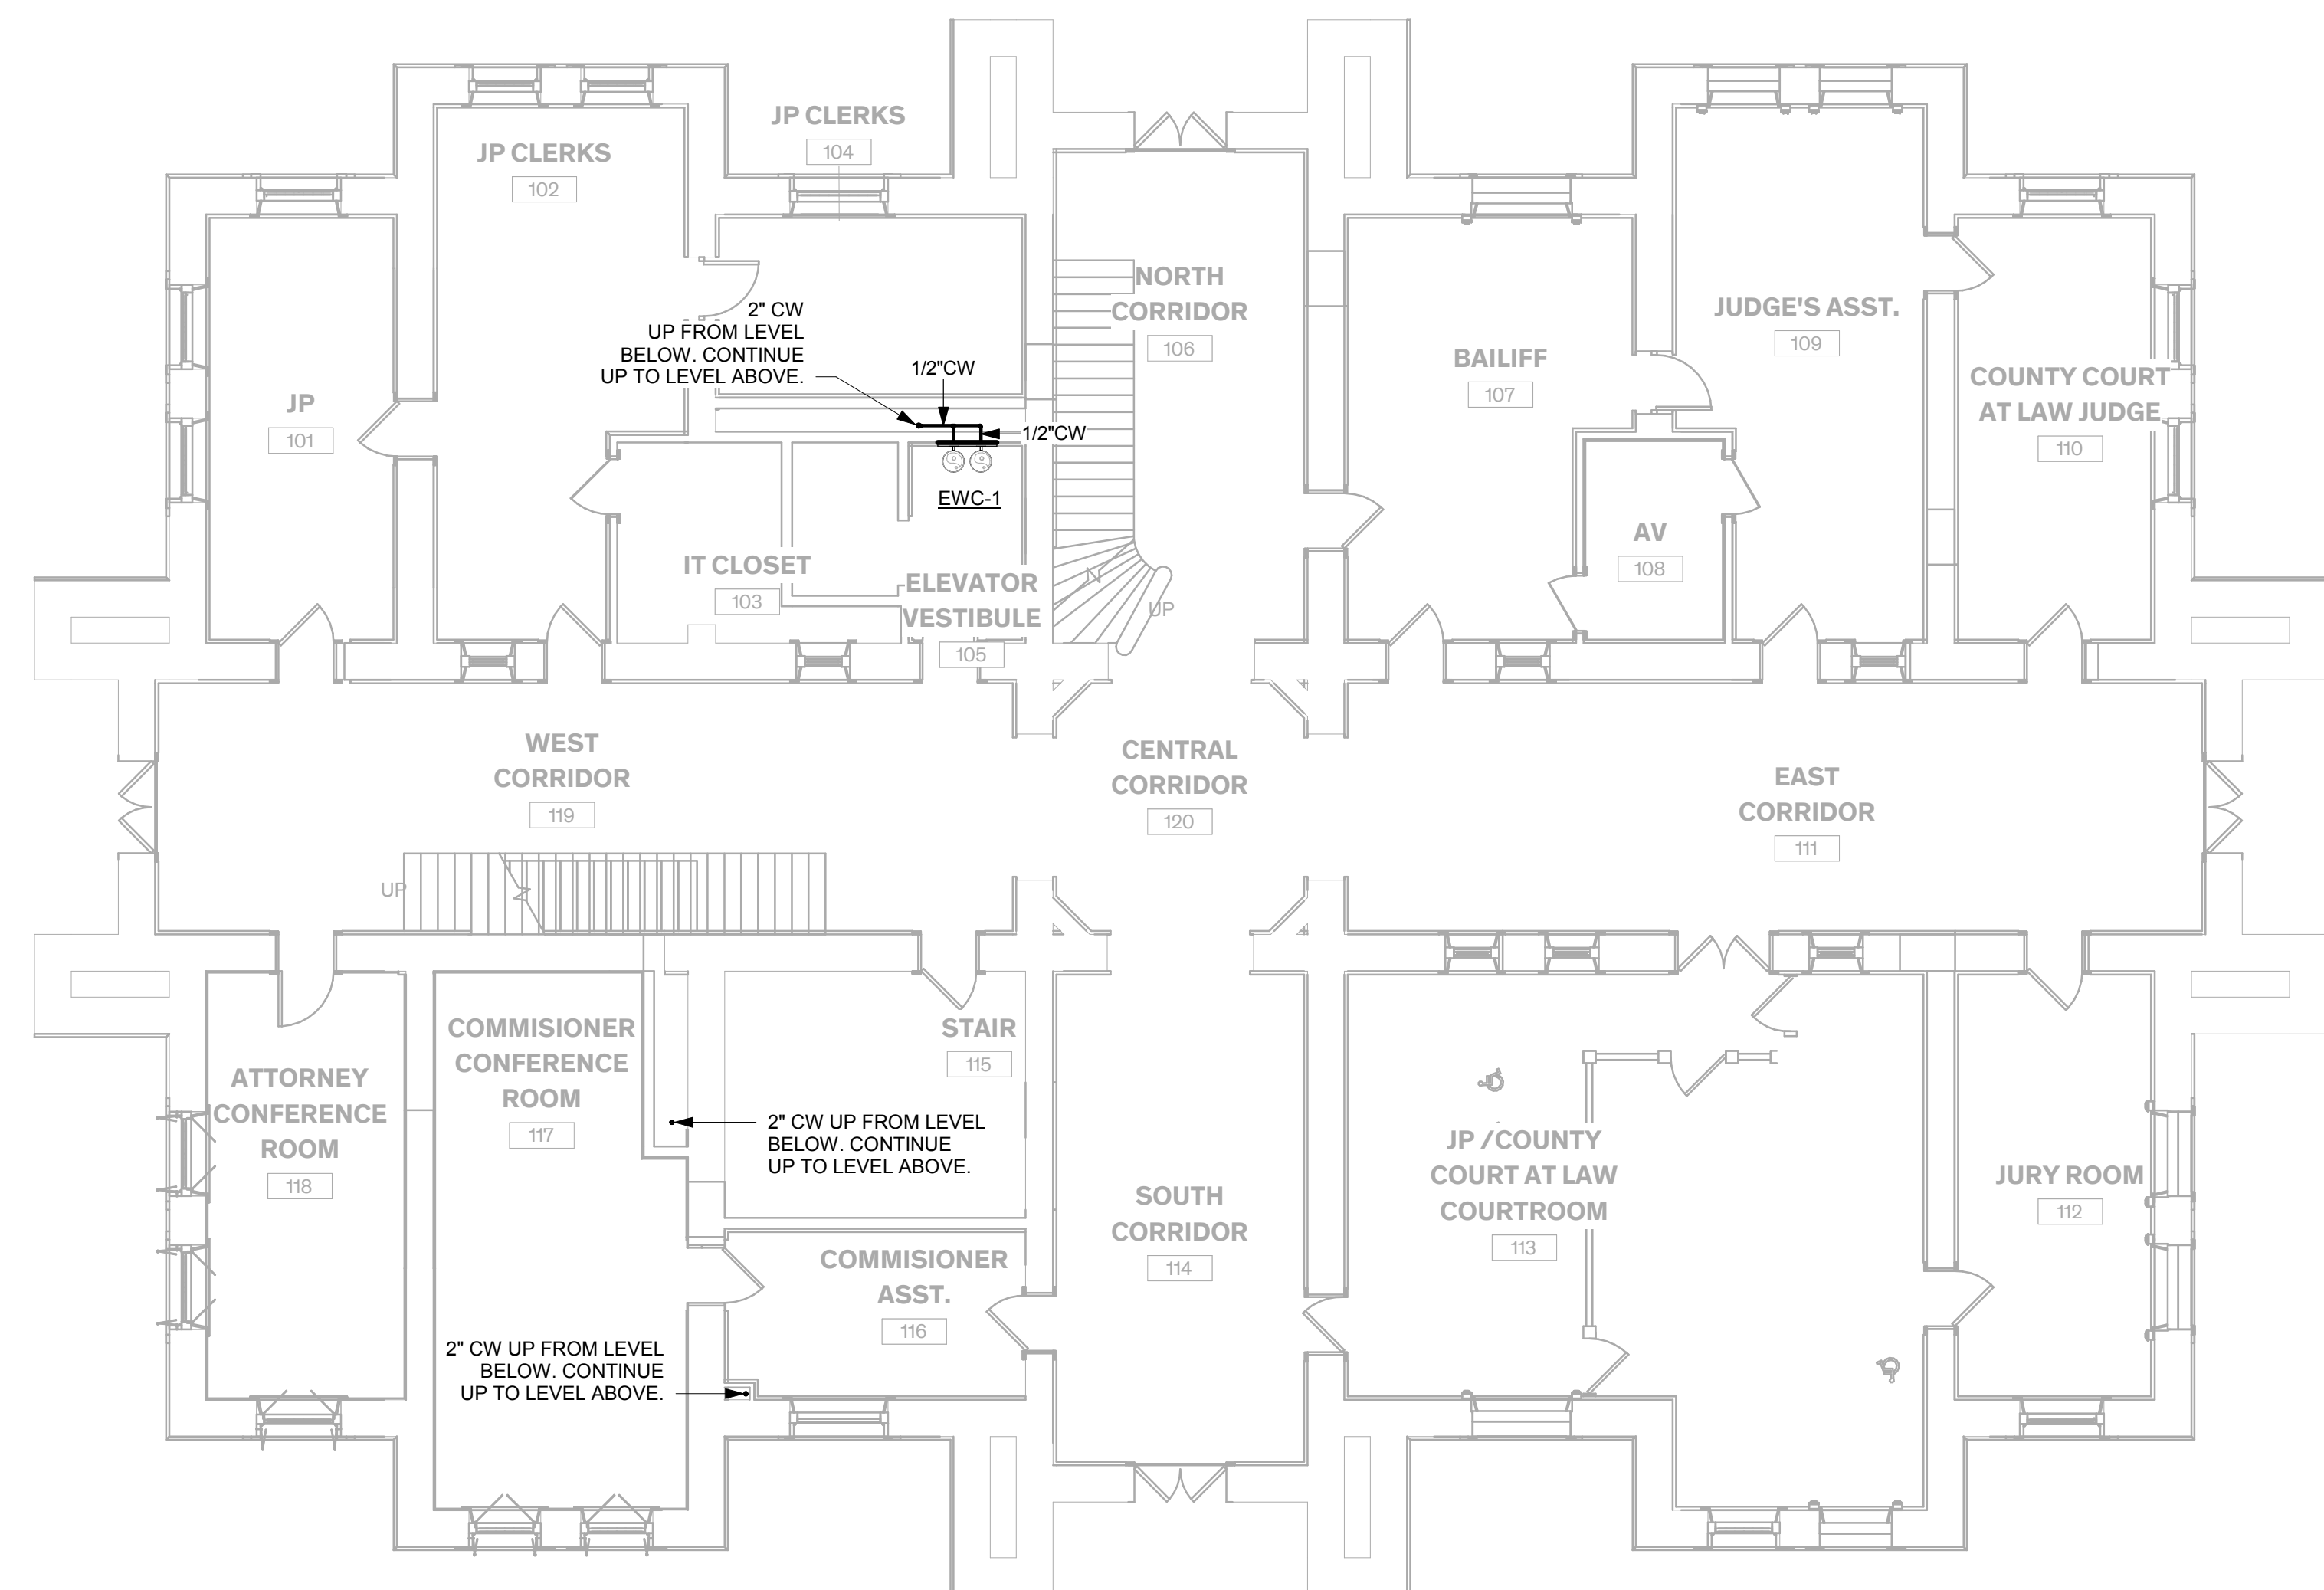

1 Ground Level Plumbing Supply Floor Plan  
1/8" = 1'-0"

**GENERAL NOTES**

1. FINAL LOCATION OF DEVICES, FIXTURES, EQUIPMENT, AND RECEPTACLES TO BE REVIEWED AND APPROVED BY ARCHITECT AND THE CONTRACTOR PRIOR TO COMMENCEMENT OF WORK AND INSTALLATION.
2. CONTRACTOR SHALL FIELD COORDINATE ALL UNDERGROUND PIPING WITH MECHANICAL, ELECTRICAL, CIVIL, AND LANDSCAPING DISCIPLINES. REFER TO WASTE AND VENT RISER DIAGRAM DETAIL #2 FOR MORE INFORMATION.

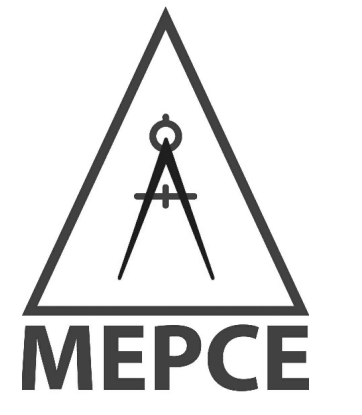

Engineering Firm: F-4050  
Dallas/Fort Worth, Texas  
www.mepce.com  
972-870-0060  
PROJECT CODE  
17.022.003



TEXAS HISTORICAL COMMISSION  
real places telling real stories




FANNIN COUNTY  
COURTHOUSE  
INTERIOR AND EXTERIOR  
RESTORATION  
101 E. Sam Rayburn Drive  
Bonham, Texas 75418

**COPYRIGHT**  
The Contractor shall verify and be responsible for all dimensions. DO NOT scale the drawing. Any errors or omissions shall be reported to Architexas without delay. The Copyrights to all designs and drawings are the property of Architexas. Reproduction or use for any purpose other than that authorized by Architexas is forbidden.

**REVISION HISTORY**

1	10/16/18	Addendum 1
---	----------	------------


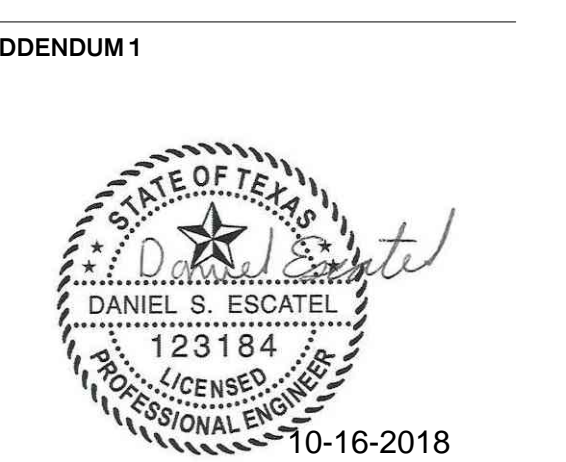


Architexas No. 1737 Date OCTOBER 16, 2018



Sheet Name Ground Level Plumbing Floor Plans

Sheet Number P2.02



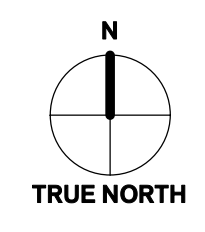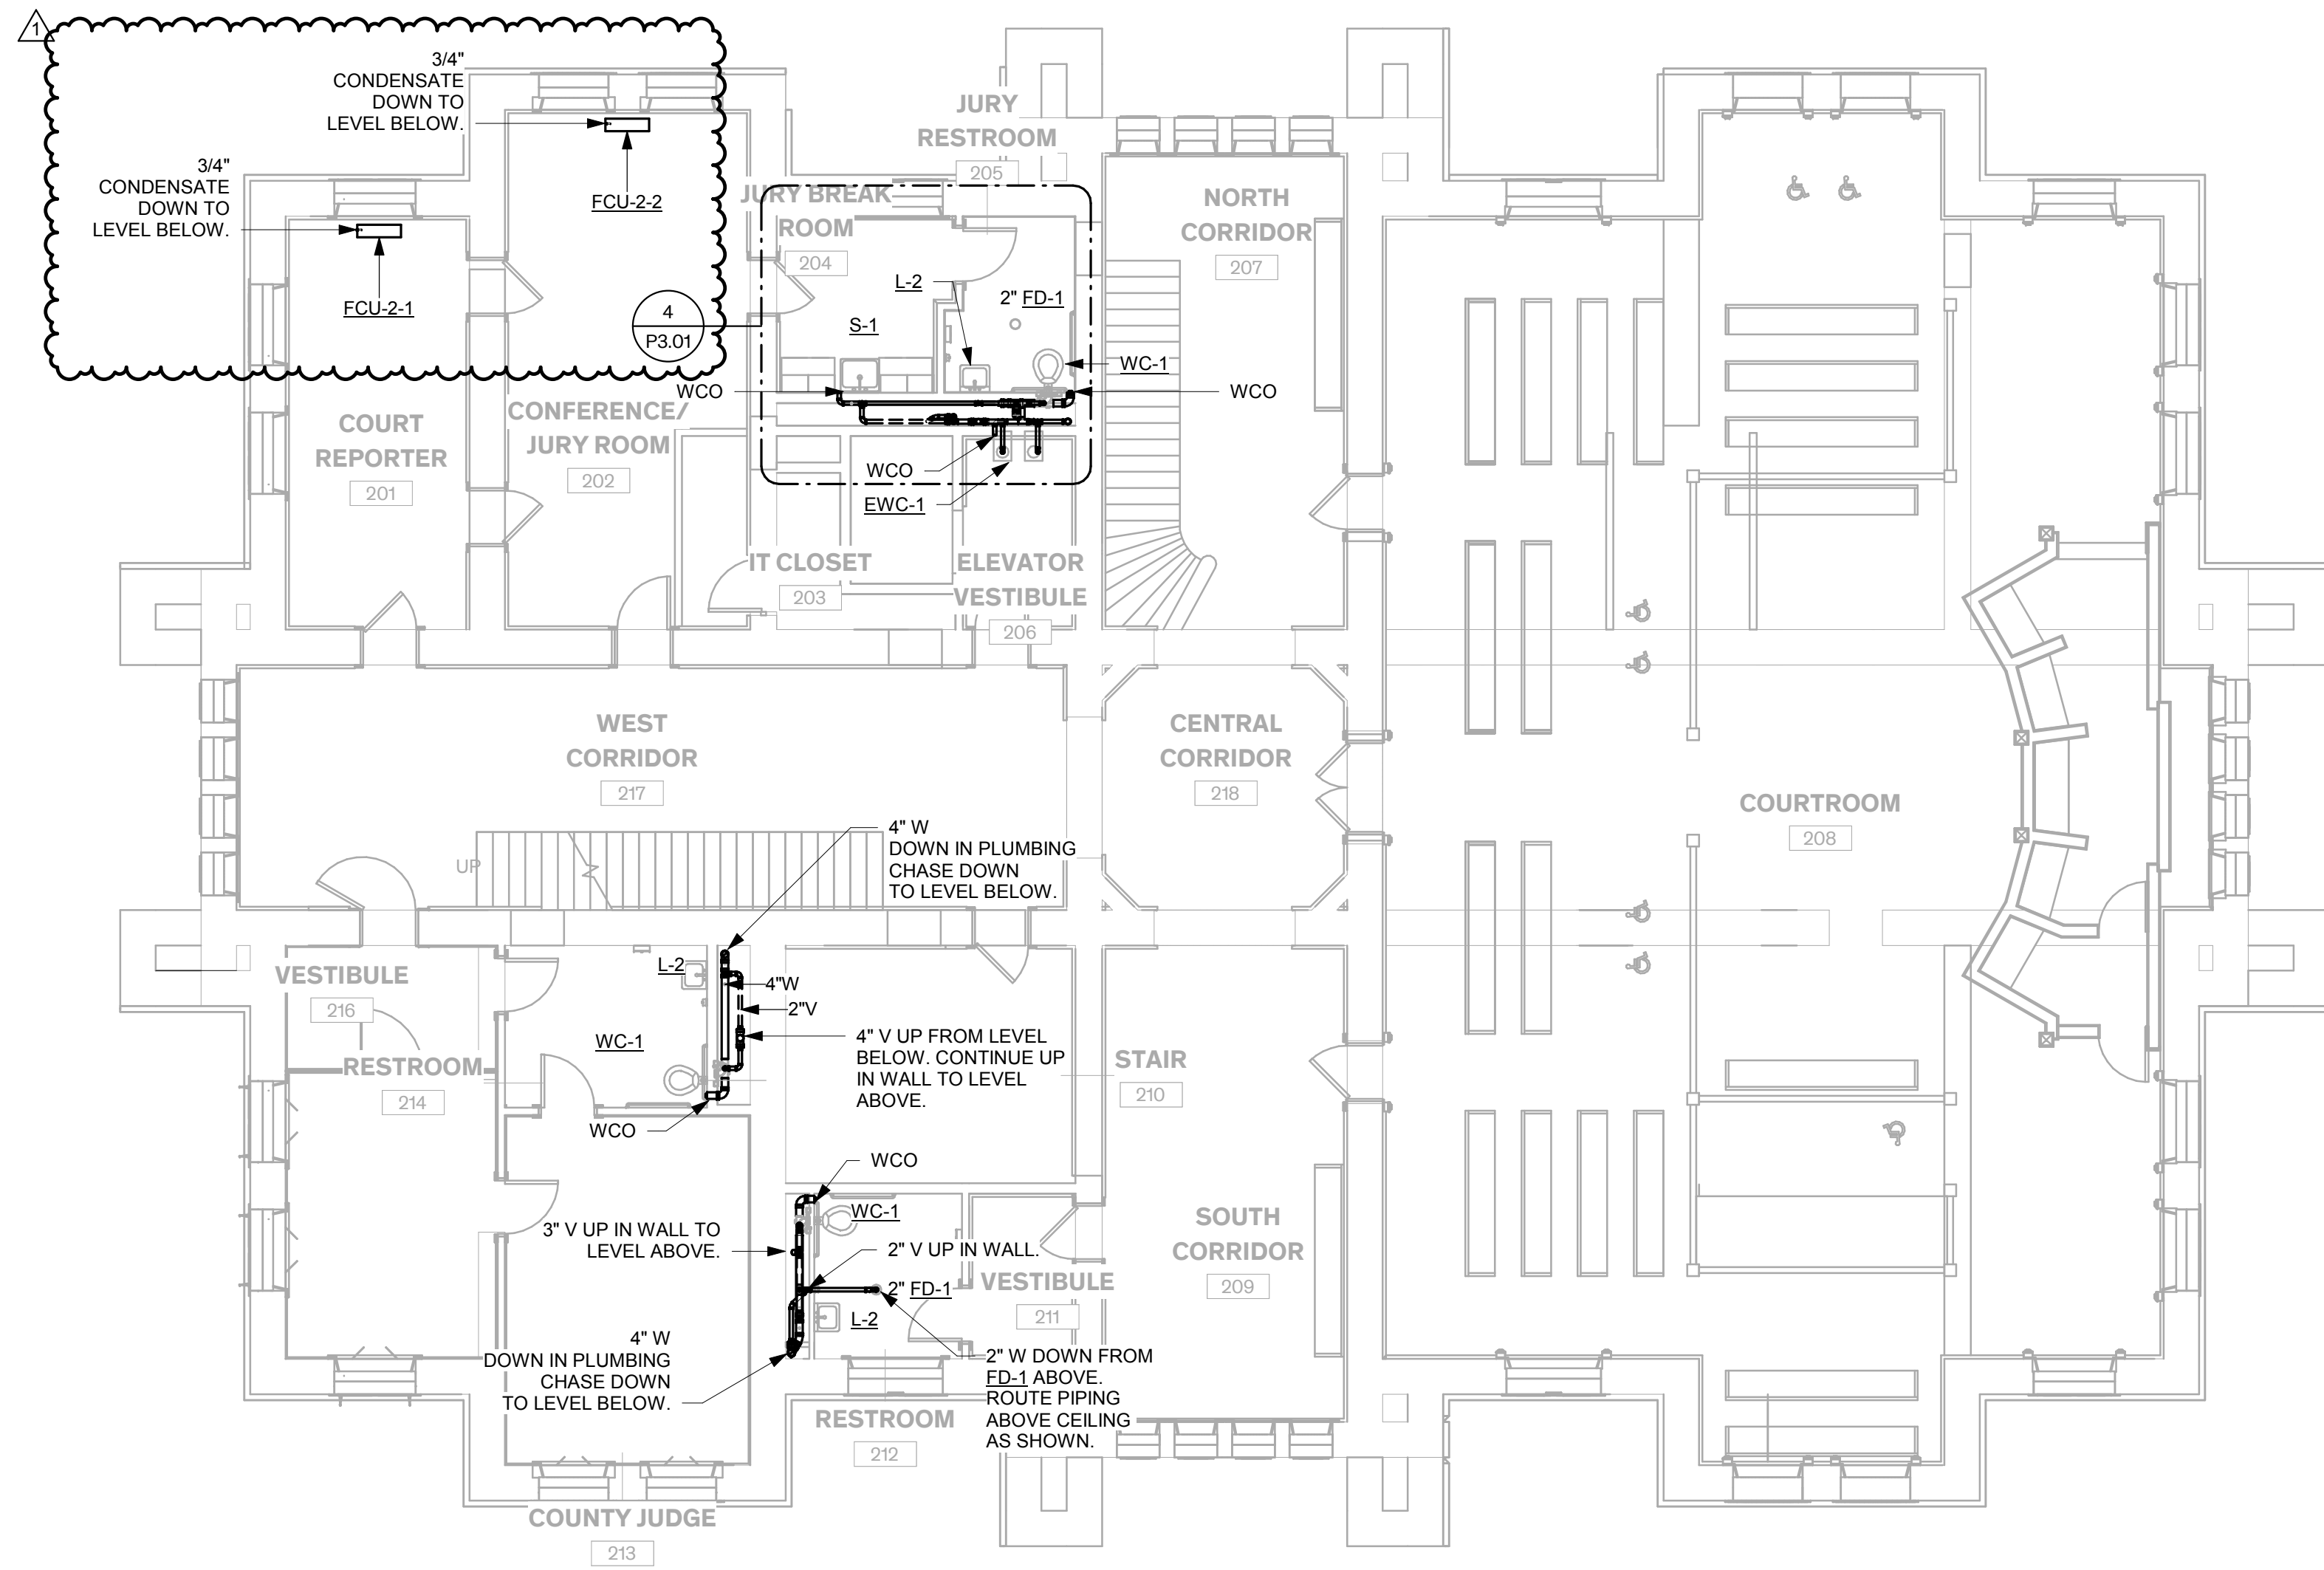


2 Second Level Plumbing Waste and Vent Floor Plan  
1/8" = 1'-0"

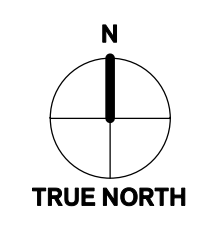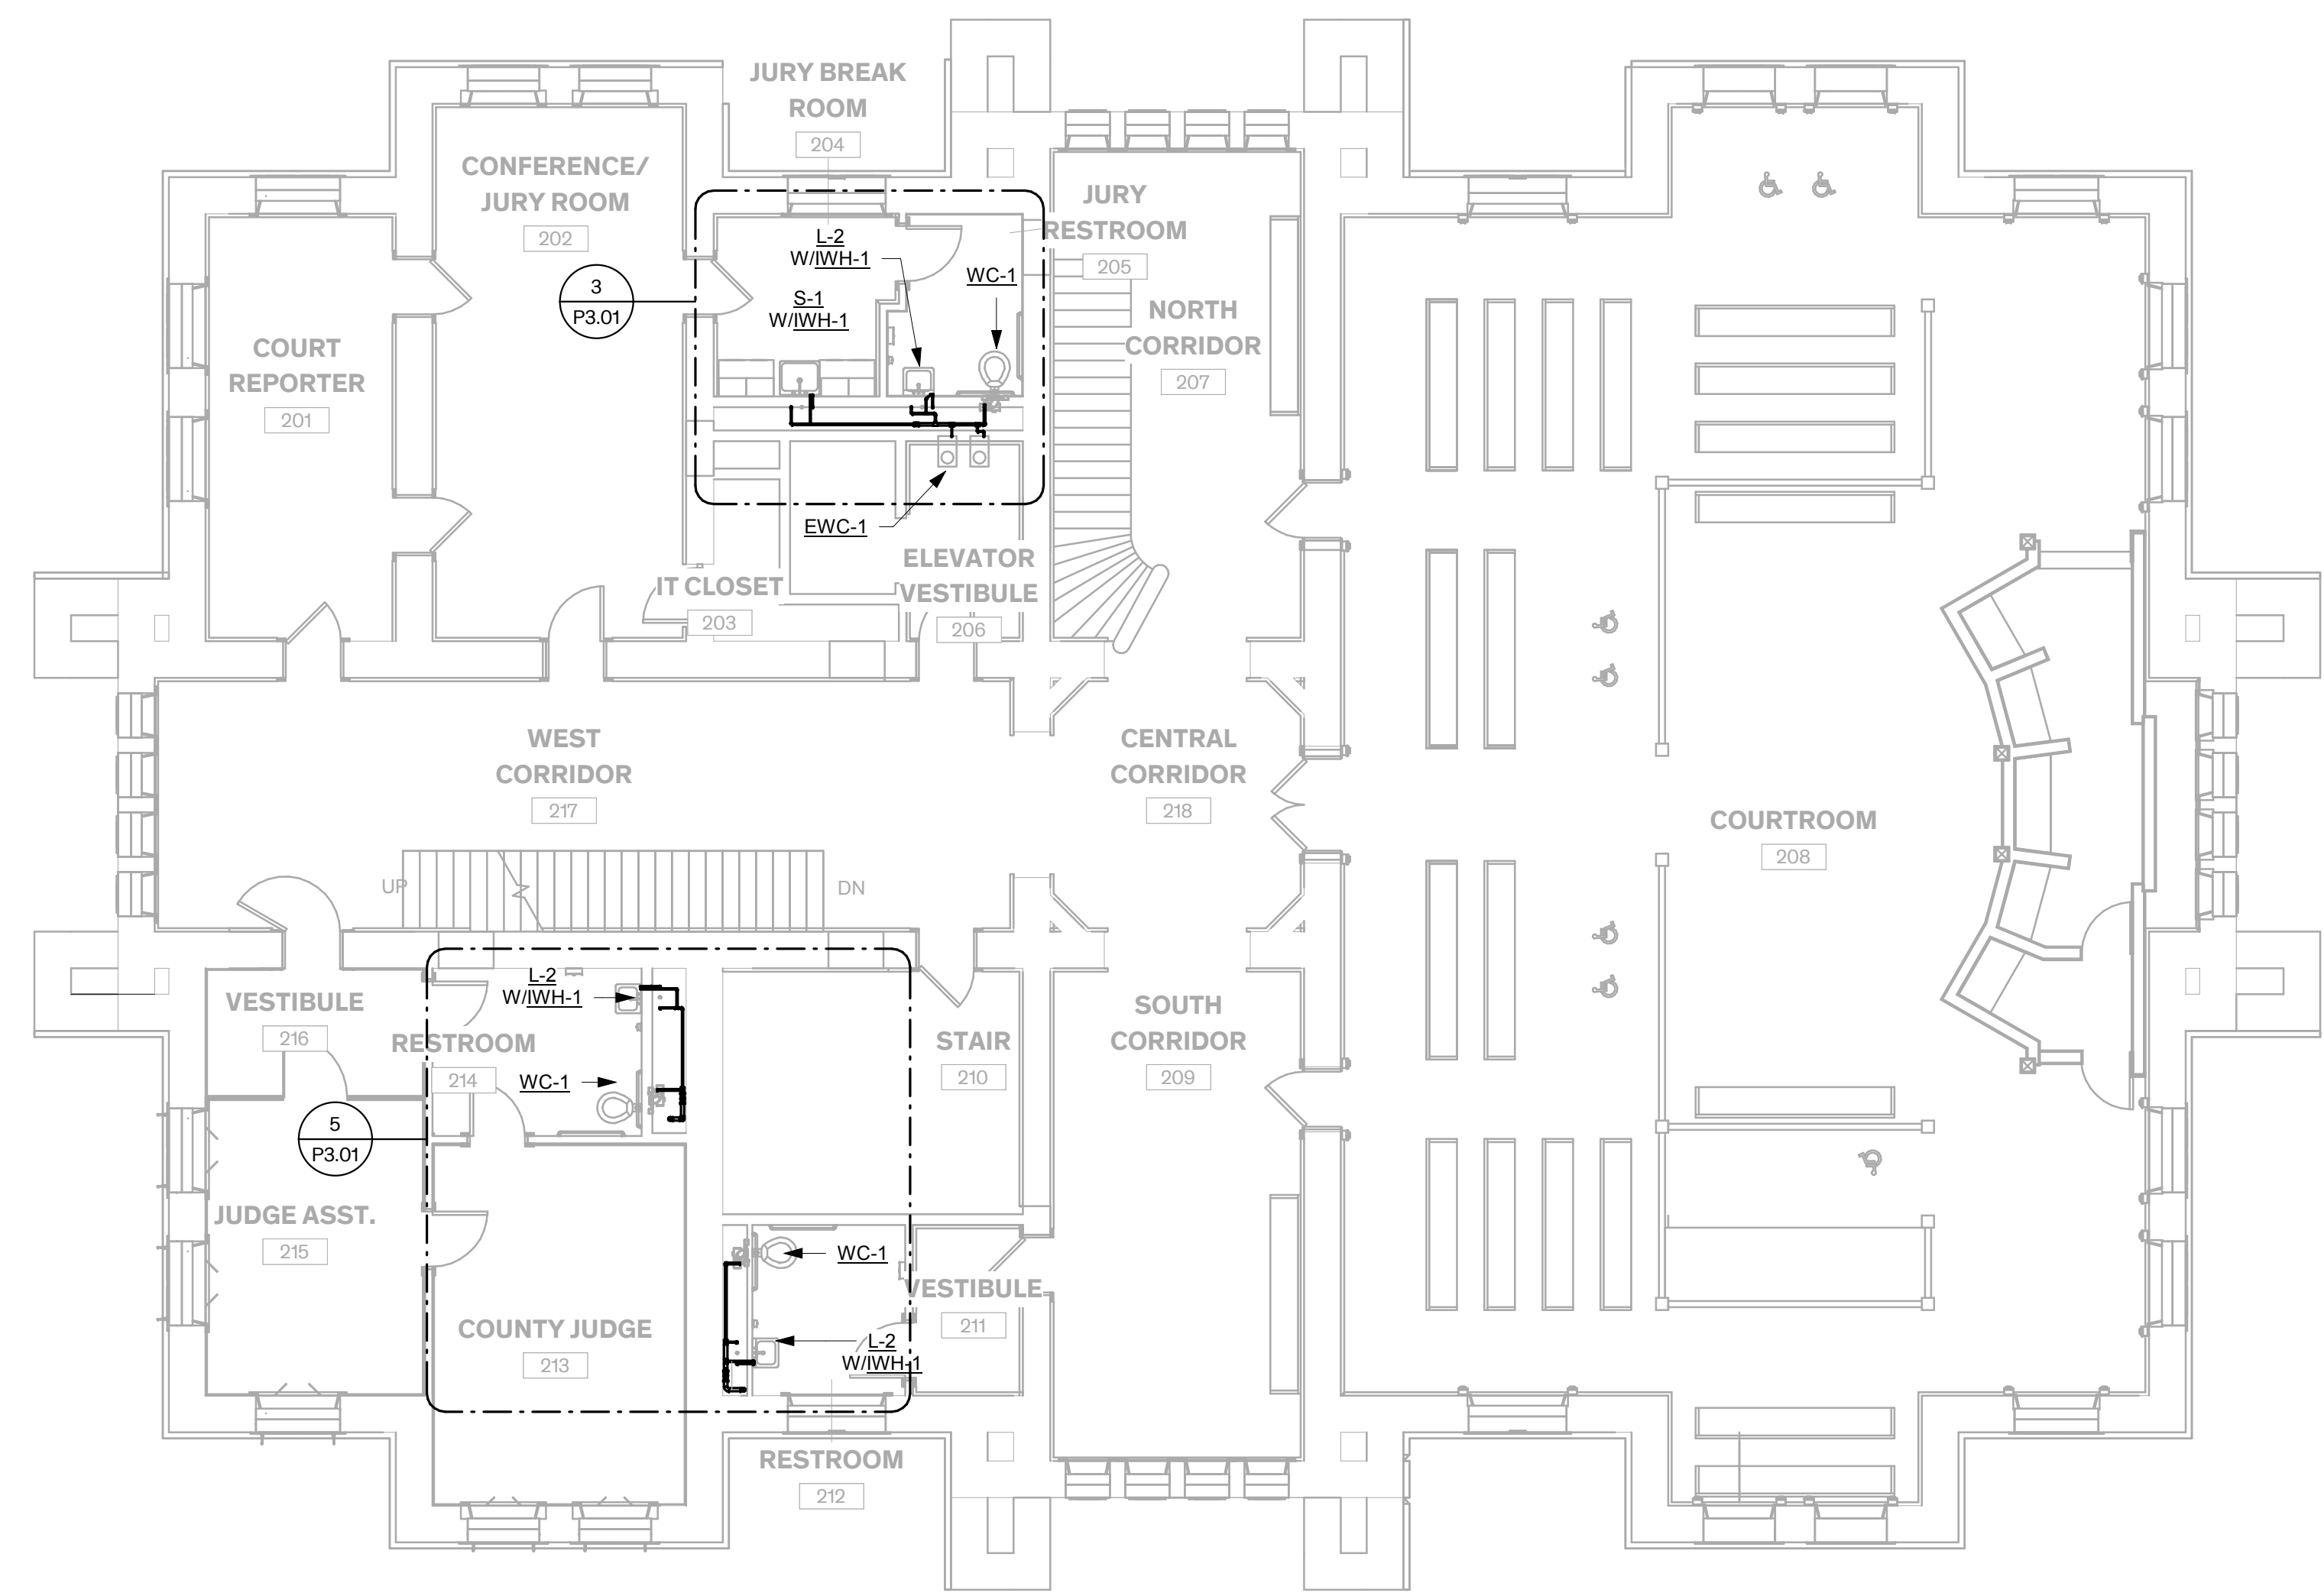


1 Second Level Plumbing Supply Floor Plan  
1/8" = 1'-0"

**GENERAL NOTES**

1. FINAL LOCATION OF DEVICES, FIXTURES, EQUIPMENT, AND RECEPTACLES TO BE REVIEWED AND APPROVED BY ARCHITECT AND THE CONTRACTOR PRIOR TO COMMENCEMENT OF WORK AND INSTALLATION. REFER TO ENLARGED FLOOR PLANS FOR MORE INFORMATION.
- 2.

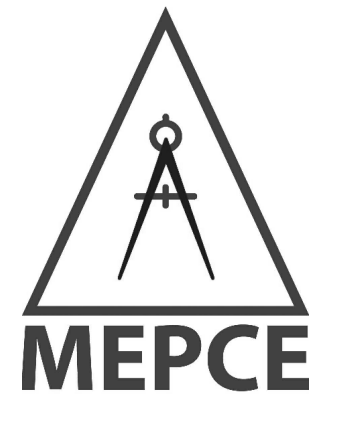

Engineering Firm: F-4050  
Dallas/Fort Worth, Texas  
www.mepce.com  
972-870-0060  
PROJECT CODE  
17.022.003

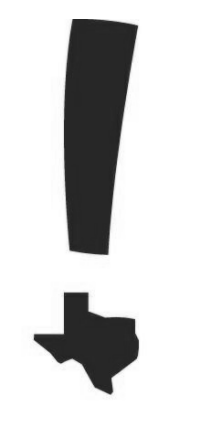


TEXAS HISTORICAL COMMISSION  
real places telling real stories



FANNIN COUNTY  
COURTHOUSE  
INTERIOR AND EXTERIOR  
RESTORATION  
101 E. Sam Rayburn Drive  
Bonham, Texas 75418

**COPYRIGHT**  
The Contractor shall verify and be responsible for all dimensions. DO NOT scale the drawing. Any errors or omissions shall be reported to Architexas without delay. The Copyrights to all designs and drawings are the property of Architexas. Reproduction or use for any purpose other than that authorized by Architexas is forbidden.

**REVISION HISTORY**  
1 10/16/18 Addendum 1

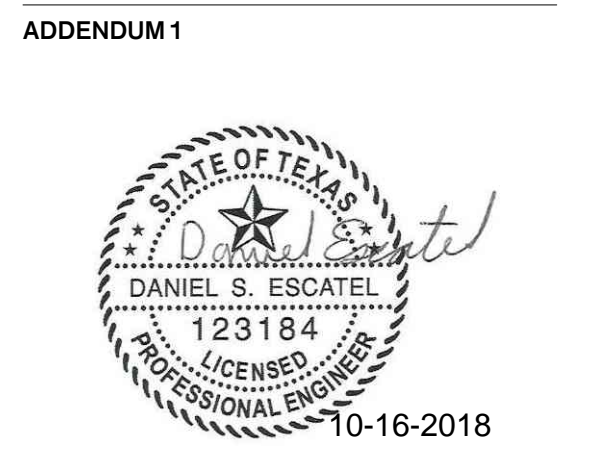

Architexas No. 1737 Date OCTOBER 16, 2018

Sheet Name Second Level Plumbing Floor Plans

Sheet Number



**GENERAL NOTES**

1. FINAL LOCATION OF DEVICES, FIXTURES, EQUIPMENT, AND RECEPTACLES TO BE REVIEWED AND APPROVED BY ARCHITECT AND THE REPRESENTATIVE PRIOR TO COMMENCEMENT OF WORK AND INSTALLATION. REFER TO FLOOR PLANS AND ENLARGED FLOOR PLANS FOR SIZING AND MORE INFORMATION.
- 2.



Engineering Firm: F-4050  
 Dallas/Fort Worth, Texas  
 www.mepce.com  
 972-870-0660

PROJECT CODE  
 17.022.003



TEXAS HISTORICAL COMMISSION  
*real places telling real stories*



FANNIN COUNTY  
 COURTHOUSE  
 INTERIOR AND EXTERIOR  
 RESTORATION  
 101 E. Sam Rayburn Drive  
 Bonham, Texas 75418

**COPYRIGHT**  
 The Contractor shall verify and be responsible for all dimensions. DO NOT scale the drawing. Any errors or omissions shall be reported to Architexas without delay. The Copyrights to all designs and drawings are the property of Architexas. Reproduction or use for any purpose other than that authorized by Architexas is forbidden.

**REVISION HISTORY**  
 1 10/16/18 Addendum 1


ADDENDUM 1




Architexas No. 1737 Date OCTOBER 16, 2018

Sheet Name Plumbing Waste and Vent Riser Diagram

Sheet Number P4.02

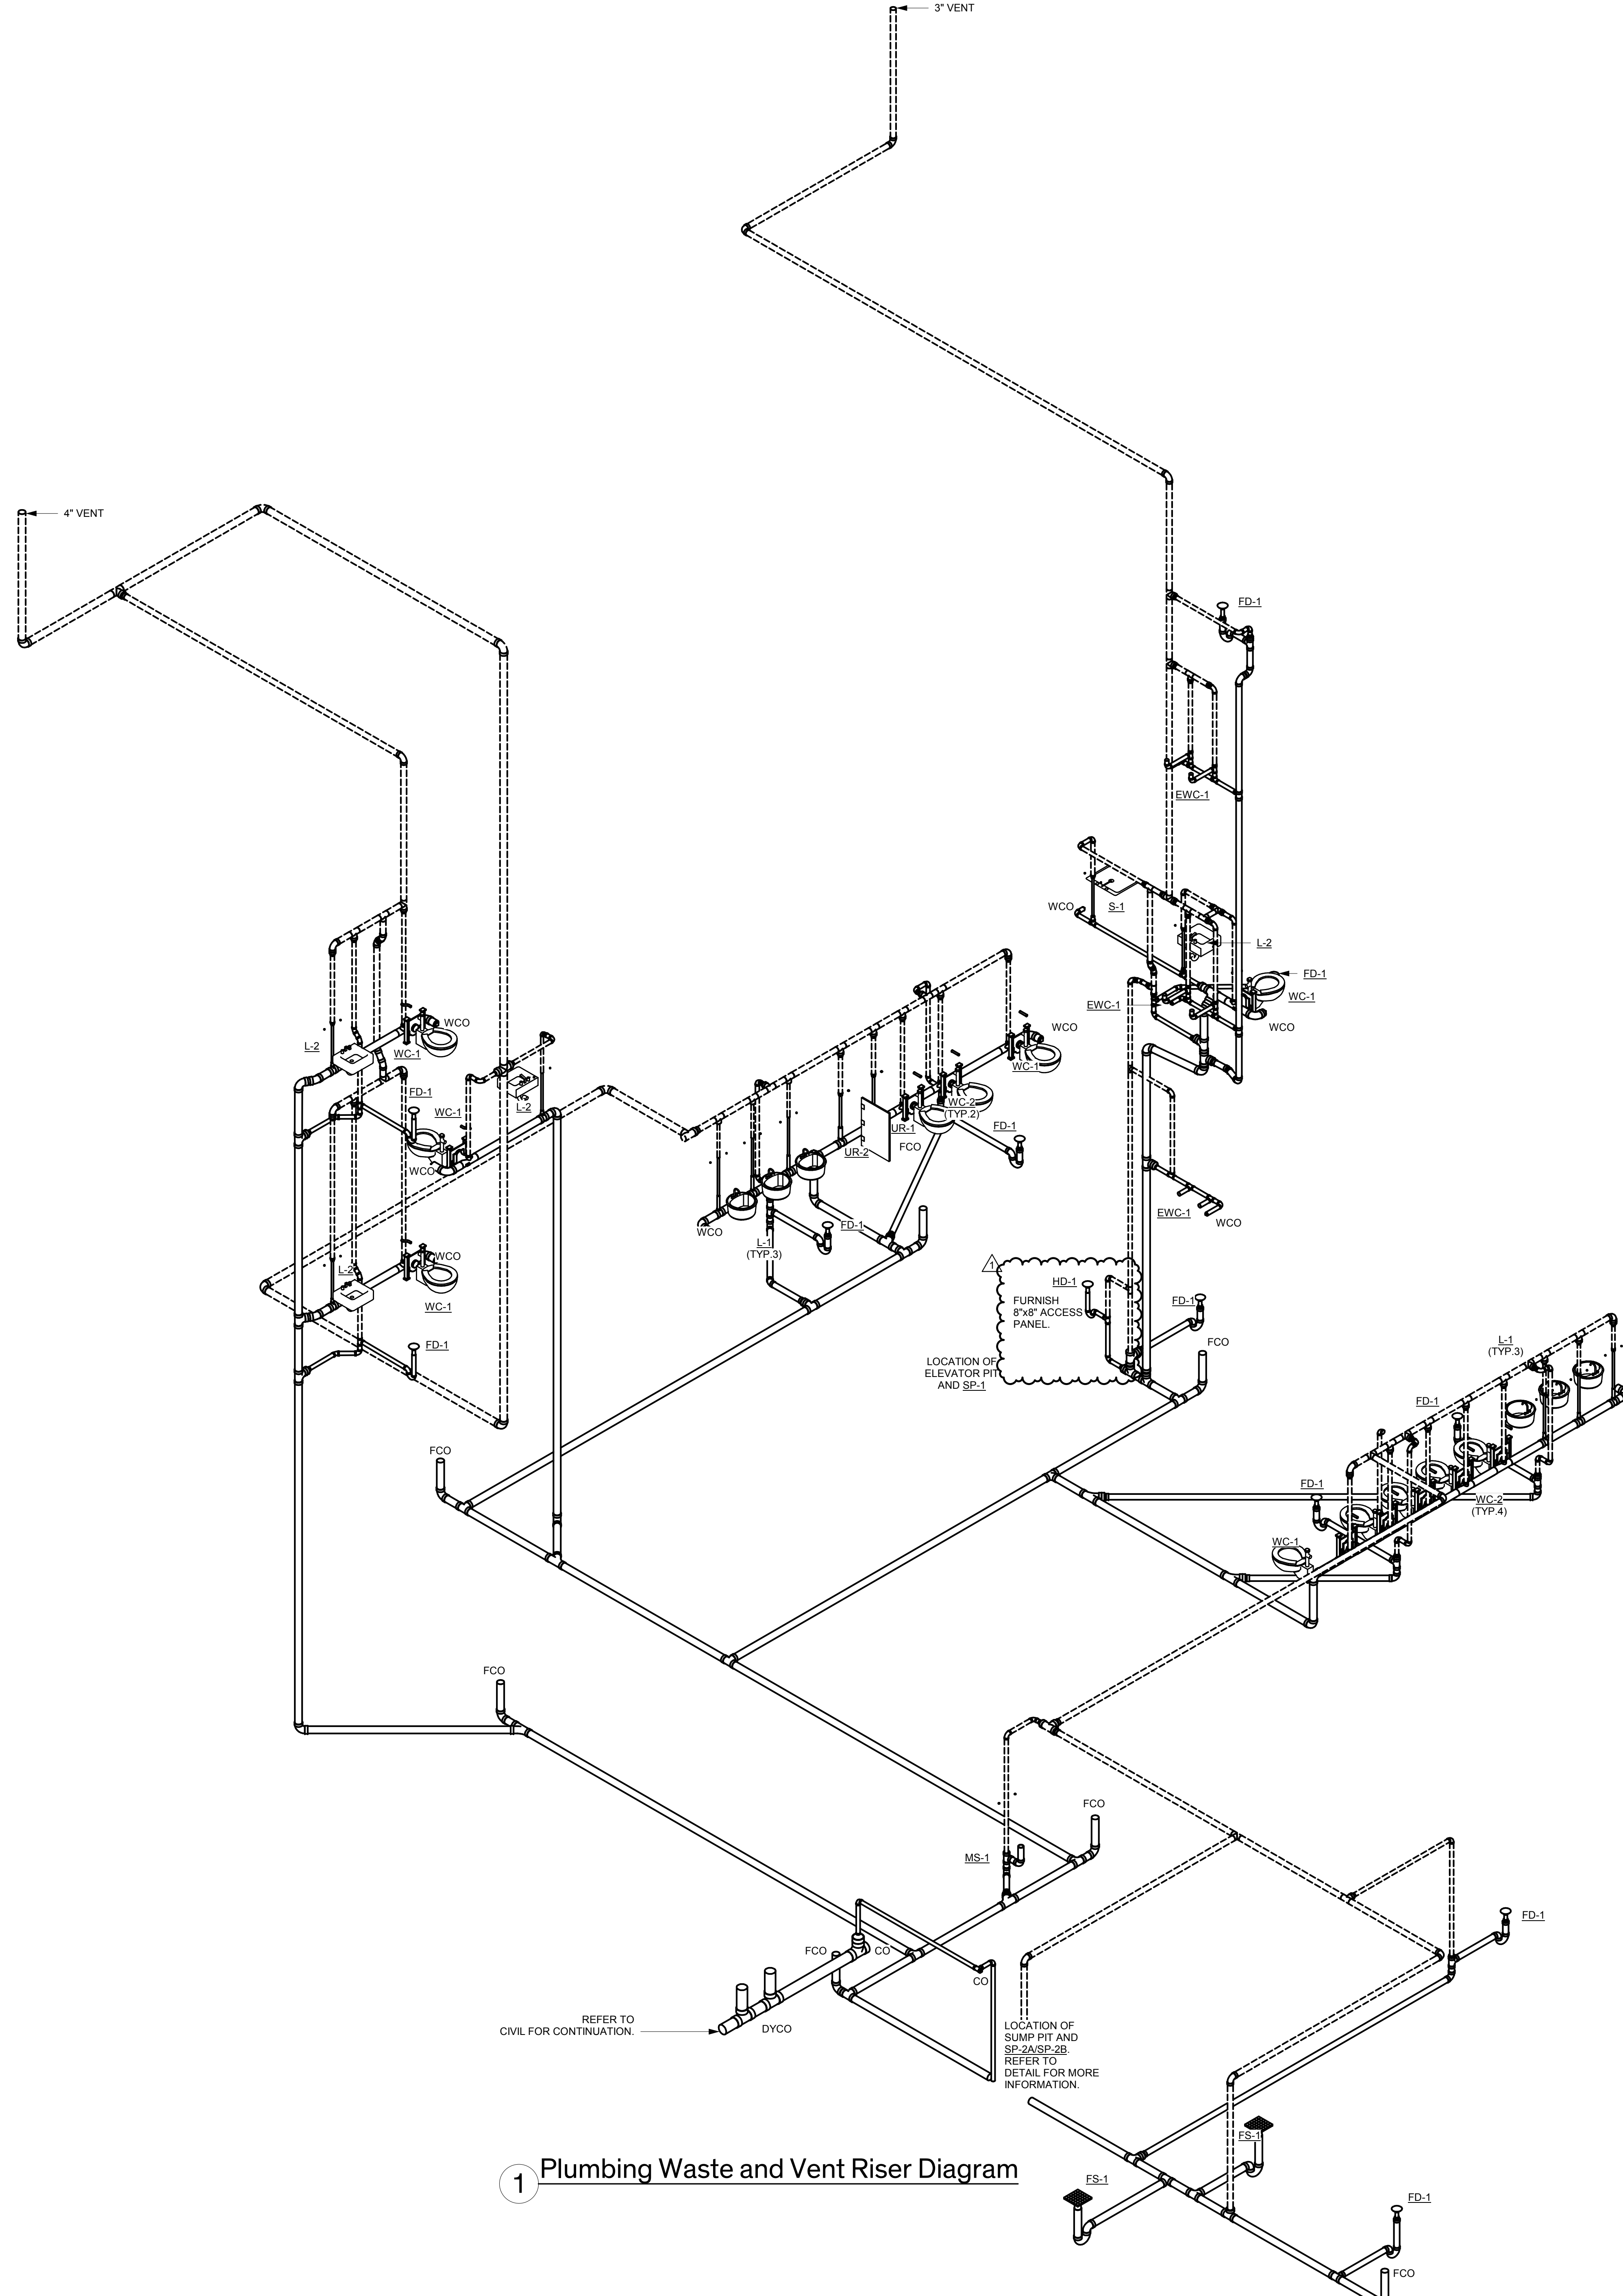

1 Plumbing Waste and Vent Riser Diagram

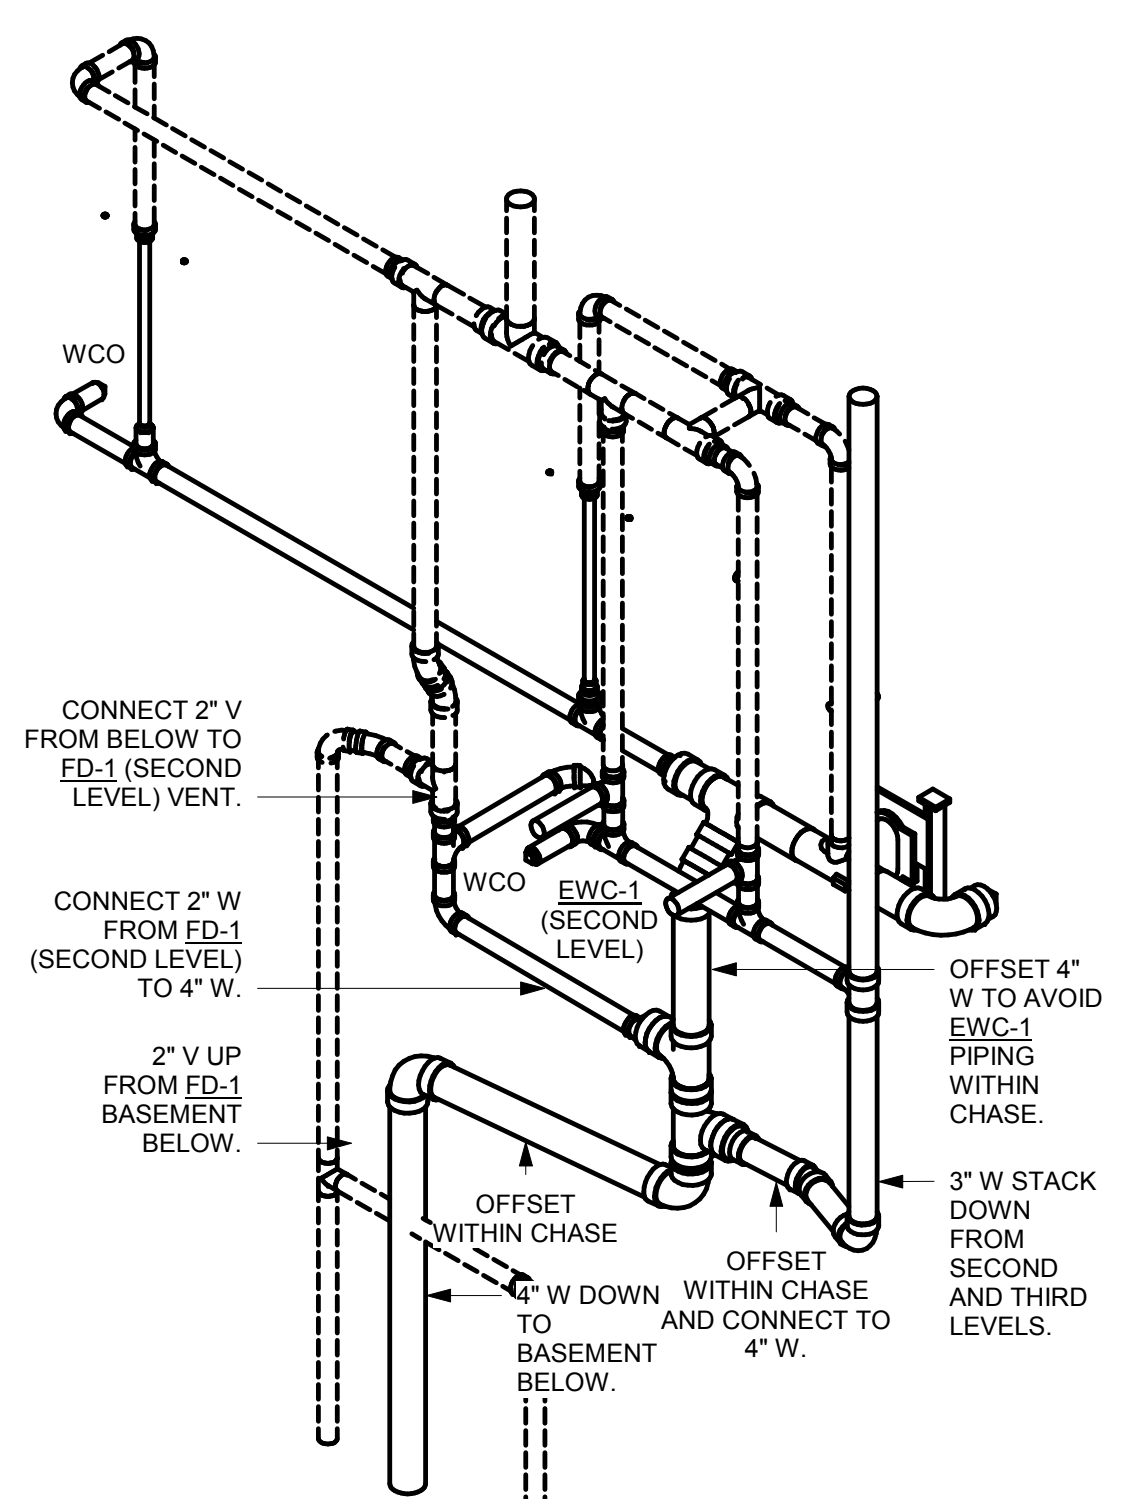

2 Ground Level Plumbing Chase



## STORAGE TYPE ELECTRIC WATER HEATER SCHEDULE

MARK	LOCATION	INPUT (KW)	STORAGE CAPACITY (GALLON)	TEMPERATURE RISE (F)	RECOVERY @ 30 F RISE (GPH)	ELECTRICAL DATA			MANUFACTURER	MODEL NUMBER
						VOLTAGE	PHASE	FLA		
WH-1	MECH 007	4.0	40	80	20	208	3	38.4	AO SMITH	DEL-40

- EQUIP WATER HEATER WITH TEMPERATURE LIMITING DEVICE. SET FOR 140 (F).
- FURNISH AND INSTALL WATTS MODEL PLT-5 EXPANSION TANK.

## SUMP PUMP SCHEDULE


MARK	LOCATION	CAPACITY (GPM)	MAXIMUM HEAD (FT)	MOTOR HORSE POWER	DISCHARGE SIZE (IN)	RPM	ELECTRICAL DATA			MANUFACTURER	MODEL NUMBER
							VOLTAGE	PHASE	HZ		
SP-1	ELEVATOR SHAFT	50	19	1/3	2	1750	120	1	60	LITTLE GIANT	WS30M
SP-2A	STORAGE 008	45	20	1	2	1750	208	3	60	LITTLE GIANT	WS102M
SP-2B	STORAGE 008	45	20	1	2	1750	208	3	60	LITTLE GIANT	WS102M
SP-3	NORTH LAWN	45	20	4/10	2	1750	120	1	60	LITTLE GIANT	95N-CIA-RF

- REFER TO SPECIFICATIONS AND DETAILS FOR MORE INFORMATION.
- PROVIDE SP-1 WITH ALDERON CONTROL PANEL AND REMOTE ALARM. SYSTEM SHALL HAVE AUTOMATIC CONTROL FLOAT SWITCHES; PUMP ON, PUMP OFF, AND HIGH WATER ALARM. ALL FIELD ADJUSTABLE AND WITH POWER CORD, CHECK VALVE AND SHUT OFF VALVE.
- PROVIDE SP-2A AND SP-2B WITH 3 PHASE DUPLEX CONTROL/ALARM PANEL WITH THREE SENSOR FLOATS AND ONE ALARM FLOAT. LITTLE GIANT MODEL 513285. 208/3 WITH 8.0 FLA. EQUIP WITH LITTLE GIANT MODEL CV-SE2 CHECK VALVES.
- PROVIDE SP-3 WITH SIMPLEX CONTROL/ALARM PANEL WITH TWO SENSOR FLOATS AND ONE ALARM FLOAT. LITTLE GIANT MODEL 1121W120H17A. 120/1 WITH 20.0 FLA.
- ALL PUMPS SHALL BE TIED INTO BUILDING AUTOMATION SYSTEM.

## GENERAL PLUMBING SCHEDULE

MARK	FIXTURE	MAX GPM/GPF	CW	HW/TW	WASTE	VENT	DESCRIPTION
AD-1	AREA DRAIN	-	-	-	4"	-	SPECIFIED BY CIVIL. REFER TO CIVIL FOR MORE INFORMATION.
CDP-1	CONDENSATE PUMP	3.5 AT 9' HEAD	-	-	1"	-	LITTLE GIANT MODEL VCL-24UL CONDENSATE PUMP WITH 1 GALLON COLLECTION TANK. 120/1. 1/18 HP.
CP-1	CLOSE COUPLED IN-LINE HOT WATER CIRCULATION PUMP	10 AT 10' HEAD	-	-	-	-	ARMSTRONG MODEL 20-20SS VARIABLE SPEED CIRCULATOR. 0' TO 20' HEAD RANGE. MINIMUM 5 WATTS. MAXIMUM 45 WATTS. 120/1. PUMP CONTROLS SHALL BE CAPABLE OF LIMITING THE OPERATION OF THE CIRCULATING PUMP FROM HEATING CYCLE START-UP TO NOT GREATER THAN 5 MINUTES AFTER THE END OF THE CYCLE.
DYCO	DOUBLE YARD CLEANOUT	-	-	-	*	-	JOSAM MODEL 58680 CAST IRON DOUBLE YARD CLEANOUT. PROVIDE "T" HANDLE WRENCH.
EWC-1	BH-LEVEL ELECTRIC WATER COOLER (TAS)	-	1/2"	-	2"	1-1/2"	ELKAY MODEL LRPBM28K TAS COMPLIANT ELECTRIC WATER COOLER. 120/1.
FCO	FLOOR CLEANOUT	-	-	-	*	-	WATTS MODEL CO-200 CAST IRON FLOOR CLEANOUT.
FD-1	FLOOR DRAIN	-	-	-	*	2"	WATTS MODEL FD-110-A. 5" NICKEL BRONZE STRAINER. EQUIP WITH TRAP PROTECTION DEVICE.
FS-1	FLOOR SINK	-	-	-	4"	2"	WATTS MODEL FS-750. 12" SQUARE. 10" DEEP WITH WHITE FINISH. 3/4 CAST IRON GRATE AND ALUMINUM DOME STRAINER. EQUIP WITH TRAP PROTECTION DEVICE.
HD-1	HUB DRAIN	-	-	-	2"	2"	SIoux CHIEF 832 SERIES HUB DRAIN FIXTURE. PROVIDE WITH DEBRIS SCREEN. HUB DRAIN SHALL BE ACCESSIBLE VIA 6"x6" ACCESS PANEL. BOTTOM OF ACCESS PANEL SHALL BE APPROXIMATELY 12" ABOVE FINISH FLOOR. EQUIP WITH TRAP PROTECTION DEVICE. CONDENSATE SHALL TERMINATE TWO PIPE DIAMETERS ABOVE FLOOR FINISH.
IWH-1	INSTANTANEOUS WATER HEATER	2.0	1/2"	1/2"	-	-	EEMAX MODEL EX4208T N4. 208/1. 4.1 KW. 0.3 GPM TURN ON. SET MAXIMUM WATER TEMPERATURE = 110 F.
L-1	LAVATORY UNDERCOUNTER (TAS)	0.5	1/2"	1/2"	2"	1-1/2"	AMERICAN STANDARD MODEL 9482 000 TAS ACCESSIBLE UNDERCOUNTER LAVATORY. EQUIP WITH: TOTO MODEL TEL115-D10ET COUNTER MOUNT SELF GENERATING FAUCET KIT WITH TOTO MODEL TELC105-D10E CONTROLLER. TOTO MODEL TLT10R ASSE 1070 THERMOSTATIC MIXING VALVE. MOUNTING HARDWARE. 4" COVER PLATE AND SWIVEL COUPLING. LESS MIXING VALVE IF EQUIPPED WITH <u>WHL-1</u> .
L-2	LAVATORY WALL MOUNT (TAS)	0.5	1/2"	1/2"	2"	1-1/2"	AMERICAN STANDARD MODEL 9024 000EC TAS ACCESSIBLE WALL HUNG LAVATORY. NO FAUCET HOLES. EQUIP WITH: TOTO MODEL TEL135-D10ET WALL MOUNT SELF GENERATING FAUCET KIT WITH TOTO MODEL TELC105-D10E CONTROLLER. TOTO MODEL TLT10R ASSE 1070 THERMOSTATIC MIXING VALVE. AND SWIVEL COUPLING. LESS MIXING VALVE IF EQUIPPED WITH <u>WHL-1</u> .
MS-1	MOP SINK	2.2	3/4"	3/4"	3"	2"	FIAT TSB3000 FLOOR SET. SQUARE TERRAZZO MOP SINK WITH STAINLESS STEEL CAPS ON ALL CURBS. EQUIP WITH: FIAT MODEL 832AA HOSE & HOSE BRACKET. AND MOEN 8230 MANUALLY-OPERATED FAUCET.
NFYH-1	NON-FREEZE YARD HYDRANT	-	3/4"	-	-	-	WOODFORD MODEL Y95 ANTI-SIPHON NON-FREEZE YARD HYDRANT. INSTALLED FLUSH WITH SURROUNDING SURFACES.
RPBP-1	REDUCED PRESSURE ZONE BACKFLOW PREVENTER	-	3"	-	-	-	WATTS MODEL 957 REDUCED PRESSURE ZONE ASSEMBLY WITH BALL TYPE SHUT-OFF VALVE.
S-1	SINGLE BOWL SINK (TAS)	1.0	1/2"	1/2"	2"	1-1/2"	ELKAY MODEL ELUHAD211556PD UNDERMOUNT SINK. EQUIP WITH: MOEN MODEL 8780 MANUALLY-OPERATED FAUCET AND TOTO MODEL TLT10R ASSE 1070 THERMOSTATIC MIXING VALVE.
TMV-1	THERMOSTATIC MIXING VALVE	14	-	3/4"	-	-	POWERS MODEL LFM431 MASTER MIXING VALVE. 5 PSI PRESSURE DROP ACROSS THE VALVE. SET OUTLET TEMPERATURE TO 120°F.
UR-1	URINAL WALL MOUNT. WALL OUTLET FLUSH VALVE	0.125	-	-	-	-	AMERICAN STANDARD MODEL 6042453 WALL HUNG URINAL WITH SELECTRONIC MODEL 6063513 BATTERY POWERED CHROME FINISH FLUSH VALVE.
UR-2	URINAL WALL MOUNT. WALL OUTLET FLUSH VALVE (TAS)	0.125	-	-	-	-	AMERICAN STANDARD MODEL 6042453 WALL HUNG. TAS ACCESSIBLE URINAL WITH SELECTRONIC MODEL 6063513 BATTERY POWERED CHROME FINISH FLUSH VALVE.
WC-1	WATER CLOSET WALL MOUNT. FLUSH VALVE (TAS)	1.1	1"	-	4"	2"	AMERICAN STANDARD MODEL 3351 511 WALL HUNG. TAS ACCESSIBLE WATER CLOSET WITH SELECTRONIC MODEL 6065 111 BATTERY POWERED CHROME FINISH FLUSH VALVE.
WC-2	WATER CLOSET WALL MOUNT. FLUSH VALVE	1.1	1"	-	4"	2"	AMERICAN STANDARD MODEL 3351 511 WALL HUNG. WATER CLOSET WITH SELECTRONIC MODEL 6065 111 BATTERY POWERED CHROME FINISH FLUSH VALVE.
WCO	WALL CLEANOUT	-	-	-	*	-	WATTS MODEL CO-380-RD WALL CLEANOUT WITH BRASS PLUG AND STAINLESS STEEL COVER.

- THE SCHEDULE ABOVE IS INFORMATIONAL AND IS IN NO WAY INTENDED TO SPECIFY ALL NECESSARY APPURTENANCES FOR THE FIXTURES LISTED. IT IS THE RESPONSIBILITY OF THE CONTRACTOR TO PROVIDE COMPLETE AND OPERATING PLUMBING SYSTEMS.
- PROVIDE AND INSTALL STOPS AT ALL FIXTURES.
- REFER TO NOTE BY SYMBOLS/NOTES ON DRAWINGS FOR HW/TW CONNECTION TYPE.
- PROVIDE AND INSTALL WALL CLEANOUTS WHERE REQUIRED BY THE IPC.
- COORDINATE FIXTURE COLORS AND FIXTURE FINISHES WITH ARCHITECT PRIOR TO ORDERING.
- WHERE REQUIRED, PLUMBING FIXTURES SHALL BE INSTALLED AT A HEIGHT THAT IS CONSISTENT WITH TAS REQUIREMENTS. REFER TO ARCHITECTURAL DRAWINGS FOR MOUNTING HEIGHTS OF ALL WALL HUNG FIXTURES.
- \* FIXTURE SHALL MATCH PIPE SIZE ON PLAN/RISER.

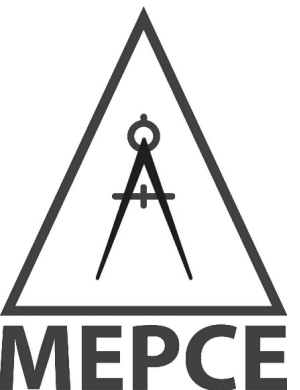

### COPYRIGHT

The Contractor shall verify and be responsible for all dimensions. DO NOT scale the drawing. Any errors or omissions shall be reported to Architexas without delay. The Copyrights to all designs and drawings are the property of Architexas. Reproduction or use for any purpose other than that authorized by Architexas is forbidden.


### REVISION HISTORY

1 10/16/18 Addendum 1

### ADDENDUM 1






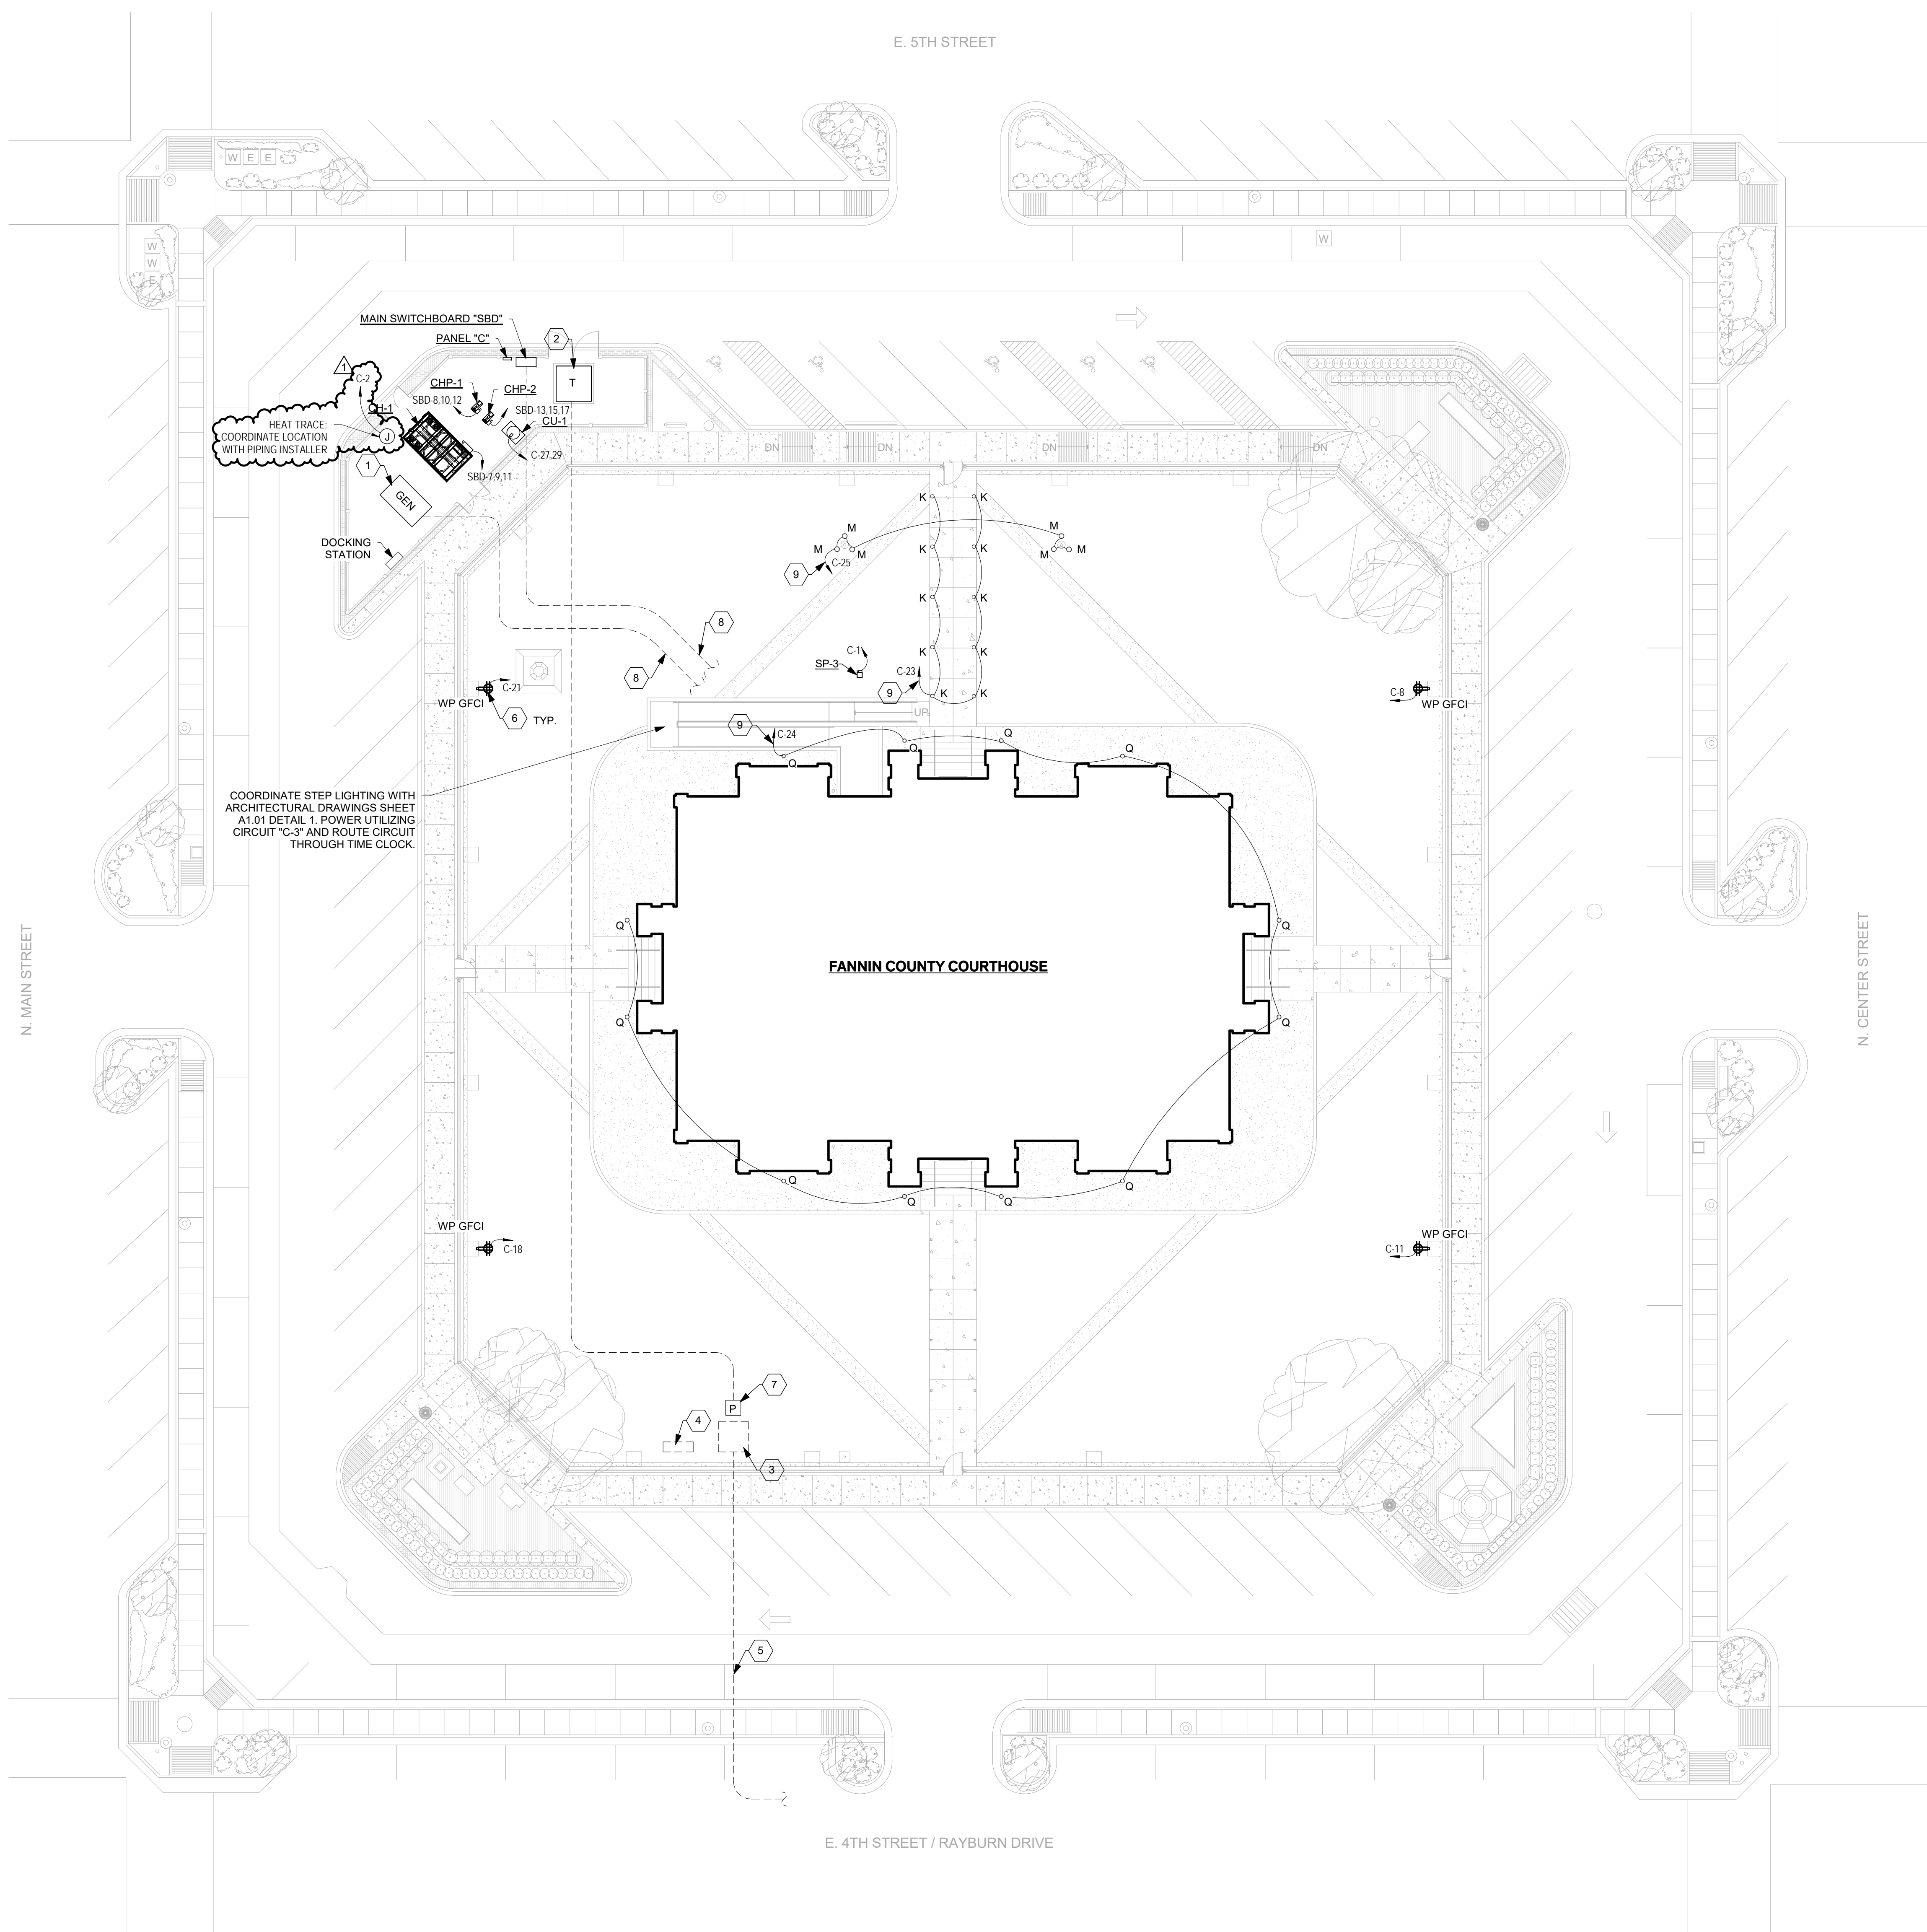

NOTES BY SYMBOL	
1	PROVIDE AND INSTALL NEW GENERATOR SET PER SPECIFICATIONS. PROVIDE AND INSTALL 1" CONDUIT WITH CONTROL WIRING TO REMOTE ANNUNCIATOR. PROVIDE AND INSTALL 1" CONDUIT WITH CONTROL WIRING TO ATS. PROVIDE AND INSTALL CIRCUITS FOR BATTERY CHARGER AND GENERATOR ACCESSORIES ACCORDINGLY. REFER TO RISER DIAGRAM AND SPECIFICATIONS FOR ADDITIONAL INFORMATION.
2	NEW UTILITY COMPANY PAD MOUNTED TRANSFORMER. PROVIDE AND INSTALL CONCRETE PAD PER ONCOR GUIDELINES. REFER TO ONCOR ELECTRIC SERVICE GUIDELINES FOR PAD/CONDUIT STUB UP REQUIREMENTS (WWW.ONCOR.COM).
3	EXISTING TRANSFORMER TO BE REMOVED BY ONCOR. CONTRACTOR TO REMOVE EXISTING PAD AND ASSOCIATED CONDUITS. COORDINATE WITH ONCOR FOR REMOVAL OR ABANDONMENT OF PRIMARY CONDUITS.
4	DEMOLISH EXISTING PEDESTAL, PAD, CONDUIT AND ALL OTHER CORRESPONDING ELECTRICAL INFRASTRUCTURE.
5	EXISTING UTILITY PRIMARY CONDUIT/CONDUCTORS. FIELD VERIFY EXACT LOCATION.
6	INSTALL QUADPLEX GFCI RECEPTACLE ON WALL BELOW FENCE.
7	PROVIDE AND INSTALL ONCOR HANDHOLE TO EXTEND EXISTING ONCOR PRIMARY FEEDER. COORDINATE WITH ONCOR FOR SIZING AND ADDITIONAL REQUIREMENTS.
8	ROUTE CONDUIT AND CONDUCTORS TO ELECTRICAL ROOM. SEE RISER DIAGRAM FOR ADDITIONAL INFORMATION.
9	ROUTE CIRCUIT THROUGH LIGHTING CONTACTOR.

1 ELECTRICAL SITE PLAN  
1/16" = 1'-0"

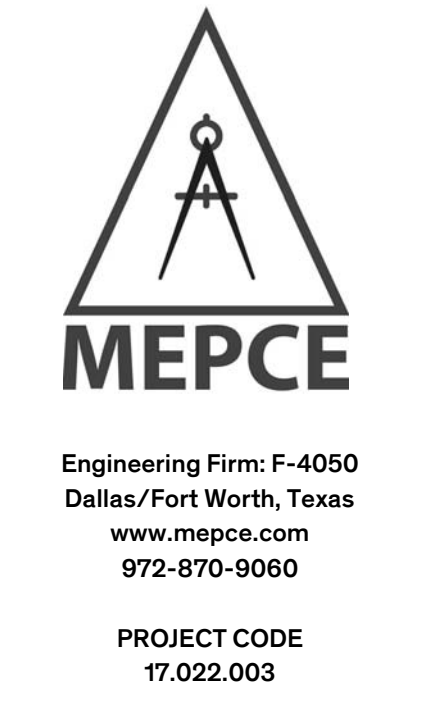

**FANNIN COUNTY COURTHOUSE**  
INTERIOR AND EXTERIOR RESTORATION  
101 E. Sam Rayburn Drive  
Bonham, Texas 75418

**COPYRIGHT**  
The Contractor shall verify and be responsible for all dimensions. DO NOT scale the drawing. Any errors or omissions shall be reported to Architexas without delay. The Copyrights to all designs and drawings are the property of Architexas. Reproduction or use for any purpose other than that authorized by Architexas is forbidden.

REVISION HISTORY	
1	10/16/18 Addendum 1

ADDENDUM 1



10-16-2018  
Architexas No. 1737 Date OCTOBER 16, 2018  
Sheet Name Electrical Site Plan  
Sheet Number







Engineering Firm: F-4050  
Dallas/Fort Worth, Texas  
www.mepce.com  
972-870-9060

PROJECT CODE  
17.022.003



TEXAS HISTORICAL COMMISSION  
real places telling real stories



FANNIN COUNTY  
COURTHOUSE  
INTERIOR AND EXTERIOR  
RESTORATION  
101 E. Sam Rayburn Drive  
Bonham, Texas 75418

**COPYRIGHT**  
The Contractor shall verify and be responsible for all dimensions. DO NOT scale the drawing. Any errors or omissions shall be reported to Architexas without delay. The Copyrights to all designs and drawings are the property of Architexas. Reproduction or use for any purpose other than that authorized by Architexas is forbidden.

**REVISION HISTORY**  
1 10/16/18 Addendum 1

ADDENDUM 1



10-16-2018

Architexas No. 1737 Date OCTOBER 16, 2018

Sheet Name Attic Level Electrical Floor Plans

Sheet Number


E2.05

**LIGHTING CONTROLS TABLE**


Lighting Control Tag	Switching Scheme
1	3-way switches for manual control of fixtures in lobby, locations as shown. No dimming controls. Lights denoted as night lights (nl) shall be ON continuously. Emergency lights (indicated hatched) are to be normally switched via manual wall switches (unless denoted as night lights), but default to ON when loss of normal power is sensed. Use UL924 listed device for emergency light operation.
2	Manual wall switch at location shown for ON/OFF control of all fixtures in room. No dimming controls. Lights shall be switched with the normal circuit in room, but automatically switch to ON position and from the emergency circuit indicated in the event of loss of the normal power circuit.
3	Corridor/Public Lobby lighting shall normally be controlled via timer-controlled relays in lighting control panel at each floor. Coordinate with Owner for scheduling of ON/OFF operation for corridor/lobby lighting. Lights shall come ON at scheduled time in the morning, and shall turn OFF at scheduled time in the evening. Lights shall provide warning blink 5 minutes in advance of scheduled OFF time. Provide push-button override switch at each major entry to corridors or lobby for after-hours operation. Wall push buttons at corridors / lobbies shall be disabled during normally scheduled ON operation. Pressing of push button override switches during after-hours operation shall turn ON all corresponding corridor or lobby light fixtures for a set period of 1 hour. After 1 hour ON duration, lights shall provide warning blink, and then turn OFF 5 minutes following blink. Lights shall then return to after-hours state. No dimming required for corridors and public lobbies. Lights shall be fully networked through the lighting control system, such that schedules and override settings may be modified at a head-end networked computer.
4	Ceiling occupancy sensor(s) with wall mounted override switch(es). No dimming controls. No networked controls. All lights in room shall be automatic on via occupancy sensor(s), and automatic or manual off via occupancy sensor(s)/switch(es). Emergency lights (indicated as hatched) are to be normally switched (unless denoted as night lights), but default to ON when loss of normal power is sensed. Use UL924 listed device for emergency light operation. Night lights shall be unswitched.
5	3-way switches for manual control of fixtures in work room, locations as shown. No dimming controls. Lights denoted as night lights (nl) shall be ON continuously. Emergency lights (indicated hatched) are to be normally switched via manual wall switches (unless denoted as night lights), but default to ON when loss of normal power is sensed. Use UL924 listed device for emergency light operation.
6	Combination dimming wall switch/occupancy sensor at location shown. Lights shall be manual ON via switch and automatic OFF via sensor. Switch shall provide for continuous dimming of lights in room. No emergency lights. No networked controls.
7	Stairwell lights to be unswitched. No networked controls. Normal and emergency circuits shall be provided to stairwell lighting as indicated. Use UL924 listed device for emergency lighting operation (each floor).
8	Provide ceiling mounted occupancy sensor coverage for full coverage of room. Upon sensing initial occupancy, general overhead lighting shall come on to 50% dimmed. Provide touch-screen controller at main entry to room, with options for multiple scene selections and dimming control. Row of general lighting at front of room shall have independent dimming control. Balcony lighting shall have independent dimming control. Each different type of light fixture in room shall have independent dimming/relay control. Coordinate with Owner for programming of scene selections and dimming presets. Lights shall be fully networked through the lighting control system, such that schedules and override settings may be modified at a head-end networked computer.

**GENERAL NOTES**

1. ALL EMERGENCY LIGHTS INDICATED WITH A HATCH SHALL BE POWERED BY CORRESPONDING EMERGENCY PANEL. SEE PANELBOARD SCHEDULE FOR INDICATED EMERGENCY LIGHTING CIRCUITS. BASEMENT, GROUND, AND SECOND LEVELS UTILIZE PANELBOARD "B" WHILE THIRD AND ATTIC LEVELS UTILIZE PANELBOARD "EA". NO CIRCUIT SHALL BE GREATER THAN 16 AMPS. EMERGENCY LIGHTING SHALL BE CONTROLLED IN ACCORDANCE WITH LIGHTING CONTROLS TABLE.
2. ALL GENERAL LIGHTING SHALL BE POWERED BY CORRESPONDING NORMAL PANEL. SEE PANELBOARD SCHEDULE FOR INDICATED LIGHTING CIRCUITS. BASEMENT, GROUND, AND SECOND LEVELS UTILIZE PANELBOARD "B" WHILE THIRD AND ATTIC LEVELS UTILIZE PANELBOARD "A". NO CIRCUIT SHALL BE GREATER THAN 16 AMPS.
3. ALL BUILDING MOUNTED EXTERIOR LIGHT FIXTURES SHALL BE CONTROLLED BY LIGHTING CONTROL PANEL.

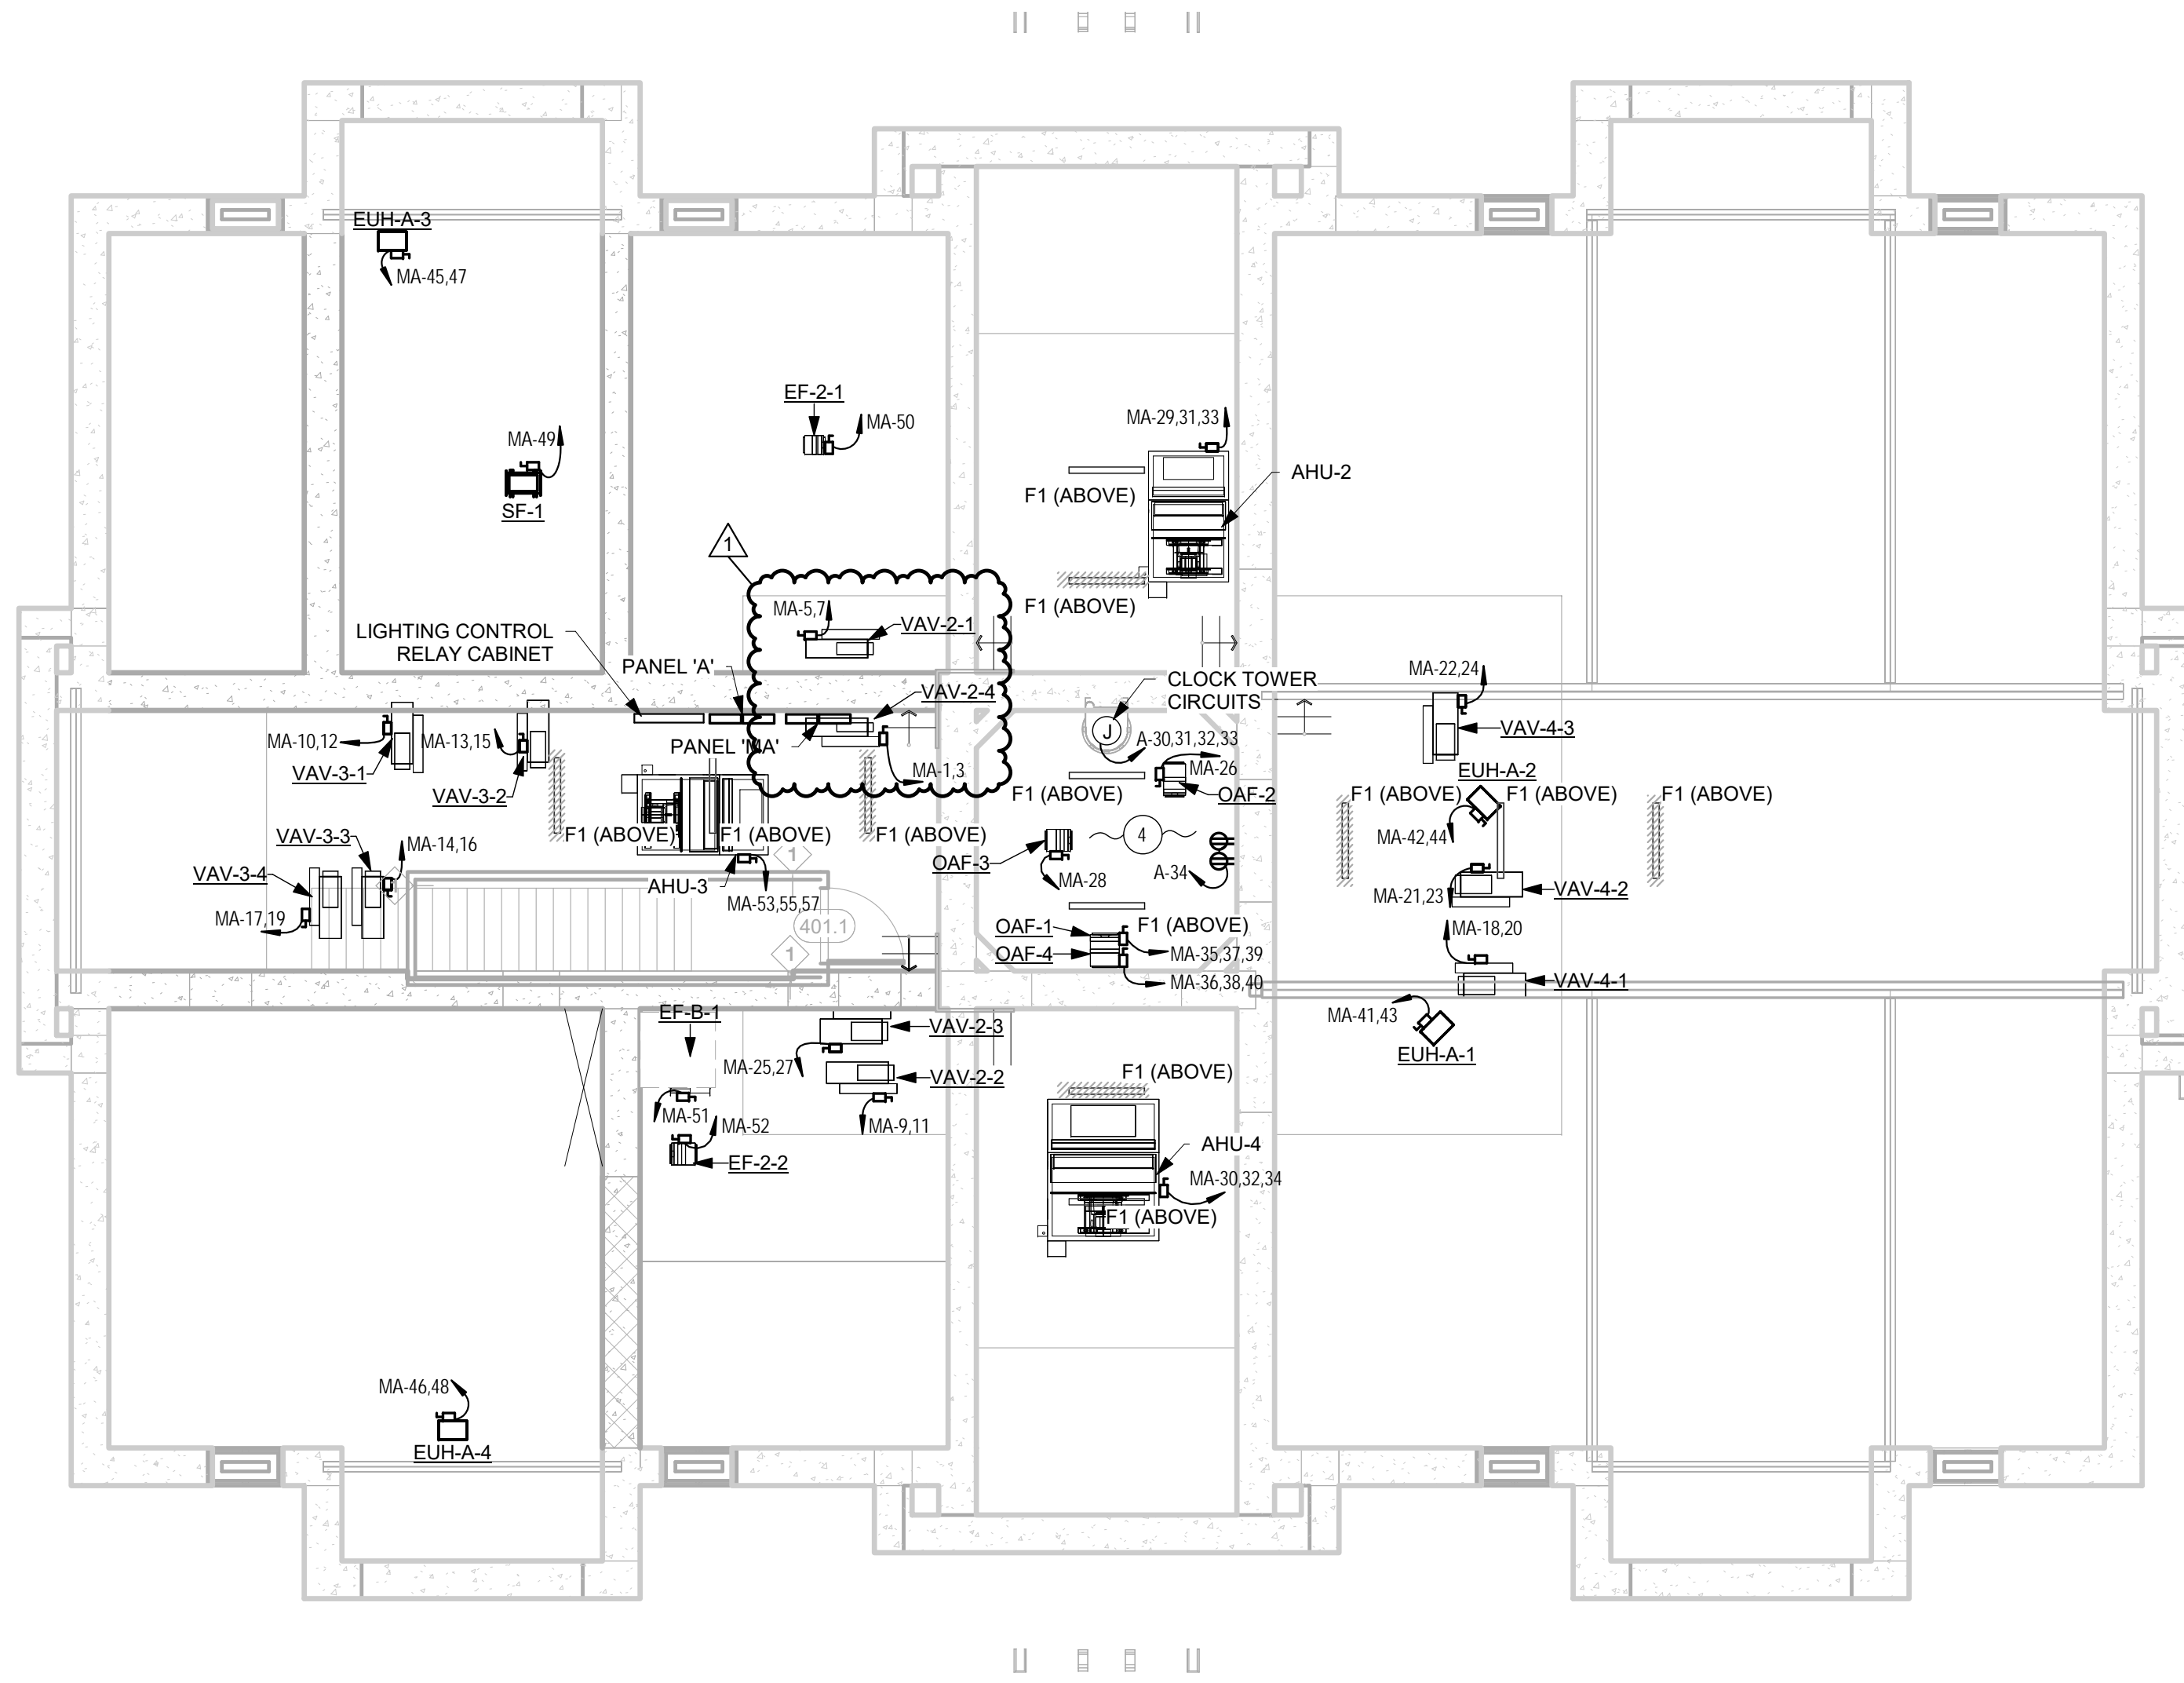

1 Attic Level Electrical Power Floor Plan  
1/8" = 1'-0"

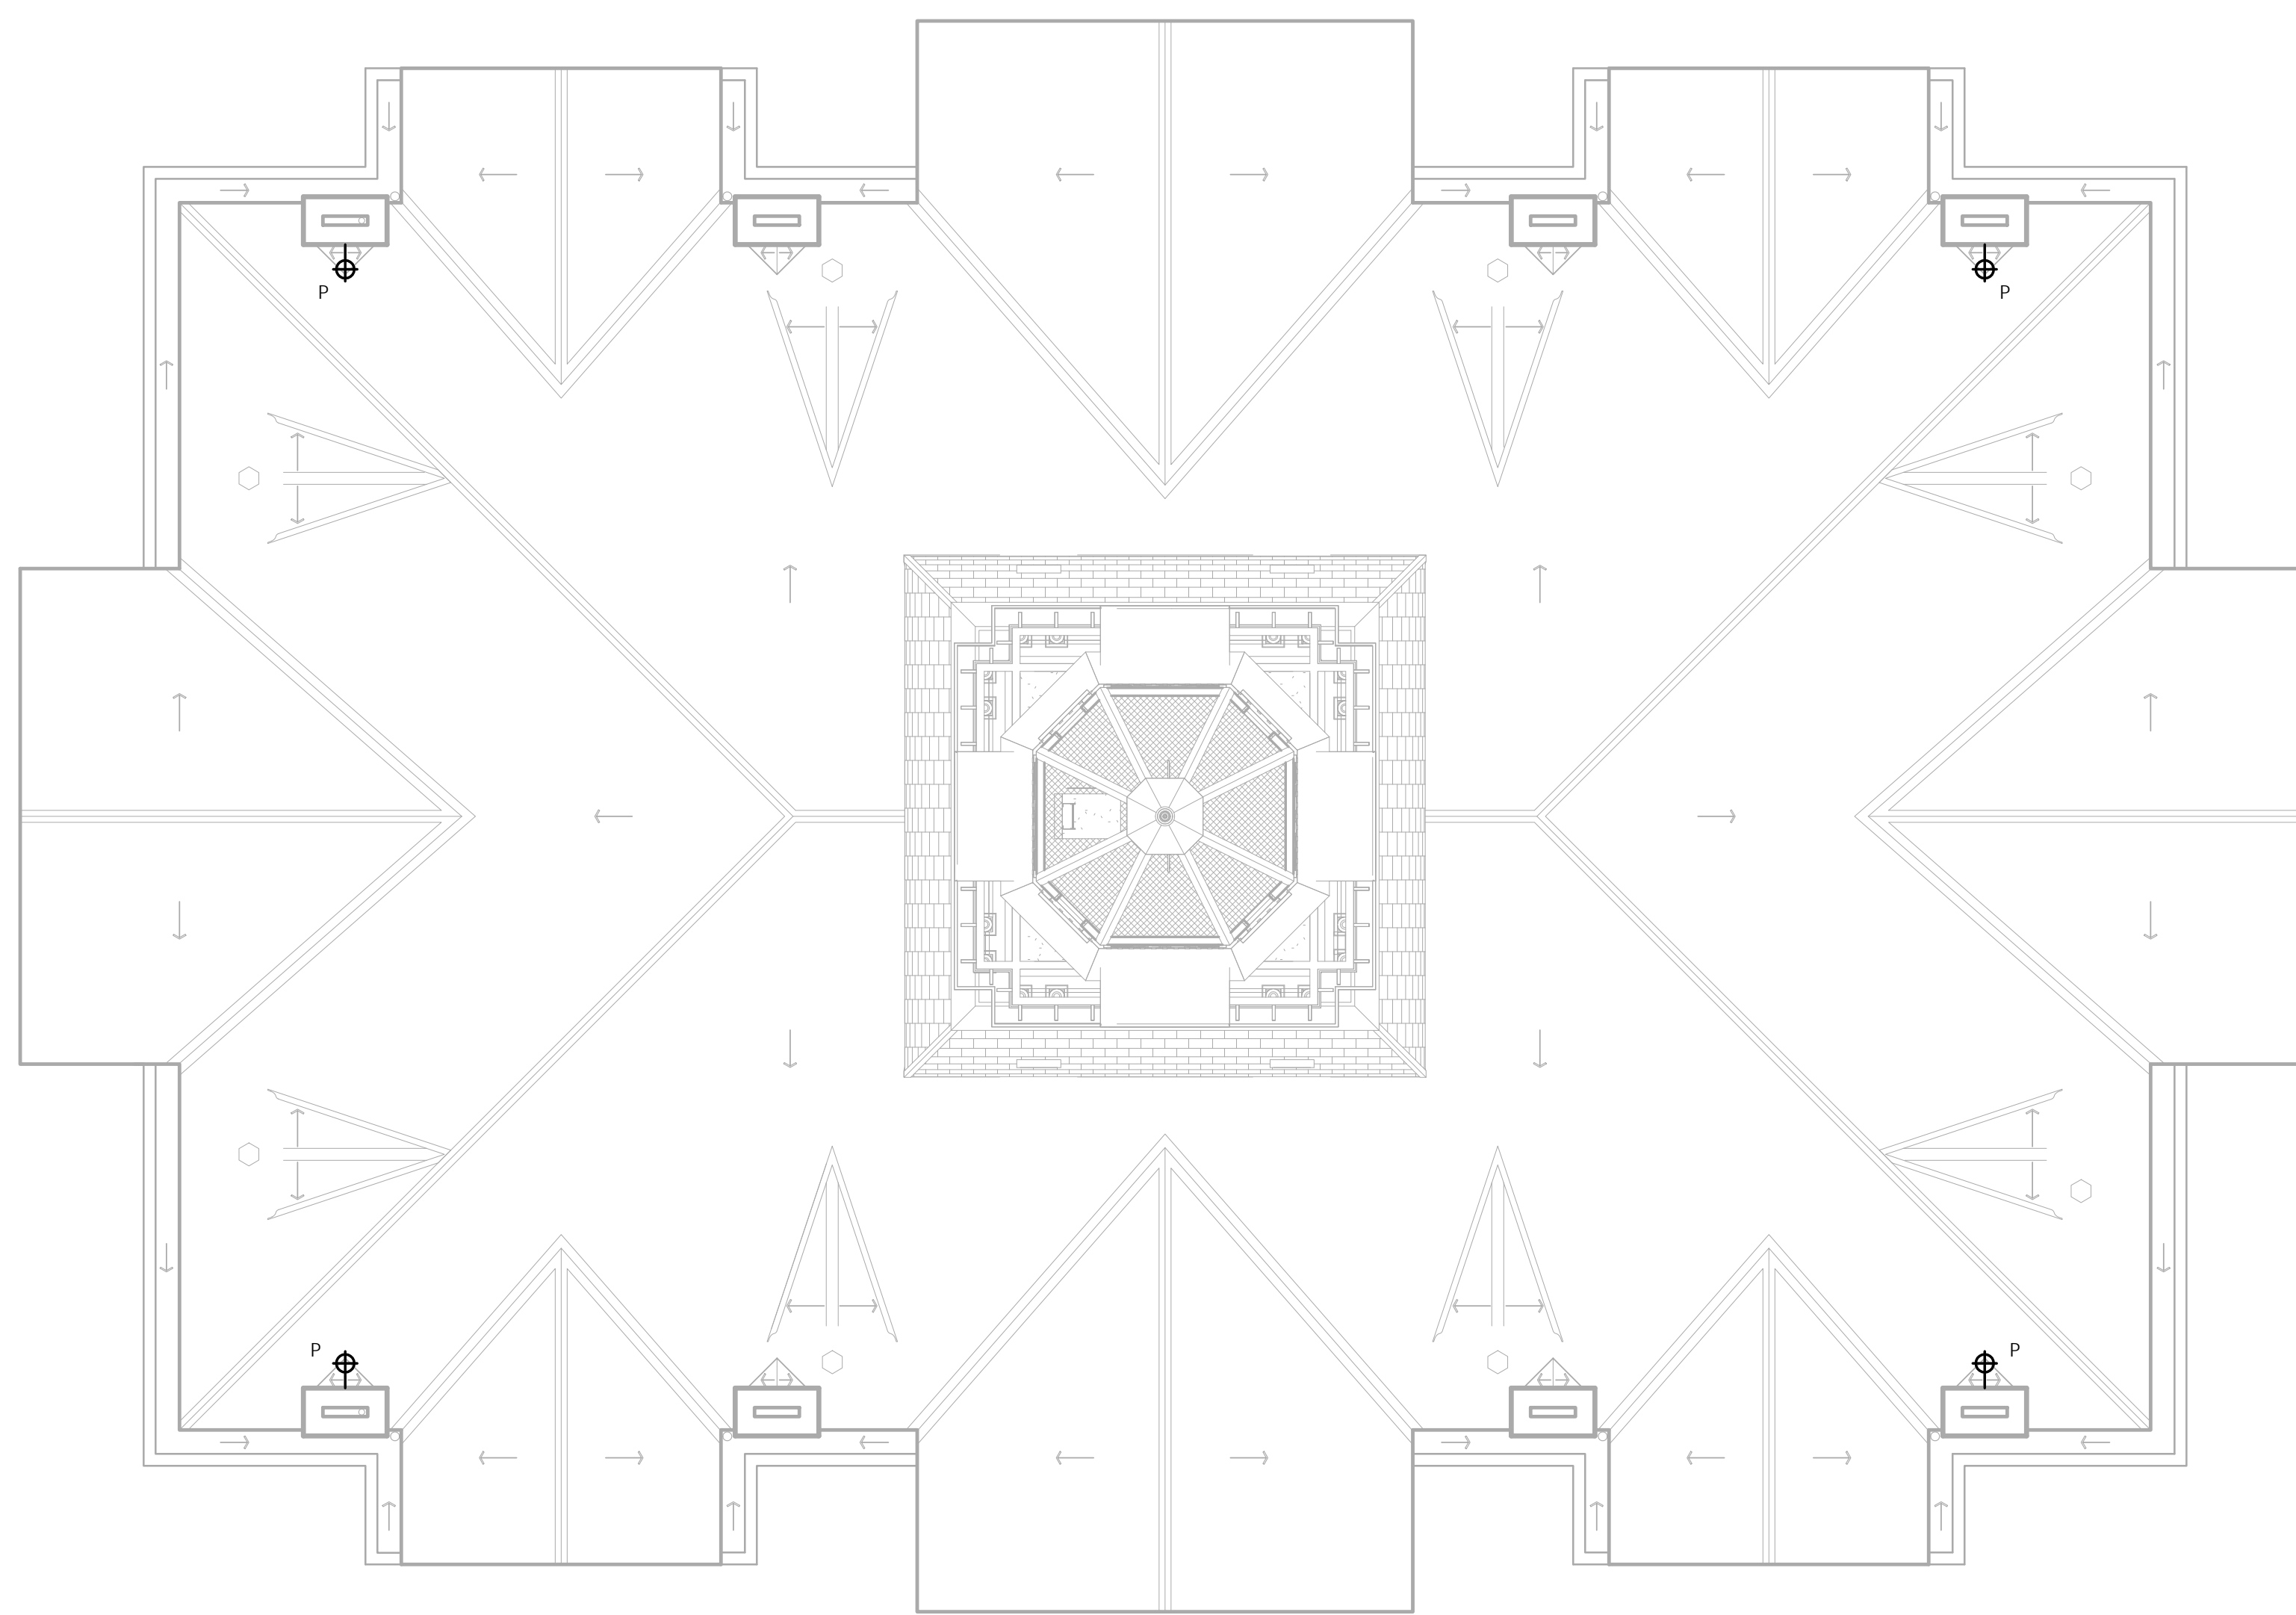

2 Roof Level Lighting Floor Plan  
1/8" = 1'-0"

Branch Panel: MA

Location: Supply From: DP Mounting: Surface Enclosure: Type 1

Volts: 208Y/120 Phases: 3 Wires: 4

A.I.C. Rating: 22K Mains Type: MLO Mains Rating: 600 A MCB Rating:

Notes:

Table with columns: CKT, Circuit Description, Trip, Poles, A, B, C, Poles, Trip, Circuit Description, CKT. Includes load classification and totals.

Legend and Load Classification table for Branch Panel MA.

Notes for Branch Panel MA.

Branch Panel: SBD

Location: Supply From: Surface Mounting: Surface Enclosure: Type 3R

Volts: 208Y/120 Phases: 3 Wires: 4

A.I.C. Rating: 65K Mains Type: MCB Mains Rating: 1600 A MCB Rating:

Notes:

Table with columns: CKT, Circuit Description, Trip, Poles, A, B, C, Poles, Trip, Circuit Description, CKT. Includes load classification and totals.

Legend and Load Classification table for Branch Panel SBD.

Notes for Branch Panel SBD.

Branch Panel: DP

Location: MECH. 008 Supply From: SBD Mounting: Surface Enclosure: Type 1

Volts: 208Y/120 Phases: 3 Wires: 4

A.I.C. Rating: 42K Mains Type: MLO Mains Rating: 1000 A MCB Rating:

Notes:

Table with columns: CKT, Circuit Description, Trip, Poles, A, B, C, Poles, Trip, Circuit Description, CKT. Includes load classification and totals.

Legend and Load Classification table for Branch Panel DP.

Notes for Branch Panel DP.

Branch Panel: MB

Location: Supply From: DP Mounting: Surface Enclosure: Type 1

Volts: 208Y/120 Phases: 3 Wires: 4

A.I.C. Rating: 22K Mains Type: MLO Mains Rating: 225 A MCB Rating:

Notes:

Table with columns: CKT, Circuit Description, Trip, Poles, A, B, C, Poles, Trip, Circuit Description, CKT. Includes load classification and totals.

Legend and Load Classification table for Branch Panel MB.

Notes for Branch Panel MB.

EQUIPMENT SCHEDULE BY SYMBOL

Equipment Schedule table with columns: SYMBOL, DESCRIPTION, LOAD, UNITS, VOLTS/PHASE, DISCONNECT, COMMENTS.

- NOTES: 1. VERIFY ALL MOUNTING REQUIREMENTS WITH EQUIPMENT PROVIDER... 2. VERIFY ACTUAL EQUIPMENT LOADS AND CONNECTION REQUIREMENTS... 3. CONTRACTOR SHALL PROVIDE APPROPRIATE RECEPTACLE...



Engineering Firm: F-4050 Dallas/Fort Worth, Texas www.mepce.com 972-870-9060

PROJECT CODE 17.022.003



TEXAS HISTORICAL COMMISSION real places telling real stories



FANNIN COUNTY COURTHOUSE INTERIOR AND EXTERIOR RESTORATION 101 E. Sam Rayburn Drive Bonham, Texas 75418

COPYRIGHT The Contractor shall verify and be responsible for all dimensions. DO NOT scale the drawing. Any errors or omissions shall be reported to Architexas without delay.

REVISION HISTORY 1 10/16/18 Addendum 1

ADDENDUM 1



Architexas No. 1737 Date OCTOBER 16, 2018

Sheet Name Electrical Schedules

Sheet Number



Branch Panel: C

Location: Supply From: SBD
Mounting: Surface
Enclosure: Type 3R

Volts: 208Y/120
Phases: 3
Wires: 4

A.I.C. Rating: 22K
Mains Type: MLO
Mains Rating: 100 A
MCB Rating:

Table with columns: CKT, Circuit Description, Trip, Poles, A, B, C, Poles, Trip, Power, Circuit Description, CKT. Includes circuit details for SP-3, ADA Step Lighting, Exterior Receptacle, Building In-Grade Lighting, and South Sidewalk Lighting.

Legend and Load Classification table. Legend lists components like Receptacle. Load Classification table shows Connected Load, Demand Factor, Estimated Demand, and Panel Totals.

Notes:

Branch Panel: B

Location: Supply From: DP
Mounting: Surface
Enclosure: Type 1

Volts: 208Y/120
Phases: 3
Wires: 4

A.I.C. Rating: 22K
Mains Type: MLO
Mains Rating: 225 A
MCB Rating:

Table with columns: CKT, Circuit Description, Trip, Poles, A, B, C, Poles, Trip, Circuit Description, CKT. Includes circuit details for Vending Machine, Receptacle, Lighting, and Power.

Legend and Load Classification table. Legend lists components like Receptacle, Power. Load Classification table shows Connected Load, Demand Factor, Estimated Demand, and Panel Totals.

Notes:

Branch Panel: A

Location: Supply From: DP
Mounting: Surface
Enclosure: Type 1

Volts: 208Y/120
Phases: 3
Wires: 4

A.I.C. Rating: 22K
Mains Type: MLO
Mains Rating: 225 A
MCB Rating:

Table with columns: CKT, Circuit Description, Trip, Poles, A, B, C, Poles, Trip, Circuit Description, CKT. Includes circuit details for Receptacle, Power, and Lighting.

Legend and Load Classification table. Legend lists components like Receptacle, Power. Load Classification table shows Connected Load, Demand Factor, Estimated Demand, and Panel Totals.

Notes:

Branch Panel: EB

Location: Supply From: DP
Mounting: Surface
Enclosure: Type 1

Volts: 208Y/120
Phases: 3
Wires: 4

A.I.C. Rating: 22K
Mains Type: MLO
Mains Rating: 225 A
MCB Rating:

Table with columns: CKT, Circuit Description, Trip, Poles, A, B, C, Poles, Trip, Circuit Description, CKT. Includes circuit details for Generator Battery Charger, Generator Heater, SP-2, Lighting, Receptacle, and Power.

Legend and Load Classification table. Legend lists components like Receptacle, Power. Load Classification table shows Connected Load, Demand Factor, Estimated Demand, and Panel Totals.

Notes:



Engineering Firm: F-4050 Dallas/Fort Worth, Texas www.mepce.com 972-870-9060

PROJECT CODE 17.022.003



TEXAS HISTORICAL COMMISSION real places telling real stories




FANNIN COUNTY COURTHOUSE INTERIOR AND EXTERIOR RESTORATION 101 E. Sam Rayburn Drive Bonham, Texas 75418

COPYRIGHT The Contractor shall verify and be responsible for all dimensions. DO NOT scale the drawing. Any errors or omissions shall be reported to Architexas without delay. The Copyrights to all designs and drawings are the property of Architexas. Reproduction or use for any purpose other than that authorized by Architexas is forbidden.

REVISION HISTORY 1 10/16/18 Addendum 1

ADDENDUM 1

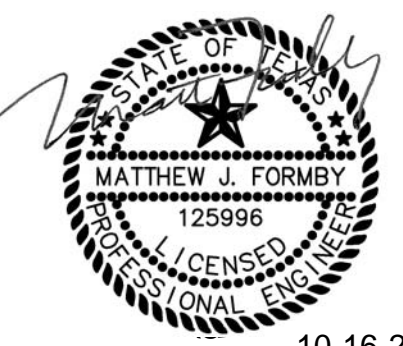

# Table of Contents

---

07 6400	Aluminum Dormers
07 7233	Roof Hatches
07 8100	Applied Fireproofing
07 8123	Intumescent Mastic Fireproofing
07 8400	Firestopping
07 9200	Joint Sealers

## Division 08 – Openings

08 0386	Vault Door Restoration
08 1113	Hollow Metal Doors and Frames
08 1433	Stile and Rail Wood Doors
08 3100	Access Doors and Panels
08 5200	Wood Windows
08 7100	Door Hardware
08 7113	Automatic Door Operators
08 8000	Glazing
08 9100	Louvers

## Division 09 – Finishes

09 2200	Metal Support Assemblies
09 2300	Gypsum Plastering
09 2313	Acoustical Plastering
09 2900	Gypsum Board
09 3000	Tiling
09 6400	Wood Flooring
09 6516	Resilient Sheet Flooring
09 6723	Resinous Flooring
09 9100	Painting

## Division 10 – Specialties

10 1200	Bulletin Boards
10 1400	Signage
10 1460	Accessible Parking Signs
10 2116	Plastic Toilet Compartments
10 2813	Toilet Accessories
10 4413	Fire Extinguishers
10 7429	Historic Cupola Clock Tower

## Division 11 – Equipment

11 5213	Projection Screens
---------	--------------------



9/21/18



**SECTION 05 5000**  
**METAL FABRICATIONS**

**PART 1 GENERAL**

1.1 SUMMARY

- A. Section Includes:
1. Shop fabricated metal components.
  2. Ladders.
  3. Guardrails and handrails.
  4. Replication of original corrugated metal ceilings.
  5. Recreation of vault doors.
  6. Recreation of metal window shutters.
  7. Outriggers at gutters.
  8. Cast Iron Stairs
- B. Related Sections:
1. Division 01: Administrative, procedural, and temporary work requirements.

1.2 REFERENCES

- A. American Welding Society (AWS) D1.1 - Structural Welding Code - Steel.
- B. ASTM International (ASTM):
1. A36/A36M - Standard Specification for Carbon Structural Steel.
  2. A47/A47M - Standard Specification for Ferritic Malleable Iron Castings.
  3. A48/A48M - Standard Specification for Gray Iron Castings.
  4. A108 - Standard Specification for Steel Bars, Carbon, Cold-Finished, Standard Quality.
  5. A123/A123M - Standard Specification for Zinc (Hot-Galvanized) Coatings on Iron and Steel Products.
  6. A283 - Standard Specification for Low and Intermediate Tensile Strength Carbon Steel Plates, Shapes and Bars.
  7. A307 - Standard Specification for Carbon Steel Externally Threaded Standard Fasteners.
  8. A500 - Standard Specification for Cold-Formed Welded and Seamless Carbon Steel Structural Tubing in Rounds and Shapes.
  9. A501 - Standard Specification for Hot-Formed Welded and Seamless Carbon Steel Structural Tubing.
  10. A780 - Standard Practice for Repair of Damaged and Uncoated Areas of Hot-Dip Galvanized Coatings.
  11. A1008/A1008M - Standard Specification for Steel, Sheet, Cold-Rolled, Carbon, Structural, High-Strength Low-Alloy and High-Strength Low-Alloy with Improved Formability.
  12. A1011/A1011M - Standard Specification for Steel, Sheet and Strip, Hot-Rolled, Carbon, Structural, High-Strength, Low-Alloy and High-Strength Low-Alloy with Improved Formability.
  13. E985 - Standard Specification for Permanent Metal Railing Systems and Rails for Buildings.
- C. Society for Protective Coatings (SSPC) - Painting Manual.
- D. Sheet Metal and Air Conditioning Contractors National Association, Inc. (SMACNA).

1.3 SYSTEM DESCRIPTION

- A. Minimum design loads:
1. Ladders:
    - a. Uniform load of 100 PSF.
    - b. Concentrated load of 300 pounds.
    - c. Maximum deflection under loading: L/240.
  2. Guard Rails and Handrails:
    - a. 50 pounds per linear foot applied in any direction at top, transferred via attachments and supports to building structure.
    - b. Concentrated 200 pound load applied in any direction at any point along top, transferred via attachments and supports to building structure.
    - c. Maximum deflection under loading: L/120.
  3. Gutter Supports:
    - a. Sufficient strength to remain intact when full of water.
    - b. Achieve minimum load requirements per SMACNA.

4. Concentrated and uniform loads do not need to be applied simultaneously.
5. Perform design under direct supervision of Professional Structural Engineer licensed in State in which project is located, with minimum 2 years experience in work of this Section.

B. Fabricate guard rails and handrails in accordance with ASTM E985

#### 1.4 SUBMITTALS

A. Submittals for Review:

1. Shop Drawings: Show dimensions, metal thicknesses, finishes, joints, attachments, and relationship of work to adjacent construction.

B. Samples: 4 x 4 finish samples from manufacturer.

C. Quality Control Submittals:

1. Certificate of Compliance from Professional Structural Engineer performing system design.

### **PART 2 PRODUCTS**

#### 2.1 MATERIALS - STEEL

A. Shapes: ASTM A36/A36M.

B. Plate: ASTM A283.

C. Sheet: ASTM A1008/A1008M.

D. Galvanized Sheet: ASTM A653/A653M, Structural Quality, G90 coating class, 24 gage core steel unless noted otherwise.

E. Pipe: ASTM A501.

F. Tube: ASTM A500.

G. Bars: ASTM A108.

#### 2.2 MATERIALS – IRON

A. Cast Iron: ASTM A48/A48M, Class 30, or ASTM A47/A47M.

#### 2.3 ACCESSORIES

A. Exposed Screws: Same material as metal being fastened; Phillips flat head, countersunk, unless noted otherwise.

B. Bolts: ASTM A307, hexagonal head type.

C. Primer Paint: SSPC Paint 15, Type 1, red oxide.

D. Anchoring Cement: Non-shrink cementitious type.

#### 2.4 FABRICATION

A. Fit and shop assemble items in largest practical sections, for delivery to site.

B. Fabricate items with joints tightly fitted and secured.

C. Grind exposed joints flush and smooth with adjacent finish surface. Make exposed joints butt tight, flush, and hairline. Ease exposed edges to small uniform radius.

D. Exposed Mechanical Fastenings: Flush countersunk screws or bolts, unobtrusively located, consistent with design of component except where specifically noted otherwise.



- E. Supply components required for anchorage of fabrications. Fabricate anchors and related components of same material and finish as fabrication, except where specifically noted otherwise.
- F. Conceal fastenings where possible.
- G. Welding to conform to AWS D1.1.
  1. Use welds for permanent connections where possible. Grind exposed welds smooth.
  2. Tack welds prohibited on exposed surfaces.

## 2.5 FINISHES

- A. Exterior Ferrous Metal: Galvanized; ASTM A123/A123M, to 2.0 ounces per square foot.
- B. Interior Ferrous Metal:
  1. Shop painted except steel to be encased in concrete and surfaces to be welded.
  2. Surface preparation: SSPC SP2 - Hand Tool Cleaning or SP3 - Power Tool Cleaning.
  3. Application: One coat; follow coating manufacturer's instructions.
  4. Minimum dry film thickness: 2.0 mils.

## PART 3 EXECUTION

### 3.1 INSTALLATION

- A. Install items in accordance with approved Shop Drawings.
- B. Install components plumb, level, and rigid.
- C. Welding: AWS D1.1. Continuously weld connections. Grind and fill exposed welds; finish smooth and flush.
- D. Make bends uniform and free from buckles and other defects.
- E. Cut intersections square to within 2 degrees and to length within 1/8 inch. Remove burrs from cut ends. Miter and cope intersections within 2 degrees, fit to within 1/8 inch.
- F. Install sleeved components with anchoring cement.
- G. Prevent contact of exterior aluminum and dissimilar metals by use of zinc rich paint, bituminous coating, or non-absorptive gaskets.

### 3.2 ADJUSTING

- A. Clean and touch up damaged primer paint with same product as applied in shop.
- B. Clean and touch up galvanized coatings at welded and abraded surfaces in accordance with ASTM A780, Annex A2.

### 3.3 SCHEDULE

- A. This Schedule includes principal items only; refer to Drawings for additional items not listed.
- B. Ladders:
  1. Side rails: Continuous steel flat bars, minimum ½ x 2-1/2 inches, eased edges, spaced 18 inches apart.
  2. Rungs: Round steel bars, 3/4 inch diameter, spaced 12 inches on center. Fit rungs in centerline of side rails and plug weld on outer rail face.
  3. Support ladders at top, bottom, and at intermediate points spaced maximum 5'-0" on center with steel brackets, welded or bolted to supports.
- C. Guardrails and Handrails:
  1. Fabricate from steel stock of sizes and types indicated.
  2. Make bends uniform and free from buckles and other defects.
  3. Cut intersections square to within 2 degrees and to length within 1/8 inch. Remove burrs from cut ends.
  4. Miter and cope intersections within 2 degrees, fit to within 1/8 inch.
  5. Continuously weld connections.

6. Where length exceeds that suitable for shipping and handling, fabricate in sections with concealed internal sleeves forming slip joints. Extend sleeves minimum 2 inches on both sides of joint; field weld and grind smooth.
- D. Corrugated Metal Ceilings: Fabricate to corrugation patterns to match historic.
- E. Vault Doors:
1. Fabricate to sizes and profiles indicated from steel shapes and plates.
  2. Cut intersections square.
  3. Continuously weld connections.
- F. Metal Window Shutters:
1. Fabricate to sizes and profiles indicated from steel shapes and plates.
  2. Cut intersections square.
  3. Continuously weld connections.

END OF SECTION



**SECTION 07 3116**  
**METAL SHINGLES**

**PART 1 GENERAL**

1.1 SUMMARY

- A. Section Includes:
  - 1. Metal shingles.
  - 2. Metal flashings and accessories.
  - 3. Underlayment.
- B. Related Sections:
  - 1. Division 01: Administrative, procedural, and temporary work requirements.

1.2 REFERENCES

- A. ASTM International (ASTM):
  - 1. A653/A653M - Standard Specification for Steel Sheet, Zinc-Coated (Galvanized) or Zinc-Iron Alloy Coated (Galvannealed) by the Hot-Dip Process.
  - 2. D412 - Standard Test Method for Vulcanized Rubber and Thermoplastic Rubbers and Thermoplastic Elastomers - Tension.
  - 3. D1970 - Standard Specification for Self-Adhering Polymer Modified Bituminous Sheet Materials Used as Steep Roofing Underlayment for Ice Dam Protection.
- B. National Roofing Contractors Association (NRCA) - Steep Roofing Manual.

1.3 SUBMITTALS

- A. Submittals for Review:
  - 1. Product Data: Technical data and installation instructions published by manufacturer of shingles.
  - 2. Samples: Full size shingle samples illustrating configuration, color, and surface finish.
- B. Quality Control Submittals:
  - 1. Qualifications: Installer qualifications per Section 01 4001.

1.4 QUALITY ASSURANCE

- A. Installer Qualifications:
  - 1. Minimum 5 years experience in work of this Section.
  - 2. Successful completion of at least 3 projects of similar scope and complexity within past 5 years.
- B. Perform Work in accordance with NRCAManual.
- C. Mockup:
  - 1. Size: Minimum 20 square feet.
  - 2. Include: Underlayment, shingles, and flashings.
  - 3. Locate where directed.
  - 4. Mockup to be approved by Architect and THC representative prior to commencing the Work.

1.5 PROJECT CONDITIONS

- A. Do not install underlayment at ambient or surface temperatures less than 40 degrees F or on wet or frozen substrate.
- B. Do not install shingles on wet or frozen substrate.

## 1.6 MAINTENANCE

- A. Extra Materials: 2 percent of extra shingles.

## PART 2 PRODUCTS

### 2.1 MANUFACTURERS

- A. Acceptable Manufacturers:
  - 1. Heather and Little ([www.heatherandlittle.com](http://www.heatherandlittle.com)) or approved substitute.
- B. Substitutions: Under provisions of Division 01.

### 2.2 MATERIALS

- A. Galvanized Steel Sheet:
  - 1. ASTM A653/A653M, Structural Quality; 24 gage core steel with minimum 1.25 ounces/square foot galvanized coating.
  - 2. Prefinished with fluoropolymer coating containing minimum 70 percent PVDF resins, Colonial Red or approved substitute.
- B. Metal Shingle Types:
  - 1. Type 1
    - a. Locations: Main roof
    - b. Size: 6 inch x 12 inch rectangular pattern to match original appearance.
    - c. Color: Colonial Red.
  - 2. Type 2:
    - a. Locations: Tower roof
    - b. Size: No. 4 Small Arrowhead shingle by Heather and Little.
    - c. Color: Colonial Red.
  - 3. Type 3:
    - a. Locations: Dormers, tower base, tower face
    - b. Size: 12 inch x 18 inch rectangular pattern to match original appearance.
    - c. Color: Colonial Red.

### 2.3 ACCESSORIES

- A. Underlayment (valleys, eaves, gutters):
  - 1. Description: ASTM D1970; minimum 30 mil thick polymer modified asphalt laminated to slip-resistant polyethylene film, self-adhering with release paper facing, specifically formulated for extended high in-service temperatures.
  - 2. Elongation: Minimum 250 percent, tested to ASTM D412.
  - 3. Tensile strength: Minimum 250 PSI, tested to ASTM D412.
  - 4. Source: Grace Ultra by Grace Construction Products or approved substitute.
- B. Underlayment:
  - 1. Description: vapor permeable underlayment
  - 2. Source: Tyvek Protec 200 or approved substitute.
- C. Fasteners: Type recommended by NRCA, hot dip galvanized steel, length to penetrate minimum 3/4 inch into sheathing.
- D. Asphalt Plastic Cement: ASTM D2822, Type II, non-running, heavy body material composed of asphalt and other mineral ingredients.

### 2.4 FABRICATION

- A. Metal Shingles:



1. Profile: Stamped to size and profile to match original shingles.
  2. Edges: Interlocking.
  3. Form shingles true to shape, accurate in size, and free from distortion and defects.
- B. Metal Flashings and Trim:
1. Fabricate from same material as shingles.
  2. Fabricate cleats and starter strips of same material as sheet metal.
  3. Hem exposed edges on underside 1/2 inch; miter and seam corners.
  4. Form sections true to shape, accurate in size, square, and free from distortion and defects.

### **PART 3 EXECUTION**

#### **3.1 INSTALLATION OF UNDERLAYMENT**

- A. Starting at low edge, apply underlayment horizontally on roof. Weatherlap each sheet 4 inches over preceding sheet. Lap ends 6 inches minimum.
- B. Press to full bond with substrate without voids, wrinkles, bridging, or fishmouths. Seal ends and edges.
- C. Lap underlayment minimum 12 inches over hips and ridges from both sides. Apply 36 inch wide strip centered lengthwise over ridge.
- D. Extend minimum 4 inches up abutting vertical surfaces.

#### **3.2 INSTALLATION OF FLASHINGS**

- A. Weather lap ends 2 inches minimum and seal with plastic cement.
- B. Apply one layer of 24 inch wide galvanized metal centered over valleys. Weather lap joints 2 inches minimum.
- C. Nail in place at 8 inches on center maximum.
- D. Apply plastic cement to cover nail heads and at edge of flashings for entire length of metal.

#### **3.3 INSTALLATION OF SHINGLES**

- A. Remove foreign matter from interlocking edges and between shingles.
- B. Cut shingles at perimeter and around penetrations with maximum 1/8 inch gaps.
- C. Nail shingles with two nails each. Do not drive nails so far as to create strain on shingles. Locate nails under subsequent shingles or cover heads with metal flashing.
- D. Miter shingles at centerline of valley metal to ensure straight border.
- E. Install flashings and trim to provide visual continuity and prevent water infiltration.

END OF SECTION

**SECTION 07 5400**

**THERMOPLASTIC MEMBRANE ROOFING**

**PART 1 GENERAL**

**1.1 SUMMARY**

- A. Section Includes:
  - 1. Sheathing board.
  - 2. Tapered roof insulation.
  - 3. Fully adhered single ply membrane roofing.
  - 4. Base flashings.
  - 5. Walkway pads.
  
- B. Related Sections:
  - 1. Division 01: Administrative, procedural, and temporary work requirements.
  - 2. Section 06 1000 - Rough Carpentry.
  - 3. Section 07 6200 - Sheet Metal Flashing and Trim.

**1.2 REFERENCES**

- A. American Society of Civil Engineers (ASCE) 7 - Minimum Design Loads for Buildings and Other Structures.
  
- B. ASTM International (ASTM):
  - 1. C728 - Standard Specification for Perlite Thermal Insulation Board.
  - 2. C1177/C1177M - Standard Specification for Glass Mat Gypsum Substrate for Use as Sheathing.
  - 3. D3273 - Standard Test Method for Resistance to Growth of Mold on the Surface of Interior Coatings in an Environmental Chamber.
  - 4. D6878 - Standard Specification for Thermoplastic Polyolefin Based Sheet Roofing.
  - 5. E108 - Standard Test Methods for Fire Tests of Roof Coverings.
  
- C. Factory Mutual Insurance Co. (FM) 4470 - Approval Standard for Class 1 Roof Covers.
  
- D. National Roofing Contractors Association (NRCA) - Roofing and Waterproofing Manual.

**1.3 SYSTEM DESCRIPTION**

- A. Design Requirements: Design roofing system to resist minimum wind loads in accordance with ASCE 7.

**1.4 SUBMITTALS**

- A. Submittals for Review:
  - 1. Shop Drawings: Indicate:
    - a. Setting plan for sheathing board and roof insulation.
    - b. Roof slopes.
    - c. Layout of seams.
    - d. Base flashing, termination, and special details.
    - e. Fastener types and locations.
    - f. Walkway pads.
  - 2. Product Data: Manufacturer's product specifications, installation instructions, and general recommendations for each product.
  - 3. Warranty: Sample warranty form.
  
- B. Quality Control Submittals:
  - 1. Certificates of Compliance: Certification from an independent testing laboratory that roofing system meets fire hazard and windstorm classification requirements.



## 1.5 QUALITY ASSURANCE

- A. Installer Qualifications:
  - 1. Minimum 3 years documented experience in work of this Section.
  - 2. Licensed or certified by roofing materials manufacturer.
- B. Roofing System:
  - 1. FM 1-90 Windstorm Resistance and MH Hail Resistance, tested to FM 4470.
  - 2. Class A Fire Hazard Classification, tested to ASTM E108.
- C. Pre-Installation Conference:
  - 1. Convene at site 2 weeks prior to beginning work of this Section.
  - 2. Attendance: Architect, Contractor, roofing applicator, roofing manufacturer's representative, and related trades.
  - 3. Review and discuss: Contract Documents, roofing system manufacturer's literature, project conditions, scheduling, and other matters affecting application.
  - 4. Tour representative areas of roofing substrates; discuss substrate construction, related work, work conditions, and materials compatibility.

## 1.6 DELIVERY, STORAGE AND HANDLING

- A. Store materials, other than membrane, in protected, dry area, between 60 and 80 degrees F until used; provide proper ventilation.
- B. Protect sheet goods from damage and wetting.

## 1.7 PROJECT CONDITIONS

- A. Do not apply roofing to damp or frozen substrate.
- B. Do not apply roofing during inclement weather or at temperatures below 40 degrees F, or above 100 degrees F or if freezing weather is anticipated within 24 hours after application. Do not use frozen materials.

## 1.8 WARRANTIES

- A. Furnish manufacturer's 20 year warranty providing coverage against water leakage through roofing system.
  - 1. Make repairs to roofing system required due to defects in materials or workmanship resulting in water leakage into or through roofing system.
  - 2. Include cost of labor and materials necessary to make required repairs.
  - 3. Cover all roofing system components including roofing membrane, built-up and meta flashings, high wall waterproof flashings, roof insulation, expansion joint covers, and preflashed accessories.
  - 4. Not limited to specific dollar amount.
  - 5. Transferable to subsequent building owners during warranty period.
  - 6. Include coverage for wind speeds up to 90 MPH. Any wind speed coverage exceeding 55 mph or projects with code requirements must be reviewed by approved manufacturer advisor.

## PART 2 PRODUCTS

### 2.1 MANUFACTURERS

- A. Acceptable Manufacturers:
  - 1. Carlisle Syntec, Inc. ([www.carlisle-syntec.com](http://www.carlisle-syntec.com))
  - 2. Firestone Building Products Co. ([www.firestonebpco.com](http://www.firestonebpco.com))
  - 3. GAF Materials Corp. ([www.gaf.com](http://www.gaf.com))
  - 4. Genflex Roofing Systems. ([www.genflex.com](http://www.genflex.com))
  - 5. Johns Manville. ([www.jm.com](http://www.jm.com))

6. Versico, Inc. ([www.versico.com](http://www.versico.com))

B. Substitutions: Under provisions of Division 01.

## 2.2 MATERIALS

A. Rigid Roof Insulation:

1. Type: ASTM C1289, Type V, Grade 2, rigid polyisocyanurate.
2. Edges: Square.
3. Thermal resistance: Minimum R value of 30.0.

B. Sheathing Board:

1. Type: ASTM C1177/C1177M, square cut ends and edges.
2. Surfacing: Fiberglass mat with non-asphaltic coating.
3. Mold resistance: 10, tested to ASTM D3273.
4. Size: 48 x 48 inches x 1/2 inch thick.
5. Source: DensDeck Prime Roof Board by GP Gypsum Corporation ([www.gp.com](http://www.gp.com)) or approved substitute.

C. Roof Membrane:

1. Type: ASTM D6878, thermoplastic polyolefin (TPO), ultraviolet resistant, reinforced.
2. Size: Maximum sheet size permitted by application and job conditions.
3. Thickness: 80 mils. reinforced
4. Color: Ultra White.

D. Flashing Sheet: Manufacturer's standard flashing sheet, color to match membrane.

## 2.3 ACCESSORIES

A. Accessories: By manufacturer of roofing system, including adhesives, tapes, solvents, sealants, water cutoff mastic, and prefabricated pipe flashings.

B. Walkway Pads: Preformed resilient pads, recommended by roofing manufacturer, minimum 1/2 inch thick.

C. Fasteners: Hot-dip galvanized or fluoropolymer coated steel, approved by roofing system manufacturer, type and length suited to project conditions.

D. Sheathing Board and Insulation Fasteners: Hot-dip galvanized or fluoropolymer coated steel, approved by FM and roofing system manufacturer, type and length suited to project conditions, with galvanized steel plates.

E. Nailers and Curbs:

1. Preservative treated wood, specified in Section 06 1000.
2. Nailers: 3-1/2 inch face dimension x insulation thickness.

F. Metal Flashings: Specified in Section 07 6200.

## PART 3 EXECUTION

### 3.1 PREPARATION

A. Remove projections that could puncture membrane from substrate.

B. Clean substrate of loose and foreign material, oil, and grease.

C. Complete roof penetrations and preparation for drains, flashings, and other penetrations prior to beginning roofing.



- D. Protect adjacent and underlying surfaces.

### 3.2 INSTALLATION - GENERAL

- A. Install roofing system in accordance with roofing system manufacturer's instructions, NRCA Manual, and approved Shop Drawings.

### 3.3 INSTALLATION OF TAPERED INSULATION

- A. Apply panels with edges perpendicular to deck flutes. Locate ends over solid bearing.
- B. Mechanically fasten to substrate in FM fastening pattern.
- C. Fit panels to other panels and at perimeter and around penetrations with maximum 3/8 inch voids.

### 3.4 INSTALLATION OF SHEATHING BOARD

- A. Apply panels with edges offset from those in tapered insulation.
- B. Mechanically fasten to substrate in FM fastening pattern.
- C. Fit panels to other panels and at perimeter and around penetrations with maximum 3/8 inch voids.

### 3.5 INSTALLATION OF ROOF MEMBRANE

- A. Position sheets without stretching; minimize wrinkles. Allow membrane to relax before proceeding.
- B. Provide minimum 5-1/2 inch lap at joints between adjacent sheets.
- C. Splice sheets by solvent welding or heat welding method.
- D. Bond membrane to substrate with full adhesive bed.
- E. Fasten membrane to perimeter nailers with fasteners spaced 6 inches on center maximum.
- F. Daily Seal:
  - 1. Ensure that water does not flow beneath completed sections of roof.
  - 2. Temporarily seal loose edge of membrane with night seal when weather is threatening.
  - 3. When work is resumed, pull sheet free before continuing installation.

### 3.6 INSTALLATION OF FLASHINGS


- A. Construct in accordance with roofing system manufacturer's standard details.
- B. Juncture of Horizontal and Vertical Surfaces:
  - 1. Use longest practical length flashing to minimize joints.
  - 2. Complete splice between flashing and main roof sheet before bonding flashing to vertical surface. Extend splice 3 inches beyond fasteners that attach membrane to horizontal surface.
  - 3. Adhere flashing to substrate with full bed of adhesive.
  - 4. Fasten top of flashing at 12 inches on center maximum, under metal flashing.
- C. Penetrations through Membrane:
  - 1. Flash pipe with premolded pipe flashings wherever possible.
  - 2. Where molded pipe flashings cannot be installed, use field fabricated pipe seals.
  - 3. Seal clusters of pipes and unusually shaped penetrations with minimum 2 inch high flashing containing pourable sealer.
- D. Roof Drains:
  - 1. Taper insulation around drain to provide smooth transition from roof surface to drain clamping ring.
  - 2. Seal between membrane and drain base with water cutoff mastic.

### 3.7 INSTALLATION OF WALKWAY PADS

- A. Clean underside of pad; set pads in full adhesive bed.
- B. Leave 2 inch space between pieces.

END OF SECTION



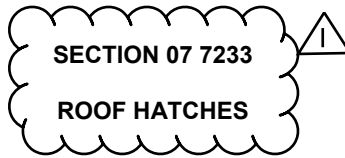

## **PART 1 GENERAL**

### **1.1 SUMMARY**

- A. Section Includes:
  - 1. Prefabricated roof hatches with integral curbs, safety rail and operating hardware.
- B. Related Sections:
  - 1. Division 01: Administrative, procedural, and temporary work requirements.

### **1.2 REFERENCES**

- A. ASTM International (ASTM) A653/A653M - Standard Specification for Steel Sheet, Zinc-Coated (Galvanized) or Zinc-Iron Alloy Coated (Galvannealed) by the Hot-Dip Process.

### **1.3 SUBMITTALS**

- A. Submittals for Review:
  - 1. Shop Drawings: Indicate locations, dimensions, materials, finishes, attachment, and relationship to adjacent construction.
  - 2. Product Data: Manufacturer's literature including description of materials, finishes, operation, and installation instructions.
  - 3. Warranty: Sample warranty form.

### **1.4 QUALITY ASSURANCE**

- A. Roof Hatches: Support minimum 40 PSF live load.

### **1.5 WARRANTIES**

- A. Furnish manufacturer's 5 year warranty providing coverage against defective materials and workmanship.

## **PART 2 PRODUCTS**

### **2.1 MANUFACTURERS**

- A. Acceptable Manufacturers:
  - 1. Babcock-Davis Hatchways, Inc. ([www.babcockdavis.com](http://www.babcockdavis.com))
  - 2. Bilco Co. ([www.bilco.com](http://www.bilco.com))
  - 3. Commercial Products Group. ([www.commercialproductsgroup.com](http://www.commercialproductsgroup.com))
  - 4. Precision Ladders, LLC. ([www.precisionladders.com](http://www.precisionladders.com))
- B. Substitutions: Under provisions of Division 01.


### **2.2 MATERIALS**

- A. Galvanized Steel Sheet: ASTM A653/A653M, Structural Quality, G90 coating class.

### **2.3 MANUFACTURED UNITS**

- A. Roof Hatch:
  - 1. Type: Single leaf, ladder access.
  - 2. Nominal opening size: 30 inches wide x 36 inches long.
  - 3. Safety railing system: Bil-Guard 2.0 by Bilco or approved substitute.

END OF SECTION

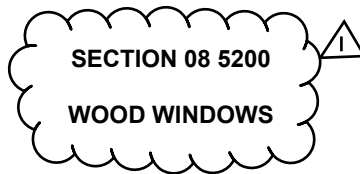

## **PART 1 GENERAL**

### **1.1 SUMMARY**

- A. Section Includes:
  - 1. Shop fabricated wood windows, with fixed and operable sash.
  - 2. Shop glazing.
  - 3. Operating hardware.
- B. Related Sections:
  - 1. Division 01: Administrative, procedural, and temporary work requirements.
  - 2. Section 08 8000 - Glazing.

### **1.2 REFERENCES**

- A. ASTM International (ASTM) B69 - Standard Specification for Rolled Zinc.
- B. Architectural Woodwork Institute (AWI) - Architectural Woodwork Quality Standards.

### **1.3 SYSTEM DESCRIPTION**

- A. Design Requirements; design windows doors to withstand:
  - 1. Design wind pressure in accordance with Building Code, with maximum allowable deflection of L/180.
  - 2. Movement caused by an ambient temperature range of 120 degrees F and a surface temperature range of 160 degrees F.

### **1.4 SUBMITTALS**

- A. Submittals for Review:
  - 1. Shop Drawings: Include locations, dimensions, profiles, relationship to adjacent construction, and attachments.
  - 2. Samples: Window corner, minimum 12 x 12 inches, showing corner construction and cross section.
- B. Quality Control Submittals:
  - 1. Qualification Statement: Fabricator qualifications per Section 01 4001.

### **1.5 QUALITY ASSURANCE**

- A. Fabricator Qualifications:
  - 1. Minimum 5 years experience in work of this Section.
  - 2. Successful completion of at least 3 projects of similar scope and complexity within past 5 years.
- B. Conform to applicable accessibility code for locating hardware.
- C. Mockup:
  - 1. Size: One full sized window unit.
  - 2. Locate where directed.
  - 3. Mockups to be approved by Architect and THC representative prior to commencing with the Work.

### **1.6 DELIVERY, STORAGE AND HANDLING**

- A. Deliver units factory assembled, with sash installed in frame.



## **PART 2 PRODUCTS**


### **2.1 MANUFACTURERS**

- A. Acceptable Manufacturers:
  - 1. Re-View. ([www.re-view.biz](http://www.re-view.biz))
- B. Substitutions: Under provisions of Division 01.

### **2.2 MATERIALS**

- A. Wood:
  - 1. Species and cut: Sapele, plain sawn, of quality suitable for opaque finish on exterior face and transparent finish on interior face.
  - 2. Grade: Graded in accordance with AW I Section 100, Premium Grade.
  - 3. Maximum moisture content: 6 percent.
- B. Glass and Glazing Accessories: Specified in Section 08 8000.
- C. Hardware:
  - 1. Sash lift:
    - a. Source: # R-09AD-FP1-605NL by House of Antique Hardware ([www.houseofantiquehardware.com](http://www.houseofantiquehardware.com)) or approved substitute.
    - b. Finish: Unlacquered brass.
  - 2. Sash lock:
    - a. Source: # R-09BM-8710-PB by House of Antique Hardware ([www.houseofantiquehardware.com](http://www.houseofantiquehardware.com)) or approved substitute.
    - b. Finish: Unlacquered brass.
  - 3. Sash pulley:
    - a. Source: # R-09SR-PBB-225-UL by House of Antique Hardware ([www.houseofantiquehardware.com](http://www.houseofantiquehardware.com)) or approved substitute.
    - b. Finish: Unlacquered brass.
- D. Sash Cord: Cotton cord with nylon core at wood windows.  
Chain at metal clad windows.
- E. Sash Weights: As required to create proper counterbalance for each operable sash.
- F. Weatherstripping: Bronze, spring folded for flexible fit.

END OF SECTION

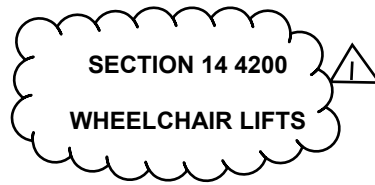

**PART 1 GENERAL**

1.1 SUMMARY

- A. Section Includes:
  - 1. Electric vertical wheelchair lifts.
  - 2. Operating equipment and accessories.
- B. Related Sections:
  - 1. Division 01: Administrative, procedural, and temporary work requirements.

1.2 REFERENCES

- A. ASME International (ASME) A18.1 - Safety Standard for Platform Lifts and Stairway Chairlifts.
- B. American Welding Society (AWS) D1.1 - Structural Welding Code - Steel.

1.3 SUBMITTALS

- A. Submittals for Review:
  - 1. Shop Drawings: Indicate drive mechanism, lift construction, dimensions, control functions and operational description.
  - 2. Product Data: Submit data on signal and operating fixtures, lift design, layout, components, and schematic of wiring diagrams.
  - 3. Samples: Submit samples, 3 x 3 inches in size illustrating floor and prefinished metal components.
  - 4. Submittals to be approved by Architect and THC Representative prior to commencing with the Work.
- B. Quality Control Submittals:
  - 1. Qualification Statement: Installer qualifications per Section 01 4001.
- C. Closeout Submittals:
  - 1. Operation and Maintenance Data.

1.4 QUALITY ASSURANCE

- A. Installer Qualifications:
  - 1. Minimum 5 years experience in work of this Section.
  - 2. Successful completion of at least 3 projects of similar scope and complexity within past 5 years.
- B. Regulatory Requirements: Comply with ASME A18.1.
- C. Perform Work in accordance with ASME A18.1 and AWS D1.1.
- D. Conform to applicable accessibility code for dimensions, locations, operation, and controls.
- E. Warranty: Provide one year warranty.

1.5 MAINTENANCE

- A. Maintenance Service: Furnish service and maintenance of wheelchair lifts for period of one year from Date of Substantial Completion.

**PART 2 PRODUCTS**



## 2.1 MANUFACTURERS

- A. Contract Documents are based on Lift-U Accessor I and II by Hogan Mfg., Inc. ([www.hoganmfg.com](http://www.hoganmfg.com))
- B. Substitutions: Under provisions of Division 01.

## 2.2 COMPONENTS

- A. Wheelchair Lift:
  - 1. Platform size: Platform size shall not exceed 25 SF.
  - 2. Rated net capacity: 1050 pounds.
  - 3. Rated speed: 10 feet per minute minimum.
  - 4. Operation: Electric motor driving four mechanically synchronized screw columns.
  - 5. Options: Include powered landing roll up barrier, automatic door operator and operable step / ramp.
- B. Controls:
  - 1. Controls: Push button controls located at top and bottom landings, enabling lift to be called or sent to landing.
  - 2. Electric strike latches and electric spring bolts for gates.
  - 3. Emergency stop switch.
  - 4. Emergency alarm.
  - 5. Upper and lower limit switches.
  - 6. Battery backup.
  - 7. Emergency lowering.
- C. Motors, Controllers, Controls, Buttons, Wiring, Devices, and Indicators: As required by NFPA 70 and ASME A 18.1.
- D. Electrical Characteristics:
  - 1. Electrical characteristics:
    - a. 115 VAC, 15 amp, three wire, single phase, 60 Hz.
    - b. 24 volt control circuit.

## 2.3 FINISHES

- A. Steel:
  - 1. Surface preparation: Clean and degrease metal surface.
  - 2. Primer: Sprayed and baked.
  - 3. Finish: Electrostatically applied powder coat; color to be selected from manufacturer's full color range.

## **PART 3 EXECUTION**

### 3.1 INSTALLATION

- A. Install in accordance with ASME A18.1.
- B. Install system components and connect to building utilities and electrical service.


### 3.2 FIELD QUALITY CONTROL

- A. Perform tests required by ASME A18.1.
- B. Submit test and approval certificates issued by authorities having jurisdiction.

### 3.3 ADJUSTING

- A. Adjust automatic floor leveling feature at each stop to stop platform within 1/4 inch of finished floor.

END OF SECTION

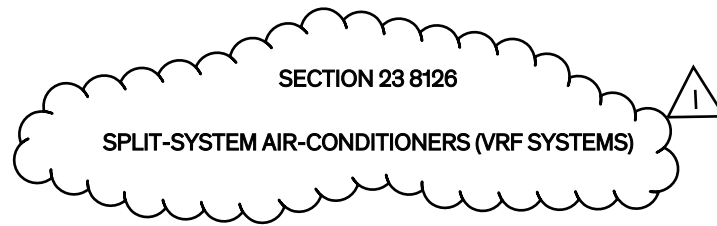

## PART 1 - GENERAL

### 1.1 RELATED DOCUMENTS

- A. Drawings and general provisions of the Contract, including General and Supplementary Conditions and Division 01 Specification Sections, apply to this Section.

### 1.2 SUMMARY

- A. This Section includes split-system air-conditioning consisting of separate evaporator-fan and compressor-condenser components.

### 1.3 SUBMITTALS

- A. Product Data: Include rated capacities, furnished specialties, and accessories for each type of product indicated. Include performance data in terms of capacities, outlet velocities, static pressures, sound power characteristics, motor requirements, and electrical characteristics. Refrigerant piping type, pressure rating, and sizes.
- B. Shop Drawings: Refrigerant routing, Diagram power, signal, and control wiring.
- C. Schematics: Refrigerant piping diagrams showing condenser unit, evaporator fan units, distribution header, all refrigerant piping sizes, and all refrigerant piping accessories.
- D. Field quality-control test reports.
- E. Operation and Maintenance Data: For split-system air-conditioning units to include in emergency, operation, and maintenance manuals.
- F. Warranty: Special warranty specified in this Section.

### 1.4 QUALITY ASSURANCE

- A. Product Options: Drawings indicate size, profiles, and dimensional requirements of split-system units and are based on the specific system indicated. Refer to Division 01 Section "Product Requirements."
- B. Electrical Components, Devices, and Accessories: Listed and labeled as defined in NFPA 70, Article 100, by a testing agency acceptable to authorities having jurisdiction, and marked for intended use.
- C. Energy-Efficiency Ratio: Equal to or greater than prescribed by ASHRAE 90.1, "Energy Efficient Design of New Buildings except Low-Rise Residential Buildings."
- D. Coefficient of Performance: Equal to or greater than prescribed by ASHRAE 90.1, "Energy Efficient Design of New Buildings except Low-Rise Residential Buildings."



- E. Units shall be designed to operate with HCFC-free refrigerants.
- F. The evaporator fans and condenser unit shall be manufacturer by the same manufacturer.

#### 1.5 COORDINATION

- A. Coordinate size and location of concrete bases for units. Cast anchor-bolt inserts into bases. Concrete, reinforcement, and formwork are specified in Division 03 Section "Cast-in-Place Concrete."
- B. Coordinate size, location, and connection details with roof curbs, equipment supports, and roof penetrations specified in Division 07 Section "Roof Accessories."

#### 1.6 WARRANTY

- A. Special Warranty: Manufacturer's standard form in which manufacturer agrees to repair or replace components of split-system air-conditioning units that fail in materials or workmanship within specified warranty period.
  - 1. Warranty Period: Five years from date of Substantial Completion.

#### 1.7 EXTRA MATERIALS

- A. Furnish extra materials described below that match products installed and that are packaged with protective covering for storage and identified with labels describing contents.
  - 1. Filters: One set of filters for each unit.
  - 2. Fan Belts: One set of belts for each unit.

### **PART 2 - PRODUCTS**

#### 2.1 MANUFACTURERS

- A. Available Manufacturers: Subject to compliance with requirements, manufacturers offering products that may be incorporated into the Work include, but are not limited to, the following:
- B. Manufacturers: Subject to compliance with requirements, provide products by one of the following:
  - 1. Carrier Air Conditioning; Div. of Carrier Corporation.
  - 2. Johnson Controls.
  - 3. Lennox Industries Inc.
  - 4. Mitsubishi.
  - 5. Toshiba.
  - 6. Trane Company (The); Unitary Products Group.
  - 7. York International Corp.

#### 2.2 WALL-MOUNTING, EVAPORATOR-FAN COMPONENTS

- A. Cabinet: Enameled steel with removable panels on front and ends in color selected by Architect, and discharge drain pans with drain connection.

- B. Refrigerant Coil: Copper tube, with mechanically bonded aluminum fins, complying with ARI 210/240, and with thermal-expansion valve.
- C. Electric Coil: Helical, nickel-chrome, resistance-wire heating elements with refractory ceramic support bushings; automatic-reset thermal cutout; built-in magnetic contactors; manual-reset thermal cutout; airflow proving device; and one-time fuses in terminal box for overcurrent protection.
- D. Fan: Direct drive, centrifugal fan.
- E. Fan Motors: Comply with requirements in Division 23 Section "Common Motor Requirements for HVAC Equipment."
- F. Filters: Permanent, cleanable.
- G. Wall mounted unit shall have independent power source. Cannot share power source with condenser unit.

### 2.3 EVAPORATOR-FAN COMPONENTS

- A. Casing: Galvanized steel with flanged edges, removable panels for servicing, and insulation on back of panel.
  - 1. Insulation: Faced, glass-fiber duct liner.
  - 2. Drain Pans: Slide-out composite, with connection for drain.
- B. Refrigerant Coil: Aluminum tube, with mechanically bonded aluminum fins, complying with ARI 210/240, and with thermal-expansion valve.
- C. Fan: Direct drive forward-curved, double-width wheel of galvanized steel.
- D. Fan Motors: Comply with requirements in Division 23 Section "Common Motor Requirements for HVAC Equipment."
  - 1. Special Motor Features: Multitapped, multispeed with internal thermal protection and permanent lubrication.
- E. Disposable Filters: 1 inch thick, in fiberboard frames.
- F. Filter Rack: Provided by manufacturer compatible with 2" throwaway filters.
- G. Wiring Terminations: Connect motor to chassis wiring with plug connection.
- H. Wall mounted unit shall have independent power source. Cannot share power source with condenser unit.

### 2.4 FLOOR CONSOLE EVAPORATOR-FAN COMPONENTS

- A. Casing: Cabinet shall be constructed of zinc-coated steel and configured for bottom return.
- B. Refrigerant Coil: Coil shall be copper tube with aluminum fins and galvanized steel tube sheets. Fins shall be bonded to the tubes by mechanical expansion and specially coated for enhanced wettability. A drip pan under the coil shall have a factory-installed drain connection for hose attachment to remove condensate.
- C. Fan: Direct Drive.



- D. Fan Motors: Motors shall be totally enclosed, permanently lubricated ball bearing with inherent overload protection.
- E. Wiring Terminations: Connect motor to chassis wiring with plug connection.
- F. Wall mounted unit shall have independent power source. Cannot share power source with condenser unit.

## 2.5 DISTRIBUTION HEADER

- A. General: Distribution header shall be able to control refrigerant flow to all VRF indoor units and allow for simultaneous heating and cooling.

## 2.6 AIR-COOLED, COMPRESSOR-CONDENSER COMPONENTS

- A. General:
 

Factory-assembled, single piece, air-cooled outdoor unit. Contained within the unit enclosure shall be all factory wiring, piping, controls, and the multiple inverter-driven twin rotary compressors.

  1. The maximum sound pressure rating for a single module shall not exceed 62 dBA sound pressure in cooling and 63 dBA in heating and for twinned systems the sound pressure numbers should not exceed 65 dBA and 66 dBA. Sound pressure ratings are measured at a distance of 3 ft out and 4 ½ ft up from the side of the outdoor unit.
  2. The outdoor unit shall include an oversized accumulator and a liquid tank for proper heating performance while allowing the indoor unit PMV (pulse modulating valve) metering device to shut off completely when a zone is satisfied.
  3. The outdoor unit shall be protected by a high-pressure switch, high-pressure sensor, low-pressure sensor, fusible plug, PC board, and inverter overload protector.
  4. The outdoor unit shall be capable of operating in cooling mode down to 23 F ambient air temperature and down to -4 F wet bulb ambient air temperature in heating.
  5. The outdoor unit shall include a total oil management system that balances oil between compressors within a module, replenishes compressor oil to the compressors in a module from the oil separator if required, and allows oil and refrigerant to move between twinned units if required, even if one of the units is not running.
- B. Unit Cabinet:
  1. Unit cabinet shall be constructed of pre-coated steel, finished on both inside and outside.
  2. Unit access panels shall be removable with minimal screws and shall provide full access to the compressors, fan, and control components.
  3. Compressors shall be isolated in a compartment and have an acoustic wrap to assure quiet operation.
  4. The outdoor unit control panel shall include a sliding window to access adjustable controls and an LED display for setup and diagnostics.
  5. Unit cabinet shall be capable of withstanding 500-hour salt spray test per Federal Test Standard No. 141 (method 6061).
- C. Fans:
  1. Outdoor fan shall discharge air vertically and be driven by a DC inverter variable speed motor.
  2. Outdoor fan motor shall be totally-enclosed with permanently-lubricated bearings.
  3. Motor shall be protected by internal thermal overload protection.
  4. Fan blade shall be statically and dynamically balanced.
  5. Outdoor fan shall be protected by a raised protective grille.
- D. Compressors:
  1. Each outdoor unit module shall be equipped with two or three inverter-driven twin rotary compressors with full range control to an accuracy of  $\pm 0.1$  Hz.
  2. Compressor shall be totally enclosed in the machine compartment.
  3. Compressors shall be equipped with factory mounted crankcase heaters.
  4. Internal overloads shall protect the compressor from over-temperature operation.

5. Motor shall be suitable for operation in an R-410A refrigerant atmosphere.
  6. Compressor assembly shall be installed on rubber vibration isolators.
  7. To maximize compressor reliability, multiple compressors within a module shall be started and operated in variable patterns to ensure equal run time on all compressors.
  8. To ensure maximum efficiency throughout the system operation range, no compressor is required to run at maximum speed under any condition.
- E. Outdoor Coil:
1. Coil shall be constructed of aluminum fins mechanically bonded to seamless copper tubes, which are cleaned, dehydrated, and sealed.
  2. The coil configuration shall be 4-sided and fully separated from the machine compartment for more effective heat transfer and sound isolation.
  3. The coil fins shall have a factory-applied corrosion resistant blue-fin finish.
- F. Controls and Safeties:
- Operating controls and safeties shall be factory selected, assembled, and tested. The minimum control functions shall include the following:
1. Controls:
    - a. Compressor speed to match the refrigerant flow and capacity with the system requirements.
    - b. Outdoor fan motor speed for higher efficiency and lower sound.
    - c. Oil control for improved system reliability and comfort
    - d. Pulse modulating valve control for precise control of the refrigerant distribution and accurate capacity management to avoid starving any units.
    - e. Control of compressor staging to maximize reliability and minimum run time on all compressors.
    - f. Module control of compressor operation, compressor speed, and outdoor heat exchanger surface to maximize efficiency and sound level and reliability across the entire operating range of the system.
    - g. Control of the outdoor heat exchanger surface (main vs sub heat exchangers) for maximum efficiency and comfort.
  2. Safeties:
 

The following safety devices shall be part of the condensing unit:

    - a. High-pressure switch
    - b. Fuses
    - c. Crankcase heater
    - d. Fusible plug
    - e. Overcurrent relay for the compressor
    - f. Thermal protectors for compressor and fan motor
    - g. Compressor time delay
    - h. Oil recovery system
    - i. Oil level sensor
    - j. Overcurrent sensor
    - k. Compressor suction and discharge temperature sensor
    - l. Compressor suction and discharge pressure sensor
- G. Electrical Requirements:
1. All sizes shall utilize 208/230-3-60 or 460-3-60 (V-Ph-Hz) field power supply.
  2. Two-core, standard, shielded low voltage cable shall be required for communication between outdoor and indoor unit.
  4. All power and control wiring must be installed per NEC and all local electrical codes.
- H. Refrigerant Piping and Line Lengths:
1. Piping connections shall be from the front or the bottom of the unit. The unit shall be capable of operating with maximum connected refrigerant line lengths of 985 ft (actual).
  2. The outdoor unit shall have the ability to operate with a maximum height of 230 ft between the outdoor and the lowest indoor unit.
  3. The maximum distance between the outdoor unit and the furthest fan coil shall not exceed 590 ft actual or 720 ft equivalent. No line size changes or oil traps shall be required.
  4. The system shall be capable of operating when the height difference between the upper and the lower fan coil is 130 ft.



I. Auxiliary Refrigerant Components:

1. All field-supplied copper tubing connecting the outdoor unit to the indoor unit shall use factory-supplied branching kits consisting of either Y joints or headers to ensure even refrigerant flow.
2. To ensure piping flexibility, the system shall allow having Y joints or headers downstream of another header.
3. When twinning two modules, and in order to maximize efficiency and comfort, a 3/8-in. oil balance line shall be used to allow the flow oil and refrigerant between the two units, even when one of the units is not running.

2.7 REFRIGERANT PIPING

A. Performance Requirements for Refrigerant R-410A:

1. Suction Line for Air-Conditioning Applications: 300 psig.
2. Hot-Gas and Liquid Lines: 535 psig.

B. Copper Tube and Fittings:

1. Copper Tube: ASTM B 88, Type K or L
2. Wrought-Copper Fittings: ASME B16.22.
3. Wrought-Copper Unions: ASME B16.22.
4. Solder Filler Metals: ASTM B 32. Use 95-5 tin antimony or alloy HB solder to join copper socket fittings on copper pipe.
5. Brazing Filler Metals: AWS A5.8.
6. Flexible Connectors:
  - a. Body: Tin-bronze bellows with woven, flexible, tinned-bronze-wire-reinforced protective jacket.
  - b. End Connections: Socket ends.
  - c. Offset Performance: Capable of minimum 3/4-inch misalignment in minimum 7-inch long assembly.
  - d. Pressure Rating: Factory test at minimum 500 psig.
  - e. Maximum Operating Temperature: 250 deg F.

2.8 ACCESSORIES

- A. Control equipment and sequence of operation are specified in Division 23 Sections "Instrumentation and Control for HVAC" and "Sequence of Operations for HVAC Controls."
- B. LonTalk building automation system controller.
- C. Smoke Detectors: Install in supply and return air. The smoke detectors stop operation of the unit by interrupting power to the control board if smoke is detected within the air compartment.
- D. Automatic-reset timer to prevent rapid cycling of compressor.

**PART 3 - EXECUTION**

3.1 INSTALLATION

- A. Install units level and plumb.
- B. Install evaporator-fan components using manufacturer's standard mounting devices securely fastened to building structure.

- C. Install ground-mounting, compressor-condenser components on 4-inch- thick, reinforced concrete base; 4 inches larger on each side than unit. Concrete, reinforcement, and formwork are specified in Division 03 Section "Cast-in-Place Concrete." Coordinate anchor installation with concrete base.
- D. Install ground-mounting, compressor-condenser components on polyethylene mounting base.
- E. Install roof-mounting compressor-condenser components on equipment supports specified in Division 07 Section "Roof Accessories." Anchor units to supports with removable, cadmium-plated fasteners.
- F. Install compressor-condenser components on restrained, spring isolators with a minimum static deflection of 1 inch.
- G. Install and connect precharged refrigerant tubing to component's quick-connect fittings. Install tubing to allow access to unit.

### 3.2 CONNECTIONS

- A. Piping installation requirements are specified in other Division 23 Sections. Drawings indicate general arrangement of piping, fittings, and specialties.
- B. Install refrigerant ball valves on each line at condensing unit and fan coil unit, a total of four valves shall be installed per split system.
- C. Install piping adjacent to unit to allow service and maintenance.
- D. Duct Connections: Duct installation requirements are specified in Division 23 Section "Metal Ducts." Drawings indicate the general arrangement of ducts. Connect supply and return ducts to split-system air-conditioning units with flexible duct connectors. Flexible duct connectors are specified in Division 23 Section "Air Duct Accessories."
- E. Ground equipment according to Division 26 Section "Grounding and Bonding for Electrical Systems."
- F. Electrical Connections: Comply with requirements in Division 26 Sections for power wiring, switches, and motor controls.

### 3.3 FIELD QUALITY CONTROL

- A. Manufacturer's Field Service: Engage a factory-authorized service representative to inspect, test, and adjust field-assembled components and equipment installation, including connections, and to assist in field testing. Report results in writing.
- B. Perform the following field tests and inspections and prepare test reports:
  1. Leak Test: After installation, charge system and test for leaks. Repair leaks and retest until no leaks exist.
  2. Operational Test: After electrical circuitry has been energized, start units to confirm proper motor rotation and unit operation.
  3. Test and adjust controls and safeties. Replace damaged and malfunctioning controls and equipment.
- C. Remove and replace malfunctioning units and retest as specified above.




3.4 STARTUP SERVICE

- A. Engage a factory-authorized service representative to perform startup service.
  - 1. Complete installation and startup checks according to manufacturer's written instructions.

3.5 DEMONSTRATION

- A. Engage a factory-authorized service representative to train Owner's maintenance personnel to adjust, operate, and maintain units. Refer to Division 01 Section "Demonstration and Training."

END OF SECTION 23 3826

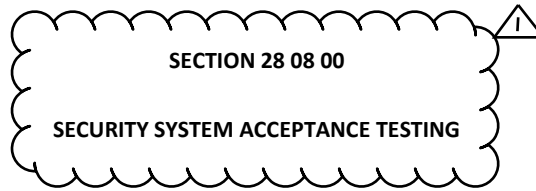

**SECTION 28 08 00**

**SECURITY SYSTEM ACCEPTANCE TESTING**

**PART 1 - GENERAL**

**1.1 GENERAL**

- A. Furnish engineering, labor, materials, apparatus, tools, equipment, and transportation required to thoroughly test the completed security system installation as described in these specifications.
- B. Full testing of a completed security system which includes:
  - 1. Develop, submit, and obtain Engineer's approval of security system Pre-Functional and Functional testing forms.
  - 2. Complete 100% Pre-Functional test of the security system. Submit Pre-Functional testing documentation reflecting that all security devices, cabling, locking hardware, power, interfaces to other systems, network switches, servers, workstations, and other components required for a completely functional security system are provided per project documents.
  - 3. Complete 100% Functional test of the security system. Submit Functional testing documentation reflecting that all security equipment, components, interfaces, and programming are functioning correctly per project documents. Upon receiving approval of functional testing documentation, schedule final acceptance testing activities to be witnessed by Engineer and/or Owner.
  - 4. Demonstrate 100% security system functionality to the Engineer and Owner's IT and Security representatives. Document testing activities and submit with final As-Built drawing.

**1.2 SUMMARY OF SYSTEM COMMISSIONING ACTIVITIES**

- A. Overview
  - 1. The purpose of system commissioning is to ensure the security system operates properly when it is needed most. Security systems are very complex from both an equipment and programming standpoint, and thorough testing is necessary to ensure correct operation.
  - 2. Perform testing activities after-hours or on weekends when the system is "quiet" and the building is generally unoccupied. This will minimize the amount of irrelevant activity in the system activity reports that will be used as a record of the pre and final test results.
- B. Pre-Functional Test
  - 1. Perform a 100% pre-functional test of system aspects to verify correct operation prior to scheduling the final test. The pre-test will help to make the final test run smoothly when demonstrating the system's operation to the Engineer and Owner's IT and Security representatives.
  - 2. Document the results of the pre-test using the approved test forms and submit a copy to the Engineer along with the system activity reports
- C. Functional Test
  - 1. Perform a 100% pre-functional test of system aspects to verify correct operation prior to scheduling the final test. The pre-test will help to make the final test run smoothly when demonstrating the system's operation to the Engineer and Owner's IT and Security representatives.
  - 2. Document the results of the pre-test using the approved test forms and submit a copy to the Engineer along with the system activity reports
- D. Final Acceptance Test
  - 1. Perform a final test of the system in the presence of the Engineer and Owner's IT and Security representatives to demonstrate correct operation of the security system.

**1.3 SUBMITTALS**

- A. Operation and Maintenance Manuals
  - 1. Functional Design Manual: Includes a detailed explanation of the operation of the system.
  - 2. Hardware Manual which includes:
    - a. Pictorial parts list and part numbers



- b. Pictorial and schematic electrical drawings of wiring systems, including devices, control panels, instrumentation and annunciators
    - c. Telephone numbers for the authorized parts and service distributors
    - d. Include service bulletins
  - 3. Software Manual which includes:
    - a. Use of system and applications software
    - b. Initialization, start-up, and shut down procedures
    - c. Alarm Reports
  - 4. Operator's Manual which fully explains procedures and instructions for the operation of the system and includes:
    - a. Computers and peripherals
    - b. System start up and shut down procedures
    - c. Use of system, command, and applications software
    - d. Recovery and restart procedures
    - e. Graphic alarm presentation
    - f. Use of report generator and generation of reports
    - g. Data entry operator commands
    - h. Alarm messages and reprinting formats
    - i. System access requirements
  - 5. Maintenance Manual which includes:
    - a. Instructions for routine maintenance listed for each component, and a multi-page summary of component's routine maintenance requirements.
    - b. Detailed instructions for repair of the security system.
    - c. A summary of the software licenses, including license numbers, quantity of clients, summary of the software options provided and database capabilities.
    - d. A summary of the TCP/IP address used and which system component they are associated with. Include the gateway address, subnet mask, DNS server, and host name information.
  - 6. Test Results Manual, which includes the document results of tests, required under this Specification, organized by System, Floor, and Door.
  - 7. Record Drawings Manual which includes 11"x17" prints of record drawings as described below.
- B. Record Drawings
- 1. Drawings to fully represent installed conditions including actual locations of devices, actual cable and terminal block numbering, and correct wire sizing as well as routing. Record changes in the work during the course of construction on blue or black line prints.
  - 2. Include drawings submitted as part of the Shop Drawing package, plus additional information required to accurately document installed conditions.
  - 3. Include the following additional information:
    - a. Device addresses & IP address information.
    - b. Settings for each camera (lens specs, mm setting, auto shutter setting, and other available camera settings, etc.)
  - 4. Final acceptance will not be made until the Engineer approves the record drawings.

**PART 2 - PRODUCTS – NOT USED**

**PART 3 - EXECUTION**

**3.1 SCHEDULING**

- A. Coordinate security commissioning with the General Contractor and provide specific information on pre-test and final-testing activities to be entered into the overall project construction schedule.

**3.2 TESTING REQUIREMENTS**

- A. Site Tests
  - 1. Perform a 100% pretest of the system prior to final testing by the Engineer. Provide the Engineer with a minimum of a 5 day notice prior to scheduling testing.

2. At the conclusion of the work on a floor, test the system on that floor to verify proper operation and reporting of devices.
3. Work with the door hardware supplier to resolve electric hardware failures and door alignment/closure problems.
4. At the completion of the work, test the entire system to verify proper operation. At a minimum, include these tests:
  - a. Door Hardware Test: Coordinate with door hardware contractor to test electrified locking hardware of associated card reader doors.
  - b. Card Reader Test: Test functionality of card reader, alarm contact, and request-to-exit sensors to indicate the following: valid card read, invalid card read, door forced, and door propped alarms.
  - c. Duress Button Test: Test functionality of duress buttons to alarm on ACAMS workstations. Verify dispatch requirements and integration with VSS to provide automatic camera call up upon alarm activation.
  - d. ACAMS Software Test: Test software for correct programming and setup. Verify integration with the video surveillance, detention control system, intercom system, and other security subsystems. Verify graphical mapping screens and devices.
  - e. Camera Test: Review cameras for proper coverage, resolution, frame rate, and overall quality of image.
  - f. Video Management Software Test: Test recording system for correct programming, alarms, and event retrieval. Verify integration with ACAMS and video analytics software. Verify functionality at each client workstation. Verify graphical mapping screens and devices.
  - g. Video Virtual Matrix Test: Test functionality of virtual matrix switch for correct programming, operation, and alarm call up. Verify functionality to push video streams on-demand to any monitor and any client workstation.
  - h. Video Appliance Test: Test functionality of servers and storage appliances for system parity and bandwidth load balancing. Verify RAID-6x functionality by demonstrating 5 simultaneous drive failures and 1 server failure.
  - i. Battery and UPS Load Test: Disconnect AC power to security system components to verify battery operation functions and system remains fully operational.

B. Test Preparation

1. Provide device identification numbers that differ from or were not included on the original contract drawing set.
2. Provide a complete systems point list.
3. Provide paper and toner for the printer so that an event log can be printed out and attached to the test reports as verification of test sequence and systems response.
4. During testing, provide a minimum of three technicians familiar with the installation to assist with the test. Stage the technicians as follows: one at the host, one at the device being tested, and one runner responsible to furnishing tools, step ladders, etc.
5. Provide radios for use by the Engineer and Owner during testing.
6. Provide pre-programmed access cards for use during testing. Provide one card for each access level.

### 3.3 TEST PROCEDURES

- A. Refer to the test forms for testing procedures for each type of device/system.




### 3.4 DOCUMENTATION

- A. Provide a full-sized drawing package containing a detailed wiring diagram (layout of equipment/elevation, complete parts list, and a complete wiring diagram for each access control panel) for each SEC location in the TR rooms. Fold the diagram and place it inside a clear plastic pocket affixed to the inside door of the SEC.
- B. Provide a service log on the inside door of each SEC. Include columns for the following information: date of service, description of work performed, service technician(s), and service company in the service log. Place the service log inside a separate clear plastic pocket affixed to the inside door of the SEC.

### 3.5 DEMONSTRATION

- A. On completion of the acceptance test, instruct the owner's representatives, at a time convenient to them, in the operation and testing of the system.
- B. Utilize the database for the project during training to give the users a project specific example to learn from.
- C. Provide a minimum of 80 hours of on-site training by a factory trained representative for each of the following systems:
  - 1. Access Control & Alarm Monitoring System
  - 2. Video Surveillance System
    - a. Network Video Recording System
    - b. Network Video Analytics System
    - c. Network Video Servers and Storage Appliances
- D. Maintain a sign in sheet with names and dates of persons trained and forwarded to owner upon completion of training.
- E. Provide for four (4) Owner's representatives to attend factory certification training (off-site) for both the following systems:
  - 1. Access Control & Alarm Monitoring System
  - 2. Video Surveillance System

END OF SECTION

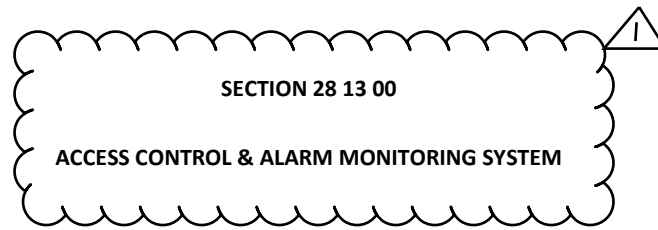

**SECTION 28 13 00**

**ACCESS CONTROL & ALARM MONITORING SYSTEM**

**PART 1 - GENERAL**

**1.1 SUMMARY**

- A. General: Furnish engineering, labor, materials, apparatus, tools, equipment, transportation, temporary construction and special or occasional services as required to make a complete working Access Control & Alarm Monitoring system installation, as described in these specifications. Contractor responsible for coordinating door hardware requirements and providing all necessary equipment and materials for proper installation of concealed access control system at each secured door with only user interaction required devices not required to be concealed.
- B. Section Includes:
  - 1. ACAMS servers and client workstations
  - 2. ACAMS control panels, input/output modules, and card readers
  - 3. ACAMS power supplies
  - 4. Alarm initiating devices, including: magnetic switch contacts, request-to-exit sensors, duress buttons, and general alarm points
  - 5. Integration with the VSS and other security subsystems to allow bi-directional communication with one another
  - 6. Interface to electric door hardware and ADA door operators
  - 7. Interface to elevator controllers
  - 8. Interface to fire/life-safety system
- C. Products Furnished and Installed Under another Section:
  - 1. 120V power
  - 2. Conduit and junction boxes
  - 3. ADA door operators and push buttons
  - 4. Fire/life-safety system interface relays
  - 5. Parking gate operators.
  - 6. Electromagnetic door holders
  - 7. Network connectivity for ACAMS devices via Owner's local/wide area network
- D. Related Sections:
  - 1. Consult other Divisions, determine the extent and character of related work and properly coordinate work specified herein with that specified elsewhere to produce a complete and operable system.
  - 2. Section 28 00 00 – Security Basic Requirements: for submittal formats, warranty, general product requirements, and installation requirements.
  - 3. Section 28 05 13 – Security System Cabling: for cable requirements related to the ACAMS.
  - 4. Section 28 05 53 – Security System Labeling: for device labeling requirements.
  - 5. Section 28 08 00 – Security System Acceptance Testing: for testing requirements.
  - 6. Section 28 16 00 – Intrusion Detection System: for interface requirement to the ACAMS.
  - 7. Section 28 13 53 – Access Detection Systems: for interface requirements to the ACAMS.
  - 8. Section 28 23 00 – Video Surveillance System: for interface requirement with the ACAMS.

**1.2 SYSTEM DESCRIPTION**

- A. Overview
  - 1. The ACAMS is a distributed network of control panels connected to and programmed from a host server and client workstations.
  - 2. The ACAMS is utilized for electronically controlling access to off-stage and on-stage areas, lounges, and supply rooms, storage rooms, and other staff-only spaces.



3. The ACAMS consists of redundant host servers located in the primary and secondary ER rooms, client workstations, control panels, card readers, and alarm initiating devices. The host server communicates with the field panels via the Owner's local/wide area network.
- B. Access Control & Alarm Monitoring System
1. Provide ACAMS software and associated licenses to support the devices shown on the project drawings.
  2. Provide ACAMS client software licenses for monitoring and control of ACAMS. Provide web browser client license (thin client) to allow for remote viewing on other workstations.
  3. Provide ACAMS control panels located in the ER and TR rooms as indicated on project drawings. Panels support up to 64 card readers each with locking control outputs and multiple general purpose input/output modules for automation.
  4. Provide multi-technology card readers as indicated on project drawings.
  5. Provide multi-technology card readers at Trans-Vac automatic feeder locations (not shown on project drawings) to activate feeder functionality. Assume a minimum of 75 locations.
  6. Provide interface to latch position switch (LX) and request-to-exit (RX) switch within electrified door hardware for card reader controlled doors. Provide alarm contacts and request-to-exit motion detectors for card reader doors that do not contain LX and RX sensors within the electrified hardware set. Refer to Section 08 06 00 – Door Hardware for additional requirements.
  7. Provide alarm contacts for non-card reader controller perimeter doors as indicated on project drawings.
  8. Provide connection to local audible alarms at monitored at exit-only and emergency exit doors as indicated on project drawings. Local audible alarms to sound upon alarm activation (forced door, door held open, etc).
  9. Provide 12/24VDC ACAMS device and lock power supplies as indicated on project drawings.
  10. Provide battery backup of system components and power supplies.
- C. Badging System
1. Included in Fannin County IT department.
- D. ACAMS Integration Requirements
1. Provide ACAMS interface software to VSS network video recorders to enable alarm event recording and automatic call up of associated cameras upon alarm activation (forced door, door held open, etc).
  2. Provide ACAMS interface software for IDS control panels to enable bidirectional alarm communication and notification.
  3. Utilize hardwired input/output points to provide integration between detention control system and ACAMS to allow for redundant reporting of alarms within the Inmate ED Unit.
  4. Provide software integration between the ACAMS database and the following non-security systems:
    - a. Owner's HR database to allow automatic provisioning and revocation of cardholder privileges
    - b. MS Active Directory to enable single sign-on, logical access control, and debit card capabilities
- E. Interface to Elevator Conveying System
1. Non-Public passenger and freight elevator card readers to control access to floors based on cardholder access levels. Public elevator card readers to control access to floors only in times of heightened security.
  2. Furnish card readers to elevator contractor for installation inside elevator cars.
  3. Provide security demarcation enclosures located in the elevator machine rooms as indicated on project drawings. Route security cabling from the ACAMS control panels to the security demarcation enclosures to interface with elevator controller. Connections in the demarcation enclosure include landings, terminal blocks, and labels.
  4. Provide coordination during installation of card reader and cable terminations. Elevator contractor responsible for elevator traveler cable, connection from elevator controller to security demarcation enclosure, and installation of card readers within the elevator cabs.
- F. Interface to Fire/Life-Safety System
1. Coordinate with Fire/Life-Safety system contractor to automatically drop power from stairwell, elevator vestibule lobby, and other access controlled doors within the path of egress upon alarm activation of the Fire/Life-Safety system.

### 1.3 SUBMITTALS

- A. Contractor Qualifications: Submit certification letters for the manufacturer of the ACAMS.
- B. Product Data: Submit product information for components specified herein.
- C. Shop Drawings:
  - 1. Device placement on floor plans
  - 2. Point-to-Point Diagrams: Include wiring, points of connection and interconnecting devices between the following:
    - a. ACAMS control panel
    - b. ACAMS card reader and input/output modules
    - c. ACAMS power supplies
    - d. Card Readers
    - e. Alarm contacts and request-to-exit sensors
    - f. Local audible alarms
    - g. Interface to electrified door hardware
    - h. Interface to fire/life-safety system
    - i. Interface to elevator controller
    - j. Cable conductors (identify conductors on the point-to-point diagrams with the same tag as the installed conductor)
  - 3. Schedules: Provide schedules for ACAMS control panels that show each point ID with a description of the connected devices.
  - 4. Block Diagram/Riser Diagram: Show the ACAMS components, conduit, wire types, and sizes between them, including cabling interties between termination hardware.
  - 5. Custom mounting details

## **PART 2 - PRODUCTS**

### 2.1 ACAMS SOFTWARE & SERVER

- A. General
  - 1. Designed for unlimited scalability with a multi-tier enterprise architecture to allow for centralized monitoring and control of buildings within the Owner's campus and future remote sites.
- B. Features
  - 1. Capable of using a single user interface for the following applications:
    - a. Access control
    - b. Alarm monitoring
    - c. Intrusion detection
    - d. Graphical mapping
    - e. Badging and credential management
    - f. Visitor management
    - g. Video management
  - 2. Supports automated communication in user configurable timed intervals for business automation processes and SQL databases using XML communications.
  - 3. Supports real-time bidirectional communication between cardholder data with HR databases, emergency response systems, and third party systems using custom software scripts.
- C. Manufacturer
  - 1. S2 Security
    - a. S2 NetBOX

### 2.2 ACAMS WORKSTATIONS

- A. ACAMS Workstation
  - 1. Provided by Owner.
- B. ACAMS Software
  - 1. Manufacturer
    - a. S2 access control system or equal.



2. Include software licenses:
  - a. Integrated video management software for specified network video recording system, refer to Section 28 23 00 – Video Surveillance System

### 2.3 ACAMS CONTROLLERS

- A. General
  1. An intelligent controller with integrated battery backup, database, and communication ports that supports 16 card readers.
  2. Supports multiple communication channels to which a variety of devices can connect.
  3. Supports hardware modules used for additional memory and/or for future feature enhancements.
  4. Functions provided include:
    - a. Central control for attached devices and addressable modules
    - b. Makes decisions for access
    - c. Responds to monitor activity
    - d. Receives input to control its decision making
    - e. Reports activity to other devices
- B. Features
  1. Supports HID proximity, MIFARE, and DESFire card reader formats
  2. Supports flash upgrades for firmware updates
  3. Utilizes an onboard Ethernet NIC
  4. Global input/output and anti-passback functionality
  5. Capable of utilizing keypad commands to activate/deactivate events
- C. Supports RS-485 connectivity to addressable modules:
  1. Input Module: Supports 8 Class A supervised input points
  2. Output Module: Supports 8 Form C dry contact relays
  3. Reader Interface Module: Supports 2 card readers with associated alarm contacts, request-to-exit devices, and lock outputs configured in Fail Secure mode.
- D. Manufacturer
  1. S2 system compatible with the existing Fannin county access controllers.

### 2.4 EQUIPMENT ENCLOSURES

- A. General
  1. Provide enclosures with butt hinged and lockable door containing a lock kit (keyed alike with other security enclosures on the project).
  2. Provide perforated back panel for mounting control boards, relays, and terminal strips with enclosure.
  3. Provide slotted wiring duct for routing security cabling within enclosure.
  4. One tamper switch for each enclosure
- B. Security Equipment Cabinets
  1. Type: NEMA type 1 enclosure
  2. Size: 36" x 24" x 6" minimum
  3. Finish: ANSI 61 gray polyester powder paint finish inside and out
  4. Manufacturer
    - a. Hoffman
      - 1) #A36N24M enclosure with #A36N24MPP back panel and #A612AR lock kit
    - b. Or equal
- C. Slotted Wiring Duct
  1. Type: Lead-free PVC with narrow finger design
  2. Size: 1" x 1" minimum
  3. Color: Light gray
  4. Manufacturer
    - a. Panduit
      - 1) #Type-F narrow slot wiring duct
    - b. Or equal

## 2.5 WIREWAYS

- A. General
  - 1. Provide screw cover wireway sections with open top assembly as shown on Security drawings.
  - 2. Provide closure plates to secure end of wireway sections.
- B. Screw Cover Gutter Wireways
  - 1. Type: NEMA type 1 enclosure
  - 2. Size: 4" x 4" x 48" minimum
  - 3. Finish: ANSI 61 gray polyester powder paint finish inside and out
- C. Manufacturer
  - 1. Hoffman
    - a. # F44T148GVP lay-in painted wireway without knockouts
    - b. #A44GCPNK closure plate without knockouts
  - 2. Or equal

## 2.6 CARD READERS

- A. General
  - 1. Presenting an access card to the reader initiates a single transmission to the ACAMS controller.
  - 2. Rugged, weatherized polycarbonate enclosure, designed to withstand an operating temperatures of -22 to 120 degrees Fahrenheit (-30 to 65 degrees Celsius) and operating humidity of 5-95% non-condensing.
  - 3. Utilizes a Wiegand protocol for communication for compatibility with standard access control systems.
  - 4. Utilizes a multi-color LED and an audible sounder to indicate the status of the door.
  - 5. Utilizes an internal tamper switch that will indicate an alarm condition if an unauthorized attempt is made to disassemble the unit.
  - 6. Capable of reading the following frequencies and card formats:
    - a. 125kHz – Indala Prox (coordinate with Owner's existing security vendor for facility code and other propriety format information)
    - b. 13.56MHz – HID iClass
- B. Manufacturer
  - 1. HID
    - a. Or equal

## 2.7 MAGNETIC CONTACT SWITCHES

- A. Wood, Steel, and Hollow Metal Doors
  - 1. General
    - a. Mounting: Recessed
    - b. Contacts: Single Pole, Single Throw
    - c. Gap Distance: 0.5" maximum
  - 2. Manufacturer
    - a. GE Security
      - 1) #1078C 3/4" alarm contact switch
    - b. Or equal

## 2.8 DURESS BUTTONS

- A. Under-Counter
  - 1. General
    - a. Actuating lever, housing, and cover plate made of ABS fire-retardant plastic
    - b. Latching circuit with integrated LED
    - c. Contact: Normally Open or Normally Closed electrical loop, SPDT
    - d. Operating Voltage: 12VDC
  - 2. Manufacturer
    - a. GE Security
      - 1) #3040 panic switch
    - b. Or equal



## 2.9 REQUEST-TO-EXIT MOTION SENSORS

### A. General

1. Power: 12 or 24VDC, 35mA
2. Relay Output: 2 form "C" contacts
3. Adjustable relay latch time
4. Programmable retrigger or non-retrigger mode
5. Programmable Fail Safe or Fail Secure Modes
6. Radio Frequency Interference (RFI) Immunity range from 26 to 1,000 MHz at 50 v/m

### B. Manufacturer

1. Bosch
  - 1) #DS160 request-to-exit sensor
  - 2) #TP160 electrical back box adapter plate
2. Or equal

## 2.10 MOTION SENSORS

### A. General

1. Type: Passive infrared (PIR) detector with Fresnel type lens
2. Operating Voltage: 10-14VDC
3. Range: 35' x 35' minimum
4. Integrated tamper switch

### B. Manufacturer

1. Bosch
  - 1) #ISM-BLP1 blue line PIR detector
2. Or equal

## 2.11 ACAMS POWER SUPPLIES

### A. General

1. Provides a 120VAC to 12 and 24VDC output, fully supervised power supply to power ACAMS field devices. Contractor responsible for providing power as necessary even if not shown on plans.
2. Utilizes 16 PTC Class 2 rated power limited outputs.
3. Short circuit and thermal overload protection.
4. Integrated charger for sealed lead acid or gel type batteries.
5. Capable of providing a 10 amp supply current.
6. Supports a fire alarm disconnect to relay that individually selects any or all of the 16 outputs.

### B. Manufacturer

1. Altronix
  - 1) #MAXIM75 power supply
2. Or equal

## 2.12 BATTERIES

### A. General:

1. Voltage: 12.00
2. Amps: 12.00
3. Chemistry: SLA or VRLA valve regulated
4. Termination: Spade protected terminals

### B. Manufacturer:

1. Yuasa
  - 1) #RE12-12 sealed lead acid 12V 12Ah battery
2. Or equal

## **PART 3 - EXECUTION**

### **3.1 INSTALLATION**

- A. ACAMS Software & Server
  - 1. Rack mount server in the security equipment rack in ER room as indicated on project drawings.
  - 2. Install MS Windows Server 2008 and necessary client access licenses. Coordinate with Owner's IT and Security representatives to program OS and other critical applications to Owner's existing standards.
- B. KVM Console
  - 1. Rack mount KVM console with integrated LCD monitor, keyboard, and mouse in the security equipment rack in ER room as indicated on the project drawings.
  - 2. Connect ACAMS servers to the KVM console. Provide adapters and cable extensions as required.
- C. ACAMS Control Panels
  - 1. Place power supply and associated hardware in same location.
  - 2. Provide designated resistors at device end of line per manufacturer's EOL recommendation to provide four-state supervision of security device and cabling.
  - 3. Provide EOL supervision for alarm contacts, local alarm sounders, motion detectors, glass break detectors, help/duress buttons, and other designated security devices connected to the ACAMS and IDS.
  - 4. Provide the following states of supervision:
    - a. Contact closed = Secure
    - b. Contact open = Alarm
    - c. Short circuit = Line fault
    - d. Open circuit = Line fault
- D. Card Readers
  - 1. Wire the card reader's multi-color LED to indicate the following status of the door.
    - a. Red status indicates the door is secure (locked).
    - b. Green status indicates the door is unsecured (unlocked).
    - c. Yellow status indicates the card reader is not functioning (off-line/trouble), is processing a read request, or has denied access.
  - 2. Utilize configuration card to enable optical tamper.
  - 3. Wire the card reader's optical tamper to spare input on the ACAMS reader module and jumper ground wire from door contact to provide a Normally Closed circuit.
  - 4. The card reader to produce an audible beep tone to indicate to the user:
    - a. The card was read and/or access was denied.
    - b. Door is being held open and needs to be closed.
- E. Elevator Readers
  - 1. Furnish card reader to elevator contractor for installation,
  - 2. Coordinate the installation and termination of the card reader inside the cab and in the elevator machine room.
  - 3. Coordinate with elevator contractor to connect ACAMS output relays to elevator controller. Install terminal blocks in security demarcation enclosure as indicated on project drawings to separate security from elevator cabling.
- F. Door Hardware
  - 1. Route power to electrically controlled locks on life-safety doors through fire alarm output to automatically unlock the door upon activation of Fire/Life-Safety system. Connect fire alarm output to the disconnect relay on the associated 24VDC lock power supply.
  - 2. Setup and conduct a door hardware coordination meeting.
  - 3. Coordinate the installation and termination of the security cable with the installation of the electric door hardware and transfer hinge.
  - 4. Provide cable and terminate wires to delayed egress devices for monitoring activation of delayed egress by the ACAMS system.
- G. Door Contacts



1. Install on protected (secured) side of door.
  2. Install 6" from leading edge at top of door.
- H. Duress Buttons
1. Mount duress buttons under work desks as indicated on the project drawings.
  2. Coordinate with architect and casework contractor to field determine exact placement prior to installation.
- I. Request-To Exit Motion Detectors
1. Mount motion detector on the secured (protected) side of door.
  2. Install motion detector so that detection pattern is not obstructed by Exit Signs, light fixtures and other objects that would interfere with proper operation.
  3. Adjust relay hold time and pattern to properly detect valid exit and allow shunting of door contact.
  4. Adjust detection sensitivity to pulse.
  5. Mask detector lens to provide a confined detection area limited to the door handle or push bar area.
  6. Run wire inside structural tube steel frame into back of conduit for cage locations.
- J. Local Alarm Sounders
1. Mount local alarm sounder as necessary for proper coverage.
  2. Install local, square, and plumb. Set flush-mounted units so that the face of the cover, bezel, or escutcheon matches the surrounding finished surface.
  3. Mount so that there are no gaps, cracks, or obvious lines between the trim and the adjacent finished surface.

### 3.2 PROGRAMMING

- A. Prior to the completion of construction, schedule a meeting with the Owner's IT and Security representatives to determine the programming criteria. Discuss the following:
1. Access card levels and door groupings
  2. Alarm priority levels
  3. Schedules and time codes
  4. Holidays and holiday types (priorities)
  5. Action/responses from individual input points
  6. Standard and custom (expanded) reports
  7. Defining alarm messages and standard response messages applicable to site
  8. Routing of alarm points to selected mobile phones
  9. Routing of alarm points to operator's workstations, printers, and history files
  10. Coordinate implementation of graphics with Owner. Develop sample graphic complete with icons and text. Alarms to appear on building floor plans depicting the nature and location of alarms. Review and revise graphic layout as required by Owner.
- B. Document the results of the meeting and perform necessary programming to achieve the Owner's requests.
- C. System Operation, Alarm and Reporting Function: Program door control panel tamper switches to immediately report as a separate "tamper" point to the system resulting in an alarm condition displayed in both text and graphic form on the applicable workstation(s) and an alarm message transmitted to the appropriate pager(s).
- D. Receive CAD drawing files of floor plans and perform the following relative to system graphics:
1. Delete non-applicable drawing layers and details to arrive at simple floor plans of the building as built.
  2. Convert drawings to a graphic file format compatible with the Owner's access control and alarm monitoring system.
  3. Load drawing files into the system.
  4. Apply new and predefined icons and other points on each graphic to indicate point and control status.
  5. Link graphic images to reader, monitor and control points.


3.3 TESTING

- A. Commission ACAMS in accordance with Section 28 08 00.

END OF SECTION



PAGE INTENTIONALLY LEFT BLANK

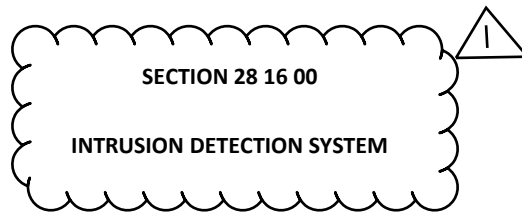

**PART 1 - GENERAL**

**1.1 SUMMARY**

- A. General: Furnish engineering, labor, materials, apparatus, tools, equipment, transportation, temporary construction, and special or occasional services required to make a complete working intrusion detection system installation as described in these specifications.
- B. Section includes:
  - 1. Intrusion Detection System, including digital communicator, keypad, and alarm devices.
  - 2. Door contacts, glass break detectors, motion sensors
  - 3. Duress alarm stations
  - 4. Interfaces and connections between intrusion detection subsystems to allow communication with one another
- C. Products furnished and installed under another section:
  - 1. 120V power
  - 2. Phone line
- D. Related sections:
  - 1. Section 28 00 00 – Basic Security Requirements: for submittal format, warranty, general product requirements, and installation requirements
  - 2. Section 28 13 00 – ACAMS: for interface requirement to the intrusion detection system
  - 3. Section 28 05 13 – Security System Cabling: for cable requirements related to the IDS
  - 4. Section 28 05 53 – Security System Labeling: for device labeling requirements
  - 5. Section 28 08 00 – Security System Acceptance Testing: for testing requirements

**1.2 SYSTEM DESCRIPTION**

- A. Overview
  - 1. The IDS is utilized for after hours monitoring of facility.
  - 2. Activation of the IDS direct dials emergency services with a prerecorded message requesting law enforcement.
  - 3. The IDS integrates with the ACAMS through software to provide bidirectional communication and notification of alarm events.
- B. Intrusion Detection System
  - 1. Provide an IDS control panel with integrated UL listed digital communicator located in the telecommunication room as indicated on project drawings. Panels support up to 8 areas and 128 zones by use of addressable input/output point modules.
  - 2. Provide LCD command keypads in the security desk. Keypads allow for system arming and disarming by authorized users.
  - 3. Provide battery backup of IDS components and power supplies for a minimum of 24 hours in the event of a power failure or emergency.
- C. Interface with ACAMS
  - 1. Provide Ethernet network interface module to allow for software integration with ACAMS.
  - 2. Configure IDS and ACAMS to allow for bidirectional communication of alarm contacts and motion detectors as shown on the project drawings.

**1.3 SUBMITTALS**

- A. Product Data: Submit product information for the intrusion detection systems, including:
  - 1. IDS control panel



2. Keypads
  3. Calculations for backup batteries
- B. Shop Drawings: Submit shop drawings containing the following:
1. Device placement on floor plans
  2. Point-to-Point Wiring Diagrams: Include wiring, points of connect, and interconnecting devices between the following:
    - a. IDS control panel
    - b. IDS expansion modules and relays
    - c. Keypads
    - d. Motion sensors
    - e. Alarm contacts
    - f. Power supplies
    - g. Cable conductors (identify conductors on the point-to-point diagrams with the same tag as the installed conductor)
  3. Schedules: Provide schedules for the IDS control panel that show each alarm zone, applicable area or partition, and a description of the connected device.
  4. Custom mounting details

## **PART 2 - PRODUCTS**

### **2.1 IDS CONTROL PANELS**

- A. General
1. Integrated UL listed digital communicator with phone line monitor (loop or ground start).
  2. Supports up to 75 alarm zones and 8 programmable areas or partitions.
  3. Capable of utilizing multiple telephone numbers, primary and duplicate paths with main and alternate destinations.
  4. Capable of utilizing a dual phone line switcher to monitor 2 phone lines.
  5. Capable of sending daily automatic test and status reports.
  6. Supports supervised expansion and relay output modules.
  7. Supports RS-232 connectivity to third party devices for automation.
  8. Capable of utilizing an TCP/IP converter for Ethernet connectivity.
- B. Manufacturer
1. Bosch G series control panels
    - a. Bosch #D7412GV2 control panel
    - b. Bosch #D8128D OctpPOPIT 8-point input module
    - c. Bosch #D8129 Octo-relay 8-point output module
    - d. Bosch #DX4020 Connettix Ethernet network interface module
  2. Or Equal

### **2.2 IDS KEYPADS**

- A. General
1. 32-character display
  2. Keys light on entry or key press
  3. Back lighted multi-key touch pad
  4. User controlled brightness and loudness
- B. Provide the ability to display for each detection point:
1. Alarm
  2. Trouble
  3. Supervisory
  4. Faulted
  5. Custom text
- C. System wide displays include:
1. Local system test

2. Sensor reset
  3. Event log
- D. Manufacturer
1. Bosch #D1260 alphanumeric LCD display keypad
  2. Or Equal

### **PART 3 - EXECUTION**

#### **3.1 INSTALLATION**

- A. General
1. Follow manufacturers recommended guidelines for installation.
  2. Install glass break detection for all first floor and ground level windows.
  3. Install motion detectors in all public areas in basement, ground floor and first floor.
- B. Components
1. IDS Control Panel
    - a. Place control panel and associated expansion boards in SEC (NEMA Type-1 enclosure) with ACAMS equipment in nearest TR room.
    - b. Utilize ACAMS power supplies to power control panel and associated expansion boards. Do not use plug-in transformers.
    - c. Provide standoff brackets to mount control boards to perforated panel within enclosure.
    - d. Place power supply and associated hardware in same location.
    - e. Install supervisory and end of line resistors as required.
    - f. Coordinate installation of phone jack in IDS control panel enclosure with telecommunications contractor for communications to the alarm receiver.
  2. Keypads
    - a. Mount keypads as indicated on project drawings.

#### **3.2 PROGRAMMING**

- A. Prior to the completion of construction, schedule a meeting with the Owner's IT and Security representatives to determine the following programming criteria:
1. Zone or alarm point descriptions
  2. User authority levels to arm/disarm areas or alarm partitions
  3. Auto arm/disarm schedules
  4. Interface requirement with ACAMS
  5. Dispatch response from individual alarm points
  6. Password and call list information
- B. Document the results of the meeting and perform necessary programming to achieve the Owner's requests. Program and setup the system such that no additional programming other than entering new access codes is required.


#### **3.3 TESTING**

- A. Commission the Intrusion Detection System in accordance with Section 28 08 00.

END OF SECTION

PAGE INTENTIONALLY LEFT BLANK



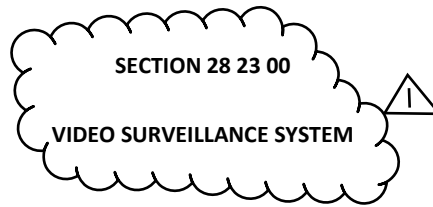

**PART 1 - GENERAL**

**1.1 SUMMARY**

**A. General**

1. Provide engineering, labor, materials, apparatus, tools, equipment, transportation, temporary construction, and special or occasional services as required to make a complete working video surveillance system installation, as described in this specification.
2. Section Includes:
  - a. Network video recording system
  - b. Network video management software
  - c. Network video cameras
  - d. Network video encoder servers
  - e. Analog cameras
  - f. Power supplies
  - g. Integration with the ACAMS and other security subsystems to allow for bidirectional communication
  - h. Interface to elevator conveying system
  - i. Interface to Point-of-Sale (POS) system
3. Products Furnished and Installed Under another Section:
  - a. 120V power
  - b. Horizontal fiber optic and UTP cabling for IP cameras

**B. Related Sections**

1. Consult other Divisions, determine the extent and character of related work and properly coordinate work specified herein with that specified elsewhere to produce a complete and operable system.
2. Section 28 00 00 – Security Basic Requirements: for submittal formats, warranty, general product requirements, and installation requirements.
3. Section 28 05 13 – Security System Cabling: for cable requirements related to the VSS.
4. Section 28 05 53 – Security System Labeling: for device labeling requirements.
5. Section 28 08 00 – Security System Acceptance Testing: for testing requirements.
6. Section 28 13 00 – Access Control & Alarm Monitoring System: for interface requirements related to the VSS.
7. Section 28 48 00 – Detention Control System: for interface requirements related to the VSS.

**1.2 SYSTEM DESCRIPTION**

**A. Overview**

1. The Owner desires a comprehensive and feature rich IP video surveillance system to monitor the flow of visitors, and staff throughout the building.
2. The VSS consists of host servers, RAID storage devices, video management software, a combination of fixed network and analog cameras, video encoder servers, and integration with other security subsystems.
3. The VSS software will reside on fully scalable iSCSI SAN array storage devices with integrated MS Windows based servers to provide a non-proprietary software-based video solution.
4. The VSS will utilize PoE network cameras within interior and exterior spaces of the building and traditional analog cameras within the elevator cars.

**B. Video Surveillance System**

1. Provide video management software and camera licenses to support the devices shown on the project drawings. Provide rack-mount NVR servers and RAID storage devices in the ER security cabinet to allow for 30 days of storage with continuous recording with 24fps at 1280x720.

2. Provide client video management software licenses for live viewing and monitoring of the cameras on ACAMS workstations. Provide web browser client software license (thin client) to allow for remote viewing on other workstations.
  3. Provide network fixed and PTZ/360/180 cameras as shown on the project drawings. Typical camera locations include:
    - a. Corridors
    - b. Perimeter entrances and emergency exits
    - c. Stairwells
    - d. Elevator vestibules
    - e. Exterior mounted cameras
- C. VSS Integration Requirements
1. Provide software integration between the ACAMS and video management software for automatic camera call-up upon access control event.
  2. Provide integration between detention control system and video management software for automatic camera call-up upon activation alarm at all duress button locations and fire alarm manual pull stations. Utilize digital I/O to capture hardwired input/outputs from detention control system and convert them to digital alarms on the video management system.
- D. Interface to Elevator Conveying System
1. Each elevator to contain an analog fixed camera within the ceiling of the elevator car.
  2. Provide stainless steel finish trim rings for mini-dome camera housings for cameras within the elevator cars. Coordinate with manufacturer to furnish custom painted housings.
  3. Furnish analog cameras with custom stainless steel finish to elevator contractor for installation within the elevator car.
  4. Provide analog signal cabling between the elevator machine room and the nearest TR room. Coordinate with elevator contractor for termination requirements.
  5. Provide analog camera power supplies to support the cameras in the elevator cars. Coordinate with elevator contractor for exact location.
  6. Provide rack-mount video encoder servers in the TR room to convert elevator analog video signals into a digital IP format for communication to the video management software.

### 1.3 SUBMITTALS

- A. Product Data: Submit product information for components specified herein.
- B. Shop Drawings:
1. Floor Plans: 1/8 inch scale floor and site plans showing the locations of devices and cable routing paths with cable types and quantity called out.
  2. Point-to-Point Diagrams: Include wiring, points of connection and interconnecting devices between the following:
  3. Video surveillance system, monitors, and recording equipment
  4. Devices connected to the system
  5. Conductors (identify conductors on the point-to-point diagrams with the same tag as the installed conductor)
  6. Block Diagram/Riser Diagram: Show the video surveillance system components, conduit, wire types, and cabling interties between termination hardware.
  7. Custom mounting details

### 1.4 EXTRA MATERIALS

- A. Furnish extra materials to the Owner in the original manufacturer's packaging.
- B. Provide spare parts of the following installed devices:
1. 4 x interior fixed network cameras
  2. 2 x exterior network cameras
  3. 4 x 8TB hard drives

## **PART 2 - PRODUCTS**

### **2.1 NETWORK VIDEO RECORDING SOFTWARE**

#### **A. General**

1. Complete software-based platform that encompasses recording video, viewing video, reviewing recorded video, and storing video for indefinite periods of time.
2. Designed for a multi-site, multi-server environment for a fully scalable network video recording solution.
3. The system simultaneously records, displays live video, and plays back video. None of the video operations interfere with each other. Live view and video playback does not interrupt the recording process.

#### **B. Features**

1. Simultaneous support for MJPEG, MPEG-4, and H.264 video compression formats.
2. Standards-based, open architecture software that is capable of running on non-proprietary hardware.
3. Supports desktop, web browser, and mobile web clients. Capable of pushing live video on-demand to and from any client.
4. Integrated virtual matrix switch for distributed video wall management.
5. Search Capabilities
  - a. Motion detection time line
  - b. Auto-generated time intervals with thumbnail image previews
  - c. Object or zone based search
  - d. Alarm or event via ACAMS or video analytics behaviors
  - e. Supports an unlimited amount of configurable camera group views
6. Recording Configuration
  - a. Advanced motion detection with configurable motion sensitivity, size, and speed
  - b. User configurable archiving schedules and sequences that do not impact uptime
  - c. Hardware and bandwidth utilization for monitoring and recording video and different frame rates and resolutions
  - d. Multiple channel audio recording
7. Virtual Matrix Switch Configuration
  - a. Supports graphical keypads, touch screen monitors, dynamic mapping, and PTZ joystick controls
  - b. Supports an unlimited amount of cameras, monitors, and operators
  - c. Capable of pushing camera streams to any video wall monitor or remote display within the video management system
  - d. Capable of creating custom groups on-demand
  - e. Utilizes a one-touch or one-click selection from active maps to specific floor plans with detailed camera locations and viewing angles
  - f. Integrates with video analytics, ACAMS, and POS systems
  - g. Enables real-time notification, reviewing, and acknowledgement of events and alarms
8. Video Analytics
9. Network Configuration
  - a. Capable of utilizing multiple networks and subnets
  - b. Capable of utilizing user authentication via MS Windows User Account and Groups
  - c. Capable of running as a MS Windows service
  - d. Support for MS Active Directory
  - e. Support for VMware and MS Virtual PC

#### **C. Manufacturer**

1. S2 NetVR 100 Series System

### **2.2 NETWORK VIDEO ANALYTICS SOFTWARE**

#### **A. General**

1. Provides the core functionality of a video analytics system that will process the digital video and generate alarms and/or event messages when specific events are detected.
2. Software based solution installed on non-proprietary hardware with NVR integration
3. The software will operate in various environmental conditions including the following:



- a. Natural or artificial lighting in indoor/outdoor environments
  - b. Infrared illumination for use with compatible cameras
  - c. Immune to false alarms in various weather conditions including sun, clouds, rain, snow, sleet, wind or fog
  - d. Image stabilization to counter camera shake from wind or vibration due to camera mounting location
- B. Performance Requirements
- 1. Capable of providing a variety of detection zones
    - a. A detection zone is defined as a region with a camera field of view used to detect behaviors specific to that zone.
  - 2. Capable of defining multiple detection zones with a single camera view.
  - 3. Capable of reporting alarms with the following:
    - a. On screen display with alarm text
    - b. Audio alarm alerts
    - c. Email notification containing the key video frame and relevant data
- C. Manufacturer
- a. S2 Security

### 2.3 NETWORK VIDEO SERVER & STORAGE APPLIANCES

- A. Document the cost of this hardware at time of bid due to price reductions and advancements in technology. Prior to placement of order, provide upgrades to the most current model as requested by the Owner up to the cost of the specified system.
- B. General
- 1. Controller: S2 Security Controller
  - 2. Processor: Intel Corei3 product family
  - 3. Memory: 8 GB RAM
  - 4. Hard Drive Configuration: RAID 5
  - 5. Hard Drive per Server: 2 x 8 TB SAS 7.2K RPM 3.5 inch HDD
  - 6. Chassis Configuration: Rack chassis with sliding rails
- C. Features
- 1. Fully scalable iSCSI SAN array with integrated virtual servers to provide a cloud-based video storage solution.
  - 2. Capable of creating a SAN array of up to 288 TB of raw storage with no single point of failure. Data access is protected during switch, port, NIC, power supply, fan, and disk failures.
  - 3. Capable of supporting RAID-6x so up to 5 simultaneous disk failures and a single server appliance failure will not affect data. Server applications restart automatically on an appliance failure.
  - 4. Integrated management software to provide alarms and alerts for disk failure, automation of iSCSI connections, and data protection.
- D. Manufacturer
- 1. S2 Security

### 2.4 NETWORK HD FIXED CAMERAS

- A. Complete prepackaged unit containing:
- 1. Sensor: 1/3" progressive scan CMOS Sensor
  - 2. Resolution: 30 frames at 1920 x 1080 (1080p HDTV)
  - 3. Video compression format: H.264 and MJPEG
  - 4. Camera Power over Ethernet (IEEE 802.3af) excluding heater/blower load
- B. Manufacturer
- a. Axis P3225-LV Mk II

### 2.5 NETWORK HD CORNER MOUNTED CAMERAS

- A. Complete prepackaged unit containing:
- 1. Sensor: 1/3" progressive scan CMOS Sensor

2. Resolution: 30 frames at 1920 x 1080 (1080p HDTV)
3. Video compression format: H.264 and MJPEG

- B. Manufacturer
  - a. AXIS Q8414-LVS in White

## 2.6 NETWORK HD EXTERIOR CAMERAS

- A. Complete prepackaged unit containing:
  1. Sensor: 1/3" progressive scan CMOS Sensor
  2. Resolution: 30 frames at 1920 x 1080 (1080p HDTV)
  3. Video compression format: H.264 and MJPEG
- B. Manufacturer
  - a. AXIS P3227-LVE

## 2.7 NETWORK VIDEO ENCODERS

- A. General
  1. Video Compression: Dual H.264 video streams per input
  2. Resolution: 30 frames at 720x480 (NTSC)
  3. Alarm and event management
  4. Inputs: 4 or 8 BNC, looping
- B. Manufacturer
  - a. Axis

## 2.8 ANALOG FIXED CAMERAS

- A. Complete prepackaged unit containing:
  1. 1/3" high resolution color CCD camera
  2. Resolution: 704x480 (4CIF)
  3. Auto iris, varifocal lens of 3.0-9.5mm
  4. Connectors:
    - a. Analog video, composite video output
    - b. Power, 12VDC or 24VAC
    - c. Vandal-resistant, IP66 rated dome housing
    - d. Stainless steel finish
- B. Features
  1. Digital signal processing
  2. Digital slow shutter to enhance image quality in low light applications
- C. Manufacturer
  - a. Axis

## 2.9 POWER SUPPLIES

- A. General
  1. Provide a 120 to 24VAC output, continuous current, fully supervised power supply for each for each exterior camera with internal defroster/heater and each elevator camera.
  2. Provide separate transformers and cables for the defroster/heater in each exterior camera housing (i.e. do not connect these loads to the camera power supply).
- B. Manufacturer
  - a. Axis

## 2.10 FIBER OPTIC MEDIA CONVERTERS

- A. General
  1. Provide fiber optic media converts to support the stand-alone cameras shown on the site drawings.
- B. Manufacturer

1. TC Communications (no substitutions)
  - a. Devices within each standalone camera:
    - 1) #TC3212-03-SC1-24 multi-mode fiber converter, stand alone, 24VDC

### **PART 3 - EXECUTION**

#### **3.1 INSTALLATION**

- A. Network Video Recording Software
  1. Program record rate for network cameras at 30 frames per second at full resolution (1920x1080) using H.264 compression format.
  2. Coordinate with Owner's IT and Security representatives to set the following criteria:
    - a. Administrator and operator passwords
    - b. Camera and video device naming conventions
    - c. Maximum bit rate
    - d. Bandwidth throttle
    - e. Camera groups and operator views
    - f. Mapping features and criteria for a fully interactive graphical display of each floor plan
    - g. Alarm events and integration into ACAMS
    - h. Interface with POS system in Dining/Serving area
- B. Network Video Analytics Software
  1. Interface with video management software to transmit metadata from behavior alarms on recorded video.
  2. Coordinate with Owner's IT and Security representatives to set the following criteria:
    - a. Define zones for advanced motion detection to enable "tailgating" behavior alarm for turnstiles at the Employee Entrance.
    - b. Define crowd size and time threshold to enable "crowding", "loitering", and "stopped vehicle" behavior alarms for exterior cameras.
- C. Network Video Server & Storage Appliance
  1. Rack mount servers in the ER room as indicated on project drawings. Coordinate with Owner's IT representative and telecommunications contractor to provide network connectivity.
  2. Install MS Windows Server 2008 and necessary client access licenses.
  3. Install video management and video analytics software packages.
  4. Configure each array to support the maximum volume of disks in a RAID-6x configuration.
  5. Setup management software to transmit alerts and alarms for disk failure to the ACAMS. This will enable a single point of monitoring all security related alarms.
  6. Connect six (6) patch cords from network switch to each appliance to provide fault tolerance and sufficient switch ports for video throughput.
- D. Interior Network HD Cameras
  1. Provide flush ceiling mount for fixed network cameras within ceiling space. Install camera body above ceiling line when camera located in ceiling so only dome exposed.
  2. Provide surface mount ring and electrical back box adapter plate for fixed network cameras in stairwells or other wall mounted locations.
  3. Field determine exact placement of cameras to ensure complete coverage.
  4. Adjust the wide dynamic range, gain control, and noise reduction settings on each camera as required to provide clear and crisp video images.
- E. Exterior Network HD Cameras
  1. Provide outdoor housing and mounts for exterior cameras.
  2. Field determine exact placement of cameras to ensure complete coverage.
  3. Coordinate a meeting with Owner's IT and Security representatives and Division 26 contractor to walk site and confirm actual mounting locations for each CCTV camera prior to installation.
  4. Field determine fixed camera lens size and settings to ensure complete coverage.
- F. Network Video Encoder Servers
  1. Rack mount video encoders in the TR rooms as shown on the project drawings.
  2. Connect analog video signal cabling from elevator cameras to BNC inputs.



3. Program record rate at 12 frames per second at full resolution (704x480) using H.264 compression format.
- G. Analog Cameras in Elevator Cars
1. Furnish housing, camera, and lens and deliver to elevator contractor.
  2. Installation of cameras within elevator cars by elevator contractor.
  3. Coordinate a meeting with elevator contractor to determine termination point of traveler cable coax for analog camera video signal.
  4. Camera powered by low voltage power supply within elevator car.
  5. Terminate analog cameras to network video encoder servers in nearest TR room.
- 3.2 TESTING
- A. Commission the video surveillance system in accordance with Section 28 08 00 – Security System Acceptance Testing.

END OF SECTION

PAGE INTENTIONALLY LEFT BLANK

## Meeting Agenda

---

<b>Project</b>	Fannin County Courthouse Phase II Interior & Exterior Restoration
<b>Project No.</b>	#1737
<b>Purpose</b>	Pre-Bid Conference
<b>Date</b>	October 2, 2018

---

- I. Introductions
  - A. Sign-in sheet
  - B. Project Personnel
    1. Owner: Fannin County  
Contact: Fannin County Purchasing  
903.583.0054  
[fcch@fanninco.net](mailto:fcch@fanninco.net)
    2. Texas Historical Commission  
Contact: James Malanaphy, Project Reviewer  
512.475.3285  
[james.malanaphy@thc.state.tx.us](mailto:james.malanaphy@thc.state.tx.us)
    3. Architect: Architexas  
Contact: David Chase, Principal  
214.748.4561  
[dchase@architexas.com](mailto:dchase@architexas.com)  
Contact: Anne Stimmel, Project Architect  
[astimmel@architexas.com](mailto:astimmel@architexas.com)  
Contact: Renee Bresson, Project Architect  
[rbresson@architexas.com](mailto:rbresson@architexas.com)
- II. Overview of Bidding Procedures, Requirements & Schedule
  - A. RFP Deadlines
  - B. Access to Drawings
  - C. Bidding Q&A
    1. Submit questions in writing to Fannin County Purchasing by 3pm on October 9th.
    2. Architexas will respond via Addendum by October 16th.
    3. Proposals must be submitted to Fannin County by 1:30pm on October 23<sup>rd</sup>.
    4. Expected selection and award by November 6<sup>th</sup>.
  - D. Bid Evaluation Criteria
 

1. Price	35%
2. Delivery Schedule	25%
3. Past Experience	15%
4. References	10%
5. Proposed Subcontractors	15%
  - E. Project Schedule 600 calendar days



### III. Summary of Work

- A. Phase II of II for the full restoration of the 1888 courthouse.
- B. Project is part of the Texas Historical Courthouse Preservation Program (THCPP).
- C. Secretary of the Interior's Standards for the Treatment of Historic Properties apply to this project.
- D. Project will be reviewed by THC.
- E. Work includes interior and exterior restoration:
  - 1. Restore exterior and interior to 1888 appearance.
  - 2. Selective demolition of roof and support structure. Provide weathertight enclosure during roof removal.
  - 3. Masonry cleaning and restoration. Utilize original quarry for limestone replacement.
  - 4. Alternate #1 - restore site to 1888 appearance.
  - 5. Determine spot elevations on site once sidewalks are removed.
  - 6. Provide foundation waterproofing system.
  - 7. Provide ADA access at basement level.
  - 8. Provide new traction elevator.
  - 9. Tower to be sole source.
  - 10. Dry in building prior to tower installation.
  - 11. New flooring throughout. Determine finish floor levels.
  - 12. Reconstruct original cast iron stairs.
  - 13. Reconstruct courtroom balcony.
  - 14. Provide new doors and windows to match historic appearance.
  - 15. Vault door restoration.
  - 16. Provide new courtroom furnishings.
  - 17. Provide all new MEP systems.
- F. Reports for Reference (included in Project Manual).
  - 1. Geotechnical Report
  - 2. Environmental Reports
  - 3. Historical Paint and Finish Analysis Report
  - 4. Masonry Conservation Report
  - 5. Acoustical Report

### IV. General Questions

### V. Tour of the Building

### VI. Tour of the Original Quarry



























WHITE BELLS  
HENRY RED  
LOUISIANA

MP30

06